

工程指示 / 要求簡箋(E.I.)

工程指示編號：EI 6385

修改版次：B

工程編號：J835

工程名稱：TKO 66 D2 平台

工程項目：幕牆(試水) - 確認鋁摺件之圖紙

收件人：陳冠

發件人：Bobbie

日期：2016.12.22

要求提供 / 確認 事項：

- | | | |
|--|-------------------------------------|-------------------------------|
| <input type="checkbox"/> 初步鋁料 B.M. | <input type="checkbox"/> 加工拆圖，然後生產 | <input type="checkbox"/> 尺寸表 |
| <input type="checkbox"/> 正式鋁料 B.M. | <input type="checkbox"/> 技術上資料 / 指示 | <input type="checkbox"/> 報價 |
| <input type="checkbox"/> 配件 B.M. | <input type="checkbox"/> 樣辦或貨品說明書 | <input type="checkbox"/> 分判合約 |
| <input checked="" type="checkbox"/> 其他：_____ | | |

內容：

請將附件之圖紙予以核對及試水。

請在 2016.1.10 前完成上列要求。

附有關圖紙 / 文件：

1+ 62

以上項目為：

- 原合約工程包 原合約工程加 / 減賬 新工程報價

原因：-

分發東莞各部門：

- () 生產技術總監 連附件 () 技術部 連附件 () 生產部 連附件 () 機械設計部 連附件
 () 採購部 連附件 () 生產統籌部 連附件
 () 質檢部 連附件 () 會計部 連附件 () 報關組 連附件 () 其他 _____ 連附件

分發香港各部門：

- () 行政部 連附件 () 會計部 連附件 () 統籌部 連附件 () 工程部地盤科文 連附件
 () 採購部 連附件 () QS 部 連附件 () 維修部 連附件 () 其他 _____ 連附件


傳遞編號：

HK 3099/16 (FTP)

發件人簽署：

[Signature] 2016.12.22

項目經理簽署：

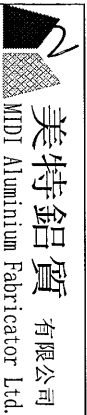

美特鋁質 有限公司
MTDI Aluminium Fabricator Ltd.

廠用鋁板B.M.表

B.M.編號:

工程號: J-835	計算: 劉寶平	日期: 29/11/2016	送呈:
地盤名稱: 將軍澳	核對: 王禮秋	日期: 29/11/2016	副本:
項目類別: 單元幕牆背板	批准:	日期:	
修改版本: B(2016.12.21)	A/C Code:	總V.F.:	此B.M.依據資料計算
		8.202	總重量: 46.21

序號	修改內容	鋁板圖號	鋁板名稱	顏色	實用	後備	總數	總重量	單件展開面積		總展開面積		備註	
									平方米	平方米	平方米	平方米		
1	B改	J835-AB-01	2mm厚鋁板	UCT34440SC-3 3 Coats silver	1		1	11.440	2.111	2.111	2.030	2.030	地盤安裝	
2	新增	J835-AB-01a	2mm厚鋁板	UCT34440SC-3 3 Coats silver	1		1	12.406	2.289	2.289	2.205	2.205	地盤安裝	
3		J835-AB-02	2mm厚鋁板	UCT34440SC-3 3 Coats silver	1		1	11.391	2.102	2.102	2.021	2.021	地盤安裝	
4		J835-AB-03	2mm厚鋁板	UCT34440SC-3 3 Coats silver	1		1	10.973	2.025	2.025	1.946	1.946	地盤安裝	
合計:							4	46.210			8.526		8.202	





美特鋁質 有限公司
MIDI Aluminium Fabricator Ltd.

产品编号	L(MM)	数量	A	N	M	B	N1	M1	备注
------	-------	----	---	---	---	---	----	----	----


1

工程號	J835	地盤	將軍澳66D平台
-----	------	----	----------

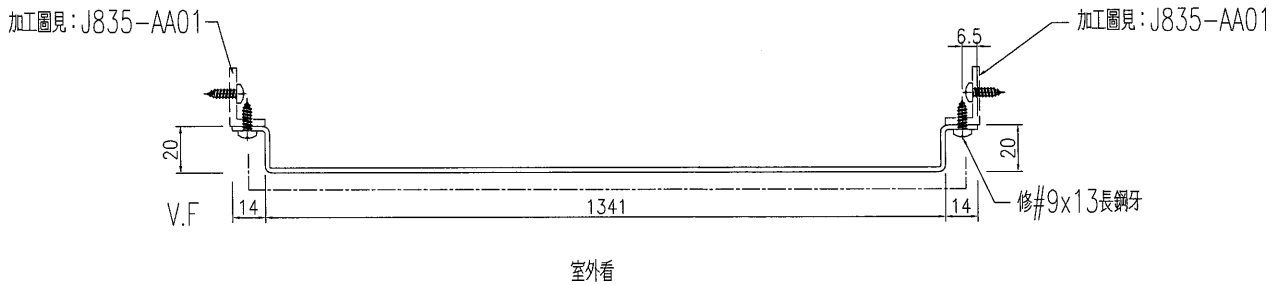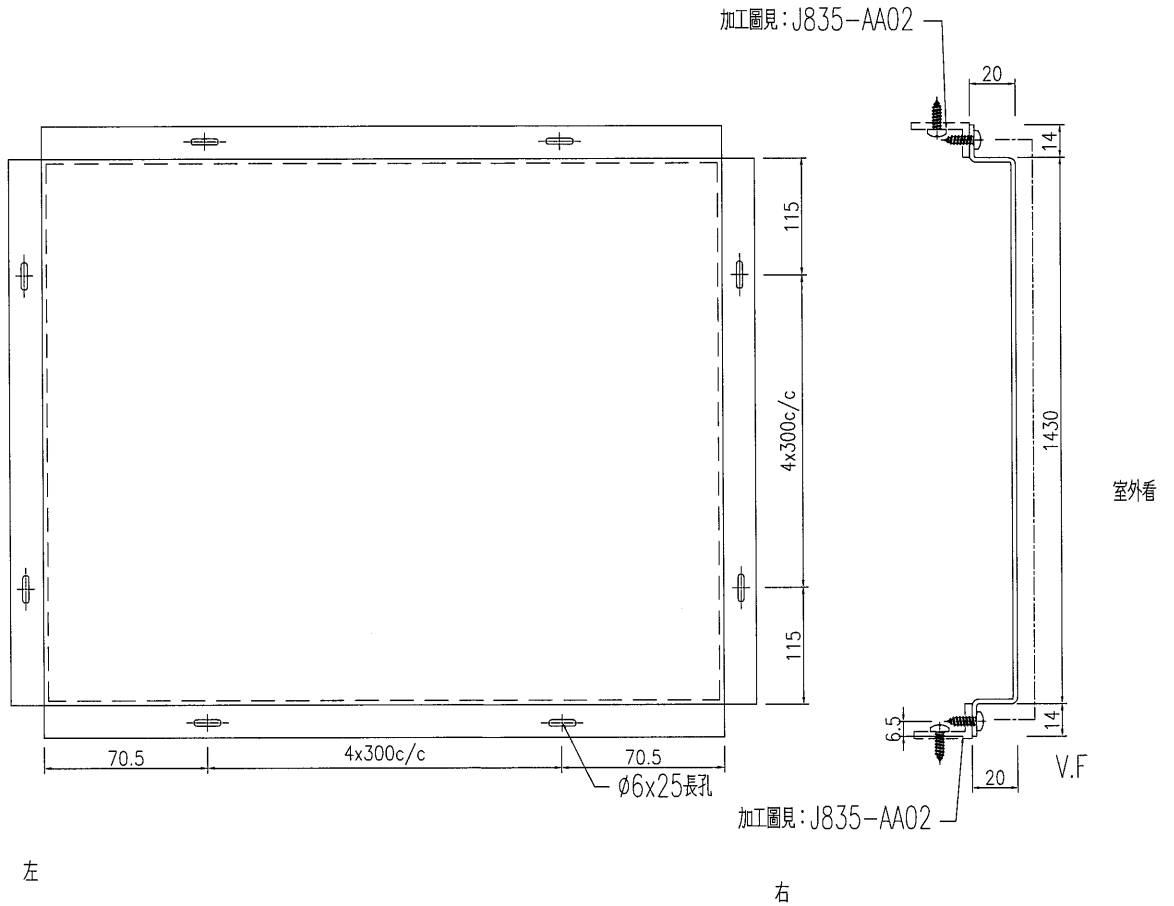

鋁角在地盤裝


名稱	鋁板加工圖	制圖	劉寶平	2016-11-18	修改	A	B	
材料	2mm鋁板	復核			日期	16-12-5	16-12-21	
顏色	UCT34440SC-3 3 Coats siver	批准			圖號	J835-AB-01		

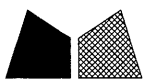

美特鋁質 有限公司
MIDI Aluminium Fabricator Ltd.

产品编号	L(MM)	数量	A	N	M	B	N1	M1	备注
------	-------	----	---	---	---	---	----	----	----

加工圖見：J835-AA02a

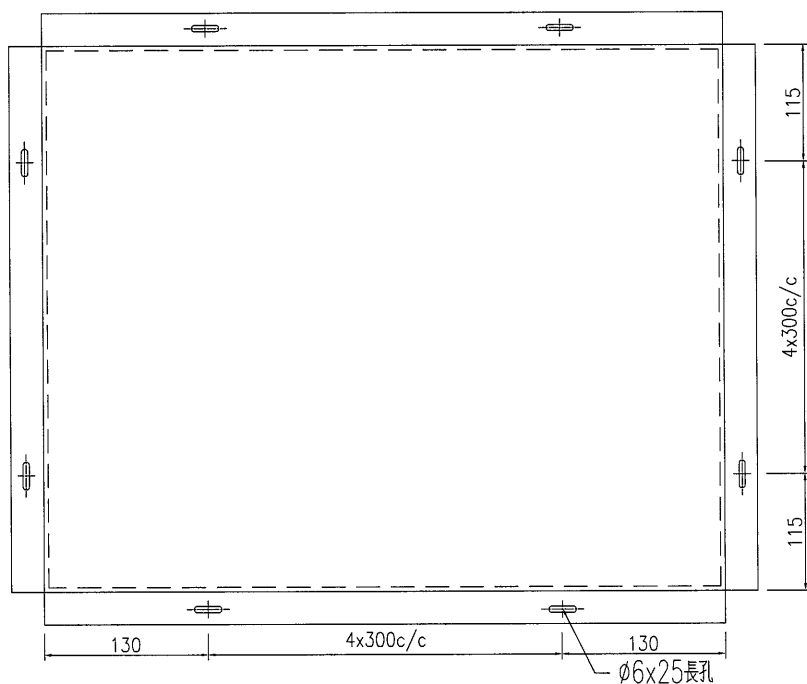


左

右

室外看

加工圖見：J835-AA02a

加工圖見：J835-AA01

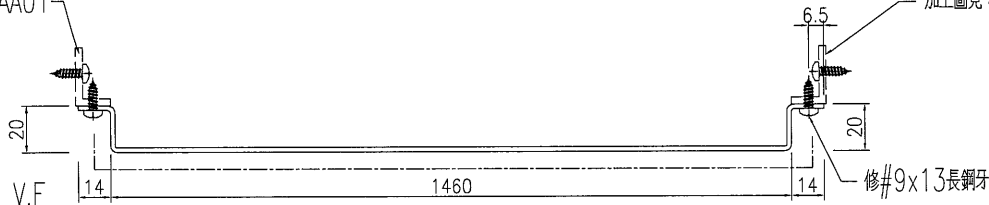

V.F

室外看


加工圖見：J835-AA01

鋁角在地盤裝

名稱	鋁板加工圖	制圖	劉寶平	2016-12-21	修改			
材料	2mm鋁板	復核			日期			
顏色	UCT34440SC-3 3 Coats siver	批准			圖號	J835-AB-01a		

产品编号	L(MM)	数量	A	N	M	B	N1	M1	备注
J835-AA01	1430	8		115	4X300C/C				
J835-AA02	1341	2		70.5	4X300C/C				
J835-AA02a	1460	2		130	4X300C/C				
J835-AA03	1335	2		67.5	4X300C/C				

工程號	J835	地盤	將軍澳66D平台
-----	------	----	----------

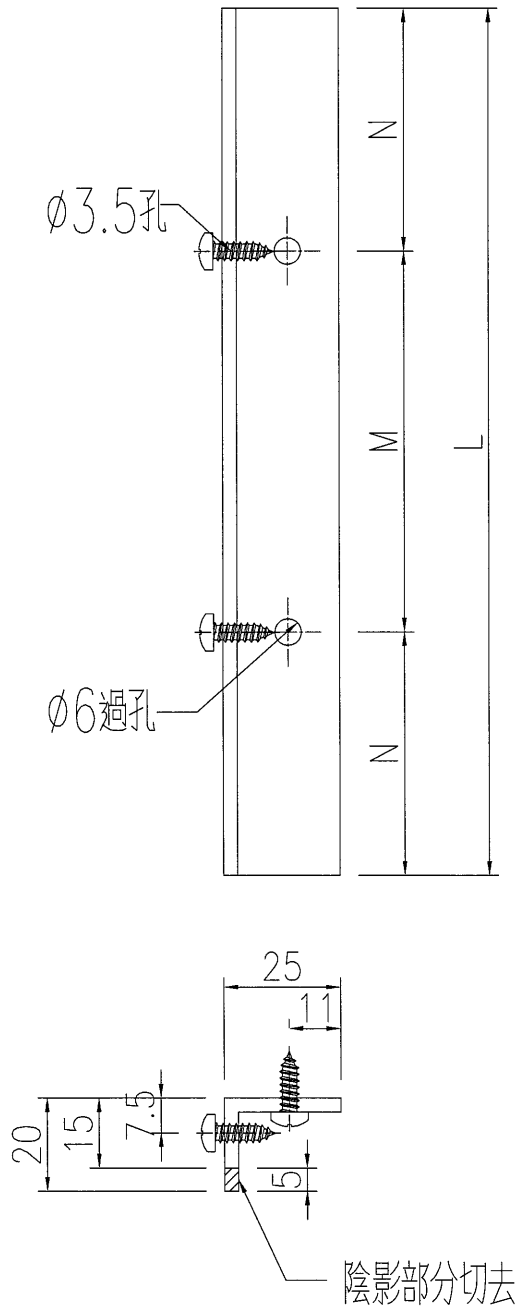

名稱	鋁角加工圖	制圖	劉寶平	2016-11-18	修改	A		
材料	25x20x3mm鋁角	復核			日期	16-12-21		
顏色	MILL	批准			圖號	J835-AB-04		

DATE/REVISION/AMENDMENTS
SUN HUNG KAI
ARCHITECTS AND ENGINEERS LTD.

SUN HUNG KAI CENTRE, WANGCHAI, HONGKONG
TEL. 28278111
YEE FAI CONTRACTORS CO. LTD.
44/F SUN HUNG KAI CENTRE, WANGCHAI, HONGKONG
TEL. 28278111 FAX. 28279717

美特知實有限公司
MEI TAI CHI SANG ARCHITECTS
Unit 603, 6/F, Sun Hung Kai Centre
91D Chee Kwo Ling Road, Kowloon
Tel: 23489211-4 Fax: (852) 7778086




This drawing and design are copyright of the submitted firm. No part of this drawing or design may be reproduced, stored in a retrieval system, or transmitted in any form or by any means, electronic, mechanical, photocopying, recording, or otherwise, without the prior written permission of the submitting firm. Use without permission, reproduction or alteration in any form or by any means, without the prior written permission of the submitting firm, is strictly prohibited. In case of any dispute, the contractor shall be responsible for the completion and satisfaction of the contract.

PROJECT
PROPOSED RESIDENTIAL
DEVELOPMENT AT
TSEUNG KWAN O
AREA 6802, T.K.O.I.L. 118

TITLE
ELEVATION, PLAN
AND SECTION

FILE NAME	
DRAWN BY	
CHECKED BY	
PRINTED DATE	
SCALE	1:10
JOB NO.	J-335
DRAWING NO.	J835-PT-301
REV.	A
R.S.E.	

Liam Kwok Leung
Senior Project Architect
FOR B.D. APPROVAL

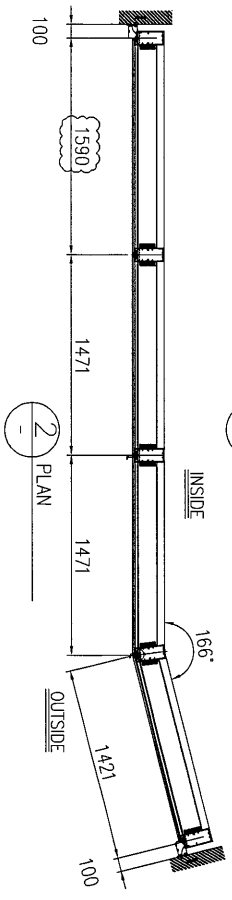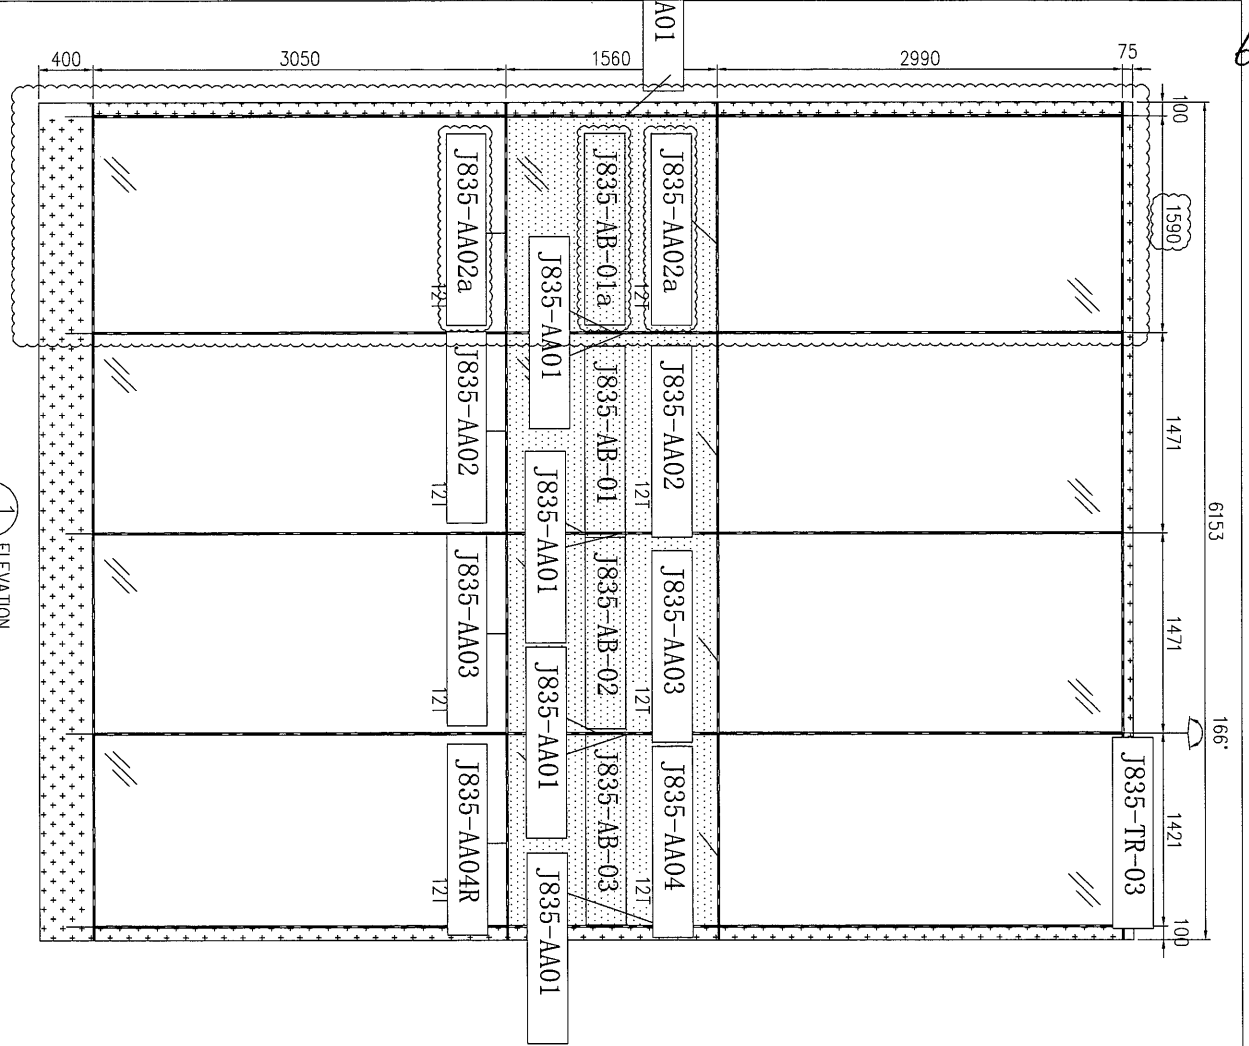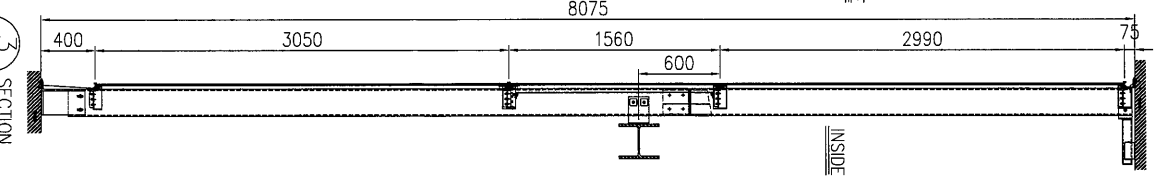

LEGEND:

- 12mm THK. CLEAR TEMPERED GLASS
- 12mm THK. CLEAR TEMPERED GLASS + ALUM. BACK PANEL