



工程指示 / 要求簡箋(E.I.)

工程指示編號：EI - 8225/17 修改版次：
 工程編號：J835 工程名稱：TK066D 平台
 工程項目：升降機大堂頂修口鐵米曹
 收件人：羅小姐 發件人：Eddie Johnny 日期：2017-9-07

要求提供 / 確認 事項：

- | | | |
|--|-------------------------------------|-------------------------------|
| <input type="checkbox"/> 初步鋁料 B.M. | <input type="checkbox"/> 加工拆圖，然後生產 | <input type="checkbox"/> 尺寸表 |
| <input type="checkbox"/> 正式鋁料 B.M. | <input type="checkbox"/> 技術上資料 / 指示 | <input type="checkbox"/> 報價 |
| <input type="checkbox"/> 配件 B.M. | <input type="checkbox"/> 樣辦或貨品說明書 | <input type="checkbox"/> 分判合約 |
| <input checked="" type="checkbox"/> 其他：_____ | | |

(急)

內容：

- ① 150 x 21 x 5mm thk GMS Angle x 55支 (340mm=L)
- ② 25 x 25 x 3mm thk GMS x 55支 (340mm=L)

請在 2017-9-14 前完成上列要求。

附有關圖紙 / 文件：

1 + 2頁

以上項目為：

- 原合約工程包 原合約工程加 / 減賬 新工程報價

原因：-

分發東莞各部門：

- () 生產技術總監 連附件 () 技術部 連附件 () 生產部 連附件 () 機械設計部 連附件
 () 採購部 連附件 () 生產統籌部 連附件
 () 質檢部 連附件 () 會計部 連附件 () 報關組 連附件 () 其他 _____ 連附件

分發香港各部門：

- () 行政部 連附件 () 會計部 連附件 () 統籌部 連附件 () 工程部地盤科文 連附件
 () 採購部 連附件 () QS 部 連附件 () 維修部 連附件 () 其他 _____ 連附件

傳遞編號：


HK

(FTP)

發件人簽署：

項目經理簽署：


GL-01

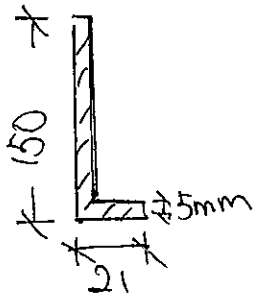

$$L = 340 \text{ mm} \times 55 \text{ 支}$$

150 x 21 x 5mm thk GMS Angle x 55 支

GL-01a


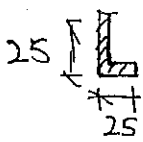


$$L = 340 \text{ mm} \times 55 \text{ 支}$$

25 x 25 x 3mm thk GMS Angle x 55 支

2017.04.01

A1H

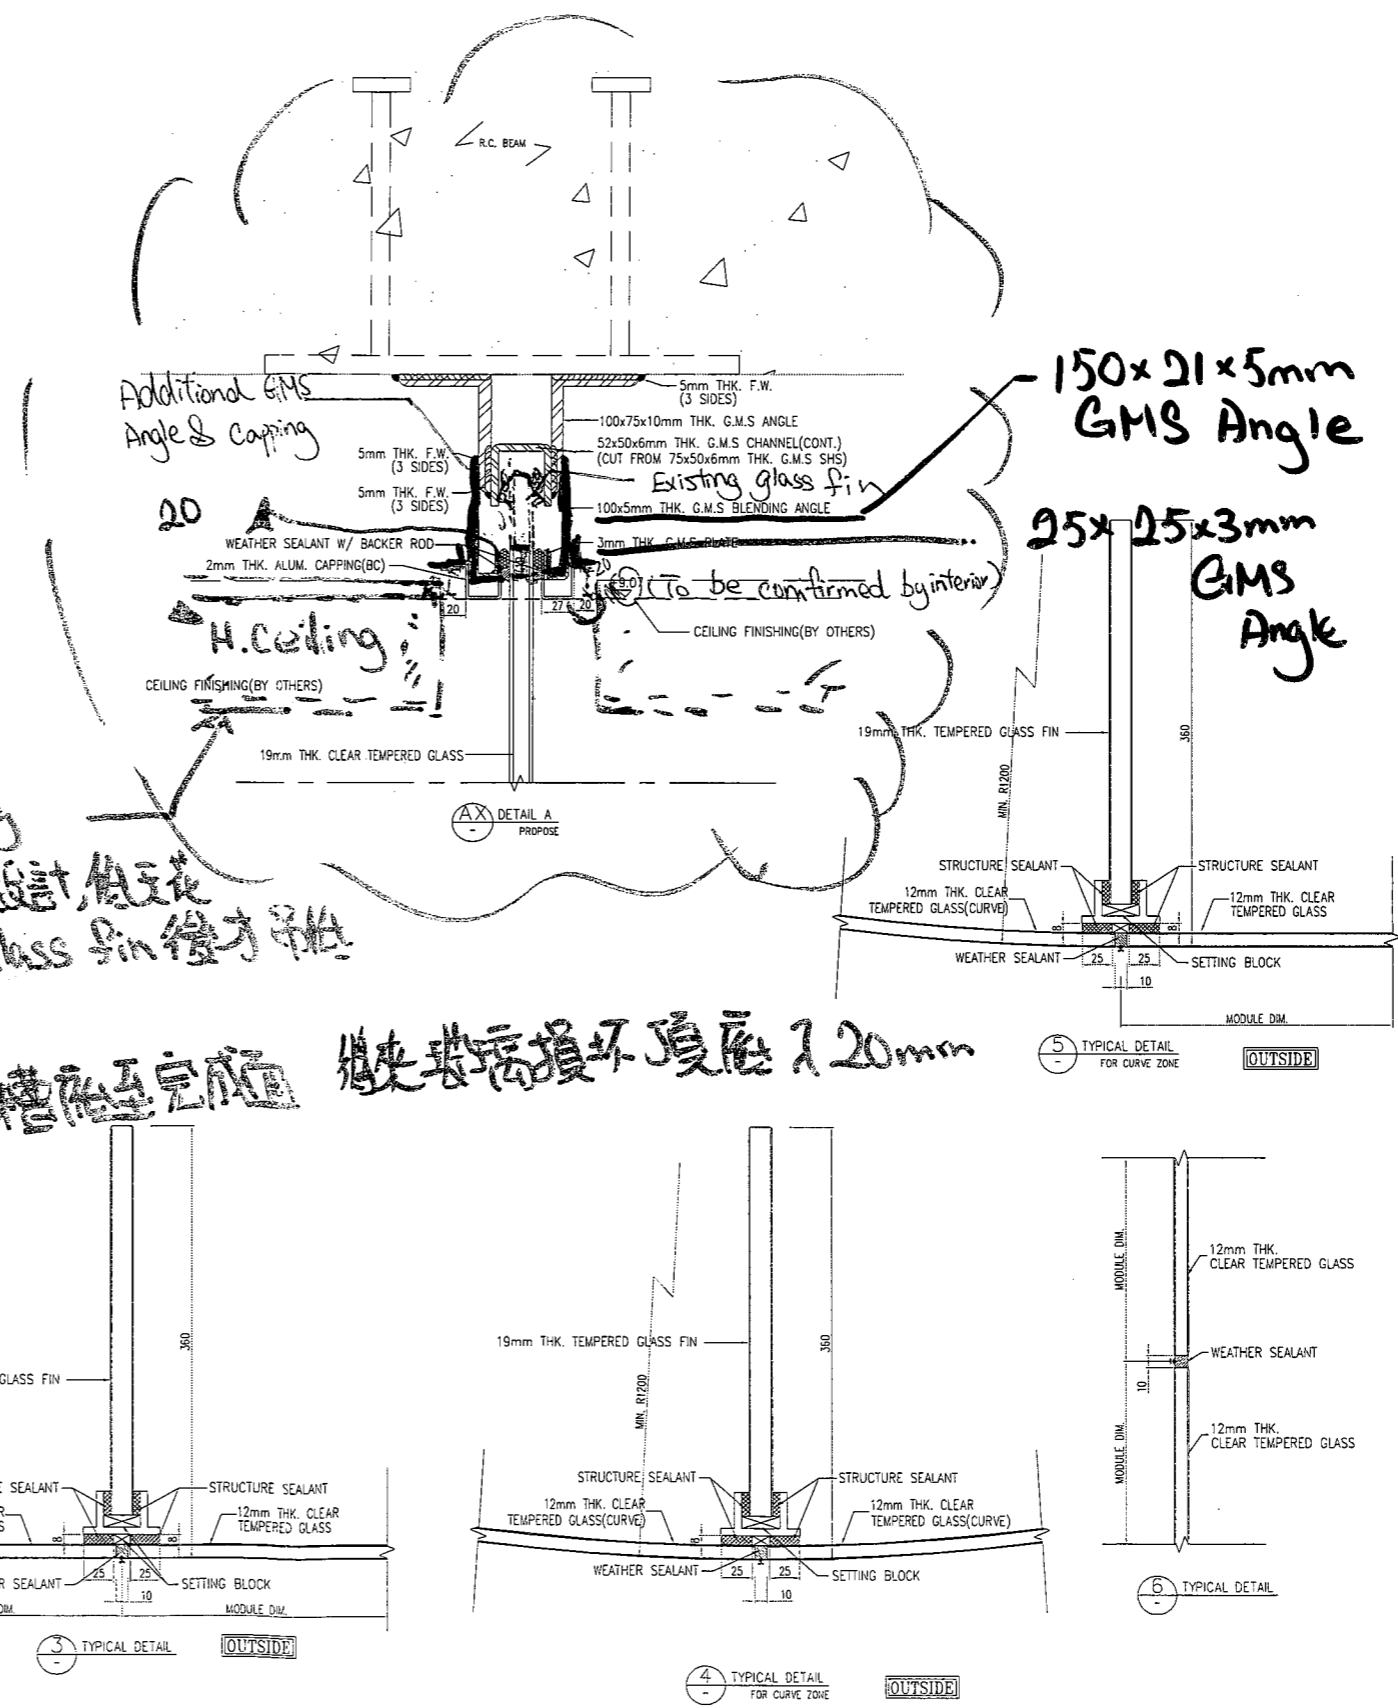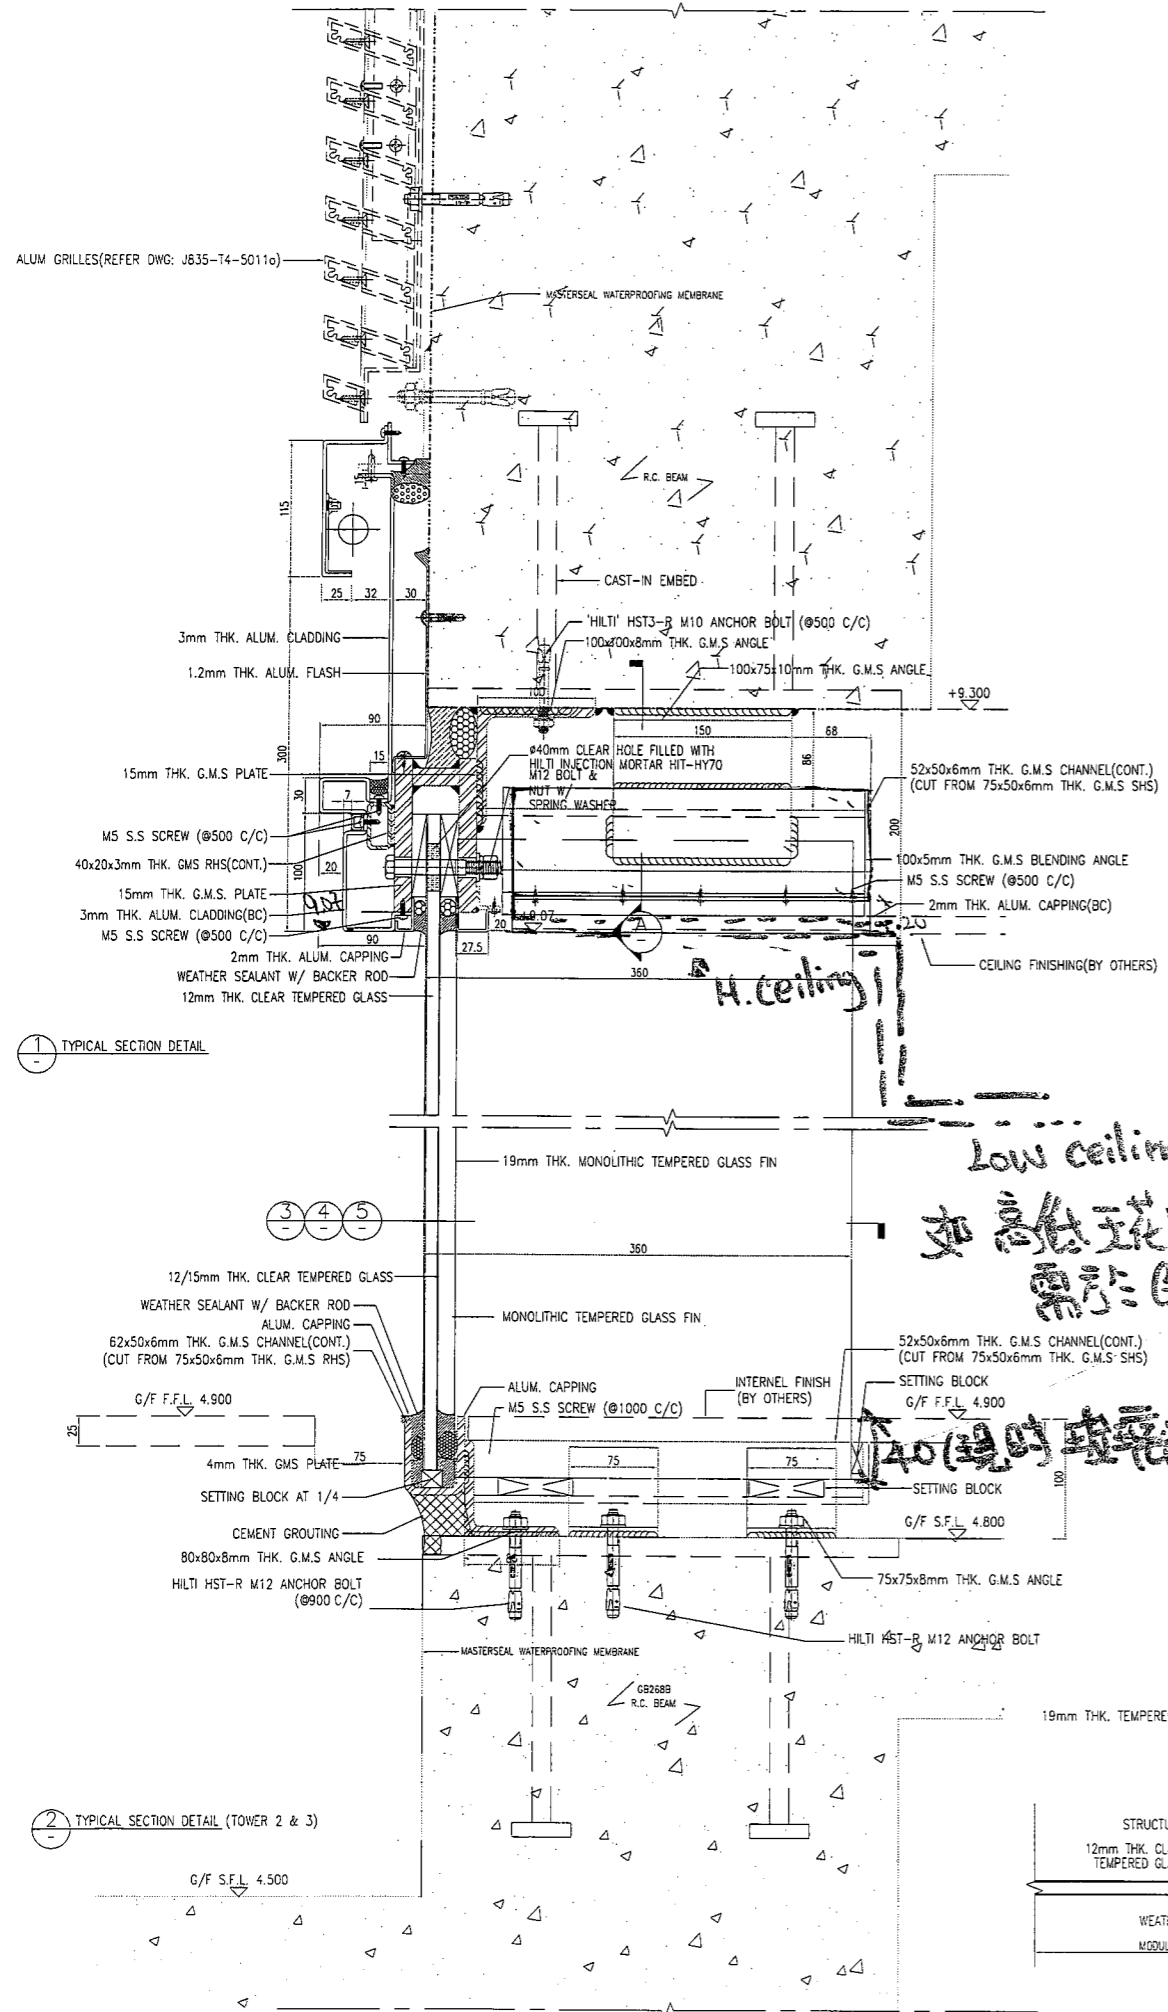

Low ceiling
如高樓天花設計做天花
需於 Glass fin 後才安裝

140 (現時的玻璃牆底至完成面)
樓上玻璃損壞 殘餘 20mm

| | | |
|---|--------------------|------|
| B.D. Ref. | | |
| F.P.B. Ref. | | |
| 21/11/16 | A GENERAL REVISION | |
| 21/01/17 | B GENERAL REVISION | |
| 27/03/17 | C GENERAL REVISION | |
| DATE/REVISION/AMENDMENTS | | |
| SUN HUNG KAI ARCHITECTS AND ENGINEERS LTD. | | |
| SUN HUNG KAI CENTRE, WANCHAI, HONGKONG TEL. 28278111 FAX. 28272884 | | |
| YEE FAI CONTRACTORS CO. LTD. | | |
| 44/F SUN HUNG KAI CENTRE, WANCHAI, HONGKONG TEL. 28278111 FAX. 28270717 | | |
| 美特鋁質有限公司 MIDI ALUMINIUM FABRICATOR LTD. | | |
| Units 6-8, Sunray Industrial Centre, 1/F 610 Cha Kwo Ling Road, Kowloon Tel: 23489211-4 Fax: (852)2727666 | | |
| This drawing and design are copyright of the authorized person. No portion may be reproduced without his written permission. Use written dimensions. Measurements to existing works to be verified on site. This drawing shall be read in conjunction with specification and condition of contract. | | |
| PROJECT PROPOSED RESIDENTIAL DEVELOPMENT AT TSEUNG KWAN O AREA 66D2, T.K.O.T.L. 118 | | |
| TITLE TYPICAL DETAILS OF GLASS WALL | | |
| FILE NAME | | |
| DRAWN BY | | |
| CHECKED BY | | |
| PRINTED DATE | | |
| SCALE | | |
| JOB No. | DRAWING No. | REV. |
| J-835 | J835-GW-DT07 | C |
| R.S.E. | | |
| FOR B.D. APPROVAL | | |