

工程指示 / 要求簡箋(E.I.)

工程指示編號：EI/ 0237 /19

修改版次：

工程編號：J836

工程名稱：日出康城7期(平台)

工程項目：WW1 新增角鐵生產

收件人：Maggie Lor

發件人：Joe Chan

日期：20/2/2019

要求提供 /  確認 事項：

- 初步鋁料 B.M.
- 加工拆圖，然後生產
- 尺寸表
- 正式鋁料 B.M.
- 技術上資料 / 指示
- 報價
- 配件 B.M.
- 樣辦或貨品說明書
- 分判合約
- 其他：\_\_\_\_\_

內容：請依附件資料生產鉄件，完成生產後送地盤。  
(新增角鐵)

請在 15/3/2019 前完成上列要求。

附有關圖紙 / 文件：

6 頁

以上項目為：

- 原合約工程包
- 原合約工程加 / 減賬
- 新工程報價

原因：-

分發東莞各部門：

- 生產技術總監  連附件
- 技術部  連附件
- 生產部  連附件
- 機械設計部  連附件
- 採購部  連附件
- 生產統籌部  連附件
- 質檢部  連附件
- 會計部  連附件
- 報關組  連附件
- 其他 \_\_\_\_\_  連附件

分發香港各部門：

- 行政部  連附件
- 會計部  連附件
- 統籌部  連附件
- 工程部地盤科文  連附件
- 採購部  連附件
- QS 部  連附件
- 維修部  連附件
- 其他 \_\_\_\_\_  連附件


積哥

傳遞編號：

發件人簽署：

項目經理簽署：

1

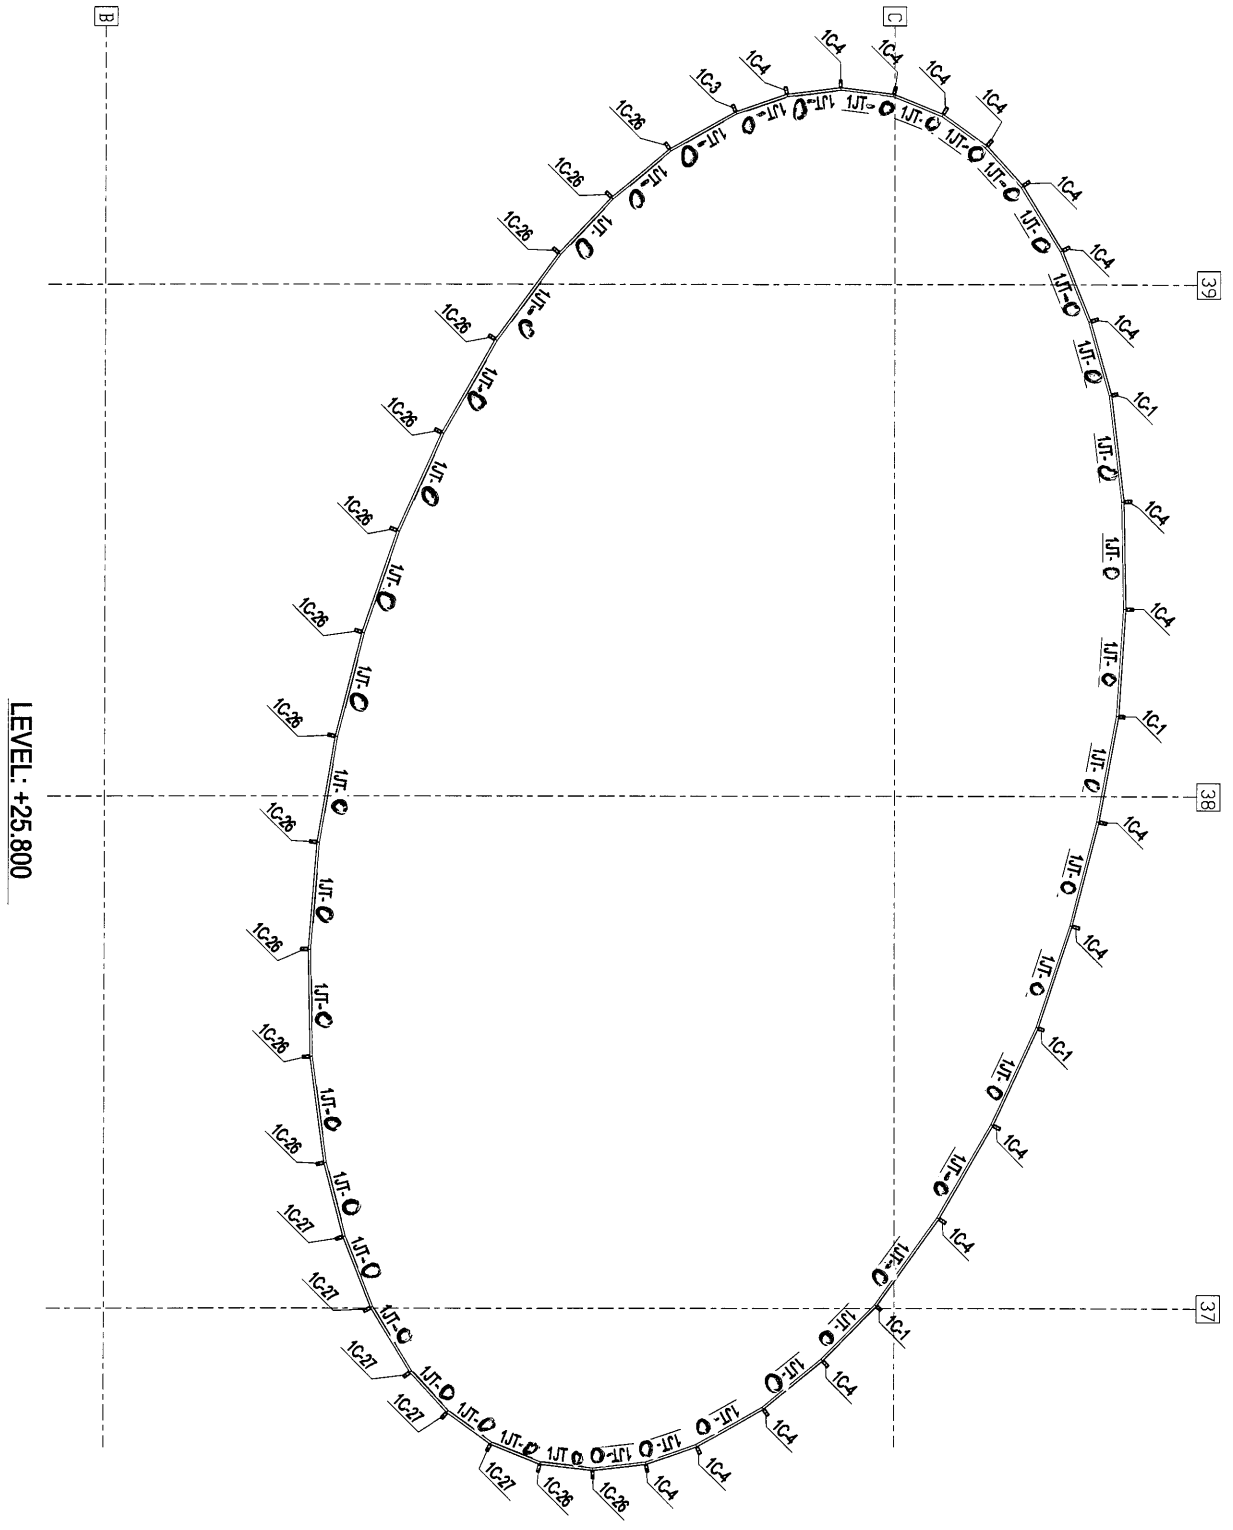

LEVEL: +25.800

Rev.	Description	Date
0	第一次报批	2019-02-14

PROJECT:  
 PROPOSED SITE C1  
 DEVELOPMENT AT AREA 86,  
 TKO1 TO RP TSEUNG KWAN O,  
 NEW TERRITORIES

CLIENT:  
**美特鋸實有限公司**  
**MIDI** AMONGY ZAMBAKOR LTD.  
 Units 6-8, Sunray Industrial Centre, 1/F  
 510 Che Kwo Ling Road, Kowloon  
 Tel: 23489211-4 Fax: (852) 27277656  
**銀同有限公司**  
**Silver Town Limited**  
 Tel: 0769-8335498 Fax: 0769-8335954  
 E-MAIL: ADDRESS@SILVERTOWN.COM


**MARKING PLAN**  
 (新增角鉄)

CAO File Name :

Designed by	
Drawn by	
Reviewed by	
Approved by	
Scale	

DMG.NO.: WM1 - MP10

REV	0
-----	---

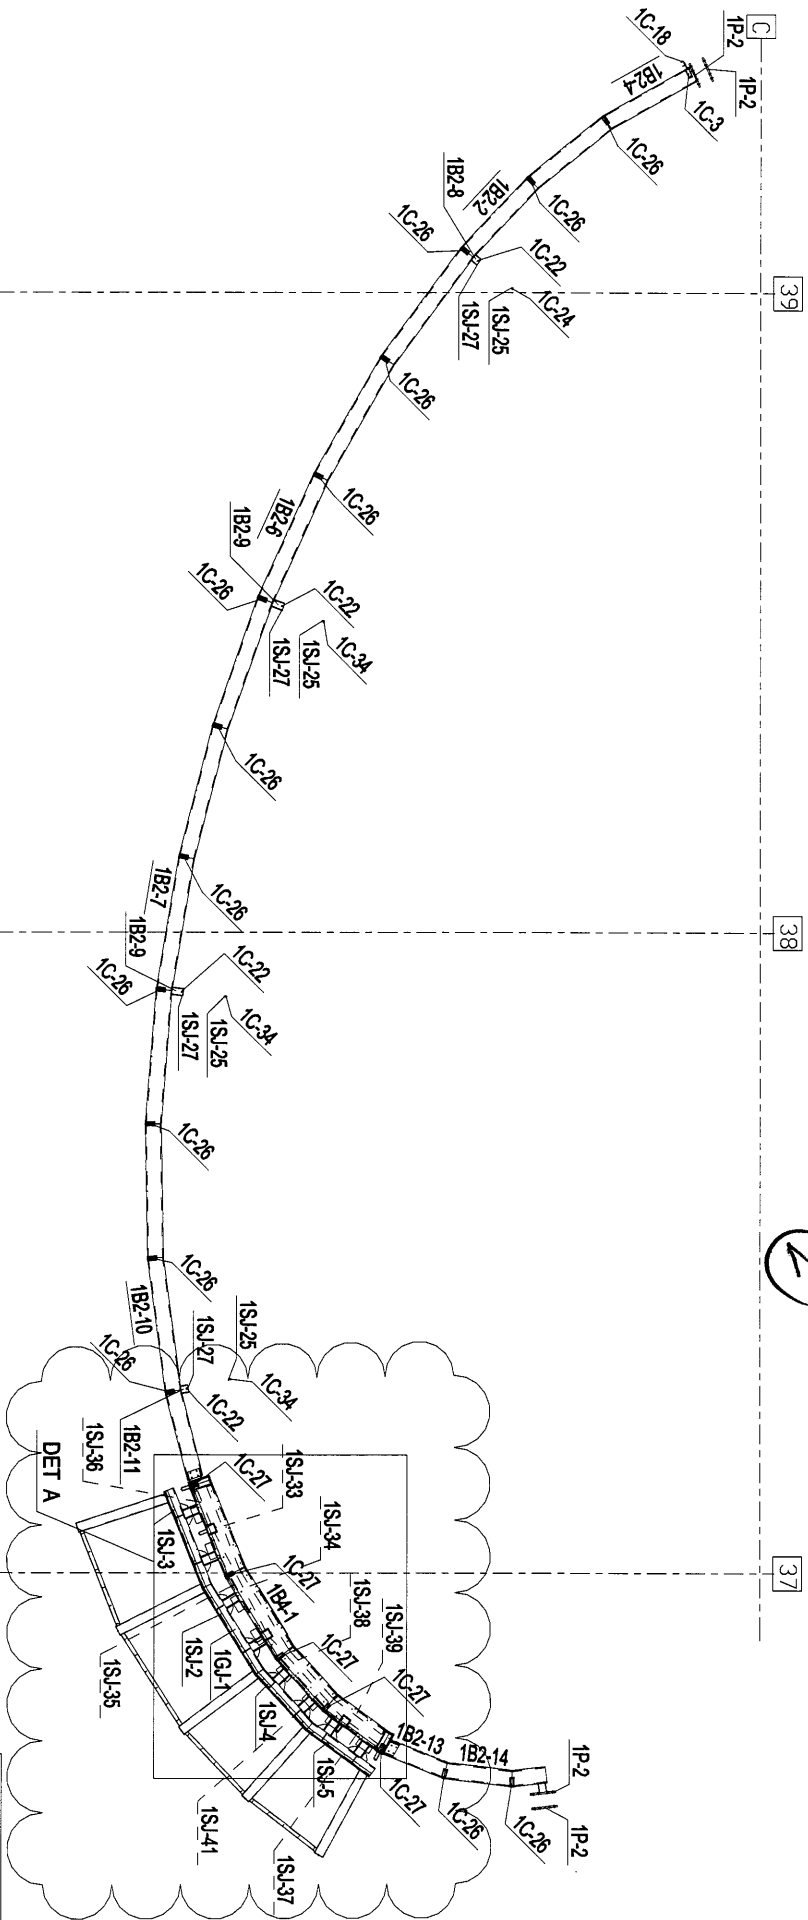

LEVEL: +21.780

C - C

说明:

- 1, 1SJ-35和1SJ-40合并为1SJ-35。
- 2, 1SJ-41, 1SJ-42, 1SJ-43合并为1SJ-41。

Rev.	Description	Date
C	第4次报批	2019-02-19


PROJECT:  
**PROPOSED SITE C1  
 DEVELOPMENT AT AREA 88,  
 TSOI TO PEI TSEUNG KWAN O,  
 NEW TERRORIES**

CLIENT:  
**美特經貿有限公司**  
**MIDI** AMERICA YAMAGUCHI LTD.  
 Units 6-8, Sunny Industrial Centre, 1/F  
 610 Chu Kwo Ling Road, Kowloon  
 Tel: (853) 892111-4 Fax: (853) 27277666

DRAWING TITLE:  
**MARKING PLAN**

CAD File Name:	
Designed by	
Drawn by	
Reviewed by	
Approved by	
Scale	
DWG NO.: WM1	REV C
	MP05

3

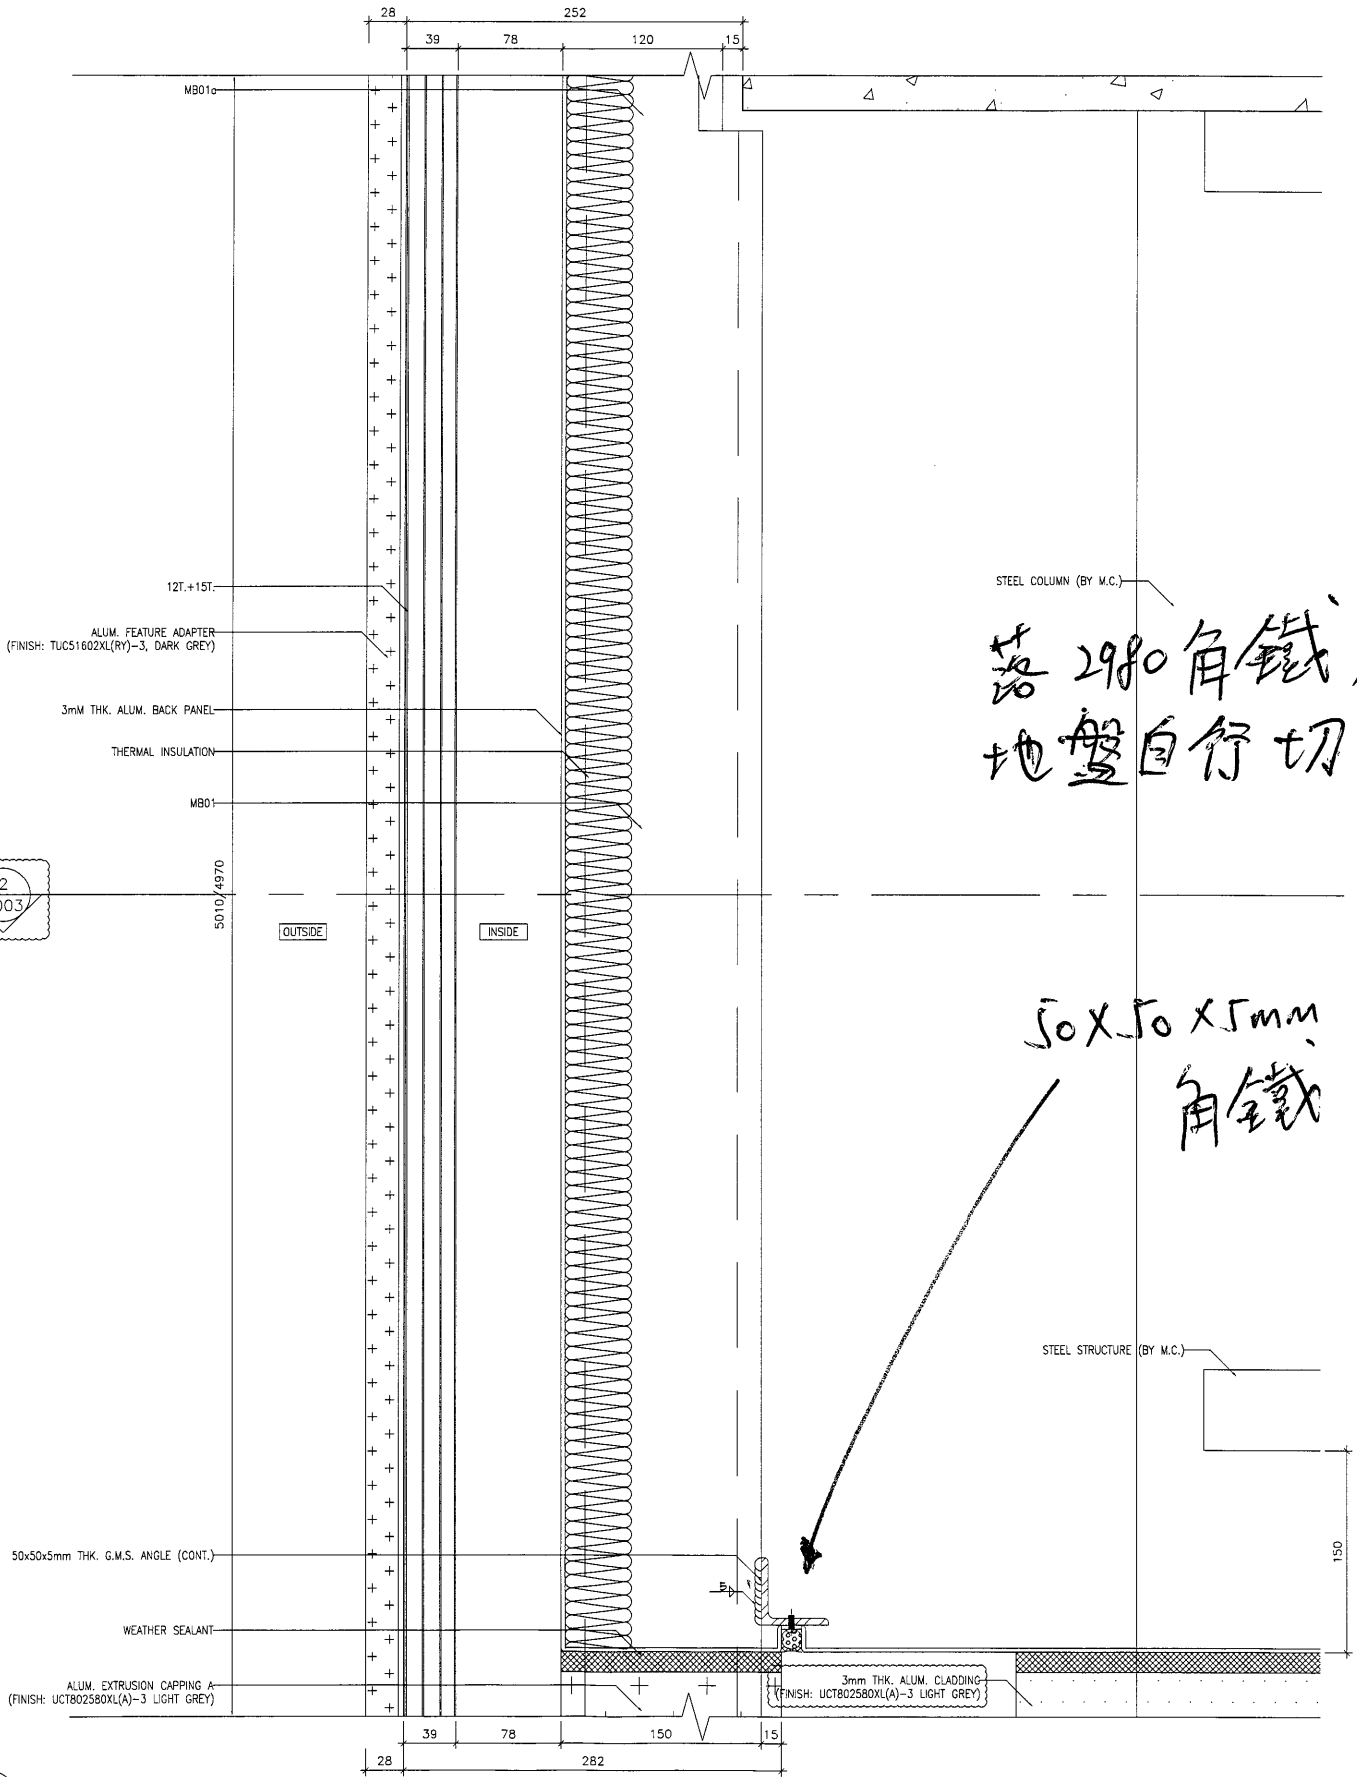

落 2980 角鐵 15 枝  
 地盤自行切割


50x50x5mm  
 角鐵

2  
 5003

④

50 X 50 X 5 mm 角鐵

每枝 2980 長 15 枝。

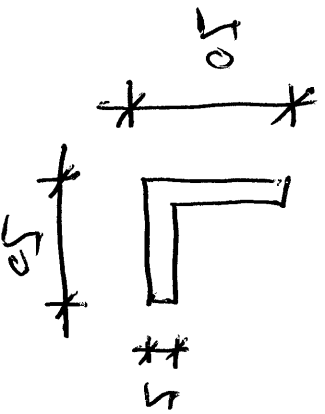


(編號: 1JT-0)



地盤自行切割所需長度。




6

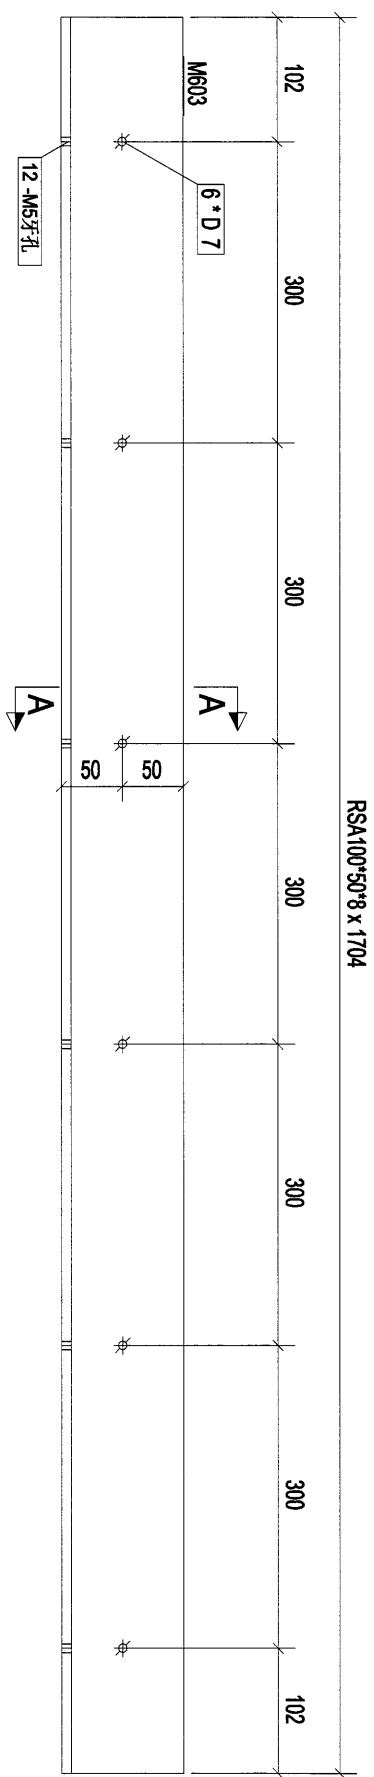

构件: 1SJ-41

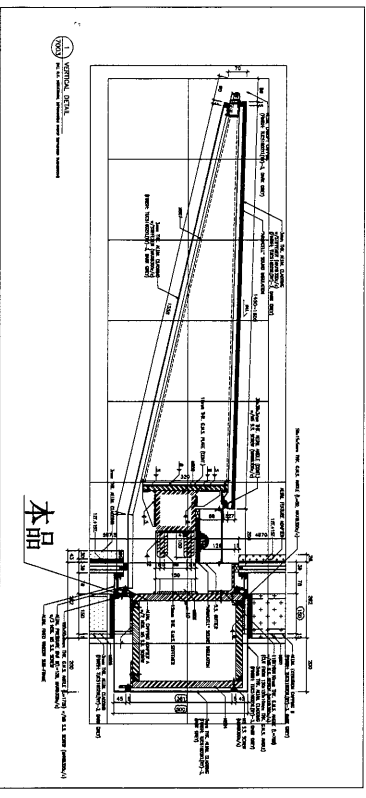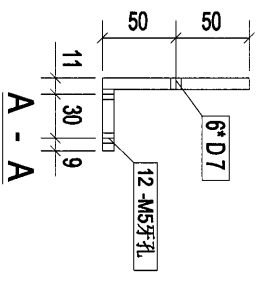

构件编号:	1SJ-41	构件数量:	1	构件重量:	15.20
部件编号	规格(mm)	长度(mm)	数量	单重(kg)	共重(kg)
M603	RSA100*50*8	1704	1	15.20	15.20
合计:				15.20	0.51

Rev.	A	第2次报批	2019-02-18
PROJECT:	PROPOSED SITE C1 DEVELOPMENT AT AREA 86 TKOJI ZOI RP TSEUNG KWAN O, NEW TERRITORIES		
CLIENT:	 <b>美特铝质有限公司</b> MID I Aluminium Fabricator Ltd. Units 6-8, Sunny Industrial Centre, 1/F 610 Cho Kwo Ling Road, Kowloon Tel: 23489211-4 Fax: 0527777686		
[1SJ-41]			
Designed by			
Drawn by			
Reviewed by			
Approved by			
Scale			
DMGNO:	WN1	-	[1SJ-41]
REV	A		