

工程指示 / 要求簡箋(E.I.)

工程指示編號：EI/ 0331/19

修改版次：A

工程編號：J836

工程名稱：日出康城7期(平台)

工程項目：E5, E6, E7 鐵件生產修改

收件人：Maggie Lor

發件人：Joe Chan

日期：27/3/2019

要求提供 / 確認 事項：

- () 初步鋁料 B.M.
- () 加工拆圖，然後生產
- () 尺寸表
- () 正式鋁料 B.M.
- () 技術上資料 / 指示
- () 報價
- () 配件 B.M.
- () 樣辦或貨品說明書
- () 分判合約
- () 其他：_____

內容：請依附件資料，修改鐵通長度。
 - 另新增 18 條角鐵。

請在 15/4/2019 前完成上列要求。

附有關圖紙 / 文件：

14 頁

以上項目為：

- 原合約工程包
- 原合約工程加 / 減賬
- 新工程報價

原因：-

分發東莞各部門：

- () 生產技術總監 連附件 () 技術部 連附件 () 生產部 連附件 () 機械設計部 連附件
- () 採購部 連附件 () 生產統籌部 連附件
- () 質檢部 連附件 () 會計部 連附件 () 報關組 連附件 () 其他 _____ 連附件

分發香港各部門：

- () 行政部 連附件 () 會計部 連附件 () 統籌部 連附件 () 工程部地盤科文 連附件
- () 採購部 連附件 () QS 部 連附件 () 維修部 連附件 () 其他 _____ 連附件


積哥

傳遞編號：




發件人簽署：

項目經理簽署：

构件编号	规格(mm)	长度(mm)	数量	重量(kg)	共重(kg)	表面积(m ²)
M1079	RHS150*100*12.5	3823	1	163.86	163.86	1.79
M1175	PL16*250.2	400	1	12.57	12.57	0.22
合计:			176.42			

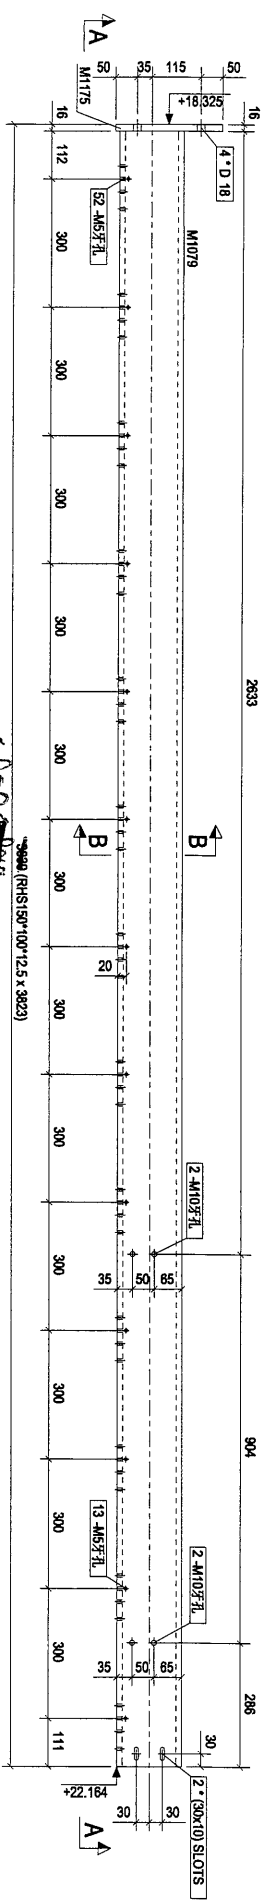

488 构件: 5C-2

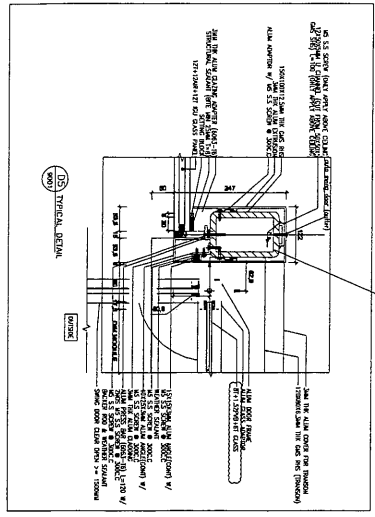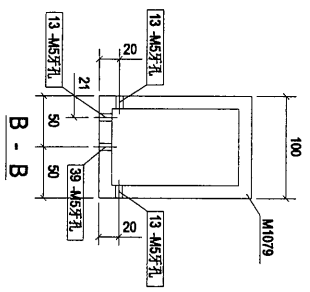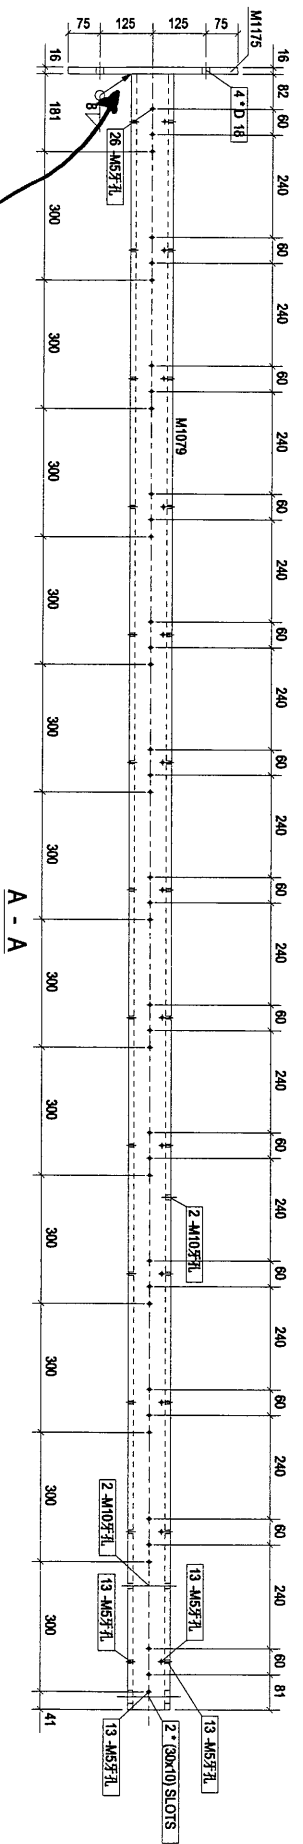


本品

敬出


Rev	0	第1次报批	2019-03-14
PROJECT	PROPOSED SITE C1 DEVELOPMENT AT AREA 06, TKOIL 70 RP, TSEUNG KWAN O, NEW TERRITORIES		
CLIENT	美特鋁質有限公司 MIDAL Aluminium Fabricator Ltd. Unit 5-8 Sunny Hill Industrial Estate, 1/F 510 Chee Kwoi Road, Kowloon Tel: 23469211-4 Fax: (852) 27272686		
DESIGNED BY	美特鋁質有限公司		
DRAWN BY	美特鋁質有限公司		
APPROVED BY	美特鋁質有限公司		
SCALE	1:1		
DWG NO.	E5 - [5C-2]		
REV	0		

2930
2465



构件编号	规格	数量	单重(kg)	共重(kg)	表面积(m ²)
M1081	RHS150*100*12.5	1	163.86	163.86	1.79
M1175	PL16*250	1	12.56	12.56	0.22
合计:				176.42	

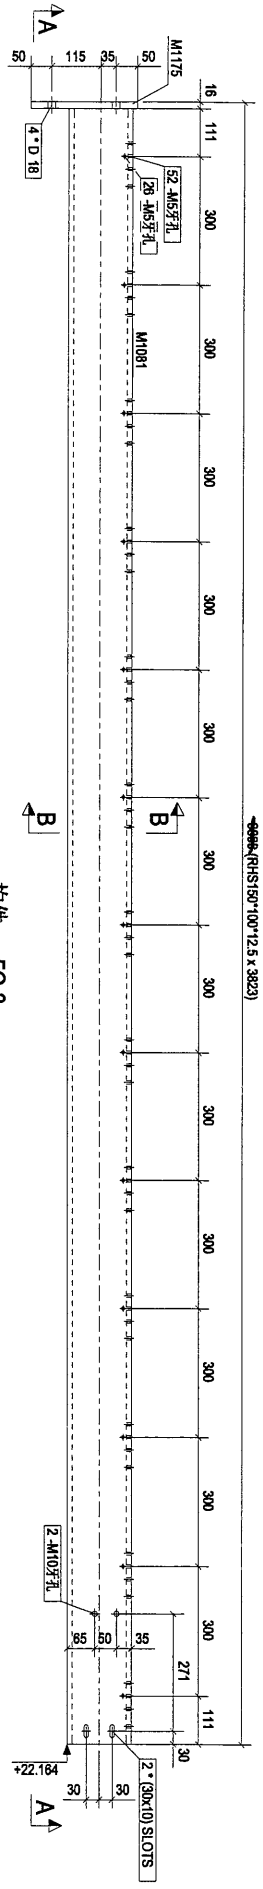

构件: 5C-3

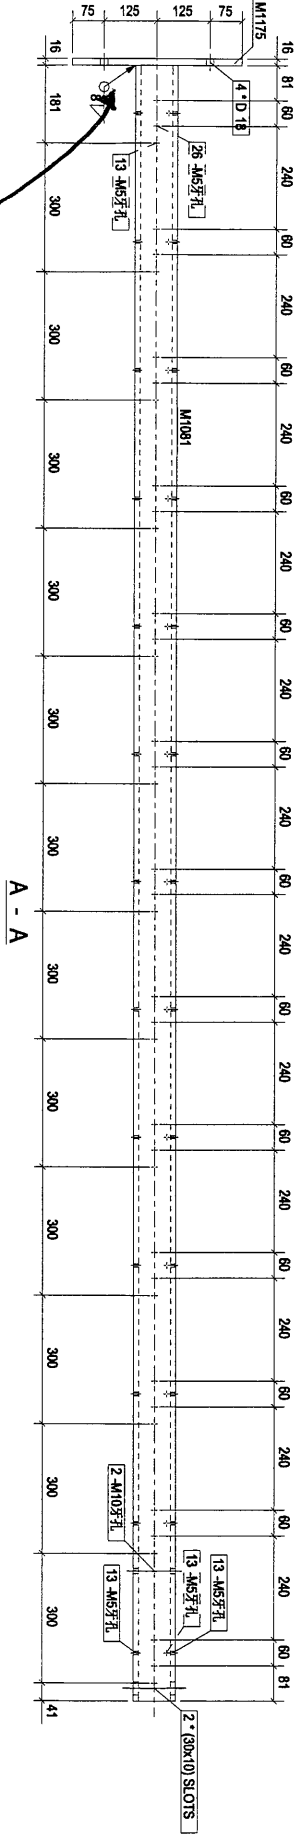


散出

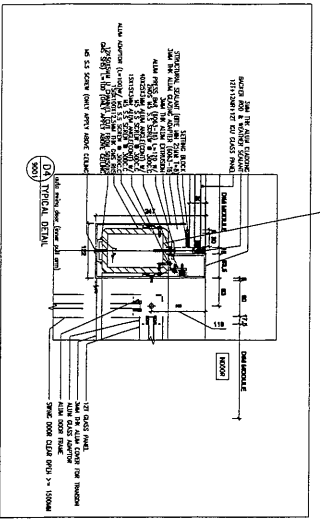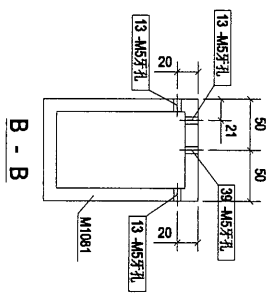


本品

Rev	0	第一次报批	2019-03-14
PROJECT	PROPOSED SITE C1 DEVELOPMENT AT AGEN 88 KOU TO RP, TSEUNG KWAN O, NEW TERRITORIES		
CLIENT	美特銀質有限公司 MIDI Automation / Robotic Ltd. Units 5-8 Sunning Industrial Estate 510 Chee Kwoi Road, Kowloon Tel: 23489211-4 Fax: (852) 27272686		
Designed by	[5C-3]		
Drawn by			
Reviewed by			
Approved by			
Scale			
DWG NO:	E5	-	[5C-3]
REV	0		


4

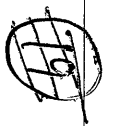

零件编号	规格(mm)	长度(mm)	数量	单重(kg)	共重(kg)	表面积(m ²)
M1085	RHS150*100*12.5	3823	1	163.86	163.86	1.79
M1175	PL16250.1	400	1	12.56	12.56	0.22
合计:				176.42		


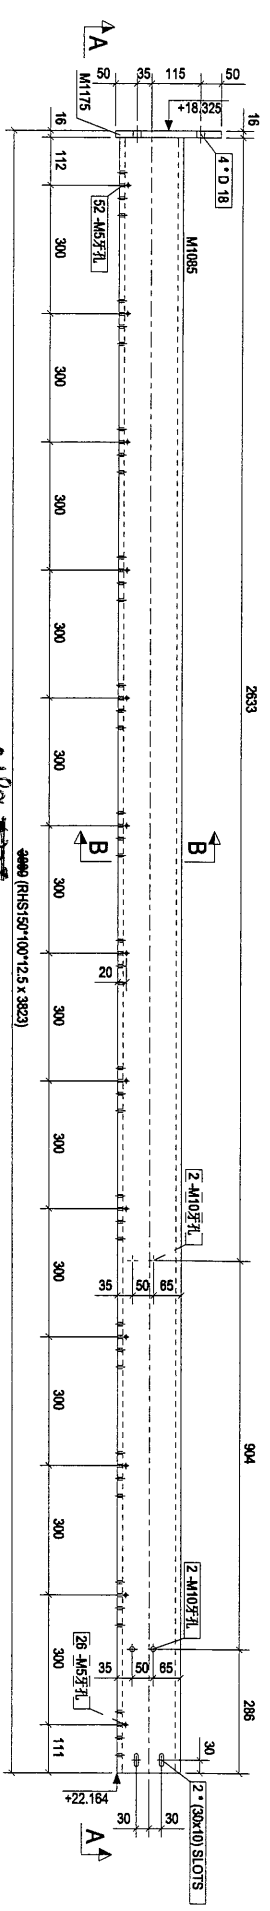


4189
构件: 5C-4

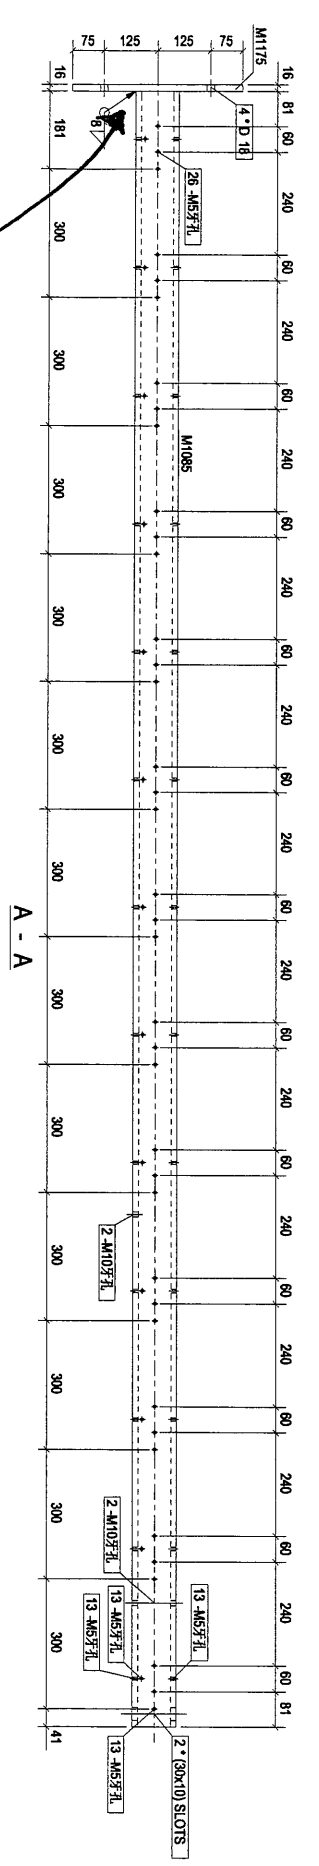

撤出

本品



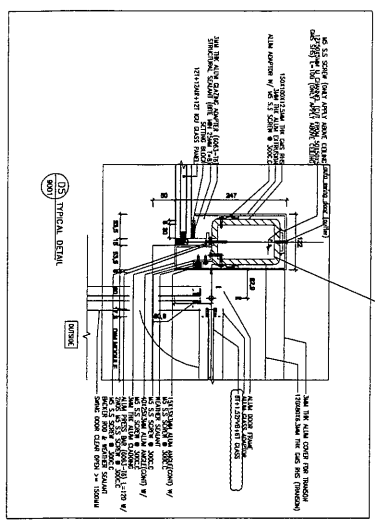
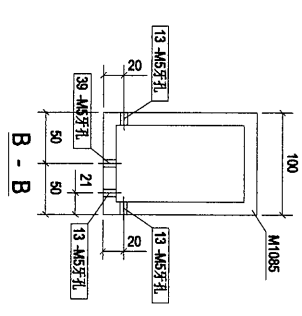


Rev	0	第一次设计	2019-03-14
Project	PROPOSED SITE C1 DEVELOPMENT AT AREA 68, KOTU, T/0/P/ TSEUNG KWAN O, NEW TERRITORIES		
Client	美特鋸質有限公司 MIDAL Construction Products Ltd. Unit 6-8, Sanyang Industrial Centre, 1/F 810 Chee Kwoi Road, Kwai Tsing, 1/F Tel: 23489211-4 Fax: (852) 27272666		
Designer	陈守富有限公司 CHEN SHOU FU LIMITED		
Scale	[5C-4]		
DWG NO.	E5		[5C-4]
REV			0


3943
~~277~~

 6

RHS150*100*12.5 x 9999

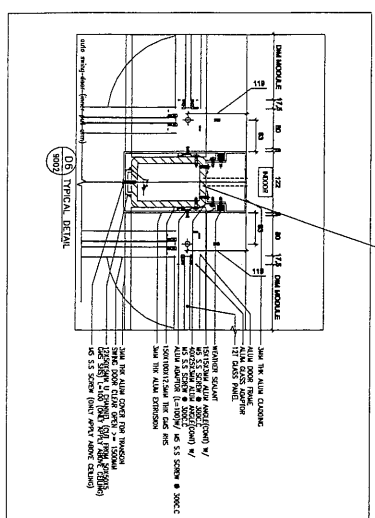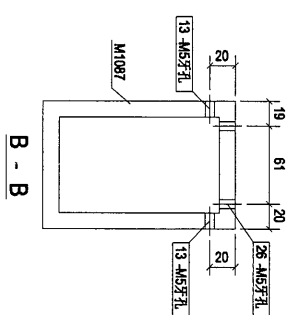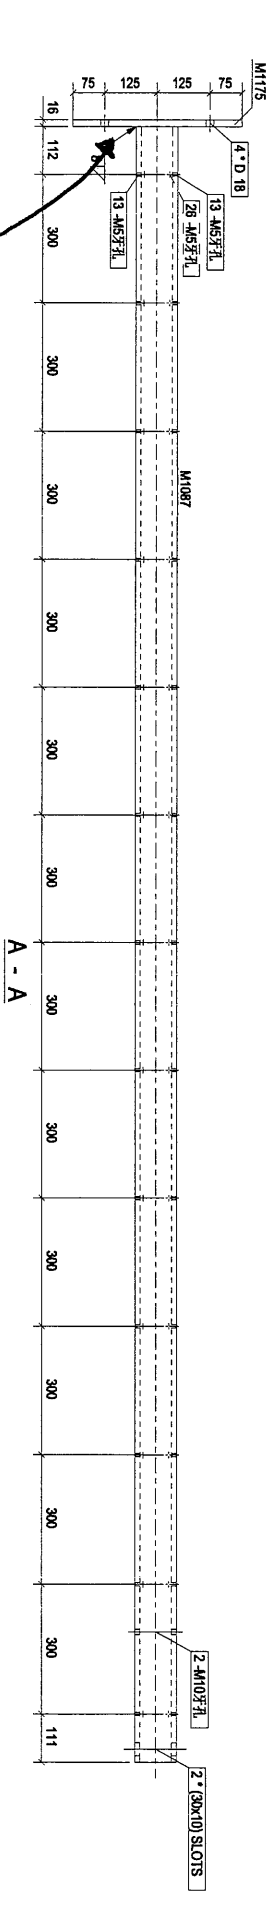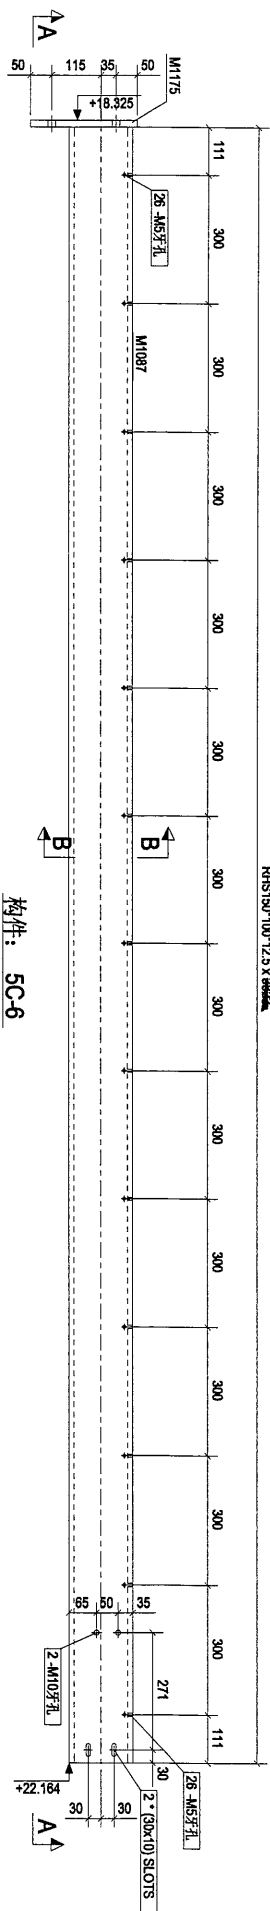


构件编号	规格(mm)	长度(mm)	数量	单重(kg)	共重(kg)	表面积(m ²)
M1087	RHS150*100*12.5	3823	1	163.86	163.86	1.79
M1175	PL16*250	400	1	12.56	12.56	0.22
合计:					176.42	


Rev: 0	第一次提批	Date: 2019-03-14
PROJECT: PROPOSED SITE C1 DEVELOPMENT AT PANGSAH, KOTLITOPU, ISERONG NIMANO, NEW TERRITORIES		
CLIENT: 華特鋁質有限公司 MIDT Technology Resource Ltd. Units E-4, Sunny Industrial Centre 1/7, 510 Chee Koo Ling Road, Kowloon. Tel: 23489211-4 Fax: (852) 27272565		
 東河有限公司 Sunway Industrial Centre		
[5C-6]		
Designed by		
Drawn by		
Reviewed by		
Approved by		
Scale		
DWG NO: E5	- [5C-6]	REV: 0

构件编号	规格(mm)	长度(mm)	数量	单重(kg)	共重(kg)	表面积(m ²)
M1072	RHS150*100*12.5	3948	1	169.22	169.22	1.85
M1175	PL16*250	400	1	12.56	12.56	0.22
合计:					181.78	

4830
-8004 (RHS150*100*12.5 X 3948)

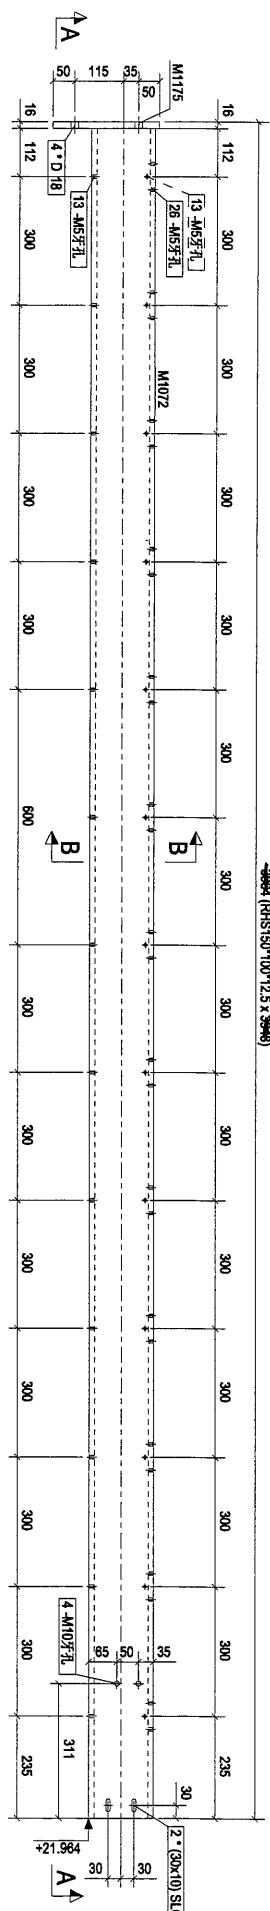


构件: 6C-2

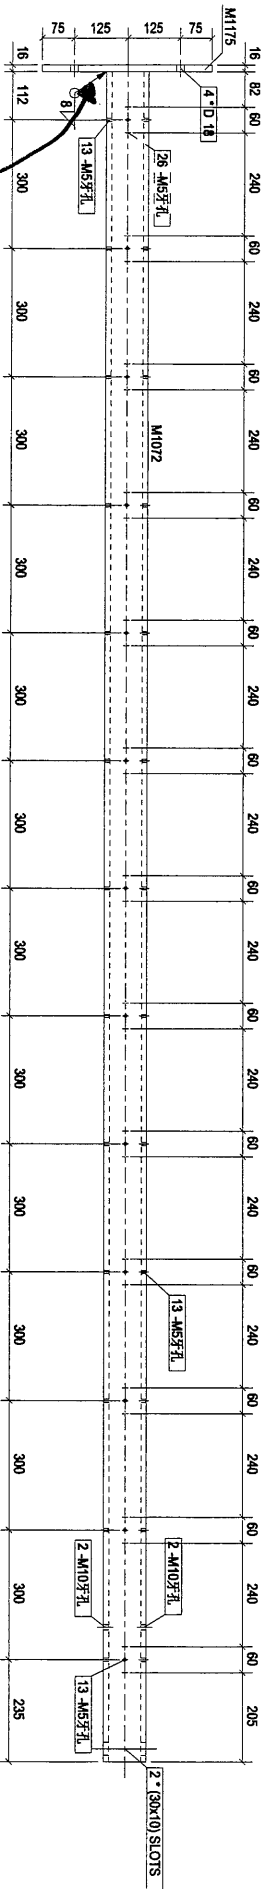


A - A

敬出

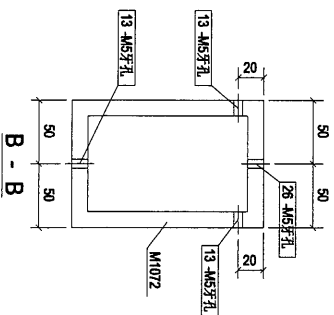


B - B

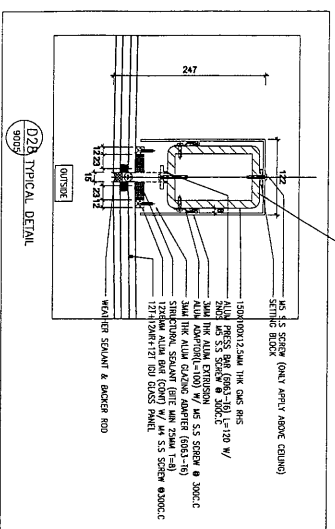

023 TYPICAL DETAIL

本品


1. 5.5 S.S. SCREW (ONLY APPLY ABOVE EQUINO)
2. 5.5 S.S. SCREW (ONLY APPLY ABOVE EQUINO)
3. 5.5 S.S. SCREW (ONLY APPLY ABOVE EQUINO)
0	第一次报批	2019-03-16
Rev.	Description	Date
PROJECT: PROPOSED SITE C1 DEVELOPMENT AT AREA 06, IKOIL TOWER, ISEUNG KWAN, NEW TERRITORIES		
CLIENT: 華特經貿有限公司 MIDI International Units 6-8, Sunny Industrial Centre, 1/F, 610 Chee Kwo Ling Road, Kowloon. Tel: 23489211-4 Fax: (852) 27272666		
 華特經貿有限公司 MIDI International 137-1377 UNIT 608		
[6C-2]		
Designed by		
Drawn by		
Reviewed by		
Approved by		
Scale		
DWG NO. E6	- [6C-2]	REV. 0


零件编号	规格(mm)	数量	单重(kg)	共重(kg)	表面积(m ²)
M1082	RHS150*100*12.5	3948	169.22	169.22	1.85
M1175	PL16*250	400	12.56	12.56	0.22
合计:				181.78	

4830

9904 (RHS150*100*12.5*3948)

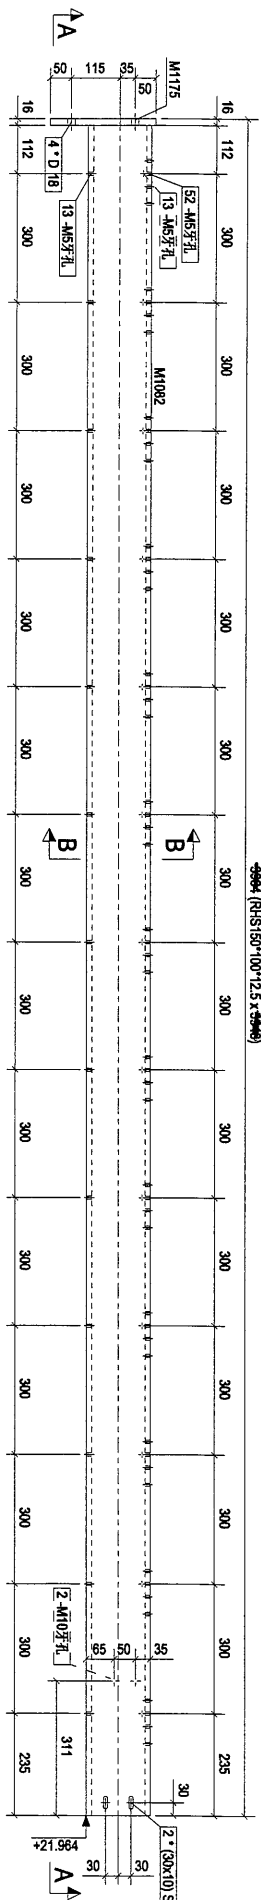


构件: 6C-5

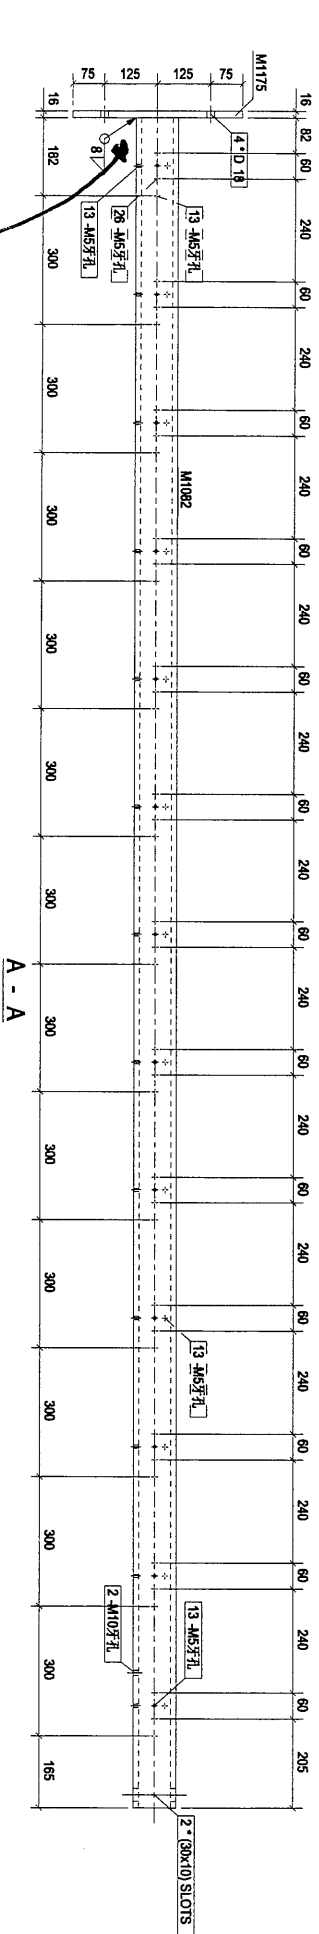


A - A

散出

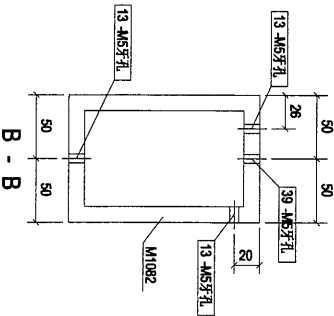


B - B

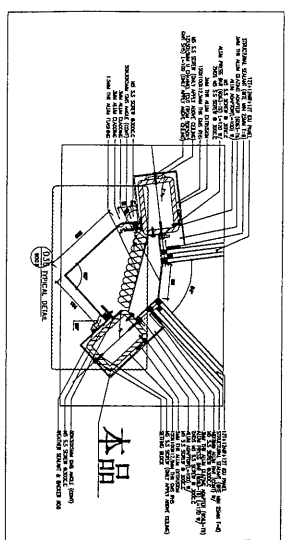

Rev.	Description	Date
0	第一次仕様	2019-03-16

PROJECT: PROPOSED SITE C1
DEVELOPMENT AT AREA 88,
TKOIL 70 RP TSEUNG KWAN O,
NEW TERRITORIES

CLIENT: 美特鋸質有限公司
MIDI AUTUMN PAPERWORKS LTD.
10/F, 5-18 Sunny Industrial Centre, 1/F
510 Canton Road, Kowloon, Hong Kong
Tel: 2389211-4 Fax: (852) 2727866

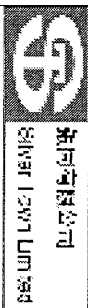

[6C-5]





Scale	Scale

DWG NO: E6 - [6C-5] 0

零件编号	规格(mm)	长度(mm)	数量	单重(kg)	共重(kg)	重量(m)
M1083	RHS150*100*12.5	3948	1	169.22	169.22	1.85
M1175	PL16*250	400	1	12.56	12.56	0.22
合计:				181.78		

4830

3948 (RHS150*100*12.5 x 3948)

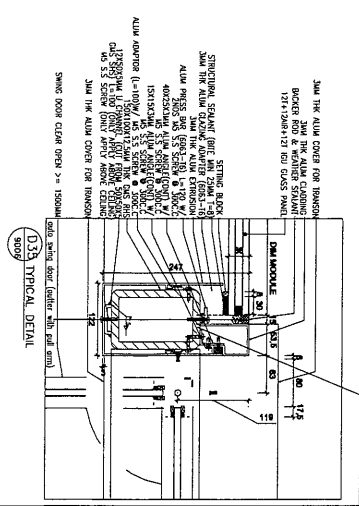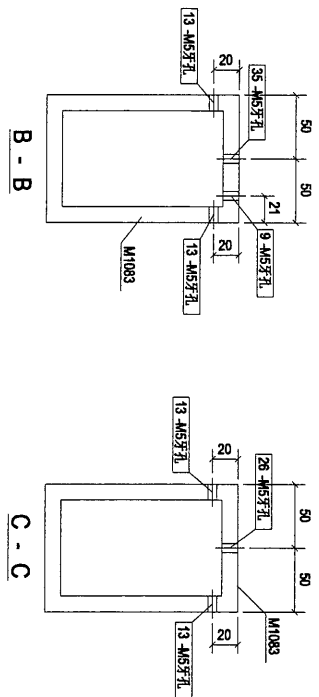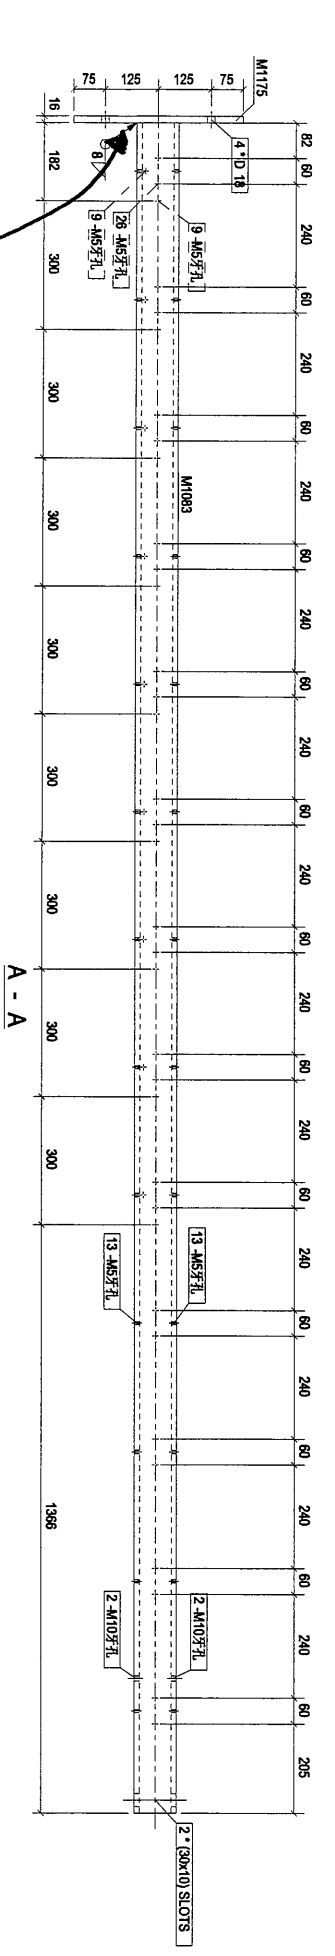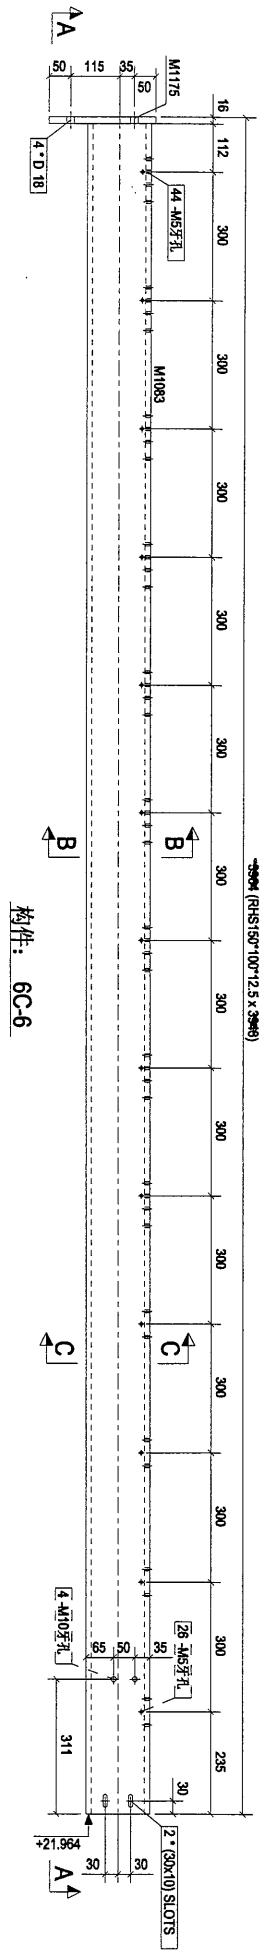

指出


本品

12

Rev.	0	第一次提批	2019-03-16
PROJECT:	PROPOSED SITE C1 DEVELOPMENT AT AREA 86, TROU TONG TSEUNG KWAN O, NEW TERRITORIES		
CLIENT:	美特經貿有限公司 MITSUBISHI KAISHA, LTD. (ASIA PACIFIC) PTE. LTD. Unit 5-4, Sunray Industrial Centre, 1/F 1110, No. 11, Ling Road, Tsimshatsui, Kowloon Tel: 24892114 Fax: (852) 27171868		
Designed by	[6C-6]		
Drawn by			
Reviewed by			
Approved by			
Scale			
DWG NO.:	E6	-	[6C-6]
REV.	0		

构件编号	规格(mm)	长度(mm)	数量	单重(kg)	共重(kg)	表面积(m ²)
M1084	RHS150*100*12.5	3948	1	169.22	169.22	1.85
M1175	PL16250	400	1	12.56	12.56	0.22
合计:					181.78	



4830
RHS150*100*12.5 x 3948

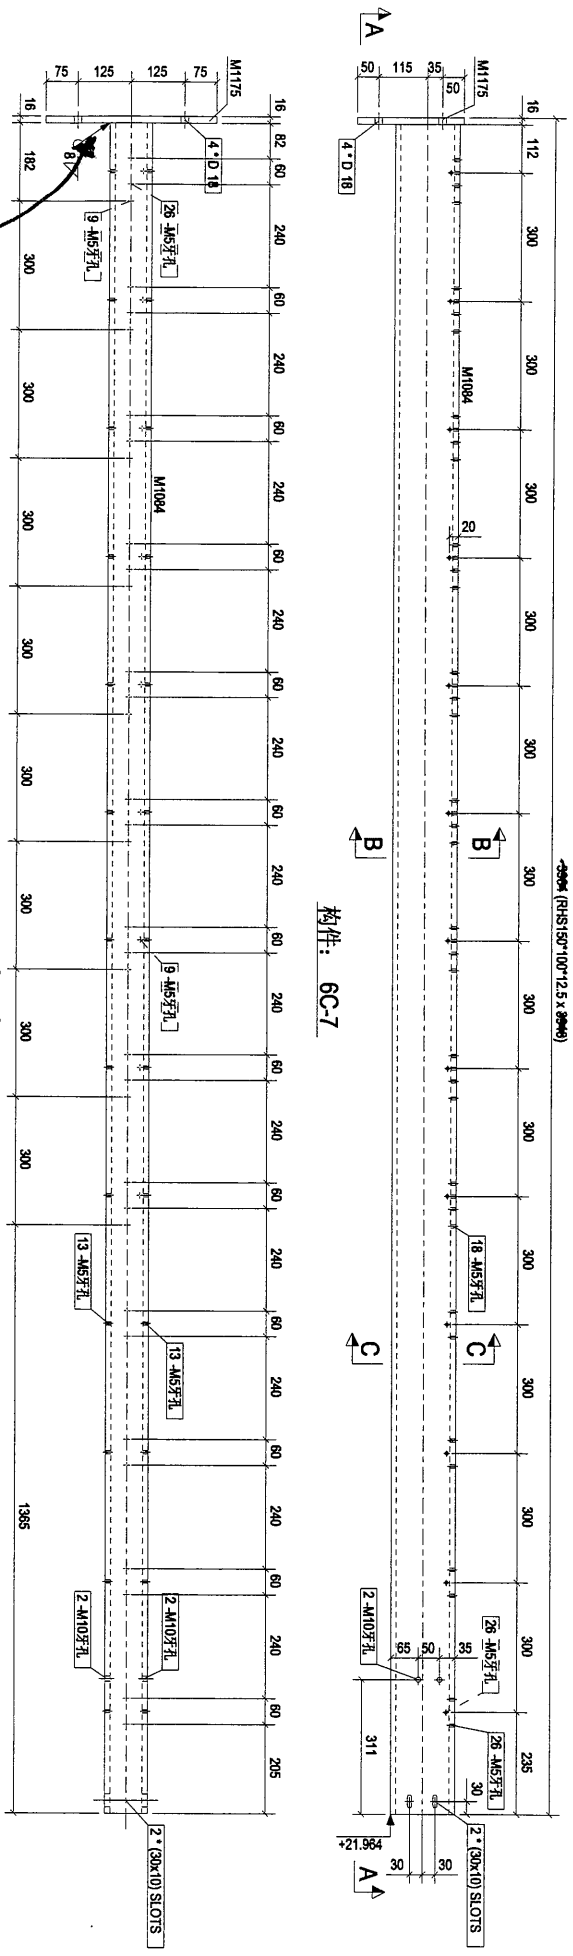

构件: 6C-7

散出

本品

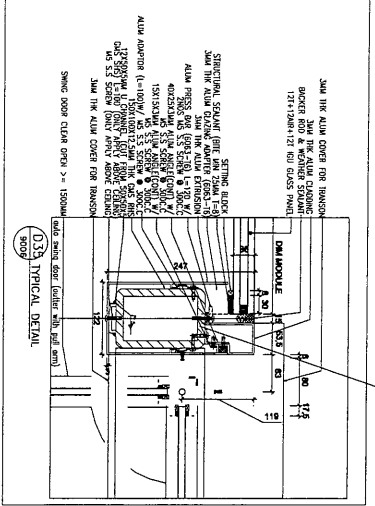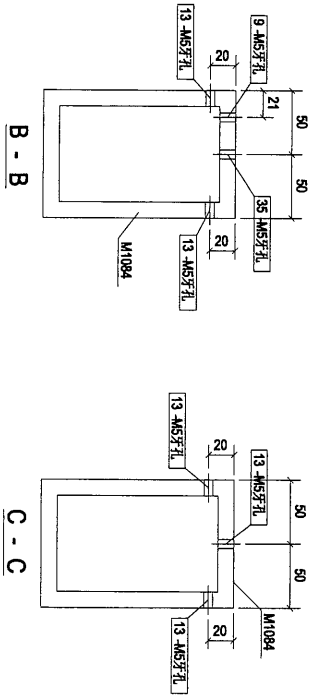


[6C-7]

Rev. 0	第一次报批	Date 2019-03-16
PROJECT:	PROPOSED SITE C1 DEVELOPMENT AT REAR OF KOTILTOP TISSING KWAN O, NEW TERRITORIES	
CLIENT:	美特德有限公司 MIDI Development / Projector Ltd. Units E-8 Sunny Industrial Centre 510 Cheong Kwo Ling Road, Kowloon Tel: 23489211-4 Fax: (852) 27272666	
Designed by	设计有限公司 SHIN YI SWI LHM 2013	
Drawn by		
Reviewed by		
Approved by		
Scale		
DWG NO: E6		REV. 0

新增鐵角

(14)

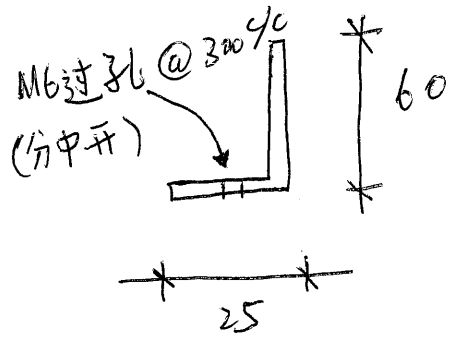

25 X 60 X 3mm 厚角鐵

每條 2m 長, 18 條

用於雨篷位置, 收垂防水片和
鋁板.