



工程指示 / 要求簡箋(E.I.)

工程指示編號：EI/ 0655 /19

修改版次：

工程編號：J836

工程名稱：日出康城7期(平台)

工程項目：WW4(N-RH) SI 項目 鐵通

收件人：Maggie Lor

發件人：Joe Chan

日期：3/6/2019

要求提供 / 確認 事項：

- | | | |
|------------------------------------|-------------------------------------|-------------------------------|
| <input type="checkbox"/> 初步鋁料 B.M. | <input type="checkbox"/> 加工拆圖，然後生產 | <input type="checkbox"/> 尺寸表 |
| <input type="checkbox"/> 正式鋁料 B.M. | <input type="checkbox"/> 技術上資料 / 指示 | <input type="checkbox"/> 報價 |
| <input type="checkbox"/> 配件 B.M. | <input type="checkbox"/> 樣辦或貨品說明書 | <input type="checkbox"/> 分判合約 |
| <input type="checkbox"/> 其他：_____ | | |

內容：

請依附件資料，生產鐵通(GMS) 共
14 枝，送地盤。(S.I. 項目)

位置：WW4(N-RH) 3/F

請在 10/6/2019 前完成上列要求。

附有關圖紙 / 文件：

5頁

以上項目為：

- 原合約工程包 原合約工程加 / 減賬 新工程報價

原因：-

分發東莞各部門：

- () 生產技術總監 連附件 () 技術部 連附件 () 生產部 連附件 () 機械設計部 連附件
() 採購部 連附件 () 生產統籌部 連附件
() 質檢部 連附件 () 會計部 連附件 () 報關組 連附件 () 其他 _____ 連附件

分發香港各部門：

- () 行政部 連附件 () 會計部 連附件 () 統籌部 連附件 () 工程部地盤科文 () 連附件 積哥
() 採購部 連附件 () QS 部 連附件 () 維修部 連附件 () 其他 _____ 連附件


傳遞編號：

發件人簽署：

項目經理簽署：

6件


物料编号	3C-X1	物料名称	6	物料单位	169.3
所在单号	RHS150100125	长度(mm)	3850	宽度(mm)	174
M81		数量	6	重量(kg)	174.42
				长度(m)	1.85
				合计	174.42

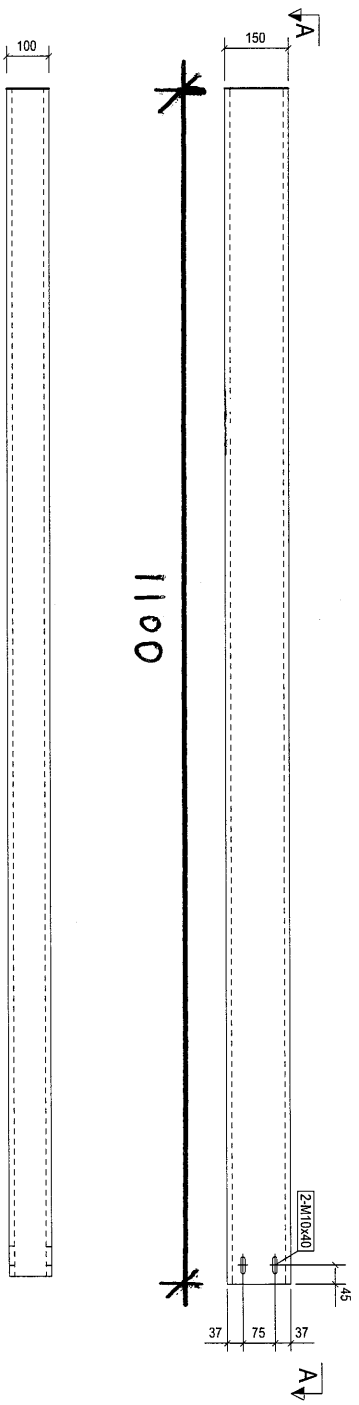

①

A - A

B - B

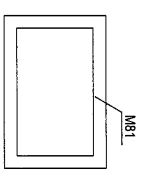

Rev.	Rev. 1	Date	2016-09-17
Rev. 2			

PROPOSED SITE C1
DEVELOPMENT AT AREA 86,
TKOIL TO RP, TSEUNG KWAN O,
NEW TERRITORIES

（名称）
基特铝业有限公司
MIDI ALUMINIUM FABRICATOR THE
HONG KONG
Unit 1, 2, 3, 999, 1000



银同有限公司
Silver Town Limited

WINDOW-WALL (M81)

Design Name	
Design No.	
Design Date	
Design By	
Checked By	
Approved By	
Scale	
DWG NO.	J-836-MW4-[3C-3]

8 件

物料编号:	3C-X2	物料数量:	169.3
物料规格:	铝隔间	单位(㎡):	74.42
M81	RHS150*100*12.5	数量:	174
		合计:	174.42

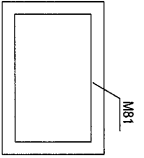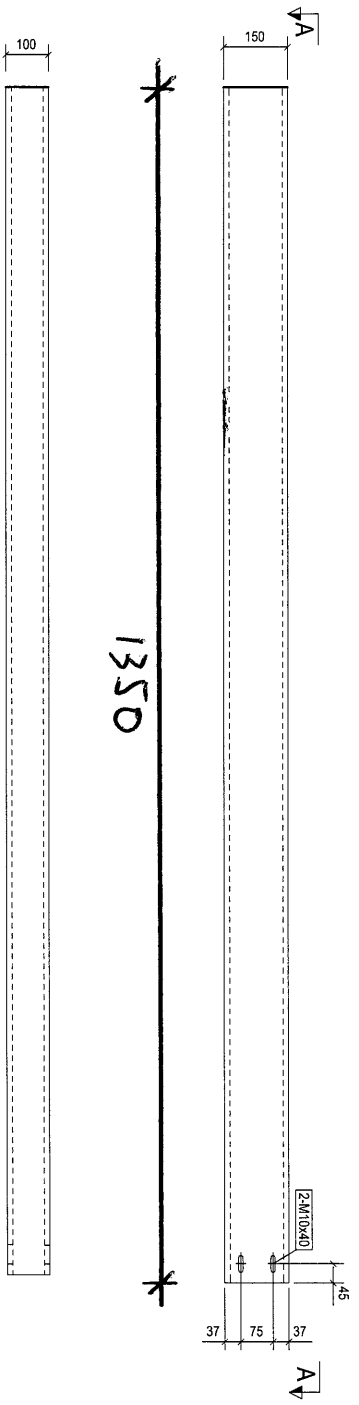

B - B

A - A


2

Part No.	B	第3次仕様	2018-09-17
Description	PROPOSED SITE C1 DEVELOPMENT AT AREA 88, KOLILTOP TSEUNGKWAN O, NEW TERRITORIES		
Client	美特鋁質有限公司 MIDI Aluminium Fabricator Ltd. Unit 105, 2nd Floor, 105-106, 111 The One, 110, 111, 112, 999, 1000.		
Design by	银同有限公司 Silver Town Limited		
Drawn by	J-388-MW4- [3C-3]		
Checked by			
Approved by			
Date			
DWG NO.	J-388-MW4- [3C-3]		

3



中國海外房屋工程有限公司
CHINA OVERSEAS BLDG. CONSTRUCTION LTD.

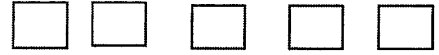

廢工 扣判頭 CI/RFAI E-mail 其他

工程指示(Site Instruction)

地盤：將軍澳日出康城7期地盤
承判工程：玻璃幕牆
判頭：美特

編號：COBC/BHX/ F10 / 2019/ 12615

日期 2019年4月2日

工程指示內容 設計,生產及安裝 E2,E5,E6 及 Window Wall (WW4)加長鐵架及鋁板收口(G.L RB-RE/31-44)及(G.L D/33)

根據分判合約條款，貴司請于 2019 年 4 月 23 日前完成以下之工作指示，此指示並不減免分判商的合約責任。

現指示貴判於附圖所示位置執行以下指令，

- 1.美特按附圖位置設計,生產及安裝 E2,E5,E6 及 Window Wall WW4 加長鐵架及鋁板收口。

以上之工程指示，*須 / 不須僱傭代工施工，*另行報價 / 依圖度數 / 有待我司工料測量部評審責任。

部門:	工程師	制表人:	Joe Ng <i>Joe Ng</i>
-----	-----	------	----------------------

必須填妥附件方可以簽署發出本 SI：
(包括工程原因,是否有廢工或扣其他判頭 及 附上施工圖則)
注：簽署後，請於右上角打“✓”


首席項目經理 (William) 或
項目經理(Bruce/Kelvin/William)

C.C.

COBC	QS Dept	工程部						BS Dept				地盤總管 / 管工部					Site Office
		李工	Kelvin Jong					Raymond Ho	馮	Daniel	YS	寶總	陳總	民雄	權/湛	基	
	✓	✓											✓	✓			✓

HC/PQS

5

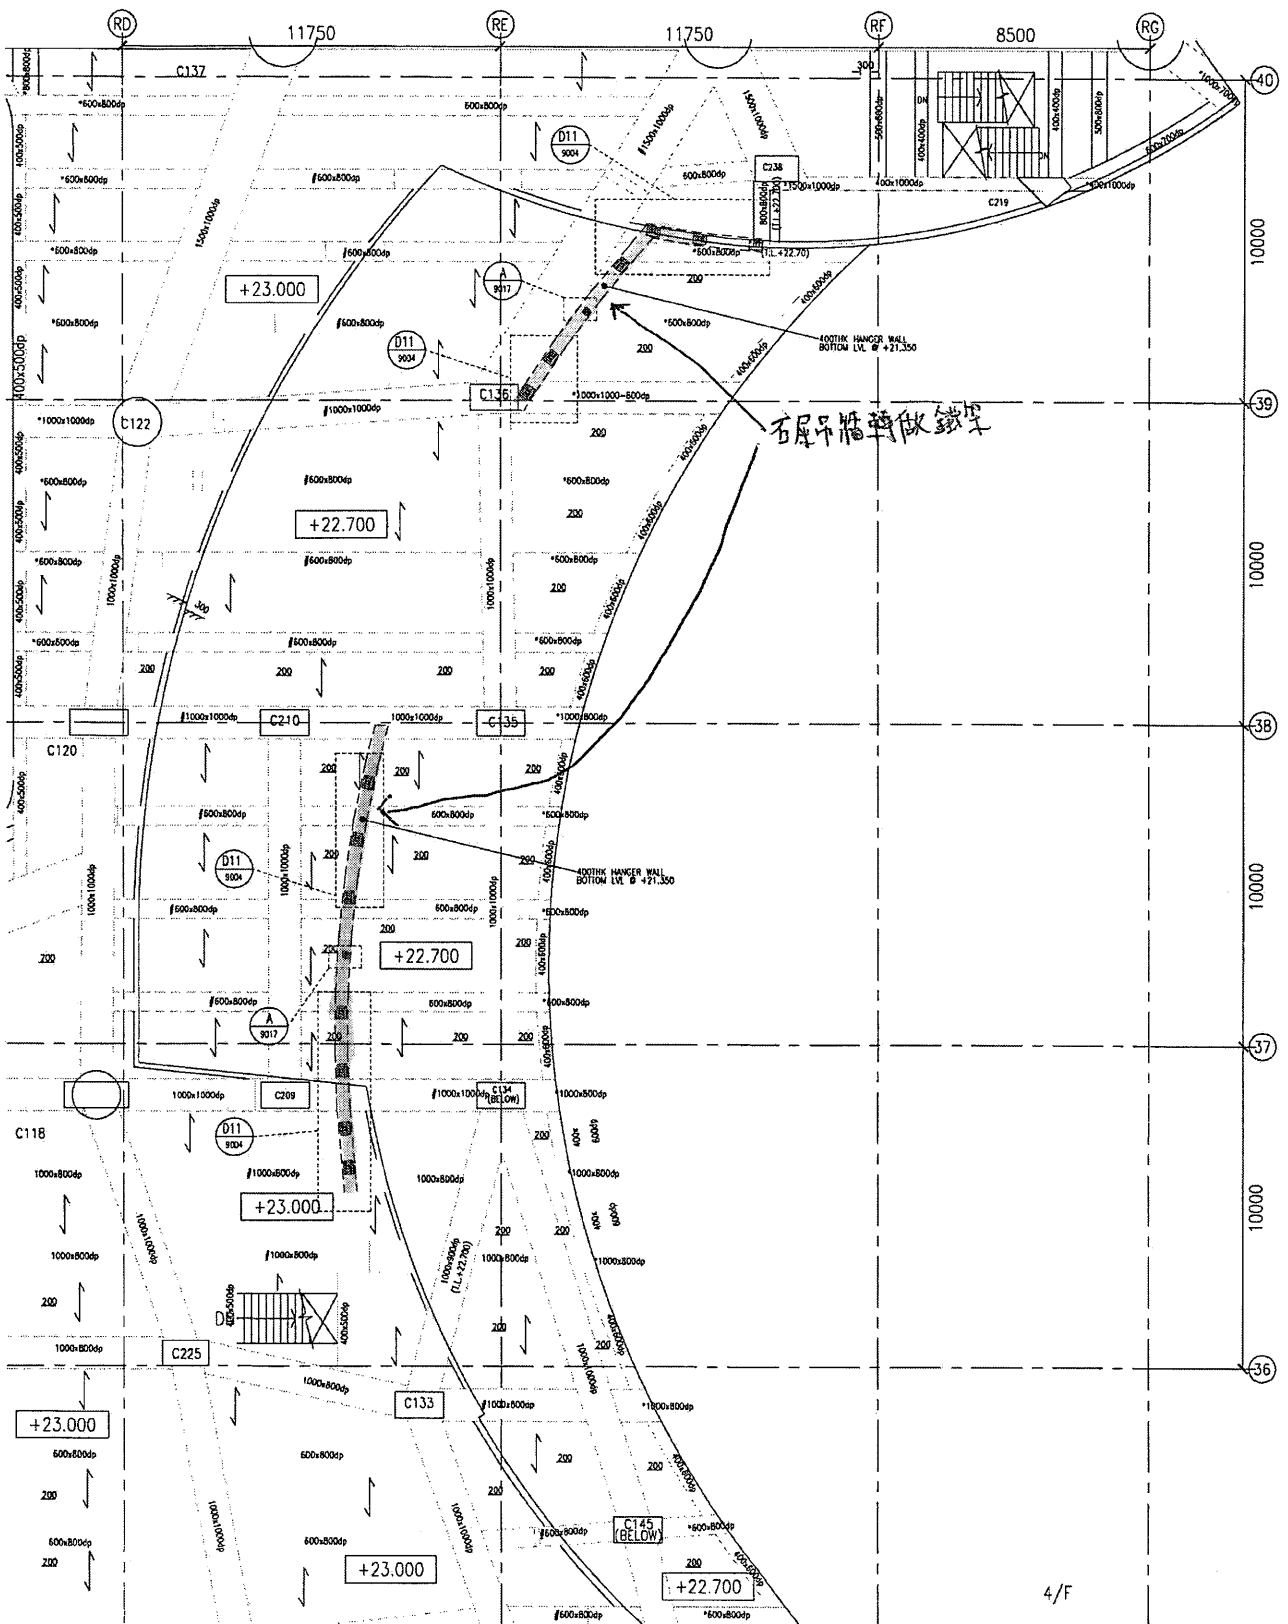

EL16
3019F
FIXING LOCATION OF WINDOW-WALL (WW4)
@4/F FRAMING BELOW (TOP FIXING)

4/F

<p>9.0. REF. : Y/18/29/77/1(C)</p> <p>LEGEND :</p> <p>0.01 --- 12mm THK CLEAR TINTED GLASS</p> <p>0.02 --- 12mm THK GLASS</p> <p>0.03 --- 12mm THK CLEAR TINTED GLASS (GL)</p> <p>0.04 --- (TYPICAL)</p> <p>0.05 --- 12mm THK CLEAR GLASS</p> <p>0.06 --- 12mm THK CLEAR GLASS</p>		<p>ARCHITECT :</p> <p>MTR</p>		<p>CLIENT :</p> <p>CHINA OVERSEAS BUILDING CONSTRUCTION LTD.</p>		<p>STRUCTURAL ENGINEER :</p> <p>ARUP</p>		<p>FAÇADE CONSULTANT :</p> <p>WEINMART</p>		<p>NOTE :</p> <p>1. ALL DIMENSIONS ARE IN mm.</p> <p>2. ALL EXPOSURES ARE FINISHED FROM OUTSIDE BEFORE FABRICATION.</p> <p>LEGEND :</p> <p>① --- REF. SHEET NO.</p> <p>② --- FINISHED FLOOR LEVEL</p> <p>③ --- STRUCTURE FLOOR LEVEL</p> <p>④ --- EXTENDED DETAIL</p>	
<p>DATE : 07-DEC-2017 SCALE : 1:150</p> <p>DRAWN BY : C.F. CHECKED BY : J.K.K.</p>		<p>TITLE :</p> <p>FIXING LOCATION PLAN (TOP)</p> <p>FOR WW4 + CCL</p> <p>③ 3/F</p>		<p>PROJECT :</p> <p>PROPOSED SITE C1 DEVELOPMENT AT AREA 86, TIKOIL 70 RP, TSEUNG KWAN O, NEW TERRITORIES</p>		<p>DRG NO. : J085-WW4-3019F</p>		<p>DATE : 07-DEC-2017 SCALE : 1:150</p> <p>DRAWN BY : C.F. CHECKED BY : J.K.K.</p>		<p>PROJECT :</p> <p>PROPOSED SITE C1 DEVELOPMENT AT AREA 86, TIKOIL 70 RP, TSEUNG KWAN O, NEW TERRITORIES</p>	