

工程指示 / 要求簡箋(E.I.)

工程指示編號：EI/ 9395 /18 修改版次： B
 工程編號： JB36 工程名稱： 日出康城7期平台
 工程項目： 修改模圖 3 個 (WW2)
 收件人： Maggie Lor 發件人： 李耀鵬 日期： 2018/6/27

□要求提供 / 確認 事項：

- () 初步鋁料 B.M. () 加工拆圖，然後生產 () 尺寸表
- () 正式鋁料 B.M. () 技術上資料 / 指示 () 報價
- () 配件 B.M. () 樣辦或貨品說明書 () 分判合約
- () 其他： _____

內容：

請確認 WW2 3款模圖修改，煩請字排修正圖模。

請在 2018/7/6 前完成上列要求。

附有關圖紙 / 文件：

3頁模圖

以上項目為：

- 原合約工程包 原合約工程加 / 減賬 新工程報價

原因：-

分發東莞各部門：

- () 生產技術總監 連附件 () 技術部 連附件 ^{永林} () 生產部 連附件 () 機械設計部 連附件
- () 採購部 連附件 () 生產統籌部 連附件 ^梅
- () 質檢部 連附件 () 會計部 連附件 () 報關組 連附件 () 其他 _____ 連附件

分發香港各部門：

- () 行政部 連附件 () 會計部 連附件 () 統籌部 連附件 () 工程部地盤科文 連附件
- () 採購部 連附件 () QS 部 連附件 () 維修部 連附件 () 其他 _____ 連附件




傳遞編號：

HK1024 /18


發件人簽署：

項目經理簽署：

CUSTOMER	HONGKONG CO.	CUSTOMER APPROVAL	CUST PART NO.	X85517
			SECTION NO.	LH0089692

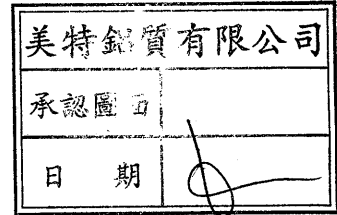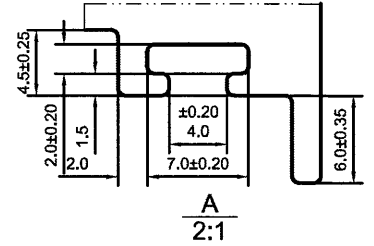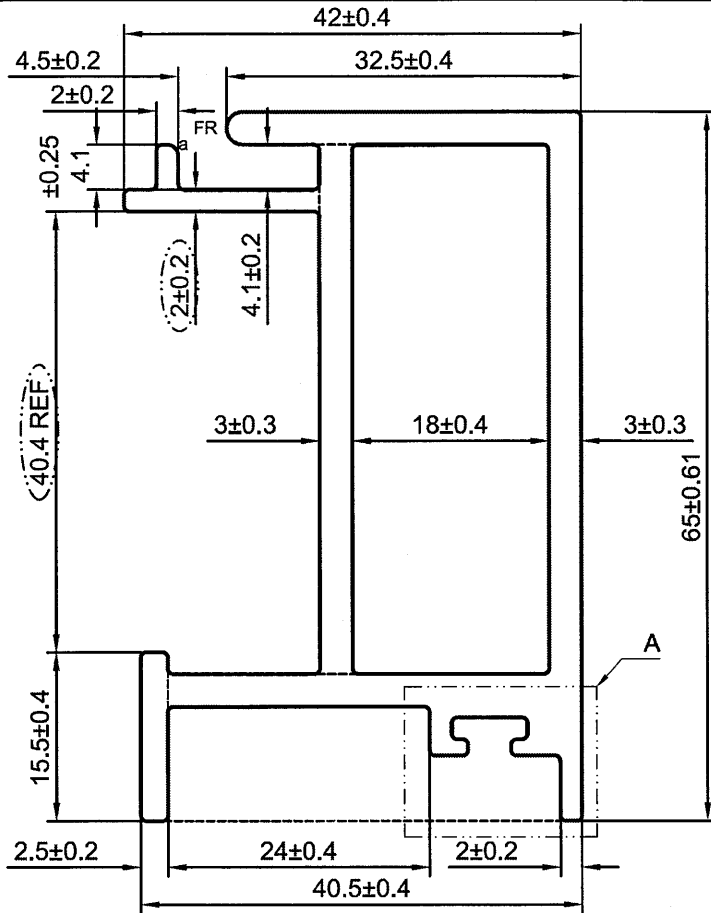


2018/6/27

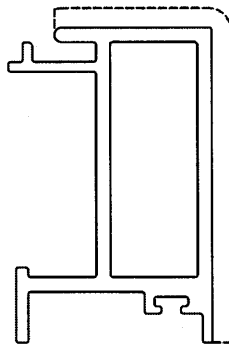

V.F

a=R1.0

SCALE 1:1.5

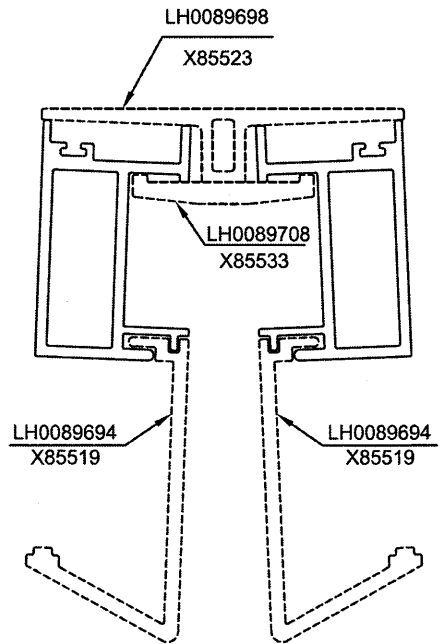

SCALE 1:2



*配合尺寸以实物配合效果为准!

SIGNATURE GRADEING	HIGH SIGNATURE GRADEING	C.C.DIA(MM)	Ø 76.21						
AREA (SQ MM)	639.43	UNSPECIFIED THICKNESS	3±0.25	PERIMETER (MM)	302.26	STANDARD	GB 5237.1	SCALE	1.5:1
MASS (KG/M)	1.733	UNSPECIFIED CORNERS	R 0.5	SURFACE AREA	100.78	ALLOY	6063-T6	VERSION	B
COMPANY ISSUE		B	DRAWA	蔡晓婷	DATE	2018-06-25	APPELLATION	-	PAGE OF
			STANDA-RDIZATION		DATE				
			TO SIGN	陈国提	DATE				
			AUDITING		DATE				
MARKER	MODIFY	FILE NO	SIGNATURE	DATE	APPROV				




PANASIA ALUMINUM (CHINA) LIMITED

CUSTOMER	HONGKONG CO.	CUSTOMER APPROVAL	CUST PART NO.	X85530
			SECTION NO.	LH0089705

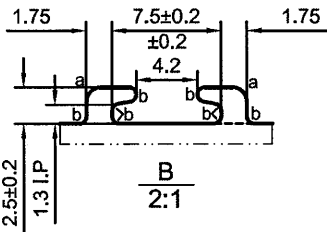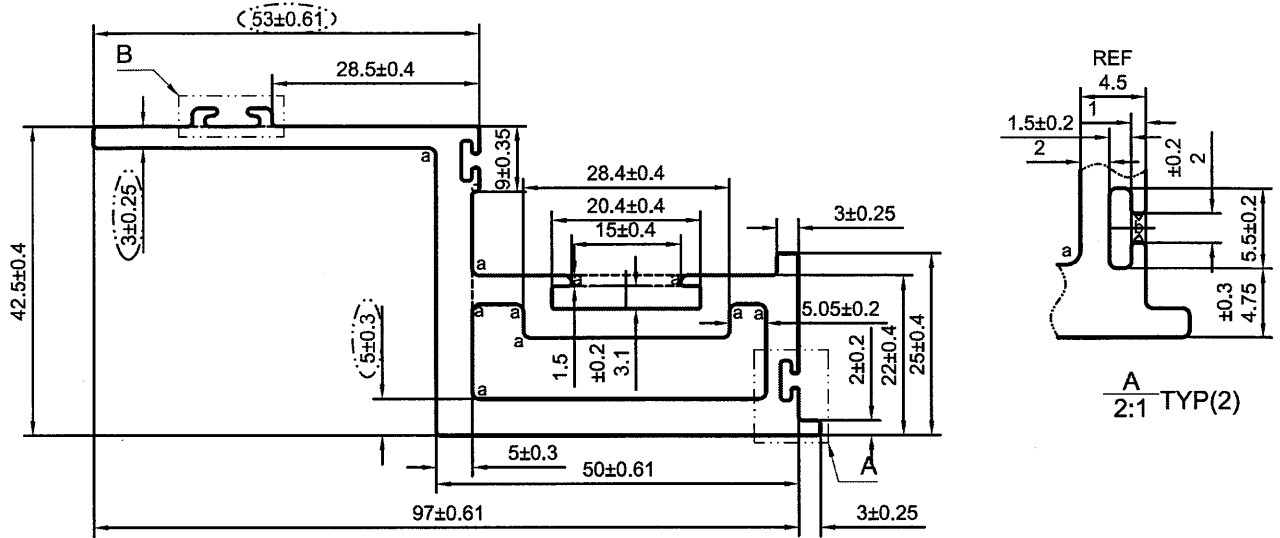


美特鋁質有限公司	
承認圖面	
日期	2018/6/27

a=R1 b=R0.3

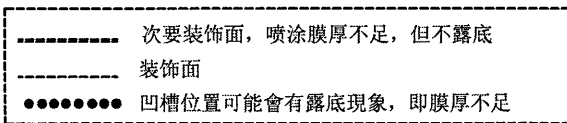

*配合尺寸以实物配合效果为准!

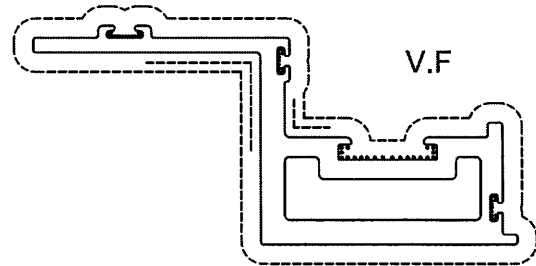


SCALE 1:1.5

SIGNATURE GRADEING	HIGH SIGNATURE GRADEING	C.C.DIA(MM)	Ø 108.35						
AREA (SQ MM)	878.13	UNSPECIFIED THICKNESS	4±0.25	PERIMETER (MM)	342.42	STANDARD	GB 5237.1	SCALE	1:1
MASS (KG/M)	2.38	UNSPECIFIED CORNERS	R 0.5	SURFACE AREA	342.42	ALLOY	6063-T6	VERSION	B
COMPANY ISSUE		B	DRAWA	蔡晓婷	DATE	2018-06-23	APPELLATION	-	PAGE OF
			STANDARDIZATION		DATE				
			TO SIGN	陈国提	DATE				
			AUDITING		DATE				
MARKER	MODIFY	FILE NO	SIGNATURE	DATE	APPROV				

PANASIA ALUMINUM (CHINA) LIMITED

CUSTOMER	HONGKONG CO.	CUSTOMER APPROVAL	CUST PART NO.	X85532
			SECTION NO.	LH0089707

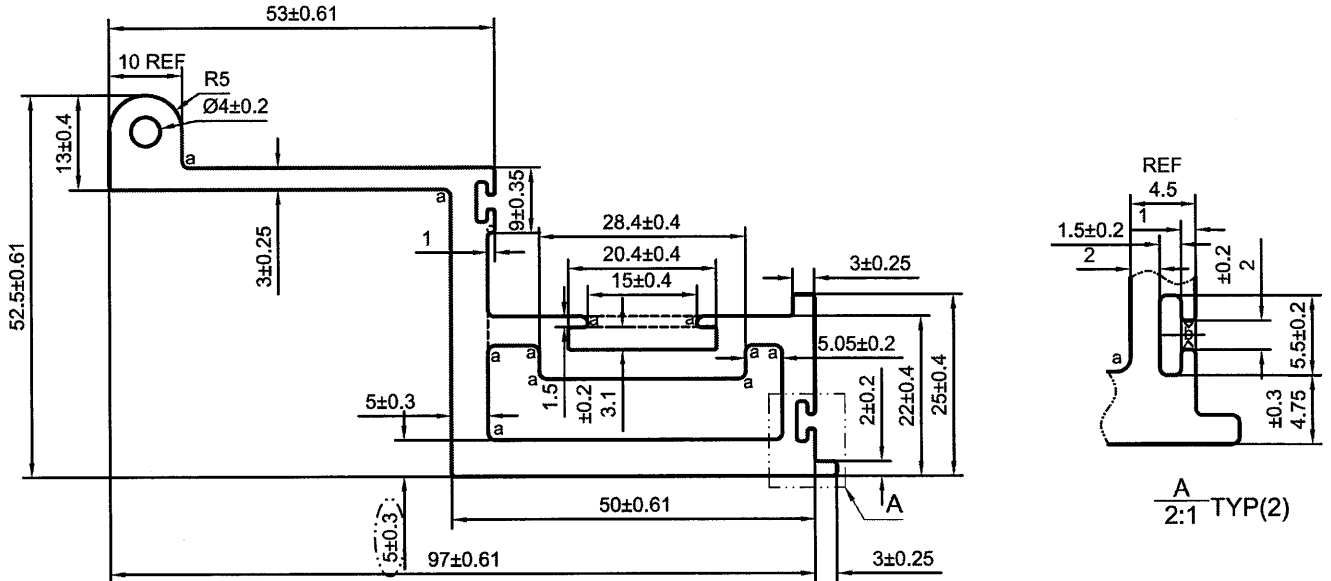


美特鋁質有限公司	
承認圖面	
日期	

2018/6/27

a=R1 b=R0.3

-----	次要裝飾面, 噴塗膜厚不足, 但不露底
-----	裝飾面
●●●●●●	凹槽位置可能會有露底現象, 即膜厚不足

*配合尺寸以实物配合效果为准!

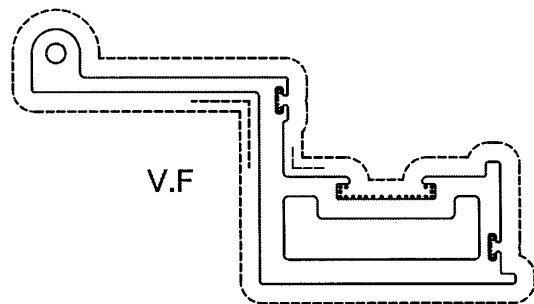

SCALE 1:1.5

SIGNATURE GRADEING	HIGH SIGNATURE GRADEING	C.C.DIA(MM)	Ø 111.04						
AREA (SQ MM)	943.15	UNSPECIFIED THICKNESS	4±0.25	PERIMETER (MM)	344.51	STANDARD	GB 5237.1	SCALE	1:1
MASS (KG/M)	2.556	UNSPECIFIED CORNERS	R 0.5	SURFACE AREA	344.51	ALLOY	6063-T6	VERSION	B
COMPANY ISSUE		B	DRAWA	蔡晓婷	DATE	2018-06-25	APPELLATION	-	PAGE OF
			STANDARDIZATION		DATE				
			TO SIGN	陈国提	DATE				
			AUDITING		DATE				
MARKER	MODIFY	FILE NO	SIGNATURE	DATE	APPROV				

PANASIA ALUMINUM (CHINA) LIMITED