


新圖

2 Please provide size of A/C unit.

3 coating thickness  
no metallic colour in paint finish.

1 could not install

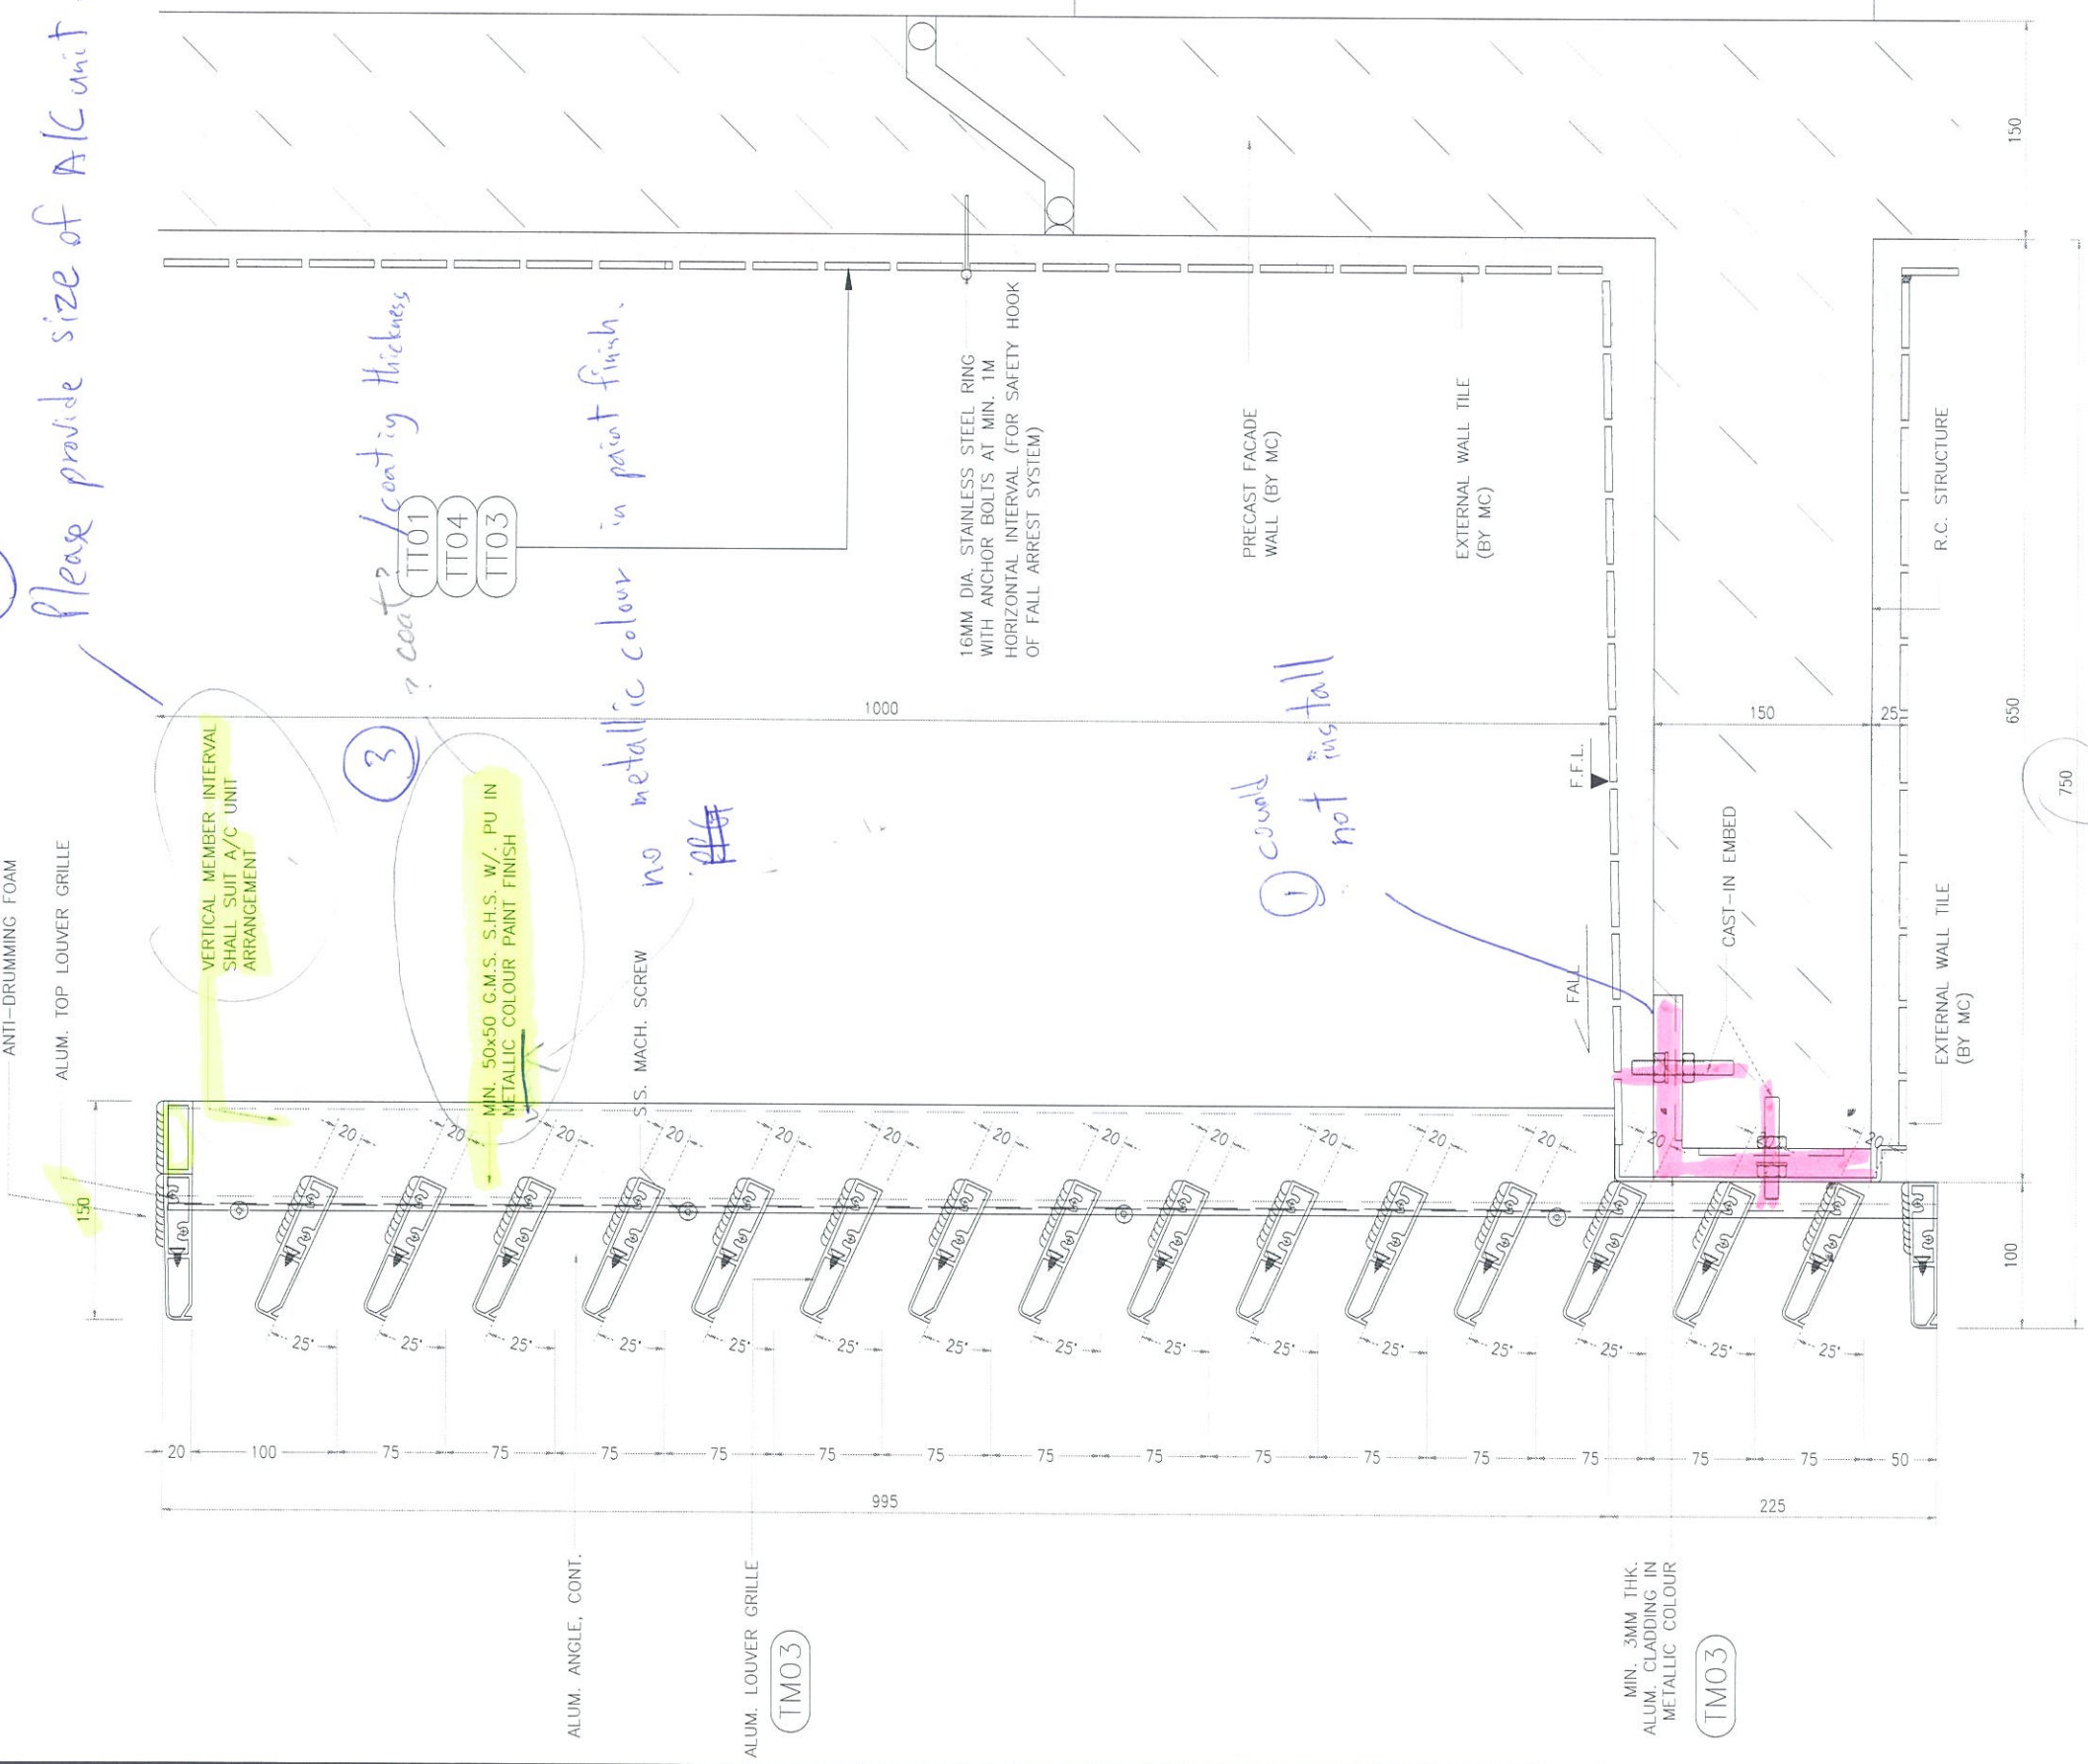

1 TYPICAL DETAILS FOR ALUM. GRILLE AT A/C PLATFORM (PRECAST FACADE)

NOTES  
DO NOT SCALE DRAWING, FIGURED DIMENSIONS ARE TO BE FOLLOWED.  
READ THIS DRAWING IN CONNECTION WITH GENERAL ARCHITECTURAL PLANS, STRUCTURAL PLANS, AND OTHER RELATED DRAWINGS, THE ARCHITECT SHALL BE NOTIFIED IMMEDIATELY OF ANY DISCREPANCY FOUND THEREIN.  
COPYRIGHT OF THIS DRAWING RESERVED BY ARCHITECT.

NO.	DATE	REVISIONS	DRAWN	CHECKED	DESIGNED	REVIEWED



**WONG TUNG & PARTNERS LIMITED**  
ARCHITECTS & PLANNERS  
18th Floor, Cityplaza 3, Taikoo Shing, Hong Kong  
T 852-2803 9888 F 852-2513 1728 www.wongtung.com

PROJECT:  
URA KWUN TONG TOWN CENTRE REDEVELOPMENT (AREA 2 & 3) AT NKIL 6514 KWUN TONG, KOWLOON

TITLE:  
AC PLATFORM GRILLE DETAILS (PRECAST FACADE)

TENDER ADDENDUM NO. 1

DATE: 01/2017	SCALE: 1:5
DRAFTED: ( )	CHECKED: ( )
DESIGNED: ( )	REVIEWED: ( )
JOB NO. 31690	DRAWING NO. T/A132/207
REV. NO. 07	