

工程指示 / 要求簡箋(E.I.)

工程指示編號：EI/ 9411 /18

修改版次： C

工程編號： J836

工程名稱： 日出康城 (平台)

工程項目： WW4(N-RH) 鐵件 (新增角鐵)

收件人： Maggie Lor

發件人： Joe Chan

日期： 12/10/2018

要求提供 /  確認 事項：

- ( ) 初步鋁料 B.M.                      ( ) 加工拆圖，然後生產                      ( ) 尺寸表
- ( ) 正式鋁料 B.M.                      ( ) 技術上資料 / 指示                      ( ) 報價
- ( ) 配件 B.M.                              ( ) 樣辦或貨品說明書                      ( ) 分判合約
- ( ) 其他： \_\_\_\_\_

內容：

請依附件資料訂購鐵件，送地盤。

請在 31/10/2018 前完成上列要求。

附有關圖紙 / 文件：

以上項目為：

- 原合約工程包                       原合約工程加 / 減賬                       新工程報價

原因：-

分發東莞各部門：

- ( ) 生產技術總監  連附件    ( ) 技術部     連附件    ( ) 生產部     連附件    ( ) 機械設計部  連附件
- ( ) 採購部     連附件    ( ) 生產統籌部  連附件
- ( ) 質檢部     連附件    ( ) 會計部     連附件    ( ) 報關組     連附件    ( ) 其他 \_\_\_\_\_  連附件

分發香港各部門：

- ( ) 行政部  連附件    ( ) 會計部  連附件    ( ) 統籌部  連附件    ( ) 工程地盤科文  連附件    積哥
- ( ) 採購部  連附件    ( ) QS 部  連附件    ( ) 維修部  連附件    ( ) 其他 \_\_\_\_\_  連附件

傳遞編號：

發件人簽署：

項目經理簽署：



美特鋁質 有限公司  
MDT Aluminium Fabricator Ltd.

工程號: J836-WW4  
地點名稱: 日出康城7期平台

計算:  
核對:

日期: 12/10/2018  
日期: 12/10/2018

送呈:  
副本:

地盘鐵件BM表

項目類別: 幕牆

批准:

日期:

BM編號: 修改版次: A/C Code: 鐵件總重量KG: 1547.61

序號	修改內容	鐵件圖號	鐵件名稱	顏色	實用	後備	總數	單位	單件(kg)	總重量(kg)	備注
1		2J-1	75*50*5mm角鐵	熱浸鋅	69	0	69	件	8.568	591.192	
2		2J-2	75*50*5mm角鐵	熱浸鋅	1	0	1	件	8.074	8.074	
3		2J-3	75*50*5mm角鐵	熱浸鋅	9	0	9	件	8.098	72.882	
4		2J-4	75*50*5mm角鐵	熱浸鋅	3	0	3	件	8.030	24.090	
5		2J-5	75*50*5mm角鐵	熱浸鋅	1	0	1	件	7.982	7.982	
6		2J-6	75*50*5mm角鐵	熱浸鋅	2	0	2	件	7.973	15.946	
7		2J-7	75*50*5mm角鐵	熱浸鋅	2	0	2	件	7.978	15.956	
8		2J-8	75*50*5mm角鐵	熱浸鋅	1	0	1	件	7.997	7.997	
9		2J-9	75*50*5mm角鐵	熱浸鋅	15	0	15	件	8.539	128.085	
10		2J-10	75*50*5mm角鐵	熱浸鋅	9	0	9	件	8.179	73.611	
11		2J-11	75*50*5mm角鐵	熱浸鋅	1	0	1	件	8.779	8.779	
12		2J-12	75*50*5mm角鐵	熱浸鋅	1	0	1	件	8.419	8.419	
13		2J-13	75*50*5mm角鐵	熱浸鋅	6	0	6	件	8.054	48.324	
14		2J-14	75*50*5mm角鐵	熱浸鋅	12	0	12	件	8.064	96.768	
15		2J-15	75*50*5mm角鐵	熱浸鋅	1	0	1	件	7.901	7.901	
16		2J-16	75*50*5mm角鐵	熱浸鋅	1	0	1	件	7.882	7.882	
17		2J-17	75*50*5mm角鐵	熱浸鋅	1	0	1	件	7.896	7.896	
18		2J-18	75*50*5mm角鐵	熱浸鋅	4	0	4	件	7.963	31.852	
19		2J-19	75*50*5mm角鐵	熱浸鋅	2	0	2	件	8.021	16.042	
20		2J-20	75*50*5mm角鐵	熱浸鋅	6	0	6	件	8.078	48.468	



美特鋁質 有限公司  
MDT Aluminium Fabricator Ltd.

工程號: J836-WW4  
地盘名稱: 日出康城7期平台

計算:  
核對:

日期: 12/10/2018  
日期: 12/10/2018

送呈:  
副本:

地盘鐵件BM表


項目類別: 幕牆

批准:


日期:

BM編號: 修改版次: A/C Code: 鐵件總重量KG: 1547.61


序號	修改內容	鐵件圖號	鐵件名稱	顏色	實用	後備	總數	單位	單件(kg)	總重量 (kg)	備注
21		2J-21	75*50*5mm角鐵	熱浸鋅	7	0	7	件	8.544	59.808	
22		2J-22	75*50*5mm角鐵	熱浸鋅	1	0	1	件	8.554	8.554	
23		2J-23	75*50*5mm角鐵	熱浸鋅	5	0	5	件	8.083	40.415	
24		2J-24	75*50*5mm角鐵	熱浸鋅	1	0	1	件	8.093	8.093	
25		2J-25	75*50*5mm角鐵	熱浸鋅	3	0	3	件	8.184	24.552	
26		2J-26	75*50*5mm角鐵	熱浸鋅	2	0	2	件	8.189	16.378	
27		2J-27	75*50*5mm角鐵	熱浸鋅	1	0	1	件	8.131	8.131	
28		2J-28	75*50*5mm角鐵	熱浸鋅	1	0	1	件	8.107	8.107	
29		2J-29	75*50*5mm角鐵	熱浸鋅	2	0	2	件	8.165	16.330	
30		2J-30	75*50*5mm角鐵	熱浸鋅	1	0	1	件	8.174	8.174	
31		2J-31	75*50*5mm角鐵	熱浸鋅	5	0	5	件	8.194	40.970	
32		2J-32	75*50*5mm角鐵	熱浸鋅	1	0	1	件	8.126	8.126	
33		2J-33	75*50*5mm角鐵	熱浸鋅	1	0	1	件	7.824	7.824	
34		2J-34	75*50*5mm角鐵	熱浸鋅	2	0	2	件	7.920	15.840	
35		2J-35	75*50*5mm角鐵	熱浸鋅	1	0	1	件	7.939	7.939	
36		2J-36	75*50*5mm角鐵	熱浸鋅	5	0	5	件	8.045	40.225	
					合計:		186	件	合共:	1547.612	

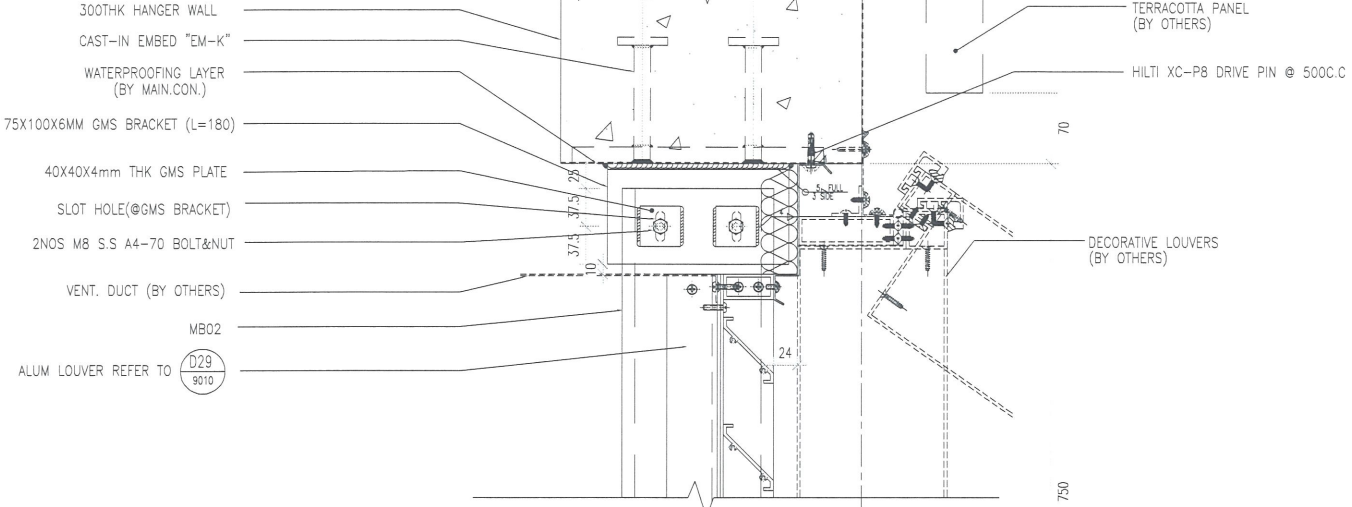

D1 WINDOW-WALL (WW4) TYPICAL DETAIL  
9001

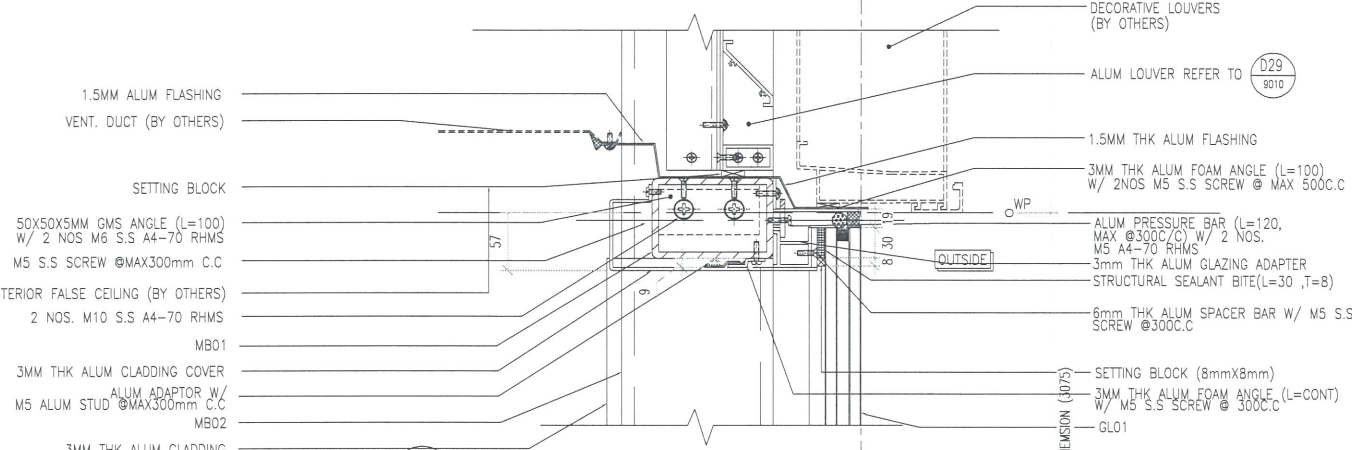


D2 WINDOW-WALL (WW4) TYPICAL DETAIL  
9001

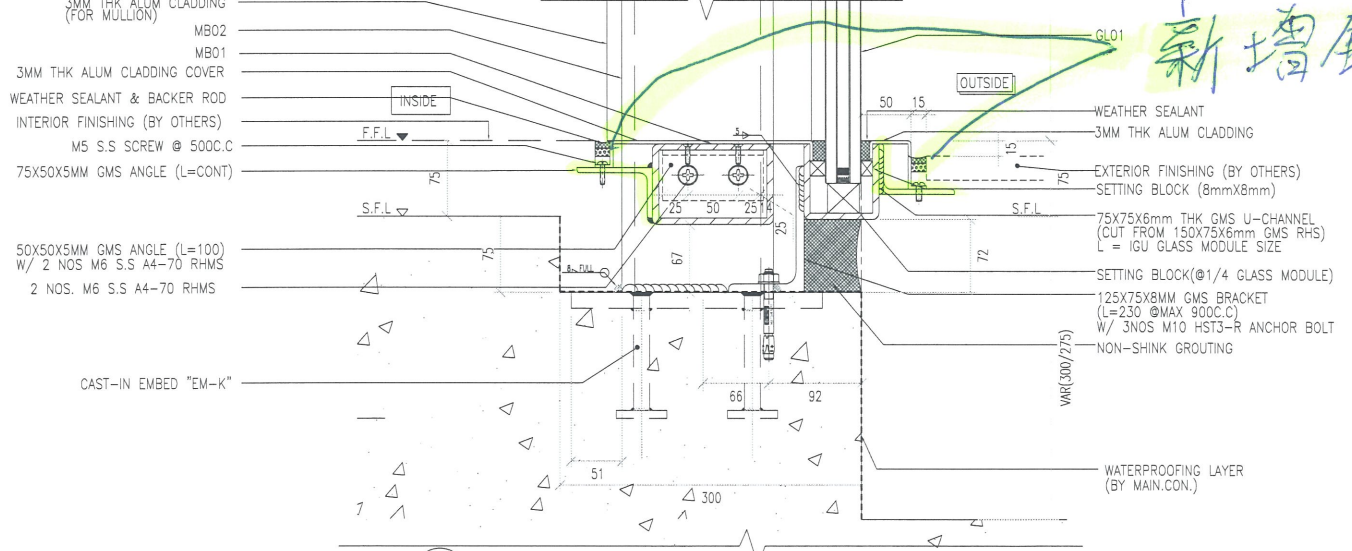


D3 WINDOW-WALL (WW4) TYPICAL DETAIL  
9001 FOR 75MM RECESS

<b>REVISIONS</b> NO. DATE BY: C/F REASON 1 01.15.2011 JH ADDITION 2 29.06.2011 TB REVISION 3 08.08.2011 RMB REVISION		<b>PROJECT:</b> PROPOSED SITE C1 DEVELOPMENT AT AREA 86, TKOIL 70 RP, TSEUNG KWAN O, NEW TERRITORIES	
<b>JOB NO.:</b> J-836		<b>TITLE:</b> TYPICAL DETAILS FOR WINDOW-WALL (WW4)	
<b>DATE:</b> 20-NOV-17 <b>SCALE:</b> 1:15		<b>DESIGNED BY:</b> C/F <b>CHECKED BY:</b> M.K.	
<b>CLIENT:</b> MTR			
<b>ARCHITECT:</b> P&L Projects and Engineers Ltd 怡和洋行建築及工程有限公司			
<b>MAIN CONTRACTOR:</b> CHINA OVERSEAS BUILDING CONSTRUCTION LTD.			
<b>STRUCTURAL ENGINEER:</b> ARUP			
<b>FAHSE CONSULTANT:</b> MEINHARDT			
<b>NOTES:</b> 1. ALL DIMENSIONS ARE IN mm. 2. ALL ELEVATIONS ARE VIEWED FROM OUTSIDE. 3. ALL DIMENSIONS TO BE VERIFIED ON SITE. 4. ALL WORK TO BE IN ACCORDANCE WITH THE SPECIFICATION.			
<b>LEGEND:</b> (X) DETAIL MARK NO. (9001) REFER SHEET NO. 1. F.F.L. --- FINISHED FLOOR LEVEL 2. S.F.L. --- STRUCTURAL FLOOR LEVEL 3. (70) --- REVERSED DETAIL			
<b>UNIT:</b> 1000mm <b>SCALE:</b> 1:15		<b>REVISIONS:</b> NO. DATE BY: C/F REASON 1 01.15.2011 JH ADDITION 2 29.06.2011 TB REVISION 3 08.08.2011 RMB REVISION	


新增鉄件

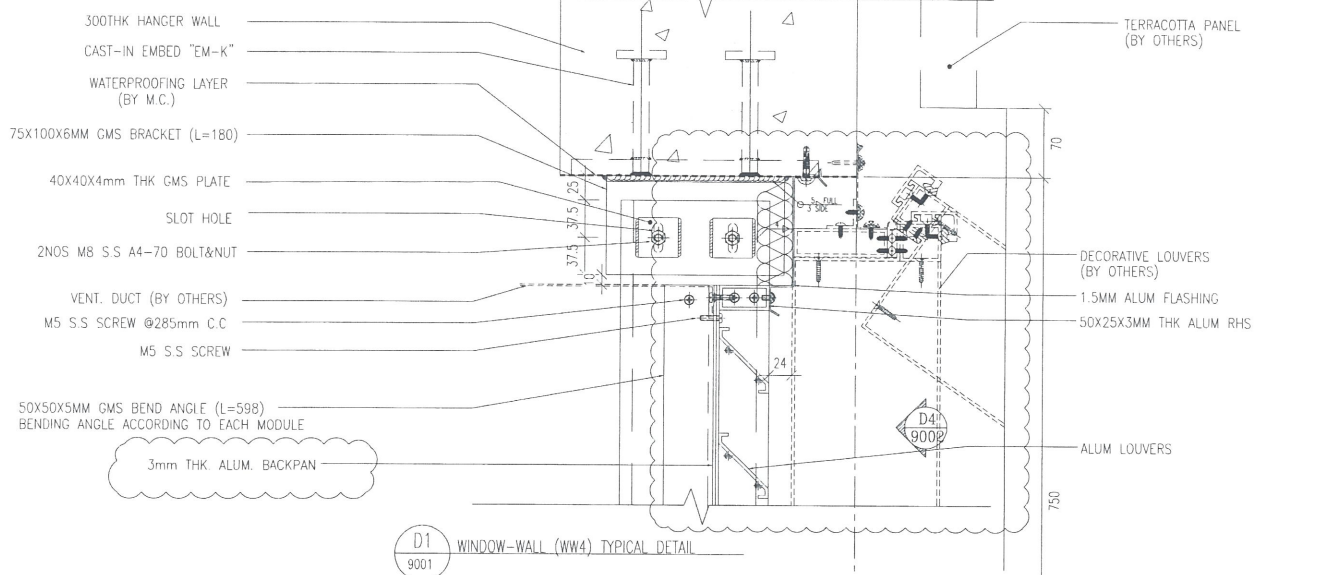

D1 WINDOW-WALL (WW4) TYPICAL DETAIL

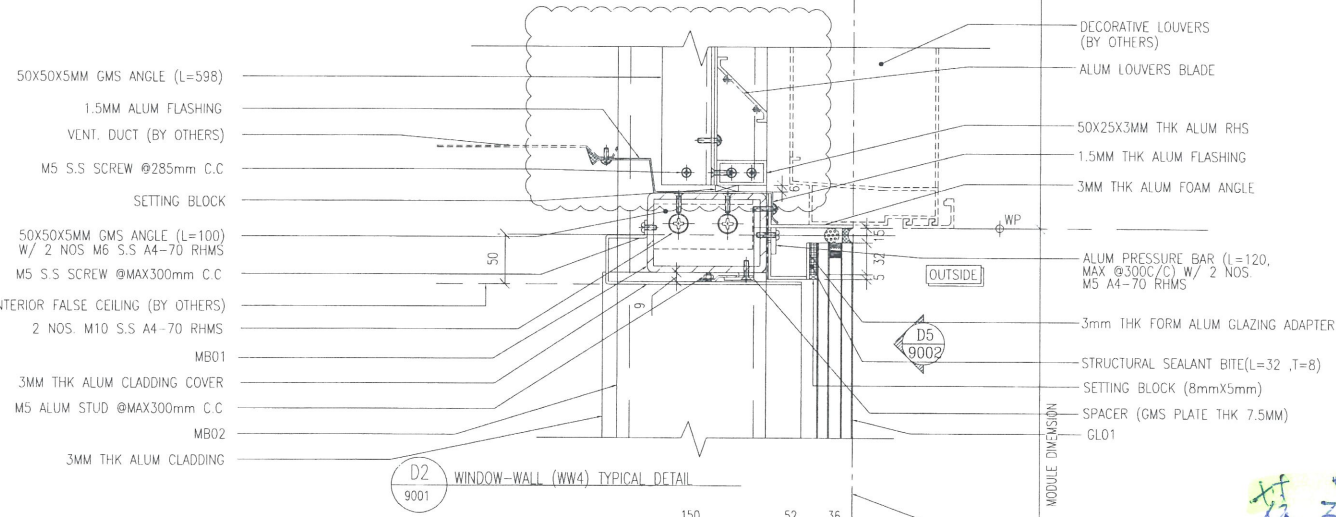

D2 WINDOW-WALL (WW4) TYPICAL DETAIL

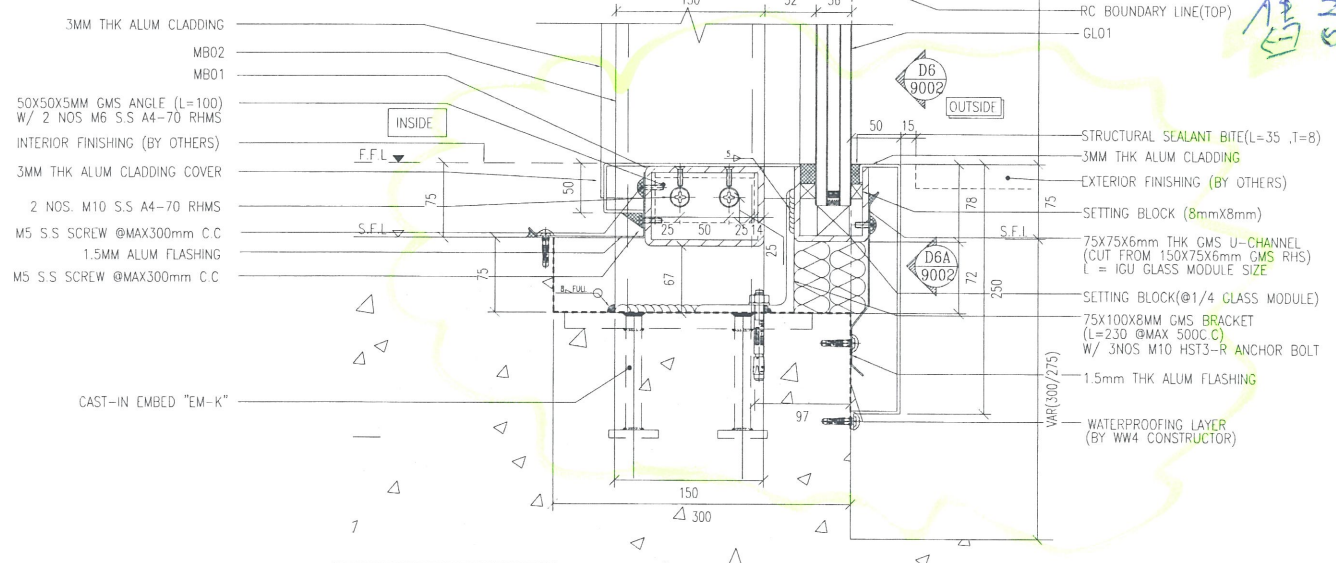


D3 WINDOW-WALL (WW4) TYPICAL DETAIL FOR 75MM RECESS

舊設計

<b>MEINHARDT</b> FACILE CONSULTANT		<b>ARUP</b> STRUCTURAL ENGINEER		<b>CHINA OVERSEAS BUILDING CONSTRUCTION LTD.</b> MAIN CONTRACTOR		<b>PTI Technology and Engineers Ltd</b> ARCHITECT		<b>MTR</b> CLIENT	
B.O. REF : 3/7/97/97/AC(1)									
LEGEND: G01 -- 12mm THK CLEAR EMBEDDED GLASS G02 -- 12mm AIR SPACE G03 -- 12mm THK CLEAR EMBEDDED GLASS (G.U.) MB01 -- (FRAMING) 300X300 3mm THK GAS RHS MB02 -- (FRAMING) 150X100X7.5mm THK GAS RHS									
NOTE: 1. ALL DIMENSIONS ARE IN mm. 2. ALL DIMENSIONS ARE VIEWED FROM OUTSIDE. 3. ALL DIMENSIONS TO BE VERIFIED ON SITE BEFORE FABRICATION. LEGEND: (ST) DETAIL MARK NO. (REV) REVISION SHEET NO. 1. F.F.L. -- FINISHED FLOOR LEVEL 2. S.F.L. -- STRUCTURAL FLOOR LEVEL 3. (R) -- REVERSED DETAIL									
PROJECT : PROPOSED SITE C1 DEVELOPMENT AT AREA B6, TIKOJI 70 RD, TSEUNG KWAN O, NEW TERRITORIES									
TITLE : TYPICAL DETAILS FOR WINDOW-WALL (WW4)									
DATE : 20-NOV-17 SCALE : 1:5 DRAWN BY : C.F. CHECKED BY : M.K. <b>美特铝业有限公司</b> MTR ALUMINIUM PROTECTOR LTD 670 Chu Kai Ling Road, Kowloon Tel: 24882111-4 Fax: (852)7727866 DMC NO. J45-16-WW4-9001 REV : A									



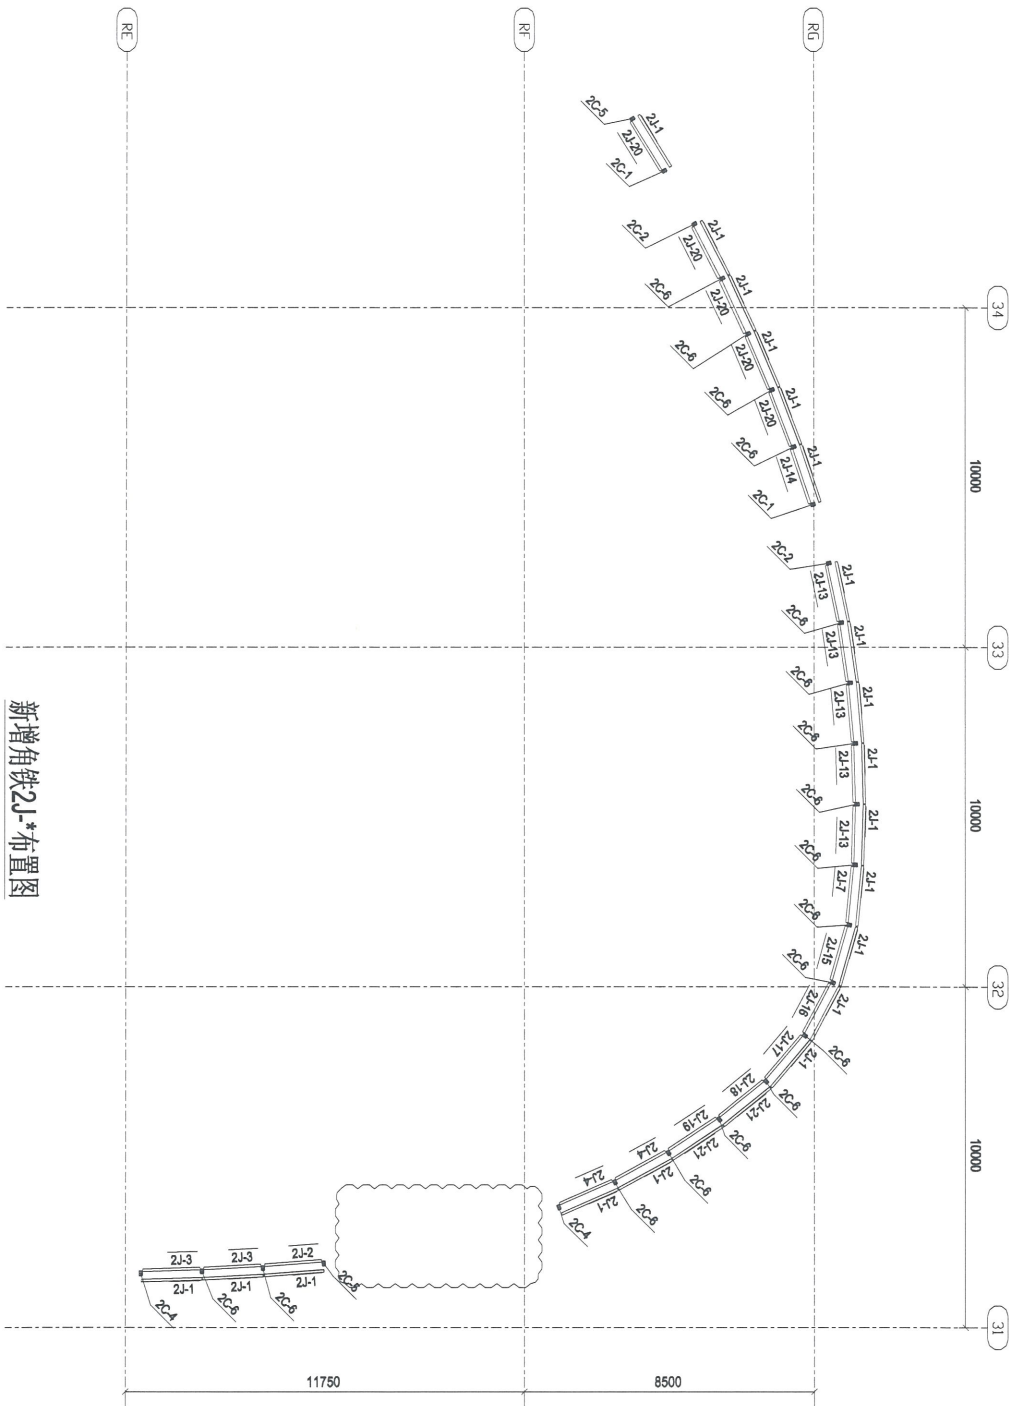

新增角铁2J\*布置图

PART PLAN OF WINDOW-WALL (WW4)  
@2/F Scale: 1/150

Rev	Description	Date
0	第一次报批	2018-10-09

PROJECT:  
PROPOSED SITE C1  
DEVELOPMENT AT AREA 88,  
TKOIT, 70 RP, TSEUNG KWAN O,  
NEW TERRITORIES

CLIENT:  
**美特铝业有限公司**  
MIDAL ALUMINIUM FABRICATOR LTD.  
Units 6-8, Shing Y Industrial Centre, 1/F,  
510 Shiu Kwo Ling Road, Kowloon  
Tel: (2346)9211-4 Fax: (852)27727666

**银同有限公司**  
Silver Town Limited  
Tel: 0769-8335988 Fax: 0769-8335954  
E-MAIL: ADDRESS: 494446@163.COM


DRAWING TITLE :  
PART PLAN  
FOR WINDOW-WALL (WW4)  
@ 2/F

CAO File Name :

Designed by	
Drawn by	
Reviewed by	
Approved by	
Scale	

DWG NO.: J-836-WW4-MP02a


REV.	0
------	---

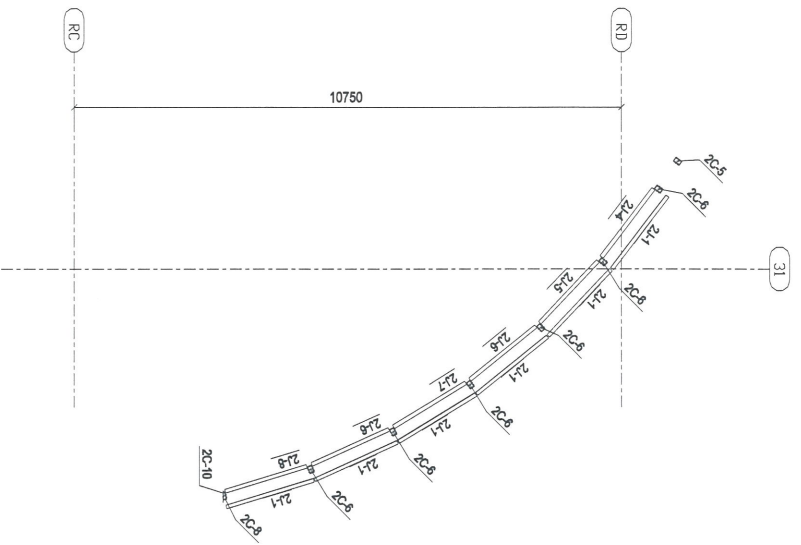

新增角铁21\*布置图

PART PLAN OF WINDOW-WALL (WW4)


@2/F Scale: 1/150

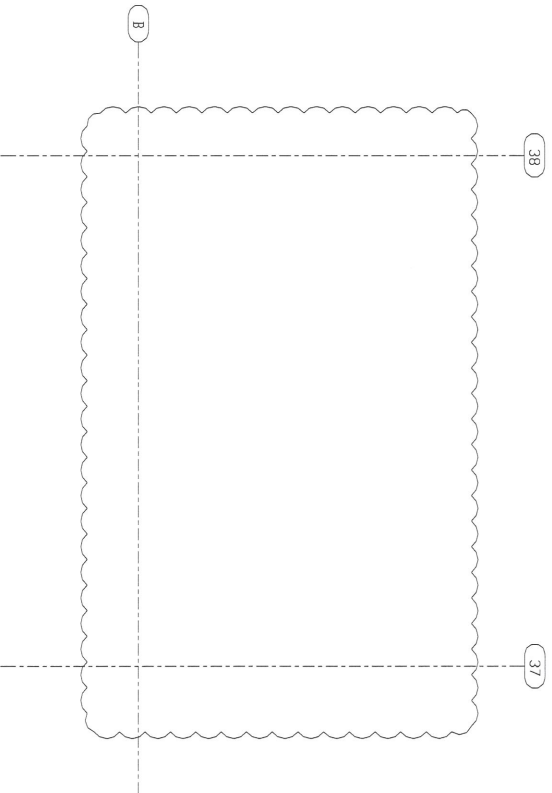

0	第一次批准	2018-10-09
Rev.	Description	Date
PROJECT: PROPOSED SITE C1 DEVELOPMENT AT AREA 86, TR0TL70 RP, TSEUNG KWAN O, NEW TERRITORIES		
CLIENT: 美特铝业有限公司 MIDI ALUMINIUM FABRICATOR LTD. Units 6-8, Sunny Industrial Centre, 1/F 610 Chee Kwo Ling Road, Kwun Tong Tel: (852) 27276665		
DRAWING TITLE : PART PLAN FOR WINDOW-WALL (WW4) @ 2/F		
CAD File Name :		
Designed by :		
Drawn by :		
Reviewed by :		
Approved by :		
Scale :		
DWG NO.: J-836-WW4-MP03a		
REV		
0		

美特铝业有限公司  
MIDI ALUMINIUM FABRICATOR LTD.  
Units 6-8, Sunny Industrial Centre, 1/F  
610 Chee Kwo Ling Road, Kwun Tong  
Tel: (852) 27276665

银同有限公司  
Silver Town Limited  
Tel: 0789-8335498 Fax: 0785-8335954  
E-MAIL: ADMIN@SILVERTOWN.COM

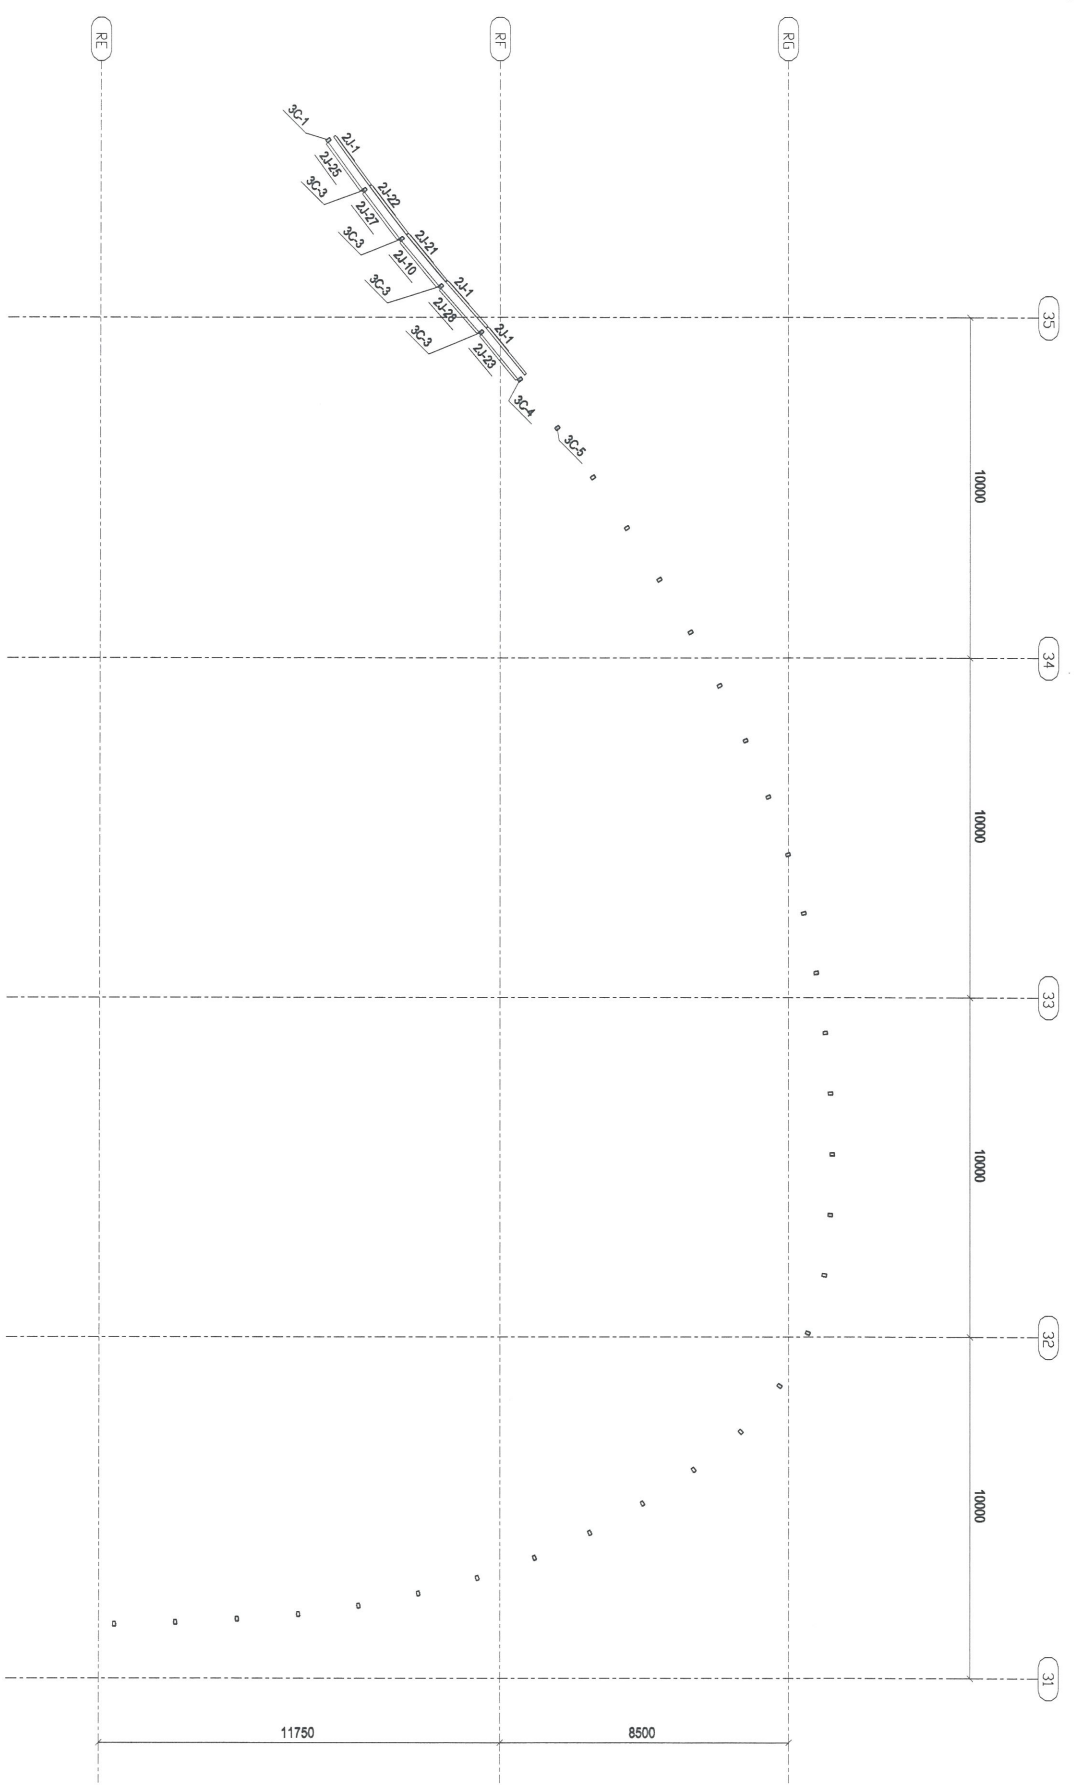

新增角铁21\*布置图

PART PLAN OF WINDOW-WALL (WW4)

@3/F Scale: 1/150

Rev.	Description	Date
0	第一次报建	2016-10-09


PROJECT:  
 PROPOSED SITE C1  
 DEVELOPMENT AT AREA 88,  
 TKO TL 70 RP TSEUNG KWAN O,  
 NEW TERRITORIES

CLIENT:

**S** 银同有限公司  
 Silver Town Limited  
 Tel: 0769-83354968 Fax: 0769-83359954  
 E-MAIL: ADDRESS@silvertown.com.hk, 163.COM

DRAWING TITLE :  
 PART PLAN  
 FOR WINDOW-WALL (WW4)  
 @ 3/F

CAD File Name :	
Designed by	
Drawn by	
Reviewed by	
Approved by	
Scale	
DWG NO. : J-836-WW4-MP04a	REV 0

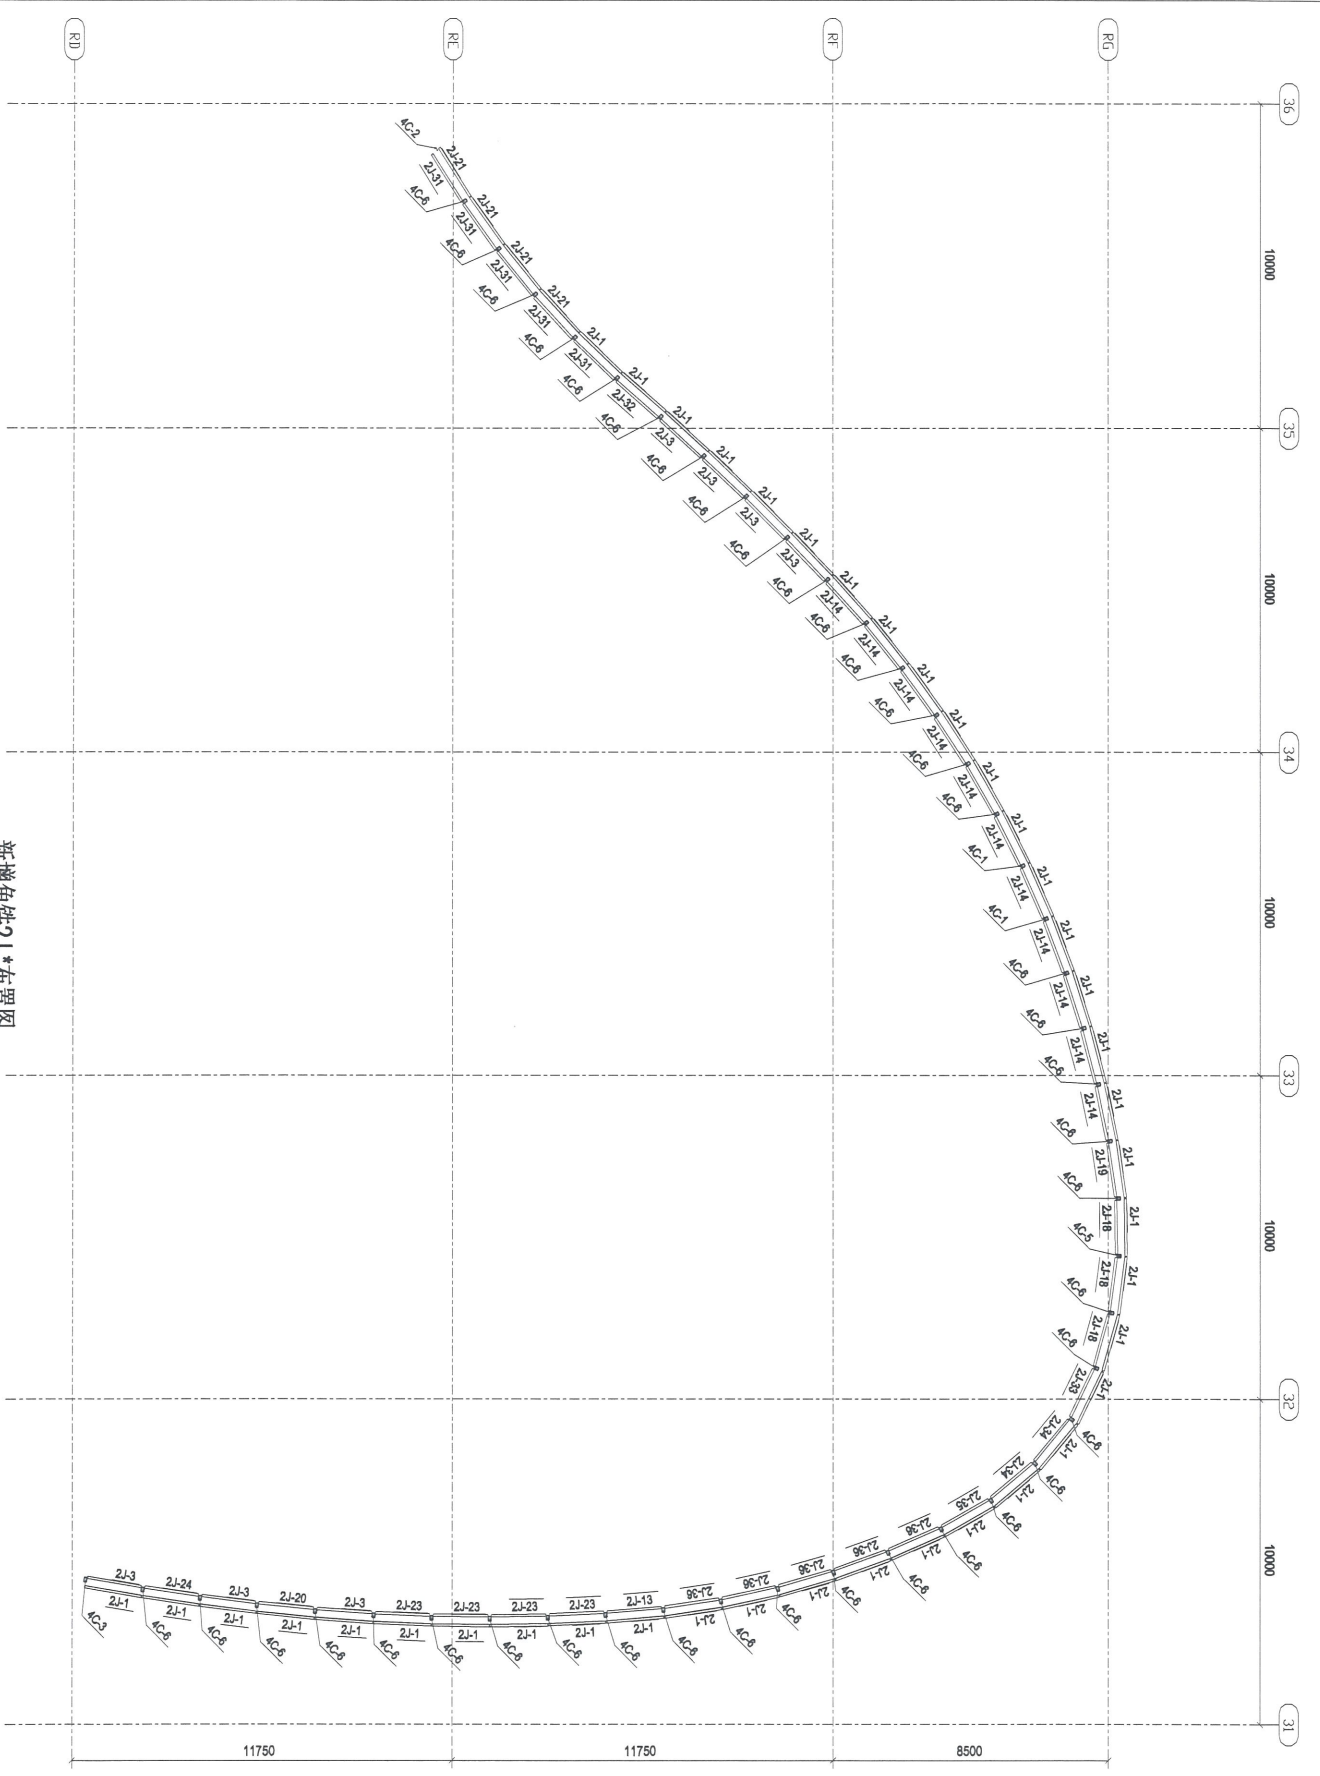

新增角铁2J\*布置图

PART PLAN OF WINDOW-WALL (WW4)

@4/F Scale: 1/150

Rev	Description	Date
0	第一次报批	2018-10-09

PROJECT:  
PROPOSED SITE C1  
DEVELOPMENT AT AREA 86,  
TKOIT TO RP, TSEUNG KWAN O,  
NEW TERRITORIES

CLIENT:  
**美特铝质有限公司**  
MIDI ALUMINIUM FABRICATOR LTD.  
Units 6-8, Sunny Industrial Centre, 1/F  
610 Chu Kwo Ling Road, Kowloon  
Tel: (852) 6921-1-4 Fax: (852) 27270665

**银同有限公司**  
Silver Town Limited  
Tel: (0755) 43534668 Fax: (0755) 43539554  
E-MAIL: ADDRESS: 99@silvertown.com

DRAWING TITLE :  
PART PLAN  
FOR WINDOW-WALL (WW4)  
@ 4/F

CAD File Name :	
Designed by	
Drawn by	
Reviewed by	
Approved by	
Scale	
DWG NO.: J-836-WW4-MP05a	REV 0

附件编号	221	附件数量	69	附件重量	8.41
附件编号	规格(mm)	数量	重量(kg)	重量(kg)	重量(kg)
M589	RSAN/75*50*5	1785	1	8.41	0.45
合计:				8.41	

M589	RSAN/75*50*5 x 1785
构件: 2J-1	

Rev.	Description	Date
0	第一次报批	2018-10-09

PROJECT: PROPOSED SITE C1  
DEVELOPMENT AT AREA 88,  
TKO TI TO RP TSEUNG KWAN O,  
NEW TERRITORIES

CLIENT: 美特銀質有限公司  
MIDI Aluminium Manufacturer Ltd.  
Units 6-8, Sunray Industrial Centre, 1/F  
610 Che Kwo Ling Road, Kowloon  
Tel: 25489211-4 Fax: (852) 27272666

Silver Town Limited  
Tel: 0769-8335498 Fax: 0769-8339954  
E-MAIL: ADDRESS@silvertown.com.hk FAX: 001

DRAWING TITLE: [2J-1]

Designed by	
Drawn by	
Reviewed by	
Approved by	
Scale	
DWG NO.: (MM)A2 - [2J-1]	
RIV	0

零件编号	规格(mm)	长度(mm)	数量	单重(kg)	共重(kg)	表面积(m <sup>2</sup> )
M590	RSAY7550*5	1882	1	7.92	7.92	0.42
合计:						7.92



构件: 2J-2

RSAY7550\*5 x 1882

Rev.	Description	Date
0	第一次报批	2018-10-09

PROJECT: PROPOSED SITE C1  
DEVELOPMENT AT AREA B6,  
TKOTI 70/RP TSEUNG KWAN O,  
NEW TERRITORIES

CLIENT: 美特鋁質有限公司  
MIDI Aluminium Manufacturer Ltd.  
Units 6-8, Sunny Industrial Centre, 1/F  
610 Chee Kwo Ling Road, Kwailoon  
Tel: 23489211-4 Fax: (852) 27272668

Silver Town Limited  
Tel: 0769-8333498 Fax: 0769-8333954  
E-MAIL: ADDRESS@silvertown.com.hk

DRAWING TITLE: [2J-2]

Designed by	
Drawn by	
Reviewed by	
Approved by	
Scale	
DWG NO: (MMAY-2 - [2J-2])	REV: 0

构件编号	21-3	构件数量	9	构件重量	7.95
构件编号	规格(mm)	长度(mm)	数量	单重(kg)	共重(kg)
M591	RSATV750*5	1897	1	7.95	7.95
合计:					7.95

M591	RSATV750*5 x 1897
------	-------------------

构件: 21-3

Rev	Description	Date
0	第一次报批	2018-10-09

PROJECT: PROPOSED SITE C1  
DEVELOPMENT AT AREA 88,  
TKO TL 70 RP TSEJING KWAN O,  
NEW TERRITORIES

CLIENT: 美特铝质有限公司  
MIDI Aluminium Fabrication Ltd.  
Units 6-8, Sunny Industrial Centre, 1/F  
610 Cho Kwo Ling Road, Kowloon  
Tel: 23489211-4 Fax: (852) 2727685

Silver Town Limited  
Tel: 0769-83354868 Fax: 0769-83399554  
E-MAIL ADDRESS: spt@skw.com.hk, 163.COM

DRAWING TITLE :  
[21-3]

CAD File Name :	
Designed by	
Drawn by	
Reviewed by	
Approved by	
Scale	
DWG NO. : (MM)A/2 - [21-3]	REV 0

零件编号	规格(mm)	数量	单重(kg)	总重(kg)	长度(mm)	直径(mm)
M592	RSAY7550*5	1	7.88	7.88	1673	0.42
合计:				7.88		

M592	RSAY7550*5 x 1673
------	-------------------

构件: 2-1-4

Rev.	Description	Date
0	第一次报批	2018-10-09

PROJECT: PROPOSED SITE C1  
DEVELOPMENT AT AREA B6,  
TKO1, TO RP, TSEUNG KWAN O,  
NEW TERRORIES

CLIENT: **美特铝有限公司**  
MIDI ALUMINIUM MANUFACTURE LTD.  
Units 5-8, Sunray Industrial Centre, Y/F  
510 Chee Kwo Ling Road, Kowloon  
Tel: 23489211-4 Fax: (852) 27215566

**银同有限公司**  
Silver Town Limited  
Tel: 0769-8335488 Fax: 0769-8335954  
E-MAIL: AD00855@silvertown.hk

DRAWING TITLE: [2-1-4]

Designated by	
Drawn by	
Reviewed by	
Approved by	
Scale	
DWG NO: (MMW)2 - [2-1-4]	REV. 0



零件编号	21-6	零件数量	2	零件重量	7.82	
零件编号	规格(mm)	长度(mm)	数量	单重(kg)	共重(kg)	表面积(m <sup>2</sup> )
M594	RSAY7550*5	1661	1	7.82	7.82	0.42
合计:					7.82	

M594	RSAY7550*5 x 1661
------	-------------------

构件: 21-6

Rev	Description	Date
0	第一次报批	2018-10-09

PROJECT:  
 PROPOSED SITE C1  
 DEVELOPMENT AT AREA 98,  
 TKO TL70 RP TSEUNG KWAN O,  
 NEW TERRITORIES

CLIENT:  
 **美特经贸有限公司**  
 MID1 ALUMINIUM FABRICATORS LTD.  
 Units 6-8, Sunray Industrial Centre, 1/F  
 610 Chin Kwo Ling Road, Kwai Tsing  
 Tai Po, N.T. HONG KONG  
 Tel: (852) 2717 7666 Fax: (852) 2717 7666

 **银同有限公司**  
 Silver Town Limited  
 Tel: 0769-8335488 Fax: 0769-8339954  
 E-mail: ADDRESS@silvertown.hk, 163.COM

DRAWING TITLE :  
**[21-6]**

CAD File Name :	
Designed by	
Drawn by	
Reviewed by	
Approved by	
Scale	
DWG NO. : (000)A/2 - [21-6]	REV
0	0

物料编号	2J-7	物料数量	2	物料重量	7.83	
物料编号	规格(mm)	长度(mm)	数量	单重(kg)	共重(kg)	表面积(m <sup>2</sup> )
M595	RSN/75*50*5	1692	1	7.83	7.83	0.42
合计:					7.83	



构件: 2J-7

Rev	Description	Date
0	第一次报批	2018-10-09

PROJECT:  
 PROPOSED SITE C1  
 DEVELOPMENT AT AREA 98,  
 TKOTL 70 RP, TSELING KWAN O,  
 NEW TERRITORIES

CLIENT:  
 **美特经贸有限公司**  
 MIDI ALUMINIUM FABRICATORS LTD.  
 Units 6-8, Suncoy Industrial Centre, 1/F  
 610 Chee Kwo Ling Road, Kowloon  
 Tel: 23489211-4 Fax: (852) 2727686

 **银同有限公司**  
 Silver Town Limited  
 Tel: 0769-8335948 Fax: 0769-8335954  
 E-mail: ADDRESS@silvertown.com.hk

DRAWING TITLE :  
**[2J-7]**

CAD File Name :	
Designed by	
Drawn by	
Reviewed by	
Approved by	
Scale	
DWG NO. : (MM)A-2 - [2J-7]	REV.
0	0

零件编号	21-8	零件数量	1	零件重量	7.85	
零件编号	规格(mm)	长度(mm)	数量	单重(kg)	共重(kg)	表面积(m <sup>2</sup> )
M596	RSAN7550*5	1695	1	7.85	7.85	0.42
合计:					7.85	

M596	RSAN7550*5 x 1695
------	-------------------

构件: 21-8

Rev	Description	Date
0	第一次报批	2018-10-09

PROJECT:  
 PROPOSED SITE C1  
 DEVELOPMENT AT AREA 98,  
 TKOIT TO RP TSEUNG KWAN O,  
 NEW TERRITORIES

CLIENT:  
 **美特铝质有限公司**  
 MIDI Aluminium Fabrication Ltd.  
 Units 6-8, Sunray Industrial Centre, 1/F  
 610 Chu Kwo Ling Road, Kwai Tsou  
 Tel: (2388)9211-4 Fax: (852)27271665

 **银同有限公司**  
 Silver Town Limited  
 Tel: (0769-8335)4868 Fax: (0769-8335)9954  
 E-MAIL ADDRESS: sp@silvertown.com.hk

DRAWING TITLE :  
**[21-8]**

CAD File Name :	
Designed by	
Drawn by	
Reviewed by	
Approved by	
Scale	
DWG NO. : (MM)A/2 - [21-8]	REV.
0	0

物料编号	219	物料数量	15	物料重量	8.38
物料编号	规格(mm)	长度(mm)	数量	单重(kg)	共重(kg)
M597	RSN75*50*5	1779	1	8.38	8.38
合计:					8.38

M597	RSN75*50*5 x 1779

构件: 21-9

0	第一次报批	2018-10-09
Rev	Description	Date

PROJECT:  
PROPOSED SITE C1  
DEVELOPMENT AT AREA 88,  
TKOJI TO PP TSEUNG KWAN O,  
NEW TERRITORIES

CLIENT:  
**美特经贸有限公司**  
MIDI ALUMINIUM FABRICATOR LTD.  
Unit 5-8, Sunray Industrial Centre, 1/F  
610 Cho Kwo Ling Road, Kwunshan  
Tel: 23489211-4 Fax: (852) 27127686

**银同有限公司**  
Silver Town Limited  
Tel: 0769-83354868 Fax: 0769-83359854  
E-Mail: ADDRESS@silvertown.hk, 163.COM

DRAWING TITLE :  
**[21-9]**

CAD File Name :	
Designed by	
Drawn by	
Reviewed by	
Approved by	
Scale	
DWG NO. : (MM)A-2 - [21-9]	REV. 0

附件编号	2J-10	附件数量	9	附件重量	8.02
附件编号	RSK/753075	长度(mm)	1704	数量	1
		单重(吨)	8.02	共重(吨)	8.02
		按重(吨)	0.43		
合计:					8.02

MS98	RSK/753075 x 1704
------	-------------------

构件: 2J-10

Rev	Description	Date
0	第一次报批	2018-10-09

PROJECT:  
 PROPOSED SITE C1  
 DEVELOPMENT AT AREA 88,  
 TKOIL 70 RP, TSEUNG KWAN O,  
 NEW TERRITORIES

CLIENT:  
 **美特经贸有限公司**  
 MID1 MIDUNION TRADING CO. LTD.  
 Units 6-8, Sunray Industrial Centre, 1/F  
 610 Chu Kwo Ling Road, Kowloon  
 Tel: 23489211 - 4 Fax: (852) 2727886

 **银同有限公司**  
 Silver Town Limited  
 Tel: 0769-83354868 Fax: 0769-83359954  
 E-mail: ADDRESS@silvertown.com.hk

DRAWING TITLE:  
**[2J-10]**

CAD File Name :	
Designed by	
Drawn by	
Reviewed by	
Approved by	
Scale	
DWG NO. : 000042 - [2J-10]	REV
	0

零件编号	规格(mm)	数量	单重(kg)	共重(kg)	表面积(m <sup>2</sup> )
M599	RSA/75*50*5	1	8.82	8.82	0.46
合计:				8.82	

M599	
	RSA/75*50*5 x 1829

构件: 2J-11

Rev.	Description	Date
0	第一次报批	2018-10-09

PROJECT: PROPOSED SITE C1  
DEVELOPMENT AT AREA B8,  
TKOIL 70 RP TSEUNG KWAN O,  
NEW TERRITORIES

CLIENT: 美特經貿有限公司  
MIDI Aluminium Fabricator Ltd.  
Units 6-8, Sunray Industrial Centre, 1/F  
610 Chu Kwo Ling Road, Kowloon  
Tel: 23489211-4 Fax: (852) 27276685

Silver Town Limited  
Tel: 0769-83354981 Fax: 0769-83359954  
E-MAIL: ADDRESS: design@stl.com.hk

DRAWING TITLE: [2J-11]

CAO File Name :

Designed by	
Drawn by	
Reviewed by	
Approved by	
Scale	
DWG NO.: (MMW)2 - [2J-11]	
REV	0

构件编号:	2J-12	构件数量:	1	构件重量:	8.26
编号	规格(mm)	长度(mm)	数量	单重(kg)	共重(kg)
M600	RS41750*5	1754	1	8.26	8.26
合计:					8.26

M600	RS41750*5 x 1754

构件: 2J-12

0	第一次报批	2018-10-09
Rev.	Description	Date

PROJECT: PROPOSED SITE C1  
DEVELOPMENT AT AREA 08,  
KOTU TO RP, TSELING KIVANO,  
NEW TERRITORIES

CLIENT: 美特 鋸 質 有 限 公 司  
MIDI ALUMINIUM FABRICATOR LTD.  
Units 6-8, Sanyo Industrial Centre, 1/7  
510 Chin Kee Long Road, Kowloon  
Tel: 2389211-4 Fax: (852) 2727886

S 銀同有限公司  
Silver Town Limited  
Tel: 0769-8354968 Fax: 0769-8353954  
E-MAIL ADDRESS: sp@silvertown.hk

DRAWING TITLE: [2J-12]

CAD File Name:	
Designed by	
Drawn by	
Reviewed by	
Approved by	
Scale	
DWG NO.: (MMW)2 - [2J-12]	R/V: 0

料库编号:	21-13	料库数量:	6	料库重量:	7.90
零件编号	规格(mm)	长度(mm)	数量	单重(kg)	共重(kg)
M801	RSAY75*50*5	1678	1	7.90	7.90
合计:					7.90

M801	RSAY75*50*5 X 1678
------	--------------------

构件: 21-13

0	第一次报批	2018-10-09
Rev.	Description	Date

PROJECT: PROPOSED SITE C1  
DEVELOPMENT AT AREA 88,  
TKOTI TO RP TSEING K/M/M/O,  
NEW TERRITORIES


CLIENT: 美特铝有限公司  
MIDI Aluminium Fabricator Ltd.  
Units 6-8, Sunny Industrial Centre, 1/F  
610 Chiu Kwo Ling Road, Kowloon  
Tel: 23489211-4 Fax: (852) 27127685

Silver Town Limited  
Tel: 0769-8334968 Fax: 0769-8339954  
E-MAIL ADDRESS: spsh@skp.com.hk

DRAWING TITLE :  
[21-13]

Designing by	
Drawn by	
Reviewed by	
Approved by	
Scale	
DMG NO.: (MM)A-2 - [21-13]	REV: 0

零件编号	2J-14	零件数量	12	零件重量	7.91	
零件编号	规格(mm)	长度(mm)	数量	单重(kg)	共重(kg)	表面积(m <sup>2</sup> )
M602	RSAT5*50*5	1680	1	7.91	7.91	0.42
合计:				7.91		

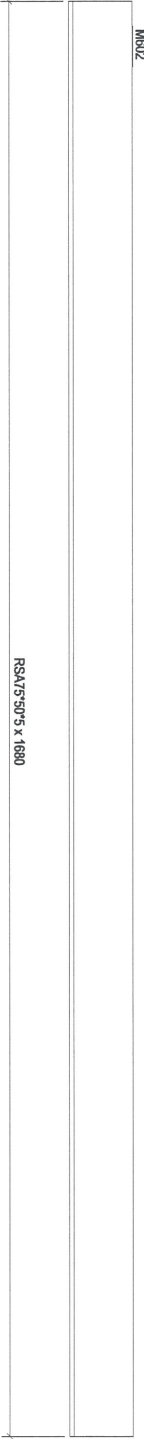

构件: 2J-14

RSAT5\*50\*5 x 1680

Rev.	Description	Date
0	第一次报批	2018-10-09

PROJECT:  
 PROPOSED SITE C1  
 DEVELOPMENT AT AREA 38,  
 TKOTI 70 RP TSEUNG KWAN O,  
 NEW TERRITORIES


CLIENT:  
 **美特经贸有限公司**  
 MIDI ALUMINIUM FABRICTION LTD.  
 Units 6-8, Sunray Industrial Centre, 1/F  
 610 Chin Kwo Ling Road, Kowloon  
 Tel: (2348)9211-4 Fax: (852)2727666

 **银同有限公司**  
 Silver Town Limited  
 Tel: 0769-8335488 Fax: 0769-8339954  
 E-mail: ADDRESS@silvertown.com.hk 163.COM

DRAWING TITLE:  
**[2J-14]**

CAD File Name :	
Designed by	
Drawn by	
Reviewed by	
Approved by	
Scale	
DWG NO. : (000)A/2 - [2J-14]	REV.
	0

附件编号	2115	附件数量	1	附件重量	7.75	
附件编号	规格(mm)	长度(mm)	数量	单重(g)	共重(g)	长乘宽乘高
M603	RSA755015	1646	1	7.75	7.75	0.41
合计:					7.75	

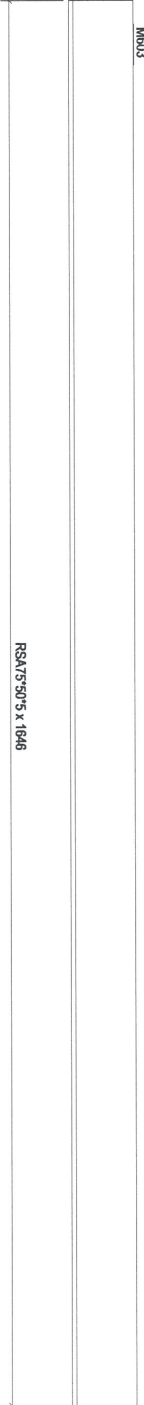

构件: 21-15

Rev	Description	Date
0	第一次报批	2018-10-09

PROJECT:  
 PROPOSED SITE C1  
 DEVELOPMENT AT AREA 88,  
 TKO1L70 RP TSEUNG KWAN O,  
 NEW TERRITORIES

CLIENT:  
 **美特经贸有限公司**  
 MIDI Aluminium Fabricator Ltd.  
 Units 6-8, Sunray Industrial Centre, 1/F  
 610 Chee Kwo Ling Road, Kamshan  
 Tel: 23499211-4 Fax: (852) 27176886

 **银同有限公司**  
 Silver Town Limited  
 Tel: 0769-83354988 Fax: 0769-83359954  
 E-mail: ADDRESS@silvertown.hk, SA.COM

DRAWING TITLE :  
**[21-15]**

CAD File Name :	
Designed by	
Drawn by	
Reviewed by	
Approved by	
Scale	
DWG NO: (MM)A/2 - [21-15]	REV
	0

附件编号	2J-16	附件数量	1	附件重量	7.73	
附件编号	规格(mm)	长度(mm)	数量	单重(kg)	共重(kg)	表面积(m <sup>2</sup> )
M804	RSAT5905	1642	1	7.73	7.73	0.41
合计:				7.73		



构件: 2J-16

Rev	Description	Date
0	第一次报批	2018-10-09

PROJECT:  
 PROPOSED SITE C1  
 DEVELOPMENT AT AREA 88,  
 TKOIL 70 RE TSEUNG KWAN O,  
 NEW TERRITORIES

CLIENT:  
 美特經貿有限公司  
 MID1 Aluminium Fabrication Ltd.  
 Units 6-8, Sunray Industrial Centre, 1/F  
 610 Chu Kwo Ling Road, Kwailoon  
 Tel: 23489211-4 Fax: (852) 27216885

Client Logo:  銀同有限公司  
 Silver Town Limited  
 Tel: 0769-8335488 Fax: 0769-8339954  
 E-mail: ADDRESS@silvertown.com.hk

DRAWING TITLE:  
**[2J-16]**

CAD File Name :	
Designed by	
Drawn by	
Reviewed by	
Approved by	
Scale	
DWG NO.: (MM4)2 - [2J-16]	REV.
	0

附件编号:	2J-17	附件数量:	1	附件重量:	7.75
附件编号	模型(mm)	长度(mm)	数量	重量	长度(mm)
M805	RSAT/50*5	1645	1	7.75	7.75
合计:				7.75	0.41

M805	RSAT/50*5 X 1645
------	------------------

构件: 2J-17

0	第一次报批	2018-10-09
Rev.	Description	Date

PROJECT: PROPOSED SITE C1 DEVELOPMENT AT AREA 88, TKOIT TO RP, TSEUNG KWAN O, NEW TERRITORIES

CLIENT: 美特 鋸 質 有 限 公 司  
MIDI ALUMINIUM FABRICATOR LTD.  
Unit: 6-8, Sunray Industrial Centre, 1/F  
610 Chin Kwo Ling Road, Kamshon  
Tel: 2389211-4 Fax: (852) 27121806

Silver Town Limited  
Tel: 0769-83354988 Fax: 0769-83359554  
E-MAIL ADDRESS: dps@stltd.com.hk, ts@stltd.com

DRAWING TITLE: [2J-17]

CAD File Name :	
Designed by	
Drawn by	
Reviewed by	
Approved by	
Scale	
DWG NO: QMMA/2 - [2J-17]	REV: 0

附件编号:	2J-18	附件数量:	4	附件重量:	7.81
附件编号	规格(mm)	长度(mm)	数量	单重(kg)	总重(kg)
M806	RSN/JS5075	1699	1	7.81	7.81
合计:					7.81

M806	RSN/JS5075 X 1699
------	-------------------

构件: 2J-18

0	第一次报批	2018-10-09
Rev	Description	Date

PROJECT:  
 PROPOSED SITE C1  
 DEVELOPMENT AT AREA 08,  
 TIKOT, 70 RP, TSELING KWAN O,  
 NEW TERRITORIES

CLIENT:  
 **美特 经贸 有限公司**  
 MIDI ALUMINIUM FABRICATOR LTD.  
 Unit 6-8, Sunray Industrial Centre, 1/F  
 610 Chee Kwo Ling Road, Kamson  
 Tel: 23489211-4 Fax: (852) 27121686

 **银同有限公司**  
 Silver Town Limited  
 Tel: 0769-83354988 Fax: 0769-83359554  
 E-MAIL ADDRESS: gpl@sktd.com.hk, ts@sktd.com

DRAWING TITLE :  
**[2J-18]**

CAD File Name :

Designed by	
Drawn by	
Reviewed by	
Approved by	
Scale	

DWG NO.: (MM)A/2 - [2J-18]

REV	0
-----	---

附件编号:	21-19	附件数量:	2	附件重量:	7.87
附件编号	规格(mm)	长度(mm)	数量	单重(kg)	总重(kg)
M807	RS475*50*5	1671	1	7.87	7.87
合计:					7.87

M807	RS475*50*5 x 1671
------	-------------------

构件: 21-19

0	第一次报批	2018-10-09
Rev	Description	Date

PROJECT: PROPOSED SITE C1  
DEVELOPMENT AT AREA 88,  
TKOIT 70 RP, TSEUNG KWAN O,  
NEW TERRITORIES

CLIENT: 美特铝质有限公司  
MIDI Aluminium Fabrication Ltd.  
Units 6-8, Sunray Industrial Centre, 1/F  
610 Cho Kwo Ling Road, Kowloon  
Tel: 23489211-4 Fax: (852) 27270686

Silver Town Limited  
Tel: 0769-83354868 Fax: 0769-83359554  
E-mail: ADDRESS@silvertown.hk, ts.c.com

DRAWING TITLE: [21-19]

CAD File Name :	
Designed by	
Drawn by	
Reviewed by	
Approved by	
Scale	
DWG NO.: 000042 - [21-19]	REV: 0

零件编号:	21-20	零件数量:	6	零件重量:	7.93
物料编号	规格(mm)	长度(mm)	数量	单重(kg)	共重(kg)
M808	RSAY75075	1683	1	7.93	7.93
合计:					7.93

M808	RSAY75075 x 1683
------	------------------

构件: 21-20

0	第一次报数	2018-10-09
Rev	Description	Date

PROJECT: PROPOSED SITE C1  
DEVELOPMENT AT AREA 86,  
TKOIL TO RP, TSEUNG KWAN O,  
NEW TERRITORIES

CLIENT: 美特铝质有限公司  
MIDI ALUMINIUM FABRICATOR LTD.  
Units 5-8, Sanyo Industrial Centre, 1/F  
610 Chee Kwoi Ling Road, Kowloon  
Tel: 23469211-4 Fax: (852) 27270686

Silver Town Limited  
Tel: 0769-83354988 Fax: 0769-83359854  
E-MAIL: ADDRESS: 394sk4@96.163.COM

DRAWING TITLE: [21-20]

CAD File Name :

Designed by	
Drawn by	
Reviewed by	
Approved by	
Scale	
DWG NO.: (MM)A-2 - [21-20]	REV: 0

构件编号	2J-21	构件数量	7	构件重量	8.38
规格(mm)	RSAY75*50*5	长度(mm)	1780	数量	1
				单重(kg)	8.38
				共重(kg)	8.38
				抗震系数	0.45
合计:					8.38

M609	RSAY75*50*5 x 1780
------	--------------------

构件: 2J-21

Rev	Description	Date
0	第一次报批	2018-10-09

PROJECT: PROPOSED SITE C1  
DEVELOPMENT AT AREA 88,  
TKOIL TO RP, TSEUNG KWAN O,  
NEW TERRITORIES

CLIENT: 美特铝质有限公司  
MIDI ALUMINIUM FABRICATOR LTD.  
Units 5-8, Sanyou Industrial Centre, 1/F  
610 Chiu Kwo Ling Road, Kowloon  
Tel: (852) 27172766

Silver Town Limited  
Tel: 0769-83354988 Fax: 0769-83359954  
E-Mail: 4008353@silvertown.com.hk

DRAWING TITLE: [2J-21]

CAD File Name:	
Designed by	
Drawn by	
Reviewed by	
Approved by	
Scale	
DWG NO.: (MMMA)-2 - [2J-21]	REV: 0

物料编号	21-22	物料数量	1	物料重量	8.39
物料编号	规格(mm)	长度(mm)	数量	单重(kg)	共重(kg)
M809	RSK75*50*5	1782	1	8.39	8.39
合计:					8.39

M809	RSK75*50*5 x 1782
------	-------------------

构件: 21-22

Rev	Description	Date
0	第一次报批	2018-10-09

PROJECT: PROPOSED SITE C1 DEVELOPMENT AT AREA 88, TIKOTI 70 RP, TSEJING KWAN O, NEW TERRITORIES

CLIENT: 美特铝质有限公司  
MIDI ALUMINIUM FABRICATOR LTD.  
Units 5-8, Sanyou Industrial Centre, 1/F  
610 Chiu Kwo Ling Road, Kowloon  
Tel: (852) 27270686

Silver Town Limited  
Tel: 0769-83354988 Fax: 0769-83359854  
E-MAIL: ADDRESS: 39, 41, 43, 4079,

构单编号:	21-23	构单数量:	5	构单重量:	7.93
零件编号	规格(mm)	长度(mm)	数量	单重(kg)	共重(kg)
M610	RSAY75*50*5	1884	1	7.93	7.93
合计:					7.93

M610	RSAY75*50*5 X 1884
------	--------------------

构件: 21-23

0	第一次报批	2018-10-09
Rev.	Description	Date

PROJECT: PROPOSED SITE C1  
DEVELOPMENT AT ABEA 08,  
TKOTI 70 RP, TSEING KWAN O,  
NEW TERRITORIES

CLIENT: 美特銀有限公司  
MIDI ASSOCIATED PAPERWORK LTD  
Units 6-8, Sunray Industrial Centre, 1/F  
510 Chu Kwo Ling Road, Kowloon  
Tel: 23489211-4 Fax: (852) 27172685

Silver Town Limited  
Tel: 0769-83354988 Fax: 0769-83359854  
E-MAIL ADDRESS: spsh@stl.com.hk

DRAWING TITLE: [21-23]

CAD File Name :	
Designed by	
Drawn by	
Reviewed by	
Approved by	
Scale	
DMG NO.: (MMA)-2 - [21-23]	REV: 0

构件编号:	21-24	构件数量:	1	构件重量:	7.94
构件编号	规格(mm)	长度(mm)	数量	单重(kg)	共重(kg)
M610	RSN/750*5	1898	1	7.94	7.94
合计:					7.94

M610	RSN/750*5 x 1898
------	------------------

构件: 21-24

Rev.	Description	Date
0	第一次报批	2018-10-09

PROJECT: PROPOSED SITE C1  
DEVELOPMENT AT ABEA 08,  
TKOTI 70 RP, TSEING KWAN O,  
NEW TERRITORIES

CLIENT: 美特铝业有限公司  
MIDI Aluminium Fabricator Ltd.  
Units 6-8, Sunny Industrial Centre, 1/F  
510 Chu Kwo Ling Road, Kowloon  
Tel: 23489211-4 Fax: (852) 27172685

Silver Town Limited  
Tel: 07789-83354968 Fax: 0769-83359554  
E-MAIL: ADDRESS@silvertown.hk

DRAWING TITLE: [21-24]

Design by	
Drawn by	
Reviewed by	
Approved by	
Scale	
DMG NO.: (MMA)-2 - [21-24]	REV: 0

构件编号	2.25	构件数量	3	构件重量	8.03
构件编号	规格(mm)	长度(mm)	数量	单重(kg)	共重(kg)
M811	RSAY75*50*5	1705	1	8.03	8.03
合计:					8.03



构件: 2J-25

Rev.	Description	Date
0	第一次报批	2018-10-09

PROJECT: PROPOSED SITE C1  
DEVELOPMENT AT AREA 88,  
TKOTI 70 RP, TSEING KWAN O,  
NEW TERRITORIES

CLIENT: 美特铝有限公司  
MID1 ALUMINIUM FABRICATORS LTD.  
Units 5-8, Sunray Industrial Centre, 1/F  
610 Chu Kwo Ling Road, Kowloon  
Tel: 23492111-4 Fax: (852) 27172686

Silver Town Limited  
Tel: 07789-83354988 Fax: 0769-8335954  
E-MAIL: ADDRESS@silvertown.hk

DRAWING TITLE: [2J-25]

Design by	
Drawn by	
Reviewed by	
Approved by	
Scale	
DMG NO.: (MMMA)2 - [2J-25]	REV: 0

构件编号:	21-26	构件数量:	2	构件重量:	8.04
编号	规格(mm)	长度(mm)	数量	单重(kg)	共重(kg)
M811	RSX/550*5	1706	1	8.04	8.04
合计:					8.04

M811	RSX/550*5 x 1706
------	------------------

构件: 21-26

0	第一次报批	2018-10-09
Rev.	Description	Date

PROJECT: PROPOSED SITE C1  
DEVELOPMENT AT AREA 88,  
TKOTI TO RP TSEING K/M/M/O,  
NEW TERRITORIES

CLIENT: 美特铝质有限公司  
MIDI Aluminium Fabricator Ltd.  
Units 5-8, Sunray Industrial Centre, 1/F  
610 Chee Kwoi Ling Road, Kowloon  
Tel: 23489211-4 Fax: (852) 27272685

Silver Town Limited  
Tel: 07789-83354988 Fax: 07789-83359554  
E-MAIL ADDRESS: s@silvertown.hk

DRAWING TITLE: [21-26]

Design by	
Drawn by	
Reviewed by	
Approved by	
Scale	
DMG NO.: (MMMA) 2 - [21-26]	REV. 0

构件编号:	2J-27	构件数量:	1	构件重量:	7.98
编号	规格(mm)	长度(mm)	数量	单重(kg)	共重(kg)
M612	RS4/75/30*5	1694	1	7.98	7.98
合计:					7.98

M612	RS4/75/30*5 x 1694
------	--------------------

构件: 2J-27

0	第一次报批	2018-10-09
Rev.	Description	Date

PROJECT: PROPOSED SITE C1 DEVELOPMENT AT AREA 86, TKOIL TO RP, TSEUNG KWAN O, NEW TERRITORIES

CLIENT: 美特铝质有限公司  
MIDI ALUMINIUM FABRICATOR LTD.  
Unit 6-8, Sunray Industrial Centre, 1/F  
610 Che Kwo Ling Road, Kwun Tong  
Tel: 23469211-4 Fax: (852) 27127886

Silver Town Limited  
Tel: 0769-83354988 Fax: 0769-83359554  
E-MAIL ADDRESS: sp@silvertown.com.hk

DRAWING TITLE: [2J-27]

CAD File Name :

Designed by	
Drawn by	
Reviewed by	
Approved by	
Scale	

DWG NO.: (MM)A/2 - [2J-27]

REV	0
-----	---

物料编号	21-28	物料数量	1	物料重量	7.95
物料编号	规格(mm)	长度(mm)	数量	单重(kg)	共重(kg)
M613	RSAY750*5	1689	1	7.95	7.95
合计:					7.95

M613	RSAY750*5 x 1689
------	------------------

构件: 21-28

Rev.	Description	Date
0	第一次报批	2018-10-09

PROJECT: PROPOSED SITE C1  
DEVELOPMENT AT AREA 88,  
TKOIL TO RP TSEUNG KWAN O,  
NEW TERRITORIES

CLIENT: 美特鋁質有限公司  
MIDI Aluminium Fabricator Ltd.  
Units 5-8, Sanyo Industrial Centre, 1/F  
610 Chiu Kwo Ling Road, Kowloon  
Tel: 23489211-4 Fax: (852) 27272686

Silver Town Limited  
Tel: 0769-83354868 Fax: 0769-83359554  
E-MAIL: ADDRESS: 99sk@kwha.hk, 163.COM

DRAWING TITLE: [21-28]

CAD File Name :	
Designed by	
Drawn by	
Reviewed by	
Approved by	
Scale	
DWG NO.: (MMMA)-2 - [21-28]	REV: 0

构件编号	规格(mm)	数量	单重(kg)	共重(kg)	重量(m³)
M614	RSN75*50*5	1	8.01	8.01	0.43
合计:				8.01	

M614	RSN75*50*5 x 1701
------	-------------------

构件: 21-29

Rev.	Description	Date
0	第一次报批	2018-10-09

PROJECT: PROPOSED SITE C1  
DEVELOPMENT AT AREA 88,  
TKO170 RP, TSEUNG KWAN O,  
NEW TERRITORIES

CLIENT: **美特铝有限公司**  
MID1 Aluminium Fabrication Ltd.  
Units 5-8, Sunray Industrial Centre, 1/F  
610 Chu Kwo Ling Road, Kowloon  
Tel: 23892111-4 Fax: (852) 27127066

**银同有限公司**  
Silver Town Limited  
Tel: 0769-83354968 Fax: 0769-83359854  
E-MAIL: ADMIN@SSTOWN.COM.hk

DRAWING TITLE: [21-29]

CAD File Name :

Designed by	
Drawn by	
Reviewed by	
Approved by	
Scale	
DMG NO.: (MM)A-2 - [21-29]	REV: 0

料号	规格	数量	单重	共重	备注
M615	RS475*50*5	1	8.02	8.02	0.43
合计:		1	8.02	8.02	

M615	RS475*50*5 x 1703
------	-------------------

构件: 21-30

Rev.	Description	Date
0	第一次报批	2018-10-09

PROJECT: PROPOSED SITE C1  
DEVELOPMENT AT AREA 88,  
TKOTI 70 RP, TSEUNG KWAN O,  
NEW TERRITORIES

CLIENT: 美特铝有限公司  
MID1 ASHURUDA FABRICATORS LTD.  
Units 6-8, Sunray Industrial Centre, 1/F  
610 Chiu Kwo Ling Road, Kowloon  
Tel: 23892111-4 Fax: (852) 27272685

Silver Town Limited  
Tel: 0769-83354968 Fax: 0769-83359854  
E-Mail: ADDRESS@silvertown.hk

DRAWING TITLE: [21-30]

CAD File Name:	
Designed by:	
Drawn by:	
Reviewed by:	
Approved by:	
Scale:	
DMG NO.: (MMW)1-2 - [21-30]	REV: 0

构件编号:	2J-31	构件数量:	5	构件重量:	8.04
编号	规格(mm)	长度(mm)	数量	单重(kg)	共重(kg)
M616	RSAY75*50*5	1707	1	8.04	8.04
合计:					8.04



构件: 2J-31

Rev.	Description	Date
0	第一次报批	2018-10-09

PROJECT: PROPOSED SITE C1  
DEVELOPMENT AT AREA 88,  
TKO TI TO RP, TSEUNG KWAN O,  
NEW TERRITORIES

CLIENT: 美特铝质有限公司  
MIDI Aluminium Fabricator Ltd.  
Units 5-8, Sunny Industrial Centre, 1/F  
610 Chee Kwo Ling Road, Kowloon  
Tel: 23892111-4 Fax: (852) 2727656

Silver Town Limited  
Tel: 07789-8334968 Fax: 07789-8339954  
E-MAIL ADDRESS: sgsh@stl.com.hk

DRAWING TITLE: [2J-31]

CAD File Name :

Designed by	
Drawn by	
Reviewed by	
Approved by	
Scale	
DMG NO.: (MMMA)-2 - [2J-31]	REV: 0

构件编号	规格(mm)	长度(mm)	数量	单重(kg)	共重(kg)	重量(m)
M817	RS475*50*5	1693	1	7.97	7.97	0.42
合计:					7.97	

M817	RS475*50*5 x 1693
------	-------------------

构件: 2J-32

Rev.	Description	Date
0	第一次报批	2016-10-09

PROJECT: PROPOSED SITE C1  
DEVELOPMENT AT AREA 88,  
TKO TI TO RP TSEUNG KWAN O,  
NEW TERRITORIES

CLIENT: 美特铝质有限公司  
MIDI ALUMINIUM FABRICATOR LTD.  
Units 5-8, Sunray Industrial Centre, 1/F  
610 Chee Kwo Ling Road, Kowloon  
Tel: (852) 27172686

Silver Town Limited  
Tel: 0789-8335488 Fax: 0789-8335954  
E-MAIL: ADDRESS@silvertown.hk


DRAWING TITLE: [2J-32]

CAD File Name :

Designed by	
Drawn by	
Reviewed by	
Approved by	
Scale	
DWG NO.: (MMMA)-2 - [2J-32]	REV: 0

构件编号:	21-33	构件数量:	1	构件重量:	7.88
零件编号	规格(mm)	长度(mm)	数量	单重(kg)	共重(kg)
M618	RSAY75*50*5	1630	1	7.88	7.88
合计:					7.88

M618

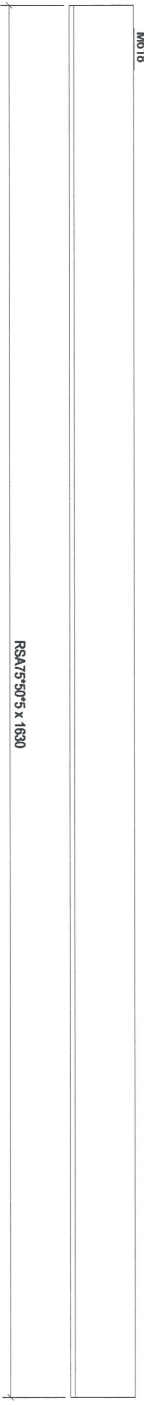

RSAY75\*50\*5 x 1630

构件: 21-33

Rev.	0	第一次报批	2018-10-09
Description			
Date			

PROJECT: PROPOSED SITE C1  
DEVELOPMENT AT AREA 88,  
KOTI 70 RP TSEUNG KWAN O,  
NEW TERRITORIES

CLIENT: 美特铝业有限公司  
MIDI Aluminium Fabrication Ltd.  
Units 5-8, Sunny Industrial Centre, 1/F  
610 Chee Kwo Ling Road, Kowloon  
Tel: 23489211-4 Fax: (852) 27272685

银同有限公司  
Silver Town Limited  
Tel: 0769-8335698 Fax: 0769-8335954  
E-MAIL ADDRESS: spsh@stwp.hk, stc@stwp.hk

DRAWING TITLE: [21-33]

Design by	
Drawn by	
Reviewed by	
Approved by	
Scale	
DMG NO.: (MMW)-2 - [21-33]	REV: 0

零件编号:	21-34	零件数量:	2	零件重量:	7.77
物料编号:	RSN/75-50'5	长度(mm)	1690	重量	共重(kg)
M619	RSN/75-50'5	1690	1	7.77	0.41
合计:					7.77

M619	RSN/75-50'5 x 1690
------	--------------------

构件: 21-34

0	第一次报批	2016-10-09
Rev.	Description	Date

PROJECT: PROPOSED SITE C1  
DEVELOPMENT AT AREA 88,  
TKO17 TO RP, TSEUNG KWAN O,  
NEW TERRITORIES

CLIENT: 美特 鋁 質 有 限 公 司  
MIDI ALUMINIUM FABRICATOR LTD  
Units 6-8, Sunny Industrial Centre, 1/F  
510 Chin Kwo Ling Road, Kowloon  
Tel: 23489211-4 Fax: (852) 27272686

Silver Town Limited  
Tel: 0769-83354968 Fax: 0769-83359854  
E-MAIL: ADDRESS@silvertown.com.hk

DRAWING TITLE: [21-34]

CAD File Name :	
Designed by	
Drawn by	
Reviewed by	
Approved by	
Scale	
DWG NO.: (MMW)-2 - [21-34]	R/W
	0

构件编号	规格(mm)	长度(mm)	数量	单重(kg)	共重(kg)	重量(m)
M620	RSAY/5-50*5	1694	1	7.79	7.79	0.41
合计:					7.79	

M620	RSAY/5-50*5 x 1694
------	--------------------

构件: 2J-35

Rev.	Description	Date
0	第一次报批	2018-10-09

PROJECT:  
 PROPOSED SITE C1  
 DEVELOPMENT AT AREA 88,  
 TOKTI TO RP TSEUNG KWAN O,  
 NEW TERRITORIES

CLIENT:  
 **美特铝质有限公司**  
 MID1 ALUMINIUM MANUFACTURE LTD.  
 Units 6-8, Sunny Industrial Centre, 1/F  
 610 Chee Kwoi Ling Road, Kowloon  
 Tel: 23489211-4 Fax: (852) 27172686

 **银同有限公司**  
 Silver Town Limited  
 Tel: 0769-83354988 Fax: 0769-83359954  
 E-Mail: ADDRESS@silvertown.hk, ts.c.com

DRAWING TITLE:  
**[2J-35]**

CAD File Name :	
Designed by	
Drawn by	
Reviewed by	
Approved by	
Scale	
DWG NO.: (WMA)-2 - [2J-35]	R/W
	0

构件编号	21-36	构件数量	5	构件重量	7.90
构件编号	规格(mm)	长度(mm)	数量	单重(kg)	共重(kg)
M821	RSAY75*50*5	1676	1	7.90	7.90
合计:					7.90



构件: 21-36

Rev	Description	Date
0	第一次报批	2018-10-09

PROJECT: PROPOSED SITE C1  
DEVELOPMENT AT AREA 88,  
TKO TL70 RP TSEANG KWAN O,  
NEW TERRITORIES

CLIENT: 美特经贸有限公司  
MIDI Aluminium Fabrication Ltd.  
Units 5-8, Sunray Industrial Centre, 1/F  
610 Cho Kwo Ling Road, Kowloon  
Tel: 23489211-4 Fax: (852) 27127666

Silver Town Limited  
Tel: 0769-83354868 Fax: 0769-83399554  
E-MAIL ADDRESS: dps@silvertown.com.hk, ts@silvertown.com.hk

DRAWING TITLE: [21-36]

CAD File Name :

Scale	REV
	0

DWG NO.: (MM)A/2 - [21-36]