

工程指示 / 要求簡箋(E.I.)

工程指示編號：EI/ 9448 /18 修改版次：  
 工程編號：J836 工程名稱：日出東城7期平台  
 工程項目：WW2 試水箱 鐵件  
 收件人：Maggie Lor 發件人：李耀鵬 日期：2018/6/19

要求提供 /  確認 事項：

- 初步鋁料 B.M.                       加工拆圖，然後生產                       尺寸表
- 正式鋁料 B.M.                       技術上資料 / 指示                       報價
- 配件 B.M.                               樣辦或貨品說明書                       分判合約
- 其他：\_\_\_\_\_

內容：

煩請按附件資料，安排生產 WW2 試水箱 鐵件送試水場  
 (大隻會再分開批出生產)

驗料：100% 自測      10% 磁粉

請在 2018/7/19 前完成上列要求。

附有關圖紙 / 文件：

16頁

以上項目為：

- 原合約工程包                       原合約工程加 / 減賬                       新工程報價

原因：-

分發東莞各部門：

- 生產技術總監  連附件     技術部     連附件     生產部     連附件     機械設計部  連附件
- 採購部     連附件     生產統籌部  連附件
- 質檢部     連附件     會計部     連附件     報關組     連附件     其他 \_\_\_\_\_  連附件

分發香港各部門：


- 行政部  連附件     會計部  連附件     統籌部  連附件     工程部地盤科文  連附件
- 採購部  連附件     QS 部     連附件     維修部  連附件     其他 \_\_\_\_\_  連附件


傳遞編號：

發件人簽署：

項目經理簽署：


for Pmc

 <b>美特铝质有限公司</b> MIDI Aluminium Fabricator Ltd.		工程號: J836-WW2 地盤名稱: 日出康城7期平台 項目類別: 幕牆 MW2 玻璃 修改版次:	計算: 14/06/2018 日期: 14/06/2018 送呈:								
核對: 14/06/2018 日期: 14/06/2018 副本:		批准:									
A/C Code: 鐵件總重量KG: 71835.09											
序號	修改內容	鐵件圖號	鐵件名稱	顏色	實用	後備	總數	單位	單件 (kg)	總重量 (kg)	備註
1	✓	P-1	4mm鐵板	GMS+UCT802580XL(A)- 3, LIGHT GREY	828	0	<del>828</del>	件	0.050	41.599	<del>2F/4F</del> 20件
2	✓	SB1-1	200*100*8mm扁通+15*40*3mm鐵槽	GMS+UCT802580XL(A)- 3, LIGHT GREY	56	0	<del>56</del>	件	67.899	3802.344	<del>3F</del> 6支
3	✓	SB2-1	150*100*8mm扁通+25*25*3mm角鐵	GMS+UCT802580XL(A)- 3, LIGHT GREY	22	0	<del>22</del>	件	50.183	1104.026	<del>2F</del> 3支
4	✓	SB2-2	150*100*8mm扁通+73*40*3mm鐵槽	GMS+UCT802580XL(A)- 3, LIGHT GREY	22	0	<del>22</del>	件	56.548	1244.056	<del>2.5F</del> 3支
5	✓	SB2-3	150*100*8mm扁通+15*40*3mm鐵槽	GMS+UCT802580XL(A)- 3, LIGHT GREY	28	0	<del>28</del>	件	50.980	1427.440	<del>4F</del> 3支
6	✓	<del>SB2-4</del>	<del>150*100*8mm扁通+25*25*3mm角鐵</del>	<del>GMS+UCT802580XL(A)- 3, LIGHT GREY</del>	6	0	<del>6</del>	<del>件</del>	<del>50.183</del>	<del>301.098</del>	<del>2F</del>
7	✓	<del>SB2-5</del>	<del>150*100*8mm扁通+73*40*3mm鐵槽</del>	<del>GMS+UCT802580XL(A)- 3, LIGHT GREY</del>	6	0	<del>6</del>	件	56.548	339.288	<del>2.5F</del>
8	✓	<del>SB3-1</del>	<del>300*200*8mm扁通</del>	<del>GMS+UCT802580XL(A)- 3, LIGHT GREY</del>	28	0	<del>28</del>	件	100.672	2818.816	<del>2F</del>
9	✓	SB4-1	60*60*5mm角鐵	GMS+UCT802580XL(A)- 3, LIGHT GREY	28	0	28	件	7.591	212.548	3支 2F
10	✓	SC-1	15mm鐵板+80*80*5方通+120*80*5扁通	GMS+UCT802580XL(A)- 3, LIGHT GREY	1	0	1	件	2042.042	2042.042	1支 4F
11	✓	SC-2	15mm鐵板+80*80*5方通+120*80*5扁通	GMS+UCT802580XL(A)- 3, LIGHT GREY	27	0	<del>27</del>	件	2048.512	55309.824	2支 2F/2.5F/3F/4F
12	✓	SC2-1	150*100*8mm扁通	GMS+UCT802580XL(A)- 3, LIGHT GREY	28	0	28	件	30.613	857.164	3支 2F/2.5F
13	✓	SC-3	15mm鐵板+80*80*5方通+120*80*5扁通	GMS+UCT802580XL(A)- 3, LIGHT GREY	1	0	1	件	2042.042	2042.042	1支 4F
14	✓	SM-1	200*150*10mm角鐵	GMS+UCT802580XL(A)- 3, LIGHT GREY	61	0	61	件	4.800	292.800	10件 4F
合計:					1142	件	71835.087	件	71835.087		

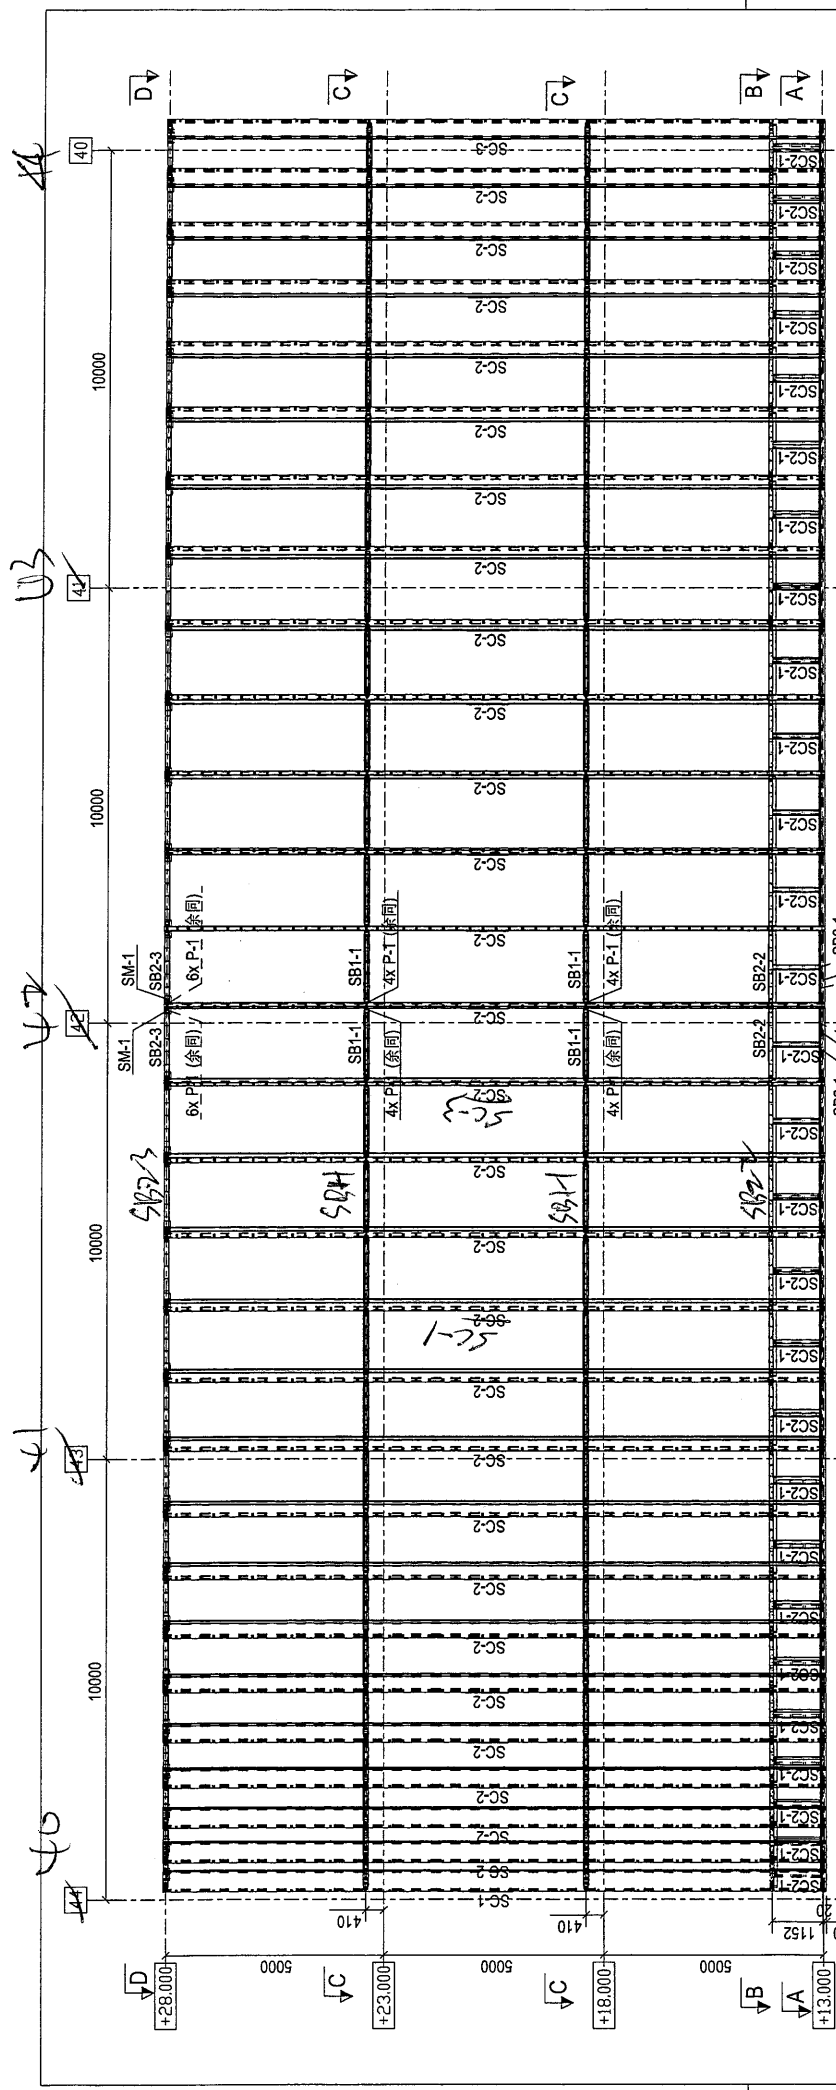

Proj.	第一次报批	Date	2018-06-13
PROJECT:			
PROPOSED SITE C1 DEVELOPMENT AT AREA 88 TKOTL TO RP TSEUNG KWAN O, NEW TERRITORIES			
CLIENT:			
<b>美特铝质有限公司</b> MIDI Aluminium Fabrication Ltd. Unit: 105, Sunny Industrial Centre, 1/F 690 Shek Mao Ling Road, Tseung Kwan O, N.T. T.S.E. 22 005			
<b>銀同有限公司</b> Silver Town Limited 10/F, 235-237A, 239-241, 243-245 Cheong Cheong Street, Tseung Kwan O, N.T. T.S.E. 22 005			
DRAWING TITLE:			
WINDOW-WALL (WW2) ELEVATION			
C.C. File Name:			
Designed by:			
Drawn by:			
Prepared by:			
Approved by:			
Scale:			
DWG NO.:			J-886-WW2-MP01
REV.			0

ELEVATION OF WINDOW WALL WW2

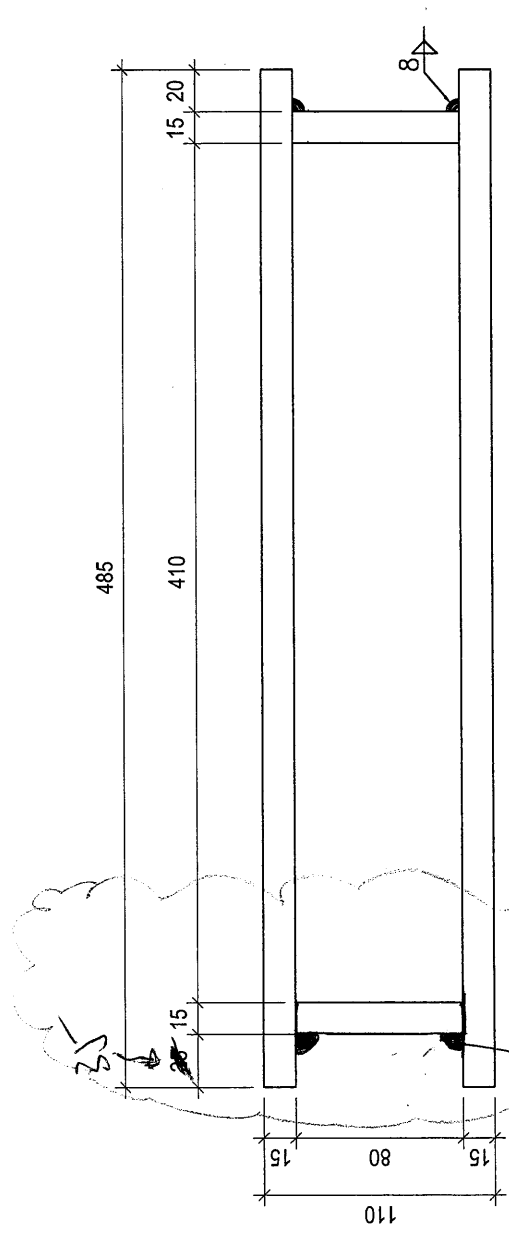

MB01 拼接示意图

INSIDE

Inner Filler used Full Corrosion

SC-3 x 1

SC-2 x 2

SC-1 x 1

total 4 支

OUTSIDE


0	第一次报批	2018-06-13
Rev.	Description	Date
PROJECT: PROPOSED SITE C1 DEVELOPMENT AT AREA B6, TKOTL 70 RD, TSEUNG KWAN O, NEW TERRITORIES		
CLIENT: 美特铝质有限公司 MITI ALUMINUM FABRI-TOE LTD. 122-15, Kwai Yee Road, Kwai Sai, Tsing Yi, New Territories Tel: 24682114 Fax: 246272766		
银同有限公司 Silver Town Limited 14/F, 148-150, Kwai Yee Road, Kwai Sai, New Territories E-MAIL: ADDRESS@silvertown.com		
DRAWING TITLE:		
MB01 拼接示意图		
CAD File Name:		
Designed by		
Drawn by		
Reviewed by		
Approved by		
Scale		
DWG NO.: J-836-IWV2-MB01		REV. 0







20 件

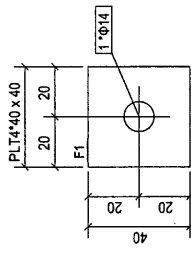


构件: P-1

构件编号: P-1		物料名称: 708-400		单件重量: 0.1	
零件编号	规格(mm)	数量	重量	共重(kg)	表面面积
F1	PLT4*40	1	0	0.05	0.00
		合计:		0.05	


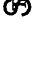
0	第一次报数	2018-06-13
Rev:	Description	Date
PROJECT: PROPOSED SITE C1 DEVELOPMENT AT AREA 86, TR01/70 RP, TSEUNG KWAN O, NEW TERRITORIES		
CLIENT:  美特铝质有限公司 MTR MIDT Aluminium Fabricator Ltd. Units 1-6, Sunny Industrial Centre, 1/F 410 Shek Kwoi Road, Tseung Kwan O, New Territories, Hong Kong Tel: 3438-1111 Fax: 3438-1106		
S 银同有限公司 Silver Town Limited 1120-1123, 3/F, 366-368, 369-371, 372-373, 374-375, 376-377, 2578-2579, 2580-2		

物料编号:	SM-1	物料名称:	4.0
物料规格:	SM-1	长度(mm):	150
物料重量:	4.0	重量(kg):	4
物料数量:	4	表面面积(m <sup>2</sup> ):	0.11
物料编号:	M18	规格(mm):	RSA200*150*10
物料数量:	1	重量(kg):	4.00
物料重量:	4.00	表面面积(m <sup>2</sup> ):	0.11
合计:	4.00		

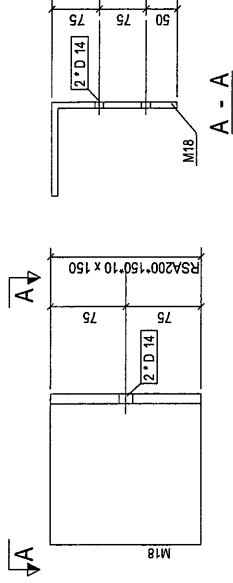

构件: SM-1


842 = 10 件

Rev:	0	第一次报批	2018-06-13
Rev:		Description	Date
PROJECT:	PROPOSED SITE C1 DEVELOPMENT AT AREA 86 TKOTI TO PP TSEUNG KWAN O, NEW TERRITORIES		
CLIENT:	 <b>美特铝质有限公司</b> MIDU Aluminium Fabrication Ltd. Units 4-6, Suncor Industrial Centre, 1/F 610 Chee Koo Ling Road, Tseung Kwan O, New Territories Tel: 3482111-4 Fax: 3482112		
	 <b>银同有限公司</b> Silver Town Limited Unit 10-12, 13, 14, 15, 99, 100 Cheung Chee Street, Tseung Kwan O, New Territories		
DRAWING TITLE:	[SM-1]		
C. G. File Name:			
Designed by:			
Drawn by:			
Checked by:			
Reviewed by:			
Scale:			
DWG NO.:	J-836-WW2-[SM-1]		
Rev:	0		


6

零件编号	规格	数量	重量 (kg)	共重 (kg)	件数占比 (%)	重量占比 (%)
M12	RHS200*100*8.0	1661	58	57.84	0.86	0.86
M16	SHS40*40*3.0 半支	1449	3	2.59	0.23	0.23
M17	SHS40*40*3.0 半支	1533	2	4.55	0.23	0.23
合计:					65.08	

7.78 = 6.2

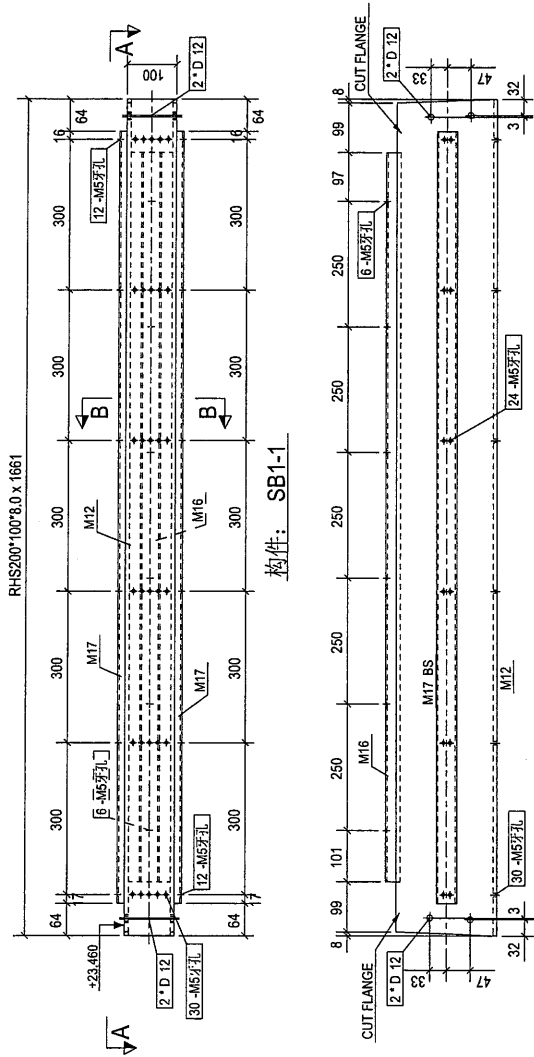


A - A

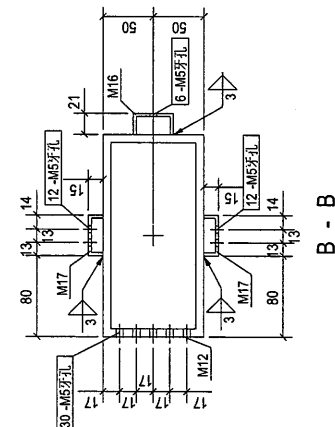


B - B

Rev.	第一次报批	2018-06-13
PROJECT:	PROPOSED SITE C1 DEVELOPMENT AT AREA 08, KROH, W.P. TSEUNG KWAN O, NEW TERRITORIES	
CLIENT:	<b>美特铝质有限公司</b> MIDT Aluminium Extrusion Ltd. Unit: 105, Sun's Industrial Centre, 1/F 510 Chu Kuo Ling Road, Kowloon TEL: 34321114 Fax: 34321965	
	<b>银同有限公司</b> 105 Cheung Kuo Ling Road, Kowloon China 4060299@silvertown.com.hk	
DRAWING TITLE:	[SB1-1]	
CAD File Name:		
Designed by		
Drawn by		
Checked by		
Approved by		
Scale		
DWG NO.:	J-836-WW2-[SB1-1]	
REV		0


物料编号	SB2-1	构件数量	49.8
规格	RHS150*100*8.0	长度(mm)	1661
M6	1	重量(kg)	47
M13	2	重量(kg)	1.83
合计:			49.22

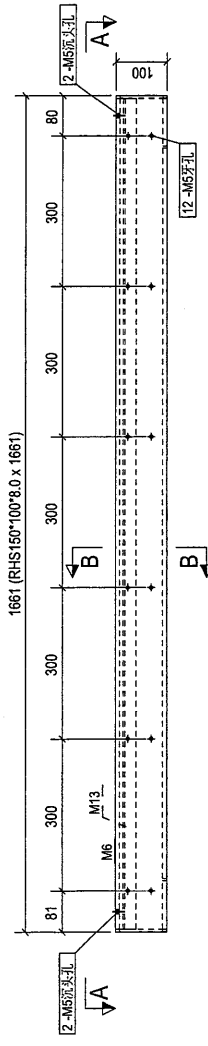

构件: SB2-1

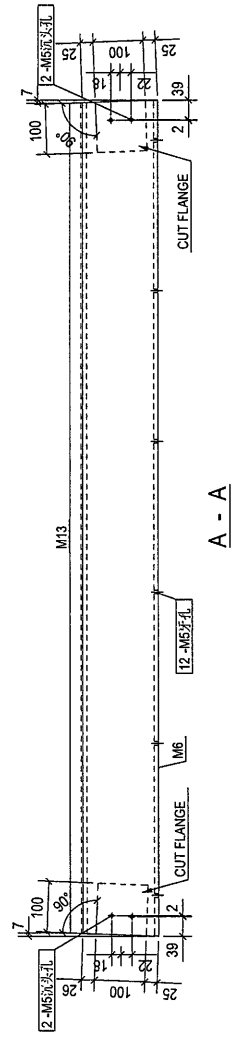

A - A

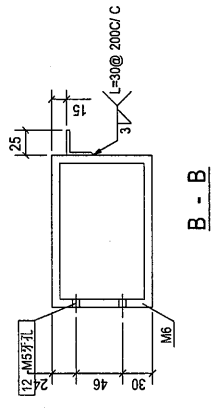


B - B

共 3 支


0	第一次报批	2018-06-13
Rev.	Description	Date
PROJECT: PROPOSED SITE C1 DEVELOPMENT AT AREA B6, TROTIL TO RP TSEUNG KWAN O, NEW TERRITORIES		
CLIENT: 美特铝业有限公司 MIDI ALUMINIUM FABRICATOR LTD. Units 1-4, Sunny Industrial Centre, 1/F 100, Tseung Kwan O Road, Tseung Kwan O, N.T. Tel: 2388 1111 Fax: 2388 2266		
S Silver Town Limited 1370-933588 fax: 93352251 1-800-488 8888		
PROJECT TITLE: [SB2-1]		
C/F File Name:		
Designed by:		
Drawn by:		
Reviewed by:		
Scale:		
DWG NO: J-836-WW2-[SB2-1]		REV: 0



零件编号	SB2-3	构件名称	SB2
尺寸(mm)	1661	数量	1
重量(kg)	48	共重(kg)	47.61
表面处理	半支	备注	48.89

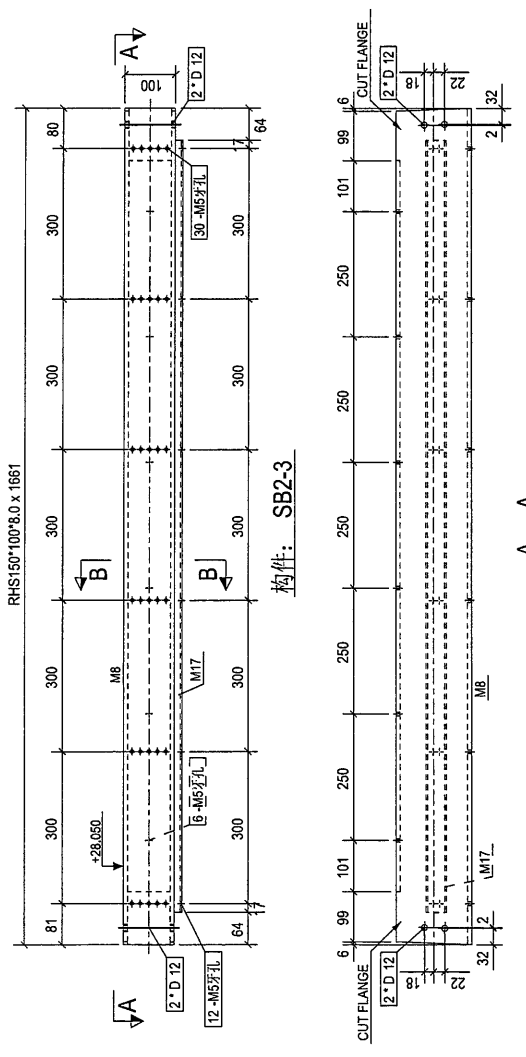

75/82 3 友

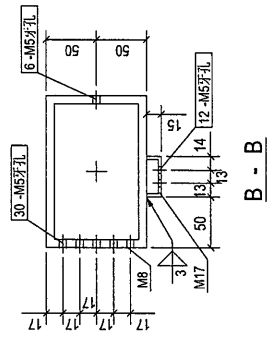


A - A

B - B

0	第一次核批	2018-06-13
Rev.	Description	Date
PROJECT: PROPOSED SITE C1 DEVELOPMENT AT AREA 08, TIKOTI TORP TSEUNG KWANO, NEW TERRITORIES		
CLIENT: 美特铝质有限公司 MIDI Aluminium Fabrication Ltd. Unit 3, 4-6, Sunny Industrial Estate, 1/F, 210 Chee Koo Tong Road, Tseung Kwan O, New Territories, Hong Kong Tel: 23392111-1, 23392122, 23392123		
SILVER TOWN LIMITED Silver Town Limited 142/F, 2-3, 3-6, 4-6, 5-6, 1566-6,		




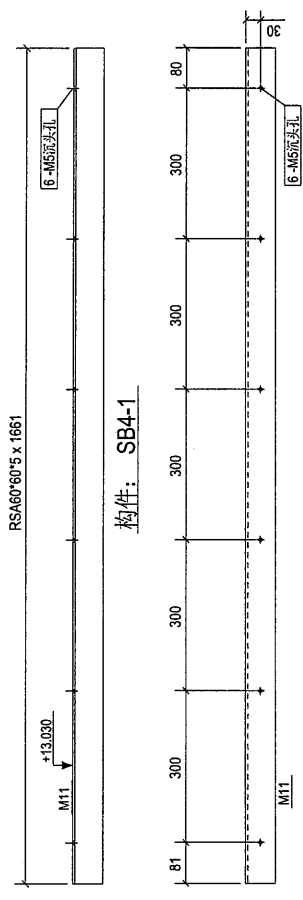

共 3 支


零件号: SB4-1		物料名称: 2#		零件重量: 7.6	
零件编号	数量	长度(mm)	重量	共重(kg)	表面面积
M11	1	1661	7.50	7.50	0.38
合计:				7.50	

0	第一次报批	2018-06-13
File:	Description	Date:
PROJECT: PROPOSED SITE C1 DEVELOPMENT AT AREA 86 TR01 TO RP, TSEUNG KWAN O, NEW TERRITORIES		
CLIENT: 美特铝质有限公司 MIDI ALUMINIUM FABRICATOR LTD. Unit 1-6, Alley Industrial Estate, 1/F, 410 Chee Koo Street, Tseung Kwan O, N.T. Tel: 33897111 Fax: 33573266		
S 银同有限公司 Silver Town Limited Tel: 33897111 Fax: 33573266 E-mail: silver_town@silvertown.com.hk		
DRAWING TITLE: [SB4-1]		
C/E Title Name:		
Designed by:		
Drawn by:		
Checked by:		
Approved by:		
Scale:		
DWG NO: J-836-WW2-[SB4-1]		PLT: 0

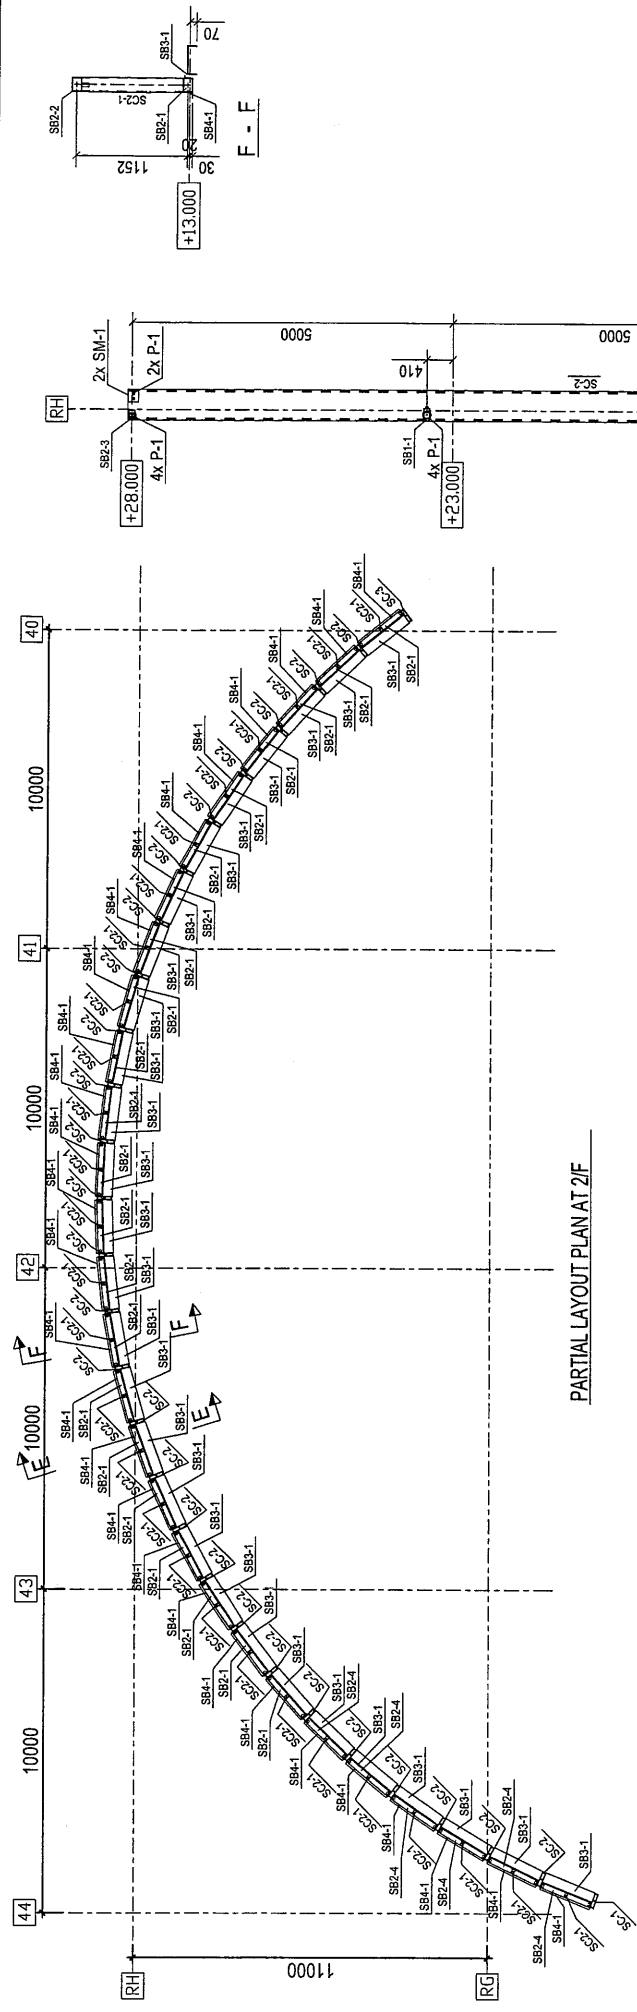


PARTIAL LAYOUT PLAN AT 2F

A - A

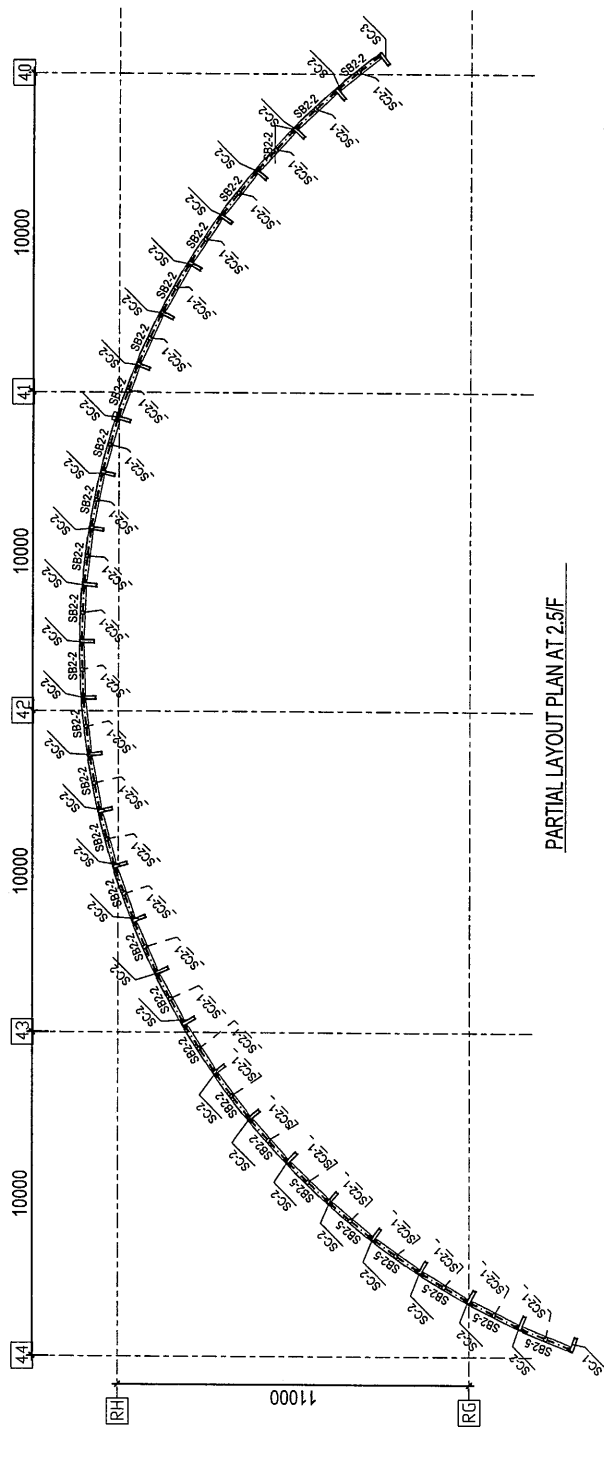

PARTIAL LAYOUT PLAN AT 2.5F

B - B

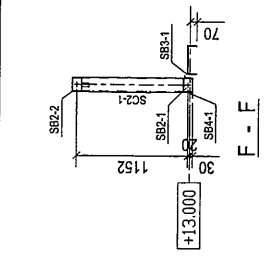

Rev.	第一次批准	Date	2018-06-13
0			

PROJECT: PROPOSED SITE C1  
DEVELOPMENT AT AREA 86,  
TKOIL 70 RP, TSEUNG KWAN O,  
NEW TERRITORIES


CLIENT: 華特鋁質有限公司  
ALUMINIUM PARTNER (HK) LTD.  
Units 63, Suning Industrial Centre, 1F  
610 Cha Wo Lo Ling Road, Kwunboon  
Tel: 23488211-4 Fax: 8522727885

銀同有限公司  
Silver Town Limited  
Tel: 008532388888 Fax: 008532388888  
EMAIL: ADDRESS: silvertown@al.tl.com

DRAWING TITLE:  
WINDOW-WALL (WV2)  
PARTIAL LAYOUT PLAN AT 2F  
PARTIAL LAYOUT PLAN AT 2.5F


CAD File Name:  
Designed by  
Drawn by  
Reviewed by  
Approved by  
Scale

DWG NO.: J-836-WV2-MF02  
REV. 0

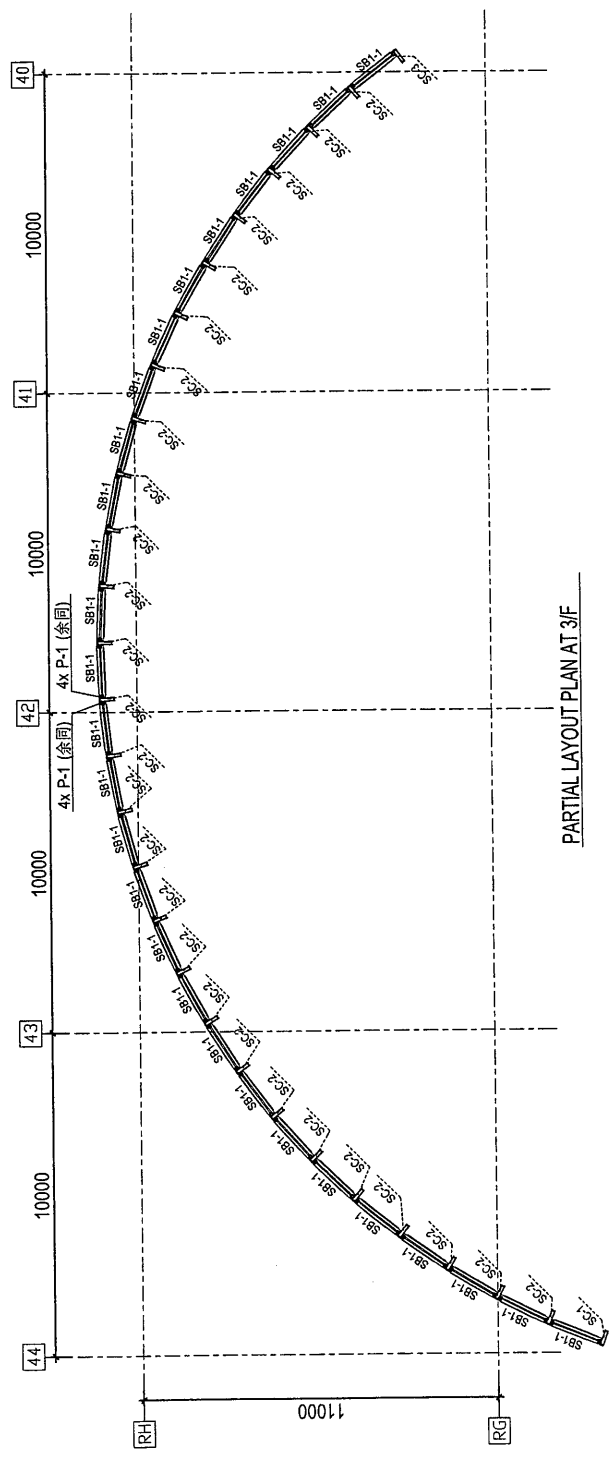

PARTIAL LAYOUT PLAN AT 3F

C - C

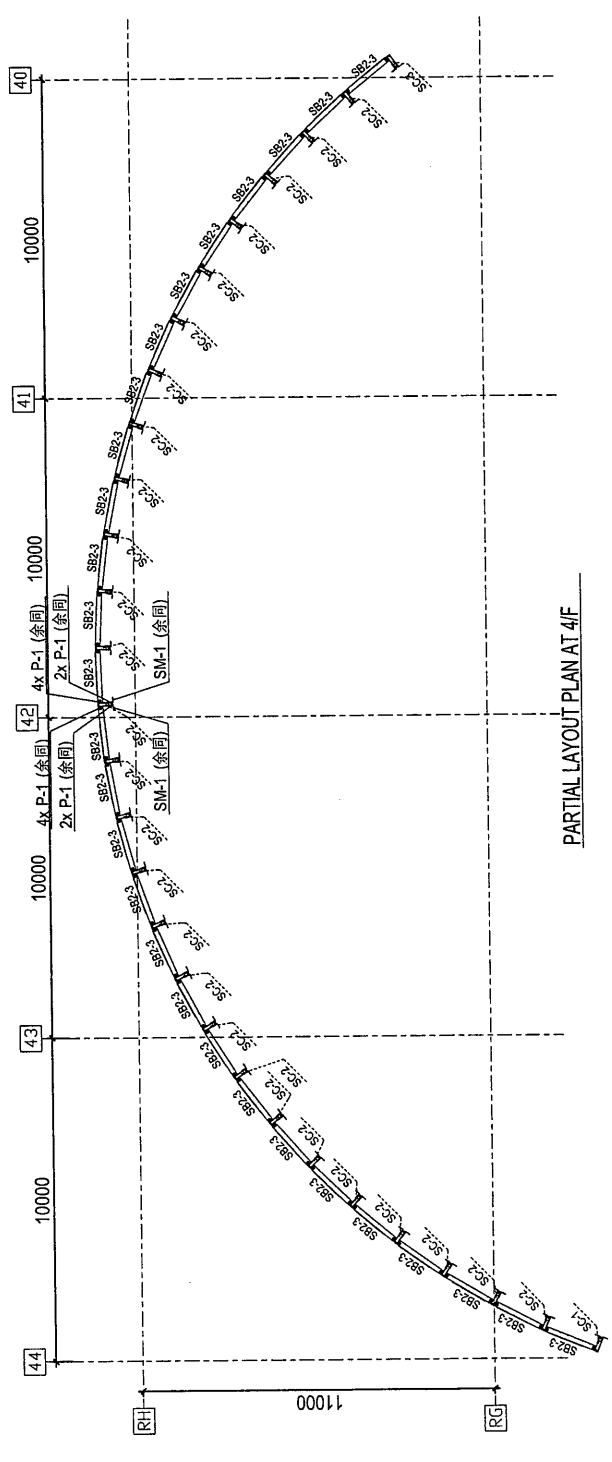

PARTIAL LAYOUT PLAN AT 4F

D - D

0	第一次报批	2018-06-13	Date
Rev.	Description		
PROJECT: PROPOSED SITE C1 DEVELOPMENT AT AREA 86, TKOTL 70 RP, TSEUNG KWAN O, NEW TERRITORIES			
CLIENT: 美特铝质有限公司 M.T.D. ALUMINUM FABRICATOR LTD. Units 8-9, Szeung Kwan O Centre, 1/F 10 Cheung Kwan Yung Road, Tseung Kwan O, New Territories Tel: 26282144 Fax: 26272668			
銀同有限公司 Silver Town Limited Tel: 34388888 Fax: 34388884 E-MAIL: ADMIN@SILVERTOWN.COM.HK			
DRAWING TITLE: WINDOW-WALL (WW2) PARTIAL LAYOUT PLAN AT 3F PARTIAL LAYOUT PLAN AT 4F			
CAD File Name:			
Designed by			
Drawn by			
Reviewed by			
Approved by			
Scale			
DWG NO.: J-836-WW2-MP03			REV. 0