

工程指示 / 要求簡箋(E.I.)

工程指示編號：EI/ 9452 /18 修改版次：B
 工程編號：JB36 工程名稱：日出康城 7 期平台
 工程項目：Window Wall (WW2) 鐵件
 收件人：Maggie Lor 發件人：李權鵬 日期：2018/6/25

□要求提供 / 確認 事項：

- () 初步鋁料 B.M. () 加工拆圖，然後生產 () 尺寸表
- () 正式鋁料 B.M. () 技術上資料 / 指示 () 報價
- () 配件 B.M. () 樣辦或貨品說明書 () 分判合約
- () 其他：_____

內容：

煩請以此修改版次為準，安排生產鐵件送地盤。

原料：100%自造，10%磁粉。

請在 2018/7/23 前完成上列要求。

附有關圖紙 / 文件：

18頁

以上項目為：

- 原合約工程包 原合約工程加 / 減賬 新工程報價

原因：-

分發東莞各部門：

- () 生產技術總監 連附件 () 技術部 連附件 ^林 () 生產部 連附件 () 機械設計部 連附件
- () 採購部 連附件 () 生產統籌部 連附件 ^梅
- () 質檢部 連附件 () 會計部 連附件 () 報關組 連附件 () 其他 _____ 連附件


分發香港各部門：

- () 行政部 連附件 () 會計部 連附件 () 統籌部 連附件 () 工程部地盤科文 連附件 ^象
- () 採購部 連附件 () QS 部 連附件 () 維修部 連附件 () 其他 _____ 連附件

傳遞編號：HK 1016 /13

發件人簽署：


項目經理簽署：

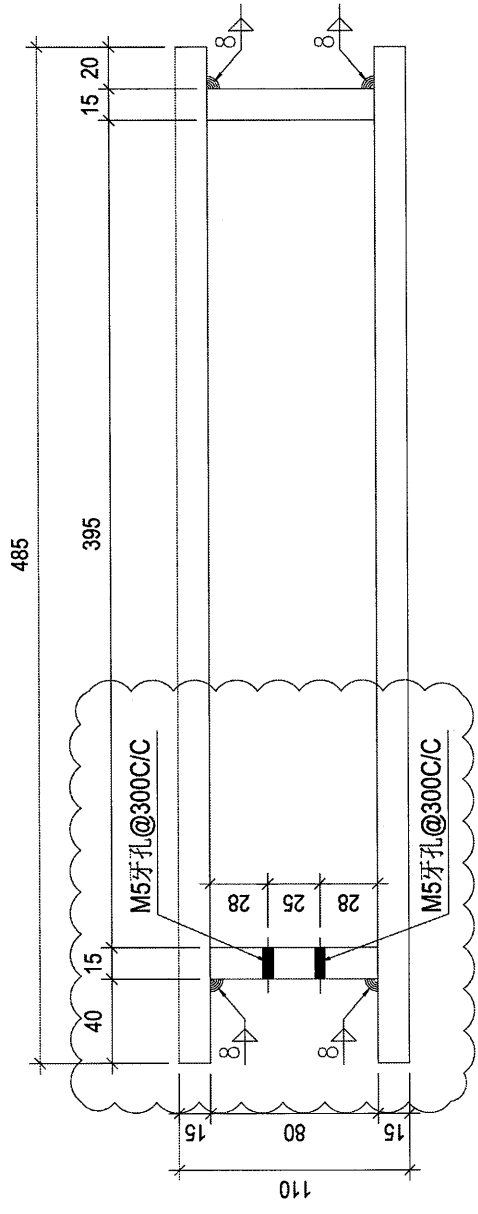



MB01拼接示意图

A	第2次修改	2018-06-20
Rev.	Description	Date
PROJECT: PROPOSED SITE C1 DEVELOPMENT AT AREA 88, TKOIL 70 RP, TSEUNG KWAN O, NEW TERRITORIES		
CLIENT: 美特铝业有限公司 MIDAL ALUMINIUM FABRICATOR LTD. Unit 8A, Suning Industrial Centre, 1/F 610 Chee Kwo Ling Road, Kwunboon Tel: 2345821, Fax: 252727888		
银同有限公司 Silver Town Limited Tel: 0754335688 Fax: 0754335984 E-MAIL ADDRESS: sgah@sk183.com		
DRAWING TITLE: MB01拼接示意图		
CAD File Name:		
Designed by		
Drawn by		
Reviewed by		
Approved by		
Scale		
DWG NO.: J-636-WWV2-MB01		REV: A

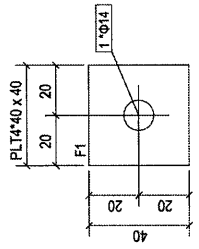
构件编号:	P-1	构件名称:	788*40	构件重量:	0.1
图样编号:	PLT440	长度(mm)	40	重量(kg)	0.00
F1		数量	1	重量(kg)	0.00
				合计:	0.05



构件: P-1


0	第一次报批	2018-06-13
Rev.	Description	Date
PROJECT:		
PROPOSED SITE C1 DEVELOPMENT AT AREA 88, KOTU 70 RP, TSEDONG KWAN O, NEW TERRITORIES		
CLIENT:		
 美特 鋸 質 有 限 公 司 MIDI STEEL MANUFACTURE LTD. Units 1-3, Shing Hwa Industrial Centre, 3/F 818 Che Koo Ling Road, Kwai Chee HK2460211-4 Fax: 38217275		
 銀 同 有 限 公 司 Silver Town Limited 40777-33333333 Fax: 38217275 E-mail: 3036333333@3333.com		
DRAWING TITLE :		
[P-1]		
C.A.D. File Name :		
Designed by		
Drawn by		
Reviewed by		
Approved by		
Scale		
DWG NO: J-836-MW2-[P-1]		
REV. 0		

材料编号: SB1-1		构件重量: 73.8	
零件编号	长度(mm)	数量	重量(kg)
M12	RHS200*100*8.0	1	57.04
M16	SHS40*40*3.0 半支	1	2.59
M17	SHS40*40*3.0 半支	2	4.56
合计:			65.08


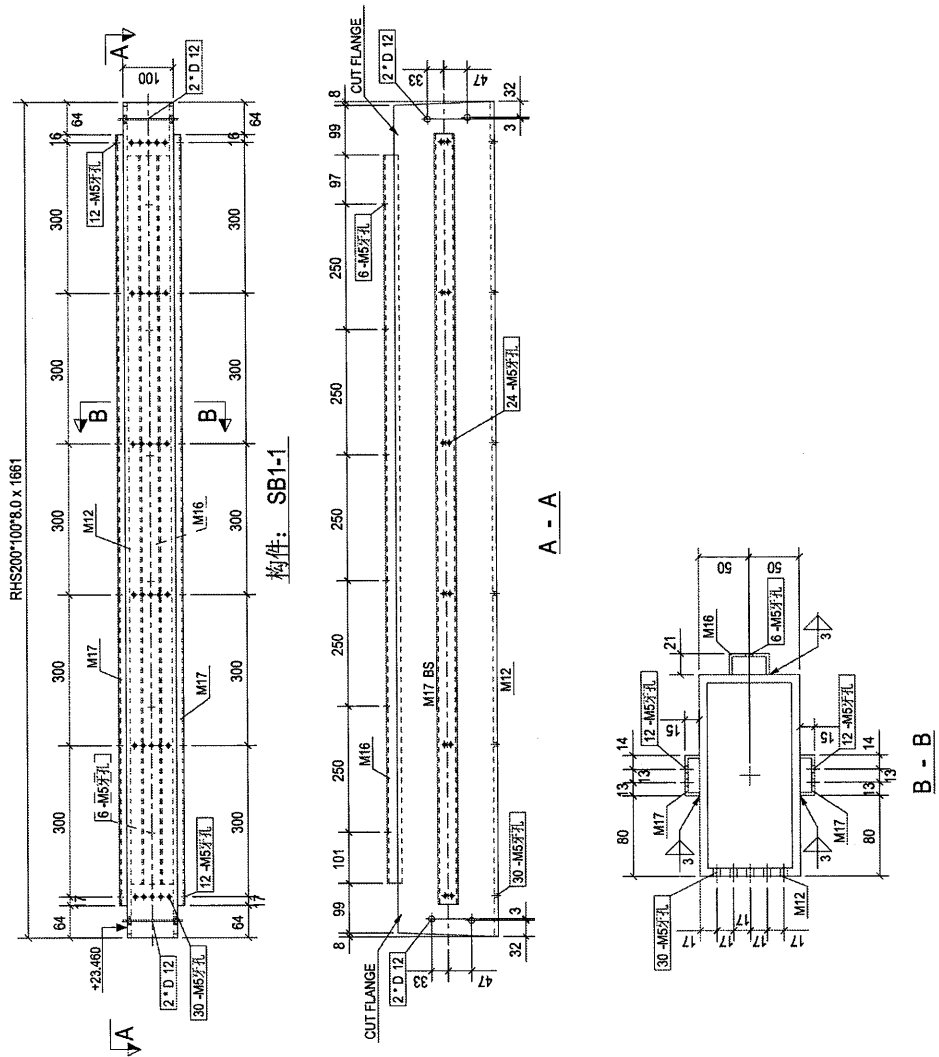


Rev	第一次报批	2018-06-13
Rev	Description	Date
PROJECT: PROPOSED SITE C1 DEVELOPMENT AREA 86, TROU TONG TSEUNG KWAN O, NEW TERRITORIES		
CLIENT: 美特鋁業有限公司 MIDI ALUMINIUM FABRICATOR LTD. Units 6-4, Sanyo Industrial Centre, 1/F 810 Chee Ann Ling Road, Kowloon Tel: 2498211-4 Fax: 249272686		
S 銀同有限公司 Silver Town Limited 140570-433936 Fax: 27383393 E-MAIL: 80037249@silvertown.com.hk		
DRAWING TITLE: [SB1-1]		
CAD File Name:		
Designed by		
Drawn by		
Reviewed by		
Approved by		
Scale		
DWG NO: J-936-WW2-[SB1-1]	Rev	0

构件编号:	SB2-1	构件数量:	22	构件重量:	49.8
原件编号	规格(mm)	数量	重量(kg)	长度(m)	体积(m ³)
M6	RHS150*100*8.0	1	47	47.40	0.80
M13	RS425*25*3	1	2	1.83	0.16
合计:					49.22

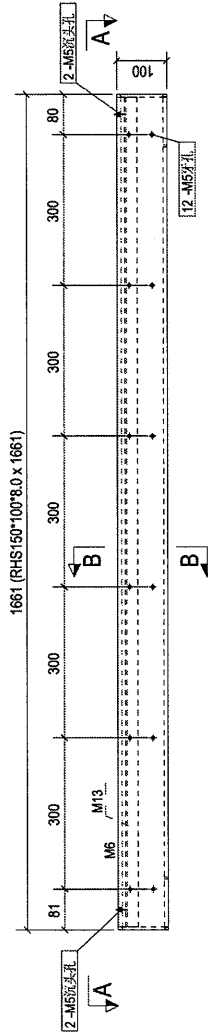


构件: SB2-1

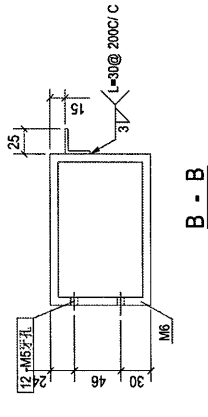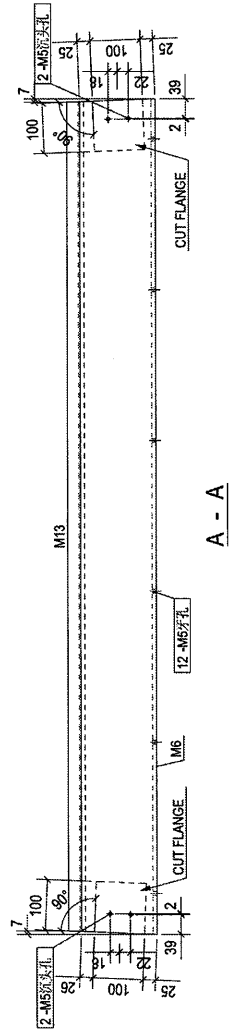



Rev.	第一次批	2018-06-13
Description		Date

PROJECT:
 PROPOSED SITE C1
 DEVELOPMENT AT AREA 88,
 TKOIL 70 RP, TSEUNG KWAN O,
 NEW TERRITORIES

CLIENT:
 美特鋁質有限公司
 MIDU aluminium manufacture ltd.
 Unit 1-4, Seng Industrial Centre, 177
 810 Chee Kee Road, Kwai Lok,
 HONG KONG TEL: 34222556 FAX: 34222556

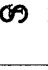
CLIENT:
 银同有限公司
 Silver Town Limited
 1-19A, 1922-1924, 1926, 1928, 1930, 5648, 56

零件编号:	SR2-2	零件数量:	22	零件重量:	56.2
规格(mm)		长度(mm)		重量(kg)	表面积(m ²)
M7	RHS150*100*3.0	1661	1	48	47.61
M14	RHS80*40*3.0	731	3	3.24	0.18
M15	RHS80*40*3.0	731	1	3	0.18
合计:				54.09	

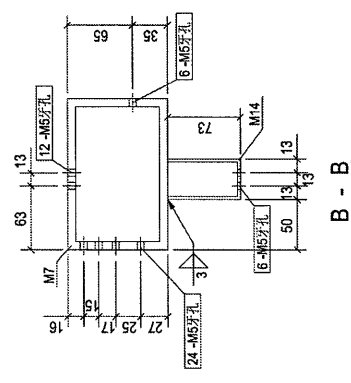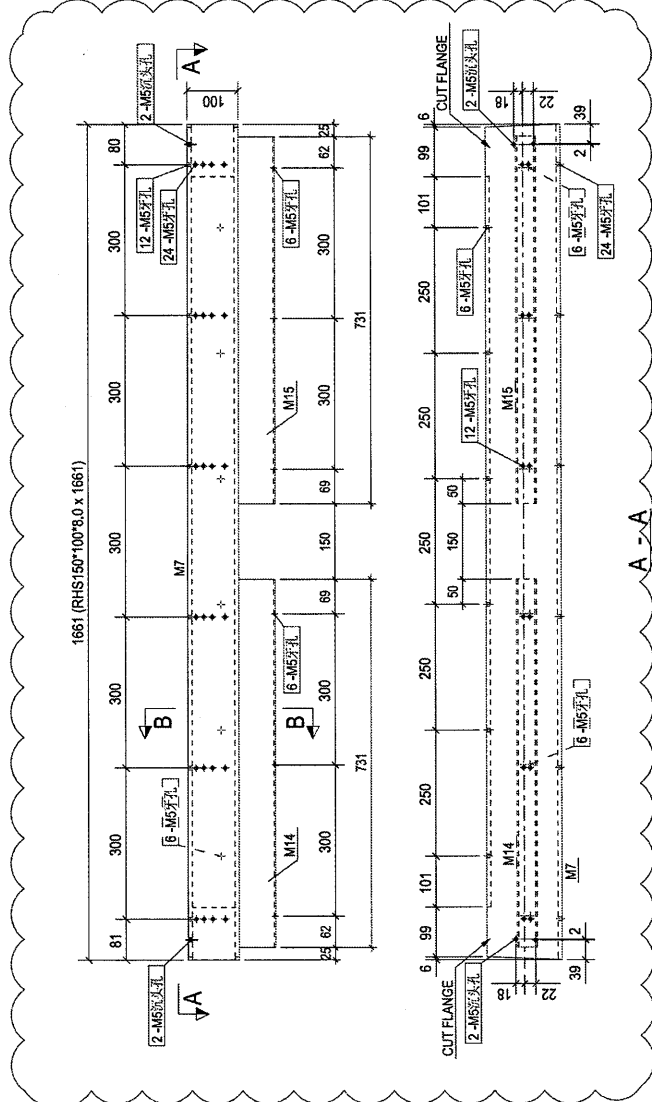


A	初次核批	2018-06-21
Rev.	Description	Site
PROJECT: PROPOSED SITE C1 DEVELOPMENT AT AREA 86, TKO/TUO RP, TSEUNG KWAN O, NEW TERRITORIES		
CLIENT: 美特鋁質有限公司 MIDI ALUMINIUM FABRICATOR LTD. 5/F, 5-8, Sunny Industrial Centre, 1/F, 610 Blue Kwo Ling Road, Kowloon, Tel: 2488211-4 Fax: (312) 2727488		
DESIGNER: 銀同有限公司 Silver Town Limited 1402-1404, 14/F, 4/F, 2/F, 1/F, 4/F, 4/F, E-Wing, Harbour Plaza, 61, 63, 65, 67, 69		
DRAWING TITLE: [SB2-2]		
CAD File Name:		
Designed by		
Drawn by		
Reviewed by		
Approved by		
Scale		
DWG NO: J-838-WW2-[SB2-2]		REV: A


零件编号:	SB2-4	零件数量:	6	制作公差:	49.8
物料编号:	RS2525F3	长度(mm)	1650	重量(kg)	1.83
M13	RHS150*100*6.0	数量	1	重量(kg)	0.16
M146	RHS150*100*6.0	数量	1	重量(kg)	0.80
合计:					49.22

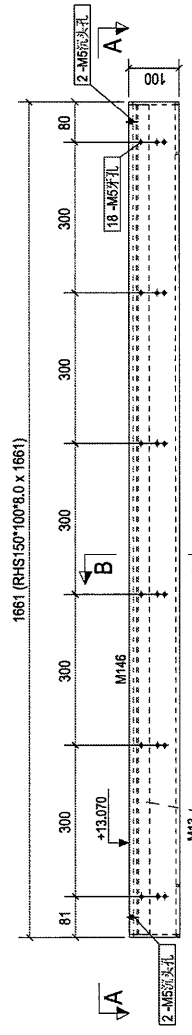

构件: SB2-4

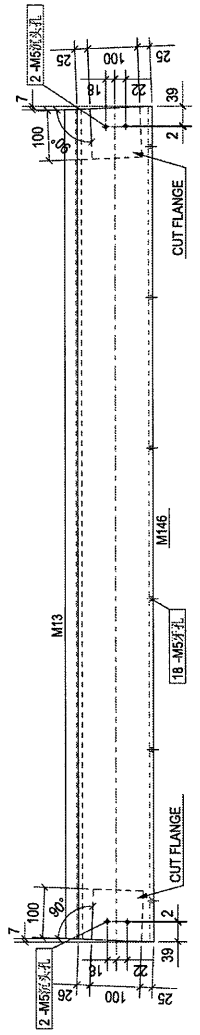


A - A

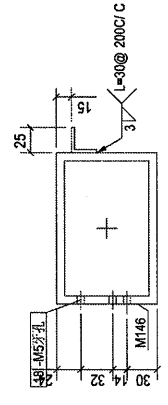

B - B


Rev.	第一次报批	2018-06-13
Rev.	Description	Date
PROJECT: PROPOSED SITE C1 DEVELOPMENT AT AREA 86, TKOIL 70 RP, TSEUNG KWAN O, NEW TERRITORIES		
CLIENT: 美特铝质有限公司 MIDAL ALUMINIUM MANUFACTURING LTD. Unit 6-3, Sui Ho Industrial Centre, 1/F 619 Chee Koo Street, Kwai Tsing Kowloon, Hong Kong Tel: 24242111-4 Fax: 242427256		
CLIENT: 银同有限公司 Silver Town Limited Unit 101-101A, 101B, 101C, 101D, 101E, 101F 101, 101A, 101B, 101C, 101D, 101E, 101F 101, 101A, 101B, 101C, 101D, 101E, 101F		
DRAWING TITLE: [SB2-4]		
CAD File Name:		
Designed by		
Drawn by		
Reviewed by		
Approved by		
Scale		
DWG NO:	J-836-MW2-[SB2-4]	REV:
		0

零件编号:	SB3-1	零件数量:	28	制作高度:	100.3
零件编号	单位(mm)	数量	重量(kg)	长度(mm)	重量(kg)
M10	RHS300*200*8.0	1	50	1664	1.63
				合计:	50.22

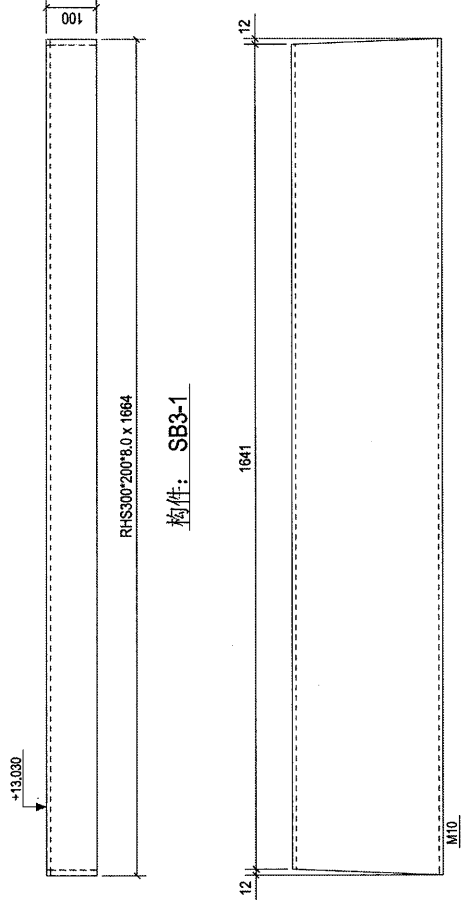

0	第一次报批	2018-06-13
Rev.	Description	Date

PROJECT:
 PROPOSED SITE C1
 DEVELOPMENT AT AREA 86,
 TKOT'L 70 RP, TSEING KWAN O,
 NEW TERRITORIES

CLIENT:
 美特铝贸有限公司
 MIDU ALUMINUM TRADING LTD.
 8088 8-8, Spring Industrial Centre, 127
 830 Gao Koo Ling Road, Kwai Kwook,
 Kowloon, Hong Kong
 Tel: 24248211-4 Fax: 242172756


 银同有限公司
 Silver Town Limited
 147771-4222228 Fax: 2727-8222224
 100A, 4355555, 4355555, 4355555

DRAWING TITLE:
 [SB3-.1]

CAD File Name:	
Designed by	
Drawn by	
Reviewed by	
Approved by	
Scale	

DWG NO:	J-836-MW2- [SB3-.1]
REV:	0

物料编号:	SB4-1	材料重量:	7.6
物料名称:	RS60*80*5	长度(mm):	1661
M11		数量:	1
		重量(kg):	7.50
		张数:	7
		表面面积(m ²):	0.28
		合计:	7.50

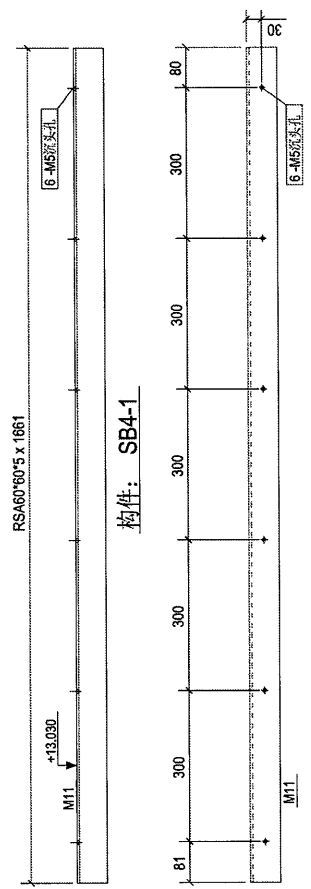


Rev:	第一次报批	Date:	2018-06-13
------	-------	-------	------------

PROJECT:
 PROPOSED SITE C1
 DEVELOPMENT AT AREA 06,
 TKOIL 70 RP, TSEUNG KWAN O,
 NEW TERRITORIES

CLIENT:
 **美特鋁質有限公司**
 MIDI ALUMINIUM FABRICATOR LTD.
 Units 8-9, Sunny Industrial Centre, 1/F
 610 Chee Ann Street, Kowloon
 Tel: 2499211-4 Fax: 242772685


 **银同有限公司**
 Silver Town Limited
 Tel: 27283308 Fax: 27283384
 E-mail: info@silvertown.com.hk

DRAWING TITLE:
[SB4-1]

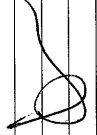CAD File Name:	
Designed by	
Drawn by	
Reviewed by	
Approved by	
Scale	

DWG NO:	J-836-MW2-[SB4-1]
REV	0

料件號:	SC2-1	料件數量:	28	料件重量:	30.4
規格:	RHS150*100*8.0	長度(mm):	1060	單重(kg):	1.086
料件編號:	M9	面積(mm ²):	31	料件重量(kg):	30.92
				合計:	30.92

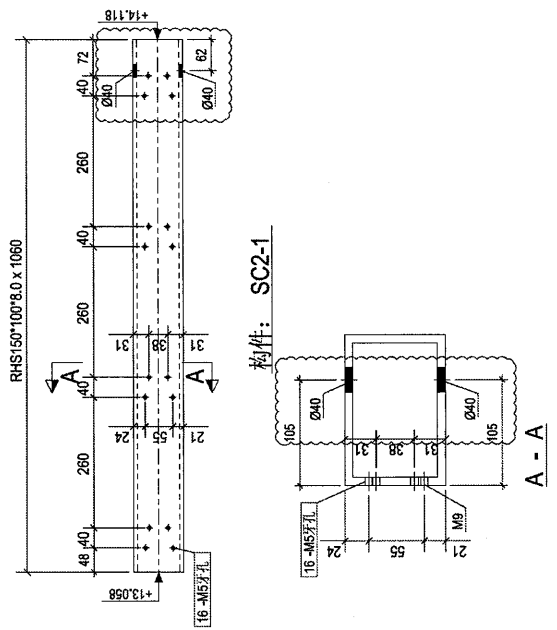

料件: SC2-1


B	第3次發批	2018-06-23
Rev.	Description	Date

PROJECT:
 PROPOSED SITE C1
 DEVELOPMENT AT AREA 86,
 TKO TL 70 RP, TSEUNG KWAN O,
 NEW TERRITORIES

CLIENT:
 **MIDI** MIDDY INTERNATIONAL LTD.
 Unit 2-4, Sunny Industrial Centre, 1/F,
 610 Chee Koo Ling Road, Kwai Fong,
 Tel: 2488311-4 Fax: 2477288F


 **銀同有限公司**
 Silver Town Limited
 140-150, HING HONG ROAD, TUNG SHAN,
 C. H. K. INDUSTRIAL ESTATE, L. 2009

DRAWING TITLE:
[SC2-1]






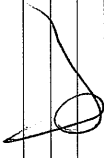
CAD File Name:	
Designed by	
Drawn by	
Reference by	
Approved by	
Scale	

DWG NO:	J-836-MW2-[SC2-1]
頁數	B

材料重量: 2041.6		材料重量: 2041.6	
材料编号	规格(mm)	数量	重量(kg)
M2	SHS50*50*5.0	60	47
M5	SHS50*50*5.0	60	0
M19	BP110*485*15 板拼	1535	1
M20	SHS80*80*5.0	100	2
M21	SHS80*80*5.0	100	1
M22	RHS120*90*5.0	100	2
		合计:	2030.1

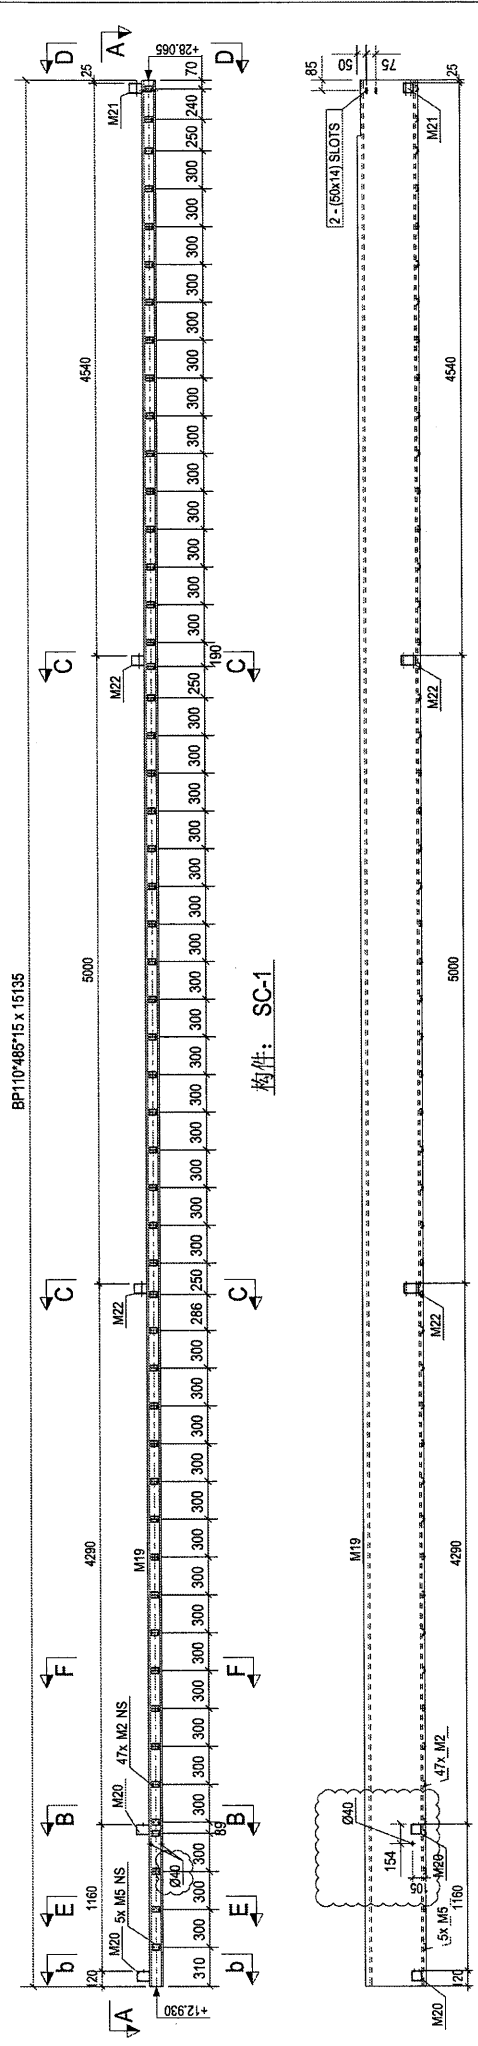


C	第4次修改	2018-06-23
Rev.	Description	Date
PROJECT: PROPOSED SITE C1 DEVELOPMENT AT AREA B6, TROTL'70 RP, TSEUNG KWAN O, NEW TERRITORIES		
CLIENT: 美特铝业有限公司 MIDI ALUMINIUM FABRICATOR LTD. 810 Chee Ann Ring Road, Kowloon Tel: 3489211-4 Fax: 3482772685		
S 银同有限公司 Silver Town Limited FLOOR 40, 333 HING HOI STREET, KOWLOON		
DRAWING TITLE: [SC-1]		
CAD File Name:		
Designed by:		
Drawn by:		
Reviewed by:		
Approved by:		
Scale:		
DWG NO: J-835-MW2-[SC-1]		REV: C

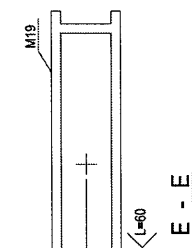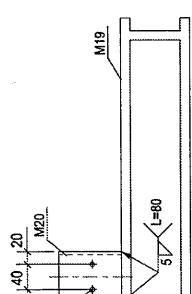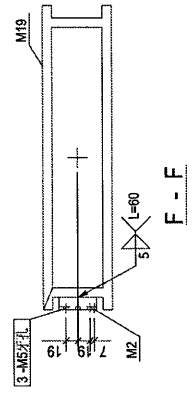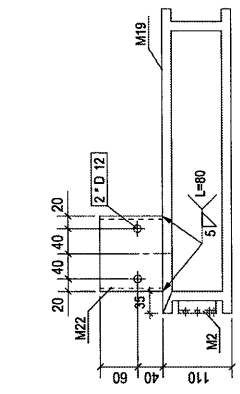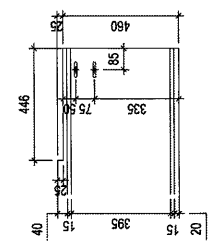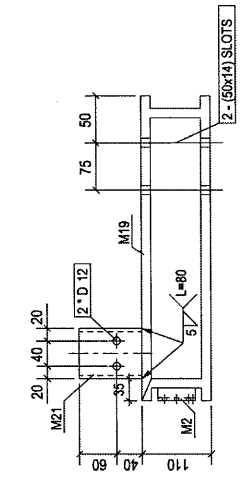


b-b Similar but no M5

物料编号:	SM-1	物料数量:	4.0
物料名称:	SM-1	物料重量:	4.0
规格(mm)	150	长度(mm)	150
物料号	RS4200160*10	数量	4
M18		共重(kg)	4.00
		合计:	4.00

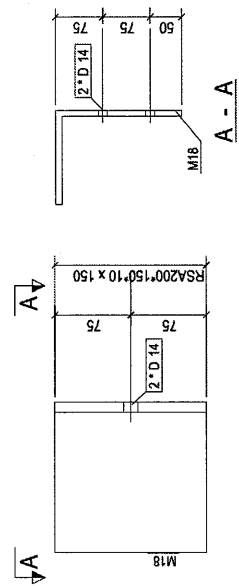


构件: SM-1

0	第一次报批	2018-06-13
Rev	Description	Date
PROJECT:		
PROPOSED SITE C1 DEVELOPMENT AT AREA B6, TKOIL 70 RP, TSEUNG KWAN O, NEW TERRITORIES		
CLIENT:		
 美特铝质有限公司 MIDI MILD STEEL FABRICATOR LTD. 810 Chee Chee Ling Road, Kowloon TEL: 2438211-4 Fax: 2432727856		
 银同有限公司 Silver Town Limited 145-146 Kwai Yee Street, Kowloon Tel: 2438211-4 Fax: 2432727856		
DRAWING TITLE:		
[SM-1]		
CAD File Name:		
Designed by		
Drawn by		
Reviewed by		
Approved by		
Scale		
DWG NO: J-836-WW2-[SM-1]		REV: 0

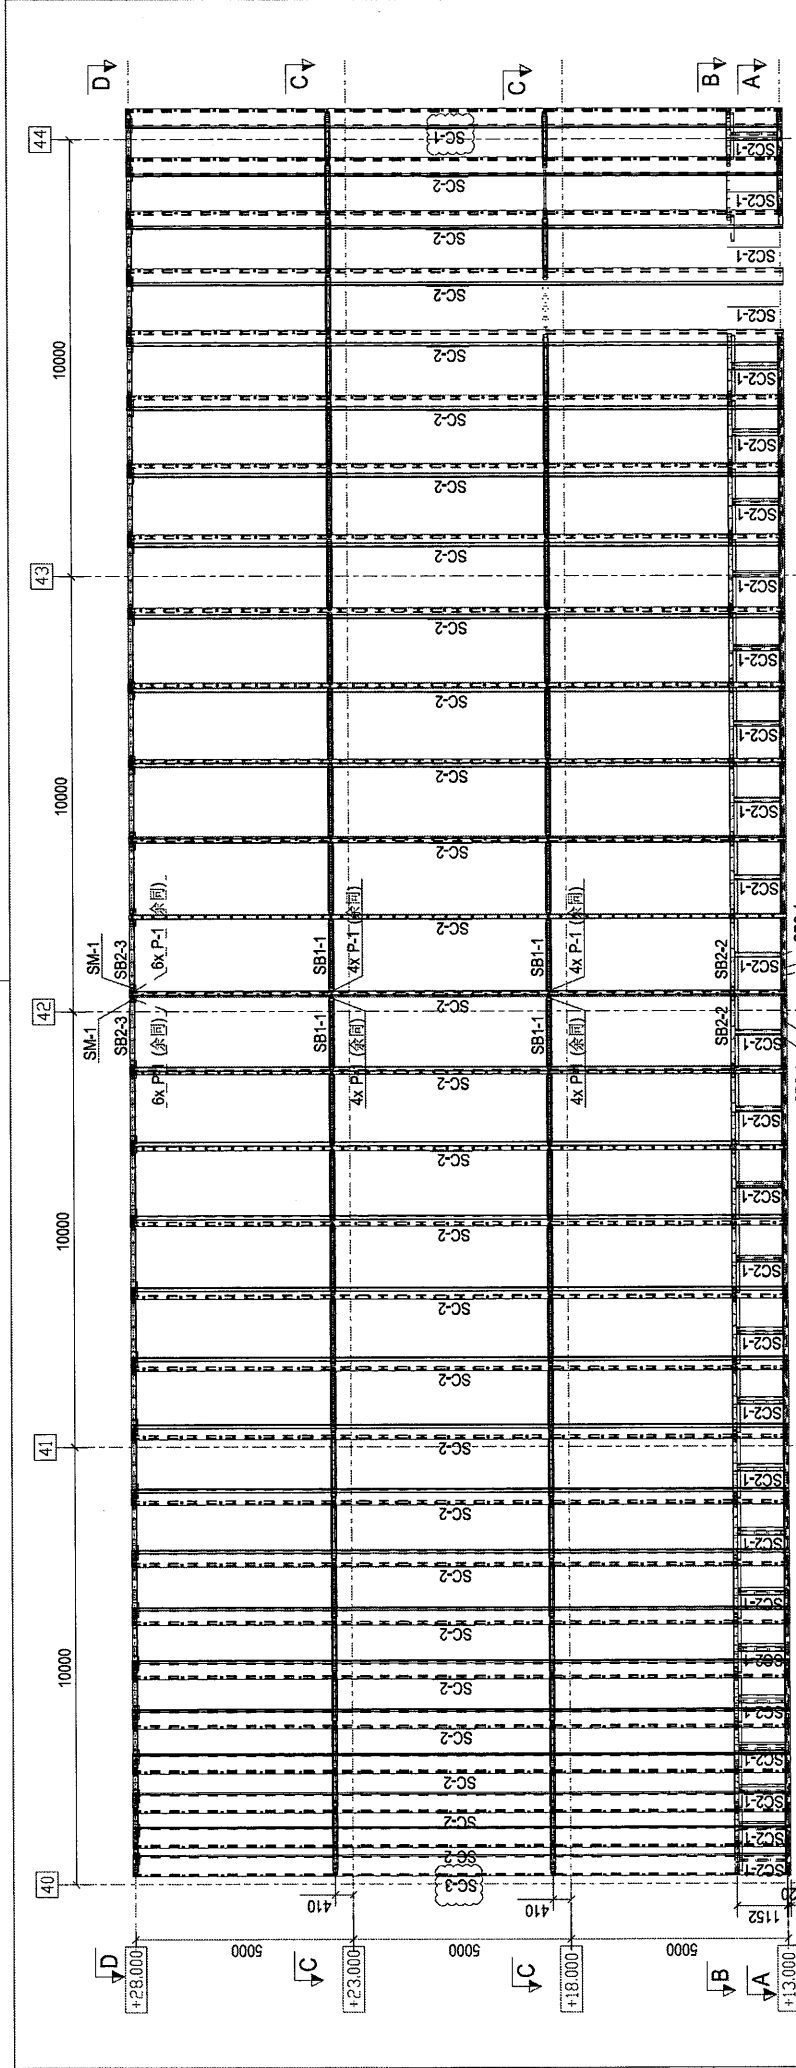


Rev.	第2次修補	Date	2018-06-21
PROJECT: PROPOSED SITE C1 DEVELOPMENT AT AREA 88, TROTIL 70 RP, TSEUNG KWAN O, NEW TERRITORIES			
CLIENT: 美特鋁質有限公司 MIDI ALUMINIUM PRODUCTS LTD. Unit: 6-8, Sung Hing Industrial Centre, 17 Rt10 Chee Koo Ling Road, Kwailoon Tel: 24692111-4 Fax: 26217786			
S 銀同有限公司 Silver Town Limited 140777-222-8888 Fax: 2778-8222664 E-MAIL: ADDRESS@SILVERTOWN.COM.HK			
DRAWING TITLE: WINDOW-WALL (WW2) ELEVATION			
C.A.D File Name:			
Designed by			
Drawn by			
Checked by			
Approved by			
Scale			
DWG NO: J-88-WW2-MP01			REV: A

ELEVATION OF WINDOW WALL WW2
FACING AT OUTSIDE

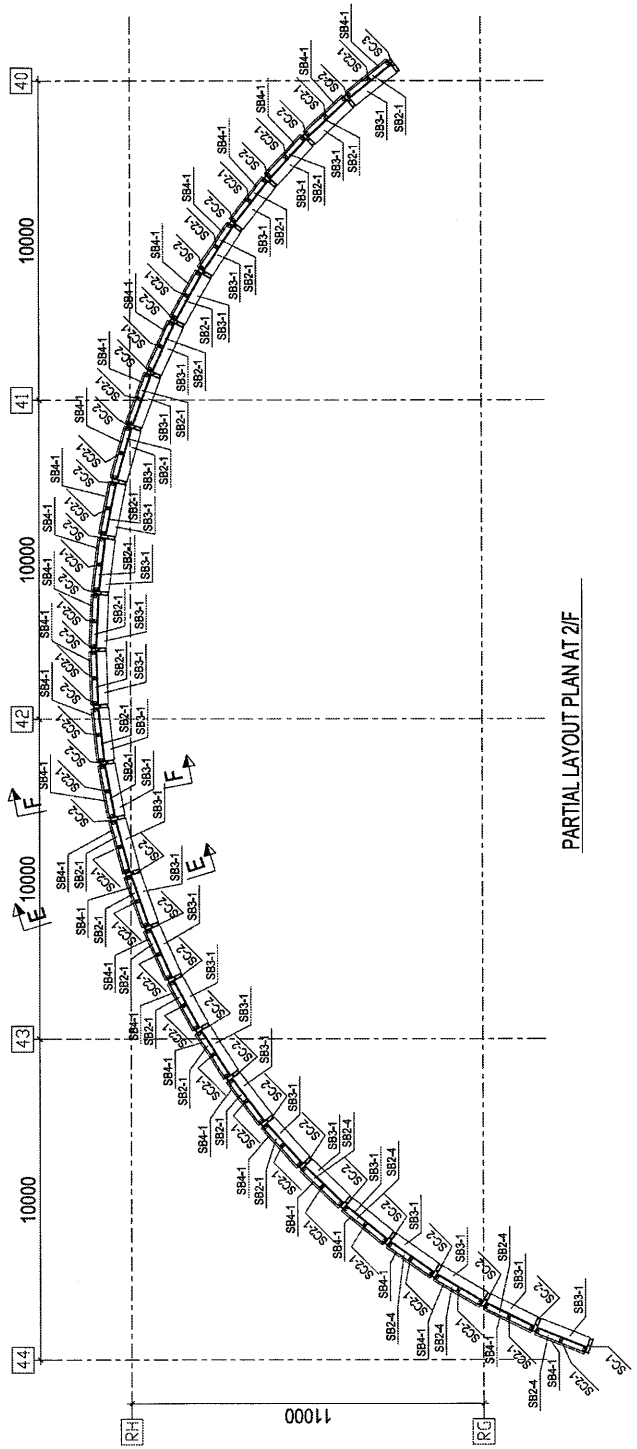


PARTIAL LAYOUT PLAN AT 2/F

A - A

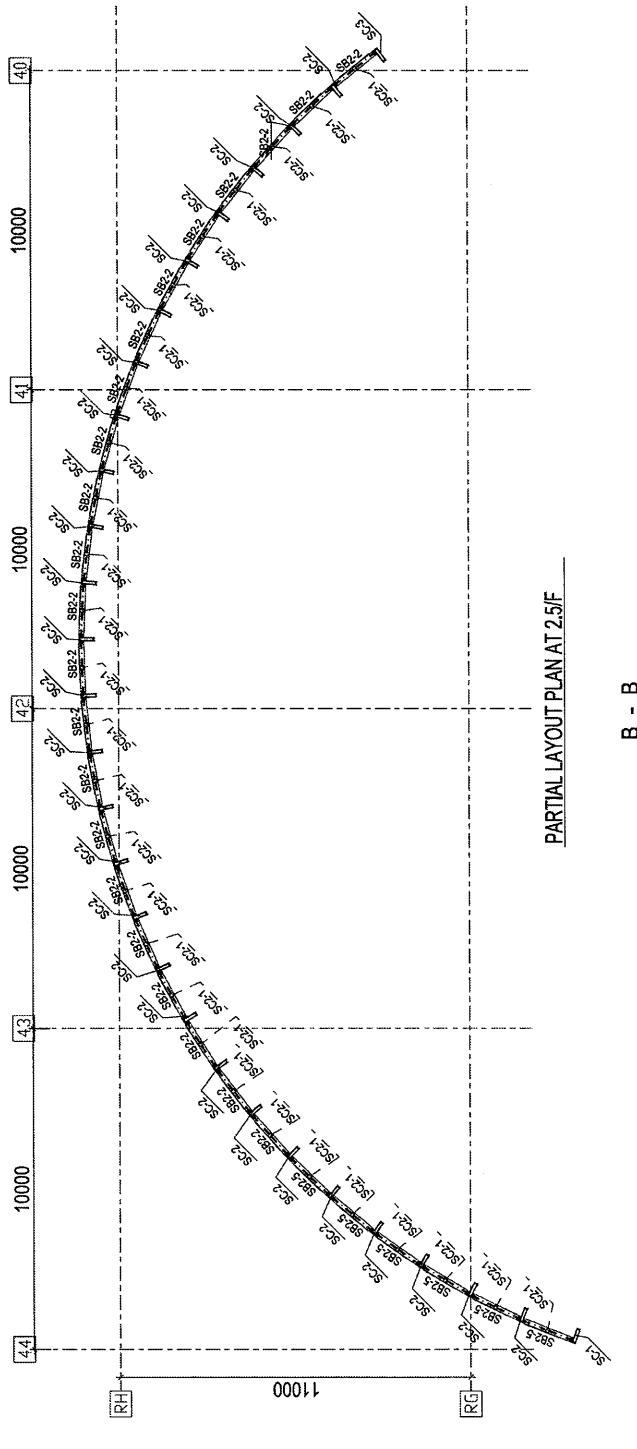


PARTIAL LAYOUT PLAN AT 2.5/F


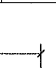
B - B

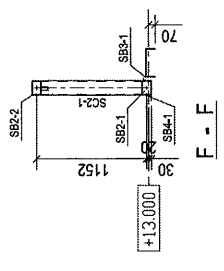


F - F

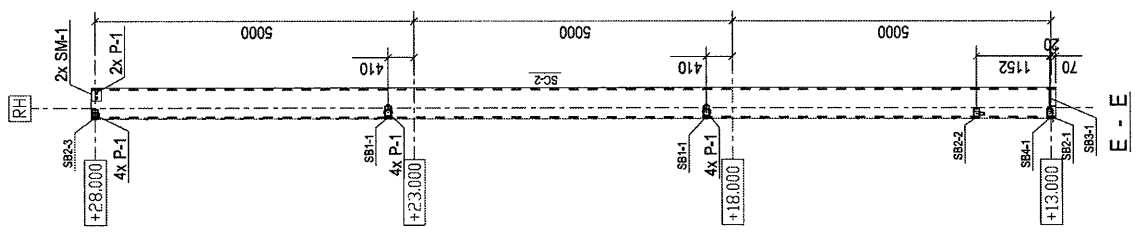


E - E

0	第一次报批	2018-06-13	Date
PROJECT:		PROPOSED SITE C1 DEVELOPMENT AT AREA 86, TKOIL 70 RP, TSEUNG KWAN O, NEW TERRITORIES	
CLIENT:		 美特銀質有限公司 MTR 810 Che Kwo Ling Road, Kwun Tong Tel: 23489214 Fax: 23277268 E-MAIL ADDRESS: mtr@me.com	
		 銀同有限公司 Silver Town Limited Tel: 23835988 Fax: 23433884 E-MAIL ADDRESS: sst@me.com	
DRAWING TITLE:			
WINDOW WALL (WW2)			
PARTIAL LAYOUT PLAN AT 2/F			
PARTIAL LAYOUT PLAN AT 2.5/F			
CAD File Name:			
Designed by			
Drawn by			
Reviewed by			
Approved by			
Scale			
DWG NO.:		J-836-WW2-MF02	
REV.:		0	

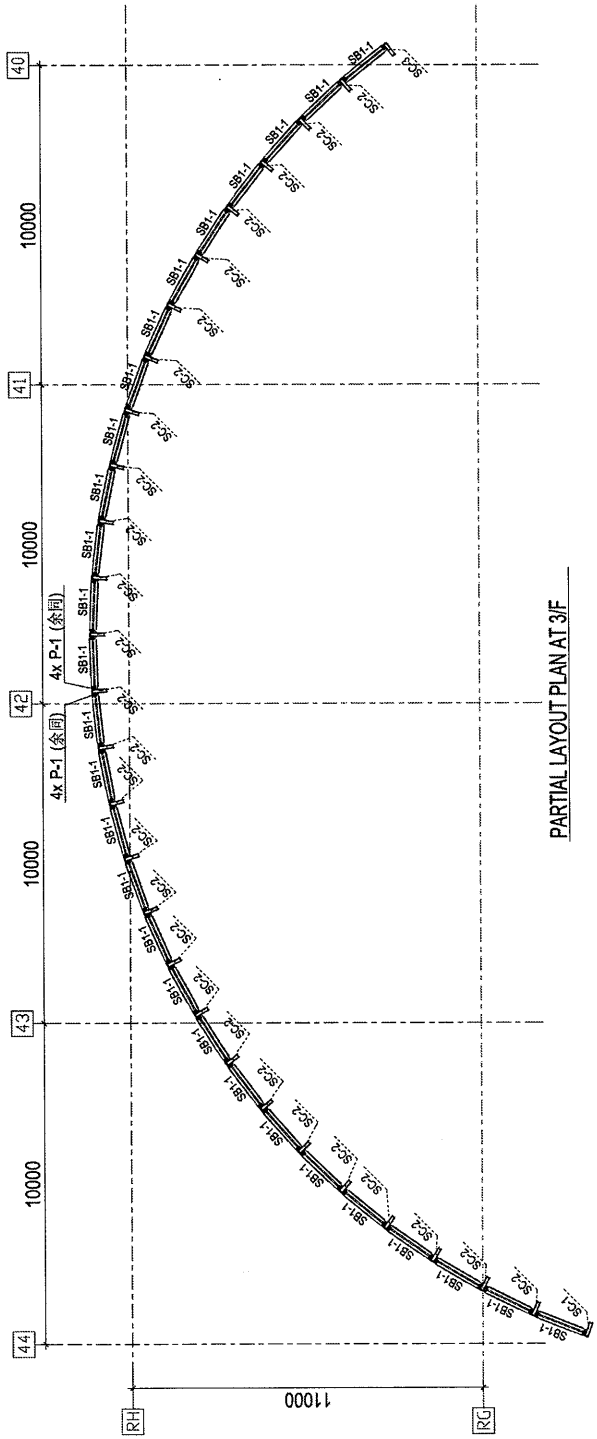

PARTIAL LAYOUT PLAN AT 3/F

C - C

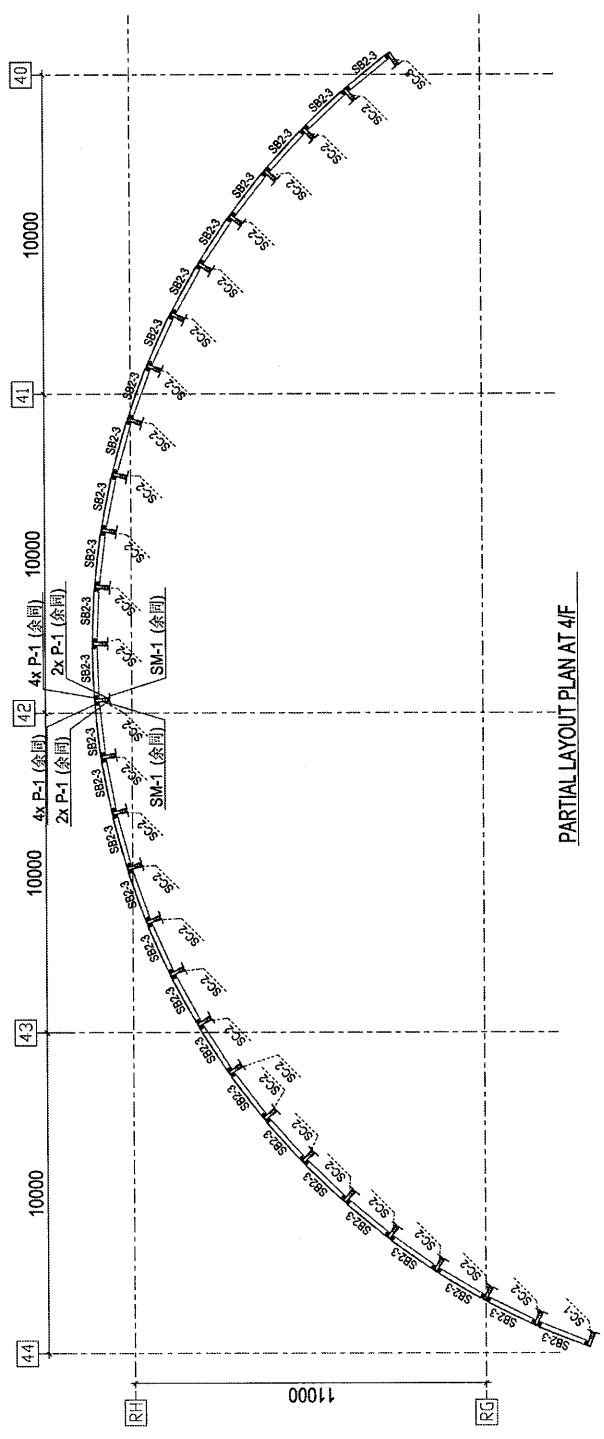

PARTIAL LAYOUT PLAN AT 4/F

D - D

0	第一次出紙	2018-06-13
Rev.	Description	Date
PROJECT: PROPOSED SITE C1 DEVELOPMENT AT AREA 08, TKOIL 70 RP-TSEUNG KWAN O, NEW TERRITORIES		
CLIENT: 美特鋁質有限公司 MITI ALUMINIUM PRODUCTS LTD. Unit 64, Sze Yee Industrial Centre, 1/F 810 Chee Kwoi Ling Road, Kowloon Tel: 2344821-4, Fax: 23272688		
銀同有限公司 Silver Town Limited Tel: 27594324/888 Fax: 27594355/854 EMAIL ADDRESS: sp@stl.com.hk		
DRAWING TITLE: WINDOW/WALL (NW2) PARTIAL LAYOUT PLAN AT 3/F PARTIAL LAYOUT PLAN AT 4/F		
CAD File Name:		
Designed by		
Drawn by		
Reviewed by		
Approved by		
Scale		
DWG NO.: J-436-WW2-JAP03		REV: 0