

工程指示 / 要求簡箋(E.I.)

工程指示編號：EI/ 9496 /18

修改版次：C

工程編號：J836

工程名稱：日出康城7期(平台)

工程項目：WW4(A-N)地盤用鐵件修改

收件人：Maggie Lor 發件人：Joe Chan

日期：14/11/2018

☐ 要求提供 / ☒ 確認 事項：

- | | | |
|------------------------------------|-------------------------------------|-------------------------------|
| ☐ 初步鋁料 B.M. | ☐ 加工拆圖，然後生產 | ☐ 尺寸表 |
| ☐ 正式鋁料 B.M. | ☐ 技術上資料 / 指示 | ☐ 報價 |
| ☐ 配件 B.M. | ☐ 樣辦或貨品說明書 | ☐ 分判合約 |
| ☐ 其他：_____ | | |

內容：

WW4(A-N)地盤用鐵件修改(2/F & 3/F).
根據最新版次施工圖(9A版)更新拆圖。

請依附件資料，生產鉄件，完成生產後
依地盤指示送地盤

請在 1/12/2018 前完成上列要求。

附有關圖紙 / 文件：

以上項目為：

☐ 原合約工程包 ☐ 原合約工程加 / 減賬 ☐ 新工程報價

原因：-

分發東莞各部門：

☐ 生產技術總監	☐ 連附件	☐ 技術部	☐ 連附件	☐ 生產部	☐ 連附件	☐ 機械設計部	☐ 連附件
☐ 採購部	☐ 連附件	☐ 生產統籌部	☐ 連附件				
☐ 質檢部	☐ 連附件	☐ 會計部	☐ 連附件	☐ 報關組	☐ 連附件	☐ 其他	☐ 連附件

分發香港各部門：

☐ 行政部	☐ 連附件	☐ 會計部	☐ 連附件	☐ 統籌部	☐ 連附件	☒ 工程部地盤科文	☒ 連附件	積哥
☐ 採購部	☐ 連附件	☐ QS 部	☐ 連附件	☐ 維修部	☐ 連附件	☐ 其他	☐ 連附件	

傳遞編號：

發件人簽署：

項目經理簽署：

美特鋁質有限公司 MIDI Aluminium Fabricator Ltd.		工程號:	J836-WW4	計算:			日期:	12/11/2018	送呈:		
		地盤名稱:	日出康城7期平台	核對:			日期:	12/11/2018	副本:		
地盘鐵件BM表		項目類別:	幕牆	批准:			日期:				
BM編號:	EI/9496	修改版次:	C	A/C Code:			鐵件總重量KG: 21894.31				
序號	修改內容	鐵件圖號	鐵件名稱	顏色	實用	後備	總數	單位	單件 (kg)	總重量 (kg)	備注
1		2HL-1	120*47*6.3mm鉄槽	熱浸鋅	4	0	4	件	26.735	106.940	
2		2HL-2	120*80*6.3mm扁通+75*50*5mm角鉄	熱浸鋅	4	0	4	件	28.175	112.700	
3		2HL-3	75*50*6mm鉄槽+5mm鉄板	熱浸鋅	4	0	4	件	17.683	70.732	
4		2HL-4	75*50*6mm鉄槽+5mm鉄板	熱浸鋅	1	0	1	件	17.751	17.751	
5		2HL-5	120*80*6.3mm扁通+75*50*5mm角鉄	熱浸鋅	1	0	1	件	31.322	31.322	
6	A	2HL-6	120*47*6.3mm鉄槽	熱浸鋅	1	0	1	件	27.471	27.471	构件取消
7		2MZ-1	50*50*6mm角鉄	熱浸鋅	18	0	18	件	0.447	8.046	
8	A	2MZ-2	50*50*5mm角鉄	熱浸鋅	4	0	4	件	0.380	1.520	新增图纸
9		2P-1	4mm鉄板	熱浸鋅	20	0	20	件	0.050	1.000	
10	A	2P-2	16mm鉄板	熱浸鋅	5	0	5	件	15.070	75.350	新增图纸
11		2QM-1	100*75*6mm角鉄	熱浸鋅	10	0	10	件	1.447	14.470	
12		2SC-1	160*80*6mm扁通	熱浸鋅	5	0	5	件	56.283	281.415	
13		2SU-1	75*60*6mm鉄槽+100*50*8mm角鉄	熱浸鋅	4	0	4	件	18.834	75.336	
14		2SU-2	75*60*6mm鉄槽+100*50*8mm角鉄	熱浸鋅	1	0	1	件	18.883	18.883	
15		3HL-1	120*80*6.3扁通+50*15*5鉄槽+5mm板	熱浸鋅	1	0	1	件	45.774	45.774	
16		3HL-2	120*80*6.3扁通+50*15*5鉄槽+5mm板	熱浸鋅	1	0	1	件	45.774	45.774	
17		3HL-3	120*80*6.3扁通+75*50*5角鉄+6mm板	熱浸鋅	1	0	1	件	40.783	40.783	
18		3HL-4	120*80*6.3扁通+75*50*5角鉄+6mm板	熱浸鋅	1	0	1	件	40.783	40.783	
19		3HL-5	120*80*6.3mm扁通+75*50*5mm角鉄	熱浸鋅	1	0	1	件	23.557	23.557	

 美特鋁質 有限公司 MIDI Aluminium Fabricator Ltd.		工程號: J836-WW4	計算:			日期:	12/11/2018	送呈:			
地盤名稱: 日出康城7期平台		核對:				日期:	12/11/2018	副本:			
項目類別: 幕牆		批准:				日期:					
BM編號: EI/9496		修改版次: C	A/C Code:			鐵件總重量KG:		21894.31			
序號	修改內容	鐵件圖號	鐵件名稱	顏色	實用	後備	總數	單位	單件 (kg)	總重量 (kg)	備注
20		3HL-6	120*47*6.3mm鉄槽	热浸鋅	1	0	1	件	31.942	31.942	
21		3HL-7	120*47*6.3mm鉄槽	热浸鋅	1	0	1	件	32.310	32.310	
22		3HL-8	120*47*6.3mm鉄槽	热浸鋅	1	0	1	件	11.574	11.574	
23		3HL-9	120*80*6.3mm扁通+75*50*5mm角鉄	热浸鋅	1	0	1	件	25.930	25.930	
24	A	3HL-10	120*80*6.3mm扁通+85*30*6mm角鉄	热浸鋅	1	0	1	件	23.430	23.430	新增图纸
25		3HL-11	120*80*6.3mm扁通+75*50*5mm角鉄	热浸鋅	1	0	1	件	34.506	34.506	
26		3HL-12	120*80*6.3mm扁通+75*50*5mm角鉄	热浸鋅	1	0	1	件	33.384	33.384	
27		3HL-13	120*80*6.3mm扁通+75*50*5mm角鉄	热浸鋅	1	0	1	件	33.513	33.513	
28		3HL-14	120*80*6.3mm扁通+75*50*5mm角鉄	热浸鋅	1	0	1	件	33.310	33.310	
29		3HL-15	120*80*6.3mm扁通+75*50*5mm角鉄	热浸鋅	1	0	1	件	33.421	33.421	
30		3HL-16	120*80*6.3mm扁通+75*50*5mm角鉄	热浸鋅	2	0	2	件	33.513	67.026	
31		3HL-17	120*80*6.3mm扁通+75*50*5mm角鉄	热浸鋅	1	0	1	件	33.384	33.384	
32		3HL-19	120*80*6.3mm扁通+75*50*5mm角鉄	热浸鋅	1	0	1	件	33.770	33.770	
33		3HL-20	120*80*6.3mm扁通+75*50*5mm角鉄	热浸鋅	1	0	1	件	33.862	33.862	
34		3HL-21	120*80*6.3mm扁通+75*50*5mm角鉄	热浸鋅	1	0	1	件	27.936	27.936	
35	A	3HL-22	120*80*6.3mm扁通	热浸鋅	1	0	1	件	31.464	31.464	构件取消、变为3HL-27
36	A	3HL-23	120*80*6.3mm扁通	热浸鋅	1	0	1	件	31.593	31.593	取消M5牙孔、并切为47高U槽
37	A	3HL-24	120*80*6.3mm扁通	热浸鋅	1	0	1	件	31.390	31.390	取消M5牙孔、并切为47高U槽
38	A	3HL-25	120*80*6.3mm扁通	热浸鋅	1	0	1	件	31.501	31.501	取消M5牙孔、并切为47高U槽

 美特鋁質 有限公司 MIDI Aluminium Fabricator Ltd.		工程號: J836-WW4	計算:			日期:	12/11/2018	送呈:			
地盤名稱: 日出康城7期平台		核對:				日期:	12/11/2018	副本:			
項目類別: 幕牆		批准:				日期:					
修改版次: C		A/C Code:				鐵件總重量KG:		21894.31			
BM編號: EI/9496											
序號	修改內容	鐵件圖號	鐵件名稱	顏色	實用	後備	總數	單位	單件 (kg)	總重量 (kg)	備注
39	C	3HL-26	120*80*6.3mm扁通	熱浸鋅	7	0	7	件	31.270	218.890	切為47高U槽
40	A	3HL-27	120*80*6.3mm扁通	熱浸鋅	2	0	2	件	31.130	62.260	修改1同上、修改2數量加1由3HL-22變來
41		3HL-29	120*80*6.3mm扁通+75*50*5mm角鐵	熱浸鋅	1	0	1	件	12.534	12.534	
42	A	3HL-30	120*80*6.3mm扁通	熱浸鋅	1	0	1	件	26.496	26.496	取消M5牙孔、并切為47高U槽
43	A	3HL-31	120*80*6.3mm扁通+84*29*6mm角鐵	熱浸鋅	1	0	1	件	77.300	77.300	新增圖紙
44	A	3HL-32	120*80*6.3mm扁通+50*15*5mm鐵槽	熱浸鋅	1	0	1	件	44.207	44.207	增加牙孔、角碼
45	A	3HL-33	120*80*6.3mm扁通+50*15*5mm鐵槽	熱浸鋅	1	0	1	件	77.300	77.300	長度加長，增加牙孔/角碼、數量減1
46		3HL-34	120*80*6.3mm扁通+75*50*5mm角鐵	熱浸鋅	1	0	1	件	39.401	39.401	
47		3HL-35	120*80*6.3mm扁通+75*50*5mm角鐵	熱浸鋅	2	0	2	件	38.297	76.594	
48		3HL-36	120*80*6.3mm扁通+75*50*5mm角鐵	熱浸鋅	2	0	2	件	38.297	76.594	
49	A	3HL-37	120*80*6.3mm扁通	熱浸鋅	1	0	1	件	31.593	31.593	取消M5牙孔、并切為47高U槽
50		3HL-38	120*80*6.3mm扁通+75*50*5mm角鐵	熱浸鋅	1	0	1	件	39.401	39.401	
51	A	3HL-39	120*80*6.3mm扁通+85*35*6mm角鐵	熱浸鋅	1	0	1	件	40.320	40.320	新增圖紙
52	A	3HL-40	120*80*6.3mm扁通	熱浸鋅	1	0	1	件	24.490	24.490	取消M5牙孔、并切為47高U槽
53		3HL-41	120*80*6.3mm扁通+75*50*5mm角鐵	熱浸鋅	1	0	1	件	33.642	33.642	
54		3HL-42	120*80*6.3mm扁通+75*50*5mm角鐵	熱浸鋅	1	0	1	件	34.157	34.157	
55	A	3HL-43	120*80*6.3mm扁通	熱浸鋅	1	0	1	件	32.237	32.237	去牙孔、開避位
56	A	3HL-44	120*80*6.3mm扁通	熱浸鋅	1	0	1	件	31.722	31.722	去牙孔、開避位
57	A	3HL-45	120*80*6.3mm扁通	熱浸鋅	1	0	1	件	31.850	31.850	去牙孔

 美特鋁質 有限公司 MEI TE Aluminium Fabricator Ltd.		工程號:	J836-WW4	計算:		日期:	12/11/2018	送呈:			
		地盤名稱:	日出康城7期平台	核對:		日期:	12/11/2018	副本:			
地盘鐵件BM表		項目類別:	幕牆	批准:		日期:					
BM編號:	EI/9496	修改版次:	C	A/C Code:		鐵件總重量KG:		21894.31			
序號	修改內容	鐵件圖號	鐵件名稱	顏色	實用	後備	總數	單位	單件 (kg)	總重量 (kg)	備注
58		3HL-46	120*80*6.3mm扁通+75*50*5mm角鐵	熱浸鋅	1	0	1	件	34.230	34.230	
59		3HL-47	75*50*6mm鐵槽+5mm鐵板	熱浸鋅	1	0	1	件	17.530	17.530	
60		3HL-49	75*50*6mm鐵槽+5mm鐵板	熱浸鋅	1	0	1	件	14.773	14.773	
61		3HL-50	75*50*6mm鐵槽+5mm鐵板	熱浸鋅	1	0	1	件	16.262	16.262	
62		3HL-51	75*50*6mm鐵槽+5mm鐵板	熱浸鋅	1	0	1	件	15.111	15.111	
63		3HL-52	75*50*6mm鐵槽+5mm鐵板	熱浸鋅	1	0	1	件	7.805	7.805	
64	C	3HL-54	75*50*6mm鐵槽+5mm鐵板	熱浸鋅	12	0	12	件	20.764	249.168	數量增加1件
65		3HL-55	75*50*6mm鐵槽+5mm鐵板	熱浸鋅	1	0	1	件	20.764	20.764	
66		3HL-56	75*50*6mm鐵槽+5mm鐵板	熱浸鋅	3	0	3	件	20.717	62.151	
67		3HL-58	75*50*6mm鐵槽+5mm鐵板	熱浸鋅	1	0	1	件	24.161	24.161	
68		3HL-59	75*50*6mm鐵槽+5mm鐵板	熱浸鋅	2	0	2	件	23.788	47.576	
69		3HL-60	75*50*6mm鐵槽+5mm鐵板	熱浸鋅	1	0	1	件	24.161	24.161	
70		3HL-61	75*50*6mm鐵槽+5mm鐵板	熱浸鋅	2	0	2	件	23.788	47.576	
71		3HL-63	75*50*6mm鐵槽+5mm鐵板	熱浸鋅	2	0	2	件	24.719	49.438	
72		3HL-64	75*50*6mm鐵槽+5mm鐵板	熱浸鋅	1	0	1	件	20.787	20.787	
73	A	3HL-65	120*80*6.3mm扁通+85*30*6mm角鐵	熱浸鋅	1	0	1	件	33.580	33.580	新增图纸
74		3HL-66	75*50*6mm鐵槽+5mm鐵板	熱浸鋅	3	0	3	件	20.683	62.049	
75		3HL-67	75*50*6mm鐵槽+5mm鐵板	熱浸鋅	1	0	1	件	20.415	20.415	
76		3HL-68	75*50*6mm鐵槽+5mm鐵板	熱浸鋅	1	0	1	件	20.741	20.741	

美特鋁質有限公司 MDI Aluminium Fabricator Ltd.		工程號: J836-WW4	計算:		日期:	12/11/2018	送呈:				
地盤名稱: 日出康城7期平台			核對:		日期:	12/11/2018	副本:				
項目類別: 幕牆			批准:		日期:						
地盤鐵件BM表		修改版次: C	A/C Code:		鐵件總重量KG:		21894.31				
BM編號:	EI/9496										
序號	修改內容	鐵件圖號	鐵件名稱	顏色	實用	後備	總數	單位	單件 (kg)	總重量 (kg)	備注
77	A	3HL-69	80*80*6mm方通	熱浸鋅	1	0	1	件	16.570	16.570	新增圖紙
78	A	3HL-70	80*80*6mm方通+70*50*5mm角鐵	熱浸鋅	1	0	1	件	17.478	17.478	新增M6沉頭孔
79		3HL-71	75*50*6mm鐵槽+5mm鐵板	熱浸鋅	1	0	1	件	20.892	20.892	
80		3HL-72	120*80*6.3mm扁通+75*50*5mm角鐵	熱浸鋅	1	0	1	件	47.570	47.570	
81	A	3HL-73	120*47*6.3mm鐵槽	熱浸鋅	1	0	1	件	32.770	32.770	去牙孔、開避位
82	C	3HL-74	120*80*6.3mm扁通+75*50*5mm角鐵	熱浸鋅	8	0	8	件	33.513	268.104	數量增加1件
83		3HL-75	120*80*6.3mm扁通+75*50*5mm角鐵	熱浸鋅	1	0	1	件	33.513	33.513	
84	A	3HL-76	120*80*6.3mm扁通	熱浸鋅	1	0	1	件	31.593	31.593	取消M5牙孔、并切为47高U槽
85	A	3HL-77	120*60*5mm扁通+50*50*5mm角鐵	熱浸鋅	1	0	1	件	57.480	57.480	新增圖紙
86	A	3HL-78	120*60*5mm扁通	熱浸鋅	1	0	1	件	52.920	52.920	新增圖紙
87	A	3HL-79	120*60*5mm扁通	熱浸鋅	1	0	1	件	8.080	8.080	新增圖紙
88	A	3HL-80	120*60*5mm扁通	熱浸鋅	2	0	2	件	26.700	53.400	新增圖紙
89	A	3HL-81	120*60*5mm扁通	熱浸鋅	2	0	2	件	26.200	52.400	新增圖紙
90	C	3HL-83	75*40*5mm角鐵+75*50*5mm角鐵	熱浸鋅	1	0	1	件	9.510	9.510	新增圖紙/角碼做散件出貨
91	C	3HL-84	75*40*5mm角鐵+75*50*5mm角鐵	熱浸鋅	1	0	1	件	9.510	9.510	新增圖紙/角碼做散件出貨
92	C	3HL-85	75*40*5mm角鐵+75*50*5mm角鐵	熱浸鋅	1	0	1	件	9.520	9.520	新增圖紙/角碼做散件出貨
93	C	3HL-86	75*40*5mm角鐵+75*50*5mm角鐵	熱浸鋅	1	0	1	件	9.520	9.520	新增圖紙/角碼做散件出貨
94	C	3HL-87	75*40*5mm角鐵+75*50*5mm角鐵	熱浸鋅	1	0	1	件	9.550	9.550	新增圖紙/角碼做散件出貨
95	C	3HL-88	75*40*5mm角鐵+75*50*5mm角鐵	熱浸鋅	1	0	1	件	9.550	9.550	新增圖紙/角碼做散件出貨

 美特鋁質有限公司 MIDI Aluminium Fabricator Ltd.		工程號:	J836-WW4	計算:		日期:	12/11/2018	送呈:			
地盤名稱:		日出康城7期平台			核對:		日期:	12/11/2018	副本:		
項目類別:		幕牆			批准:		日期:				
地盤鐵件BM表											
BM編號:	EI/9496	修改版次:	C	A/C Code:		鐵件總重量KG:		21894.31			
序號	修改內容	鐵件圖號	鐵件名稱	顏色	實用	後備	總數	單位	單件 (kg)	總重量 (kg)	備注
96	C	3HL-89	75*40*5mm角鐵+75*50*5mm角鐵	熱浸鋅	1	0	1	件	9.510	9.510	新增圖紙/角碼做散件出貨
97	C	3HL-90	75*40*5mm角鐵+75*50*5mm角鐵	熱浸鋅	1	0	1	件	9.510	9.510	新增圖紙/角碼做散件出貨
98	C	3HL-91	75*40*5mm角鐵+75*50*5mm角鐵	熱浸鋅	1	0	1	件	9.520	9.520	新增圖紙/角碼做散件出貨
99	C	3HL-92	75*40*5mm角鐵+75*50*5mm角鐵	熱浸鋅	1	0	1	件	9.520	9.520	新增圖紙/角碼做散件出貨
100	C	3HL-93	75*40*5mm角鐵+75*50*5mm角鐵	熱浸鋅	1	0	1	件	9.550	9.550	新增圖紙/角碼做散件出貨
101	C	3HL-94	75*40*5mm角鐵+75*50*5mm角鐵	熱浸鋅	1	0	1	件	9.550	9.550	新增圖紙/角碼做散件出貨
102	C	3MZ-1	50*50*6mm角鐵	熱浸鋅	96	0	96	件	0.447	42.912	數量增加2件
103		3MZ-2	50*50*6mm角鐵	熱浸鋅	36	0	36	件	0.402	14.472	
104	A	3MZ-3	50*50*6mm角鐵	熱浸鋅	4	0	4	件	0.268	1.072	數量增加2件
105	C	3MZ-10	50*50*5mm角鐵	熱浸鋅	25	0	25	件	0.760	19.000	新增圖紙 / 數量減少16件
106	C	3P-1	4mm鐵板	熱浸鋅	144	0	144	件	0.050	7.200	數量增加4件
107	C	3QM-1	100*75*6mm角鐵	熱浸鋅	70	0	70	件	1.447	101.290	數量增加2件
108		3QM-2	100*75*6mm角鐵	熱浸鋅	4	0	4	件	0.804	3.216	
109	A	3SB-53	120*47*6.3mm鐵槽	熱浸鋅	2	0	2	件	31.593	63.186	去牙孔
110	A	3SC-1	110*100*12.5mm鐵槽	熱浸鋅	1	0	1	件	49.267	49.267	增加牙孔
111	A	3SC-2	80*40*6mm鐵槽+50*50*5mm角鐵	熱浸鋅	1	0	1	件	43.056	43.056	增加M5牙孔長度減短、數量減1變為3SC-27
112	A	3SC-3	75*50*5mm角鐵	熱浸鋅	1	0	1	件	11.780	11.780	新增圖紙
113	A	3SC-4	160*80*6mm扁通+50*50*5mm角鐵	熱浸鋅	1	0	1	件	86.675	86.675	增加牙孔、數量減2 變為3SC-14
114	A	3SC-5	160*80*6mm扁通+50*50*5mm角鐵	熱浸鋅	1	0	1	件	86.675	86.675	增加牙孔、去角碼

 美特鋁質 有限公司 MEI TE Aluminium Fabricator Ltd.		工程號:	J836-WW4	計算:		日期:	12/11/2018	送呈:			
地盤名稱:		項目類別:	幕牆	核對:		日期:	12/11/2018	副本:			
修改版次:		修改版次:	C	批准:		日期:					
BM編號:		修改版次:	C	A/C Code:		鐵件總重量KG:		21894.31			
序號	修改內容	鐵件圖號	鐵件名稱	顏色	實用	後備	總數	單位	單件 (kg)	總重量 (kg)	備注
115	A	3SC-6	160*80*6mm扁通	熱浸鋅	1	0	1	件	75.555	75.555	增加牙孔、圓孔、長度減短
116	A	3SC-7	160*80*6mm扁通	熱浸鋅	1	0	1	件	75.762	75.762	加牙孔/加底板/長度減短, 數量減2變為3SC-25/33
117	C	3SC-8	160*80*6mm扁通	熱浸鋅	8	0	8	件	75.555	604.440	加牙孔/長度減短, 數量減6變為3SC-22/23/24/28
118	A	3SC-9	160*80*6mm扁通	熱浸鋅	1	0	1	件	75.555	75.555	增加M5牙孔、長度減短
119	A	3SC-10	160*80*6mm扁通	熱浸鋅	1	0	1	件	75.762	75.762	加牙孔/加底板/長度減短, 數量減2變為3SC-26/32
120	A	3SC-11	160*80*6mm扁通	熱浸鋅	1	0	1	件	75.762	75.762	增加M5牙孔、長度減短
121	A	3SC-12	160*80*6mm扁通	熱浸鋅	1	0	1	件	75.762	75.762	增加M5牙孔、長度減短
122	A	3SC-13	160*80*6mm扁通	熱浸鋅	2	0	2	件	85.967	171.934	增加底板、數量減1 變為3SC-14
123	A	3SC-14	160*80*6mm扁通	熱浸鋅	5	0	5	件	85.967	429.835	數量增加3件
124		3SC-15	75*40*6mm鐵槽+75*57*8mm折角	熱浸鋅	1	0	1	件	50.107	50.107	
125	A	3SC-16	100*100*10mm方通	熱浸鋅	1	0	1	件	101.835	101.835	增加M5牙孔、長度減短
126	A	3SC-17	100*100*10mm方通	熱浸鋅	1	0	1	件	101.835	101.835	增加M5牙孔、長度減短
127	A	3SC-18	44*100*5mm折槽+50*50*5mm角鐵	熱浸鋅	4	0	4	件	34.685	138.740	增加M5牙孔、長度減短
128	A	3SC-19	44*100*5mm折槽+50*50*5mm角鐵	熱浸鋅	1	0	1	件	29.949	29.949	增加牙孔、長度減短、數量減1 變為3SC-29
129		3SC-20	44*100*5mm折槽+60*85*8mm鐵槽	熱浸鋅	1	0	1	件	8.427	8.427	
130		3SC-21	44*100*5mm折槽+60*85*8mm鐵槽	熱浸鋅	1	0	1	件	8.427	8.427	
131	C	3SC-22	160*80*6mm扁通	熱浸鋅	3	0	3	件	75.555	226.665	新增圖紙 由3SC-8變來
132	A	3SC-23	160*80*6mm扁通	熱浸鋅	2	0	2	件	75.555	151.110	增加牙孔、長度減短、數量加1由3SC-8變來
133	A	3SC-24	160*80*6mm扁通	熱浸鋅	2	0	2	件	75.555	151.110	增加牙孔、長度減短、數量加1由3SC-8變來

 美特鋁質 有限公司 MIDI Aluminium Fabricator Ltd.		工程號:	J836-WW4	計算:		日期:	12/11/2018	送呈:			
		地盤名稱:	日出康城7期平台	核對:		日期:	12/11/2018	副本:			
地盘鐵件BM表		項目類別:	幕牆	批准:		日期:					
BM編號:	EI/9496	修改版次:	C	A/C Code:		鐵件總重量KG:		21894.31			
序號	修改內容	鐵件圖號	鐵件名稱	顏色	實用	後備	總數	單位	單件 (kg)	總重量 (kg)	備注
134	A	3SC-25	160*80*6mm扁通+16mm鐵板	熱浸鋅	1	0	1	件	90.170	90.170	新增圖紙 由3SC-7變來
135	A	3SC-26	160*80*6mm扁通+16mm鐵板	熱浸鋅	1	0	1	件	115.600	115.600	新增圖紙 由3SC-10變來
136	A	3SC-27	160*80*6mm扁通+50*50*5mm角鐵	熱浸鋅	1	0	1	件	115.600	115.600	新增圖紙 由3SC-2變來
137	A	3SC-28	160*80*6mm扁通	熱浸鋅	1	0	1	件	115.600	115.600	新增圖紙 由3SC-8變來
138	A	3SC-29	100*40*10mm鐵槽	熱浸鋅	1	0	1	件	41.450	41.450	新增圖紙 由3SC-19變來
139	A	3SC-32	160*80*6mm扁通	熱浸鋅	1	0	1	件	44.110	44.110	新增圖紙 由3SC-10變來
140	A	3SC-33	160*80*6mm扁通	熱浸鋅	1	0	1	件	18.670	18.670	新增圖紙 由3SC-7變來
141	A	3SC-34	160*80*6mm扁通	熱浸鋅	1	0	1	件	52.630	52.630	新增圖紙
142		3SJ-1	50*50*5mm角鐵	熱浸鋅	16	0	16	件	0.377	6.032	
143	A	3SJ-3	54*70*6mm鐵槽	熱浸鋅	2	0	2	件	3.060	6.120	修改孔徑
144		3SJ-4	75*50*5mm角鐵	熱浸鋅	16	0	16	件	0.480	7.680	
145	C	3SJ-7	75*50*5mm角鐵	熱浸鋅	49	0	49	件	0.480	23.520	新增圖紙
146	A	3SJ-12	6mm鐵板	熱浸鋅	1	0	1	件	3.770	3.770	新增圖紙
147	A	3SP-1	16mm鐵板	熱浸鋅	14	0	14	件	15.070	210.980	新增圖紙
148		3SU-1	60*75*6mm鐵槽+100*50*8mm角鐵	熱浸鋅	1	0	1	件	23.431	23.431	
149		3SU-2	60*75*6mm鐵槽+100*50*8mm角鐵	熱浸鋅	1	0	1	件	23.412	23.412	
150		3SU-3	60*75*6mm鐵槽+100*50*8mm角鐵	熱浸鋅	3	0	3	件	23.450	70.350	
151	A	3SU-5	55*75*6mm鐵槽+100*50*8mm角鐵	熱浸鋅	1	0	1	件	23.421	23.421	角碼移位
152	A	3SU-6	55*75*6mm鐵槽+100*50*8mm角鐵	熱浸鋅	1	0	1	件	23.160	23.160	角碼移位

 美特鋁質 有限公司 MIDI Aluminium Fabricator Ltd.		工程號: J836-WW4	計算:			日期:	12/11/2018	送呈:			
地盤名稱: 日出康城7期平台		項目類別: 幕牆	核對:			日期:	12/11/2018	副 本:			
修改版次: C		批准:				日期:					
BM編號: EI/9496		A/C Code:	鐵件總重量KG:			21894.31					
序號	修改內容	鐵件圖號	鐵件名稱	顏色	實用	後備	總數	單位	單件 (kg)	總重量 (kg)	備 注
153		3SU-7	55*75*6mm鐵槽+100*50*8mm角鐵	熱浸鋅	1	0	1	件	23.557	23.557	
154		3SU-8	60*75*6mm鐵槽+100*50*8mm角鐵	熱浸鋅	1	0	1	件	8.552	8.552	
155	C	3SU-9	60*75*6mm鐵槽+100*50*8mm角鐵	熱浸鋅	1	0	1	件	27.912	27.912	補回角碼、取消加孔
156	C	3SU-10	60*75*6mm鐵槽+100*50*8mm角鐵	熱浸鋅	3	0	3	件	27.873	83.619	補回角碼、取消加孔
157	C	3SU-11	60*75*6mm鐵槽+100*50*8mm角鐵	熱浸鋅	1	0	1	件	25.253	25.253	補回角碼、取消加孔
158	C	3SU-12	150*75*6mm鐵槽	熱浸鋅	1	0	1	件	10.220	10.220	新增圖紙 / 補回角碼、取消加孔
159	C	3SU-13	60*75*6mm鐵槽+100*50*8mm角鐵	熱浸鋅	1	0	1	件	27.960	27.960	補回角碼、取消加孔
160	C	3SU-14	60*75*6mm鐵槽+100*50*8mm角鐵	熱浸鋅	9	0	9	件	27.941	251.469	補回角碼、取消加孔
161	C	3SU-16	60*75*6mm鐵槽+100*50*8mm角鐵	熱浸鋅	1	0	1	件	24.199	24.199	補回角碼、取消加孔
162		4HL-1	120*80*6.3mm扁通+75*50*5mm角鐵	熱浸鋅	1	0	1	件	19.840	19.840	已送地盤
163		4HL-2	120*80*6.3mm扁通+75*50*5mm角鐵	熱浸鋅	2	0	2	件	21.754	43.508	已送地盤
164		4HL-3	120*80*6.3mm扁通+75*50*5mm角鐵	熱浸鋅	1	0	1	件	22.379	22.379	已送地盤
165		4HL-4	120*80*6.3mm扁通+75*50*5mm角鐵	熱浸鋅	1	0	1	件	21.993	21.993	已送地盤
166		4HL-5	120*80*6.3mm扁通+75*50*5mm角鐵	熱浸鋅	1	0	1	件	21.533	21.533	已送地盤
167		4HL-6	120*47*6.3mm鐵槽	熱浸鋅	1	0	1	件	27.876	27.876	已送地盤
168		4HL-7	120*47*6.3mm鐵槽	熱浸鋅	1	0	1	件	25.686	25.686	已送地盤
169		4HL-8	120*47*6.3mm鐵槽	熱浸鋅	1	0	1	件	18.400	18.400	已送地盤
170		4HL-9	120*47*6.3mm鐵槽	熱浸鋅	2	0	2	件	32.384	64.768	已送地盤
171		4HL-10	120*47*6.3mm鐵槽	熱浸鋅	1	0	1	件	11.187	11.187	已送地盤

 美特鋁質 有限公司 MEI TE Aluminium Fabricator Ltd.		工程號: J836-WW4	計算:		日期:	12/11/2018	送呈:				
地盤名稱: 日出康城7期平台		項目類別: 幕牆	核對:		日期:	12/11/2018	副本:				
修改版次: C		批准:			日期:						
BM編號: EI/9496		A/C Code:		鐵件總重量KG:		21894.31					
序號	修改內容	鐵件圖號	鐵件名稱	顏色	實用	後備	總數	單位	單件 (kg)	總重量 (kg)	備注
172		4HL-11	120*47*6.3mm鉄槽	熱浸鋅	16	0	16	件	20.093	321.488	已送地盤
173		4HL-13	120*80*6.3mm扁通+75*50*5mm角鉄	熱浸鋅	1	0	1	件	33.274	33.274	已送地盤
174		4HL-14	120*80*6.3mm扁通+75*50*5mm角鉄	熱浸鋅	1	0	1	件	25.838	25.838	已送地盤
175		4HL-15	120*80*6.3mm扁通+75*50*5mm角鉄	熱浸鋅	1	0	1	件	29.316	29.316	已送地盤
176		4HL-16	120*80*6.3mm扁通+75*50*5mm角鉄	熱浸鋅	1	0	1	件	31.174	31.174	已送地盤
177		4HL-17	120*80*6.3mm扁通	熱浸鋅	1	0	1	件	31.354	31.354	已送地盤
178		4HL-19	120*80*6.3mm扁通+75*50*5mm角鉄	熱浸鋅	6	0	6	件	33.421	200.526	已送地盤
179		4HL-20	120*80*6.3mm扁通+75*50*5mm角鉄	熱浸鋅	1	0	1	件	31.581	31.581	已送地盤
180		4HL-21	120*80*6.3mm扁通+75*50*5mm角鉄	熱浸鋅	1	0	1	件	33.366	33.366	已送地盤
181		4HL-22	120*80*6.3mm扁通+75*50*5mm角鉄	熱浸鋅	1	0	1	件	33.439	33.439	已送地盤
182		4HL-24	120*80*6.3mm扁通+75*50*5mm角鉄	熱浸鋅	1	0	1	件	33.458	33.458	已送地盤
183		4HL-25	120*80*6.3mm扁通+75*50*5mm角鉄	熱浸鋅	16	0	16	件	33.476	535.616	已送地盤
184		4HL-26	120*80*6.3mm扁通+75*50*5mm角鉄	熱浸鋅	2	0	2	件	34.322	68.644	已送地盤
185		4HL-27	120*80*6.3mm扁通+75*50*5mm角鉄	熱浸鋅	1	0	1	件	27.126	27.126	已送地盤
186		4HL-29	120*80*6.3mm扁通+75*50*5mm角鉄	熱浸鋅	1	0	1	件	17.667	17.667	已送地盤
187		4HL-31	120*80*6.3mm扁通	熱浸鋅	5	0	5	件	31.501	157.505	已送地盤
188		4HL-32	120*80*6.3mm扁通	熱浸鋅	1	0	1	件	29.661	29.661	已送地盤
189		4HL-33	120*80*6.3mm扁通	熱浸鋅	1	0	1	件	31.446	31.446	已送地盤
190		4HL-34	120*80*6.3mm扁通	熱浸鋅	1	0	1	件	31.519	31.519	已送地盤

 美特鋁質有限公司 MIDI Aluminium Fabricator Ltd.		工程號:	J836-WW4	計算:		日期:	12/11/2018	送呈:			
		地盤名稱: 日出康城7期平台		核對:		日期:	12/11/2018	副本:			
		項目類別: 幕牆		批准:		日期:					
地盘鐵件BM表											
BM編號:	EI/9496	修改版次:	C	A/C Code:		鐵件總重量KG:		21894.31			
序號	修改內容	鐵件圖號	鐵件名稱	顏色	實用	後備	總數	單位	單件 (kg)	總重量 (kg)	備注
191		4HL-36	120*80*6.3mm扁通	熱浸鋅	1	0	1	件	31.538	31.538	已送地盘
192		4HL-37	120*80*6.3mm扁通+75*50*5mm角鉄	熱浸鋅	1	0	1	件	12.147	12.147	已送地盘
193		4HL-38	120*80*6.3mm扁通+75*50*5mm角鉄	熱浸鋅	1	0	1	件	18.612	18.612	已送地盘
194		4HL-39	120*80*6.3mm扁通	熱浸鋅	1	0	1	件	16.707	16.707	已送地盘
195		4HL-40	120*80*6.3mm扁通+75*50*5mm角鉄	熱浸鋅	1	0	1	件	29.261	29.261	已送地盘
196		4HL-41	120*80*6.3mm扁通+75*50*5mm角鉄	熱浸鋅	1	0	1	件	27.439	27.439	已送地盘
197		4HL-42	120*80*6.3mm扁通+75*50*5mm角鉄	熱浸鋅	1	0	1	件	25.562	25.562	已送地盘
198		4HL-43	120*80*6.3mm扁通	熱浸鋅	1	0	1	件	27.821	27.821	已送地盘
199		4HL-44	120*80*6.3mm扁通	熱浸鋅	1	0	1	件	25.999	25.999	已送地盘
200		4HL-45	120*80*6.3mm扁通	熱浸鋅	1	0	1	件	24.122	24.122	已送地盘
201		4HL-46	120*80*6.3mm扁通+75*50*5mm角鉄	熱浸鋅	1	0	1	件	23.557	23.557	已送地盘
202		4HL-47	120*80*6.3mm扁通	熱浸鋅	1	0	1	件	22.117	22.117	已送地盘
203		4HL-48	120*80*6.3mm扁通	熱浸鋅	2	0	2	件	20.295	40.590	已送地盘
204		4HL-49	120*47*6.3mm鉄槽	熱浸鋅	1	0	1	件	20.553	20.553	已送地盘
205		4HL-50	120*47*6.3mm鉄槽	熱浸鋅	1	0	1	件	20.939	20.939	已送地盘
206		4HL-51	120*47*6.3mm鉄槽	熱浸鋅	1	0	1	件	24.398	24.398	已送地盘
207		4HL-52	120*47*6.3mm鉄槽	熱浸鋅	2	0	2	件	20.295	40.590	已送地盘
208		4HL-53	120*47*6.3mm鉄槽	熱浸鋅	1	0	1	件	20.387	20.387	已送地盘
209		4HL-54	120*47*6.3mm鉄槽	熱浸鋅	1	0	1	件	20.682	20.682	已送地盘

 美特鋁質 有限公司 MIDI Aluminium Fabricator Ltd.		工程號:	J836-WW4	計算:			日期:	12/11/2018	送呈:		
		地盤名稱:		日出康城7期平台	核對:			日期:	12/11/2018	副本:	
		項目類別:		幕牆	批准:			日期:			
地盤鐵件BM表											
BM編號:		EI/9496	修改版次:		A/C Code:		鐵件總重量KG:		21894.31		
序號	修改內容	鐵件圖號	鐵件名稱	顏色	實用	後備	總數	單位	單件 (kg)	總重量 (kg)	備注
210		4HL-55	120*47*6.3mm鐵槽	熱浸鋅	3	0	3	件	20.829	62.487	已送地盤
211		4HL-56	120*80*6.3mm扁通+75*50*5mm角鐵	熱浸鋅	1	0	1	件	22.122	22.122	已送地盤
212		4HL-57	120*80*6.3mm扁通+75*50*5mm角鐵	熱浸鋅	3	0	3	件	22.269	66.807	已送地盤
213		4HL-58	120*80*6.3mm扁通+75*50*5mm角鐵	熱浸鋅	1	0	1	件	21.827	21.827	已送地盤
214		4HL-59	120*80*6.3mm扁通+75*50*5mm角鐵	熱浸鋅	5	0	5	件	21.735	108.675	已送地盤
215		4HL-61	120*80*6.3mm扁通+75*50*5mm角鐵	熱浸鋅	6	0	6	件	39.033	234.198	已送地盤
216		4HL-63	120*80*6.3mm扁通+75*50*5mm角鐵	熱浸鋅	1	0	1	件	23.886	23.886	已送地盤
217		4HL-64	120*80*6.3mm扁通+75*50*5mm角鐵	熱浸鋅	1	0	1	件	32.113	32.113	已送地盤
218		4HL-65	120*47*6.3mm鐵槽	熱浸鋅	1	0	1	件	30.654	30.654	已送地盤
219		4HL-66	120*47*6.3mm鐵槽	熱浸鋅	1	0	1	件	22.926	22.926	已送地盤
220		4HL-67	120*47*6.3mm鐵槽	熱浸鋅	2	0	2	件	20.314	40.628	已送地盤
221		4HL-68	75*50*6mm鐵槽+5mm鐵板	熱浸鋅	1	0	1	件	21.334	21.334	已送地盤
222		4HL-69	75*50*6mm鐵槽+5mm鐵板	熱浸鋅	1	0	1	件	15.971	15.971	已送地盤
223		4HL-70	75*50*6mm鐵槽+5mm鐵板	熱浸鋅	1	0	1	件	19.589	19.589	已送地盤
224		4HL-71	75*50*6mm鐵槽+5mm鐵板	熱浸鋅	1	0	1	件	18.403	18.403	已送地盤
225		4HL-72	75*50*6mm鐵槽+5mm鐵板	熱浸鋅	1	0	1	件	17.251	17.251	已送地盤
226		4HL-73	75*50*6mm鐵槽+5mm鐵板	熱浸鋅	1	0	1	件	16.064	16.064	已送地盤
227		4HL-74	75*50*6mm鐵槽+5mm鐵板	熱浸鋅	1	0	1	件	14.820	14.820	已送地盤
228		4HL-75	75*50*6mm鐵槽+5mm鐵板	熱浸鋅	3	0	3	件	13.680	41.040	已送地盤

 美特鋁質 有限公司 MIDI Aluminium Fabricator Ltd.		工程號: J836-WW4	計算:		日期:	12/11/2018	送呈:				
地盤名稱: 日出康城7期平台			核對:		日期:	12/11/2018	副本:				
項目類別: 幕牆			批准:		日期:						
修改版次: EI/9496		C	A/C Code:		鐵件總重量KG:		21894.31				
序號	修改內容	鐵件圖號	鐵件名稱	顏色	實用	後備	總數	單位	單件 (kg)	總重量 (kg)	備注
229		4HL-76	75*50*6mm鐵槽+5mm鐵板	熱浸鋅	4	0	4	件	13.691	54.764	已送地盤
230		4HL-77	75*50*6mm鐵槽+5mm鐵板	熱浸鋅	1	0	1	件	11.993	11.993	已送地盤
231		4HL-78	75*50*6mm鐵槽+5mm鐵板	熱浸鋅	1	0	1	件	15.902	15.902	已送地盤
232		4HL-79	75*50*6mm鐵槽+5mm鐵板	熱浸鋅	4	0	4	件	13.761	55.044	已送地盤
233		4HL-80	75*50*6mm鐵槽+5mm鐵板	熱浸鋅	1	0	1	件	13.750	13.750	已送地盤
234		4HL-81	75*50*6mm鐵槽+5mm鐵板	熱浸鋅	1	0	1	件	13.610	13.610	已送地盤
235		4HL-82	75*50*6mm鐵槽+5mm鐵板	熱浸鋅	1	0	1	件	7.864	7.864	已送地盤
236		4HL-83	75*50*6mm鐵槽+5mm鐵板	熱浸鋅	1	0	1	件	10.765	10.765	已送地盤
237		4HL-84	75*50*6mm鐵槽+5mm鐵板	熱浸鋅	17	0	17	件	20.752	352.784	已送地盤
238		4HL-85	75*50*6mm鐵槽+5mm鐵板	熱浸鋅	1	0	1	件	20.752	20.752	已送地盤
239		4HL-86	75*50*6mm鐵槽+5mm鐵板	熱浸鋅	4	0	4	件	20.729	82.916	已送地盤
240		4HL-87	75*50*6mm鐵槽+5mm鐵板	熱浸鋅	1	0	1	件	20.741	20.741	已送地盤
241		4HL-88	75*50*6mm鐵槽+5mm鐵板	熱浸鋅	1	0	1	件	20.671	20.671	已送地盤
242		4HL-89	75*50*6mm鐵槽+5mm鐵板	熱浸鋅	1	0	1	件	20.706	20.706	已送地盤
243		4HL-90	75*50*6mm鐵槽+5mm鐵板	熱浸鋅	1	0	1	件	19.566	19.566	已送地盤
244		4HL-91	75*50*6mm鐵槽+5mm鐵板	熱浸鋅	2	0	2	件	21.276	42.552	已送地盤
245		4HL-92	75*50*6mm鐵槽+5mm鐵板	熱浸鋅	4	0	4	件	24.254	97.016	已送地盤
246		4HL-94	75*50*6mm鐵槽+5mm鐵板	熱浸鋅	1	0	1	件	20.741	20.741	已送地盤
247		4HL-95	75*35*6mm鐵槽	熱浸鋅	1	0	1	件	15.356	15.356	已送地盤

 美特鋁質有限公司 MIDI Aluminium Fabricator Ltd.		工程號:	J836-WW4	計算:		日期:	12/11/2018	送呈:			
		地盤名稱:	日出康城7期平台	核對:		日期:	12/11/2018	副本:			
		項目類別:	幕牆	批准:		日期:					
地盤鐵件BM表		修改版次:	C	A/C Code:		鐵件總重量KG:		21894.31			
BM編號:	EI/9496										
序號	修改內容	鐵件圖號	鐵件名稱	顏色	實用	後備	總數	單位	單件 (kg)	總重量 (kg)	備注
248		4HL-96	75*35*6mm鐵槽	熱浸鋅	1	0	1	件	14.234	14.234	已送地盤
249		4HL-97	75*35*6mm鐵槽	熱浸鋅	1	0	1	件	10.366	10.366	已送地盤
250		4HL-98	75*50*6mm鐵槽+5mm鐵板	熱浸鋅	2	0	2	件	24.254	48.508	已送地盤
251		4HL-99	75*50*6mm鐵槽+5mm鐵板	熱浸鋅	1	0	1	件	13.761	13.761	已送地盤
252		4HL-100	75*50*6mm鐵槽+5mm鐵板	熱浸鋅	1	0	1	件	27.663	27.663	已送地盤
253		4HL-101	75*50*6mm鐵槽+5mm鐵板	熱浸鋅	1	0	1	件	27.639	27.639	已送地盤
254		4HL-102	75*50*6mm鐵槽+5mm鐵板	熱浸鋅	3	0	3	件	27.663	82.989	已送地盤
255		4HL-103	75*50*6mm鐵槽+5mm鐵板	熱浸鋅	1	0	1	件	24.137	24.137	已送地盤
256		4HL-104	75*50*6mm鐵槽+5mm鐵板	熱浸鋅	1	0	1	件	24.370	24.370	已送地盤
257		4HL-105	75*50*6mm鐵槽+5mm鐵板	熱浸鋅	1	0	1	件	13.715	13.715	已送地盤
258		4HL-106	75*50*6mm鐵槽	熱浸鋅	1	0	1	件	16.226	16.226	已送地盤
259		4HL-107	75*50*6mm鐵槽+5mm鐵板	熱浸鋅	1	0	1	件	9.457	9.457	已送地盤
260		4HL-108	75*50*6mm鐵槽+5mm鐵板	熱浸鋅	1	0	1	件	9.469	9.469	已送地盤
261		4HL-109	75*50*6mm鐵槽+5mm鐵板	熱浸鋅	1	0	1	件	9.515	9.515	已送地盤
262		4HL-110	75*50*6mm鐵槽+5mm鐵板	熱浸鋅	1	0	1	件	9.597	9.597	已送地盤
263		4HL-112	120*80*6.3mm扁通+75*50*5mm角鐵	熱浸鋅	1	0	1	件	38.849	38.849	已送地盤
264		4HL-113	120*80*6.3mm扁通+75*50*5mm角鐵	熱浸鋅	1	0	1	件	39.217	39.217	已送地盤
265		4HL-116	120*80*6.3mm扁通	熱浸鋅	1	0	1	件	15.327	15.327	已送地盤
266		4HL-117	120*80*6.3mm扁通	熱浸鋅	1	0	1	件	14.996	14.996	已送地盤

美特鋁質 有限公司 MDI Aluminium Fabricator Ltd.		工程號:	J836-WW4	計算:		日期:	12/11/2018	送呈:			
		地盤名稱:	日出康城7期平台	核對:		日期:	12/11/2018	副本:			
地盘鐵件BM表		項目類別:	幕牆	批准:		日期:					
BM編號:		EI/9496	修改版次:	C	A/C Code:	鐵件總重量KG:		21894.31			
序號	修改內容	鐵件圖號	鐵件名稱	顏色	實用	後備	總數	單位	單件 (kg)	總重量 (kg)	備注
267		4HL-120	120*80*6.3mm扁通+75*50*5mm角鉄	热浸鋅	1	0	1	件	42.934	42.934	已送地盘
268		4HL-121	120*80*6.3mm扁通+75*50*5mm角鉄	热浸鋅	1	0	1	件	42.934	42.934	已送地盘
269		4HL-122	80*120*6.3mm鉄槽	热浸鋅	1	0	1	件	30.866	30.866	已送地盘
270		4HL-123	80*120*6.3mm鉄槽	热浸鋅	1	0	1	件	30.866	30.866	已送地盘
271		4HL-124	120*80*6.3mm扁通+75*50*5mm角鉄	热浸鋅	1	0	1	件	42.934	42.934	已送地盘
272		4HL-125	80*120*6.3mm鉄槽	热浸鋅	1	0	1	件	30.866	30.866	已送地盘
273		4HL-126	120*80*6.3mm扁通+75*50*5mm角鉄	热浸鋅	1	0	1	件	42.915	42.915	已送地盘
274		4HL-127	80*120*6.3mm鉄槽	热浸鋅	1	0	1	件	30.852	30.852	已送地盘
275		4HL-128	120*80*6.3mm扁通+75*50*5mm角鉄	热浸鋅	1	0	1	件	43.099	43.099	已送地盘
276		4HL-129	80*120*6.3mm鉄槽	热浸鋅	1	0	1	件	30.990	30.990	已送地盘
277		4HL-130	120*80*6.3mm扁通+75*50*5mm角鉄	热浸鋅	1	0	1	件	30.181	30.181	已送地盘
278		4HL-131	120*47*6.3mm鉄槽	热浸鋅	1	0	1	件	28.741	28.741	已送地盘
279		4HL-134	120*80*6.3mm扁通+75*50*5mm角鉄	热浸鋅	1	0	1	件	15.965	15.965	已送地盘
280		4HL-135	120*80*6.3mm扁通+75*50*5mm角鉄	热浸鋅	1	0	1	件	15.919	15.919	已送地盘
281		4HL-136	120*80*6.3mm扁通+75*50*5mm角鉄	热浸鋅	1	0	1	件	15.956	15.956	已送地盘
282		4HL-137	120*80*6.3mm扁通+75*50*5mm角鉄	热浸鋅	1	0	1	件	16.287	16.287	已送地盘
283		4HL-138	120*80*6.3mm扁通	热浸鋅	1	0	1	件	14.996	14.996	已送地盘
284		4HL-139	120*80*6.3mm扁通	热浸鋅	1	0	1	件	14.959	14.959	已送地盘
285		4MZ-1	50*50*6mm角鉄	热浸鋅	240	0	240	件	0.447	107.280	已送地盘

美特鋁質有限公司 MDI Aluminium Fabricator Ltd.		工程號:	J836-WW4	計算:			日期:	12/11/2018	送呈:		
		地盤名稱:	日出康城7期平台	核對:			日期:	12/11/2018	副本:		
地盤鐵件BM表		項目類別:	幕牆	批准:			日期:				
BM編號:	EI/9496	修改版次:	C	A/C Code:			鐵件總重量KG:		21894.31		
序號	修改內容	鐵件圖號	鐵件名稱	顏色	實用	後備	總數	單位	單件 (kg)	總重量 (kg)	備注
286		4MZ-2	50*50*6mm角鉄	熱浸鋅	56	0	56	件	0.402	22.512	已送地盤
287		4P-1	4mm鉄板	熱浸鋅	312	0	312	件	0.050	15.600	已送地盤
288		4QM-1	100*50*5mm角鉄	熱浸鋅	156	0	156	件	1.447	225.732	已送地盤
289		4SC-7	160*80*6mm扁通	熱浸鋅	1	0	1	件	73.071	73.071	已送地盤
290		4SC-8	160*80*6mm扁通	熱浸鋅	2	0	2	件	73.071	146.142	已送地盤
291		4SC-9	160*80*6mm扁通	熱浸鋅	13	0	13	件	79.695	1036.035	已送地盤
292		4SC-9A	160*80*6mm扁通	熱浸鋅	4	0	4	件	71.312	285.248	已送地盤
293		4SC-9B	160*80*6mm扁通	熱浸鋅	17	0	17	件	55.890	950.130	已送地盤
294		4SC-10	160*80*6mm扁通	熱浸鋅	6	0	6	件	73.071	438.426	已送地盤
295		4SC-11	160*80*6mm扁通	熱浸鋅	4	0	4	件	73.071	292.284	已送地盤
296		4SC-12	160*80*6mm扁通	熱浸鋅	2	0	2	件	71.312	142.624	已送地盤
297		4SC-12A	160*80*6mm扁通	熱浸鋅	1	0	1	件	55.890	55.890	已送地盤
298		4SC-13	160*80*6mm扁通	熱浸鋅	1	0	1	件	79.695	79.695	已送地盤
299		4SC-14	160*80*6mm扁通	熱浸鋅	11	0	11	件	57.443	631.873	已送地盤
300		4SC-16	160*80*6mm扁通	熱浸鋅	1	0	1	件	57.443	57.443	已送地盤
301		4SC-17	160*80*6mm扁通	熱浸鋅	2	0	2	件	73.071	146.142	已送地盤
302		4SC-19	160*80*6mm扁通	熱浸鋅	1	0	1	件	73.071	73.071	已送地盤
303		4SC-20	160*80*6mm扁通	熱浸鋅	1	0	1	件	73.071	73.071	已送地盤
304		4SC-21	160*80*6mm扁通	熱浸鋅	2	0	2	件	79.695	159.390	已送地盤


美特鋁質有限公司 MIDI Aluminium Fabricator Ltd.		工程號:	J836-WW4	計算:		日期:	12/11/2018	送呈:			
		地盤名稱: 日出康城7期平台		核對:		日期:	12/11/2018	副本:			
地盤鐵件BM表		項目類別:	幕牆	批准:		日期:					
		修改版次:	C	A/C Code:		鐵件總重量KG: 21894.31					
BM編號:	EI/9496										
序號	修改內容	鐵件圖號	鐵件名稱	顏色	實用	後備	總數	單位	單件 (kg)	總重量 (kg)	備注
305		4SC-22	160*80*6mm扁通	熱浸鋅	8	0	8	件	79.695	637.560	已送地盤
306		4SC-23	160*80*6mm扁通	熱浸鋅	1	0	1	件	73.071	73.071	已送地盤
307		4SC-24	40*120*5mm鐵槽+50*50*5mm角鐵	熱浸鋅	1	0	1	件	34.685	34.685	已送地盤
308		4SC-25	40*120*5mm鐵槽+50*50*5mm角鐵	熱浸鋅	2	0	2	件	36.255	72.510	已送地盤
309		4SC-26	鐵件加工圖	熱浸鋅	1	0	1	件	73.469	73.469	已送地盤
310		4SC-27	鐵件加工圖	熱浸鋅	1	0	1	件	73.469	73.469	已送地盤
311		4SC-28	鐵件加工圖	熱浸鋅	1	0	1	件	80.526	80.526	已送地盤
312		4SC-29	鐵件加工圖	熱浸鋅	1	0	1	件	80.526	80.526	已送地盤
313		4SC-30	鐵件加工圖	熱浸鋅	1	0	1	件	80.526	80.526	已送地盤
314		4SC-31	鐵件加工圖	熱浸鋅	1	0	1	件	80.526	80.526	已送地盤
315		4SC-32	45*65*5mm折槽+78*62*8mm折角	熱浸鋅	1	0	1	件	37.490	37.490	已送地盤
316		4SJ-2	75*50*5mm角鐵	熱浸鋅	14	0	14	件	0.480	6.720	已送地盤
317		4SU-1	75*54*6mm鐵槽+100*50*8mm角鐵	熱浸鋅	2	0	2	件	25.939	51.878	已送地盤
318		4SU-2	75*54*6mm鐵槽+100*50*8mm角鐵	熱浸鋅	1	0	1	件	17.419	17.419	已送地盤
319		4SU-3	75*54*6mm鐵槽+100*50*8mm角鐵	熱浸鋅	1	0	1	件	20.424	20.424	已送地盤
320		4SU-4	75*60*6mm鐵槽+100*50*8mm角鐵	熱浸鋅	2	0	2	件	15.508	31.016	已送地盤
321		4SU-5	75*60*6mm鐵槽+100*50*8mm角鐵	熱浸鋅	2	0	2	件	15.498	30.996	已送地盤
322		4SU-6	75*54*6mm鐵槽+100*50*8mm角鐵	熱浸鋅	1	0	1	件	14.492	14.492	已送地盤
323		4SU-7	75*60*6mm鐵槽+100*50*8mm角鐵	熱浸鋅	1	0	1	件	19.408	19.408	已送地盤

 美特鋁質有限公司 MIDI Aluminium Fabricator Ltd.		工程號:	J836-WW4	計算:		日期:	12/11/2018	送呈:			
		地盤名稱:	日出康城7期平台	核對:		日期:	12/11/2018	副本:			
		項目類別:	幕牆	批准:		日期:					
地盘鐵件BM表											
BM編號:	EI/9496	修改版次:	C	A/C Code:		鐵件總重量KG:		21894.31			
序號	修改內容	鐵件圖號	鐵件名稱	顏色	實用	後備	總數	單位	單件 (kg)	總重量 (kg)	備注
324		4SU-8	75*60*6mm鉄槽+100*50*8mm角鉄	熱浸鋅	1	0	1	件	15.566	15.566	已送地盘
325		4SU-9	75*60*6mm鉄槽+100*50*8mm角鉄	熱浸鋅	1	0	1	件	15.566	15.566	已送地盘
326		4SU-10	75*60*6mm鉄槽+100*50*8mm角鉄	熱浸鋅	3	0	3	件	15.575	46.725	已送地盘
327		4SU-11	75*60*6mm鉄槽+100*50*8mm角鉄	熱浸鋅	1	0	1	件	15.556	15.556	已送地盘
328		4SU-12	75*54*6mm鉄槽+100*50*8mm角鉄	熱浸鋅	1	0	1	件	15.440	15.440	已送地盘
329		4SU-13	75*54*6mm鉄槽+100*50*8mm角鉄	熱浸鋅	1	0	1	件	25.734	25.734	已送地盘
330		4SU-14	75*60*6mm鉄槽+100*50*8mm角鉄	熱浸鋅	1	0	1	件	15.527	15.527	已送地盘
331		4SU-15	75*54*6mm鉄槽+100*50*8mm角鉄	熱浸鋅	1	0	1	件	17.838	17.838	已送地盘
332		4SU-16	75*54*6mm鉄槽+100*50*8mm角鉄	熱浸鋅	1	0	1	件	8.600	8.600	已送地盘
333		4SU-17	75*54*6mm鉄槽+100*50*8mm角鉄	熱浸鋅	1	0	1	件	26.924	26.924	已送地盘
334		4SU-18	75*60*6mm鉄槽+100*50*8mm角鉄	熱浸鋅	16	0	16	件	23.441	375.056	已送地盘
335		4SU-19	75*60*6鉄槽+50*50*6角鉄+100*100*8角鉄	熱浸鋅	1	0	1	件	28.342	28.342	已送地盘
336		4SU-21	75*60*6鉄槽+50*50*6角鉄+100*100*8角鉄	熱浸鋅	1	0	1	件	28.284	28.284	已送地盘
337		4SU-22	75*60*6鉄槽+50*50*6角鉄+100*100*8角鉄	熱浸鋅	1	0	1	件	28.313	28.313	已送地盘
338		4SU-23	75*60*6鉄槽+50*50*6角鉄+100*100*8角鉄	熱浸鋅	1	0	1	件	27.365	27.365	已送地盘
339		4SU-24	75*60*6鉄槽+50*50*6角鉄+100*100*8角鉄	熱浸鋅	1	0	1	件	20.538	20.538	已送地盘
340		4SU-25	75*60*6鉄槽+50*50*6角鉄+100*100*8角鉄	熱浸鋅	1	0	1	件	26.398	26.398	已送地盘
341		4SU-26	75*60*6鉄槽+50*50*6角鉄+100*100*8角鉄	熱浸鋅	1	0	1	件	25.441	25.441	已送地盘
342		4SU-27	75*60*6鉄槽+50*50*6角鉄+100*100*8角鉄	熱浸鋅	1	0	1	件	24.454	24.454	已送地盘


 美特鋁質 有限公司 MIDI Aluminium Fabricator Ltd.		工程號:	J836-WW4	計算:		日期:	12/11/2018	送呈:			
		地盤名稱:	日出康城7期平台	核對:		日期:	12/11/2018	副本:			
		項目類別:	幕牆	批准:		日期:					
地盘鐵件BM表		修改版次:	C	A/C Code:		鐵件總重量KG:		21894.31			
BM編號:	EI/9496										
序號	修改內容	鐵件圖號	鐵件名稱	顏色	實用	後備	總數	單位	單件 (kg)	總重量 (kg)	備注
343		4SU-28	75*60*6鉄槽+50*50*6角鉄+100*100*8角鉄	熱浸鋅	1	0	1	件	19.720	19.720	已送地盘
344		4SU-29	75*60*6鉄槽+50*50*6角鉄+100*100*8角鉄	熱浸鋅	2	0	2	件	18.772	37.544	已送地盘
345		4SU-30	75*60*6鉄槽+50*50*6角鉄+100*100*8角鉄	熱浸鋅	1	0	1	件	49.060	49.060	已送地盘
346		4SU-31	75*60*6鉄槽+50*50*6角鉄+100*100*8角鉄	熱浸鋅	1	0	1	件	49.040	49.040	已送地盘
347		4SU-32	75*60*6鉄槽+50*50*6角鉄+100*100*8角鉄	熱浸鋅	3	0	3	件	49.050	147.150	已送地盘
348		4SU-33	75*60*6鉄槽+50*50*6角鉄+100*100*8角鉄	熱浸鋅	5	0	5	件	28.351	141.755	已送地盘
349		4SU-35	75*60*6鉄槽+50*50*6角鉄+100*100*8角鉄	熱浸鋅	1	0	1	件	15.368	15.368	已送地盘
350		4SU-36	75*60*6鉄槽+50*50*6角鉄+100*100*8角鉄	熱浸鋅	1	0	1	件	15.262	15.262	已送地盘
351		4SU-37	75*60*6鉄槽+50*50*6角鉄+100*100*8角鉄	熱浸鋅	1	0	1	件	15.271	15.271	已送地盘
352		4SU-38	75*60*6鉄槽+50*50*6角鉄+100*100*8角鉄	熱浸鋅	1	0	1	件	15.300	15.300	已送地盘
合計:					1906			件	合共:	21894.308	

修改说明:

- 1, 2HL-6取消。
- 2, 新增5件2P-2。
- 3, 新增2件2MZ-2。

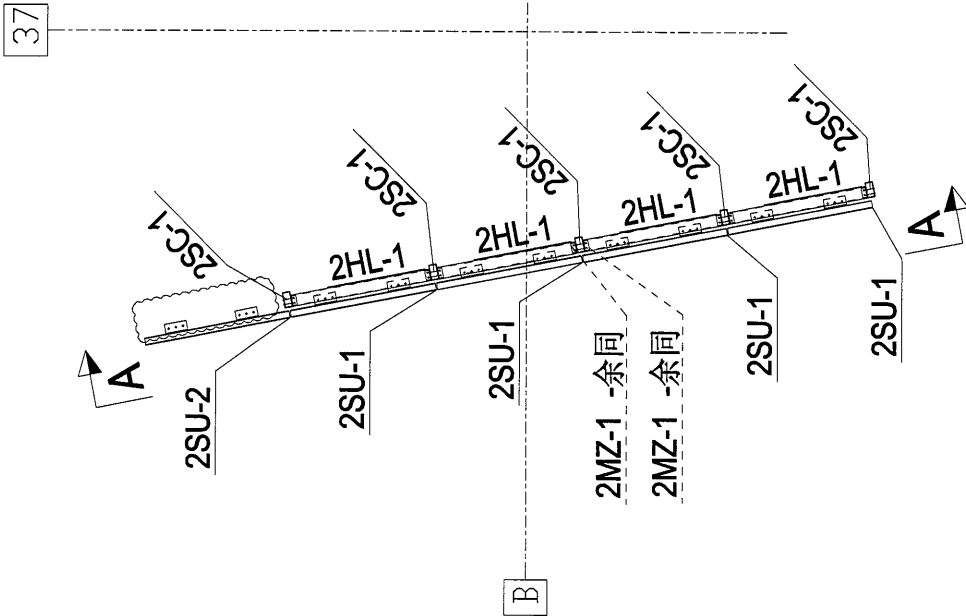

PART PLAN OF WINDOW-WALL (WW4)
@2/F-DOWN Scale: 1/100

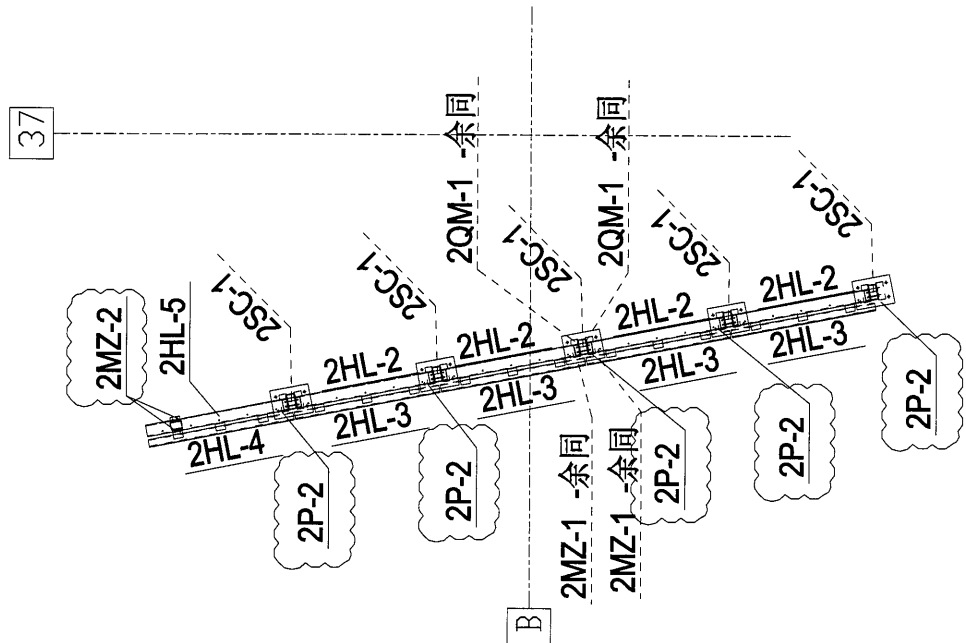


PART PLAN OF WINDOW-WALL (WW4)
@2/F-TOP Scale: 1/100

A	第2次提批	2018-11-05
Rev.	Description	Date
PROJECT:		
PROPOSED SITE C1 DEVELOPMENT AT AREA 86, TKOTL 70 RP, TSEUNG KWAN O, NEW TERRITORIES		
CLIENT:		
美特鋁質有限公司 MIDAL ALUMINIUM FABRICATOR LTD. Units 6-8, Sunray Industrial Centre, 1/F 810 Cheung Yee Ling Road, Kwun Tong Tel: 23489211-4 Fax: (852) 2772656		
S 银同有限公司 Silver Town Limited Tel: 0769-8335698 Fax: 0769-8339354 E-MAIL: ADDRESS@silvertown.com		
DRAWING TITLE:		
PART PLAN FOR WINDOW-WALL (WW4) @ 2/F		
CAD File Name:		
Designed by		
Drawn by		
Reviewed by		
Approved by		
Scale		
DWG NO.: J-836-WW4-MP11		REV.
		A

修改说明:

1, 3HL-73,3SU-7预长100。

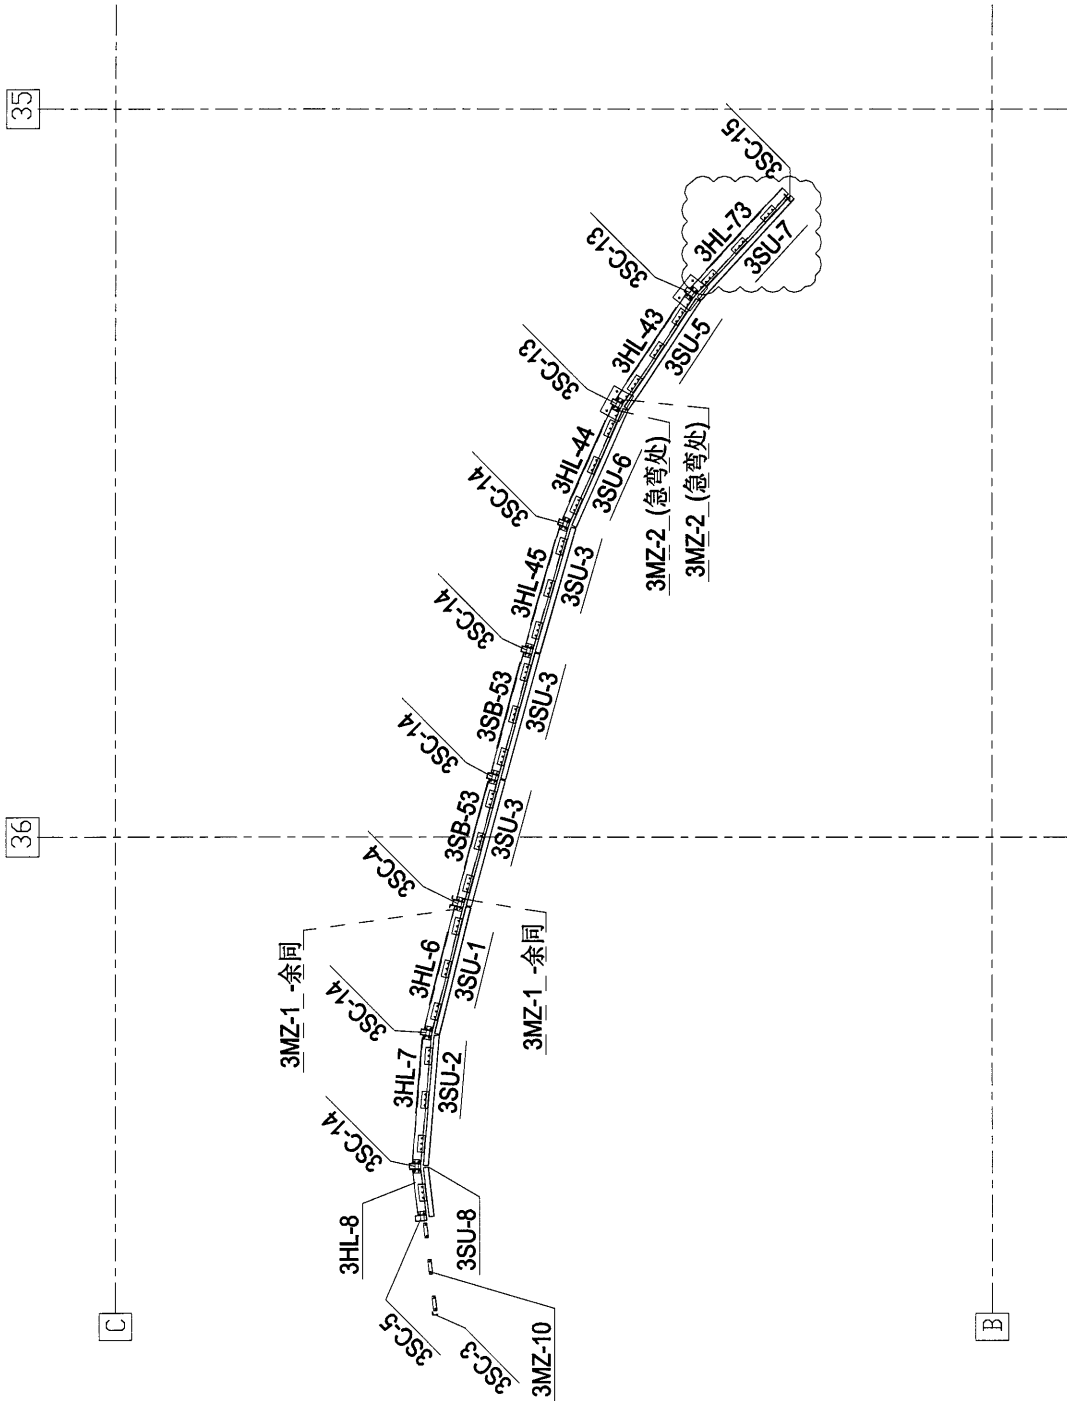

PART PLAN OF WINDOW-WALL (WW4)

@3/F-DOWN Scale: 1/100

B	第3次建批	2018-11-10
Rev.	Description	Date
PROJECT:		
PROPOSED SITE C1 DEVELOPMENT AT AREA 88, TKOTL 70 RP, TSEUNG KWAN O, NEW TERRITORIES		
CLIENT:		
MIDJ 美特鋁質有限公司 Units 6-8, Sunray Industrial Centre, 1/F 610 Che Kwo Ling Road, Kowloon Tel: 23489211-4 Fax: (852) 2727666		
S 銀同有限公司 Silver Town Limited Tel: 23489211-4 Fax: (852) 2727666		
DRAWING TITLE :		
PART PLAN FOR WINDOW-WALL (WW4) @ 3/F		
CAD File Name :		
Designed by		
Drawn by		
Reviewed by		
Approved by		
Scale		
DWG NO.: J-836-WW4-MP12-1		REV.
		B

1, 3HL-71, 72 预长100。



B	第3次提批	2018-11-10
Rev.	Description	Date
PROJECT: PROPOSED SITE C1 DEVELOPMENT AT AREA 86, TROT 170 RP, TSEUNG KWAN O, NEW TERRORIES		
CLIENT:  美特鋁質有限公司 MIDI ALUMINIUM FABRICATOR LTD. Units 6-8, Sunray Industrial Centre, 1/F 610 Cha Kwo Ling Road, Kwailoon Tel:23489211-4 Fax:(852)2727666		
 銀同有限公司 Silver Town Limited Tel:0769-83334968 Fax:0769-83359554 E-MAIL: ADDRESS@silvertown.hk, 163.COM		
DRAWING TITLE : PART WALL FOR WINDOW-PLAN (WW4) © 3/F		
CAD File Name :		
Designed by		
Drawn by		
Reviewed by		
Approved by		
Scale		
DWG NO: J-836-WW4-MP12-2		REV. B

- 1, 3MZ-10数量-8件。
- 2, 新增散件3SJ-7。
- 3, 3SJ-3取消。



B	第次報稅	2018-11-10
Rev.	Description	Date
PROJECT:		
PROPOSED SITE C1 DEVELOPMENT AT AREA 88, KOTU 10 RP, TSEUNG KWAN O, NEW TERRITORIES		
CLIENT:		
 美特鋁質有限公司 MIDJ ALUMINUM EXTRACTOR LTD. Units 6-B, Sunray Industrial Centre, 1/F 1010 Cho Kwo Lin Road, Kwailoon Tel: (852) 27727656 Fax: (852) 27727656		
DRAWING TITLE :		
PART PLAN FOR WINDOW-WALL (WW4) @ 3/F		
CAD File Name :		
Designed by		
Drawn by		
Reviewed by		
Approved by		
Scale		
DWG NO.: J-836-WWW4-MP13-2		
REV		
a		


1, 3SC-8减少3条, 变为3SC-22。



@3/F-TOP Scale: 1/100



A	第2次報稅	2018-11-05
Rev.	Description	Date

PROJECT:		PROPOSED SITE C1 DEVELOPMENT AT AREA 88, KOTOT 70 RP, TSEUNG KWAN O, NEW TERRITORIES
CLIENT:		 美特銘質有限公司 MIDJ MARUBENI EXPOSITOR LTD. Units 6-B, Sunray Industrial Centre, 61610 Cho Kwo Ling Road, Kowloon. Tel:23488211-4 Fax:(852)27277666
DRAWING TITLE :		S 銀同有限公司 Silver Town Limited TEL:0769-43354068 FAX:0769-4335654 E-MAIL ADDRESS:silvertown@163.COM
CAD File Name :		PART PLAN FOR WINDOW-WALL (WNW4) @ 3/F
Designed by		
Drawn by		
Reviewed by		
Approved by		
Scale		
DWG NO.:	J-836-WNW4-MP14-2	REV. A

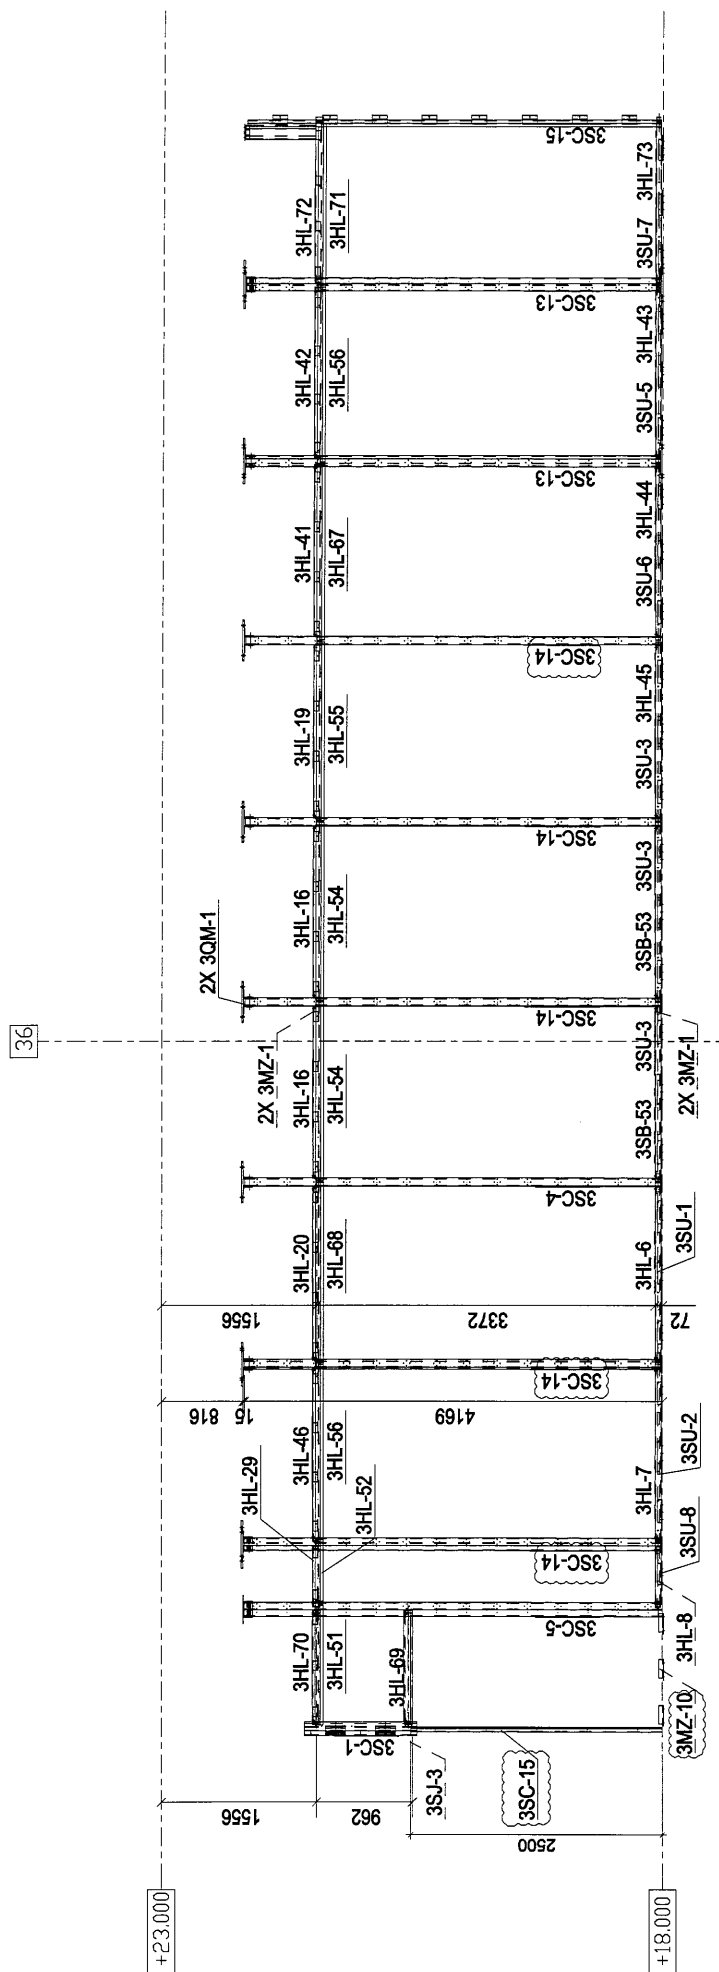**B
-
B**

PART ELEV. OF WINDOW-WAL (WW4)
COMBINE 3/F TO 4/F SCALE 1/60

B	第3次报批	2018-11-05
Rev.	Description	Date
PROJECT: PROPOSED SITE C1 DEVELOPMENT AT AREA 86, TKOT170 RP, TSEUNG KWAN O, NEW TERRORIES		
CLIENT:  美特铝质有限公司 MIDI ALUMINIUM EXTRUDER LTD. Units 6-8, Sunny Industrial Centre, 1/F 616 Cho Kwo Ling Road, Kowloon Tel: 23489211-4 Fax: (852) 27277666		
S 银同有限公司 Silver Town Limited Tel: 07188 453388 Fax: 07188 45339594 E-MAIL: 20075553@silvertown.hk, CO.UM		
DRAWING TITLE : PART 1ELEV. FOR WINDOW-WALL (WW4) @ 3F		
CAO File Name :		
Designed by		
Drawn by		
Reviewed by		
Approved by		
Scale		
DWG NO.: J-836-WWW4-MP-1-2		REV. B

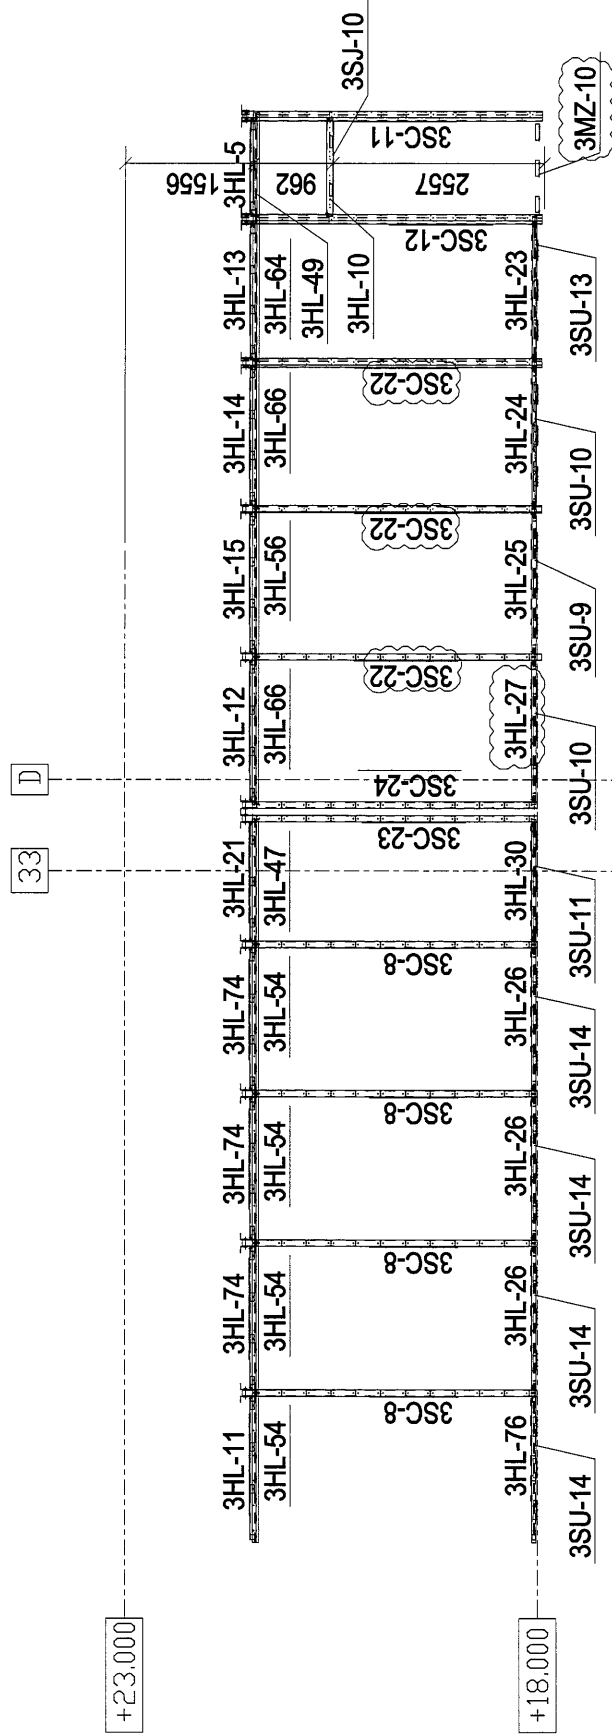
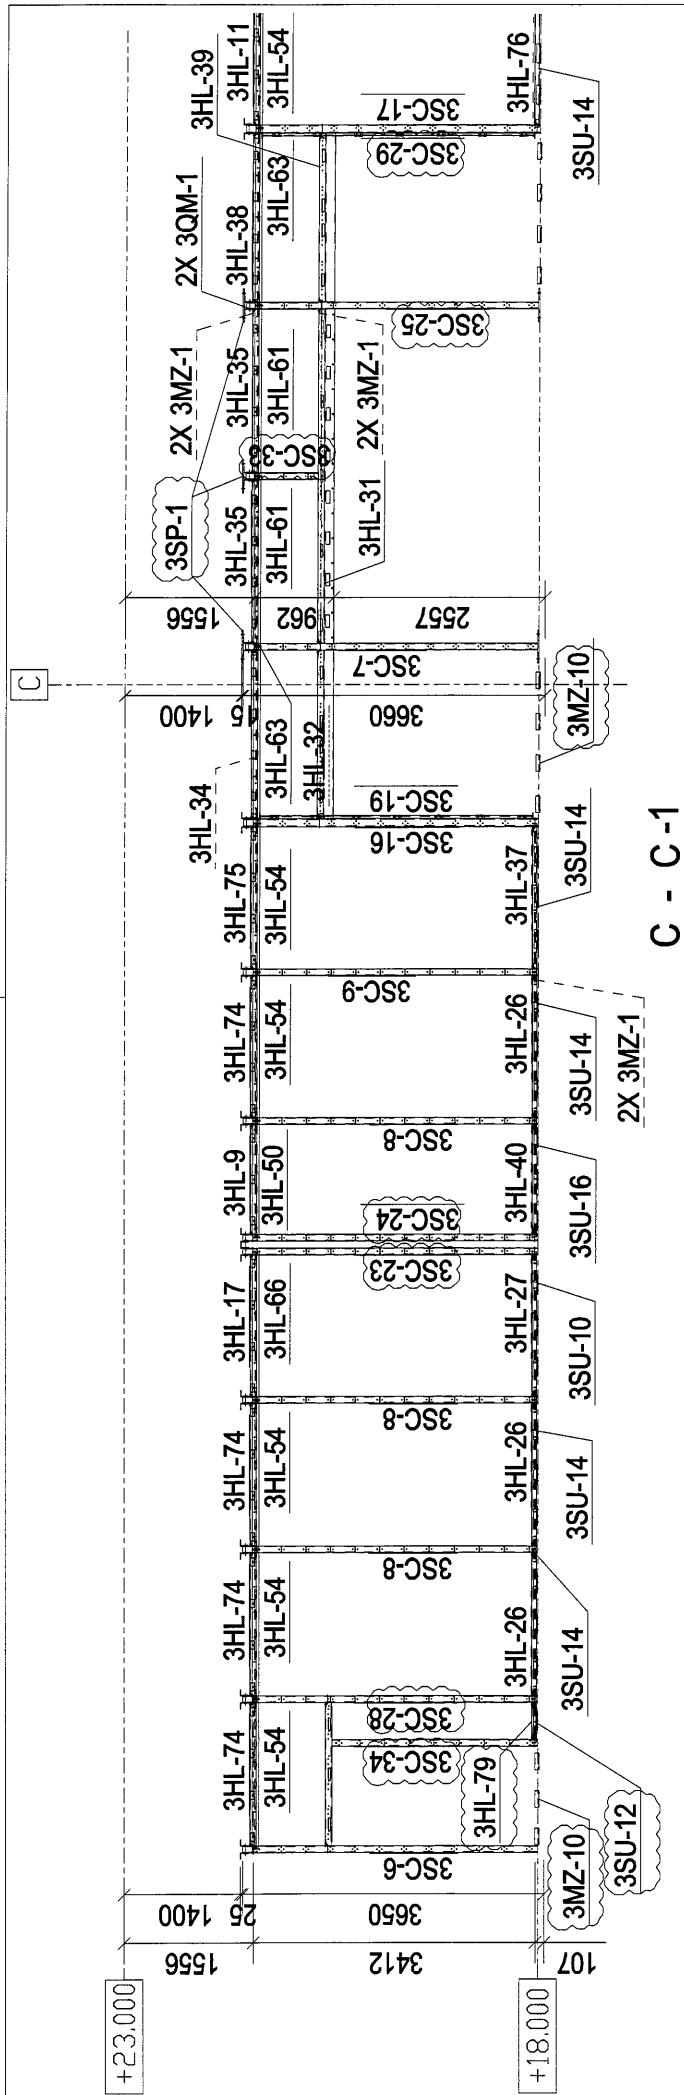


C - C-2

PART ELEV. OF WINDOW-WAL (WW4)

COMBINE $3/F$ TO $4/F$ SCALE $1/100$



A	第2次派報	2018-11-05
Rev.	Description	Date
PROJECT: PROPOSED SITE C1 DEVELOPMENT AT AREA 88, KOTOT 70 RP, TSEUNG KWAN O, NEW TERRITORIES		
CLIENT:  美特鋁質有限公司 MIDI ALUMINUM CORPORATION LTD. Units 6-8, Sunray Industrial Centre, 1/F 610 Cho Kwo Ling Road, Kowloon Tel: 23489211-4 Fax: (852) 27727666		
DRAWING TITLE :  銀同有限公司 Silver Town Limited Tel: 018-258588 Fax: 018-258584 E-MAIL ADDRESS: design@wpw.hk		
FOR WINDOW-MALL (WNW4) @ 3/F, 4/F		
CAD File Name :		
Designed by		
Drawn by		
Reviewed by		
Approved by		
Scale		
DWG NO.: J-836-WNW4-MP20-1		REV. A

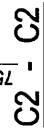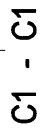

PART ELEV. OF WINDOW - WAL (WW4)
COMBINE 3/F TO 4/F SCALE 1/60

A	第2次提批	2018-11-05
Rev.	Description	Date


PROJECT:	PROPOSED SITE C1 DEVELOPMENT AT AREA 88, KOTU 70 RP, TSEUNG KWAN O, NEW TERRITORIES
CLIENT:	 美特鋁質有限公司 MIDI ALUMINIUM CORPORATION LTD. Units 6-8, Sunray Industrial Centre, 1/F 610 Cho Kwong Road, Kwun Tong Tel: 23489211-4 Fax: (852) 27276665
	 S Silver Town Limited 404/405-406, 407-408 TradeHub 360 E-Mall: 4086553@360.com, 163.COM
DRAWING TITLE :	PART ELEV. FOR WINDOW-WALL (WW4) @ 3/F, 4F
CAD File Name :	
Drawn by	
Reviewed by	
Approved by	
Scale	
DWG NO.:	J-838-WW4-MP20-2
REV.	A

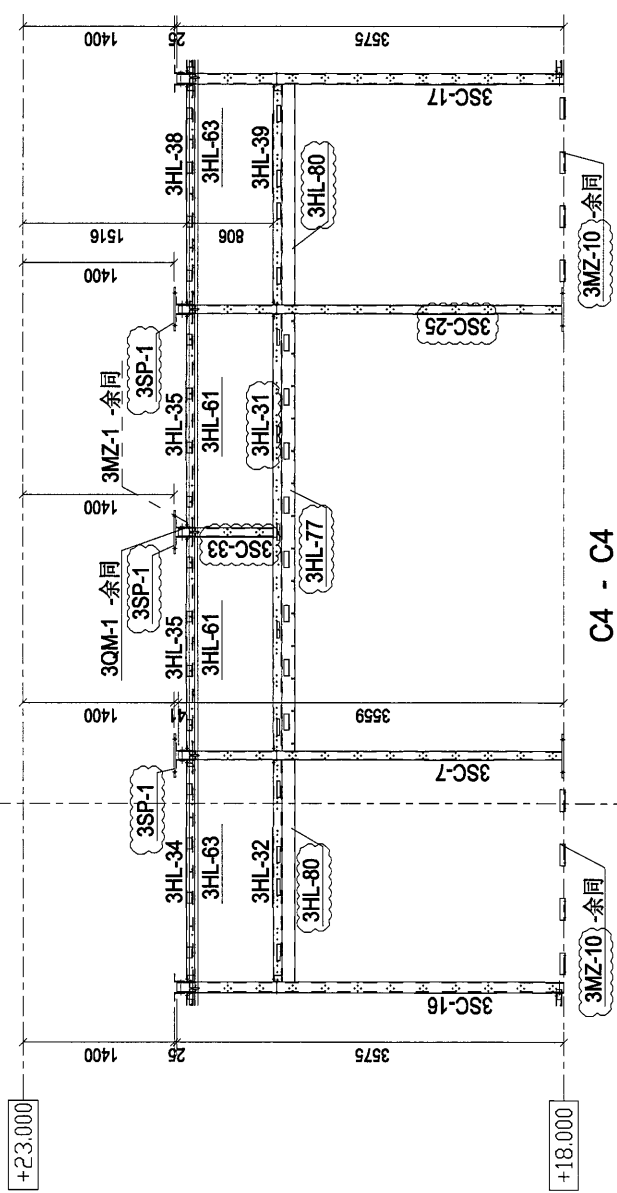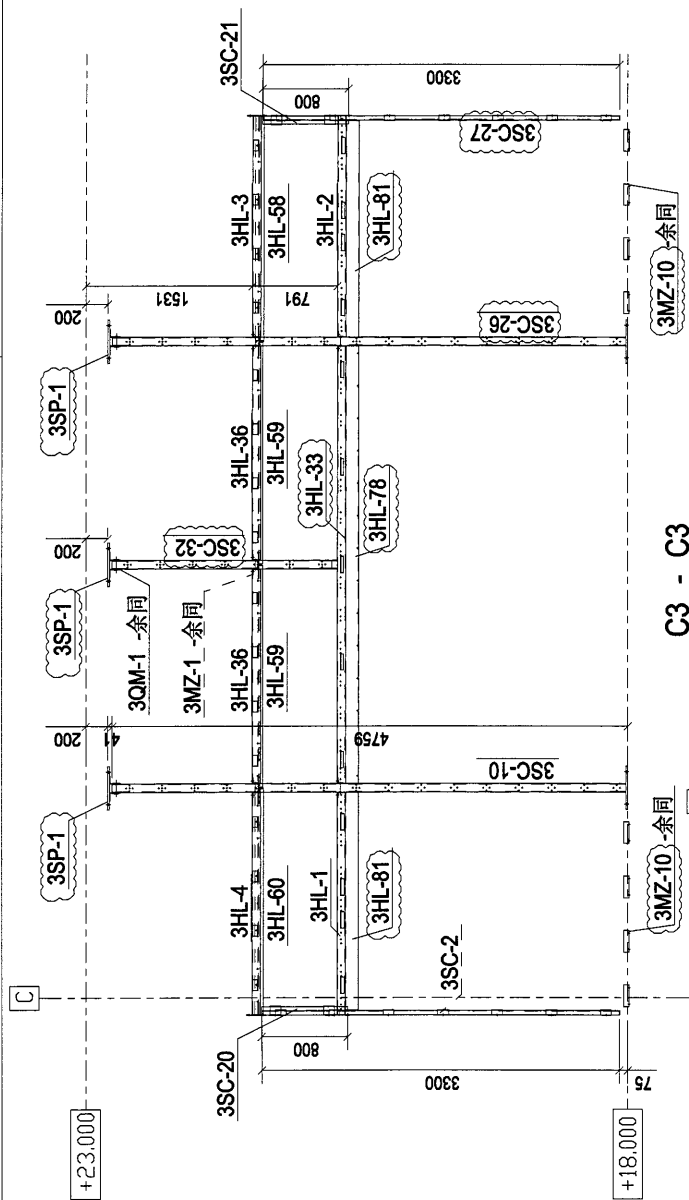

PART ELEV. OF WINDOW-WAL (WW4)
COMBINE 3/F TO 4/F SCALE 1/60


A	第2次报批	2018-11-05
Rev.	Description	Date
PROJECT:		
PROPOSED SITE C1 DEVELOPMENT AT AREA 88, KOTOT 70 RP, TSEUNG KWAN O, NEW TERRITORIES		
CLIENT:		
 美特鋁質有限公司 MIDI ALUMINUM EXPOSITOR LTD. Units 6-8, Sunray Industrial Centre, 1/F 610 Cho Kwo Ling Road, Kowloon Tel:23489211-4 Fax:(852)27276656		
 S 銀同有限公司 Silver Town Limited Tel:87618588 Fax:87618584 E-mail: a02333@silvertown.hk 16.0 CM		
DRAWING TITLE :		
PART ELEV. FOR WINDOW-WALL (WW4) @ 3/F, 4/F		
CAD File Name :		
Designed by		
Drawn by		
Reviewed by		
Approved by		
Scale		
DWG NO. : J-836-1WW4-MP2-3		REV. A

构件编号:		2HL-1	构件数量:		4	构件重量:		28.47
零件编号	规格(mm)	长度(mm)	数量	单重(kg)	共重(kg)	截面面积(m²)		
M148	RHS120*80*6.3	1453	1	28.47	28.47	0.56		
合计:					28.47			

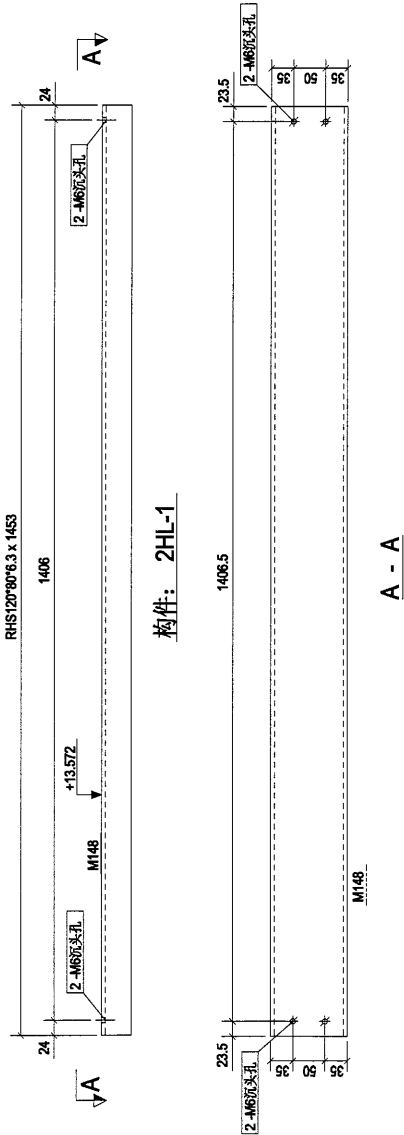


0	第一次报批	2018-07-04
Rev.	Description	Date
PROJECT: PROPOSED SITE C1 DEVELOPMENT AT AREA 08, TKOTL 70 RP, TSEUNG KWAN O, NEW TERRITORIES		
CLIENT: 美特铝质有限公司 MIDALUMINUM CO., LTD. Unit 6-8, Sunny Industrial Centre, Y/T 610, Cha Kwo Ling Road, Kowloon Tel: 23489211 - 4, Fax: (852) 2727665		
S 银同有限公司 Silver Town Limited Tel: 0755-23556888, Fax: 0755-23556894 E-MAIL: ADDRESS@silvertown.com		
DRAWING TITLE : [2HL-1]		
CAD File Name :		
Designed by		
Drawn by		
Reviewed by		
Approved by		
Scale		
DWG NO.: (WWW)-2 - [2HL-1]		REV. 0

材料编号:		2HL-2	构件数量:		4	构件重量:		27.88
零件编号	规格(mm)	数量	重量(kg)	长度(mm)	重量(kg)	重量(kg)	重量(kg)	重量(kg)
M175	RHS120*80*6.3	1453	1	26.47	26.47	0.96		
M468	RSA75*50*5	100	3	0.47	1.41	0.03		
合计:								27.88

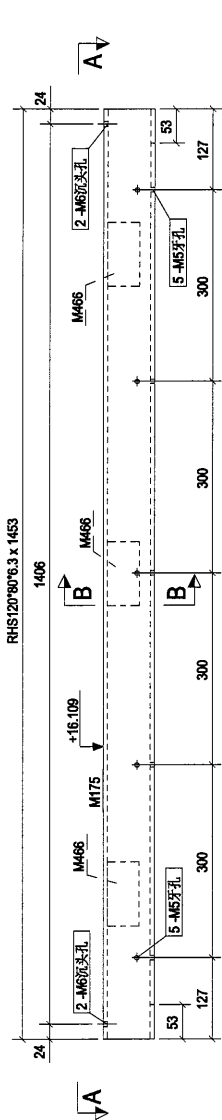


构件: 2HL-2

说明: 为了方便横梁安装, 故在其底部开了个缺口。

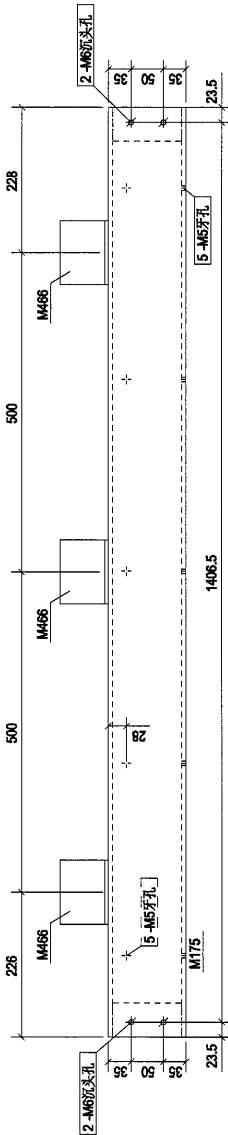


A - A

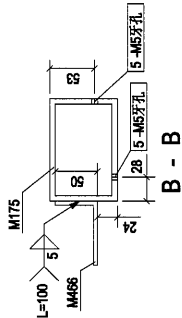


0	第1次提批	2018-07-04
Rev.	Description	Date
PROJECT: PROPOSED SITE C1 DEVELOPMENT AT AREA 88, TKOTI, 70 RP, TSEUNG KWAN O, NEW TERRITORIES		
CLIENT: 美特鋁質有限公司 MIDAL ALUMINIUM FABRICATOR LTD. 104B S.H. Sun Industrial Estate, 810 Che Kwo Ling Road, Kwai Tsing, Tel: 23489211-4, Fax: (852) 2727656		
S 銀同有限公司 Silver Town Limited Tel: 0755-83335866 Fax: 0755-83335854 E-mail: 808533586@163.com		
DRAWING TITLE : [2HL-2]		
CAD File Name :		
Designed by		
Drawn by		
Reviewed by		
Approved by		
Scale		
DWG NO.: (WW4)-2 - [2HL-2]		REV. 0

构件编号:		2HL-3	构件数量:		4	构件重量:		33.51
零件编号		长度(mm)	数量	重量(kg)	共重(kg)	表面面积(m ²)		
M299	PL550	1406	1	2.99	2.99	1406	0.17	
M447	RHS150*75*6.0	1406	1	30.53	30.53	1406	0.27	
合计:								33.51

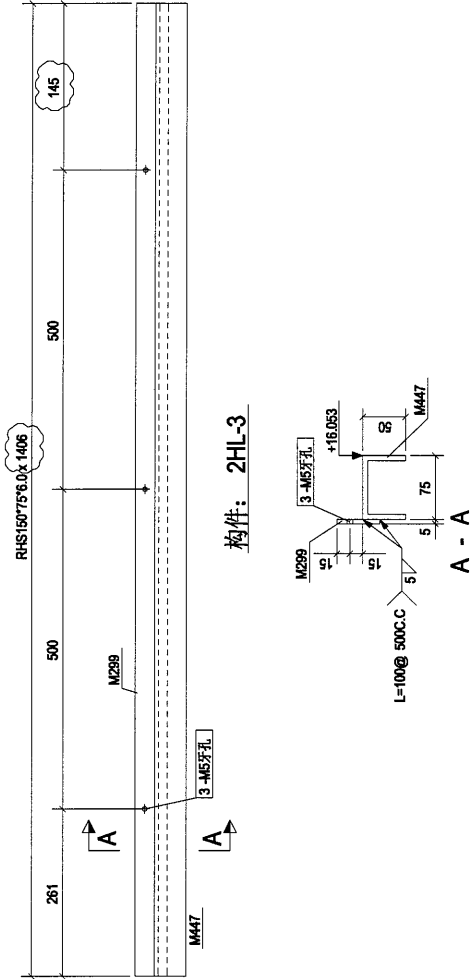


A	第2次排批	2018-08-22
Rev.	Description	Date
PROJECT: PROPOSED SITE C1 DEVELOPMENT AT AREA 88, TKOTL 70 RP, TSEUNG KWAN O, NEW TERRITORIES		
CLIENT:  美特铝质有限公司 MIDY ALUMINIUM FABRICATOR LTD. Units 5 & 6, Sunning Industrial Estate, 1/F 510 Chee Kwan Tsing Road, Kowloon Tel: 23489211-4 Fax: (852) 2727666		
 银同有限公司 Silver Town Limited Tel: 2769-8339/888 Fax: 2769-8339/854 E-Mail: ADDRESS@silvertown.com.hk		
DRAWING TITLE : [2HL-3]		
CAD File Name :		
Designed by		
Drawn by		
Reviewed by		
Approved by		
Scale		
DWG NO.: (WW4)-2 - [2HL-3]		REV. A

构件编号:		2HL-4	构件数量:		1	构件重量:		33.62
零件编号	规格(mm)	数量	重量(kg)	共重(kg)	共重(kg)	共重(kg)	共重(kg)	共重(kg)
M504	PL550	1	3.00	3.00	0.17			
M543	RHS150*75*6.0	1	30.62	30.62	0.27			
合计:								33.62

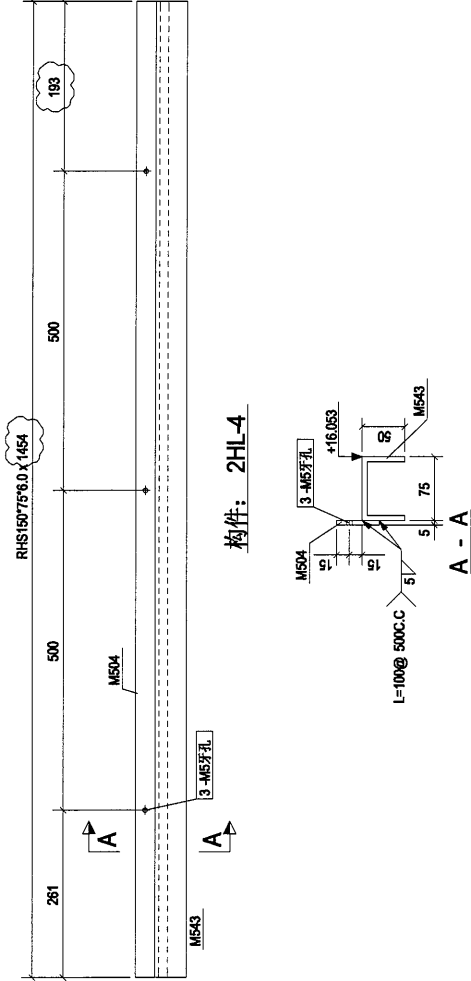


A	第2次审批	2018-08-22
Rev.	Description	Date
PROJECT: PROPOSED SITE C1 DEVELOPMENT AT AREA B8, TKOTL 70 RP, TSEUNG KWAN O, NEW TERRITORIES		
CLIENT: 美特鋁質有限公司 MIDY ALUMINUM FABRICATOR LTD. Units 5 & 6, Sunmyoung Industrial Centre, 1/F 510 Chee Kwan Road, Kwai Tsing Tel: 23489211-4, Fax: (852) 27727666		
S 銀同有限公司 Silver Town Limited Tel: (852) 43339888 Fax: (852) 43339884 E-Mail: ADDRESS@silvertown.hk		
DRAWING TITLE : [2HL-4]		
CAD File Name :		
Designed by		
Drawn by		
Reviewed by		
Approved by		
Scale		
DWG NO.: (WW4)-2 - [2HL-4]		REV. A


构件编号:		2HL-5	构件数量:		1	构件重量:				30.98
零件编号	规格(mm)	数量	重量(kg)	长度(mm)	数量	重量(kg)	共重(kg)	共重(lb)	共重(lbm)	
M466	RHS175*50*5	3	0.47	100	3	0.47	1.41	1.41	0.03	
M481	RHS120*80*6.3	131	1	131	1	2.39	2.39	2.39	0.05	
M483	RHS120*80*6.3	1493	1	1493	1	27.18	27.18	27.18	0.57	
合计:							30.98			

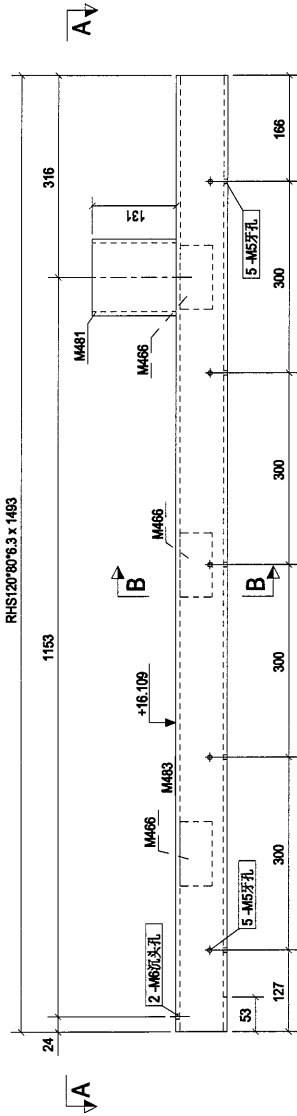


构件: 2HL-5

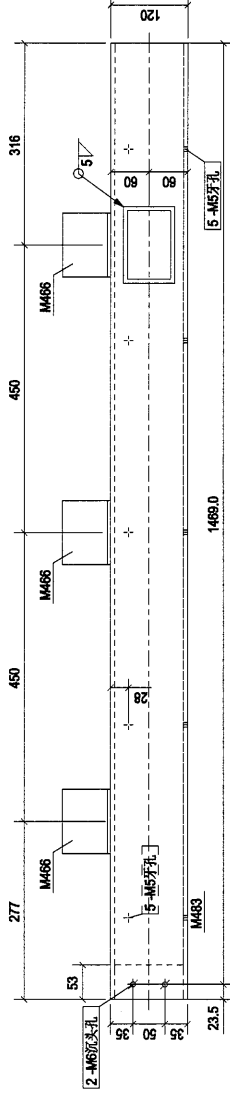

A - A

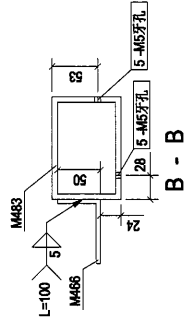


0	第1次报批	2018-07-04
Rev.	Description	Date
PROJECT: PROPOSED SITE C1 DEVELOPMENT AT AREA 88, TKOTL 70 RP, TSEUNG KWAN O, NEW TERRITORIES		
CLIENT: 美特铝质有限公司 MIDY ALUMINIUM FABRICATOR LTD. Unit 5-8, Sunny Industrial Centre, 1/F 810 Chee Kwan Road, Kwai Tsing Tel: 23489211-4, Fax: (852) 2777666		
S 银同有限公司 Silver Town Limited Tel: (726) 4335966, Fax: (726) 4335964 E-Mail: Admin@silvertown.hk, 103.COM		
DRAWING TITLE : [2HL-5]		
CAD File Name :		
Designed by		
Drawn by		
Reviewed by		
Approved by		
Scale		
DWG NO. (WW4)-2 - [2HL-5]		REV 0

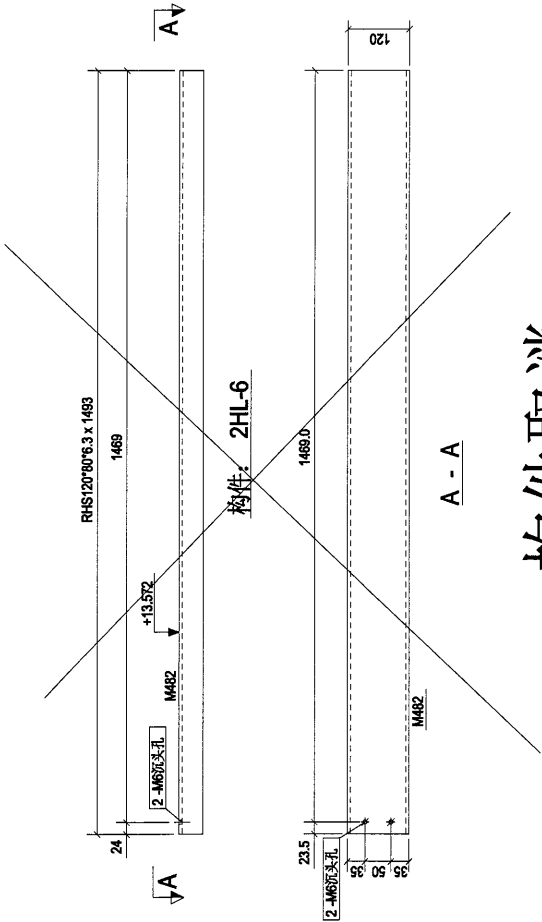

构件取消


A	第2次修改	2018-11-05
Rev.	Description	Date
PROJECT: PROPOSED SITE C1 DEVELOPMENT AT AREA B8, TKOTL 70 RP, TSEUNG KWAN O, NEW TERRITORIES		
CLIENT: 美特鋁質有限公司 MIDALUMINUM 810 Clio Kwo Ling Road, Kwai Tsing Tel: 23489211-4, Fax: (852) 7777666		
銀同有限公司 Silver Town Limited Tel: (852) 23558888, Fax: (852) 23558884 E-MAIL: ADDRESS@silvertown.com.hk		
DRAWING TITLE : [2HL-6]		
CAD File Name :		
Designed by		
Drawn by		
Reviewed by		
Approved by		
Scale		
DWG NO.: (WW4)-2 - [2HL-6]		REV. A

构件编号:	2MZ-1	构件数量:	18	构件重量:	0.45
材料编号:	M154	长度(mm)	100	单重(kg)	共重(kg)
				0.45	0.45
				合计:	0.45

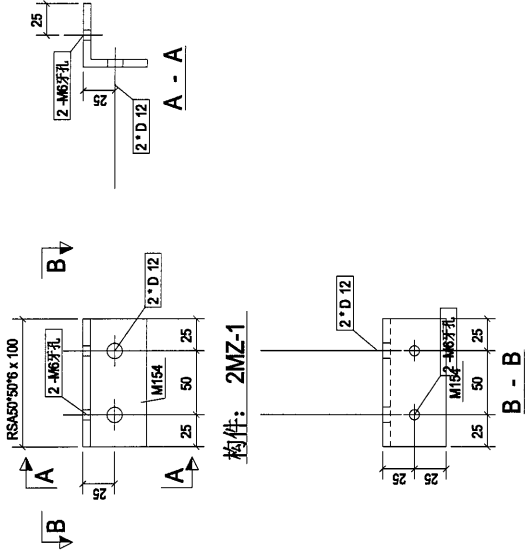


0	第1次修改	2018-07-04
Rev.	Description	Date
PROJECT: PROPOSED SITE C1 DEVELOPMENT AT AREA 88, TKOIL TWP, TSEUNG KWAN O, NEW TERRITORIES		
CLIENT:  美特铝质有限公司 MIDI ALUMINUM EXTRUSION LTD. Units 6-8, Sunco Industrial Centre, 1/F 810 Cha Kwo Ling Road, Kowloon Tel: 23489211-4, Fax: (852) 27727686		
 银同有限公司 Silver Town Limited Tel: 086-8358088, Fax: 086-8358854 E-MAIL: ADDRESS@silvertown.hk		
DRAWING TITLE : [2MZ-1]		
CAD File Name :		
Designed by		
Drawn by		
Reviewed by		
Approved by		
Scale		
DWG NO: (WW4)-2 - [2MZ-1]		REV. 0


构件编号: 2MZ-2		构件数量: 4		构件重量: 0.38	
部件编号	规格(mm)	数量	单重(kg)	共重(kg)	表面积(m²)
M910	RSA50*50*5	100	0.38	0.38	0.02
合计: 0.38					

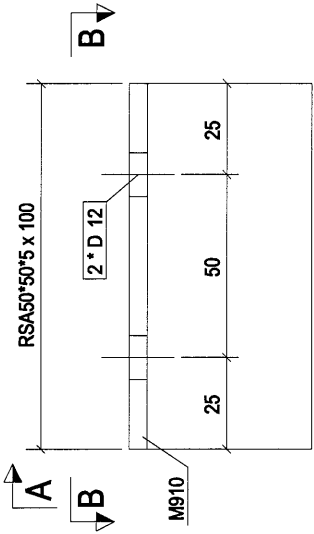

构件: 2MZ-2

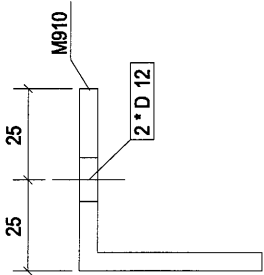


A - A

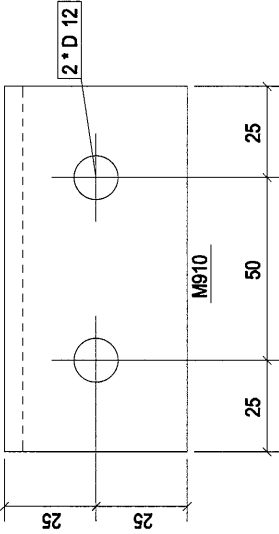

B - B

0	第1次报批	2018-11-05
Rev.	Description	Date
PROJECT: PROPOSED SITE C1 DEVELOPMENT AT AREA 08, TKOTL 70 RP, TSEUNG KWAN O, NEW TERRITORIES		
CLIENT: 美特铝质有限公司 MIDALUMINUM ASSOCIATE LTD. Units 6-8, Sunny Industrial Centre, 1/F 810 Cha Kwo Ling Road, Kowloon Tel: 23489211-4, Fax: 8522772665		
S 银同有限公司 Silver Town Limited Tel: 02382 03366, Fax: 02382 03364 E-Mail: A00825@silvertown.hk, 183.0304		
DRAWING TITLE : [2MZ-2]		
CAD File Name :		
Designed by		
Drawn by		
Reviewed by		
Approved by		
Scale		
DWG NO.: (WWW)-2 - [2MZ-2]		REV. 0


构件编号:		2P-1	构件数量:		20	构件重量:		0.05
零件编号	规格(mm)		长度(mm)	数量	重量(kg)	长度(mm)	重量(kg)	重量(kg)
F31	PL14*40		40	1	0.05		0.05	0.00
合计:					0.05			

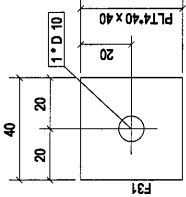

构件: 2P-1

0	第1次批	2018-07-04
Rev.	Description	Date
PROJECT: PROPOSED SITE C1 DEVELOPMENT AT AREA 88, TKOTL 70 RP, TSEUNG KWAN O, NEW TERRITORIES		
CLIENT:  美特铝质有限公司 MIDY ALUMINIUM FABRICATOR LTD. Units 5 & 6, Sun Yee Industrial Estate, /F 810 Che Kwo Yee Road, Kwai Tsan Tel: 23489211-4, Fax: 8522772666		
 银同有限公司 Silver Town Limited Tel: 0762-8335988 Fax: 0762-8335954 E-Mail: ADDRESS@silvertown.hk		
DRAWING TITLE : [2P-1]		
CAD File Name :		
Designed by		
Drawn by		
Reviewed by		
Approved by		
Scale		
DWG NO. (WWW)-2 - [2P-1]		REV 0


构件编号: 2P-2		5		构件重量: 15.07	
部件编号	规格(mm)	数量	单重(kg)	共重(kg)	表面积(m²)
F82	PLT16*300	1	15.07	15.07	0.26
合计: 15.07					

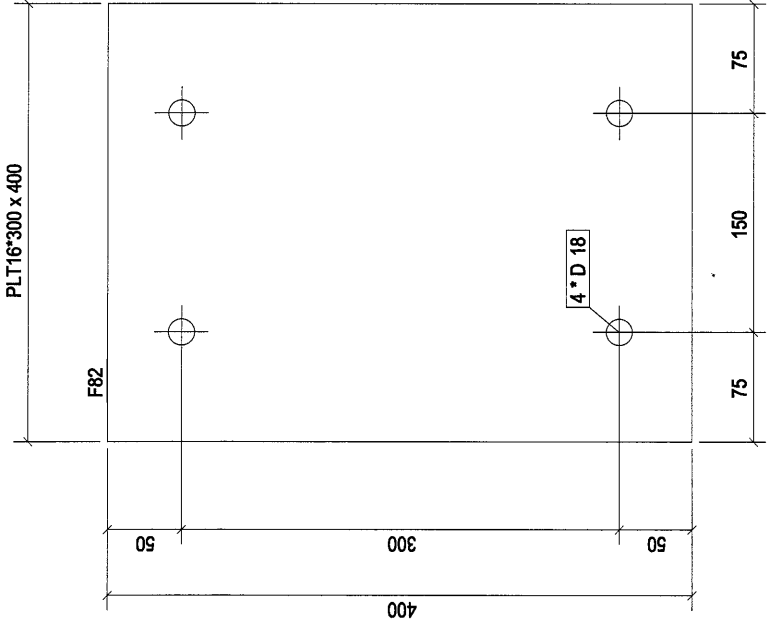

构件: 2P-2

0	第一次设计	2018-11-05
Rev.	Description	Date
PROJECT: PROPOSED SITE C1 DEVELOPMENT AT AREA 08, TKOTI, 70 RP, TSEUNG KWAN O, NEW TERRITORIES		
CLIENT: 美特铝质有限公司 MIDI ALUMINUM MANUFACTURE LTD. Units 6-8, Sunny Industrial Centre, V/F, 610 Chee Kwee Road, Kowloon Tel: 23489211-4, Fax: (853) 2772666		
S 银同有限公司 Silver Town Limited Tel: 00853 23580000, Fax: 00853 23580004 E-MAIL: ADDRESS@silvertown.com.hk, G31.COM		
DRAWING TITLE : [2P-2]		
CAD File Name :		
Designed by		
Drawn by		
Reviewed by		
Approved by		
Scale		
DWG NO.: (WWW)-2 - [2P-2]		REV 0


构件编号: 2QM-1		构件数量: 10		构件重量: 1.43	
部件编号	规格(mm)	长度(mm)	数量	单重(kg)	共重(kg)
M136	RSA100756	180	1	1.43	1.43
					表面积(m²)
					0.07
合计:					1.43

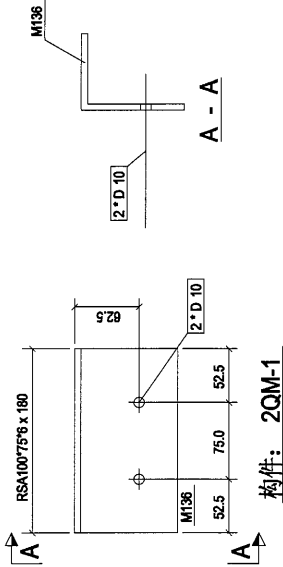


构件: 2QM-1

0	第1次提批	2018-07-04
Rev.	Description	Date
PROJECT: PROPOSED SITE C1 DEVELOPMENT AT AREA 08, TKOIL TOWNSHIP, TSEUNG KWAN O, NEW TERRITORIES		
CLIENT: 美特铝业有限公司 MIDI ALUMINIUM MANUFACTURE LTD. Units 5-8, Sunny Industrial Centre, 1/F, 610 Cha Kwo Ling Road, Kowloon Tel: 23489211-4, Fax: (852) 2727666		
S 银同有限公司 Silver Town Limited Tel: 23489211-4, Fax: (852) 2727666 E-MAIL: ADDRESS@silvertown.com.hk		
DRAWING TITLE : [2QM-1]		
CAD File Name :		
Designed by		
Drawn by		
Reviewed by		
Approved by		
Scale		
DWG NO: (WW4)-2 - [2QM-1]		REV. 0

构件编号:		2SU-1	构件数量:		4	构件重量:		34.63
零件编号		规格(mm)	长度(mm)		数量	重量(kg)		共重(kg)
M155		RHS150*75*8.0	1521		1	30.53		30.53
M156		RSA100*50*8	230		2	2.05		4.10
								0.07
								合计: 34.63

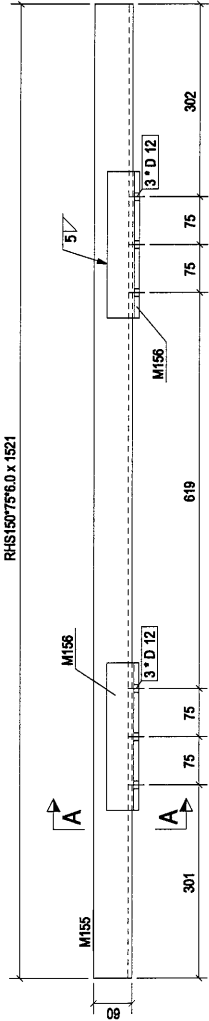


构件: 2SU-1

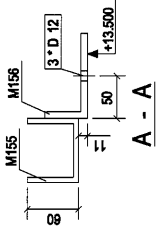


0	第1次报批	2018-07-04
Rev.	Description	Date
PROJECT: PROPOSED SITE C1 DEVELOPMENT AT AREA 88, TKOIT, 70 RP, TSEUNG KWAN O, NEW TERRITORIES		
CLIENT: 美特经贸有限公司 MIDI INTERNATIONAL DEVELOPMENT LTD. Units 6-8, Sunco Industrial Centre, 1/F, 610 Cha Kwo Ling Road, Kowloon Tel: 23489211-4, Fax: (852) 2727656		
S 银同有限公司 Silver Town Limited Tel: 0250 835586, 0250 835584 E-MAIL: ADDRESS@silvertown.com.hk, 163.COM		
DRAWING TITLE : [2SU-.1]		
CAD File Name :		
Designed by		
Drawn by		
Reviewed by		
Approved by		
Scale		
DWG NO: (WW4)-2 - [2SU-.1]		REV. 0

构件编号:		2SU-2	构件数量:		1	构件重量:		34.72
构件编号	规格(mm)	数量	重量(kg)	长度(mm)	数量	重量(kg)	长度(mm)	重量(kg)
M156	RS4100*50*8	230	2	230	2	2.05	4.10	0.07
M544	RHS150*75*6.0	1528	1	1528	1	30.62	30.62	0.30
合计:								34.72

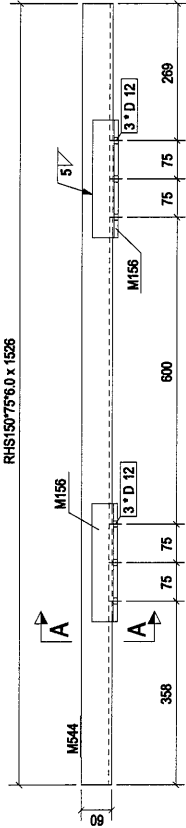


构件: 2SU-2

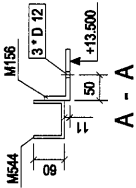


0	第1次提批	2018-07-04
Rev.	Description	Date
PROJECT: PROPOSED SITE C1 DEVELOPMENT AT AREA 86, TKOTI TO RP, TSEUNG KWAN O, NEW TERRITORIES		
CLIENT:  美特鋁質有限公司 MIDI ALUMINIUM FABRICATOR LTD. Units 6 & 7, Sunny Industrial Centre, 1/F 610 Chee Kwan Road, Kwai Tsing Tel: 23489211-4 Fax: (852) 27727566		
 銀同有限公司 Silver Town Limited Tel: 075-8335468 Fax: 075-8338954 E-Mail: ADDRESS@silvertown.hk		
DRAWING TITLE : [2SU-2]		
C-A-D File Name :		
Designed by		
Drawn by		
Reviewed by		
Approved by		
Scale		
DWG NO.: (WW4)-2 - [2SU-2]		REV. 0


零件编号: 3HL-5		零件数量: 1		零件重量: 23.30	
零件编号: 规格(mm)		数量		重量(kg)	
M163	RHS120*80*6.3	1	21.89	21.89	0.46
M468	RSA75*50*5	3	0.47	1.41	0.03
合计:					23.30

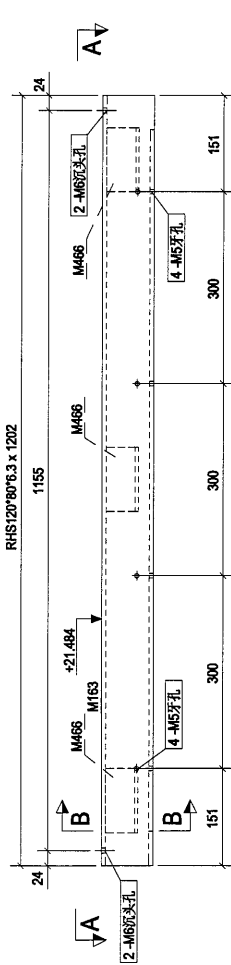

构件: 3HL-5

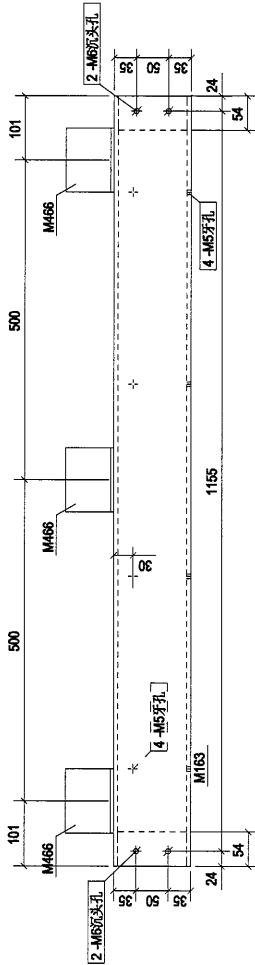


A - A

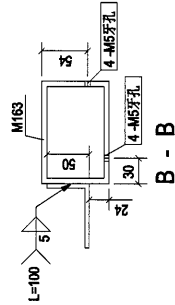

B - B

0	第1次提批	2018.07.04
Rev.	Description	Date
PROJECT: PROPOSED SITE C1 DEVELOPMENT AT AREA 86, TKOTL 70 RP, TSEUNG KWAN O, NEW TERRITORIES		
CLIENT:  美特鋁質有限公司 MIDI ALUMINIUM FABRICATOR LTD. Units 6 & 8, Shing Yee Industrial Centre, 1/F 610 Che Kwoi Road, Kwai Chung, Kowloon Tel: 23488211-4 Fax: (852) 27272666		
 銀同有限公司 Silver Town Limited Tel: 2769-8335/888 Fax: 2769-8335/854 E-mail: ADDRESS@silvertown.com.hk		
DRAWING TITLE : [3HL-5]		
CAD File Name :		
Designed by		
Drawn by		
Reviewed by		
Approved by		
Scale		
DWG NO.: (WW4)2 - [3HL-5]		REV. 0

零件编号:	3HL-6	零件数量:	1	零件重量:	31.62
零件编号:	数量	重量(kg)	共重(kg)	共重(kg)	共重(kg)
M170	1736	1	31.62	31.62	0.67
合计:					31.62

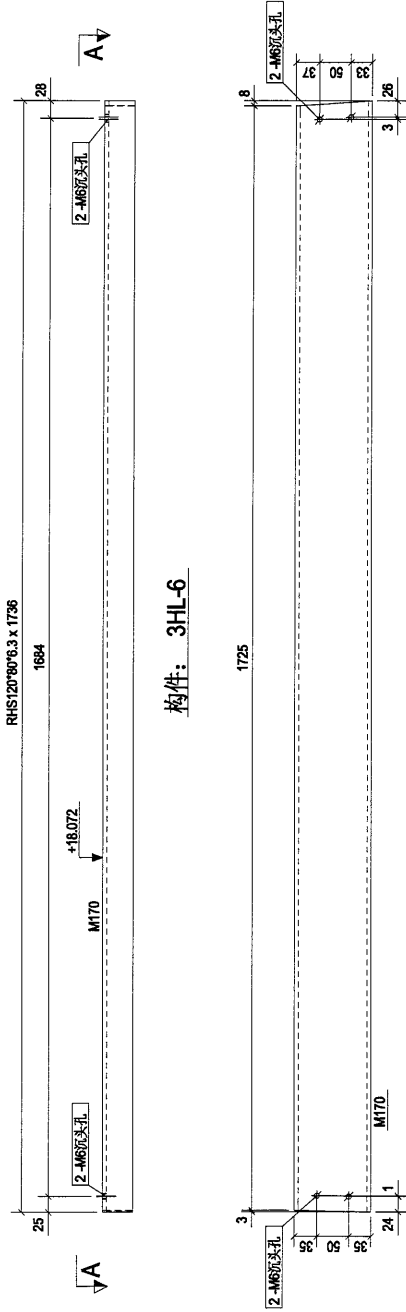


构件: 3HL-6

A - A


0	第1次提批	2018-07-04
Rev.	Description	Date
PROJECT: PROPOSED SITE C1 DEVELOPMENT AT AREA 86, TKOTL 70 RP, TSEUNG KWAN O, NEW TERRITORIES		
CLIENT:  美特鋁質有限公司 MIDI ALUMINIUM FABRICATOR LTD. Units 6 & 7, Sunny Industrial Centre, 1/F 510 Cheong Cheong Street, Kwun Tong Tel: 2348211-4 Fax: (852) 2727566		
 銀同有限公司 Silver Town Limited Tel: 278-2335488 Fax: 278-8339554 E-Mail: ADDRESS@silvertown.hk		
DRAWING TITLE : [3HL-6]		
CAD File Name :		
Designed by		
Drawn by		
Reviewed by		
Approved by		
Scale		
DWG NO.:	(WWW)2 - [3HL-6]	REV. 0

零件编号:	3HL-7	零件数量:	1	零件重量:	31.99
零件编号:	数量	重量(kg)	重量(kg)	重量(kg)	重量(kg)
MT1	1	17.96	1	31.99	0.67
合计:					31.99

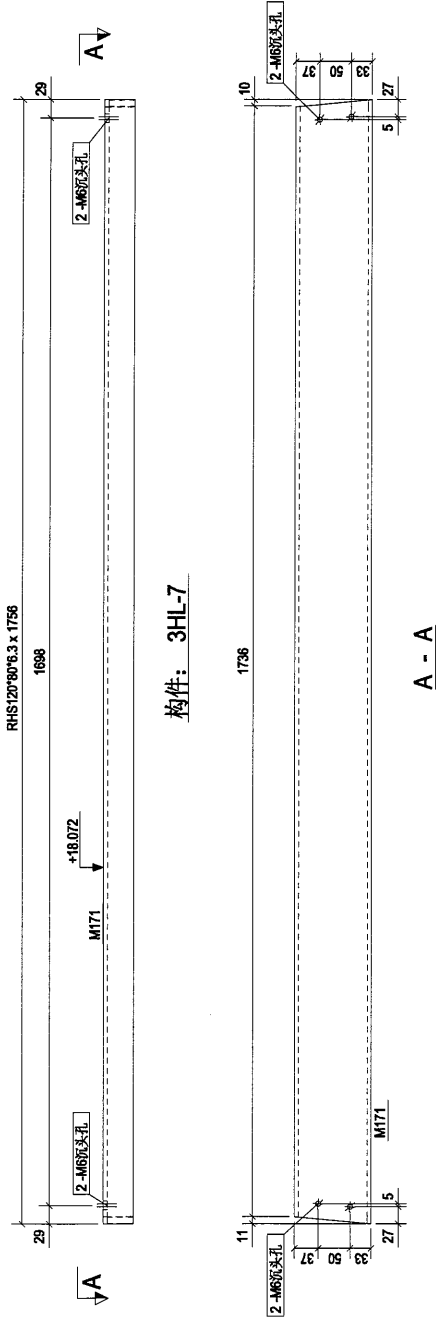


0	第1次提批	2018-07-04
Rev.	Description	Date
PROJECT:		
PROPOSED SITE C1 DEVELOPMENT AT AREA 86, TKOTL 70 RP, TSEUNG KWAN O, NEW TERRITORIES		
CLIENT:		
美特鋁質有限公司 MIDI ALUMINUM FABRICATOR LTD. Units 1 & 2, Sam Chai Industrial Centre, 1/F 510 Che Kwan Road, Kwai Chung, Kowloon Tel: 23485211-4 Fax: (852) 27275566		
銀同有限公司 Silver Town Limited Tel: 2789-2335/888 Fax: 2789-8338/854 E-mail: ADDRESS@silvertown.com.hk		
DRAWING TITLE :		
[3HL-7]		
CAD File Name :		
Designed by		
Drawn by		
Reviewed by		
Approved by		
Scale		
DWG NO.:	(WWW)2 - [3HL-7]	REV.
		0

构件编号:	3HL-8	构件数量:	1	构件重量:	11.45
零件编号:	材料(mm)	数量	重量(kg)	长度(mm)	表面面积(m ²)
M172	RHS120*80*6.3	029	11.45	11.45	0.24
合计:					11.45

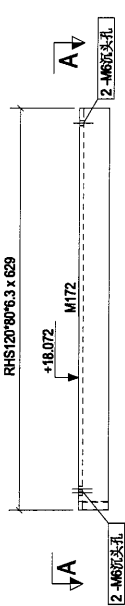

构件: 3HL-8

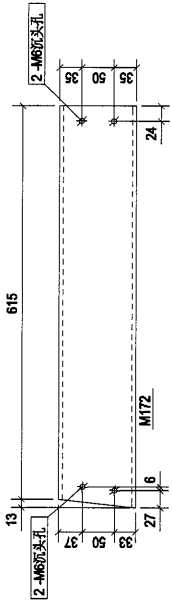

A - A

0	第1次提批	2018-07-04
Rev.	Description	Date
PROJECT: PROPOSED SITE C1 DEVELOPMENT AT AREA 88, TKOTL 70 RP, TSEUNG KWAN O, NEW TERRITORIES		
CLIENT:  美特铝质有限公司 MIDI ALUMINUM FABRICATOR LTD. Units 6 & 7, Sam Yee Industrial Centre, 1/F 610 Cheong Kwai Road, Kwai Chung, Kowloon Tel: 2348211-4 Fax: (852) 2727566		
 银同有限公司 Silver Town Limited Tel: 0769-333988 Fax: 0769-333954 E-Mail: ADMIN@silvertown.hk		
DRAWING TITLE : [3HL-8]		
CAD File Name :		
Designed by		
Drawn by		
Reviewed by		
Approved by		
Scale		
DWG NO. : (WW4)-2 - [3HL-8]		REV 0

1, M191取消, 增加解码。

合计: 23.43



构件: 3HL-10



A	第2次报批	2018-11-05
Rev.	Description	Date

1. אמצעים

IKU IL 70 RP, ISEUNG KWAN O,
NEW TERRITORIES

RESEARCH

Units 6-8, Sunray Industrial Centre, 1/F
610 Cha Kwo Ling Road, Kowloon
Tel: 23489211-4 Fax: (852) 27777666

Tel: 0769-83354968 Fax: 0769-83359954
E-MAIL ADDRESS: dqslkk@vip.163.com

[illegible]

[3HL-.10]

D. J. Nisbet et al.


Drawn by

Reviewed by


1	2	3	466
---	---	---	---	---	---	---	---	---	----	----	-----	-----	
	A
--	---


构件编号:		3HL-11	构件数量:		1	构件重量:		33.15
零件编号	规格(mm)	数量	重量(kg)	共重(kg)	接量(m)			
M192	RHS120*80*6.3	1717	1	31.27	0.88			
M466	RS475*50*5	100	4	0.47	1.88			
合计:					33.15			

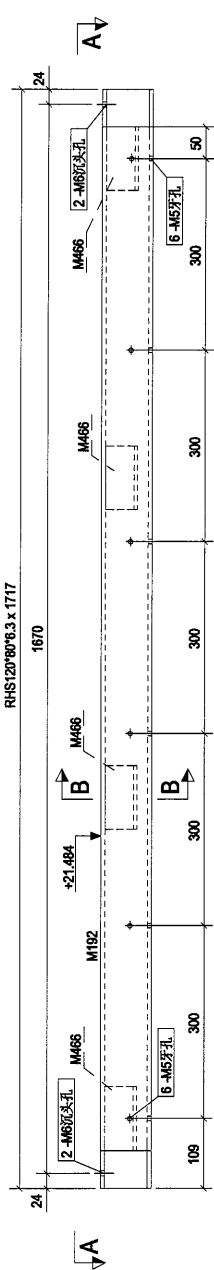

构件: 3HL-11

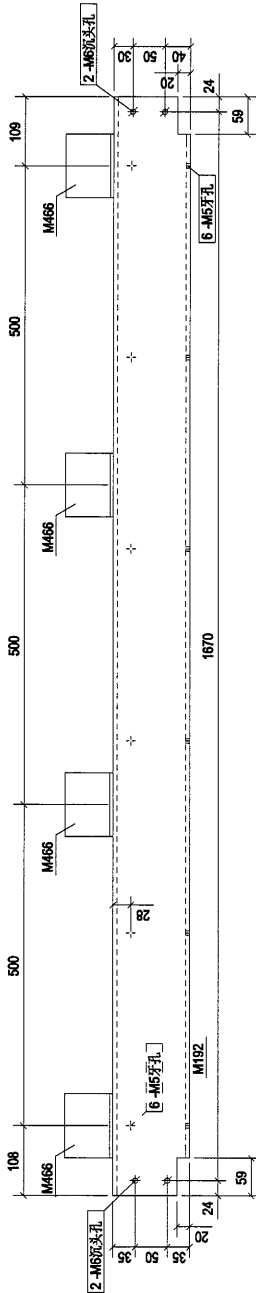


A - A

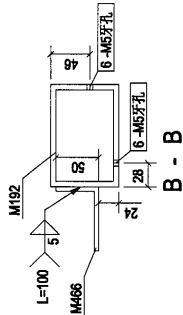


B - B

0	第1次报批	2016-07-04
Rev.	Description	Date
PROJECT: PROPOSED SITE C1 DEVELOPMENT AT AREA 88, TKOTL 70 RP, TSEUNG KWAN O, NEW TERRITORIES		
CLIENT:  美特鋁質有限公司 MIDY ALUMINIUM FABRICATOR LTD. Units 6-8, Sun Yee Industrial Estate, 1/F 810 Che Kwoi Yee Road, Kwai Tsing Tel: 23489211-4, Fax: (852) 2772 6656		
 銀同有限公司 Silver Town Limited Tel: (852) -83339883 Fax: (852) -83339854 E-Mail: ADDRESS@silvertown.hk, 163.07.00		
DRAWING TITLE : [3HL-11]		
CAD File Name :		
Designed by		
Drawn by		
Reviewed by		
Approved by		
Scale		
DWG NO.: (WW4)-2 - [3HL-11]		REV 0


构件编号:		3HL-12	构件数量:		1	构件重量:		33.03
零件编号	规格(mm)	数量	重量(kg)	长度(mm)	重量(kg)	长度(mm)	重量(kg)	
M193	RHS120*80*6.3	1770	1	31.14	31.14	0.96		
M466	RSA75*50*5	100	4	0.47	1.88	0.03		
合计:								33.03

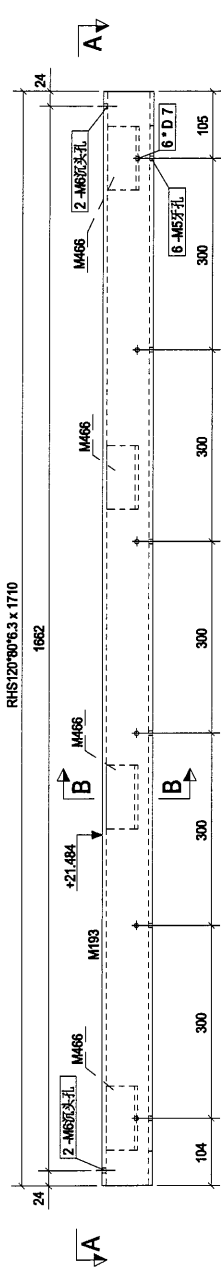

构件: 3HL-12

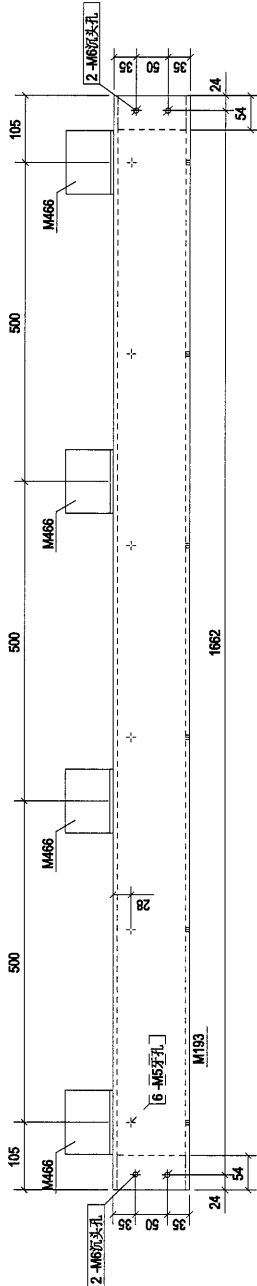


A - A

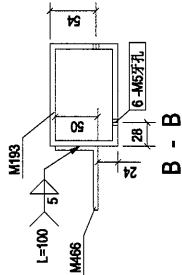


B - B

0	第1次报批	2018-07-04
Rev.	Description	Date
PROJECT: PROPOSED SITE C1 DEVELOPMENT AT AREA 88, TKOIL 70 RP, TSEUNG KWAN O, NEW TERRITORIES		
CLIENT: 美特鋁質有限公司 MIDAL ALUMINIUM FABRICATOR LTD. Units 5 & 6, Sunning Industrial Estate, 7/F, 610 Cha Kwo Ling Road, Kowloon Tel: 23489211-4, Fax: (852) 27277656		
S 銀同有限公司 Silver Town Limited Tel: (852) 235586 Fax: (852) 235584 E-Mail: ADDRESS@silvertown.com.hk		
DRAWING TITLE : [3HL-12]		
CAD File Name :		
Designed by		
Drawn by		
Reviewed by		
Approved by		
Scale		
DWG NO: (MW4)-2 - [3HL-12]	REV.	0


构件编号:		3HL-14	构件数量:		1	构件重量:		32.96
构件编号	规格(mm)	长度(mm)	数量	重量(kg)	共重(kg)	长度(mm)	重量(kg)	共重(kg)
M195	RHS120*80*6.3	1706	1	31.07	31.07			
M466	RS475*50*5	100	4	0.47	1.88			
合计:								32.96

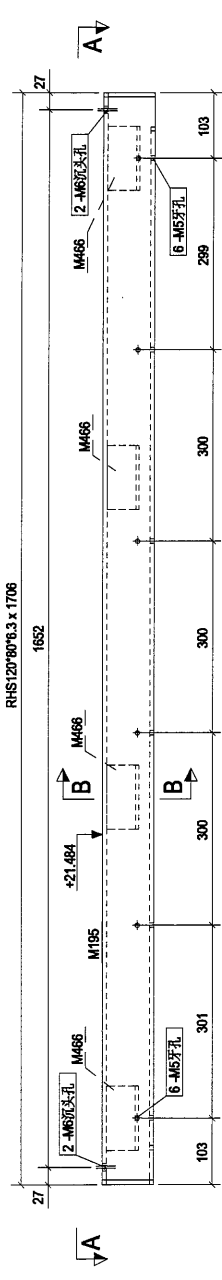

构件: 3HL-14

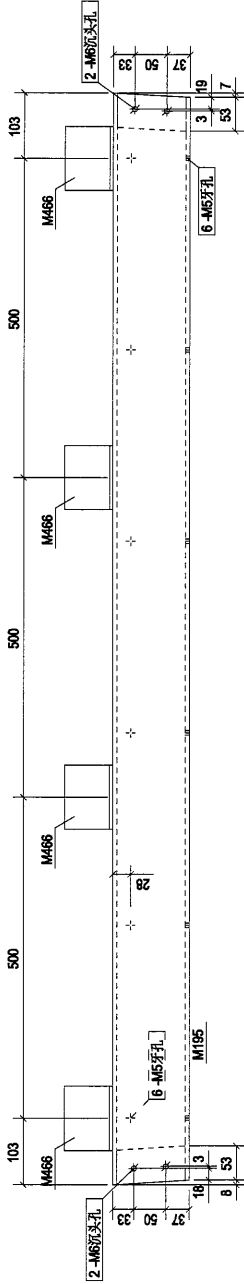


A - A

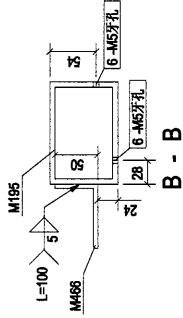


B - B

0	第1次提批	2018-07-04
Rev.	Description	Date
PROJECT: PROPOSED SITE C1 DEVELOPMENT AT AREA B8, TKOIL 70 RP, TSEUNG KWAN O, NEW TERRITORIES		
CLIENT: 美特鋁質有限公司 MIDAL ALUMINIUM FABRICATOR LTD. Units 5 & 8, Sunning Industrial Estate, 7/F 610 Cha Kwo Ling Road, Kowloon Tel: 23489211-4, Fax: (852) 2727656		
S 銀同有限公司 Silver Town Limited Tel: 00852 23558666, Fax: 00852 2355864 E-MAIL: ADDRESS@silvertown.hk, 153.0204		
DRAWING TITLE : [3HL-.14]		
CAD File Name :		
Designed by		
Drawn by		
Reviewed by		
Approved by		
Scale		
DWG NO: (WW4)-2 - [3HL-.14]	REV.	0


材料编号	3HL-15	材料数量	1	材料重量	33.06
零件编号	长度(mm)	数量	重量(kg)	共重量(kg)	长度(mm)
M196	RHS120*80*6.3	1712	1	31.17	0.86
M466	RS475*50*5	100	4	0.47	1.88
				0.03	
合计					33.06

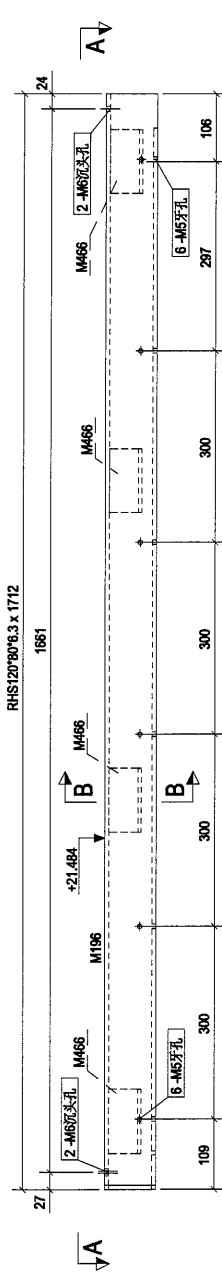

构件: 3HL-15

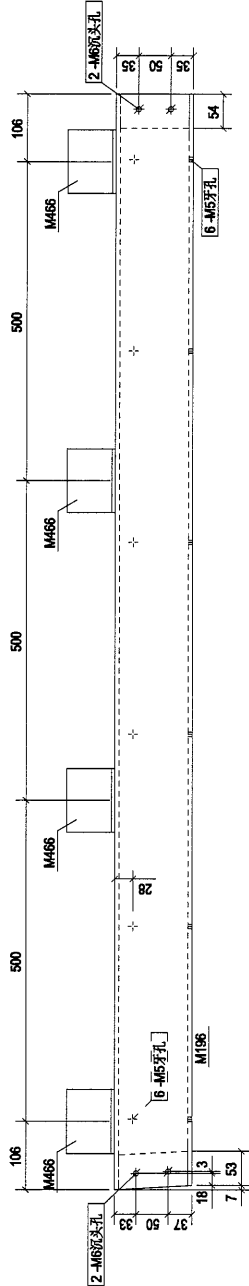


A - A

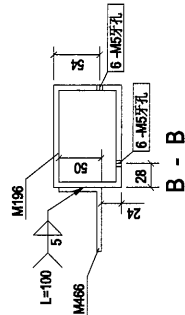


0	第1次报批	2018-07-04
Rev.	Description	Date
PROJECT: PROPOSED SITE C1 DEVELOPMENT AT AREA 88, TKOTL 70 RP, TSEUNG KWAN O, NEW TERRITORIES		
CLIENT: 美特铝质有限公司 MIDAL 810 Che Kwo Ling Road, Kwai Tsing Tel: 23489211-4, Fax: 23489211-4		
S 银同有限公司 Silver Town Limited Tel: 23489211-4, Fax: 23489211-4 E-mail: ADDRESS@silvertown.com.hk		
DRAWING TITLE : [3HL-15]		
CAD File Name :		
Designed by		
Drawn by		
Reviewed by		
Approved by		
Scale		
DWG NO. (WWW)-2 - [3HL-15]		REV. 0


构件编号:		3HL-16	构件数量:		2	构件重量:		33.15
零件编号	规格(mm)	数量	重量(kg)	共重(kg)	长度(mm)	重量(kg)	共重(kg)	重量(m)
M197	RHS120*80*5.3	1	31.27	31.27	1717	0.88		
M466	RS475*50*5	4	0.47	1.88	100	0.03		
合计:								33.15

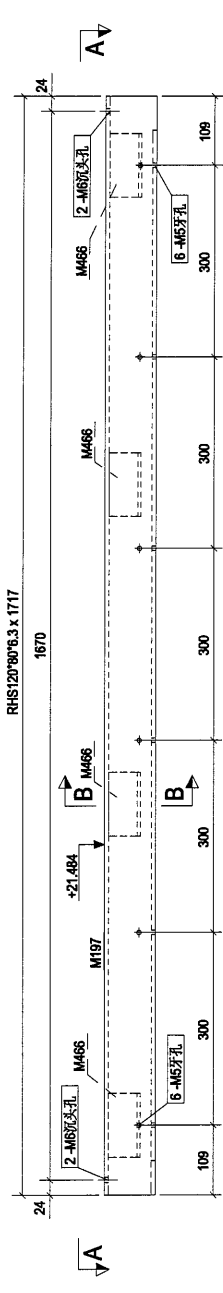

构件: 3HL-16

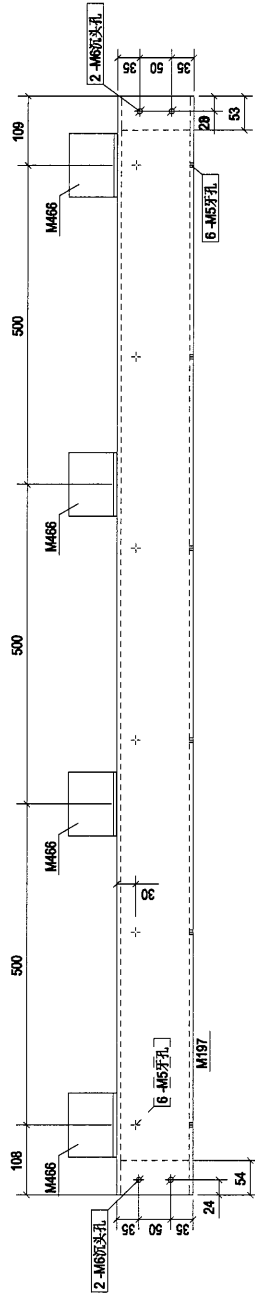


A - A

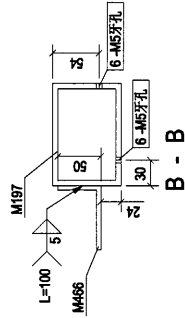


B - B

0	第1次提批	2018-07-04
Rev.	Description	Date
PROJECT: PROPOSED SITE C1 DEVELOPMENT AT AREA 88, TKOIL 70 RP, TSEUNG KWAN O, NEW TERRITORIES		
CLIENT: 美特鋁質有限公司 MIDAL ALUMINIUM FABRICATOR LTD. 1018 S.H. Sun Industrial Estate, 1/F 510 Chee Kwoi Road, Kwai Tsing Tel: 23489211-4, Fax: (852) 2727666		
3 銀同有限公司 Silver Town Limited Tel: 2765-8335/886 Fax: 2765-8335/854 E-Mail: ADDR33@silvertown.hk		
DRAWING TITLE : [3HL-16]		
CAD File Name :		
Designed by		
Drawn by		
Reviewed by		
Approved by		
Scale		
DWG NO.: (WW4)-2 - [3HL-16]		REV. 0


材料编号:		3HL-19	材料数量:		1	材料重量:		33.42
操作编号		长度(mm)	数量	重量(kg)	并 重(kg)	注 重(mm)		
M200		RHS120*80*6.3	1731	1	31.53	0.88		
M468		RSA75*50*5	100	4	0.47	1.88		0.03
						合计:		33.42

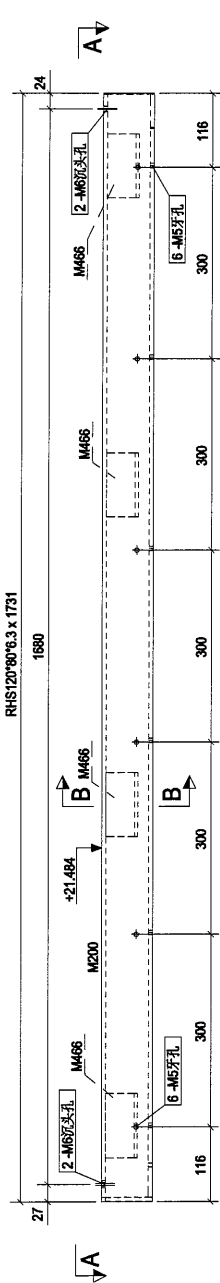

构件: 3HL-19

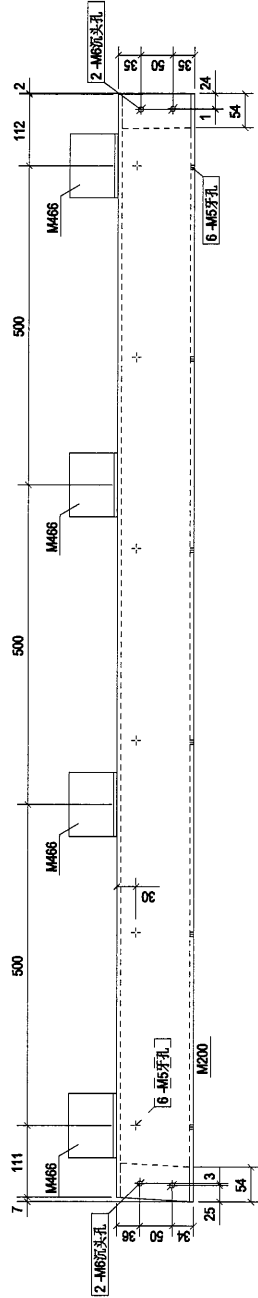

A - A

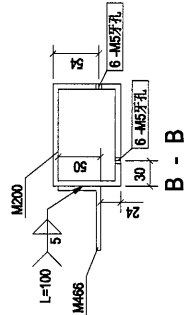

CLIENT: 美特铝业有限公司
MIDI ALUMINUM MANUFACTURE LTD.
Units 5-8, Sunny Industrial Centre, 1/F,
810 Cha Kwo Ling Road, Kowloon
Tel: 23489211-4, Fax: (852) 2727656

S 银同有限公司
Silver Town Limited
Tel: (852) 23489211-4, Fax: (852) 2727656
E-MAIL: ADDRESS@silvertown.com.hk

DRAWING TITLE :

[3HL-.19]

CAD File Name :

Designed by

Drawn by

Reviewed by


Approved by

Scale

DWG NO: (WW4)-2 - [3HL-.19]


REV	0
-----	---

材料编号:		3HL-20	构件数量:		1	构件重量:		33.50
材料名称:		长度(mm)	重量	高度(mm)	数量	重量(kg)	高度(mm)	重量(kg)
M201	RHS120*80*6.3	1736	1	31.62	31.62	31.62	0.57	0.57
M466	RSA75*50*5	100	4	0.47	1.88	0.47	1.88	0.03
合计:								33.50

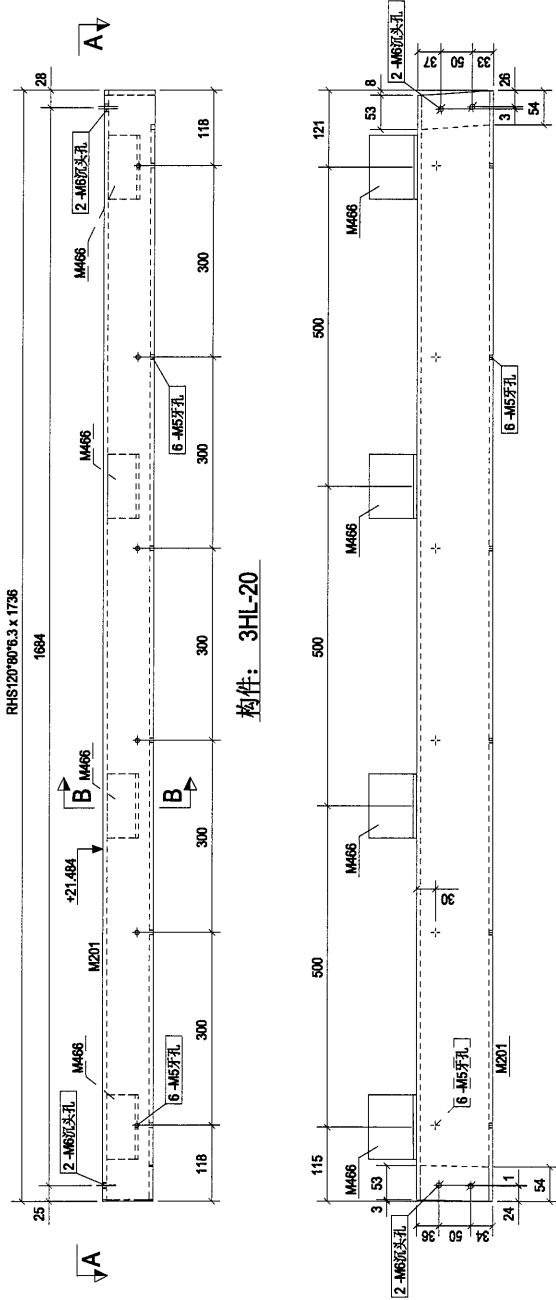


0	第1次提批	2018-07-04
Rev.	Description	Date
PROJECT: PROPOSED SITE C1 DEVELOPMENT AT AREA 88, TKOIL 70 RP, TSEUNG KWAN O, NEW TERRITORIES		
CLIENT: 美特鋁質有限公司 MIDY UNITED MANUFACTURING LTD. Units 5 & 8, Sunny Industrial Centre, 7/F 810 Cha Kwo Ling Road, Kowloon Tel: 23489211-4, Fax: (852) 2777666		
S 銀同有限公司 Silver Town Limited Tel: (852) 3035586 Fax: (852) 3035584 E-Mail: Address@silvertown.com.hk		
DRAWING TITLE : [3HL-20]		
CAD File Name :		
Designed by		
Drawn by		
Reviewed by		
Approved by		
Scale		
DWG NO: (WW4)-2 - [3HL-20]		REV. 0


材料编号: 3HL-21		构件数量: 1		构件重量: 27.63	
零件编号	规格(mm)	数量	重量(kg)	共重(kg)	重量(m)
M214	RHS120*80*6.3	1	26.22	26.22	0.55
M466	RSA75*50*5	3	0.47	1.41	0.03
合计:					27.63

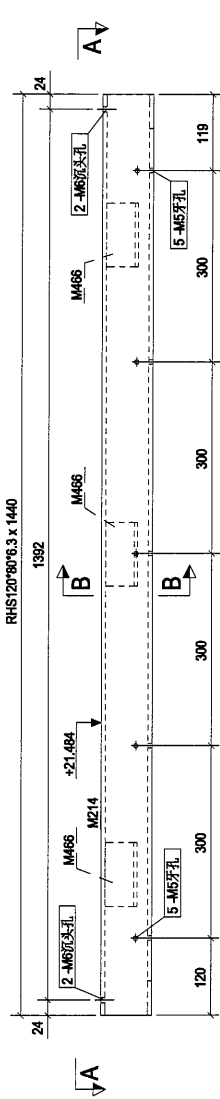

构件: 3HL-21

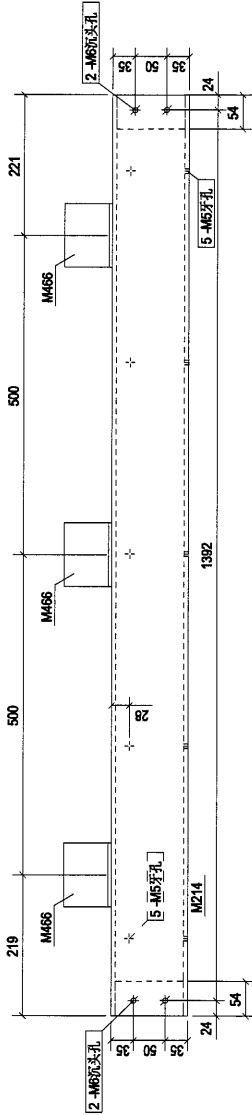

A - A

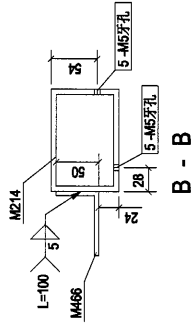

B - B


0	第1次提批	2018-07-04
Rev.	Description	Date
PROJECT: PROPOSED SITE C1 DEVELOPMENT AT AREA 88, TKOIL 70 RP, TSEUNG KWAN O, NEW TERRITORIES		
CLIENT: 美特鋁質有限公司 MIDJ ALUMINIUM FABRICATOR LTD. Units 6 & 8, Sunny Industrial Estate, 7/F 810 Cha Kwo Ling Road, Kowloon Tel: 23489211 - 4, Fax: 6527727655		
S 銀同有限公司 Silver Town Limited INCORPORATED IN HONG KONG F-MAIL: ADDRESS@silvertown.hk, 16.02.04		
DRAWING TITLE : [3HL-21]		
CAD File Name :		
Designed by		
Drawn by		
Reviewed by		
Approved by		
Scale		
DWG NO.:	(WW4)-2 - [3HL-21]	REV. 0

修改说明:
1, 取消M5牙孔,并切为47高U槽。

构件编号: 3HL-23		1		构件数量:		31.26	
零件编号	规格(mm)	数量	单重(kg)	共重(kg)	表面利(m)	表面利(m)	0.66
M216	RHS120*80*6.3	1	31.26	31.26			
合计: 31.26							



构件: 3HL-23

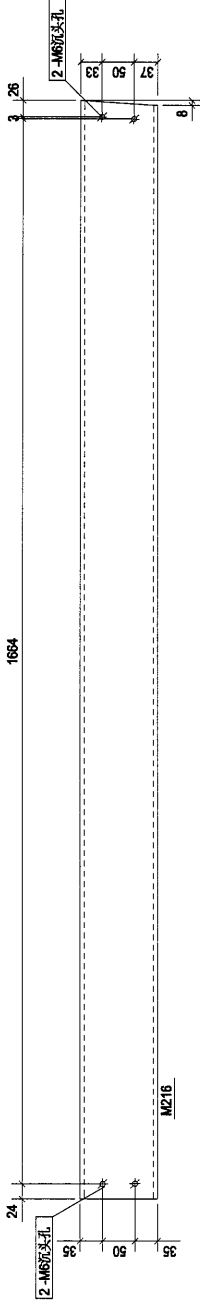


A - A


A		第2次保批	2018-11-05
Rev.	Description		Date
PROJECT: PROPOSED SITE C1 DEVELOPMENT AT AREA 88, TKO T.L. 70 RP, TSEUNG KWAN O, NEW TERRITORIES			
CLIENT:  美特鋁質有限公司 MIDI ALUMINIUM FABRICATOR LTD. Units E-B, Sunny Industrial Centre, 1/F 610 Che Kwo Ling Road, Kowloon Tel: 23489211-4 Fax: (852) 27727656			
 銀同有限公司 Silver Town Limited Tel: 0755-8335088 Fax: 0755-8335854 E-MAIL: ADDRESS@silvertown.com			
DRAWING TITLE : [3HL-23]			
CAD File Name :			
Designed by			
Drawn by			
Reviewed by			
Approved by			
Scale			
DWG NO: (MW4)2 - [3HL-23]			REV. A

修改说明:
1, 取消M5牙孔, 并切为47高U槽。

构件编号:	3HL-24	1	构件数量:	31.07
零件编号	规格(mm)	数量	重量(kg)	共重(kg)
M217	RHS120*80*6.3	1	31.07	31.07
合计:				31.07

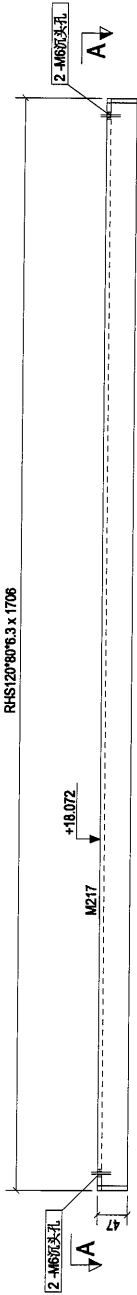

构件: 3HL-24

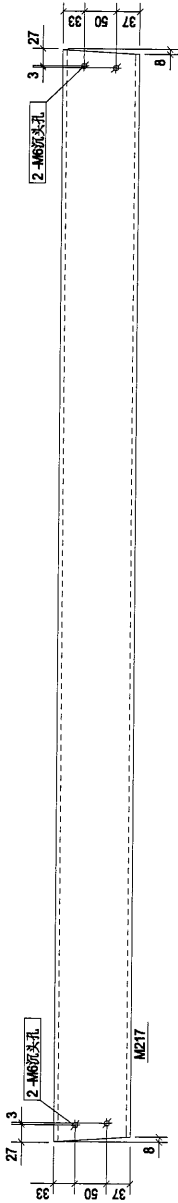

A - A


A	第2次报批	2018-11-05
Rev.	Description	Date
PROJECT:		
PROPOSED SITE C1 DEVELOPMENT AT AREA B8, TKOIL 70 RP, TSEUNG KWAN O, NEW TERRITORIES		
CLIENT:		
美特铝质有限公司 MIDI ALUMINIUM FABRICATOR LTD. Units 6-8, Sunny Industrial Centre, 1/F 81, Tin Tin Road, Tseung Kwan O, New Territories Tel: 2346911-4 Fax: (852) 2727866		
S 银同有限公司 Silver Town Limited Tel: 0769-4335498 Fax: 0769-4335954 E-MAIL: J00R335@silvertown.hk		
DRAWING TITLE :		
[3HL-24]		
CAD File Name :		
Designed by		
Drawn by		
Reviewed by		
Approved by		
Scale		
DWG NO.: (WW4)-2 - [3HL-24]		
REV. A		

修改说明:
1, 取消M5牙孔,并切为47高U槽。

构件编号: 3HL-25		构件数量: 1		构件重量: 31.17	
部件编号	规格(mm)	数量	单重(kg)	共重(kg)	表面积(m²)
M218	RHS120*80*6.3	1	31.17	31.17	0.66
合计:					31.17



构件: 3HL-25

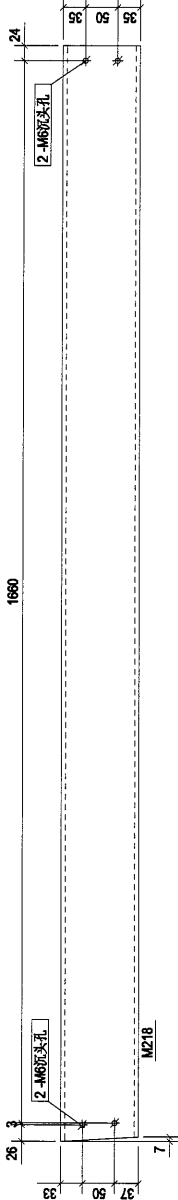

A	第2次报批	2018-11-05
Rev.	Description	Date
PROJECT: PROPOSED SITE C1 DEVELOPMENT AT AREA 88, TKOTI 70 RP, TSEUNG KWAN O, NEW TERRITORIES		
CLIENT:  美特铝质有限公司 MIDI ALUMINIUM FABRICATOR LTD. Units 6 & 7, Sunny Industrial Centre, 1/F 510 Cheung Kwan Road, Kwai Chung, Kowloon Tel: 2348211-4 Fax: (852) 27727556		
 银同有限公司 Silver Town Limited Tel: 0709-8335488 Fax: 0769-8335954 E-Mail: ADDRESS@silvertown.hk		
DRAWING TITLE : [3HL-25]		
CAD File Name :		
Designed by		
Drawn by		
Reviewed by		
Approved by		
Scale		
DWG NO.: (WW4)-2 - [3HL-25]		REV. A


修改说明:
1, 切为47高U槽。
2, 数量减+1.

构件编号: 3HL-26		构件数量: 7		构件重量: 31.27	
部件编号	规格(mm)	数量	单重(kg)	共重(kg)	表面积(m ²)
M274	RHS120*80*6.3	1	31.27	31.27	0.66

合计: 31.27




构件: 3HL-26

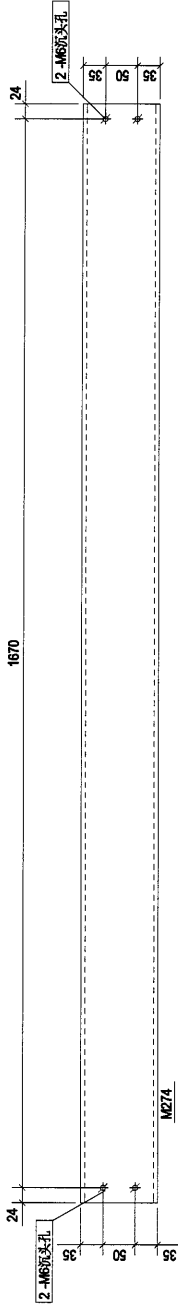


B	第3次找批	2018-11-09
Rev.	Description	Date
PROJECT: PROPOSED SITE C1 DEVELOPMENT AT AREA 88, TKOTIL 70 RP, TSEUNG KWAN O, NEW TERRITORIES		
CLIENT: 美特鋁質有限公司 MIDY ALUMINIUM FABRICATOR LTD. Units 6 & 8, Sun Chai Industrial Estate, 7/F 810 Che Kwoi Ling Road, Kwai Tsing Tel: 23489211-4, Fax: (852) 2727656		
S 銀同有限公司 Silver Town Limited Tel: 00853 233586, Fax: 00853 233584 E-MAIL: ADDRESS@silvertown.hk		
DRAWING TITLE : [3HL-26]		
CAD File Name :		
Designed by		
Drawn by		
Reviewed by		
Approved by		
Scale		
DWG NO. (WWW)-2	[3HL-26]	REV. B

修改说明:
1, 取消M5牙孔,并切为47高U槽。
2, 数量+1, 由3HL-22变来。

构件编号:	3HL-27	构件数量:	2	构件重量:	31.13
零件编号	规格(mm)	数量	单重(kg)	共重(kg)	表面积(m ²)
M220	RHS120*80*6.3	1	31.13	31.13	0.66
合计:					31.13

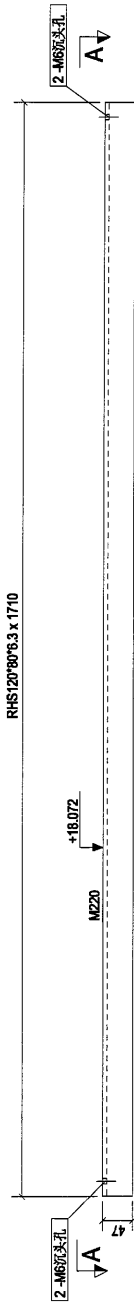


构件: 3HL-27

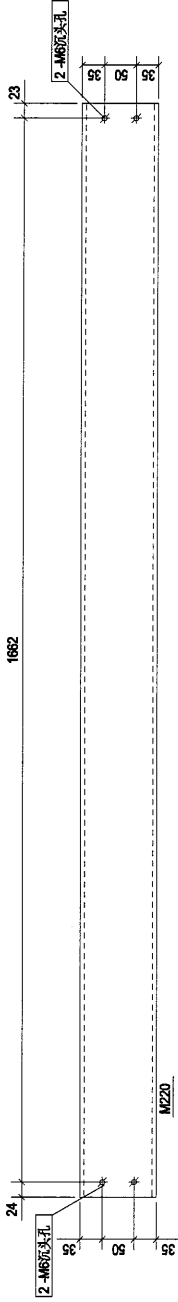


A - A

A	第2次报批	2018-11-05
Rev.	Description	Date
PROJECT: PROPOSED SITE C1 DEVELOPMENT AT AREA 88, TKOIL TO RP, TSEUNG KWAN O, NEW TERRITORIES		
CLIENT:  美特铝质有限公司 MIDY ALUMINIUM FABRICATOR LTD. Units 5-8, Sun Chai Industrial Estate, 1/F 610 Che Kwo Ling Road, Kwai Tsing, Tel: 23489211-4, Fax: (852) 2727666		
 银同有限公司 Silver Town Limited Tel: 2769-8339/888 Fax: 2769-8339/854 E-Mail: ADRC33@silvertown.hk		
DRAWING TITLE : [3HL-27]		
CAD File Name :		
Designed by		
Drawn by		
Reviewed by		
Approved by		
Scale		
DWG NO: (WW4)-2 - [3HL-27]		REV. A


材料编号		3HL-29		材料重量		1		材料重量		12.39	
材料编号		规格(mm)		数量		重量(kg)		数量		重量(kg)	
M222		RHS120*80*3		629		1		11.45		11.45	
M468		RSA75*50*5		100		2		0.47		0.94	
										0.03	
										合计:	
										12.39	

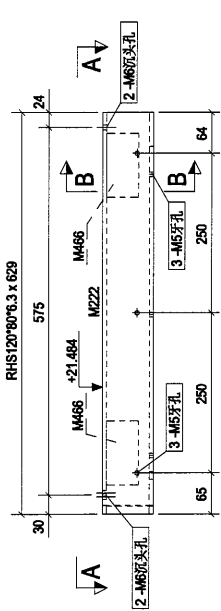

构件: 3HL-29

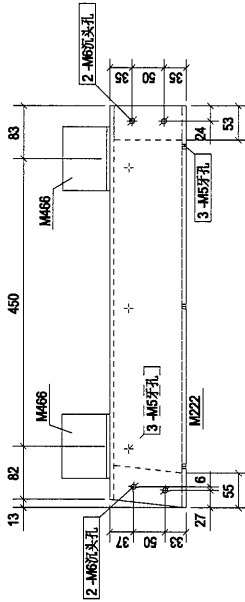

A - A

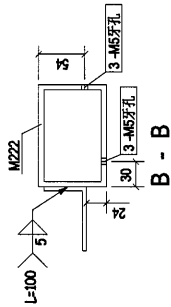


B - B


0	第1次提批	2018-07-04
Rev.	Description	Date
PROJECT: PROPOSED SITE C1 DEVELOPMENT AT AREA B8, TKOIL 70 RP, TSEUNG KWAN O, NEW TERRITORIES		
CLIENT: 美特鋁質有限公司 METAL QUALITY INDUSTRIES LTD. Units 5-8, Sunway Industrial Centre, 610 Cha Kwo Ling Road, Kowloon Tel: 23489211-4 Fax: (852) 2777666		
S 銀同有限公司 Silver Town Limited Tel: 00853 23556666 Fax: 00853 23556664 E-MAIL: ADDRESS@silvertown.hk		
DRAWING TITLE : [3HL-29]		
CAD File Name :		
Designed by		
Drawn by		
Reviewed by		
Approved by		
Scale		
DWG NO: (WW4)-2 - [3HL-29]		REV. 0

修改说明:
1, 取消M5牙孔, 并切为47高U槽。

构件编号:	3HL-30	构件数量:	1	构件重量:	26.22
部件编号	规格(mm)	数量	单重(kg)	共重(kg)	表面积(m ²)
M246	RHS120*80*6.3	1	26.22	26.22	0.55
合计:					26.22

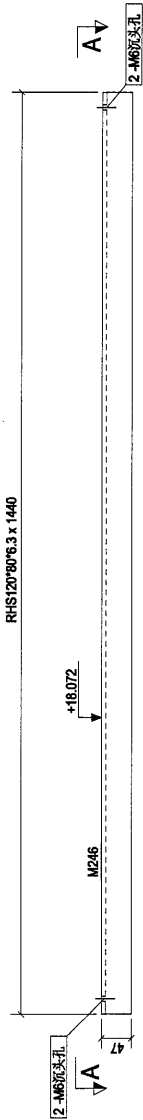

构件: 3HL-30

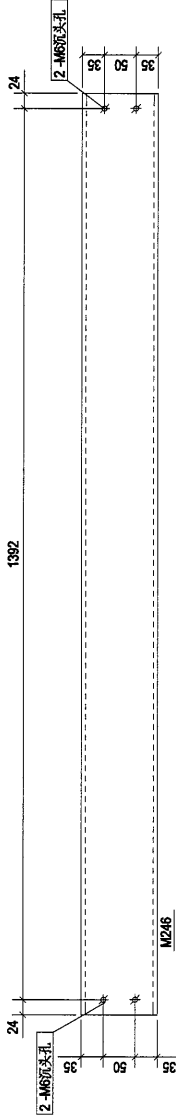

A - A

A	第2次修改	2018-11-05
Rev.	Description	Date
PROJECT: PROPOSED SITE C1 DEVELOPMENT AT AREA 08, TKOTL 70 RP, TSEUNG KWAN O, NEW TERRITORIES		
CLIENT: 美特铝质有限公司 MIDT ADVANCED ALUMINUM LTD. Units 6-8, Sunny Industrial Centre, Y/F 610 Cha Kwo Ling Road, Kowloon Tel: 23489211 - 4, Fax: (853) 2727655		
S 银同有限公司 Silver Town Limited Tel: 00853-2355088, Fax: 00853-2355084 E-MAIL: ADDRESS@silvertown.hk, SILTOW		
DRAWING TITLE : [3HL-30]		
CAD File Name :		
Designed by		
Drawn by		
Reviewed by		
Approved by		
Scale		
DWG NO: (WWW)-2 - [3HL-30]		REV. A

2, 数量減1。

合计: 77.30




DWG NO.: (WW4)-2 - [3HL-31]	REV.	R
-----------------------------	------	---

修改说明:


1, 增加牙孔, 角码。

[illegible]


2037 (RHS120*80*6.3 x 2037)

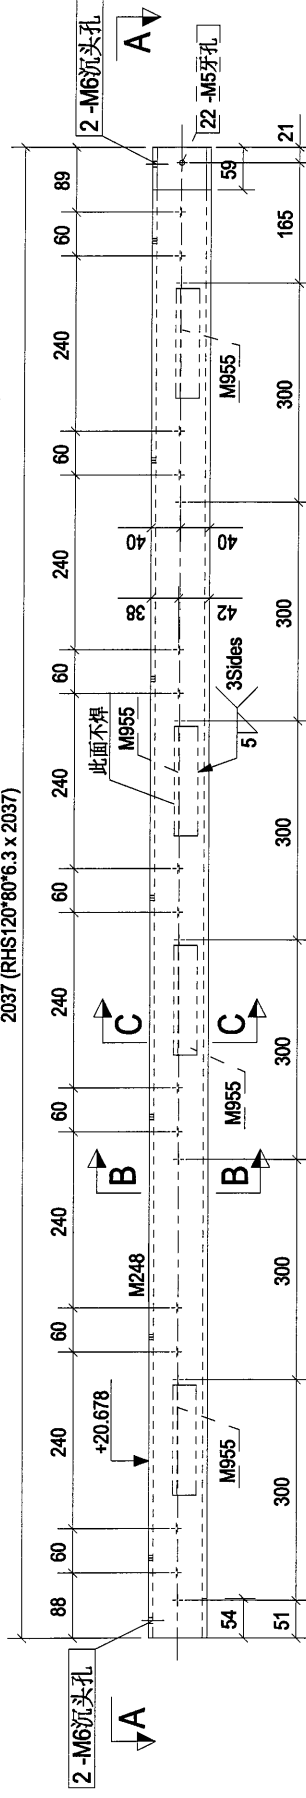

构件: 3HL-32

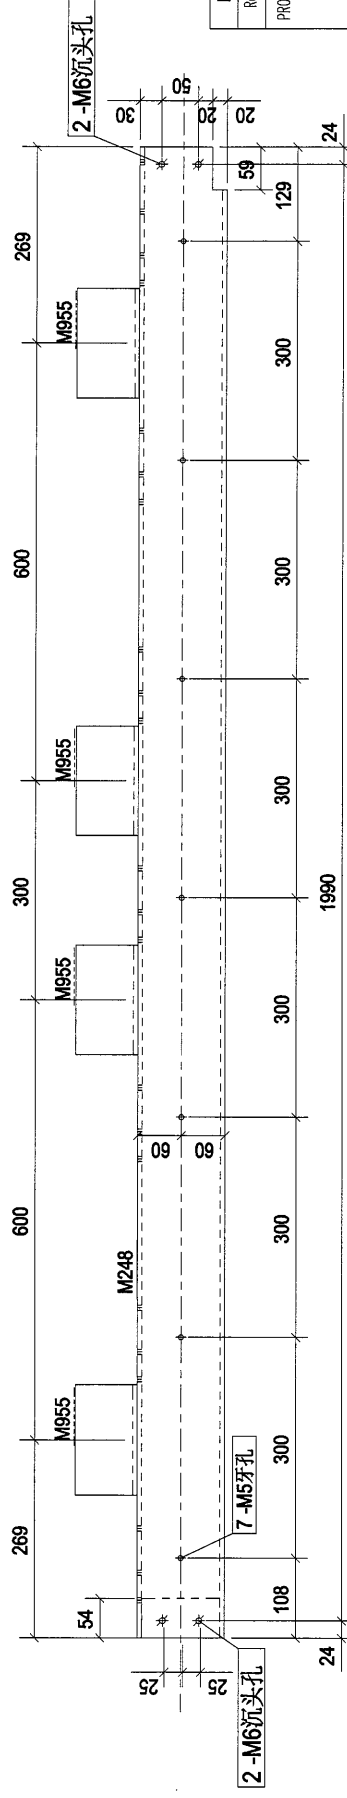

A - A

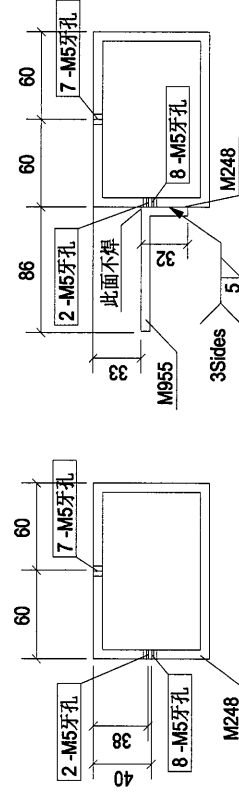
**BB**

U
I
U


B	第3次提批	2018-11-05
Rev.	Description	Date
PROJECT: PROPOSED SITE C1 DEVELOPMENT AT AREA 68, KOTU 70 RD, TSEUNG KWAN O, NEW TERRITORIES		
CLIENT:	 美特铝质有限公司 MIDI ALUMINIUM FABRICATORS LTD. Units 6-8, Sunny Industrial Centre, 1/F 610 Cha Kwo Ling Road, Kowloon Tel:23489211-4 Fax: (852)27276666	
	 银同有限公司 Silver Town Limited Tel:0769-8338498 Fax:768-8338654 E-MAIL: ADDRESS@silvertown.hk, 163.COM	
DRAWING TITLE : [3HL-32]		
CAD File Name :		
Designed by		
Drawn by		
Reviewed by		
Approved by		
Scale		
DWG NO.:	(WWW4)-2	[3HL-32]
		REV.

- 1, 长度加长, 增加牙孔, 增加角码。
- 2, 数量减1。


构件编号:	3H-33	构件数量:	1	构件重量:	77.30
零件编号	规格(mm)	长度(mm)	数量	单重(kg)	共重(kg)
M075	RHS120*80*6.3	4037	1	73.52	73.52
M086	RSA84*29*6	150	5	0.76	3.78
					77.30
					合计:

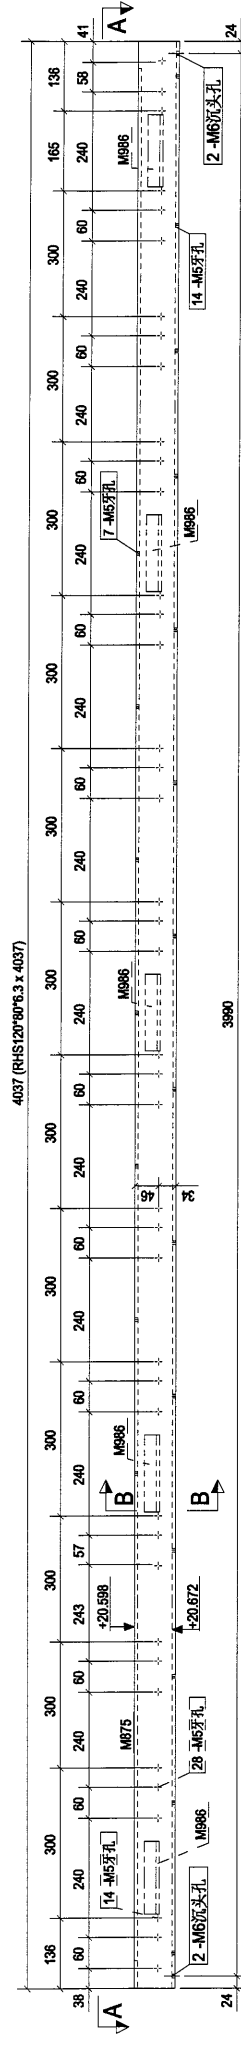

构件: 3HL-33

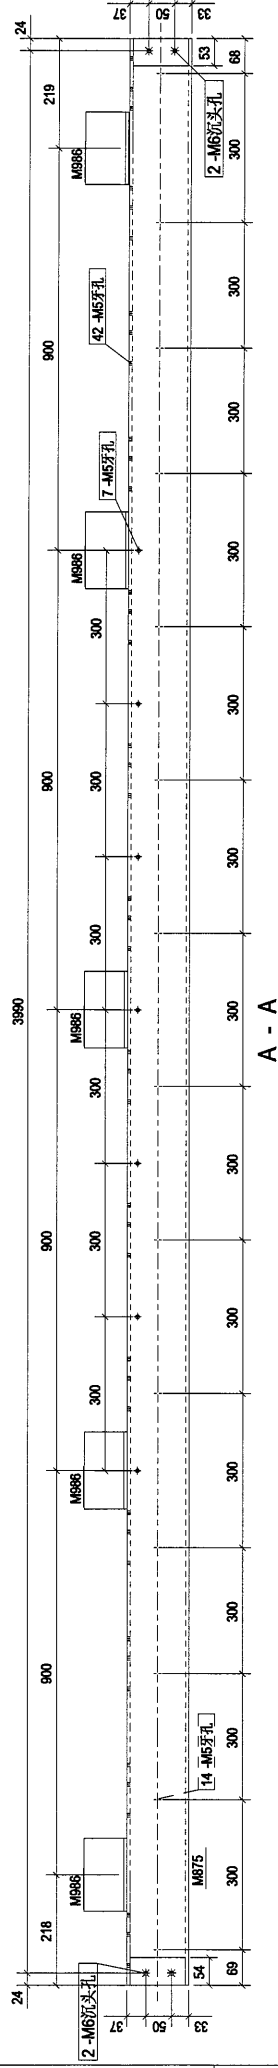


A - A

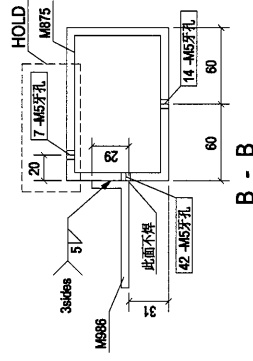


—

A	第23次批發	2018-11-05
Rev.	Description	Date
PROJECT: PROPOSED SITE C1 DEVELOPMENT AT AREA 88, TR012 TO KP. TSEUNG KWAN O, NEW TERRITORIES		
CLIENT:  美特鋁質有限公司 MIDIS ALUMINIUM MANUFACTURING LTD. Units 5-8, Sunray Industrial Centre, 1/F, 610 Cha Kwo Ling Road, Kowloon Tel: 234349211-4 Fax: (852) 27272656		
 銀同有限公司 Silver Town Limited Tel: 0766-8355088 Fax: 0766-8355854 E-MAIL ADDRESS: ag@silvertown.hk		
DRAWING TITLE :		
[3HL-33]		
CAD File Name :		
Designed by Drawn by Reviewed by Approved by Scale		
DWG NO.: (WW44)-2 - [3HL-33] REV.		


料件编号:	3HL-35	料件数量:	2	料件重量:	37.90
规格(mm)	1977	长度(mm)	1977	重量	36.01
M252	RHS120*80*6.3	1	36.01	共重(kg)	72.02
M466	RSA175*50*5	4	0.47	共重(kg)	1.88
					0.03
合计:					37.90

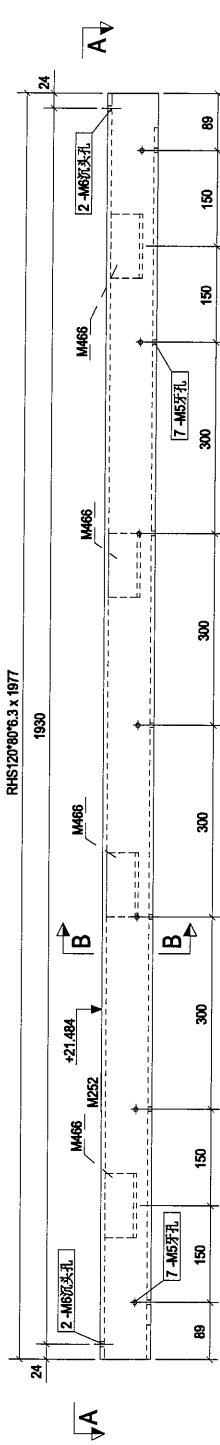

构件: 3HL-35


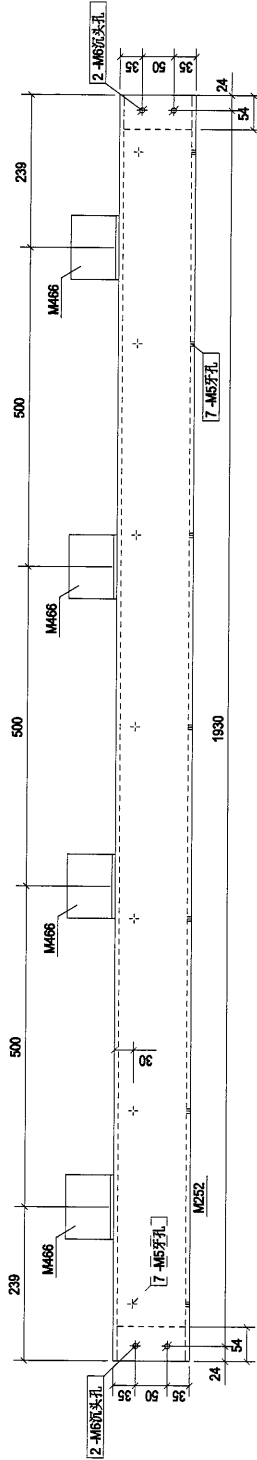


A - A

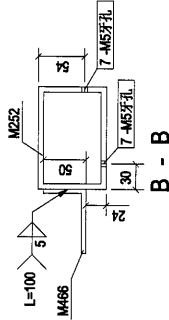

0	第1次报批	2018-07-04
Rev.	Description	Date
PROJECT: PROPOSED SITE C1 DEVELOPMENT AT AREA B8, TKOTIL 70 RP, TSEUNG KWAN O, NEW TERRITORIES		
CLIENT: 美特铝质有限公司 MIDI ALUMINIUM FABRICATOR LTD. Units 6-7, Sunny Industrial Centre, 1/F 510 Che Kwo Ling Road, Kwun Tong Tel: 2348211-4 Fax: (852) 2727656		
S 银同有限公司 Silver Town Limited Tel: 0769-8335488 Fax: 0766-8335854 E-MAIL: ADDRESS@silvertown.hk		
DRAWING TITLE : [3HL-35]		
CAD File Name :		
Designed by		
Drawn by		
Reviewed by		
Approved by		
Scale		
DWG NO: (WW4)-2 - [3HL-35]	REV.	0


零件编号:	3HL-36	零件数量:	2	零件重量:	37.89	
零件编号	规格(mm)	长度(mm)	数量	重量	单位(mm)	漆面积(m ²)
M253	RHS120*80*6.3	1977	1	36.01	36.01	0.76
M466	RSA75*50*5	100	4	0.47	1.88	0.03
合计:				37.89		

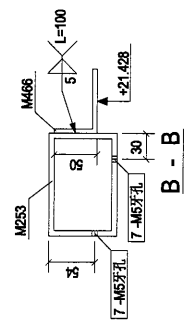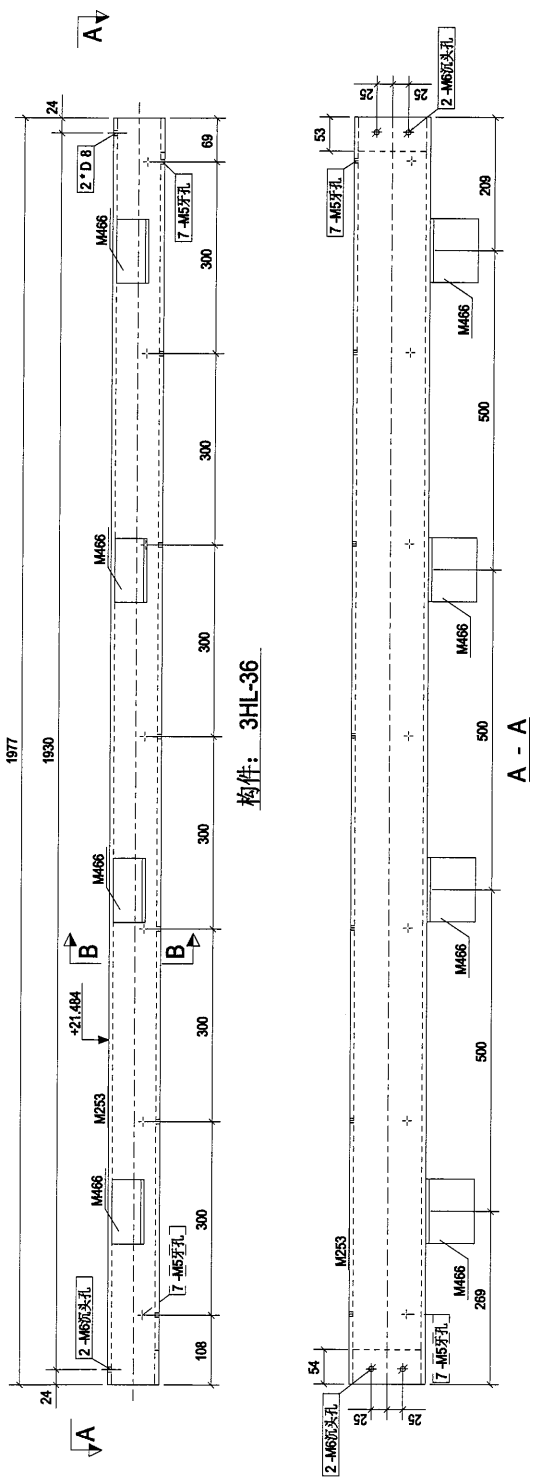


0	第1次提批	2018-07-04
Rev.	Description	Date
PROJECT:		
PROPOSED SITE C1 DEVELOPMENT AT AREA 86, TKOTL 70 RP, TSEUNG KWAN O, NEW TERRITORIES		
CLIENT:		
美特铝质有限公司 MIDI ALUMINIUM FABRICATOR LTD. Units E-B, Sunny Industrial Centre, 1/F 510 Chee Kwo Ling Road, Kowloon Tel: 23682111-4 Fax: (852) 2712166		
S 银同有限公司 Silver Town Limited Tel: 0769-8335488 Fax: 0769-8335854 E-MAIL: ADDRESS@silvertown.com.hk		
DRAWING TITLE :		
[3HL-36]		
CAD File Name :		
Designed by		
Drawn by		
Reviewed by		
Approved by		
Scale		
DWG NO: (WWW)2 - [3HL-36]		REV.
		0

修改说明:
1, 取消M5牙孔,并切为47高U槽。

构件编号:	3HL-37	构件数量:	1	构件重量:	31.27
零件编号	规格(mm)	数量	单重(kg)	共重(kg)	漆面积(m ²)
M265	RHS120*80*6.3	1	31.27	31.27	0.66
合计:					31.27

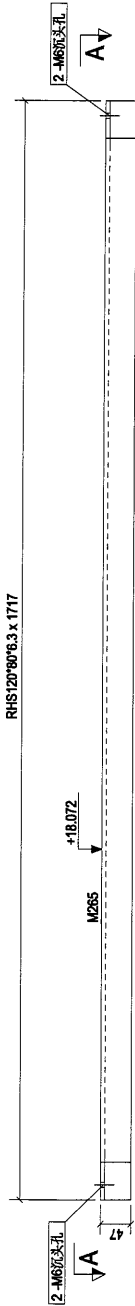

构件: 3HL-37

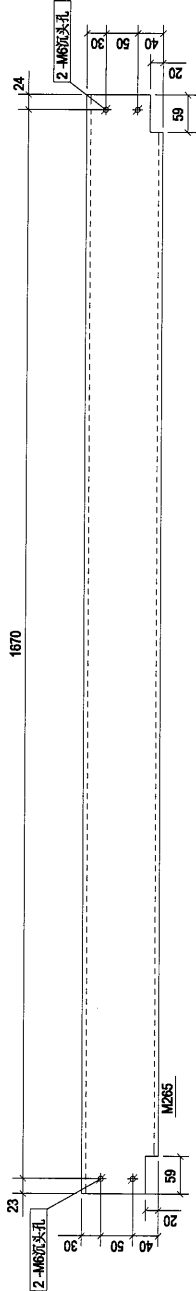


A - A


A	第2次投批	2018-11-05
Rev.	Description	Date
PROJECT:		
PROPOSED SITE C1 DEVELOPMENT AT AREA 86, TKOTIL 70 RP, TSEUNG KWAN O, NEW TERRITORIES		
CLIENT:		
美特鋁質有限公司 MIDI ALUMINIUM FABRICATOR LTD. Units 6-8, Sunoy Industrial Centre, 1/F 610 Che Kwo Ling Road, Kowloon Tel: 23489211-4 Fax: (852) 2727665		
S 银同有限公司 Silver Town Limited Tel: 0769-8335466 Fax: 0769-8335854 E-MAIL: ADDRESS@silvertown.hk		
DRAWING TITLE :		
[3HL-37]		
CAD File Name :		
Designed by		
Drawn by		
Reviewed by		
Approved by		
Scale		
DWG NO.:	(WWW)-2	- [3HL-37]
REV.	A	

零件编号	3HL-38	材料数量	1	材料重量	38.98
零件编号	规格(mm)	长度(mm)	数量	重量(kg)	长度(mm)
M286	RHS120*80*6.3	2037	1	37.10	37.10
M466	RSA15*50*5	100	4	0.47	1.88
合计:				38.98	0.03


RHS120*80*6.3 x 2037

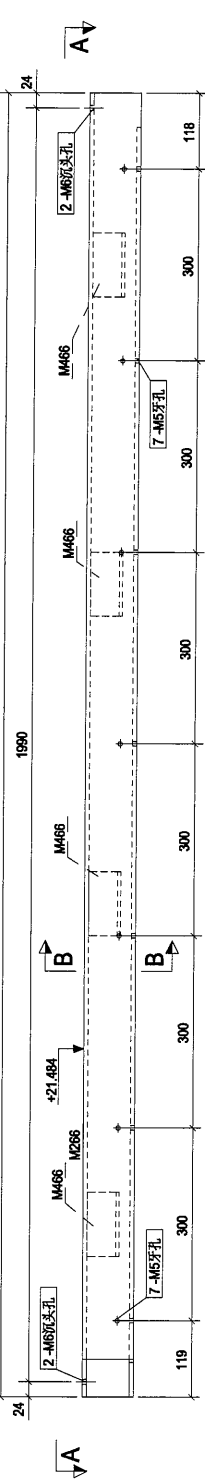

构件: 3HL-38

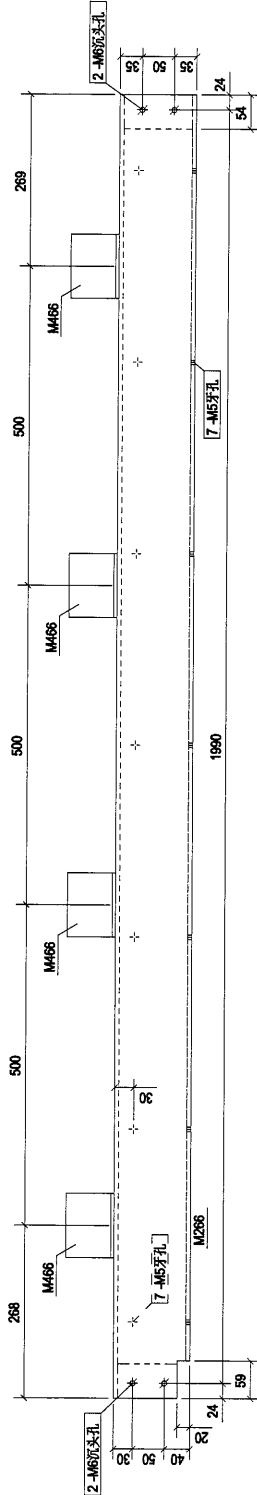

A - A

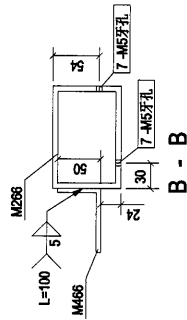

B - B

0	第1次出图	2018-07-04
Rev.	Description	Date
PROJECT: PROPOSED SITE C1 DEVELOPMENT AT AREA B6, TKOTL 70 RP TSEUNG KWAN O, NEW TERRITORIES		
CLIENT: 美特铝质有限公司 MIDI ALUMINIUM FABRICATOR LTD. Units 6-8, Sunny Industrial Centre, 1/F 8-11, Cheong Chee Yee Road, Kwun Tong Tel: 2482111-4 Fax: (852) 2727666		
S 银同有限公司 Silver Town Limited Tel: 0769-8335488 Fax: 0769-8335954 E-MAIL: ADDRESS@silvertown.hk		
DRAWING TITLE : [3HL-38]		
CAD File Name :		
Designed by		
Drawn by		
Reviewed by		
Approved by		
Scale		
DWG NO. (WWW)-2 - [3HL-38]	REV.	0

2, 加M5牙孔, 加角码。

合计:	40.32
-----	-------




DWG NO.: (WW4)-2 - [3HL-39]

修改说明:
1, 取消M5牙孔,并切为47高U槽。

构件编号: 3HL-40		构件数量: 1	构件重量: 24.24	
零件编号	规格(mm)	数量	单重(kg)	共重(kg)
M268	RHS120*80*6.3	1	24.24	24.24
合计:			24.24	
			表面刮油	0.51




构件: 3HL-40

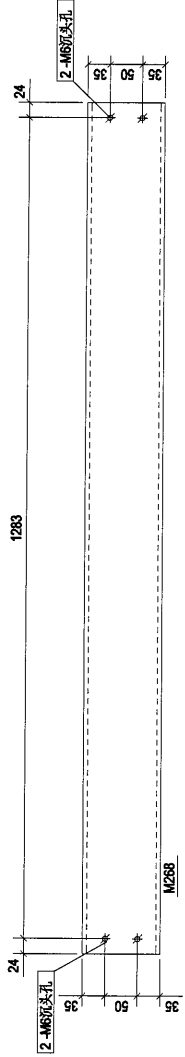


A - A

A	第2次设计	2018-11-05
Rev.	Description	Date
PROJECT: PROPOSED SITE C1 DEVELOPMENT AT AREA B6, TXOTIL TO RP TSEUNG KWAN O, NEW TERRITORIES		
CLIENT: 美特铝业有限公司 MIDI ALUMINIUM FABRICATOR LTD. Units 6-8, Sunny Industrial Centre, 1/F 510 Che Kwo Ling Road, Kwun Tong Tel: 2348211-4 Fax: (852) 2727566		
S 银同有限公司 Silver Town Limited Tel: 0769-83354988 Fax: 0769-83358954 E-MAIL: ADDRESS: silvertown@163.com		
DRAWING TITLE: [3HL-40]		
CAD File Name:		
Designed by		
Drawn by		
Reviewed by		
Approved by		
Scale		
DWG NO: (WW4)-2 - [3HL-40]		REV. A


构件编号:	3HL-41	构件数量:	1	构件重量:	33.28
零件编号	厚度(mm)	长度(mm)	数量	重量(kg)	重量(kg)
M269	RHS120*80*3	1724	1	31.40	0.66
M466	RSA75*50*5	100	4	0.47	1.88
					0.03
合计:					33.28

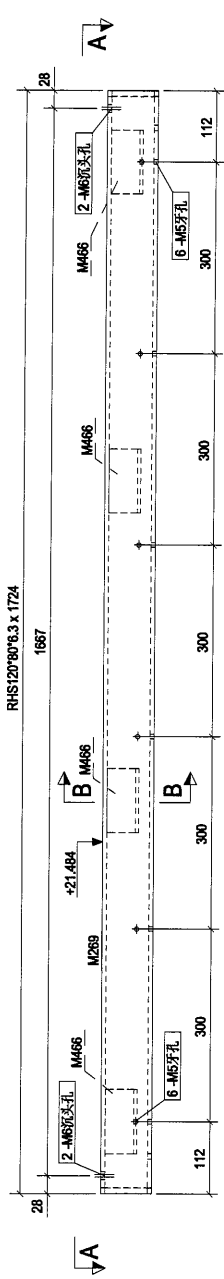

构件: 3HL-41

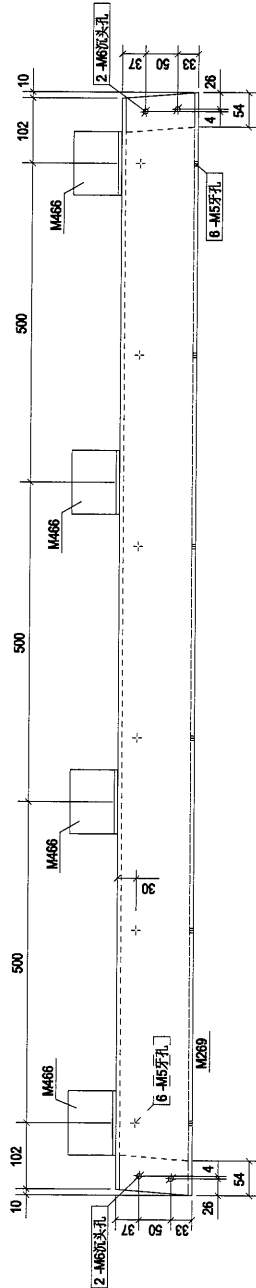


A - A

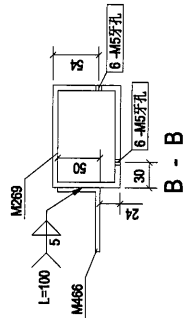


0	第1次报批	2018-07-04
Rev.	Description	Date
PROJECT: PROPOSED SITE C1 DEVELOPMENT AT AREA B6, TKOTL 70 RP TSEUNG KWAN O, NEW TERRITORIES		
CLIENT: 美特铝贸有限公司 MIDI ALUMINIUM FABRICATOR LTD. Units 6-8, Sunny Industrial Centre, 1/F 510 Chung Yee Ling Road, Kwai Chung Tel: 23482111-4 Fax: (852) 27271666		
S 银同有限公司 Silver Town Limited Tel: 2769-8335/888 Fax: 2769-8335/854 E-MAIL: ADDRESS@silvertown.hk		
DRAWING TITLE : [3HL-41]		
CAD File Name :		
Designed by		
Drawn by		
Reviewed by		
Approved by		
Scale		
DWG NO: (WW4)-2 - [3HL-41]		REV. 0


材料编号: 3HL-42		材料数量: 1		材料重量: 33.78	
零件编号	规格(mm)	数量	重量(kg)	长度(m)	重量(kg)
M270	RHS120*80*3	1	31.90	31.90	0.67
M466	RSA75*50*5	4	0.47	1.88	0.03
合计:				33.78	

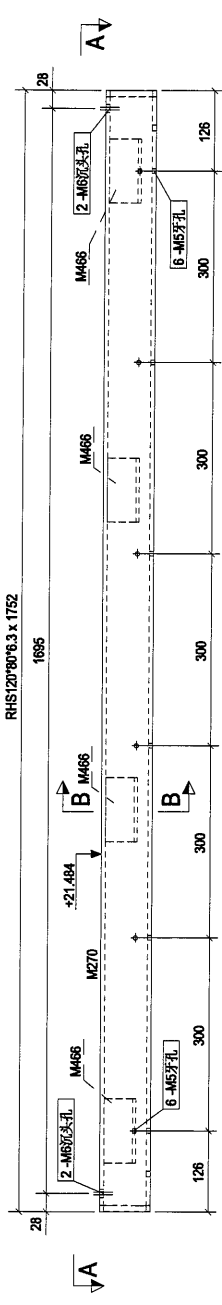

构件: 3HL-42

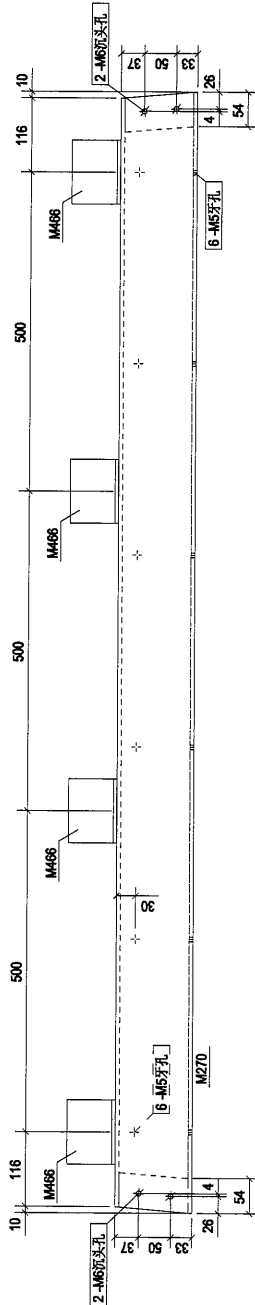


A - A

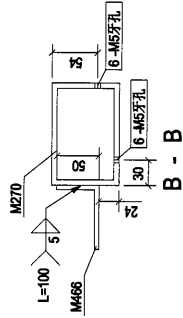



0	第1次报批	2018-07-04
Rev.	Description	Date
PROJECT: PROPOSED SITE C1 DEVELOPMENT AT AREA B6, TKOTIL 70 RD, TSEUNG KWAN O, NEW TERRITORIES		
CLIENT: 美特铝质有限公司 MIDI ALUMINIUM FABRICATOR LTD. Units 6-8, Sunny Industrial Centre, 1/F 181A, Shek Kwo Ling Road, Kwunboon Tel: 2348211-4 Fax: (852) 2727666		
S 银同有限公司 Silver Town Limited Tel: 0769-83354888 Fax: 0769-83359554 E-MAIL: ADDRESS@silvertown.hk		
DRAWING TITLE : [3HL-42]		
CAD File Name :		
Designed by		
Drawn by		
Reviewed by		
Approved by		
Scale		
DWG NO. (WW4)-2 - [3HL-42]	REV.	0

修改说明:
1, 去牙孔, 开避位。

构件编号:	3HL-43	构件数量:	1	构件重量:	31.90
部件编号	规格(mm)	数量	单重(kg)	共重(kg)	表面积(m ²)
M271	RHS120*80*6.3	1752	31.90	31.90	0.67
合计:					31.90

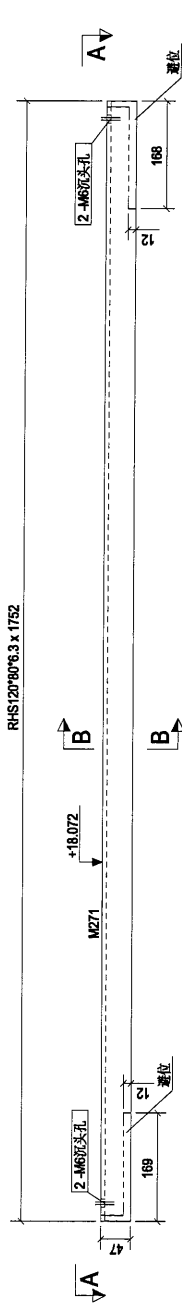

构件: 3HL-43

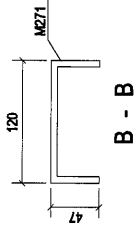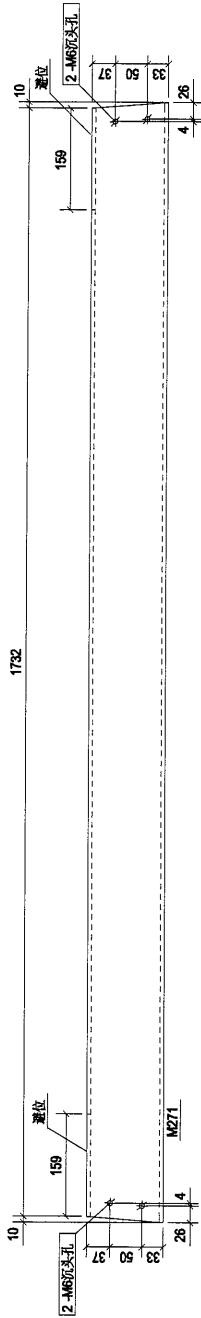


A	第2次报批	2018-11-05
Rev.	Description	Date
PROJECT:		
PROPOSED SITE C1 DEVELOPMENT AT AREA 88, TKOTL 70 RP, TSEUNG KWAN O, NEW TERRITORIES		
CLIENT:		
美特铝质有限公司 MIDI ALUMINIUM FABRICATOR LTD. Units 6-8, Sunny Industrial Centre, 1/F 510 Chee Kwo Ling Road, Kwunboon Tel: 2346211-4 Fax: (852) 27271666		
S 银同有限公司 Silver Town Limited Tel: 0769-83354888 Fax: 0769-83359554 E-MAIL: ADDRESS@silvertown.com.hk		
DRAWING TITLE :		
[3HL-43]		
CAD File Name :		
Designed by		
Drawn by		
Reviewed by		
Approved by		
Scale		
DWG NO: (WW4)-2 - [3HL-43]		REV. A


修改说明:
1, 去牙孔, 开避位。

构件编号:	3HL-44	构件数量:	1	构件重量:	31.40
零件编号	规格(mm)	数量	单重(kg)	共重(kg)	表面积(m ²)
M272	RHS120*80*6.3	1724	31.40	31.40	0.66

合计: 31.40

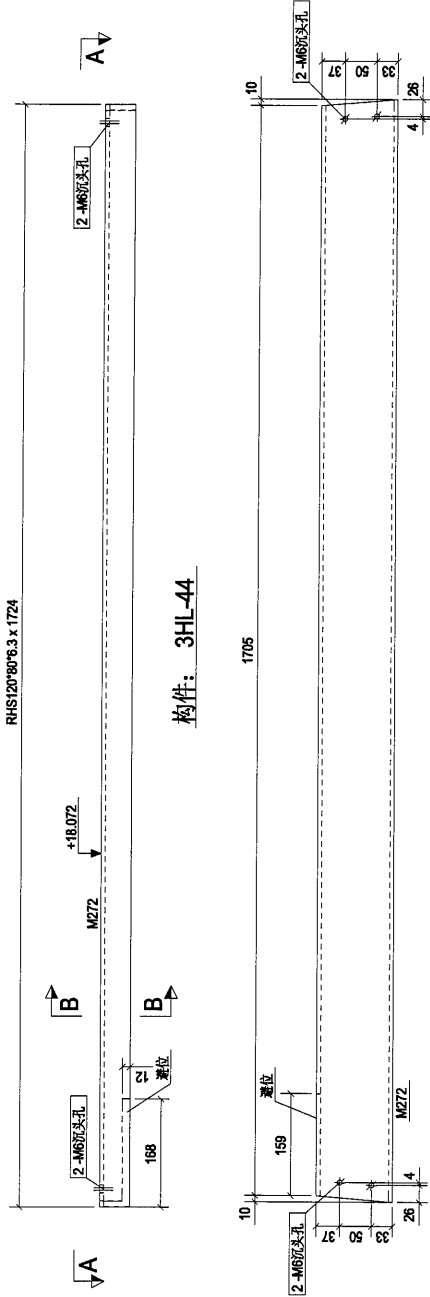


A - A

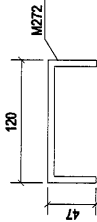

A	第2次报批	2018-11-05
Rev.	Description	Date
PROJECT: PROPOSED SITE C1 DEVELOPMENT AT AREA B6, TKOIL 70 RD, TSEUNG KWAN O, NEW TERRITORIES		
CLIENT:  美特铝质有限公司 MTDI ALUMINIUM FABRICATOR LTD. Units E & F, Sunny Industrial Centre, 1/F 610 Cheong Cheong Street, Hong Kong Tel: 23489211-4 Fax: (852) 27216565		
 银同有限公司 Silver Town Limited Tel: 2769-8335/888 Fax: 2768-8335/854 E-MAIL: ADMIN@silvertown.hk		
DRAWING TITLE : [3HL-44]		
CAD File Name :		
Designed by		
Drawn by		
Reviewed by		
Approved by		
Scale		
DWG NO.: (WW4)-2 - [3HL-44]		REV. A

修改说明:
1, 去牙孔.

构件编号: 3HL-45		构件数量: 1		构件重量: 31.53	
部件编号	规格(mm)	数量	单重(kg)	共重(kg)	表面积(m²)
M273	RHS120*80*6.3	1	31.53	31.53	0.66
合计:					31.53

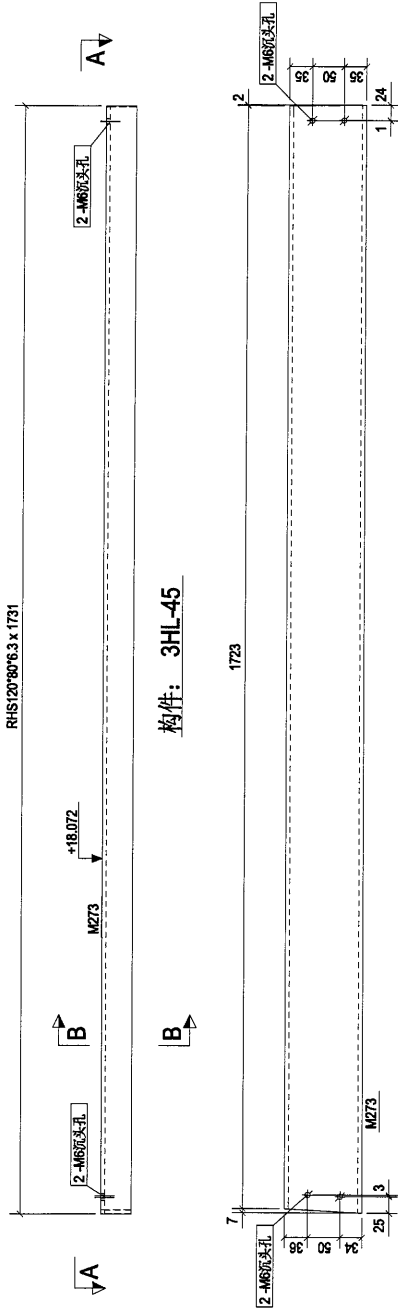


A - A


B - B

A	第2次提批	2018-11-05
Rev.	Description	Date
PROJECT: PROPOSED SITE C1 DEVELOPMENT AT AREA B6, TKOTIL TO RP, TSEUNG KWAN O, NEW TERRITORIES		
CLIENT: 美特鋁質有限公司 MIDI ALUMINIUM FABRICATOR LTD. Units 6-8, Sunny Industrial Centre, 1/F 88 Tai Wo Ling Road, Tseung Kwan O, New Territories Tel: 2348211-4 Fax: (852) 2727666		
S 銀同有限公司 Silver Town Limited Tel: 2769-8335/888 Fax: 2769-8335/854 E-MAIL: ADDRESS@silvertown.hk		
DRAWING TITLE : [3HL-45]		
CAD File Name :		
Designed by		
Drawn by		
Reviewed by		
Approved by		
Scale		
DWG NO.: (WW4)-2 - [3HL-45]		REV. A

构件编号:		3HL-47	构件数量:		1	构件重量:		33.19
构件编号	规格(mm)		长度(mm)	数量	单重(kg)	重量(kg)	长度(m)	
M294	PL550		1400	1	2.96	2.96	0.17	
M428	RHS150*75*6.0		1400	1	30.23	30.23	0.27	
合计:							33.19	

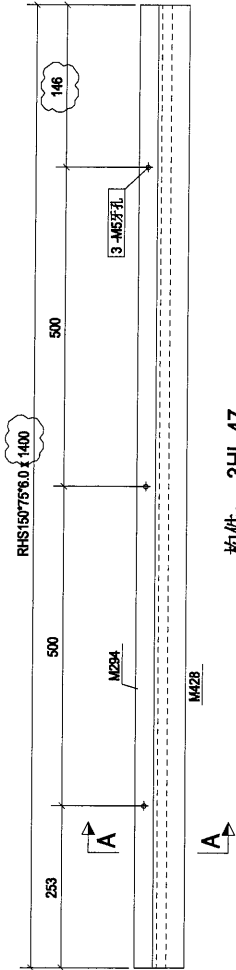


构件: 3HL-47

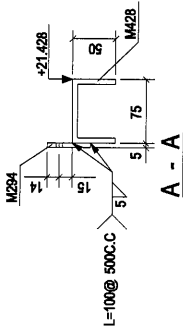


A	第2次报批	2018-08-22
Rev.	Description	Date
PROJECT: PROPOSED SITE C1 DEVELOPMENT AT AREA B6, TKOTIL 70 RP, TSEUNG KWAN O, NEW TERRITORIES		
CLIENT: 美特铝质有限公司 MIDI ALUMINIUM FABRICATOR LTD. Units 6-8, Sunny Industrial Centre, 1/F 610 Chee Kwo Ling Road, Kwailoon Tel: 23469211-4 Fax: (852) 27277666		
S 银同有限公司 Silver Town Limited Tel: 0769-83354988 Fax: 0769-83359954 E-MAIL: ADDRESS@silvertown.hk		
DRAWING TITLE : [3HL-47]		
CAD File Name :		
Designed by		
Drawn by		
Reviewed by		
Approved by		
Scale		
DWG NO: (WW4)-2 - [3HL-47]		REV. A

构件编号:	3HL-49	构件数量:	1	构件重量:	27.97
零件编号	规格(mm)	数量	重量(kg)	共重(kg)	漆量(kg)
M296	PL5F50	1	2.49	2.49	0.14
M433	RHS150*75*6.0	1	25.48	25.48	0.22
合计:					27.97

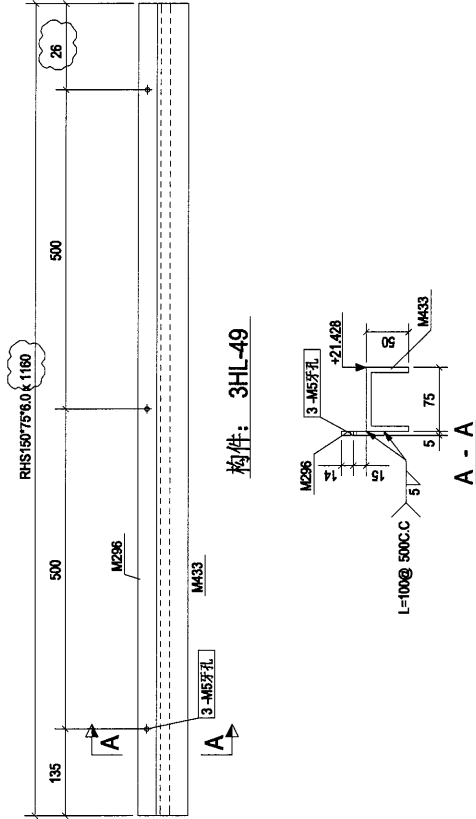


A	第2次通批	2018-08-22
Rev.	Description	Date
PROJECT: PROPOSED SITE C1 DEVELOPMENT AT AREA B8, TKOIL 70 RP, TSEUNG KWAN O, NEW TERRITORIES		
CLIENT:  美特铝质有限公司 MIDI ALUMINIUM FABRICATOR LTD. Units 5 & 6, Sunny Industrial Centre, 1/F 610, Cheong Cheong Street, Kwun Tong Tel: 23489211-4, Fax: (852) 2727666		
 银同有限公司 Silver Town Limited Tel: 0769-83051988 Fax: 0769-8305954 E-MAIL: ADDRESS@silvertown.hk		
DRAWING TITLE : [3HL-49]		
CAD File Name :		
Designed by		
Drawn by		
Reviewed by		
Approved by		
Scale		
DWG NO: (MW4)-2 - [3HL-49]		REV.
		A

零件编号:		3HL-50	零件数量:		1	零件重量:		30.80
规格(mm)		长度(mm)	重量		单重(kg)	共重(kg)		涂覆前(μl)
M297	PL5F50	1290	1	2.74	2.74	2.74	0.15	
M438	RHS150756.0	1290	1	28.06	28.06	28.06	0.25	
合计:								30.80

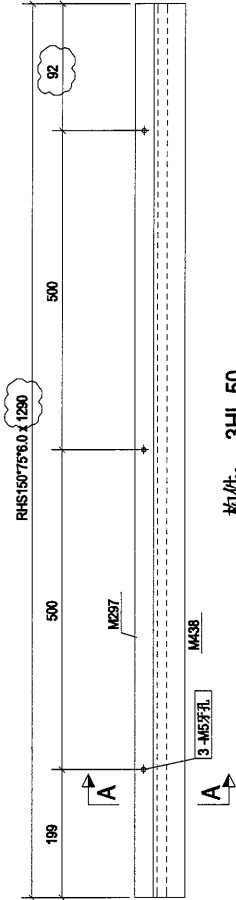


构件: 3HL-50

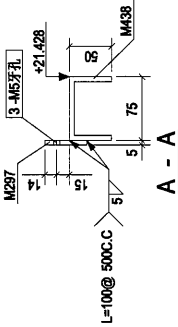

A	第2次派批	2018-08-22
Rev.	Description	Date
PROJECT: PROPOSED SITE C1 DEVELOPMENT AT AREA B8, TKO TL 70 RP, TSEUNG KWAN O, NEW TERRITORIES		
CLIENT: 美特鋁質有限公司 MIDALUMINUM TOWN LIMITED Units 5-8, Sunny Industrial Centre, 610 Chin Kwo Ling Road, Kowloon Tel: 23483211-4, Fax: (852) 27272665		
S 银同有限公司 Silver Town Limited Tel: 3789 4338, Fax: 3789 4339 E-MAIL: ADDRESS@silvertown.hk		
DRAWING TITLE : [3HL-50]		
CAD File Name :		
Designed by		
Drawn by		
Reviewed by		
Approved by		
Scale		
DWG NO: (MMW)2 - [3HL-50]		REV. A

料号编号:	3HL-51	结构数量:	1	附件重量:	28.82
零件编号	规格(mm)	数量	长度(mm)	重量(kg)	注量(mm)
M298	PL5-50	1	2.55	2.55	0.14
M446	RHS150*75*0	1	1177	26.07	0.23
合计:					28.82

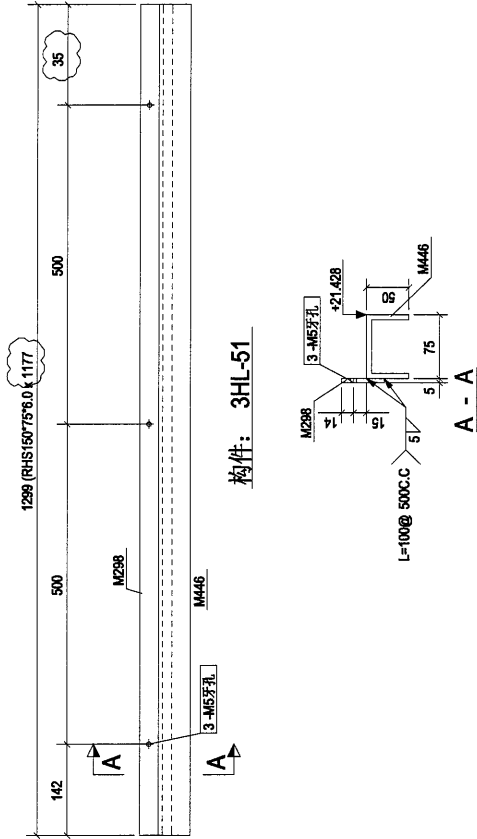


构件: 3HL-51


A	第2次提批	2018-08-22
Rev.	Description	Date
PROJECT: PROPOSED SITE C1 DEVELOPMENT AT AREA B8, TKOIL 70 RP, TSEUNG KWAN O, NEW TERRITORIES		
CLIENT:  美特铝质有限公司 MIDI ALUMINIUM FABRICATOR LTD. Units 5 & 6, Sunny Industrial Centre, 1/F 610 Chee Koon Street, Tseung Kwan O, New Territories Tel: 23489211-4, Fax: (852) 2727666		
 银同有限公司 Silver Town Limited Tel: 0769-8335988 Fax: 0769-8335954 E-Mail: ADDRESS@silvertown.hk		
DRAWING TITLE : [3HL-51]		
CAD File Name :		
Designed by		
Drawn by		
Reviewed by		
Approved by		
Scale		
DWG NO: (MW4)-2 - [3HL-51]		REV.
		A

构件编号:		3HL-52	构件数量:		1	构件重量:		14.78
材料编号		规格(mm)	数量		重量(kg)	共重(kg)		净重(kg)
M300		PL5F50	559		1.32	1.32		0.07
M445		RHS150756.0	559		13.47	13.47		0.12

合计: 14.78

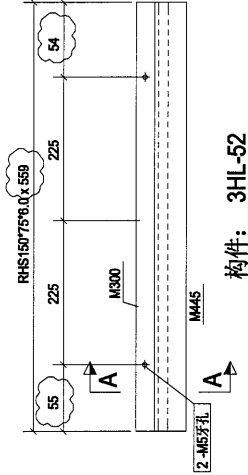


构件: 3HL-52

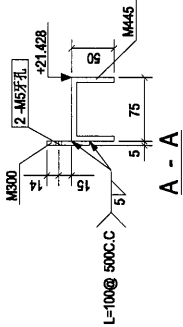

A	第2次报批	2018-08-22
Rev.	Description	Date
PROJECT: PROPOSED SITE C1 DEVELOPMENT AT AREA B8, TKOTL 70 RP, TSEUNG KWAN O, NEW TERRITORIES		
CLIENT: 美特铝质有限公司 MIDI Units 5-8, Sunny Industrial Centre, 610 Chin Kwo Ling Road, Kowloon Tel:23483211-4 Fax:(852)27272666		
S 银同有限公司 Silver Town Limited Tel:23483211-4 Fax:(852)27272666 E-MAIL: ADDRESS@silvertown.com.hk		
DRAWING TITLE : [3HL-52]		
CAD File Name :		
Designed by		
Drawn by		
Reviewed by		
Approved by		
Scale		
DWG NO: (NMW4)-2 - [3HL-52]		REV. A

修改说明:
1, 数量减+1.

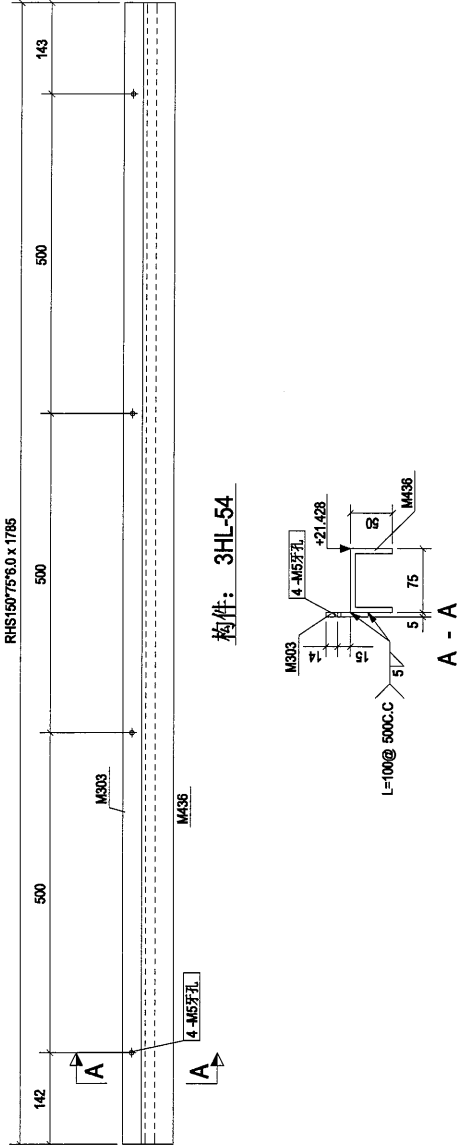


构件编号: 3HL-54		构件数量: 12		构件重量: 39.32	
部件编号	规格(mm)	数量	单重(kg)	共重(kg)	表面积(m²)
M303	PL5*50	1	3.50	3.50	0.20
M436	RHS150*75*6.0	1	35.82	35.82	0.32
		合计:		39.32	


B	第3次报批	2018-11-09
Rev.	Description	Date
PROJECT: PROPOSED SITE C1 DEVELOPMENT AT AREA B8, TKOIL 70 RP, TSEUNG KWAN O, NEW TERRITORIES		
CLIENT:  美特铝质有限公司 MIDI Aluminium Co., Ltd. Units 6-8, Sunny Industrial Centre, 1/F 610 Chin Kwo Ling Road, Kowloon Tel: 23489211-4, Fax: (852) 2727665		
 银同有限公司 Silver Town Limited Tel: 2789 4338, Fax: 2789 4339 E-MAIL: ADDRESS@silvertown.com		
DRAWING TITLE : [3HL-54]		
CAD File Name :		
Designed by		
Drawn by		
Reviewed by		
Approved by		
Scale		
DWG NO: (MM4)-2 - [3HL-54]		REV. B

料件编号:	3HL-56	料件重量:	3	料件重量:	39.24
料件编号:	规格(mm)	数量	重量(kg)	共重量	注量(km)
M305	PL550	1	3.50	3.50	0.20
M385	RHS150*75*0	1	35.74	35.74	0.31

合计: 39.24

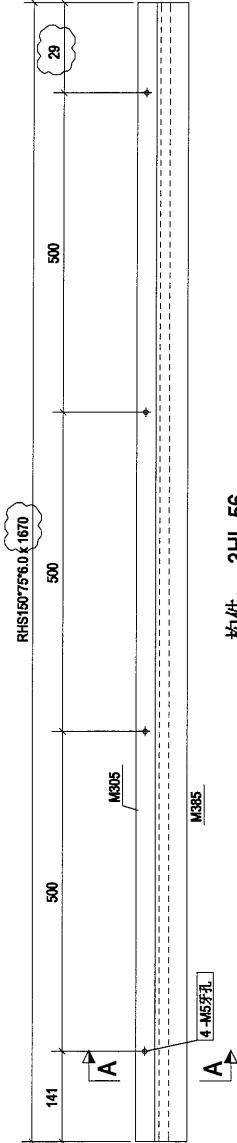


构件: 3HL-56

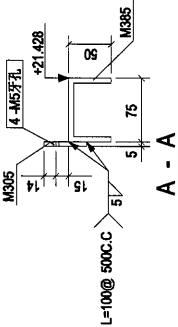


A	第2次报批	2018-08-22
Rev.	Description	Date
PROJECT:		
PROPOSED SITE C1 DEVELOPMENT AT AREA B8, TKOIL 70 RP, TSEUNG KWAN O, NEW TERRITORIES		
CLIENT:		
美特鋁質有限公司 MIDI Units 6-8, Sunny Industrial Centre, 1/F 610 Chee Kwo Ling Road, Kwai Tsing Tel: 23489211-4 Fax: (852) 27272666		
S 银同有限公司 Silver Town Limited Tel: 3789 4338 Fax: 3789 4339 E-MAIL: ADDRESS@silvertown.hk		
DRAWING TITLE :		
[3HL-56]		
CAD File Name :		
Designed by		
Drawn by		
Reviewed by		
Approved by		
Scale		
DWG NO: (MM4)-2 - [3HL-56]		REV.
		A

构件编号:	3HL-58	构件数量:	1	构件重量:	45.74
零件编号	规格(mm)	数量	重量(kg)	长度(m)	重量(kg)
M311	PL550	1	4.08	4.08	0.23
M426	RHS150*75*3.0	1	41.66	41.66	0.37
合计:					45.74

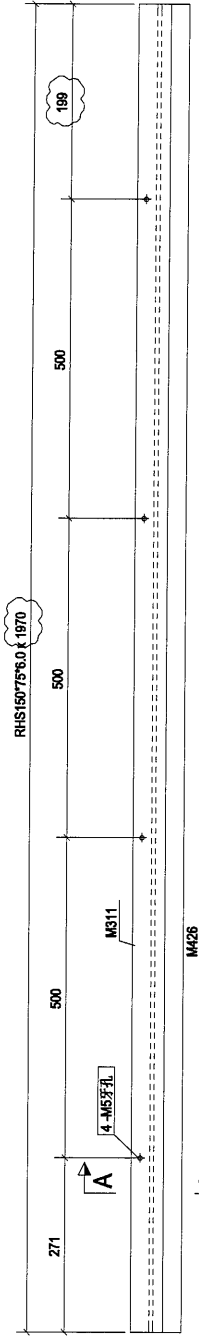


构件: 3HL-58

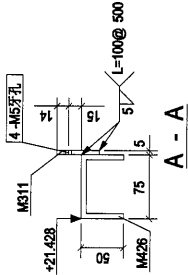


A	第2次报批	2018-08-22
Rev.	Description	Date
PROJECT:		
PROPOSED SITE C1 DEVELOPMENT AT AREA 88, TKOTL 70 RP, TSEUNG KWAN O, NEW TERRITORIES		
CLIENT:		
美特铝质有限公司 MIDI ALUMINIUM FABRICATOR LTD. Units 6-8, Sunny Industrial Centre, 1/F 610 Che Kwo Ling Road, Kwloon Tel: 22469211-4 Fax: (852) 2727666		
S 银同有限公司 Silver Town Limited Tel: 0769-83354988 Fax: 0769-83359554 E-MAIL: ADDRESS@silvertown.hk		
DRAWING TITLE :		
[3HL-58]		
CAD File Name :		
Designed by		
Drawn by		
Reviewed by		
Approved by		
Scale		
DWG NO: (WW4)-2 - [3HL-58]		
REV. A		

构件编号:	3HL-59	构件数量:	2	构件重量:	45.05
编号	长度(mm)	数量	重量(kg)	共重(kg)	按量(m)
M312	1930	1	4.01	4.01	0.23
M427	1930	1	41.04	41.04	0.36
合计:					45.05

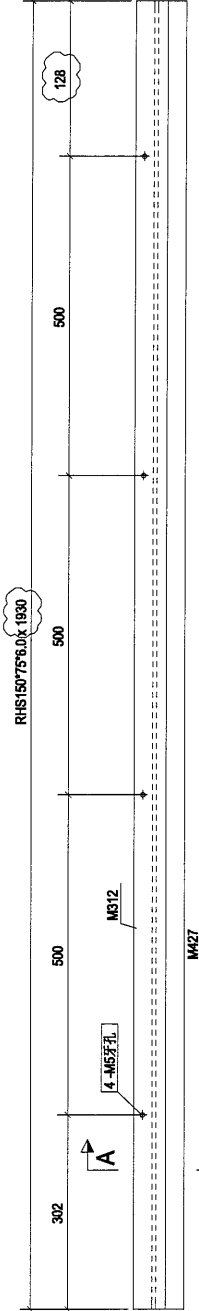


构件: 3HL-59

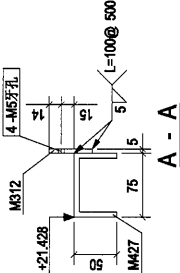


A	第2次提批	2018-08-22
Rev.	Description	Date
PROJECT:		
PROPOSED SITE C1 DEVELOPMENT AT AREA B8, TKOIL 70 RP, TSEUNG KWAN O, NEW TERRITORIES		
CLIENT:		
美特鋁質有限公司 MTI ALUMINIUM FABRICATING LTD. Units 5-8, Sunny Industrial Centre, 1/F 610, Cheong Cheong Street, Kwun Tong Tel: 23489211-4, Fax: (852) 7272666		
S 銀同有限公司 Silver Town Limited Tel: 0769-4335988 Fax: 0769-4335954 E-MAIL: ADDRESS@SILVERTOWN.LICOM		
DRAWING TITLE :		
[3HL-59]		
CAD File Name :		
Designed by		
Drawn by		
Reviewed by		
Approved by		
Scale		
DWG NO: (WW4)-2 - [3HL-59]		REV
		A

构件编号:		3HL-60	构件数量:		1	构件重量:		45.75
构件编号	规格(mm)	重量(kg)	数量	长度(mm)	重量(kg)	共重(kg)	共重(kg)	接重(kg)
M313	PL5F50	4.08	1	1970	4.08	4.08	0.23	0.23
M426	RHS150*75*6.0	41.67	1	1970	41.67	41.67	0.37	0.37

合计: 45.75

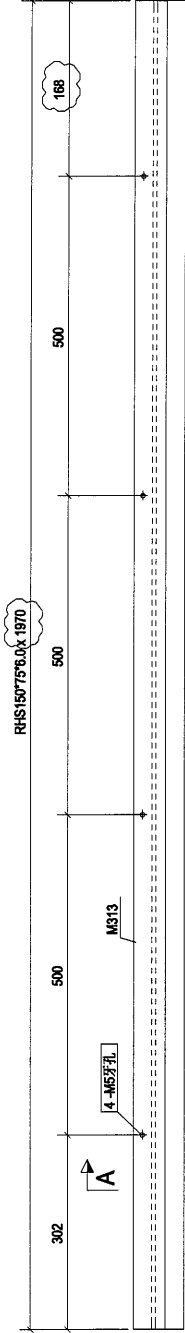


构件: 3HL-60

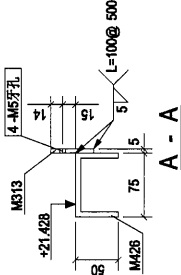


A	第2次报批	2018-08-22
Rev.	Description	Date
PROJECT: PROPOSED SITE C1 DEVELOPMENT AT AREA 88, TKOTL 70 RP, TSEUNG KWAN O, NEW TERRITORIES		
CLIENT:  美特铝质有限公司 MIDT ALUMINIUM FABRICATOR LTD. Units 5-8, Silver Town Industrial Centre, 7/F 610 Chee Kwo Jung Road, Kwun Tong Tel: 23489211-4, Fax: (852) 2727665		
S 银同有限公司 Silver Town Limited Tel: 0753-5324588 Fax: 0753-5325584 E-MAIL: ADDRESS@silvertown.com		
DRAWING TITLE : [3HL-60]		
CAD File Name :		
Designed by		
Drawn by		
Reviewed by		
Approved by		
Scale		
DWG NO: (WW4)-2 - [3HL-60]		REV. A

构件编号:		3HL-61	构件数量:		2	构件重量:		45.06
详细编号		规格(mm)	长度(mm)	数量	单重(kg)	重量(kg)	共重(kg)	漆重(kg)
M314		PL5F50	1930	1	4.01	4.01	4.01	0.23
M427		RHS150*75*6.0	1930	1	41.04	41.04	41.04	0.36
合计:								45.06

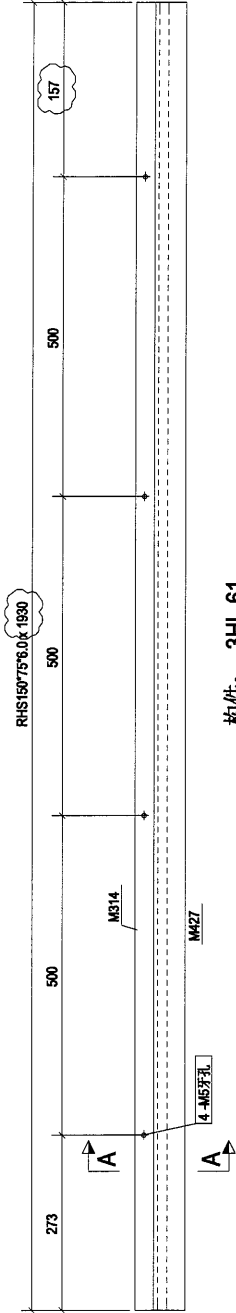


构件: 3HL-61

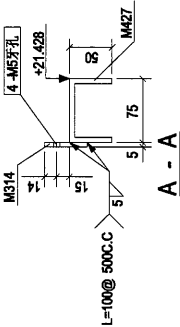


A	第2次报批	2018-08-22
Rev.	Description	Date
PROJECT:		
PROPOSED SITE C1 DEVELOPMENT AT AREA B8, TKOIL 70 RP, TSEUNG KWAN O, NEW TERRITORIES		
CLIENT:		
美特铝质有限公司 MIDI UNIT 6-8 Sunny Industrial Centre 7/F 610 Chin Kuo Ling Road, Kwai Tsing Tel: 23489211-4 Fax: (852) 27272665		
S 银同有限公司 Silver Town Limited Tel: 0759 4334588 Fax: 0759 4334584 E-MAIL: ADDRESS@silvertown.hk		
DRAWING TITLE :		
[3HL-61]		
CAD File Name :		
Designed by		
Drawn by		
Reviewed by		
Approved by		
Scale		
DWG NO: (MM4)-2 - [3HL-61]		REV.
		A

构件编号:	3HL-64	构件数量:	1	构件重量:	39.37
规格(mm)	规格(mm)	重量	重量(kg)	共重(kg)	共重(kg)
M317	PL5*50	1	3.51	3.51	0.20
M434	RHS150*75*6.0	1	35.86	35.86	0.32
合计:					39.37

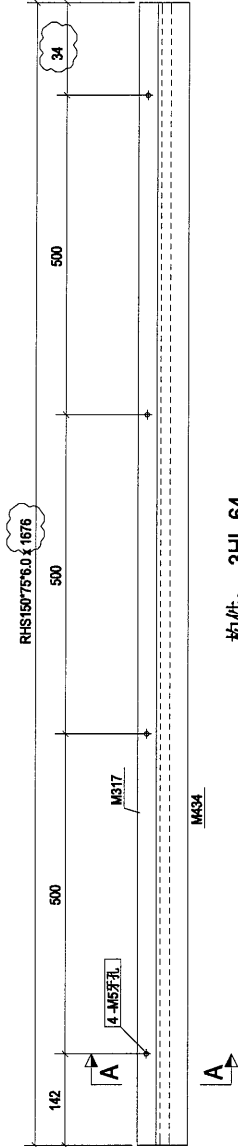


构件: 3HL-64

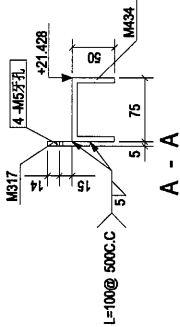


A	第2次报批	2018-08-22
Rev.	Description	Date
PROJECT:		
PROPOSED SITE C1 DEVELOPMENT AT AREA B8, TKOTL 70 RP, TSEUNG KWAN O, NEW TERRITORIES		
CLIENT:		
美特铝质有限公司 MIDI ALUMINIUM FABRICATOR LTD. Unit 5-8 Sunny Industrial Centre, 610 Che Kwo Ling Road, Kwun Tong, Tel: 23489211-4 Fax: (852) 2727666		
S 银同有限公司 Silver Town Limited Tel: (852) 33252986 Fax: (852) 33259584 E-MAIL: J008233@silvertown.com.hk		
DRAWING TITLE :		
[3HL-64]		
CAD File Name :		
Designed by		
Drawn by		
Reviewed by		
Approved by		
Scale		
DWG NO: (MM4)-2 - [3HL-64]		REV.
		A

料件编号:	3HL-66	料件数量:	3	料件重量:	39.15
料件编号	规格(mm)	数量	重量(kg)	共重(kg)	漆重(kg)
M319	PL5F50	1	3.49	3.49	0.20
M387	RHS15075*6.0	1	35.67	35.67	0.31

合计: 39.15

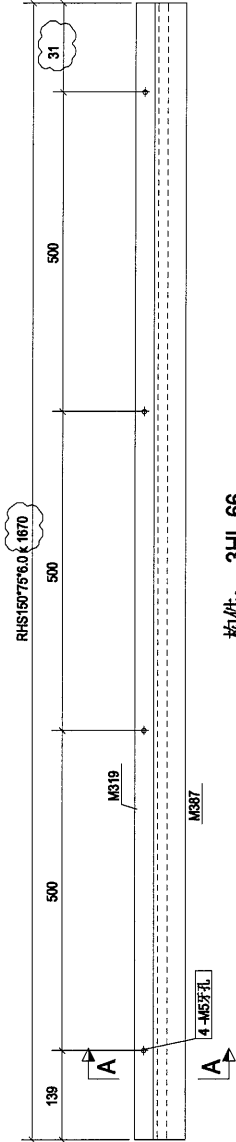


构件: 3HL-66

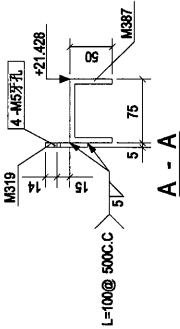

A	第2次提批	2018-08-22
Rev.	Description	Date
PROJECT:		
PROPOSED SITE C1 DEVELOPMENT AT AREA B8, TKOTL 70 RP, TSEUNG KWAN O, NEW TERRITORIES		
CLIENT:		
美特鋁質有限公司 MID ALUMINIUM FABRICATOR LTD. Units 6-8 Sunny Industrial Centre, 610 Chee Kwo Ling Road, Kowloon Tel:23483211-4 Fax:(852)2727666		
S 銀同有限公司 Silver Town Limited Tel:2786 15558 Fax:2786 15584 E-MAIL: info@silvertown.hk		
DRAWING TITLE :		
[3HL-66]		
CAD File Name :		
Designed by		
Drawn by		
Reviewed by		
Approved by		
Scale		
DWG NO: (MM4)2 - [3HL-66]		REV.
		A


构件编号:		3HL-67	构件数量:		1	构件重量:		38.65
零件编号	规格(mm)	数量	重量(kg)	共重(kg)	长度(mm)	共重(kg)	共重(kg)	净重(kg)
M321	PLF50	1	3.44	3.44	1670	0.19	0.19	0.19
M441	RHS150*75*6.0	1	35.21	35.21	1670	0.31	0.31	0.31
合计:								38.65

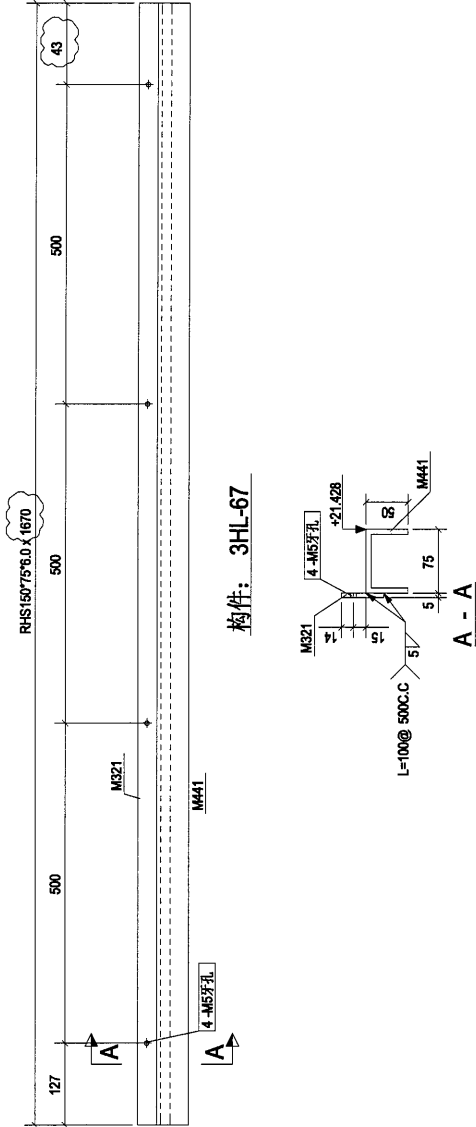


A	第2次修改	2018-08-22
Rev.	Description	Date
PROJECT:		
PROPOSED SITE C1 DEVELOPMENT AT AREA B8, TKOTIL 70 RP, TSEUNG KWAN O, NEW TERRITORIES		
CLIENT:		
美特鋁質有限公司 MIDI ALUMINIUM MANUFACTURE LTD. Unit 5-8 Sunny Industrial Centre, 510 Chee Kwoi Lang Road, Kwun Tong, Tel: 23469211-4 Fax: (852) 27272666		
S 銀同有限公司 Silver Town Limited Tel: 0769-8335498 Fax: 0769-8335954 E-MAIL: ADMIN@silvertown.hk		
DRAWING TITLE :		
[3HL-67]		
CAD File Name :		
Designed by		
Drawn by		
Reviewed by		
Approved by		
Scale		
DWG NO: (MM4)2 - [3HL-67]		REV.
		A

构件编号:	3HL-68	构件数量:	1	构件重量:	39.28
材料编号	规格(mm)	数量	重量(kg)	共重(kg)	注量(m³)
M322	PL5*50	1	3.50	3.50	0.20
M383	RHS150*75*6.0	1	35.78	35.78	0.31

合计: 39.28

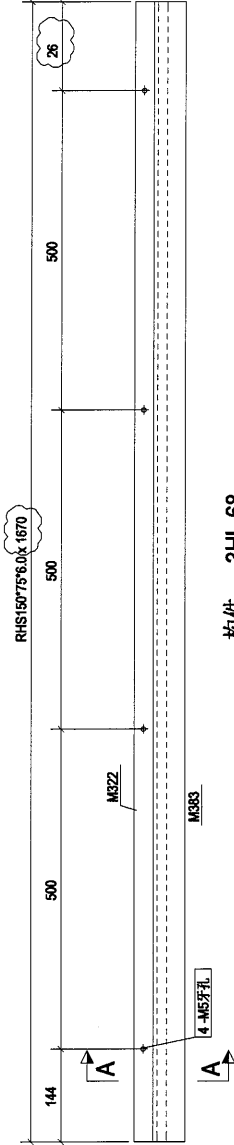


构件: 3HL-68

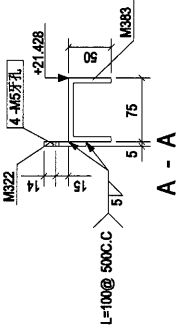


A	第2次报批	2018-08-22
Rev.	Description	Date
PROJECT: PROPOSED SITE C1 DEVELOPMENT AT AREA B8, TKOTL 70 RP, TSEUNG KWAN O, NEW TERRITORIES		
CLIENT: 美特铝质有限公司 MIDI Units 6-8, Sunny Industrial Centre, 1/F, 610 Che Kwo Ling Road, Kowloon Tel: 23489211-4 Fax: (852) 2723666		
S 银同有限公司 Silver Town Limited Tel: 3789-1188 Fax: 3789-1335 E-MAIL: ADDRESS@silvertown.hk		
DRAWING TITLE : [3HL-68]		
CAD File Name :		
Designed by		
Drawn by		
Reviewed by		
Approved by		
Scale		
DWG NO: (MM4)-2 - [3HL-68]		REV. A

修改说明:
1, 取消M340, 增加M5牙孔和M6觉头孔。


构件编号:	3HL-69	构件数量:	1	构件重量:	16.57
部件编号	规格(mm)	数量	单重(kg)	共重(kg)	表面积(m ²)
M371	SHS80*80*6.0	1	16.57	16.57	0.37
合计:					16.57

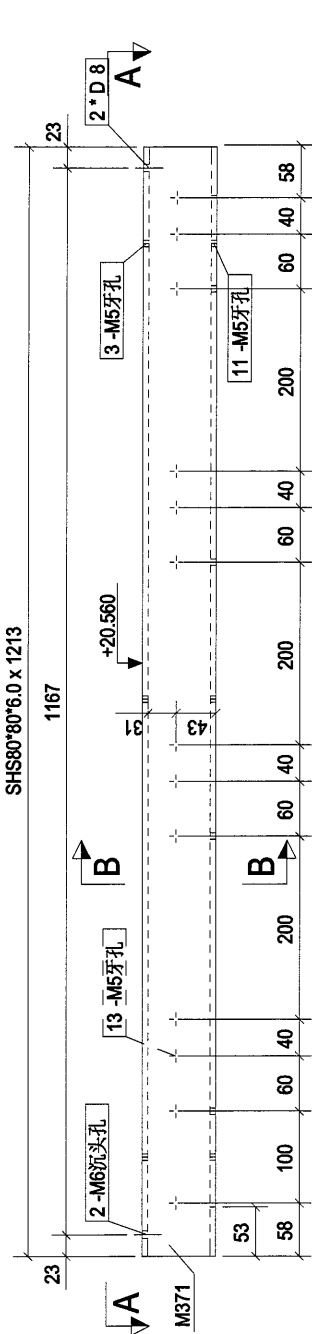

构件: 3HL-69

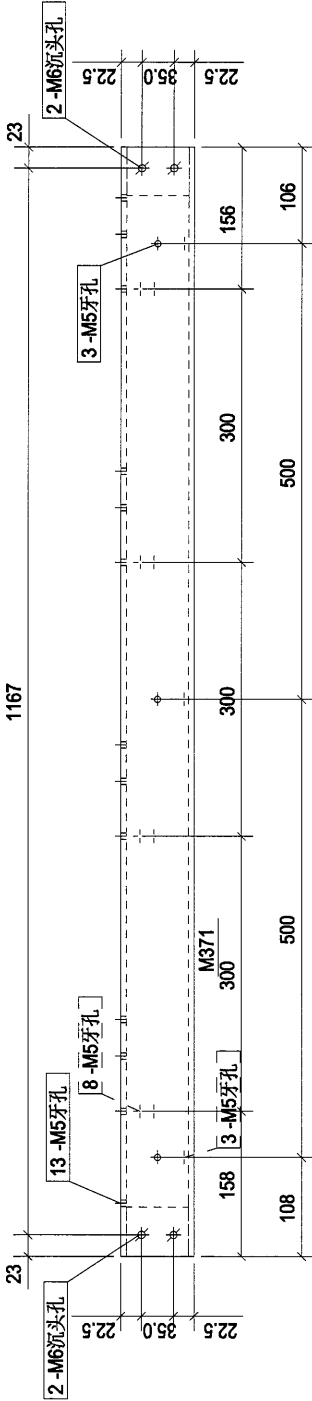

A - A

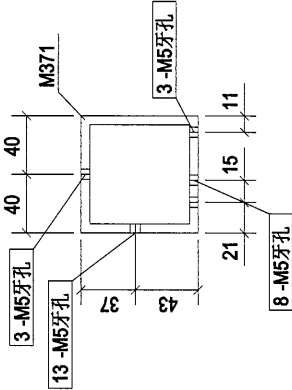


B - B

B	第3次提批	2018-11-05
Rev.	Description	Date
PROJECT:		
PROPOSED SITE C1 DEVELOPMENT AT AREA B6, TKOIL 70 RP, TSEUNG KWAN O, NEW TERRORIES		
CLIENT:		
美特铝质有限公司 MTDI ALUMINUM FABRICATOR LTD. Units 6-8, Sunny Industrial Centre, 1/F 610, Cheong Kwai Road, Tseung Kwan O, New Territories Tel: 23489211-4 Fax: (852) 2727666		
S 银同有限公司 Silver Town Limited Tel: 40769-8335988 Fax: 40769-8335954 E-Mail: Address@silvertown.hk		
DRAWING TITLE :		
[3HL-69]		
CAD File Name :		
Designed by		
Drawn by		
Reviewed by		
Approved by		
Scale		
DWG NO: (MMV4)-2 - [3HL-69]		
REV.		B

1, 增加M6沉头孔.

合计:	17.99
-----	-------

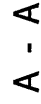PROJECT:

CLIENT:

MIDI ALUMINIUM FABRICATOR LTD.
Units 6-8, Sunray Industrial Centre, 1/F

Tel: 0769-83354968 Fax: 0769-83359954
E-MAIL ADDRESS: dqslk@vip.163.com

[3HL-.70]

Designed by

Reviewed by


Approved by	Scale
-------------	-------

W4)-2 - [3HL-.70]


REV. B

修改说明：
1，杆件加长100（做地盘预留）。

构件编号: 3HL-71		1		构件重量: 38.98	
部件编号	规格(mm)	数量	单重(kg)	共重(kg)	表面积(m²)
M556	PL5*50	1	3.47	3.47	0.20
M574	RHS150*75*6.0	1	35.51	35.51	0.31
合计:					38.98

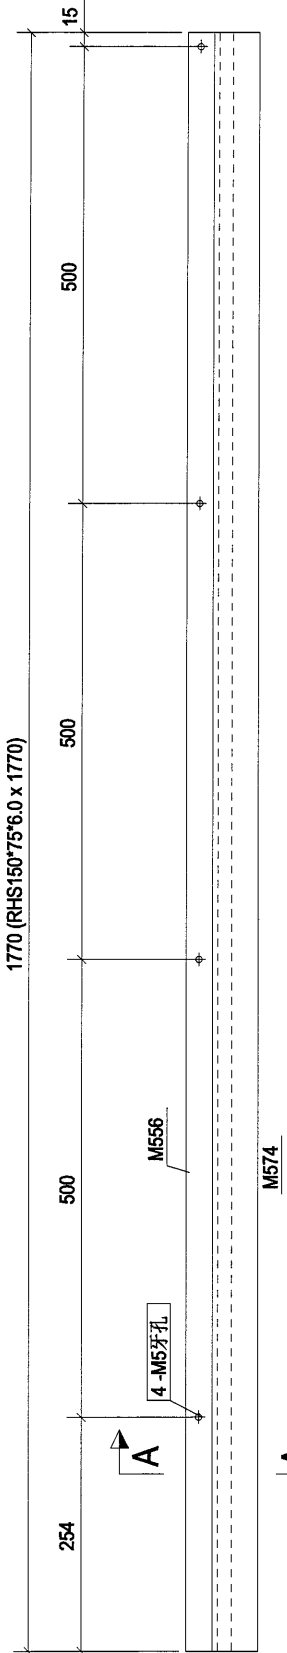

构件: 3HL-71

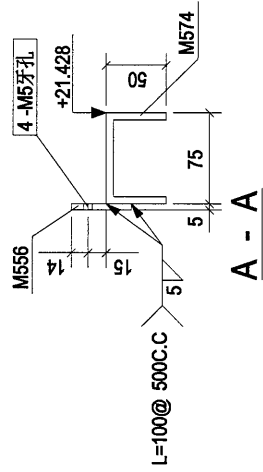

B	第3次报批	2018-11-10
Rev.	Description	Date
PROJECT: PROPOSED SITE C1 DEVELOPMENT AT AREA 88, TKOIL 70 RP, TSEUNG KWAN O, NEW TERRITORIES		
CLIENT: 美特铝质有限公司 MIDI Units 6-8, Sunny Industrial Centre, 1/F 610 Cha Kwo Ling Road, Kowloon Tel: 23489211-4 Fax: (852) 2722666		
S 银同有限公司 Silver Town Limited Tel: 0759-8336468 Fax: 0759-8336294 E-MAIL: ADDRESS@silvertown.hk		
DRAWING TITLE : [3HL-71]		
CAD File Name :		
Designed by		
Drawn by		
Reviewed by		
Approved by		
Scale		
DWG NO: (MM4)-2 - [3HL-71]		REV. B

- 1, 杆件加长100 (做地盘预留)。
- 2, M551取消, 做法改变。

合计:	36.13
-----	-------

**მ**
1
მPROJECT.

CLIENT:

MIDAL ALUMINIUM FABRICATOR LTD.
Units 6-8, Sunray Industrial Centre, 1/F
610 Cha Kwo Ling Road, Kowloon
Tel: 27489211-4 Fax: (852) 27727666

Tel: 0769-83354968 Fax: 0769-83359954
E-MAIL ADDRESS: dngstk@vip.163.COM

[3HL-.72]


Scale

REV.


修改说明:
1, 杆件加长100 (做地盘预留)。

构件编号: 3HL-73		构件数量: 1	构件重量: 34.25	
零件编号	规格(mm)	数量	单重(kg)	共重(kg)
M553	RHS120*80*6.3	1	34.25	34.25
合计:			34.25	
			表面积(m²)	0.72

RHS120*80*6.3 x 1881

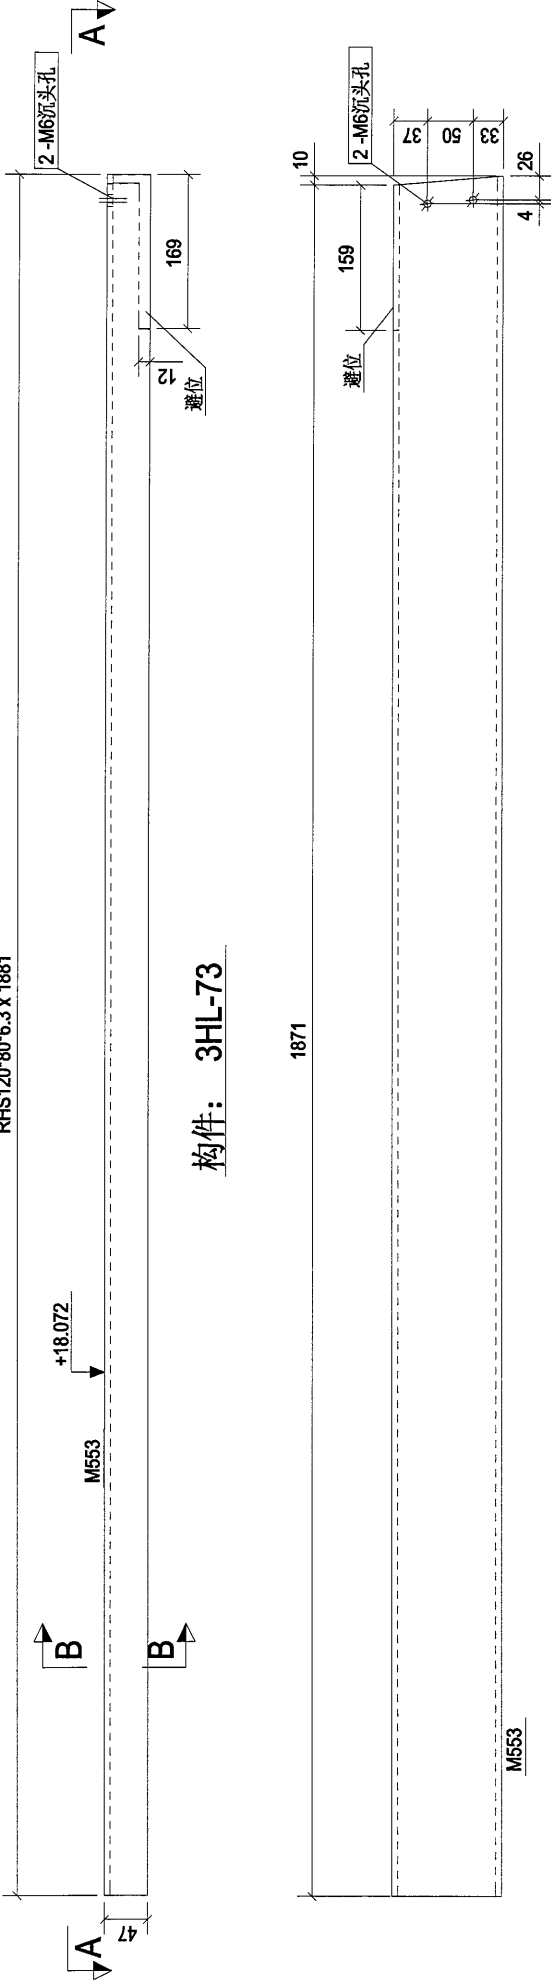


A - A

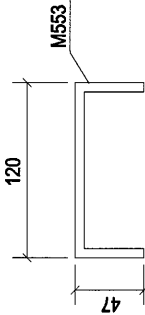

B - B

B	第3次报批	2018-11-10
Rev.	Description	Date
PROJECT: PROPOSED SITE C1 DEVELOPMENT AT AREA 08, TKOIL 70 RP, TSEUNG KWAN O, NEW TERRITORIES		
CLIENT: 美特铝质有限公司 MIDI Units 6-8, Sunny Industrial Centre, 1/F 610 Cha Kwo Ling Road, Kowloon Tel: 23489211-4 Fax: (852) 27272666		
DRAWING TITLE : [3HL-73]		
CAD File Name :		
Designed by		
Drawn by		
Reviewed by		
Approved by		
Scale		
DWG NO: (MM4)-2 - [3HL-73]		REV. B


构件编号:	3#L74	构件数量:	8	构件重量:		33.15
部件编号	规格(mm)	长度(mm)	数量	单重(kg)	共重(kg)	表面剥[㎡]
M466	RS475*50'5	100	4	0.47	1.88	0.03
M554	RHS120*80*6.3	1717	1	31.27	31.27	0.66
合计:					33.15	

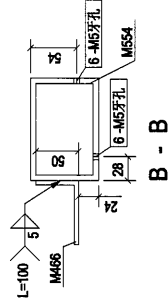


8
,
8

A	第2次报批	2018-11-09
Rev.	Description	Date
PROJECT: PROPOSED SITE C1 DEVELOPMENT AT AREA 08, TKOIT TO RP, TSUNG KUNAN O, NEW TERRITORIES		
CLIENT:	 美特铝质有限公司 MIDI ALUMINIUM INDUSTRIES LTD. Units 6-8, Suncoy Industrial Centre, 1/F 610 Cha Kwo Ling Road, Kowloon Tel: 23489211-4 Fax: (852) 27277666	
 S Silver Town Limited Tel: 0769-8354586 Fax: 0769-8355954 E-MAIL ADDRESS: sg@sttwp.com, ts@sttwp.com	3 [3HL-74]	
DRAWING TITLE :		
CADD File Name :		
Designed by		
Drawn by		
Reviewed by		
Approved by		
Scale		
DWG NO.:	(WW4)-2 - [3HL-74]	REV. A


构件编号:		3HL-75	构件数量:	1	构件重量:		33.15
零件编号	规格(mm)	长度(mm)	重量	单重(kg)	共重(kg)	共重(kg)	共重(kg)
M466	RHS75*50*5	100	4	0.47	1.88	0.03	0.03
M555	RHS120*80*6.3	1717	1	31.27	31.27	0.86	0.86
合计:							33.15

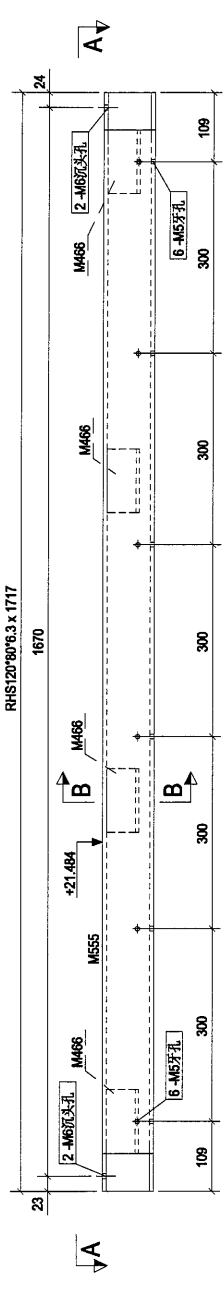

构件: 3HL-75

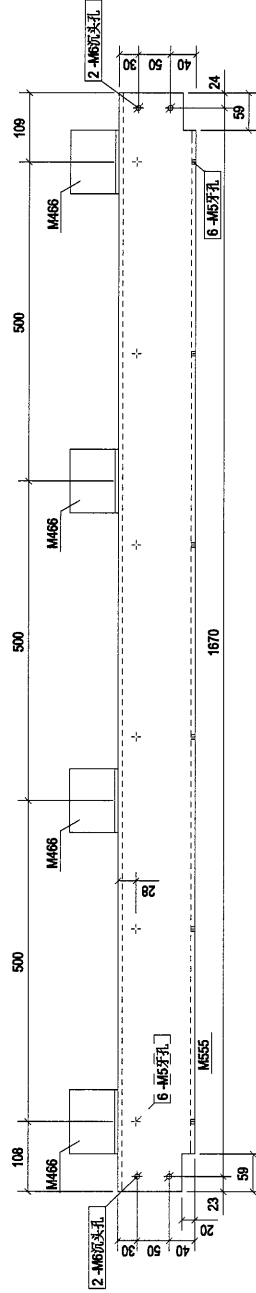

A - A

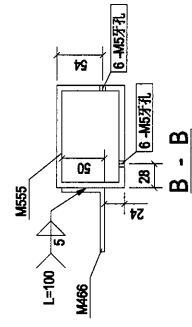


B - B


0	第1次提批	2018-07-04
Rev.	Description	Date
PROJECT:		
PROPOSED SITE C1 DEVELOPMENT AT AREA B8, TKOIL 70 RP, TSEUNG KWAN O, NEW TERRITORIES		
CLIENT:		
美特铝质有限公司 MIDI ALUMINIUM FABRICATOR LTD. Units 6-8, Sunny Industrial Centre, 1/F 61 Yuen Yee Ave, Lung Kwu Tan, Tseung Kwan O, New Territories Tel: 23489211-4 Fax: (852) 2727666		
S 银同有限公司 Silver Town Limited Tel: 0769-8335498 Fax: 0769-8335954 E-MAIL: ADDRESS@silvertown.hk		
DRAWING TITLE :		
[3HL-75]		
CAD File Name :		
Designed by		
Drawn by		
Reviewed by		
Approved by		
Scale		
DWG NO: (WVW4)-2 - [3HL-75]		REV.
		0

修改说明:
1, 取消M5牙孔,并切为47高U槽。

构件编号:	3HL-76	1	构件数量:	1	构件重量:	31.27
部件编号	规格(mm)	数量	单重(kg)	共重(kg)	表面面积(m ²)	
M582	RHS120*80*6.3	1	31.27	31.27	0.66	
合计:						31.27

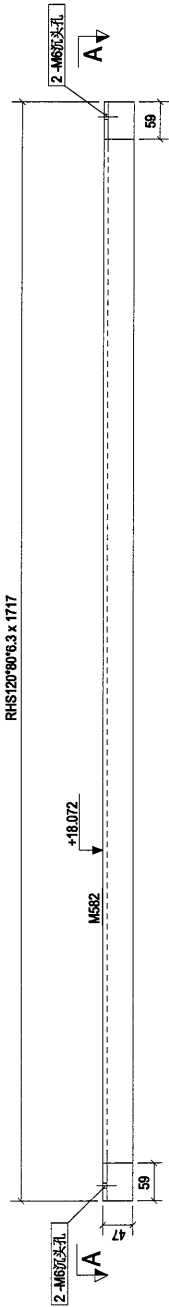


构件: 3HL-76

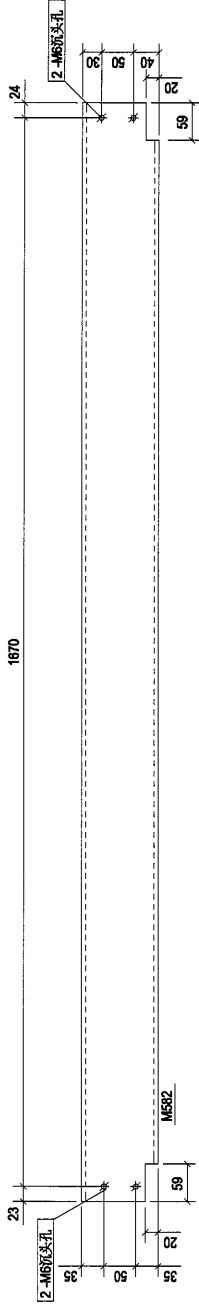


A	第2次提批	2018-11-05
Rev.	Description	Date
PROJECT:		
PROPOSED SITE C1 DEVELOPMENT AT AREA B8, TKOIL 70 RP, TSEUNG KWAN O, NEW TERRITORIES		
CLIENT:		
美特鋁質有限公司 MIDI ALUMINIUM FABRICATING LTD. Units 5-8, Sunny Industrial Centre, 1/F 610, Cheong Cheong Street, Kwun Tong Tel: 23469211-4, Fax: (852) 2727666		
S 銀同有限公司 Silver Town Limited Tel: 0769-83054988 Fax: 0769-8305954 E-Mail: ADMIN@silvertown.hk, S.T.COM		
DRAWING TITLE :		
[3HL-76]		
CAD File Name :		
Designed by		
Drawn by		
Reviewed by		
Approved by		
Scale		
DWG NO: (WWA)-2 - [3HL-76]		
REV		A

构件编号: 3HL-79		构件数量: 1		构件重量: 8.08	
部件编号	规格(mm)	数量	单重(kg)	共重(kg)	表面积(m ²)
M883	RHS120*80*6.3	444	8.08	8.08	0.17
合计: 8.08					

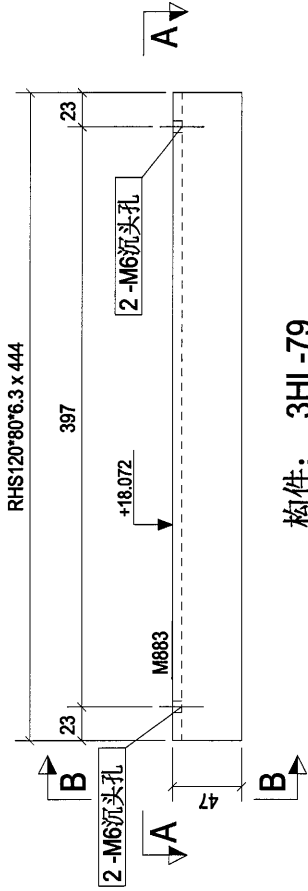

构件: 3HL-79

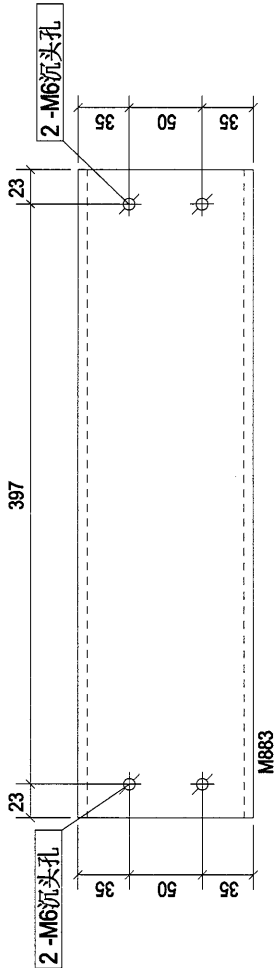

A - A

B - B

0	第一次报批	2018-11-05
Rev.	Description	Date
PROJECT: PROPOSED SITE C1 DEVELOPMENT AT AREA B8, TKOTL 70 RP, TSEUNG KWAN O, NEW TERRITORIES		
CLIENT: 美特铝质有限公司 MIDAL ALUMINIUM FABRICATOR LTD. Unit 6-8 Sunny Industrial Centre, 7/F 610 Chee Kwo Ling Road, Kwai Tsing Tel: 23489211-4 Fax: (852) 2727666		
S 银同有限公司 Silver Town Limited Tel: 3789 4338 Fax: 3789 4339 E-MAIL: ADDRESS@silvertown.ltd.com		
DRAWING TITLE : [3HL-79]		
CAD File Name :		
Designed by		
Drawn by		
Reviewed by		
Approved by		
Scale		
DWG NO: (MM4)-2 - [3HL-79]		REV. 0

构件编号: 3HL-80		构件数量: 2	构件重量: 26.70	
部件编号	规格(mm)	数量	单重(kg)	共重(kg)
M922	RHS120*60*5.0	1	26.70	26.70
合计:			26.70	0.71

M922


RHS120*60*5.0 x 2037

构件: 3HL-80

0	第一次报批	2018-11-05
Rev.	Description	Date
PROJECT: PROPOSED SITE C1 DEVELOPMENT AT AREA B6, TKOTL 70 RP, TSEUNG KWAN O, NEW TERRITORIES		
CLIENT: 美特铝质有限公司 MIDALUMINUM MANUFACTURE LTD. Units 6-8, Sunny Industrial Centre, / 610, Cha Kwo Ling Road, Kowloon Tel:23489211-4, Fax:(852)2727656		
S 银同有限公司 Silver Town Limited Tel:0782-8335968 Fax:0781-8335954 E-MAIL: AD@S3S@silvertown.hk, 18.02.04		
DRAWING TITLE : [3HL-80]		
CAD File Name :		
Designed by		
Drawn by		
Reviewed by		
Approved by		
Scale		
DWG NO: (WM4)-2 - [3HL-80]		REV. 0

构件编号: 3HL-81		构件数量: 2		构件重量:		26.20
部件编号	规格(mm)	数量	长度(mm)	单重(kg)	共重(kg)	表面积(m²)
M823	RHS120*60*5.0	1	1998	26.20	26.20	0.69
合计:						26.20

M823

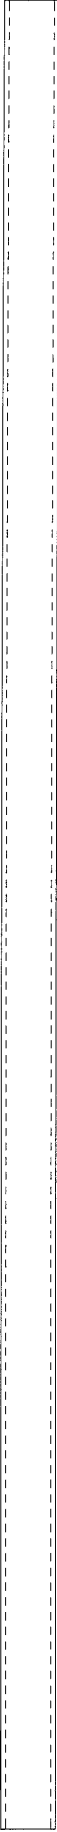

RHS120*60*5.0 x 1998

构件: 3HL-81

0	第1次报批	2018-11-05
Rev.	Description	Date
PROJECT: PROPOSED SITE C1 DEVELOPMENT AT AREA 08, TKOTL 70 RP, TSEUNG KWAN O, NEW TERRITORIES		
CLIENT:  美特铝质有限公司 ALUMINIUM MANUFACTURE LTD. Units 6-8, Sun Yee Industrial Centre, 7/F 610, Chee Kwee Ling Road, Kowloon Tel: 23489211-4, Fax: (852) 27727666		
 银同有限公司 Silver Town Limited Tel: 0789-8339886 Fax: 0789-8339894 E-Mail: 0008233@silvertown.hk		
DRAWING TITLE : [3HL-81]		
CAD File Name :		
Designed by		
Drawn by		
Reviewed by		
Approved by		
Scale		
DWG NO: (WM4)-2 - [3HL-81]		REV.
		0

构件编号:	3HL-83	构件数量:	1	构件重量:	7.63
部件编号	规格(mm)	长度(mm)	数量	单重(kg)	共重(kg)
M939	RSA75*40*5	1767	1	7.63	7.63
合计:					7.63



A	第2次核批	2018-11-10
Rev.	Description	Date
PROJECT:		
PROPOSED SITE C1 DEVELOPMENT AT AREA 08, TKOT, T70 RP, TSSUNG KWAN O, NEW TERRITORIES		
CLIENT:		
 美特鋁質有限公司 MIDI ALUMINIUM FABRICATOR LTD. Units 6-8, Sunny Industrial Centre, 1/F 610 Cha Kwo Ling Road, Kowloon Tel: 23499211-4 Fax: (852) 27777665		
 S silver Town Limited E-Mail: ADDRESS@silvertown.hk, 163.7104		
DRAWING TITLE :		
[3HL-83]		
CAD File Name :		
Designed by		
Drawn by		
Reviewed by		
Approved by		
Scale		
DWG NO.: (W144)-2 - [3HL-83]		REV. A

CAD File Name : 	Designed by
	Drawn by
	Reviewed by
	Approved by
	Scale

1, 角码做散件(3SJ-7)出货。


合计:	7.63
-----	------




DWG NO.: (WW4)-2 - [3HL-86]

修改说明:
1, 角码做散件(3SJ-7)出货。

构件编号: 3HL-87		构件数量: 1		构件重量: 7.67	
部件编号	规格(mm)	数量	单重(kg)	共重(kg)	表面积(m²)
M943	RSA75*40*5	1	7.67	7.67	0.41
合计: 7.67					

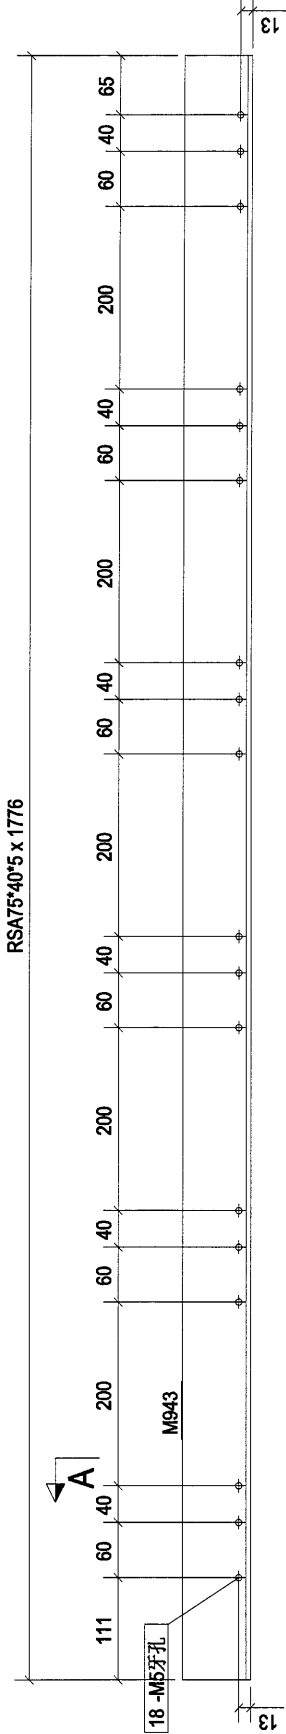


构件: 3HL-87

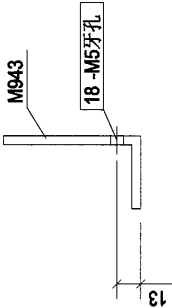


A	第2次报批	2018-11-10
Rev.	Description	Date
PROJECT: PROPOSED SITE C1 DEVELOPMENT AT AREA B8, TKOTL 70 RP, TSEUNG KWAN O, NEW TERRITORIES		
CLIENT: 美特铝质有限公司 MIDAL ALUMINIUM FABRICATING LTD. Units 6-8 Sun Chai Industrial Centre, 610 Chee Koo Jing Road, Kwai Tsing, Tseung Kwan O, New Territories Tel: 23489211-4 Fax: (852) 2727666		
S 银同有限公司 Silver Town Limited Tel: 0753-8333686 Fax: 0753-8333684 E: info@silvertown.hk		
DRAWING TITLE : [3HL-87]		
CAD File Name :		
Designed by		
Drawn by		
Reviewed by		
Approved by		
Scale		
DWG NO: (MMW4)-2 - [3HL-87]		REV. A

修改说明：
1，角码做散件(3SJ-7)出货。

构件编号: 3HL-88		构件数量: 1		构件重量: 7.67	
零件编号	规格(mm)	数量	单重(kg)	共重(kg)	表面积(m²)
M944	RSA75*40*5	1	7.67	7.67	0.41
合计:				7.67	

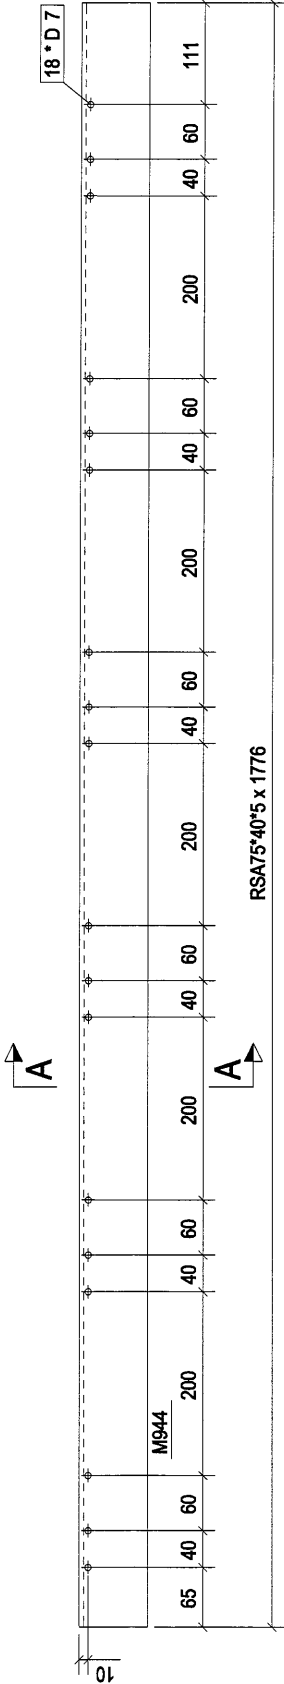


构件: 3HL-88

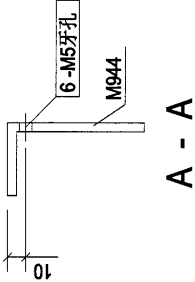


A	第2次报批	2018-11-10
Rev.	Description	Date
PROJECT: PROPOSED SITE C1 DEVELOPMENT AT AREA B8, TKOIL 70 RP, TSEUNG KWAN O, NEW TERRORIES		
CLIENT: 美特铝质有限公司 MIDI Unit 6-8, Sunny Industrial Centre, 1/F, 610 Cha Kwo Ling Road, Kowloon Tel: 23489211-4 Fax: (852) 2723665		
S 银同有限公司 Silver Town Limited Tel: 0759-8316468 Fax: 0759-8338994 E-MAIL: ADDRESS@silvertown.hk		
DRAWING TITLE : [3HL-88]		
CAD File Name :		
Designed by		
Drawn by		
Reviewed by		
Approved by		
Scale		
DWG NO: (MM4)-2 - [3HL-88]		REV. A

修改说明:
1, 角码做散件(3SJ-7)出货。

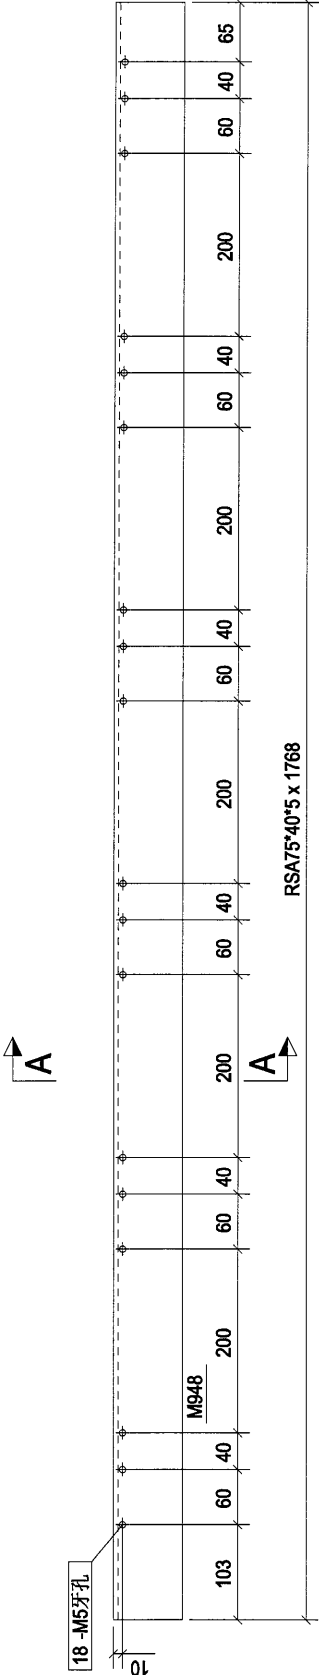

构件: 3HL-92

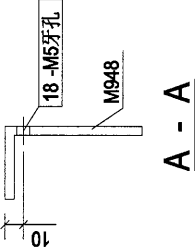


构件编号: 3HL-92		构件数量: 1		构件重量: 7.63	
部件编号	规格(mm)	数量	单重(kg)	共重(kg)	表面积(m ²)
M948	RSA75*40*5	1	7.63	7.63	0.41


合计: 7.63

A	第2次提批	2018-11-10
Rev.	Description	Date
PROJECT: PROPOSED SITE C1 DEVELOPMENT AT AREA B6, TKOIL 70 RP, TSEUNG KWAN O, NEW TERRORIES		
CLIENT: 美特铝质有限公司 MIDI ALUMINUM FABRICATOR LTD. Units 6-8, Sun Yee Industrial Centre, 1/F 610, Chee Koo Street, Tseung Kwan O, New Territories Tel: 23469211-4 Fax: (852) 2727666		
S 银同有限公司 Silver Town Limited Tel: 0769-8335988 Fax: 0769-8335984 E-Mail: ADDRESS@silvertown.hk		
DRAWING TITLE : [3HL-92]		
CAD File Name :		
Designed by		
Drawn by		
Reviewed by		
Approved by		
Scale		
DWG NO: (MM4)-2 - [3HL-92]		REV
		A

修改说明:
1, 角码做散件(3SJ-7)出货。

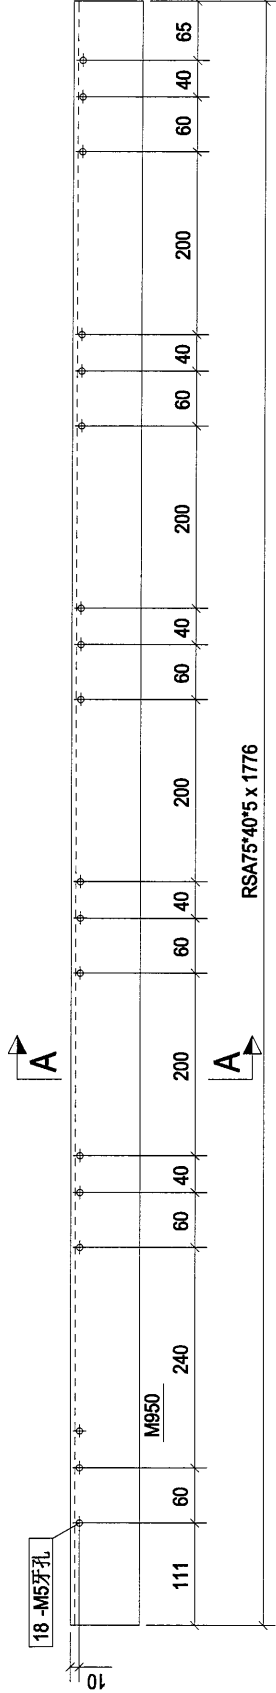


构件: 3HL-94

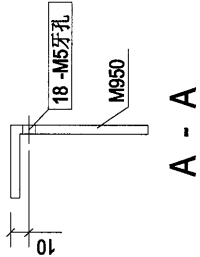


构件编号:	3HL-94	构件数量:	1	构件重量:	7.67
部件编号	规格(mm)	数量	单重(kg)	共重(kg)	表面积(m²)
M950	RSA75*40*5	1	7.67	7.67	0.41
合计:					7.67

A	第2次审批	2018-11-10
Rev.	Description	Date
PROJECT:		
PROPOSED SITE C1 DEVELOPMENT AT AREA 08, TKOTL 70 RP, TSEUNG KWAN O, NEW TERRITORIES		
CLIENT:		
美特铝质有限公司 MIDALUMINUM FABRICATOR LTD. Units 6 & 8, Sunny Industrial Estate, 7/F, 610 Che Kwan Ling Road, Kowloon Tel: 23489211-4, Fax: (852) 27775666		
S 银同有限公司 Silver Town Limited Tel: 00853 23366100, Fax: 00853 23366104 E: MTR, ADDRESS@silvertown.com.hk		
DRAWING TITLE :		
[3HL-94]		
CAD File Name :		
Designed by		
Drawn by		
Reviewed by		
Approved by		
Scale		
DWG NO: (WWW)-2 - [3HL-94]		REV
		A

修改说明:
1, 数量增加2件。

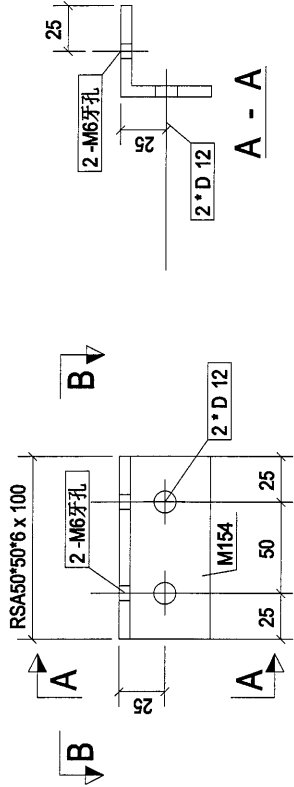


构件: 3MZ-1

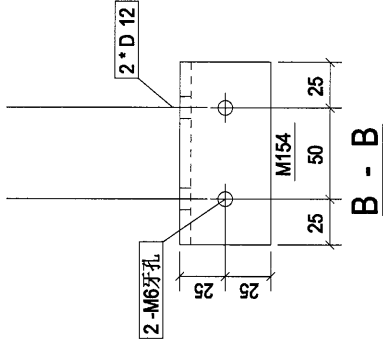

构件编号: 3MZ-1		构件数量: 96		构件重量: 0.45	
部件编号	规格(mm)	数量	单重(kg)	共重(kg)	表面积(m²)
M154	RSA50*50*6	1	0.45	0.45	0.02
合计:					0.45

A	第2次报批	2018-11-09
Rev.	Description	Date
PROJECT: PROPOSED SITE C1 DEVELOPMENT AT AREA 86, TKOTL 70 RP, TSEUNG KWAN O, NEW TERRITORIES		
CLIENT: 美特铝质有限公司 MIDY ALUMINUM FABRICATOR LTD. Units 5 & 6, Sunny Industrial Estate, 1/F 810 Chee Kwai Road, Kowloon Tel: 23489211-4, Fax: 8522772666		
S 银同有限公司 Silver Town Limited Tel: 0789-833568 Fax: 0789-8335954 E-Mail: ADDRESS@silvertown.hk		
DRAWING TITLE : [3MZ-1]		
CAD File Name :		
Designed by		
Drawn by		
Reviewed by		
Approved by		
Scale		
DWG NO: (WWW)-2 - [3MZ-1]		REV. A


构件编号:	3MZ-2	构件数量:	36	构件重量:	0.40
零件编号	规格(mm)	数量	重量(kg)	共重(kg)	注量(m³)
M449	RS450*50*6	1	0.40	0.40	0.02
合计:					0.40

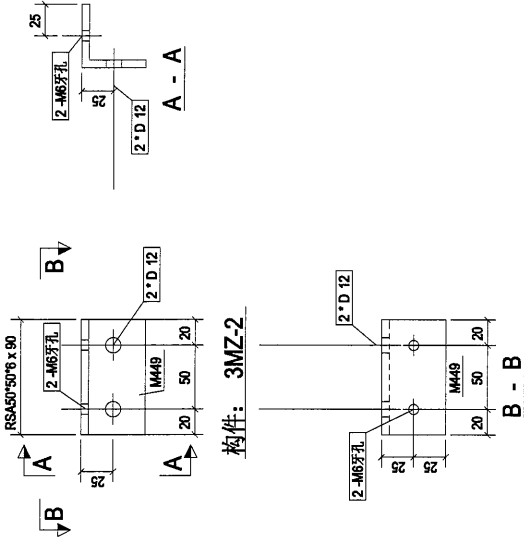


0	第1次报批	2018-07-04
Rev.	Description	Date
PROJECT: PROPOSED SITE C1 DEVELOPMENT AT AREA B8, TKOIL TO RP, TSEUNG KWAN O, NEW TERRITORIES		
CLIENT:  美特鋁質有限公司 MIDI ALUMINIUM FABRICATOR LTD. Unit 5-8, Sunny Industrial Centre, 1/F 510 Cheung Cheong Street, Tseung Kwan O, New Territories Tel: 23489211-4, Fax: (852) 2772666		
 銀同有限公司 Silver Town Limited Tel: 0769-8335988 Fax: 0769-8335984 E-Mail: ADDRESS@silvertown.hk		
DRAWING TITLE : [3MZ-2]		
CAD File Name :		
Designed by		
Drawn by		
Reviewed by		
Approved by		
Scale		
DWG NO.: (WWW)-2 - [3MZ-2]		REV. 0

修改说明:
1, 数量增加。

构件编号: 3MZ-3		构件数量: 4		构件重量: 0.27	
部件编号	规格(mm)	数量	单重(kg)	共重(kg)	表面积(m²)
M454	RSA50°50°6	60	1	0.27	0.01
合计: 0.27					

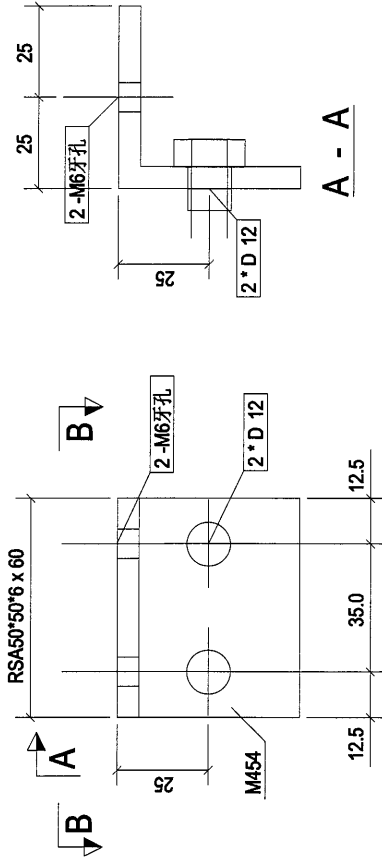


A 构件: 3MZ-3

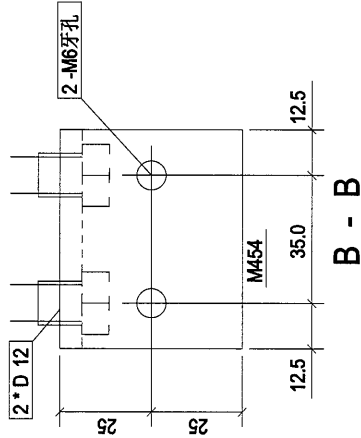

A	第2次批注	2016-11-05
Rev.	Description	Date
PROJECT: PROPOSED SITE C1 DEVELOPMENT AT AREA 86, TKOTL 70 RP, TSEUNG KWAN O, NEW TERRITORIES		
CLIENT:  美特铝质有限公司 MIDI ALUMINIUM FABRICATOR LTD. Units 6 & 7, Sunny Industrial Centre, 1/F 510 Chee Kwan Road, Tseung Kwan O Tel: 23489211-4, Fax: 232772666		
 银同有限公司 Silver Town Limited Tel: 028-8335968, Fax: 028-8335964 E-Mail: ADMIN@silvertown.com.cn		
DRAWING TITLE : [3MZ-3]		
CAD File Name :		
Designed by		
Drawn by		
Reviewed by		
Approved by		
Scale		
DWG NO. (WWW)-2 - [3MZ-3]		REV A


修改说明:
1, 数量减少16件。

构件编号:	3MZ-10	构件数量:	25	构件重量:	0.76
部件编号	规格(mm)	数量	长度(mm)	单重(kg)	共重(kg)
M997	RSA50*50*5	1	200	0.76	0.76
合计:					0.76

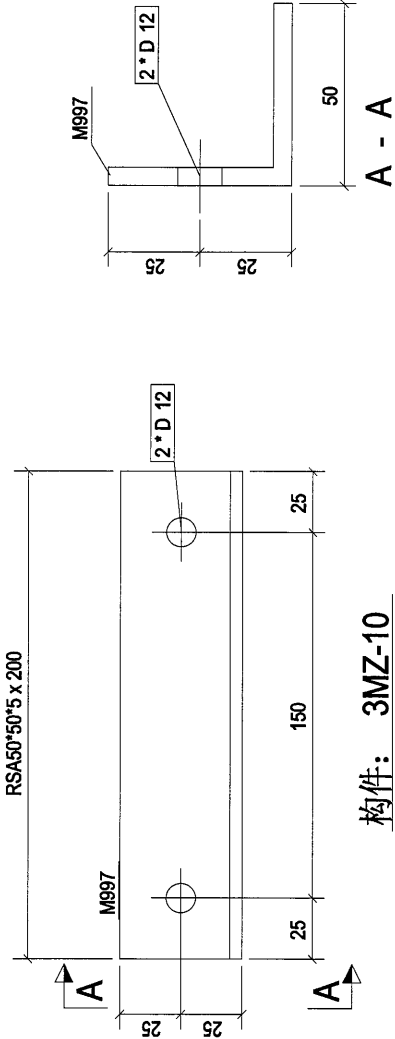

A	第2次修改	2018-11-09
Rev.	Description	Date
PROJECT:		
PROPOSED SITE C1 DEVELOPMENT AT AREA 08, TKOTL 70 RP, TSEUNG KWAN O, NEW TERRITORIES		
CLIENT:		
美特铝质有限公司 METAL QUALITY LTD. Unit 6-8, Sunny Industrial Centre, 7/F 810 Che Kwo Ling Road, Kowloon Tel: 23489211-4, Fax: 852 2777 6655		
S 银同有限公司 Silver Town Limited Tel: 00853 23356666, Fax: 00853 23356664 E-mail: AD@S23group.hk, TS.TS@STL		
DRAWING TITLE :		
[3MZ-10]		
CAD File Name :		
Designed by		
Drawn by		
Reviewed by		
Approved by		
Scale		
DWG NO.: (WWW)-2 - [3MZ-10]		REV. A

修改说明:
1, 数量+4件。

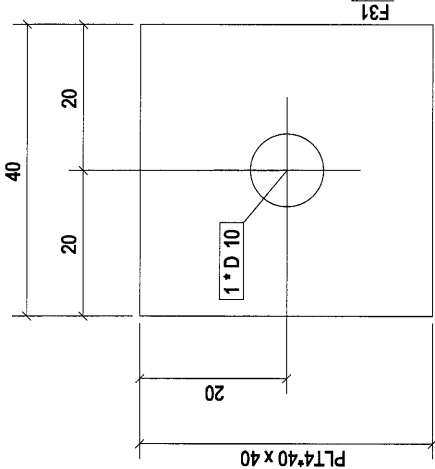


构件: 3P-1

构件编号: 3P-1		构件数量: 144		构件重量: 0.05	
部件编号	规格(mm)	数量	单重(kg)	共重(kg)	表面积(m²)
F31	PLT4*40	1	0.05	0.05	0.00
合计:					0.05

A	第2次报批	2018-11-09
Rev.	Description	Date
PROJECT: PROPOSED SITE C1 DEVELOPMENT AT AREA B6, TKOTL 70 RP, TSEUNG KWAN O, NEW TERRITORIES		
CLIENT: 美特铝质有限公司 MIDALUMINUM FABRICATOR LTD. Units 6-8, Sunny Industrial Centre, 7/F, 610 Cha Kwo Ling Road, Kowloon Tel: 23489211-4, Fax: (852) 2777656		
S 银同有限公司 Silver Town Limited Tel: (852) 33888888, Fax: (852) 33888884 E-MAIL: ADDRESS@silvertown.hk, 63.0204		
DRAWING TITLE : [3P-.1]		
CAD File Name :		
Designed by		
Drawn by		
Reviewed by		
Approved by		
Scale		
DWG NO.: (WWW)-2 - [3P-.1]		REV. A

修改说明:
1, 数量+2件。


构件编号: 3QM-1		构件数量: 70		构件重量: 1.43	
部件编号	规格(mm)	数量	单重(kg)	共重(kg)	表面积(m²)
M136	RSA100*75*6	1	1.43	1.43	0.07
合计:					1.43

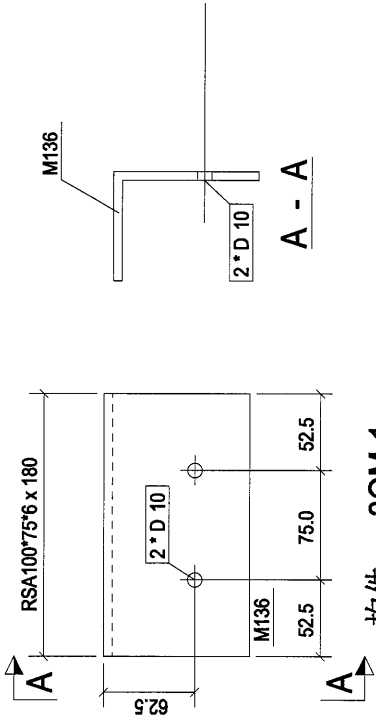

构件: 3QM-1

A	第2次批注	2018-11-09
Rev.	Description	Date
PROJECT: PROPOSED SITE C1 DEVELOPMENT AT AREA 86, TKOTL 70 RP, TSEUNG KWAN O, NEW TERRITORIES		
CLIENT:  美特铝质有限公司 MIDALUMINUM FABRICATORS LTD. Units 6 & 8, Sunny Industrial Estate, 610 Che Kwa Ling Road, Kowloon Tel: 23489211-4, Fax: (852) 2777 6865		
 银同有限公司 Silver Town Limited Tel: (852) 23353668, Fax: (852) 23353664 E-MAIL: ADDRESS@silvertown.hk, HK.COM		
DRAWING TITLE : [3QM-1]		
CAD File Name :		
Designed by		
Drawn by		
Reviewed by		
Approved by		
Scale		
DWG NO.: (WWW)-2 - [3QM-1]		REV. A

构件编号:	3QM-2	构件数量:	4	构件重量:	0.80
零件编号	规格(mm)	数量	重量(kg)	共重(kg)	注量(m)
M377	RSA100*75*6	1	0.80	0.80	0.04
合计:					0.80

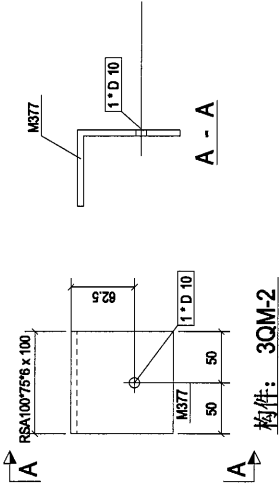


0	第1次提批	2018-07-04
Rev.	Description	Date
PROJECT: PROPOSED SITE C1 DEVELOPMENT AT AREA 08, TKOTL 70 RP, TSEUNG KWAN O, NEW TERRITORIES		
CLIENT:  美特铝质有限公司 MIDI ALUMINIUM FABRICATING LTD. Unit 5-8, Sunny Industrial Centre, 1/F 100, Kwai Chung Road, Kwai Chung Tel: 23489211-4, Fax: (852) 27727666		
 银同有限公司 Silver Town Limited Tel: 0769-83354988 Fax: 0769-83359854 E-MAIL ADDRESS: ag@silvertown.hk		
DRAWING TITLE : [3QM-2]		
CAD File Name :		
Designed by		
Drawn by		
Reviewed by		
Approved by		
Scale		
DWG NO.: (WWW)-2 - [3QM-2]		REV.
		0

修改说明:
1, 去牙孔。

构件编号:	3SB-53	2	构件数量:	2	构件重量:	31.27
零件编号	规格(mm)	数量	单重(kg)	共重(kg)	表面积(m ²)	
M274	RHS120*80*6.3	1	31.27	31.27	0.66	


合计: 31.27

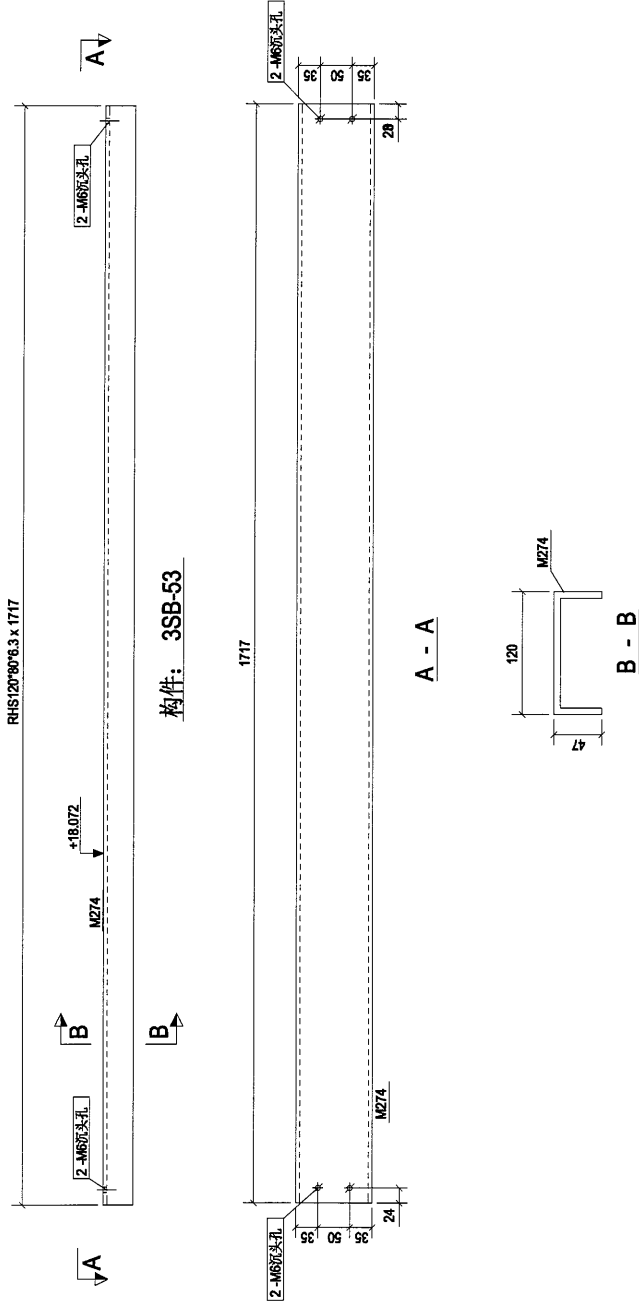

A	第2次提批	2018-11-05
Rev.	Description	Date
PROJECT:		
PROPOSED SITE C1 DEVELOPMENT AT AREA 08, TKOTL70 RP, TSEUNG KWAN O, NEW TERRITORIES		
CLIENT:		
美特鋁質有限公司 MIDI ALUMINIUM FABRICATOR LTD. Units 5-8, Sunray Industrial Centre, 1/F 150, Shing Mun Street, Tseung Kwan O, New Territories Tel: 23489211-4 Fax: (852) 27727666		
S 銀同有限公司 Silver Town Limited Tel: 0769-8335988 Fax: 0769-8335984 E-MAIL: ADDRESS@silvertown.hk		
DRAWING TITLE :		
[3SB-53]		
CAD File Name :		
Designed by		
Drawn by		
Reviewed by		
Approved by		
Scale		
DWG NO.: (WWW)-2 - [3SB-53]		
REV.		
A		

1,增加牙孔。

合计:	48.43
-----	-------

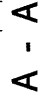

A	第2次草稿	2018-11-05
Rev.	Description	Date

PROJECT: PROPOSED SITE C4
DEVELOPMENT AT AREA 68,
TRONTI ROAD, TSENG KWAN O,
NEW TERRITORIES

CUSTOMER: 美特鋁質有限公司
MIDI ALUMINIUM MANUFACTURE LTD.
Units 6-8, Sunny Industrial Centre, 1/F
610 Cha Kwo Ling Road, Kowloon
Tel: 23489211-4 Fax: (852) 27727666

DESIGNER: 3 Silver Town Limited
Tel: 0769-8355498 Fax: 0769-8359854
E-MAIL: ADDRESS@silvertownp.13.COM


DRAWING TITLE : [3SC-1]

CAD File Name :	
Designed by	
Drawn by	
Reviewed by	
Approved by	
Scale	


DWG NO.: (WW4)-2	- [3SC-1]	REV. A
------------------	-----------	--------

改说明：
1, 增加M5牙孔, 长度减短。
2, 数量减1, 变为3SC-27.

构件编号:	3SC-2	构件数量:		1	构件重量:		78.36
零件编号	规格(mm)	长度(mm)	数量	单重(kg)	共重(kg)	表面积(m ²)	
M278	RSA50°50°5	100	14	0.38	5.31	0.02	
M345	RHS160°80°6.3	3300	1	73.05	73.05	1.53	
合计:							78.36

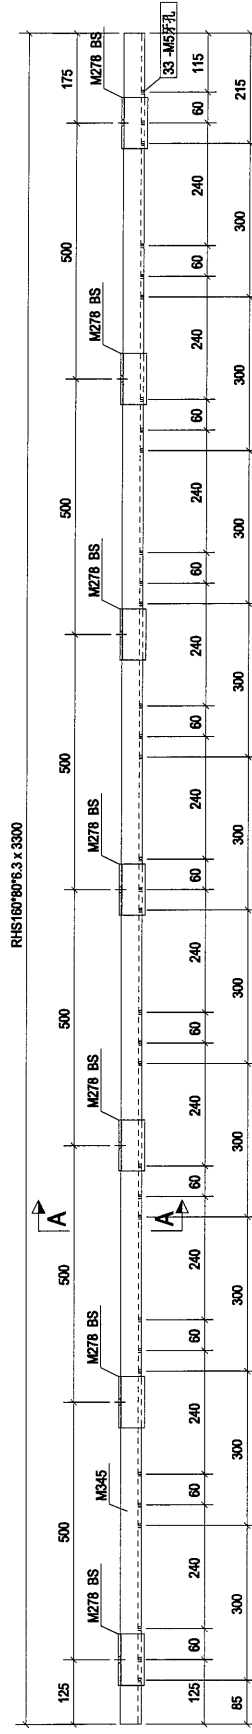

构件: 3SC-2

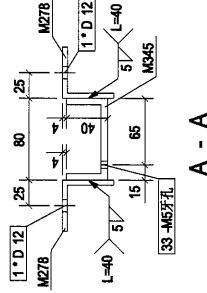

A	第2次批註	2018-11-05
Rev.	Description	Date

PROJECT:	PROPOSED SITE C1 DEVELOPMENT AT AREA 88, TR01, TO RP, TSEUNG KWAN O, NEW TERRORIES
----------	---

CUSTOMER:	 美特鋁質有限公司 MIDI ALUMINIUM MANUFACTURER LTD. Units 6-8, Sany Industrial Centre, 1/F 610 Cha Kwo Ling Road, Kowloon Tel: 33489211 - 4 Fax: (852) 2772666
	 Silver Town Limited Tel: 0769-8335498 Fax: 0769-8335864 E-MAIL: ADDRESS.ag@silvertown.hk, 633.COM


DRAWING TITLE :	[3SC--2]
-----------------	----------

CAD File Name :	
Designed by	
Drawn by	
Reviewed by	
Approved by	
Scale	



DWG NO. : (WWW)-2 - [3SC-2]	REV. : A
-----------------------------	----------

构件编号: 3SC-3		1	构件数量:		构件重量:	
零件编号	规格(mm)	数量	单重(kg)	共重(kg)	长度(mm)	表面积(m ²)
M951	RSA75*50*5	1	11.78	11.78	2500	0.63

合计: 11.78

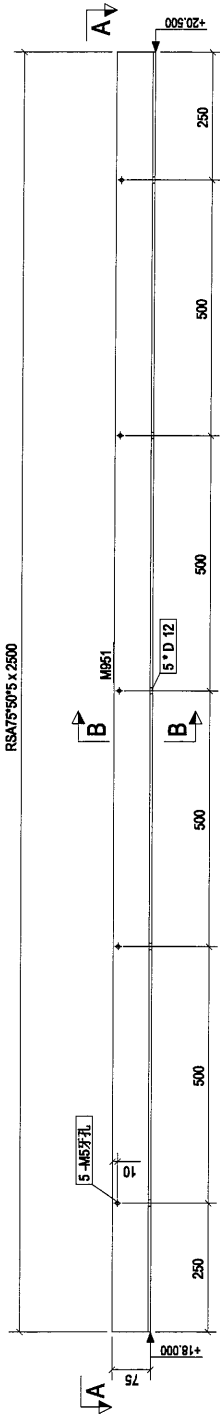

构件: 3SC-3

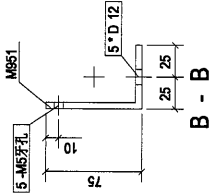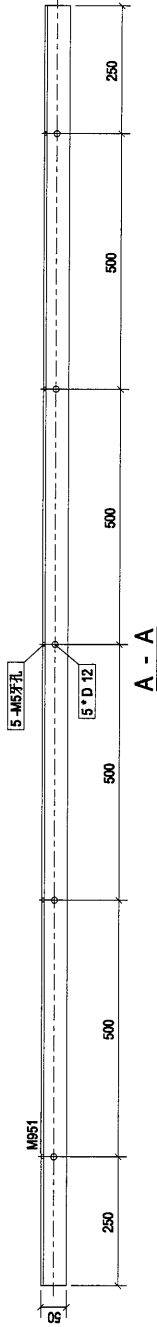

0	第1次报批	2018-11-05
Rev.	Description	Date

PROJECT:
PROPOSED SITE C1
DEVELOPMENT AT AREA 88,
TKOTL 70 RP, TSEUNG KWAN O,
NEW TERRITORIES

CLIENT:
美特铝质有限公司
MIDI ALUMINIUM FABRICATING LTD.
Unit 6-8, Sunny Industrial Centre, 1/F
50 D'Almeida Street, Tseung Kwan O,
New Territories
Tel: 23489111-4, Fax: (852) 2727866

S 银同有限公司
Silver Town Limited
Tel: 0769-8335698 Fax: 0769-8335954
E-MAIL: ADDRESS@silvertown.hk



DRAWING TITLE :
[3SC-3]

CAD File Name :	
Designed by	
Drawn by	
Reviewed by	
Approved by	
Scale	

DWG NO: (WW4)-2	- [3SC-3]
REV	0

修改说明:
1, 增加牙孔。
2, 数量减2, 变为3SC-14.



构件编号:		3SC-4	构件数量:		1	构件重量:		88.74
零件编号	规格(mm)	数量	重量(kg)	共重(kg)	表面面积(m ²)			
M279	RSA50*50*5	50	2	0.19	0.38			
M854	RHS160*80*6.0	4169	1	88.36	1.94			
合计:						88.74		

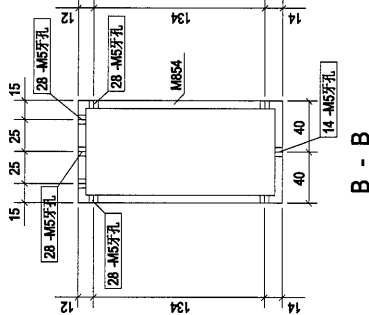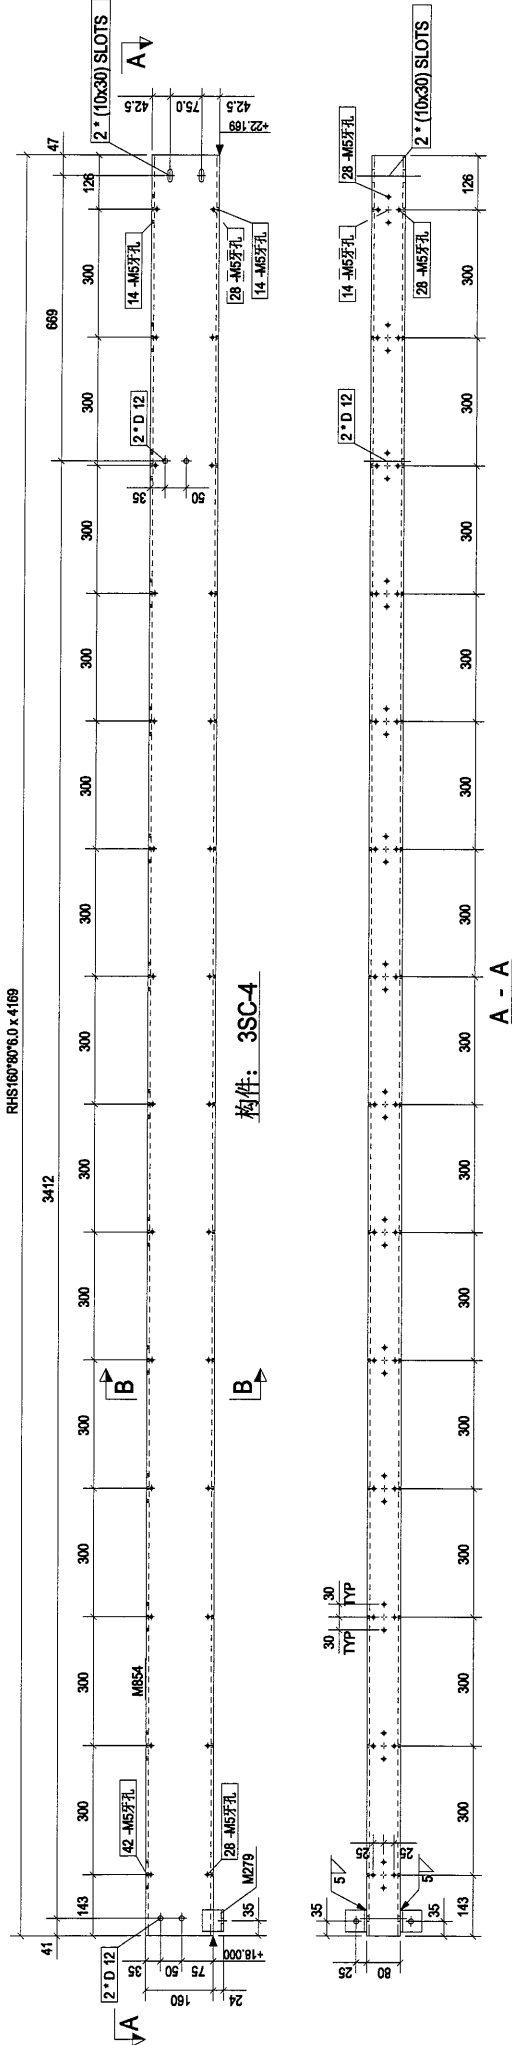

B	第3次提批	2018-11-05
Rev.	Description	Date
PROJECT:		
PROPOSED SITE C1 DEVELOPMENT AT AREA 88, TKOTL 70 RP, TSEUNG KWAN O, NEW TERRITORIES		
CLIENT:		
美特鋁質有限公司 MTDI ALUMINIUM FABRICATING LTD. Unit 5-8, Sunny Industrial Centre, 1/F 510 C, Yuen Long Road, Yuen Long Tel: (852) 2772 7656		
S 銀同有限公司 Silver Town Limited Tel: (769) 8335988 Fax: (769) 8335984 E-Mail: ADDRESS@silvertown.hk		
DRAWING TITLE :		
[3SC-4]		
CAD File Name :		
Designed by		
Drawn by		
Reviewed by		
Approved by		
Scale		
DWG NO. (WWW)-2 - [3SC-4]		REV
		B

修改说明：
1, 增加牙孔, 去角码。



构件编号:	35C-5	构件数量:	1	构件重量:	88.36
部件编号	规格(mm)	长度(mm)	数量	单重(kg)	共重(kg)
M369	RHS160*80*6.0	4169	1	88.36	88.36
合计:					88.36

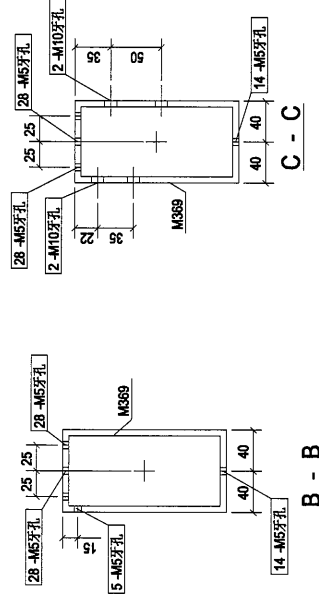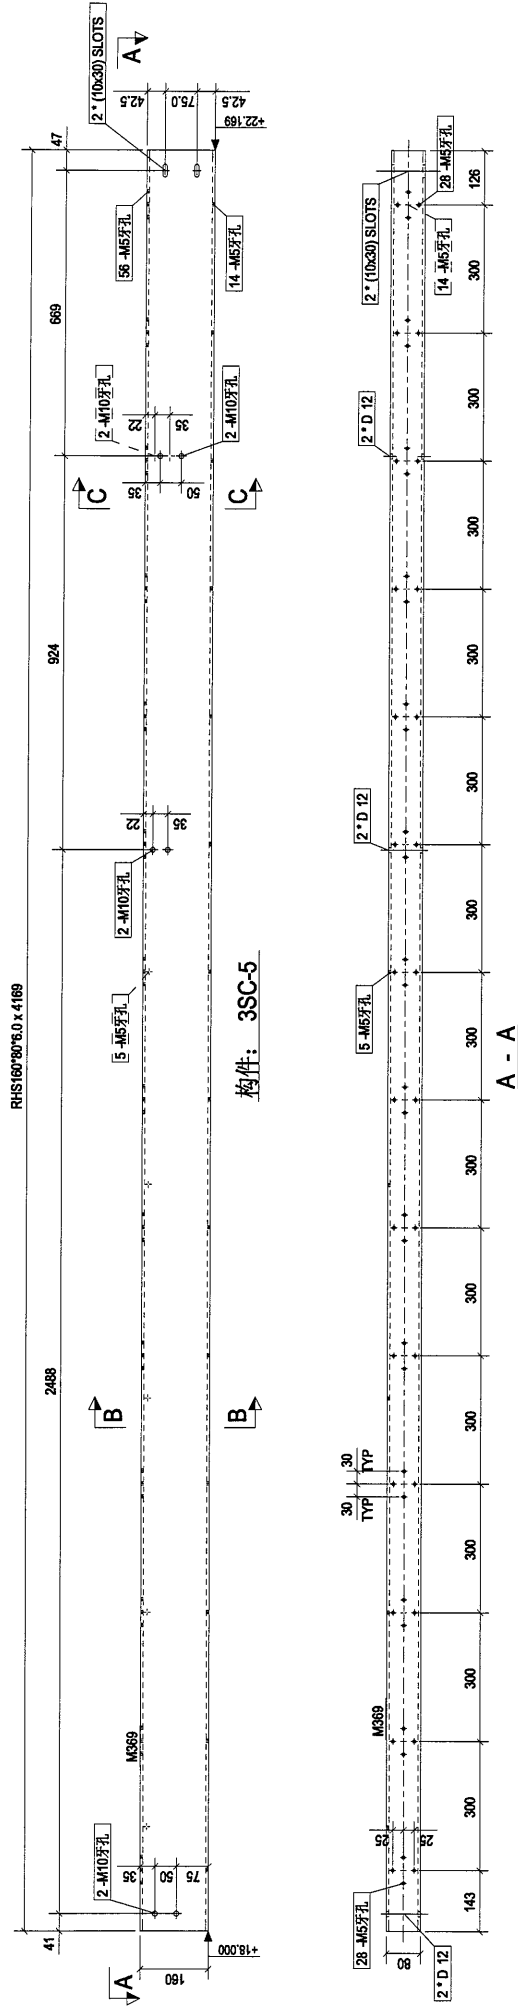

A	第2次校對	2018-11-05
Rev.	Description	Date
PROJECT: PROPOSED SITE C1 DEVELOPMENT AT AREA 88, TKOT, TO RP, TSEUNG KWAN O, NEW TERRITORIES		
CLIENT:  美特鋁質有限公司 MIDT ALUMINIUM MANUFACTURE LTD. Units 6-8, Sung Yee Industrial Centre, 1/F, 610 Cho Kwo Ling Road, Kowloon Tel: 23469211-4, Fax: (852) 27727666		
 銀同有限公司 Silver Town Limited Tel: 0769-8355088 Fax: 0769-8355854 E-MAIL: ANDREW.Singhal@tp.161.COM		
DRAWING TITLE : [3SC--5]		
CAD File Name :		
Designed by Drawn by Reviewed by Approved by Scale		
DWG NO.: (WW4)-2 - [3SC-5]		REV.

修改说明:
1, 增加M5牙孔, 增加Φ12孔, 长度减短。


构件编号:	3SC-6	构件数量:	1	构件重量:	75.77
零件编号	规格(mm)	数量	单重(kg)	共重(kg)	表面积(m ²)
M347	RHS160*80*6.0	3575	1	75.77	1.66
合计:					75.77

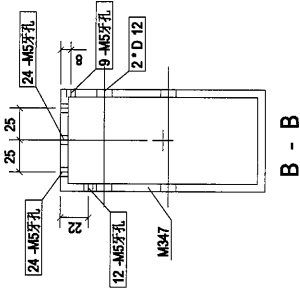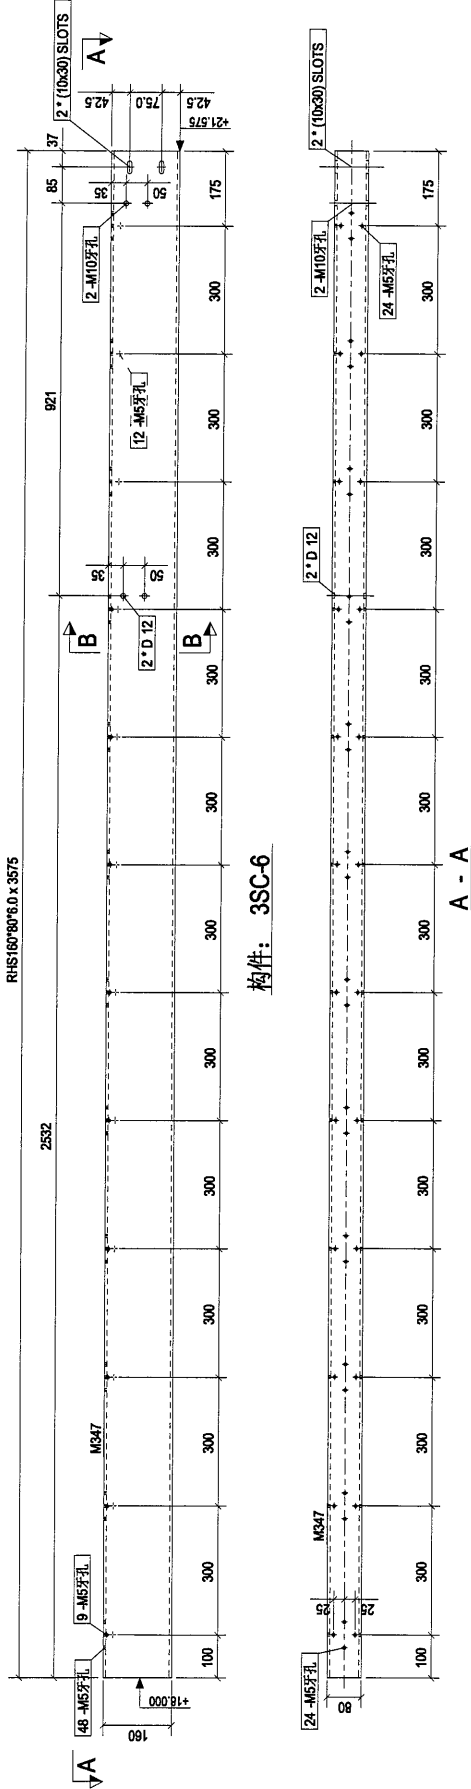

B	第3次提批	2018-11-05
Rev.	Description	Date
PROJECT: PROPOSED SITE C1 DEVELOPMENT AT AREA 88, TKOTL TO RP, TSEUNG KWAN O, NEW TERRITORIES		
CLIENT: 美特鋁質有限公司 MIDI ALUMINIUM FABRICATOR LTD. Unit 6-8, Sunny Industrial Centre, 1/F 500, Gao Tin Road, Tseung Kwan O, New Territories Tel: 23489211-4, Fax: (852) 27727656		
S 銀同有限公司 Silver Town Limited Tel: 0769-83354968 Fax: 0769-43359554 E-MAIL: ADDRESS@silvertown.hk		
DRAWING TITLE : [3SC-6]		
CAD File Name :		
Designed by		
Drawn by		
Reviewed by		
Approved by		
Scale		
DWG NO: (WVW4)-2 - [3SC-6]		
REV		B


1, 增加M5牙孔, 加底板, 长度减短。
2, 数量减2, 变为3SC-25, 33.

构件编号:		3SC-7	构件数量:		1	构件重量:		90.17
部件编号	规格(mm)		长度(mm)	数量	单重(kg)	共重(kg)	表面面积(m ²)	
F82	PLT16*300		400	1	15.07	15.07	0.26	
M348	RHS160*80*6.0		3543	1	75.09	75.09	1.65	
						合计:		90.17

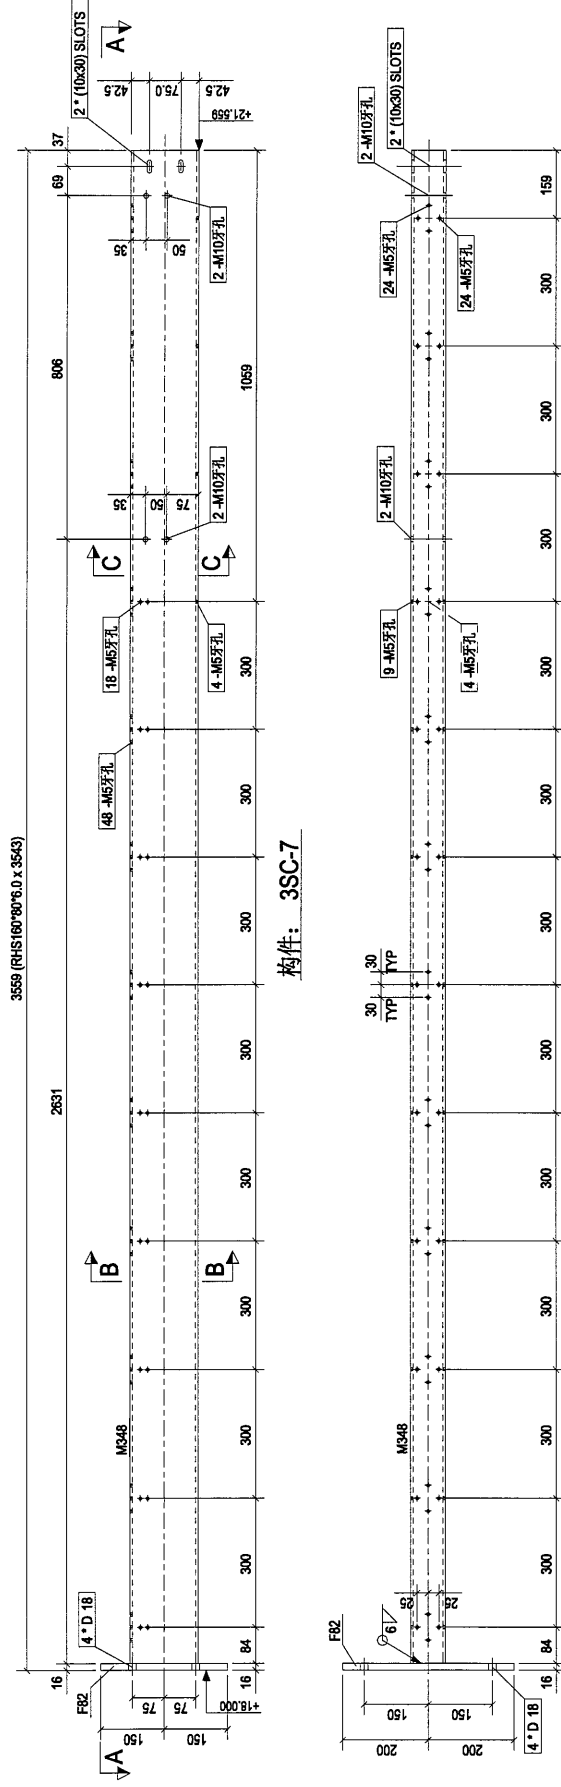

构件: 3SC-7

A - A

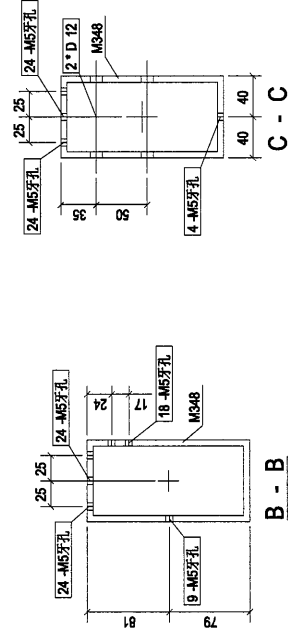

B	第3次批核	2018-11-05
Rev.	Description	Date
PROJECT: PROPOSED SITE C1 DEVELOPMENT AT AREA 88, TKOIT, 70 R/F, T'SUNG KWAN O, NEW TERRITORIES		
CLIENT:  美特鋁質有限公司 MIDY COMMUNICATIONS LTD. Units 6-8, Sunway Intellectual Center, 1/F, 610, Cha Tse Tung Road, Kowloon Tel:23492111-4, Fax:(852)2772686		
 Silver Town Limited Tel:0760-315568 Fax:0760-315584 E-MAIL: ADDRESS@silvertown.hk, 163.COM		
DRAWING TITLE : [3SC-.7]		
CAD File Name :		
Designed by		
Drawn by		
Reviewed by		
Approved by		
Scale		
DWG NO.: (WW4)-2 - [3SC-.7]		REV. 1



构件编号:	3SC-8	构件数量:	8	构件重量:	75.77
部件编号	规格(mm)	长度(mm)	数量	单重(kg)	共重(kg)
M857	RHS160*80*6.0	3575	1	75.77	75.77
合计:					75.77



DWG NO.: (WW4)-2 - [3SC-8]	REV.	C
----------------------------	------	---


修改说明:
1, 增加M5牙孔, 长度减短。

构件编号:	3SC-9	构件数量:	1	构件重量:	75.77
零件编号	规格(mm)	数量	单重(kg)	共重(kg)	表面积(m ²)
M361	RHS160*80*6.0	3575	75.77	75.77	1.66
合计:					75.77

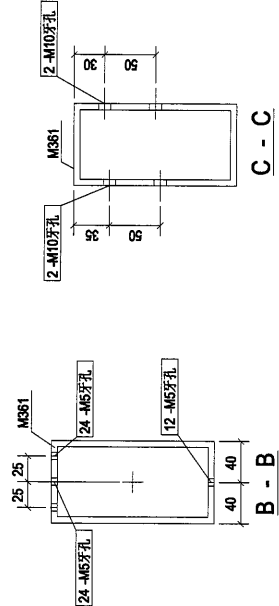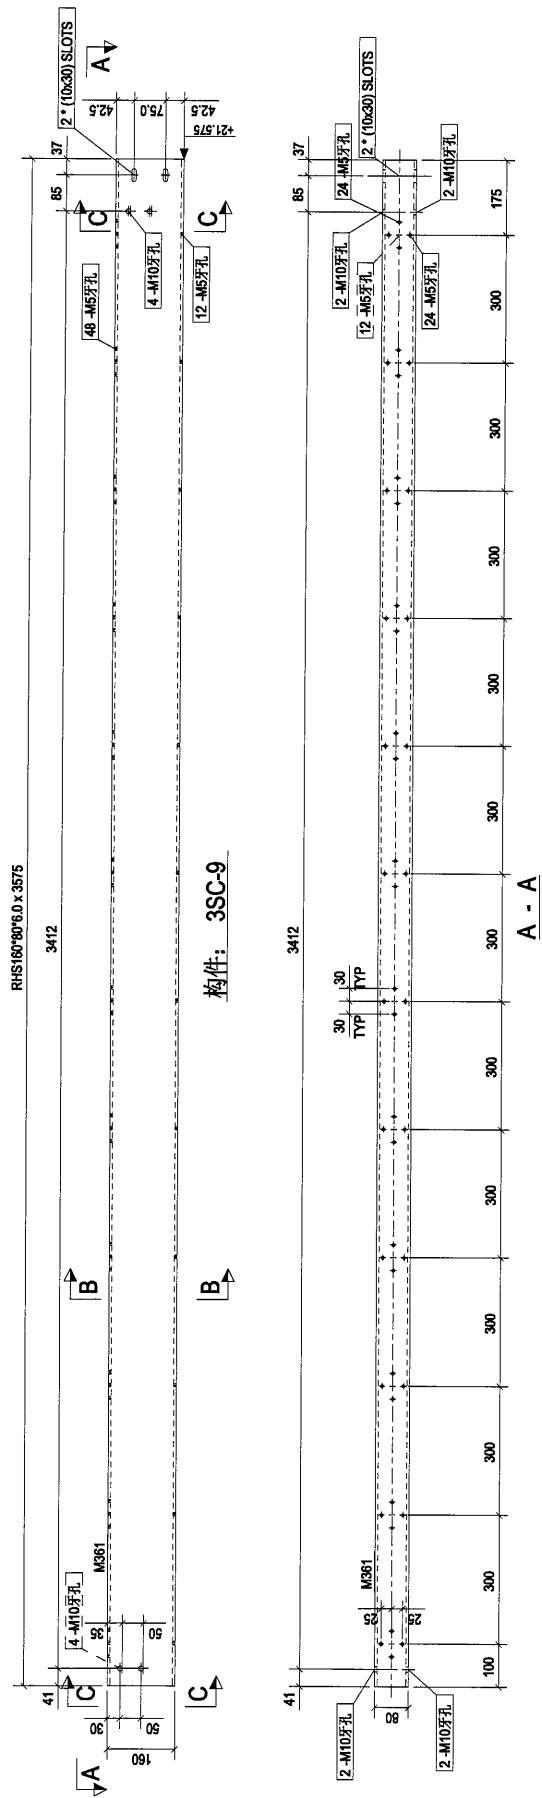

B	第3次报批	2018-11-05
Rev.	Description	Date
PROJECT: PROPOSED SITE C1 DEVELOPMENT AT AREA B8 TKOTL 70 RP, TSEUNG KWAN O, NEW TERRITORIES		
CLIENT: 美特鋁質有限公司 MIDI ALUMINIUM FABRICATOR LTD. Units 6-8, Sunoy Industrial Centre, 1/F 610 Cho Kwo Ling Road, Kowloon Tel: 2463211-4 Fax: (852) 2727666		
S 银同有限公司 Silver Town Limited Tel: 0769-83354868 Fax: 0769-83359554 E-MAIL ADDRESS: silvertown@163.com		
DRAWING TITLE : [3SC-9]		
CAD File Name :		
Designed by		
Drawn by		
Reviewed by		
Approved by		
Scale		
DWG NO: (WW4)-2 - [3SC-9]		REV. B

1, 增加M5牙孔, 加底板, 长度减短。
2, 数量减2, 变为3SC-26, 32.


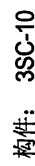
4759 (RHS160*80*6.0 x 4743)

Scale		
DWG NO.: (WWW)-2 - [3SC-10]		REV. B

修改说明:
1, 增加M5牙孔, 长度减短。

构件编号:	3SC-11	构件数量:	1	构件重量:	77.04
部件编号	规格(mm)	数量	重量(kg)	共重(kg)	表面积(m ²)
M365	RHS160*80*6.0	1	77.04	77.04	1.89


合计: 77.04

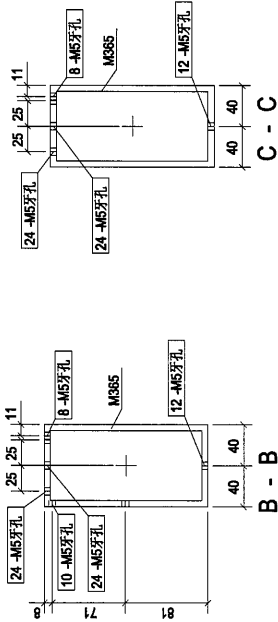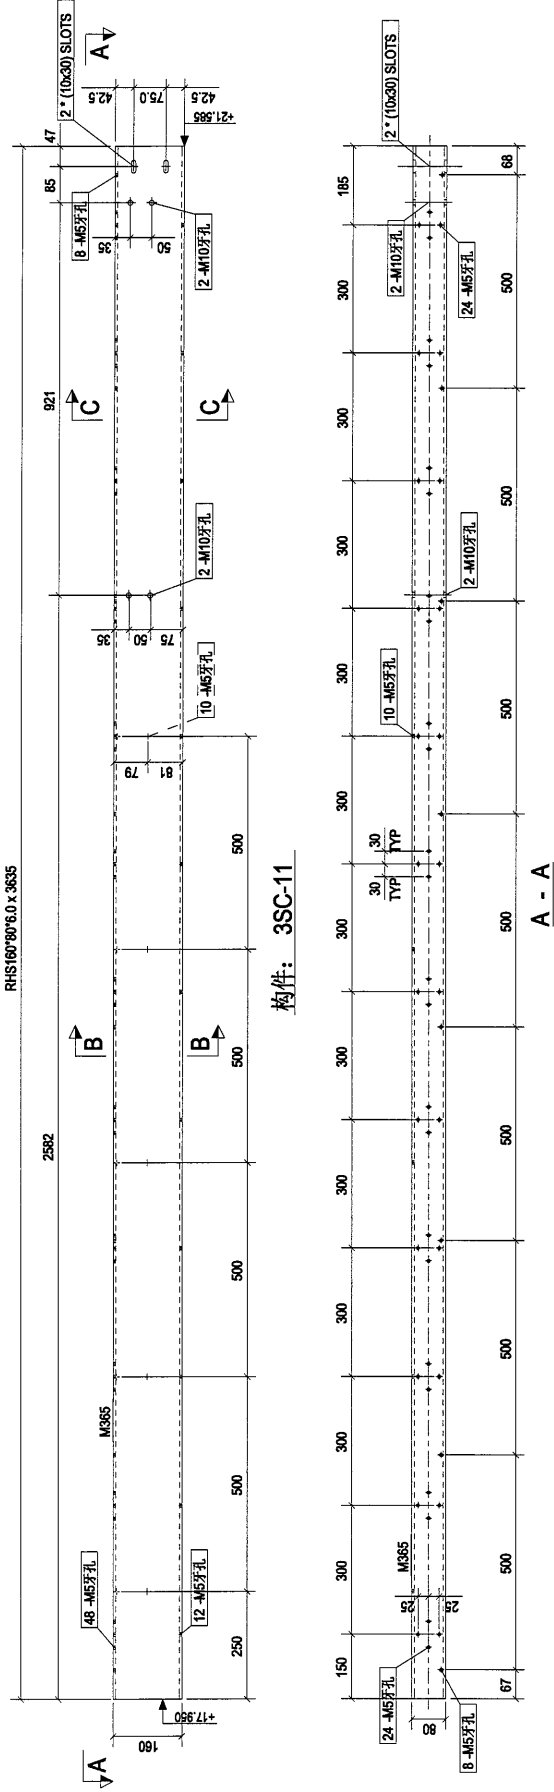


B	第3次提批	2018-11-05
Rev.	Description	Date
PROJECT:		
PROPOSED SITE C1 DEVELOPMENT AT AREA B8, TKOIL 70 RP, TSEUNG KWAN O, NEW TERRITORIES		
CLIENT:		
美特鋁質有限公司 MIDI ALUMINIUM FABRICATOR LTD. Unit 6-8, Sunny Industrial Centre, 1/F 610, Chee Kwan Jong Road, Kowloon Tel: 23469211-4, Fax: (852) 27272666		
S 銀同有限公司 Silver Town Limited Tel: 0753-43354988 Fax: 0753-4335954 E-MAIL: ADDRESS@silvertown.hk		
DRAWING TITLE :		
[3SC-11]		
CAD File Name :		
Designed by		
Drawn by		
Reviewed by		
Approved by		
Scale		
DWG NO: (MW4)-2 - [3SC-11]		
REV		B

修改说明:
1, 增加M5牙孔,长度减短。


构件编号:	3SC-12	构件数量:	1	构件重量:	77.04
部件编号	规格(mm)	数量	重量(kg)	共重(kg)	表面积(m ²)
M366	RHS160*80*6.0	1	77.04	77.04	1.69
合计:					77.04

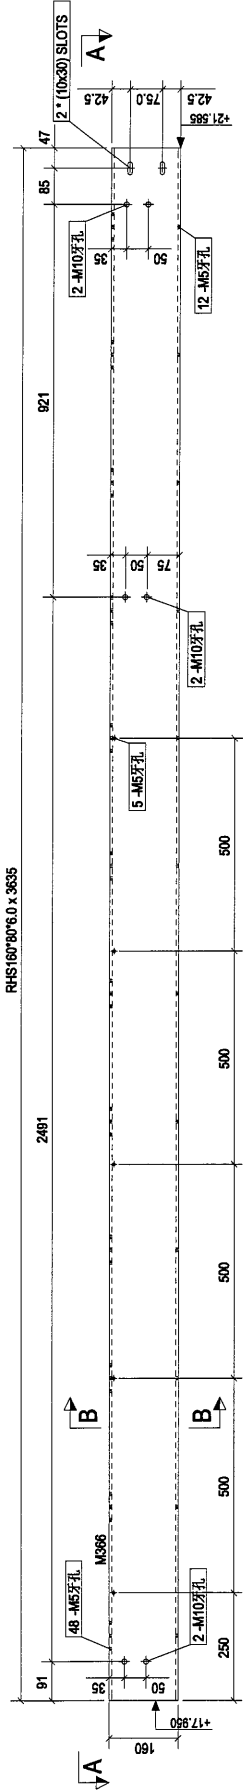

构件: 3SC-12

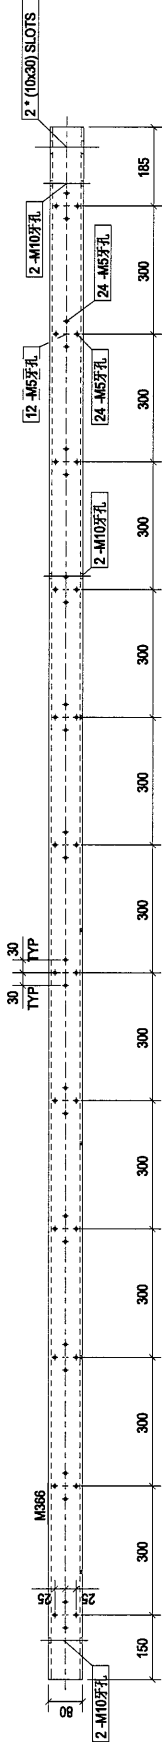

A - A

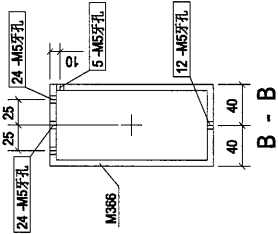



B	第3次修改	2018-11-05
Rev.	Description	Date
PROJECT:		
PROPOSED SITE C1 DEVELOPMENT AT AREA 88, TKOIL 70 RP, TSEUNG KWAN O, NEW TERRITORIES		
CLIENT:		
美特鋁質有限公司 MIDALUMINUM FABRICATOR LTD. Units 6-8, Sunny Industrial Centre, 510 Chee Koo Ling Road, Kwun Tong, Tel: 23489211-4, Fax: (852) 27777665		
S 銀同有限公司 Silver Town Limited Tel: (852) 23586100, Fax: (852) 23586104 E-MAIL: ADDRESS@silvertown.com.hk		
DRAWING TITLE :		
[3SC-12]		
CAD File Name :		
Designed by		
Drawn by		
Reviewed by		
Approved by		
Scale		
DWG NO: (MM4)-2 - [3SC-12]		
REV.		
B		

修改说明:
1, 数量增加3件。

构件编号: 3SC-14		构件数量: 5		构件重量: 88.36	
部件编号	规格(mm)	数量	单重(kg)	共重(kg)	涂面积(m ²)
M368	RHS160*80*6.0	1	88.36	88.36	1.94

合计: 88.36



RHS160*80*6.0 x 4169

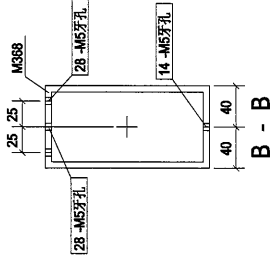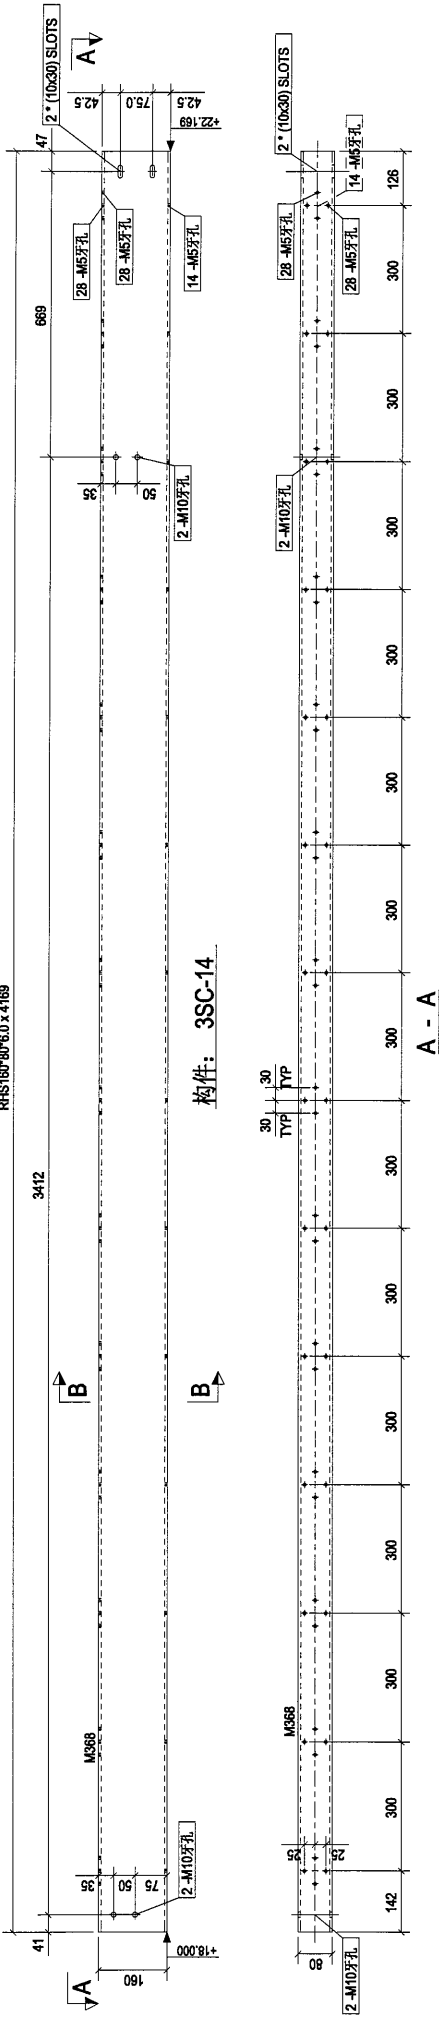

B	第3次提批	2018-11-05
Rev.	Description	Date
PROJECT: PROPOSED SITE C1 DEVELOPMENT AT AREA 88, TKOTL 70 RP, TSEUNG KWAN O, NEW TERRITORIES		
CLIENT: 美特鋁質有限公司 MIDI ALUMINIUM FABRICATOR LTD. Units 6-8, Sunny Industrial Centre, 1/F 80 Hing Fong Chung Road, Tseung Kwan O, New Territories Tel: 2348211-4 Fax: (852) 2727656		
S 銀同有限公司 Silver Town Limited Tel: 0789-8335988 Fax: 0789-8335984 E-MAIL: ADDRESS@silvertown.hk		
DRAWING TITLE : [3SC-14]		
CAD File Name :		
Designed by		
Drawn by		
Reviewed by		
Approved by		
Scale		
DWG NO.: (WWW)-2 - [3SC-14]		REV B

材料编号:		3SC-15	1		构件重量:		92.22
材料编号	规格(mm)	长度(mm)	重量	单重(kg)	井重(kg)	重量(m)	重量(m)
M373	PLF118	150	8	1.11	8.89	0.04	
M443	RHS150*75*6.0	4153	1	83.33	83.33	0.64	
合计:							92.22

Rev.	第1次报批	2018-07-04
PROJECT:		
PROPOSED SITE C1 DEVELOPMENT AT AREA B8, TKOIL 70 RP, TSEUNG KWAN O, NEW TERRITORIES		
CLIENT:		
美特铝质有限公司 MIDI ALUMINIUM FABRICATOR LTD. Units 5-8, Sun Chai Industrial Centre, 7/ 810, Chee Kwee Ling Road, Kowloon Tel: 23489211-4, Fax: (852) 27277666		
S 银同有限公司 Silver Town Limited Tel: 00853 23586700, 23586747 E: Mtl, 00853 23586747, 03.02M		
DRAWING TITLE :		
[3SC-15]		
CAD File Name :		
Designed by		
Drawn by		
Reviewed by		
Approved by		
Scale		
DWG NO: (WNM4)-2 - [3SC-15]		REV.
		0

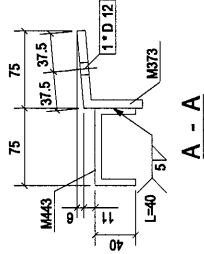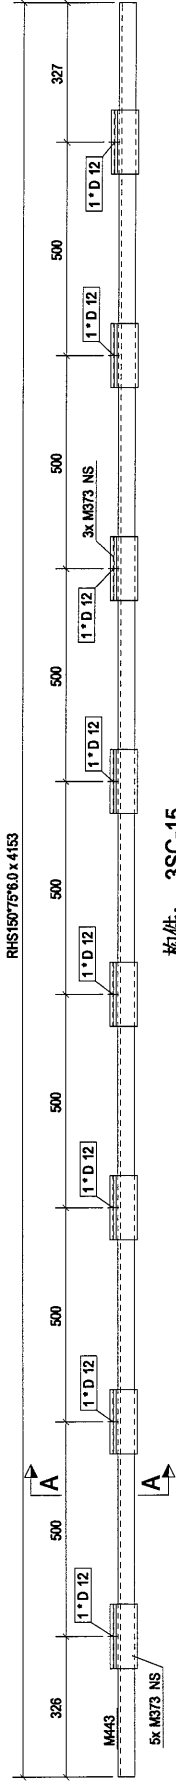

1, 增加M5牙孔, 长度减短。


合计:	97.94
-----	-------




DWG NO.: (WW4)-2 - [3SC-16]

修改说明:
1, 增加M5牙孔, 长度减短。


构件编号: 3SC-17		构件数量: 1		构件重量: 97.94	
零件编号	规格(mm)	数量	单重(kg)	共重(kg)	表面积(m ²)
M375	SHS100*100*10.0	1	97.94	97.94	1.34
合计:					97.94

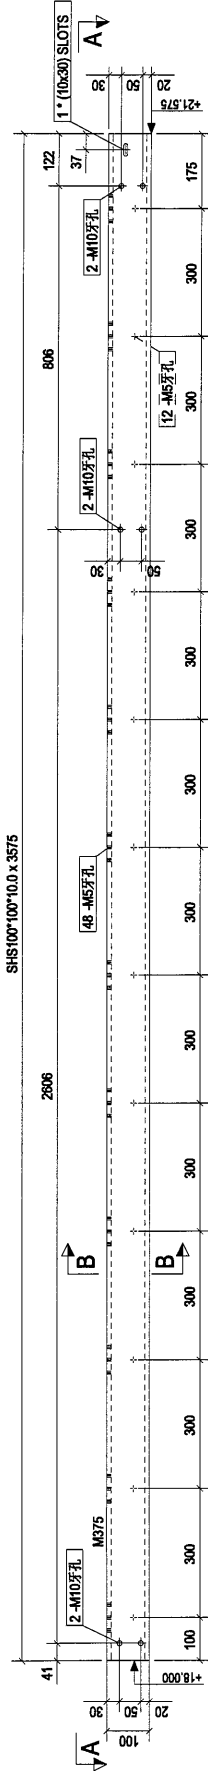

构件: 3SC-17

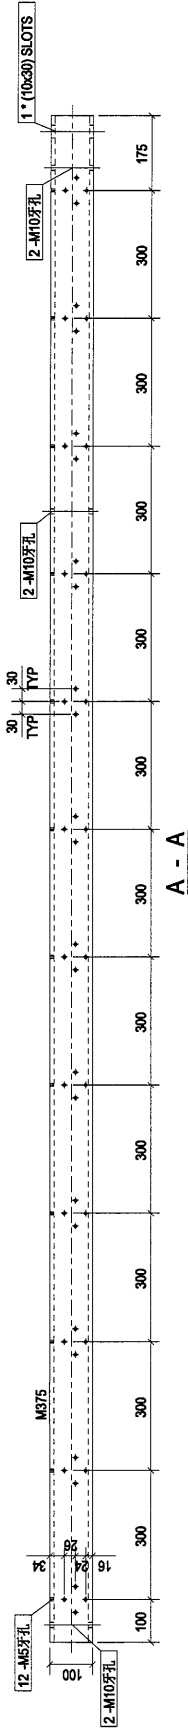

A - A

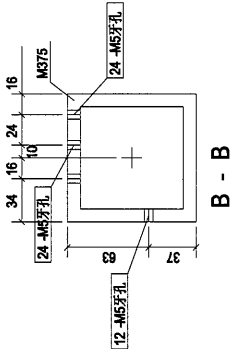


B - B


B	第3次报批	2018-11-05
Rev.	Description	Date
PROJECT:		
PROPOSED SITE C1 DEVELOPMENT AT AREA B8, TKOIL 70 RP, TSEUNG KWAN O, NEW TERRITORIES		
CLIENT:		
美特鋁質有限公司 MIDA ALUMINIUM FABRICATOR LTD. Units 6-8 Sunny Industrial Centre, 610 Chee Kwo Ling Road, Kowloon Tel: 23489211-4 Fax: (852) 2727666		
S 银同有限公司 Silver Town Limited Tseung Kwan O Factory Building E-MAIL: ADDRESS@silvertown.com.hk		
DRAWING TITLE :		
[3SC-17]		
CAD File Name :		
Designed by		
Drawn by		
Reviewed by		
Approved by		
Scale		
DWG NO: (MM4)-2 - [3SC-17]		
REV.		B

修改说明:
1, 增加M5牙孔,长度减短。
2, 数量减1, 变为3SC-29.


构件编号: 3SC-19		构件数量: 1		构件重量: 41.45	
构件编号	规格(mm)	数量	单重(kg)	共重(kg)	表面积(m ²)
M378	PFC-100*40*10	1	41.45	41.45	1.13
合计: 41.45					

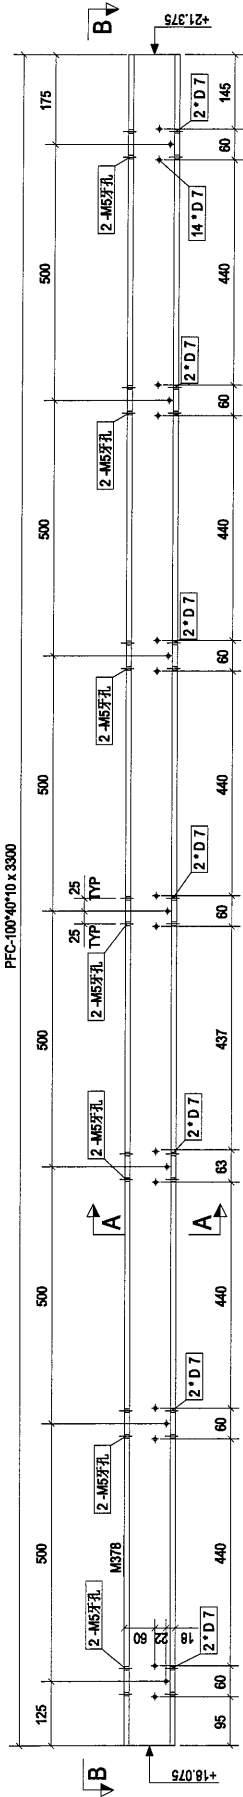

构件: 3SC-19

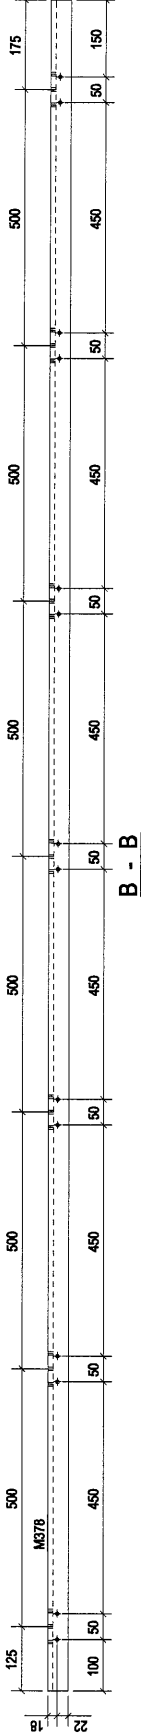



B - B

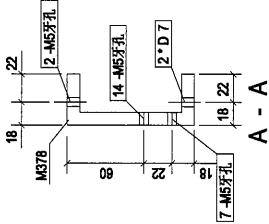

A - A

B	第3次报批	2018-11-05
Rev.	Description	Date
PROJECT:		
PROPOSED SITE C1 DEVELOPMENT AT AREA 88, TKOTIL 70 RP, TSEUNG KWAN O, NEW TERRITORIES		
CLIENT:		
美特铝质有限公司 MIDI ALUMINIUM FABRICATOR LTD. Units 5-8, Sunny Industrial Centre, T/F 810 Canton Road, Kwai Chung, Kowloon Tel: 23488211-4 Fax: (852) 2727866		
银同有限公司 Silver Town Limited Tel: 0769-8335488 Fax: 0769-8335854 E-MAIL: ADDRESS@silvertown.hk		
DRAWING TITLE :		
[3SC-19]		
CAD File Name :		
Designed by		
Drawn by		
Reviewed by		
Approved by		
Scale		
DWG NO.:	(WW4)-2	- [3SC-19]
REV	B	


零件编号:		SSC-20	零件数量:		1	零件重量:		8.38
零件编号		规格(mm)	数量	长度(mm)	重量(kg)	重量(kg)	重量(kg)	重量(kg)
M324		PLS155	800	1	4.87	4.87	0.24	
M463		RHS100*60*6.0	100	2	1.76	3.52	0.09	
合计:								8.38

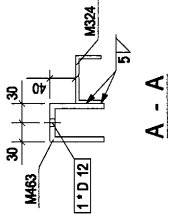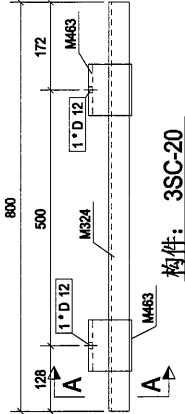


0	第1次提批	2018-07-04
Rev.	Description	Date
PROJECT:		
PROPOSED SITE C1 DEVELOPMENT AT AREA B8, TKOTL 70 RP, TSEUNG KWAN O, NEW TERRITORIES		
CLIENT:		
美特铝质有限公司 MIDALUMINUM FABRICATOR LTD. Units 6-8 Sunny Industrial Centre, 7/F, 610 Chee Kwo Ling Road, Kwun Tin, Tel: 23489211-4 Fax: (852) 27272665		
S 银同有限公司 Silver Town Limited Tel: 0769-3302598 Fax: 0769-3302594 E-Mail: ADMS@silvertown.hk.com		
DRAWING TITLE :		
[3SC-20]		
CAD File Name :		
Designed by		
Drawn by		
Reviewed by		
Approved by		
Scale		
DWG NO: (MW4)-2 - [3SC-20]		REV.
		0

构件编号:		3SC-21	构件数量:		1	构件重量:		8.38
操作编号	规格(mm)	数量	长度(mm)	重量(kg)	共重量(kg)	共长度(m)	共重量(kg)	共长度(m)
M324	PL5*155	1	800	4.87	4.87	0.24	4.87	0.24
M463	R4S100*50*1.0	2	100	1.76	3.52	0.03	3.52	0.03

合计: 8.38

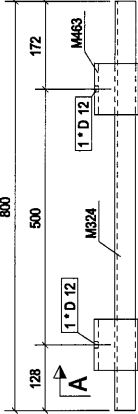

构件: 3SC-21

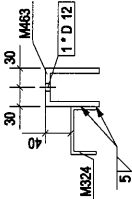


A - A

0	第1次报批	2018-07-04
Rev.	Description	Date
PROJECT: PROPOSED SITE C1 DEVELOPMENT AT AREA B8, TKOIL 70 RP, TSEUNG KWAN O, NEW TERRITORIES		
CLIENT: 美特鋁質有限公司 MID Unit 6-8, Survey Industrial Centre, 7/F 610, Chin Kwo Ling Road, Kowloon Tel: 23489211-4 Fax: (852) 27277666		
S 银同有限公司 Silver Town Limited Tel: 00853 23588600-23588604 E: MLC_00853@silvertown.hk, 10.0.0.0		
DRAWING TITLE : [3SC-21]		
CAD File Name :		
Designed by		
Drawn by		
Reviewed by		
Approved by		
Scale		
DWG NO: (WM4)-2 - [3SC-21]		REV. 0

修改说明:
1, 由3SC-8变来。


构件编号:	3SC-22	构件数量:	3	构件重量:	76.83
部件编号	规格(mm)	数量	单重(kg)	共重(kg)	表面积(m²)
M360	RHS160*80*6.0	1	76.83	76.83	1.69
合计:					76.83

RHS160*80*6.0 x 3412

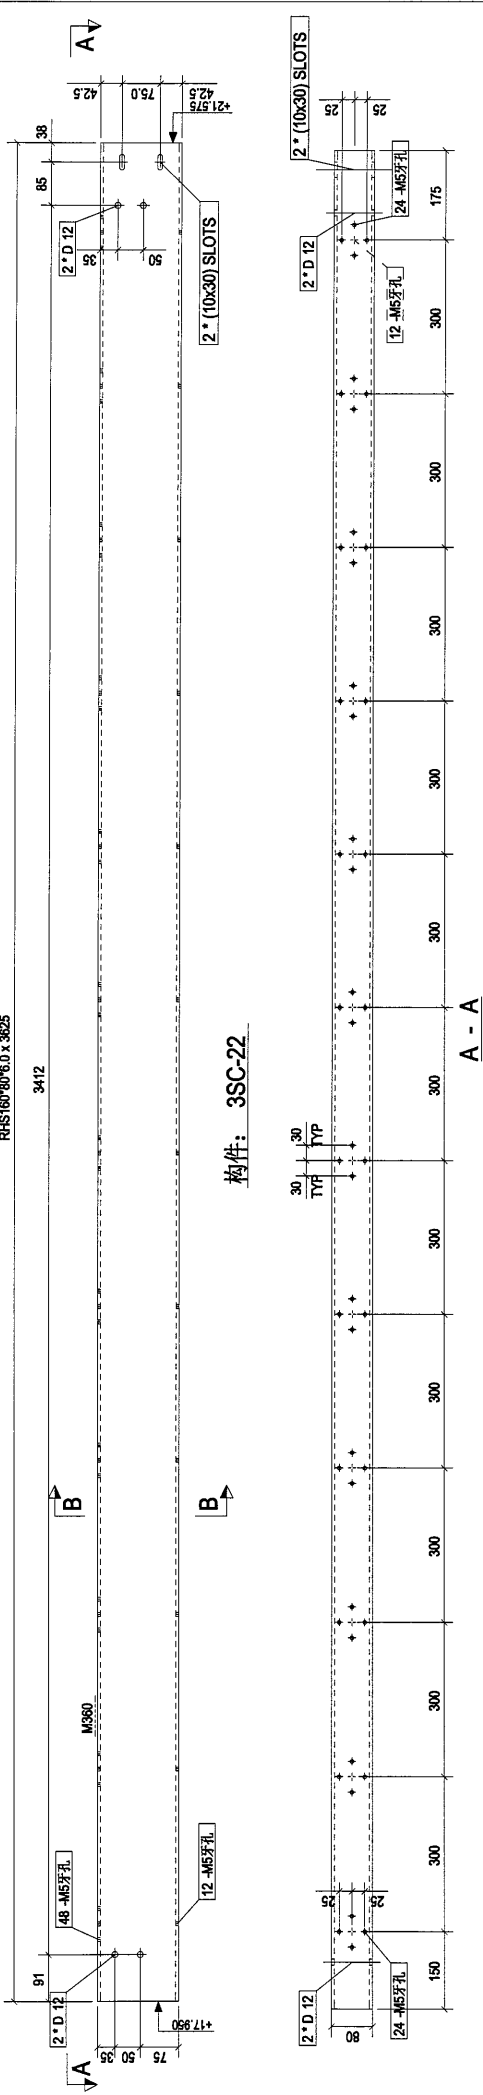

构件: 3SC-22

A - A

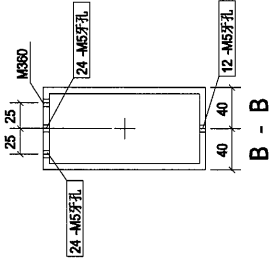


B - B

0	第1次报批	2018-11-09
Rev.	Description	Date
PROJECT: PROPOSED SITE C1 DEVELOPMENT AT AREA B8, TKOIL 70 RP, TSEUNG KWAN O, NEW TERRITORIES		
CLIENT: 美特铝质有限公司 MIDI ALUMINIUM FABRICATOR LTD. Units 6-8 Sunny Industrial Centre, 510 Che Kwo Ling Road, Kowloon Tel:2489211-4 Fax:(852)2727666		
S 银同有限公司 Silver Town Limited Tel:2786-6008 Fax:2786-600584 E-MAIL: info@silvertown.hk		
DRAWING TITLE : [3SC-22]		
CAD File Name :		
Designed by		
Drawn by		
Reviewed by		
Approved by		
Scale		
DWG NO: (MW4)-2 - [3SC-22]		REV. 0


修改说明:
1, 增加M5牙孔,长度减短。
2, 数量+1, 由3SC-8变来。

构件编号:	3SC-23	构件数量:	2	构件重量:	75.77
部件编号	规格(mm)	数量	单重(kg)	共重(kg)	表面积(m ²)
M860	RHS160*80*6.0	1	75.77	75.77	1.66
合计:					75.77

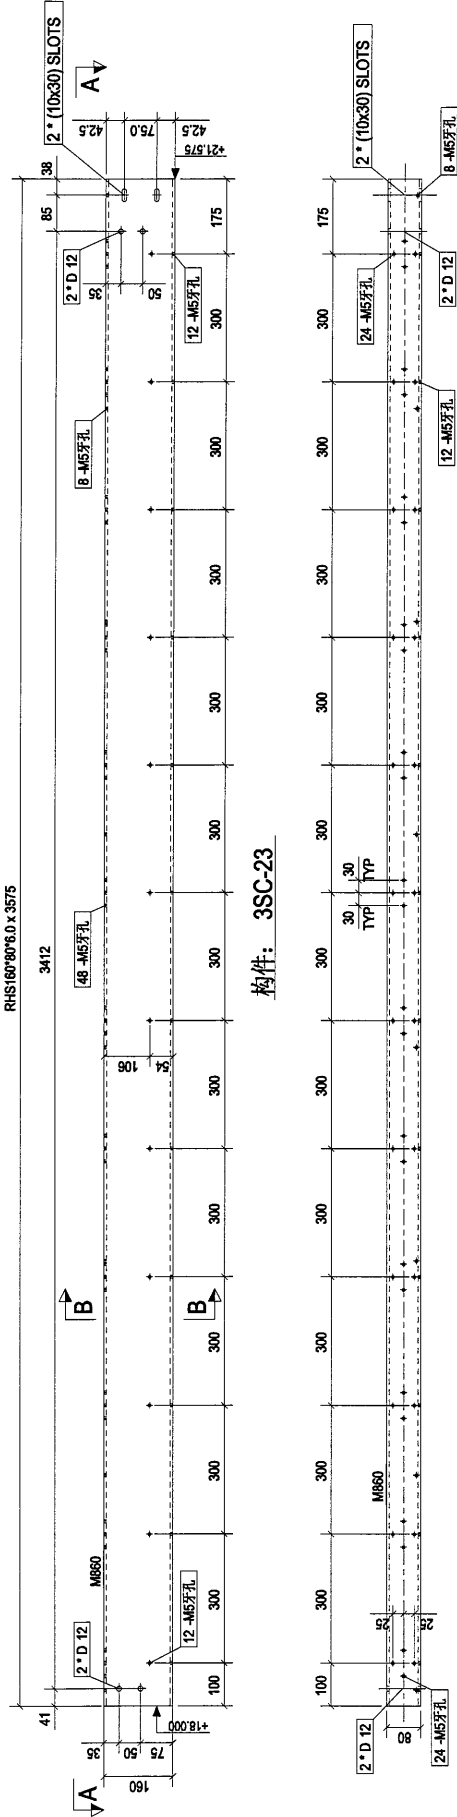

构件: 3SC-23

A - A

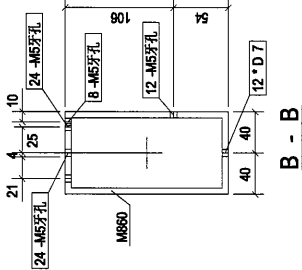


B	第3次报批	2018-11-05
Rev.	Description	Date
PROJECT:		
PROPOSED SITE C1 DEVELOPMENT AT AREA B8, TKOIL 70 RP, TSEUNG KWAN O, NEW TERRITORIES		
CLIENT:		
美特铝质有限公司 MIDI ALUMINIUM FABRICATOR LTD. Units 5-8, Sun Yee Industrial Centre, 1/F 610, Chin Kwe Leng Road, Kowloon Tel: 23489211-4, Fax: (852) 27272666		
S 银同有限公司 Silver Town Limited Tel: 0768-8335866, Fax: 0768-8335864 E-Mail: ADDRESS@silvertown.hk, 103.COM		
DRAWING TITLE :		
[3SC-23]		
CAD File Name :		
Designed by		
Drawn by		
Reviewed by		
Approved by		
Scale		
DWG NO: (WN4)-2 - [3SC-23]		REV
		B

修改说明:

- 1, 增加M5牙孔,长度减短。
- 2, 数量+1, 由3SC-8变来。


构件编号	3SC-24	构件数量	2	构件重量	75.77
部件编号	规格(mm)	数量	单重(kg)	共重(kg)	表面积(m ²)
M861	RHS160*80*6.0	1	75.77	75.77	1.66

合计: 75.77

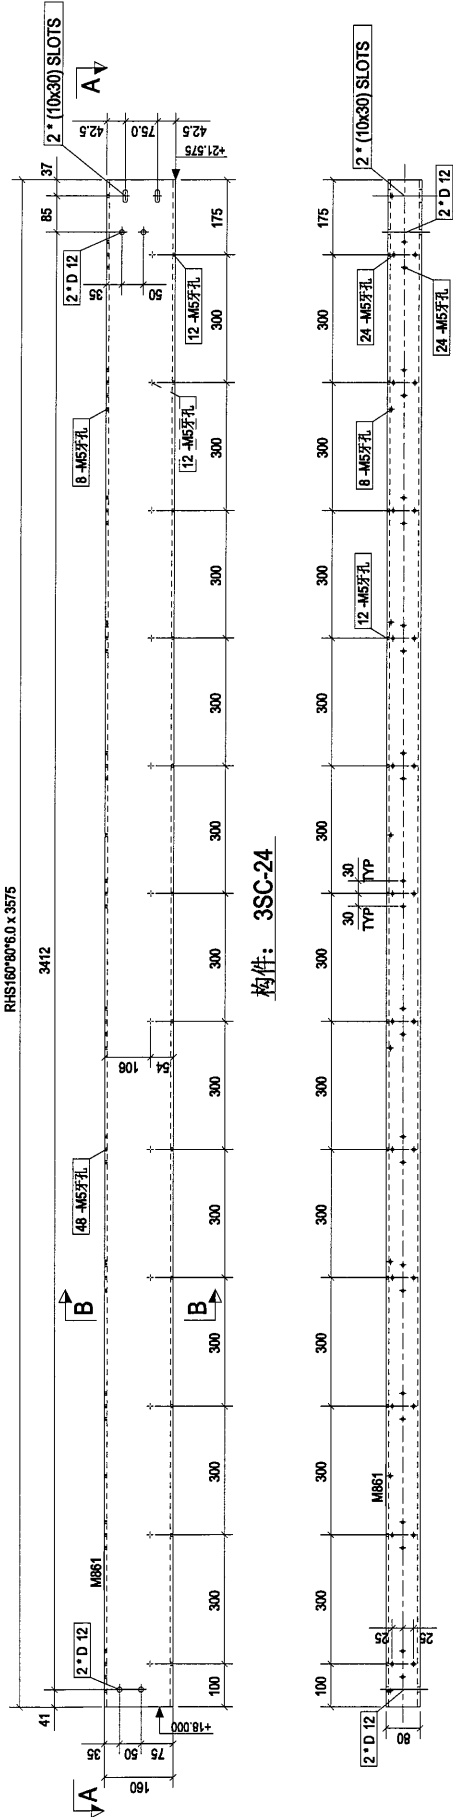



构件: 3SC-24

A - A

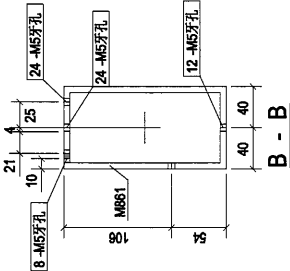

B	第3次设计	2018-11-05
Rev.	Description	Date
PROJECT: PROPOSED SITE C1 DEVELOPMENT AT AREA 86, TKOTI 70 RP, TSEUNG KWAN O, NEW TERRITORIES		
CLIENT: 美特铝质有限公司 MIDAL ALUMINIUM FABRICATOR LTD. Unit 5-8, Sun Yee Industrial Estate, 1/F 510, Chee Kwan Tong Road, Yuen Long Tel: 3489211-4, Fax: (852) 2727655		
S 银同有限公司 Silver Town Limited Tel: 0769-8335988 Fax: 0769-8335954 E-Mail: ADDRESS@silvertown.hk		
DRAWING TITLE: [3SC-24]		
CAD File Name:		
Designed by		
Drawn by		
Reviewed by		
Approved by		
Scale		
DWG NO: (WV4)-2 - [3SC-24]		
REV B		




构件编号:	3SC-25	构件数量:		1		构件重量:		90.17
部件编号	规格(mm)	长度(mm)	数量	单重(kg)	共重(kg)	表面重力(m ²)		
F92	PLT16*300	400	1	15.07	15.07	0.26		
M855	RHS160*80*0	3543	1	75.09	75.09	1.65		
					合计:		90.17	

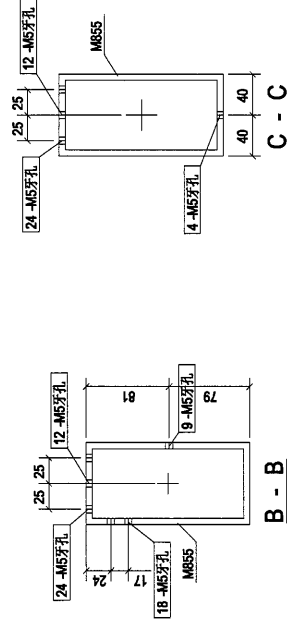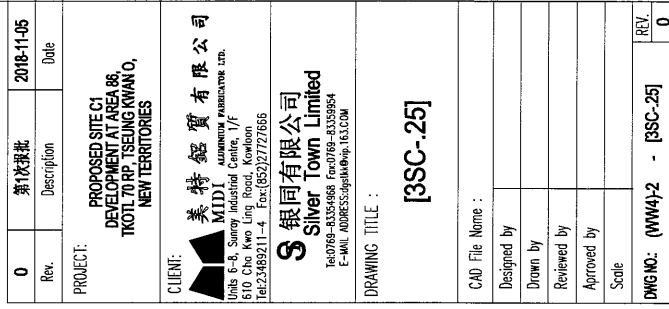

修改说明:
1, 由3SC-10变来。

构件编号: 3SC-26		构件数量: 1		构件重量: 115.60	
部件编号	规格(mm)	数量	单重(kg)	共重(kg)	表面积(m ²)
F82	PLT16*300	1	15.07	15.07	0.26
M1002	RHS160*80*6.0	1	100.53	100.53	2.21
		合计:		115.60	


4753 (RHS160*80*6.0 x 4743)

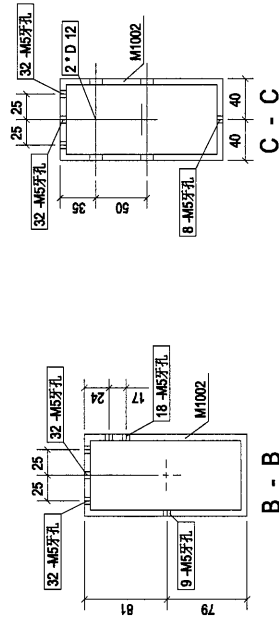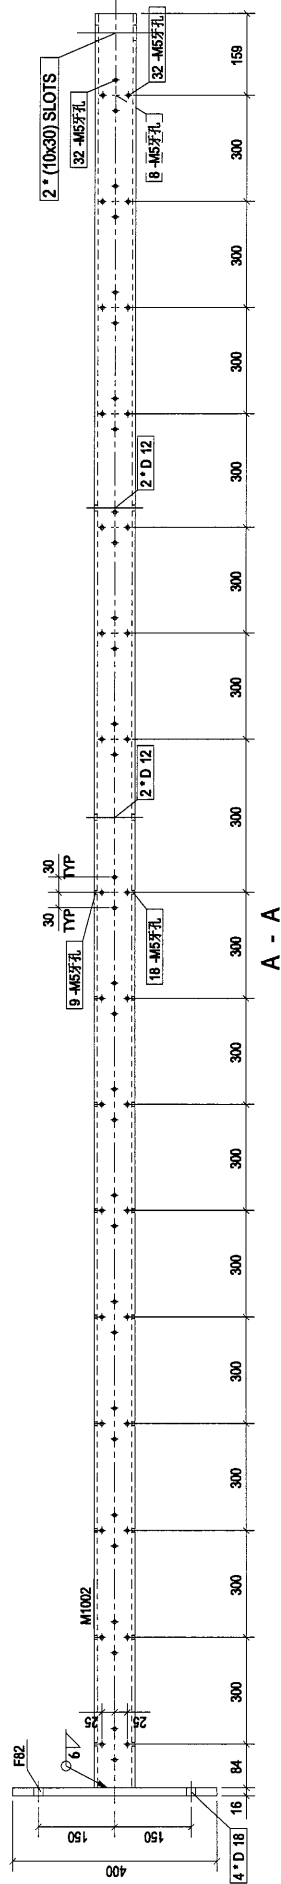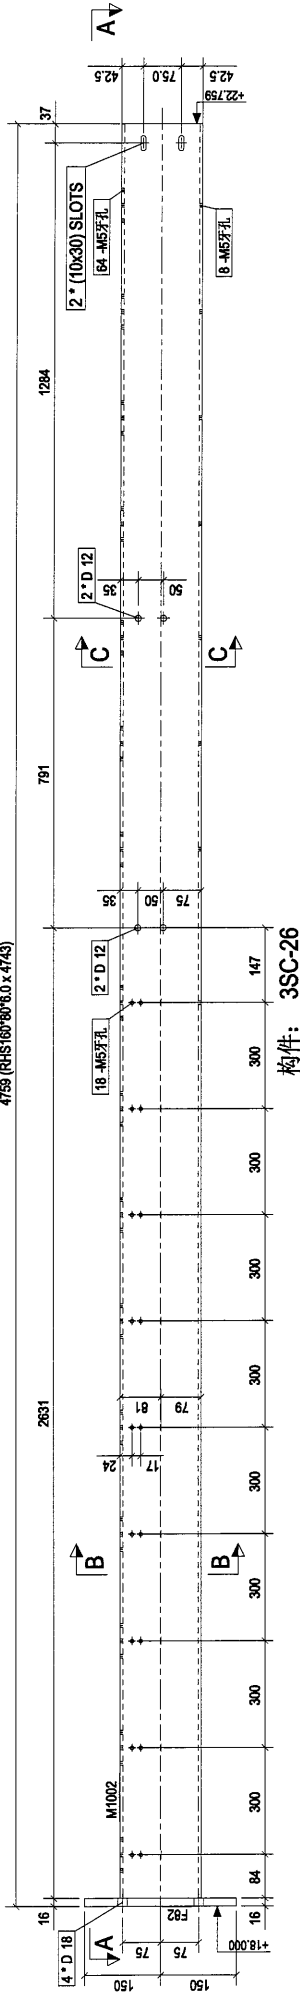


0	第1次设计	2018-11-05
Rev.	Description	Date
PROJECT:		
PROPOSED SITE C1 DEVELOPMENT AT AREA B6, TKOIL 70 RP, TSEUNG KWAN O, NEW TERRITORIES		
CLIENT:		
美特铝质有限公司 MIDI ALUMINIUM FABRICATOR LTD. Units 5-8, Sunny Industrial Centre, 1/F 610, Cheong Cheong Street Tseung Kwan O, New Territories Tel: 23469211-4, Fax: (852) 2727566		
S 银同有限公司 Silver Town Limited Tel: 0769-83535988 Fax: 0769-83535954 E-MAIL: ADMIN@silvertown.hk		
DRAWING TITLE :		
[3SC-26]		
CAD File Name :		
Designed by		
Drawn by		
Reviewed by		
Approved by		
Scale		
DWG NO: (MW4)-2 - [3SC-26]		REV
		0

修改说明:
1, 由3SC-2变来。

构件编号: 3SC-27		构件数量: 1		构件重量: 78.36	
部件编号	规格(mm)	数量	单重(kg)	共重(kg)	表面积(m²)
M278	RS450*50*5	14	0.38	5.31	0.02
M897	RHS160*80*6.3	1	73.05	73.05	1.53
合计:					78.36

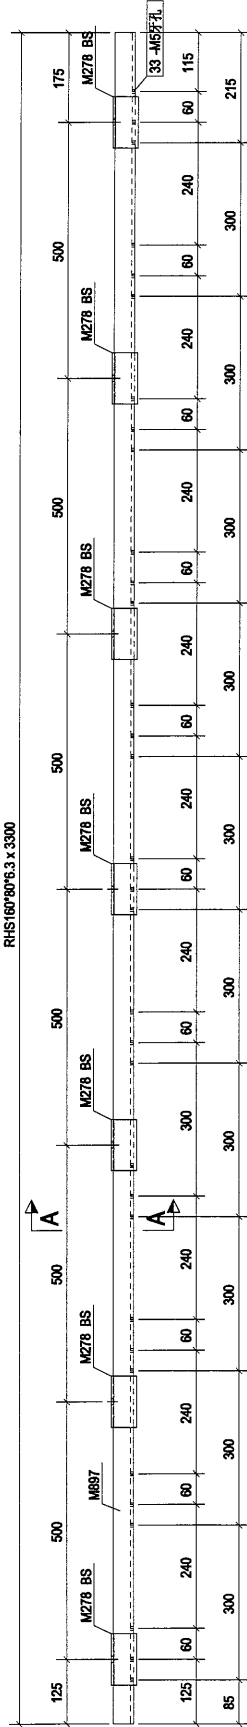




构件: 3SC-27

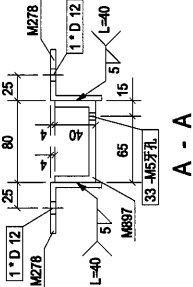

0	第1次报批	2018-11-05
Rev.	Description	Date
PROJECT: PROPOSED SITE C1 DEVELOPMENT AT AREA B8, TKOIL 70 RP, TSEUNG KWAN O, NEW TERRITORIES		
CLIENT:  美特鋁質有限公司 MIDI UNIT 5-8, Sunny Industrial Centre, 1/F 610 Chee Kwo Ling Road, Kwailoon Tel: 23499211-4 Fax: (852) 27272666 E-MAIL: ADDRESS@midialuminum.com.hk		
 银同有限公司 Silver Town Limited Tel: 0789-8355468 Fax: 0789-8338854 E-MAIL: ADDRESS@silvertown.hk		
DRAWING TITLE : [3SC-27]		
CAD File Name :		
Designed by		
Drawn by		
Reviewed by		
Approved by		
Scale		
DWG NO.: (WM4)-2 - [3SC-27]		REV. 0

修改说明:
1, 由3SC-10变来。

构件编号: 3SC-32		构件数量: 1		构件重量: 44.11	
部件编号	规格(mm)	数量	单重(kg)	共重(kg)	表面积(m²)
M871	RHS160*80*6.0	1	44.11	44.11	0.97
合计: 44.11					

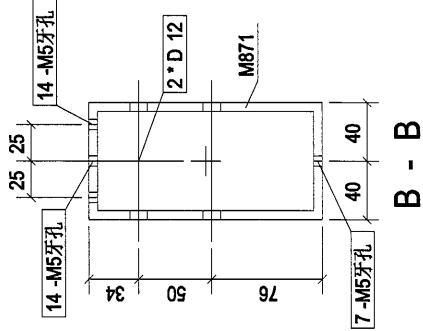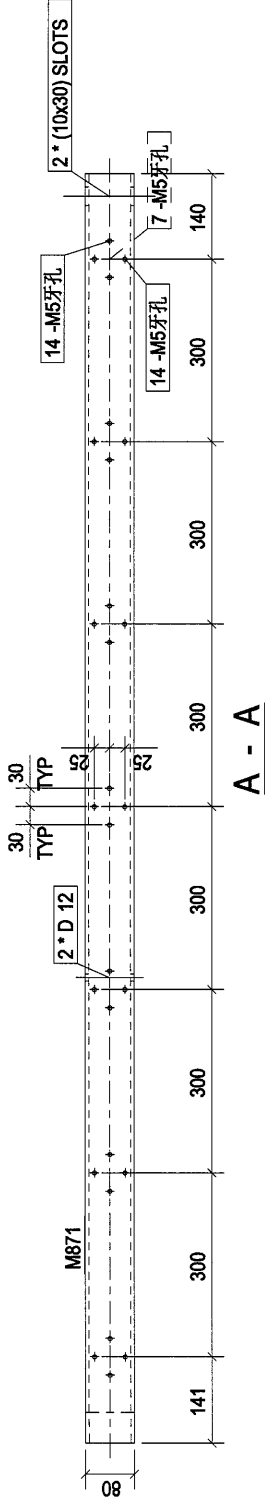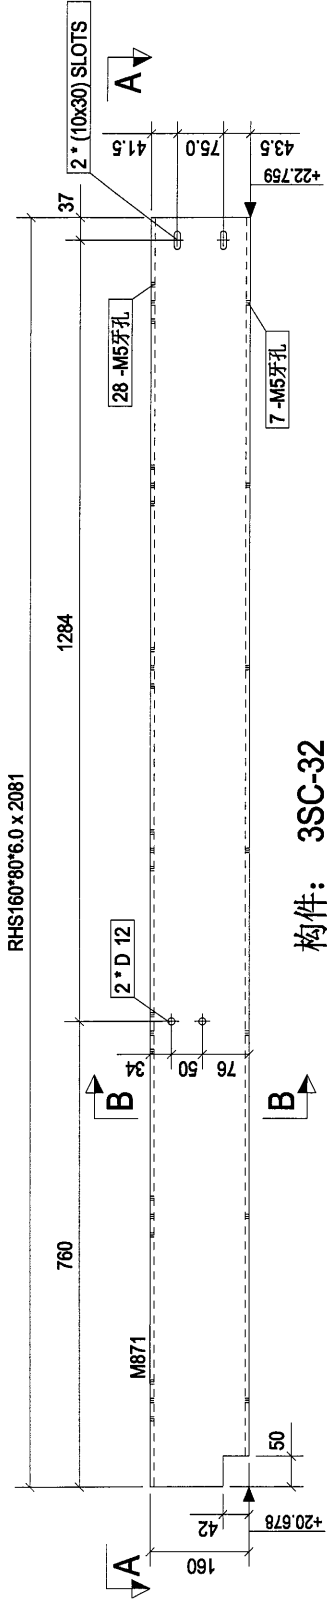

0	第一次报批	2018-11-05
Rev.	Description	Date
PROJECT: PROPOSED SITE C1 DEVELOPMENT AT AREA B8, TKOIL 70 RP, TSEUNG KWAN O, NEW TERRORIES		
CLIENT: 美特铝质有限公司 MIDI ALUMINIUM FABRICATOR LTD. Units 6-8 Sun Chai Industrial Centre, 7/F 610 Chee Kwo Ling Road, Kwun Tong Tel: 23489211-4 Fax: (852) 2727666		
S 银同有限公司 Silver Town Limited Tel: 40789-4335988 Fax: 40789-4335954 E-Mail: ADMIN@silvertown.hk		
DRAWING TITLE : [3SC-32]		
CAD File Name :		
Designed by		
Drawn by		
Reviewed by		
Approved by		
Scale		
DWG NO: (MMW4)-2 - [3SC-32]		
REV. 0		

1, 由3SC-7变来。

合计:	18.67
-----	-------

PROJECT:

CLIENT:

MIDI
ALUMINIUM FABRICATOR LTD.

000-17-17(000)ubd / 11 Bureau of Census

000-17-17(000)ub / 11 Bureau of Census

中國銀行有限公司

Silver Town Limited

Y-1 0750 07754060 F. 0750 07500000
DAILY 11AM 12PM

TEL: 0769-8334968 FAX: 0769-8339954
E-MAIL ADDRESS: doct@163.COM

U.S. DEPARTMENT OF AGRICULTURE

DRAWING TITLE :

100

3300

35-33

1

100

Table 2

LAD File Name :

Discussed by _____

Designed by

Drawn by

	by
--	----

Reviewed by

[illegible]

Approved by _____

Code	
------	--

scale



[illegible]

DWG NO.: (VVV4)-2 - [35C-33]

修改说明:

1, 由3SC-7变来。

构件编号:		35C-34		构件数量:		1		构件重量:		52.63			
部件编号		规格(mm)		长度(mm)		数量		单重(kg)		共重(kg)		表面面积(m ²)	
M873		RHS160*80*6.0		2483		1		52.63		52.63		1.15	
										合计:		52.63	

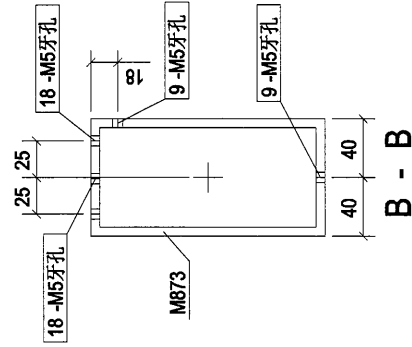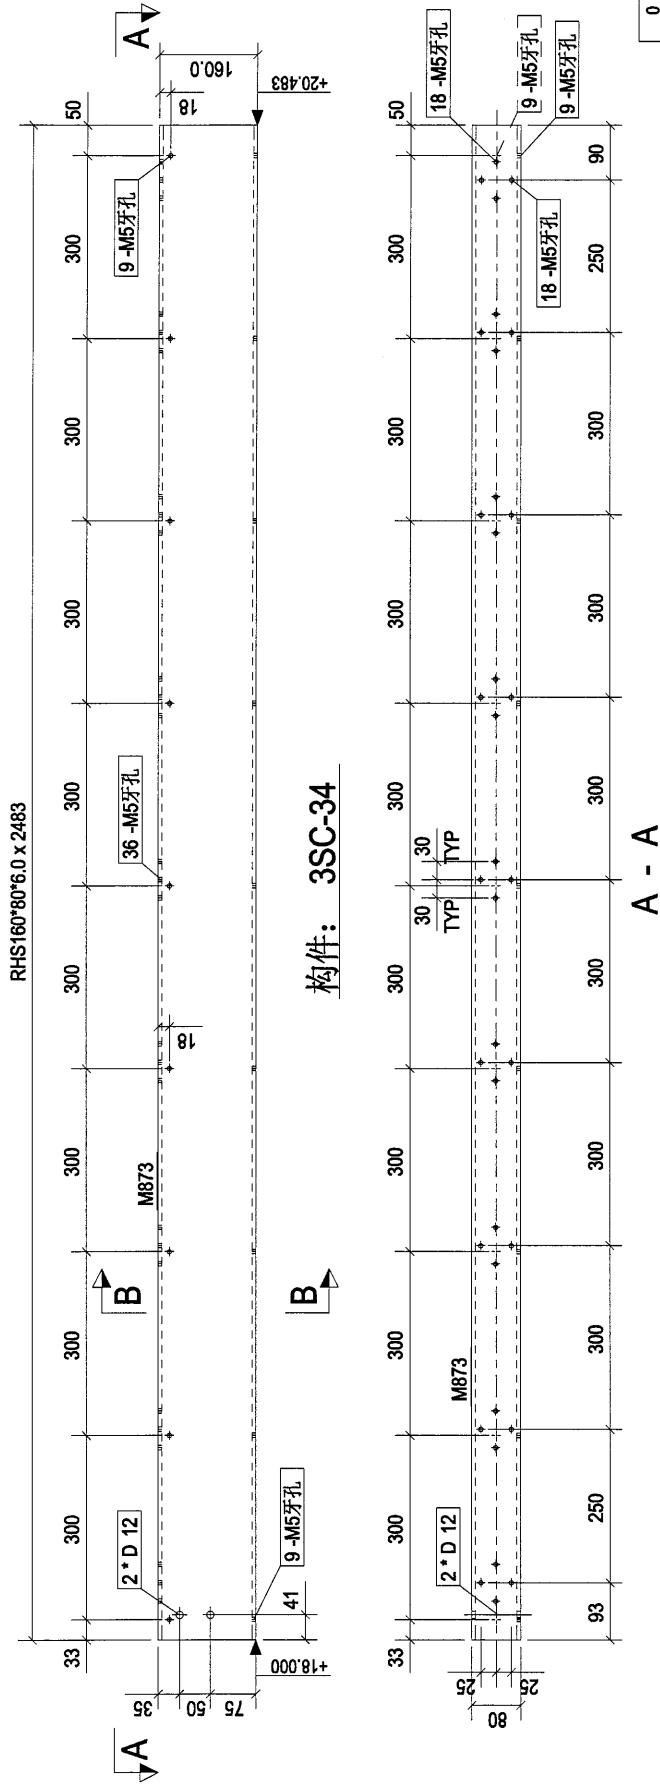

0	第1次招標	2018-11-05
Rev.	Description	Date

PROJECT:	PROPOSED SITE C1 DEVELOPMENT AT AREA 88, TKOIT 70 RP, TSUNG KWAN O, NEW TERRITORIES
----------	--

CUSTOMER:	 美特鋁質有限公司 MIDT ALUMINIUM MANUFACTURER LTD. Units 6-8, Sunny Industrial Centre, 1/F, 610 Cha Kwo Ling Road, Kowloon Tel: 23489211-4 Fax: (852) 27727656
-----------	---


 Silver Town Limited TAOJIAO-3115068 FAX: 83-83554 E-MAIL ADDRESS: Sg@silvertown.hk	銀同有限公司 Silver Town Limited
---	-------------------------------

DRAWING TITLE :	[3SC--34]
-----------------	-----------


CAD File Name :	
Designed by	
Drawn by	
Reviewed by	
Approved by	
Scale	

DWG NO.:	(WW4)-2	[3SC-34]	REV.	
----------	---------	----------	------	--

构件编号:	3SJ-1	构件数量:	16	构件重量:	0.38
零件编号	规格(mm)	数量	单重(kg)	共重(kg)	深孔(mm)
M277	RS450*50*5	1	0.38	0.38	0.02
合计:					0.38


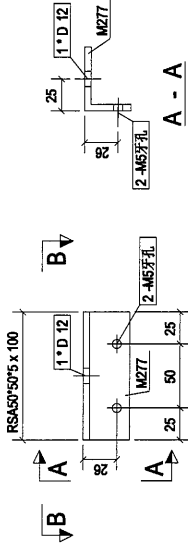


构件: 3SJ-1

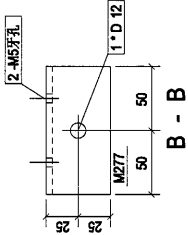

0	第1次设计	2018-07-04
Rev.	Description	Date
PROJECT:		
PROPOSED SITE C1 DEVELOPMENT AT AREA B8, TKOIL 70 RP, TSEUNG KWAN O, NEW TERRITORIES		
CLIENT:		
美特铝质有限公司 MIDI ALUMINIUM FABRICATOR LTD. Unit 5-8, Sunny Industrial Centre, 1/F 610, Cheong Cheong Road, Tseung Kwan O, New Territories Tel: 2348211-4, Fax: (852) 2727666		
S 银同有限公司 Silver Town Limited Tel: 0769-8339888, Fax: 0769-8339884 E-Mail: ADDRESS@silvertown.hk, 03.COM		
DRAWING TITLE :		
[3SJ-1]		
CAD File Name :		
Designed by		
Drawn by		
Reviewed by		
Approved by		
Scale		
DWG NO: (WVW4)2 - [3SJ-1]		
REV		
0		


修改说明:
1, 修改孔径。

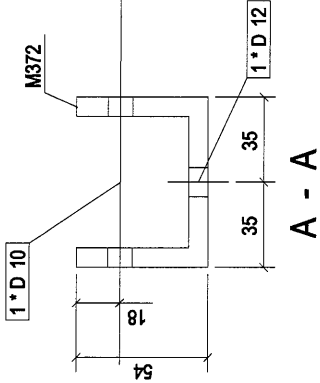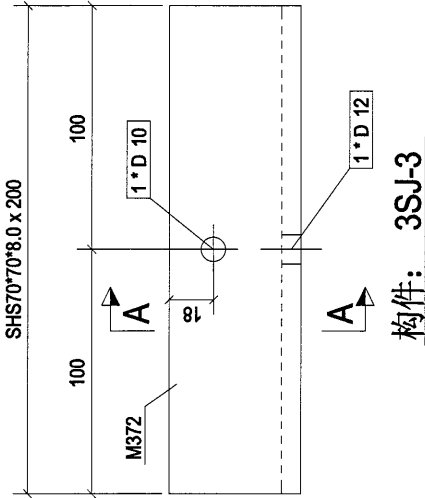

构件编号: 3SJ-3		构件数量: 2		构件重量: 3.01	
部件编号	规格(mm)	数量	单重(kg)	共重(kg)	表面积(m²)
M372	SHS70*70*8.0	1	3.01	3.01	0.05
合计:				3.01	

A	第2次报批	2018-11-05
Rev.	Description	Date
PROJECT: PROPOSED SITE C1 DEVELOPMENT AT AREA 88, TKOTL 70 RP, TSEING KWAN O, NEW TERRITORIES		
CLIENT:  美特铝质有限公司 MTDI ALUMINUM FABRICATOR LTD. Rm 6-3, Sunny Industrial Centre, 1/F 810 Chai Wan Road, Chai Wan, Hong Kong Tel: 23489211-4 Fax: (852) 2772 6666		
 银同有限公司 Silver Town Limited Tel: 0789-8335988 Fax: 0789-8335954 E-MAIL: ADDRESS@silvertown.hk, HK.COM		
DRAWING TITLE : [3SJ-3]		
CAD File Name :		
Designed by		
Drawn by		
Reviewed by		
Approved by		
Scale		
DWG NO.: (WWW)-2 - [3SJ-3]		REV A

零件编号:	3SJ-4	零件数量:	16	构件重量:	0.47
零件编号	材料(mm)	数量	重量(kg)	长度(mm)	重量(kg)
M585	RS475*50*5	1	0.47	100	0.03
合计:					0.47

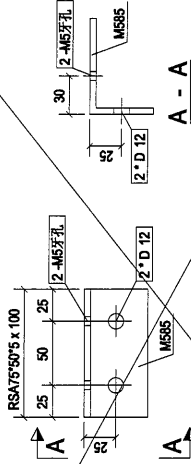


构件: 3SJ-4

取消

A	第2次提批	2018-11-10
Rev.	Description	Date
PROJECT:		
PROPOSED SITE C1 DEVELOPMENT AT AREA 86, TKOTI 70 RP, TSEUNG KWAN O, NEW TERRITORIES		
CLIENT:		
美特鋁質有限公司 MIDI ALUMINIUM FABRICATOR LTD. Units 6-8, Sunny Industrial Centre, 1/F 810, Cheung Nin Road, Cheung Pai, Tai Po, New Territories Tel: 23489211-4, Fax: (852) 2777666		
S 銀同有限公司 Silver Town Limited Tel: 2768-8335/888 Fax: 2768-8335/854 E-MAIL: ADDRESS: agata@sp.163.com		
DRAWING TITLE :		
[3SJ-4]		
CAD File Name :		
Designed by		
Drawn by		
Reviewed by		
Approved by		
Scale		
DWG NO: (WW4)-2 - [3SJ-4]		REV
		10


构件编号: 3SJ-7		构件数量: 49		构件重量: 0.47	
部件编号	规格(mm)	数量	单重(kg)	共重(kg)	表面积(m²)
M585	RSA75*50*5	100	1	0.47	0.03
合计:					0.47

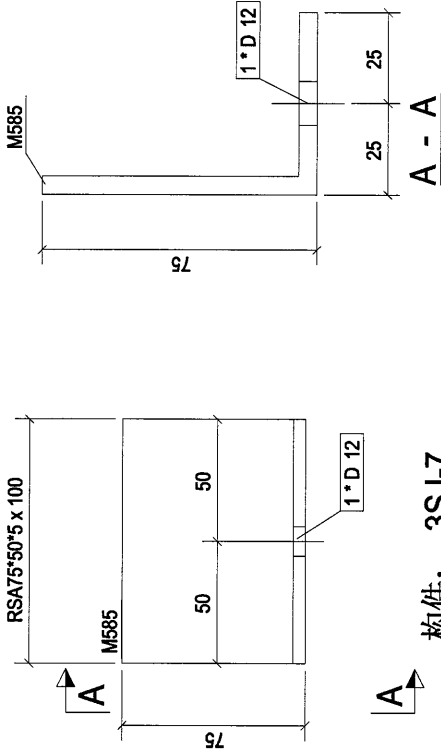

构件: 3SJ-7

0	第1次提批	2018-11-09
Rev.	Description	Date
PROJECT: PROPOSED SITE C1 DEVELOPMENT AT AREA 86, TKOTI, 70 RP, TSEUNG KWAN O, NEW TERRITORIES		
CLIENT:  美特鋁質有限公司 MIDI ALUMINIUM FABRICATOR LTD. Units C-8, Sunny Industrial Centre, 1/F 810 Cheong Cheong Street Tseung Kwan O, New Territories Tel: 23480211-4 Fax: (852) 2772666		
 銀同有限公司 Silver Town Limited Tel: 0769-8335968 Fax: 0769-8335964 E-MAIL: ADDRESS@silvertown.hk		
DRAWING TITLE : [3SJ-7]		
CAD File Name :		
Designed by		
Drawn by		
Reviewed by		
Approved by		
Scale		
DWG NO.: (WWW)-2 - [3SJ-7]		REV. 0

修改说明:
1, 由3SC-19的角码变来。

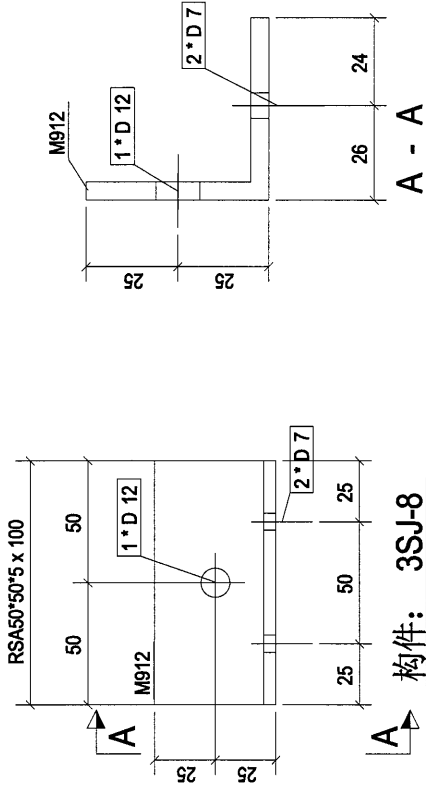


构件编号: 3SJ-8		构件数量: 14		构件重量: 0.38	
部件编号	规格(mm)	数量	单重(kg)	共重(kg)	表面积(m ²)
M912	RSA50*50*5	1	0.38	0.38	0.02
合计:				0.38	

0	第1次报批	2018-11-10
Rev.	Description	Date
PROJECT: PROPOSED SITE C1 DEVELOPMENT AT AREA B8, TKOIL 70 RP, TSEUNG KWAN O, NEW TERRITORIES		
CLIENT: 華特銘實有限公司 MID1 610 Che Kwo Ling Road, Kowloon Tel:22489211-4 Fax:(852)2727666		
S 銀同有限公司 Silver Town Limited Tel:2769 4334/669 Fax:2769 4336/664 E-MAIL ADDRESS:silvertown@163.com		
DRAWING TITLE : [3SJ-8]		
CAD File Name :		
Designed by		
Drawn by		
Reviewed by		
Approved by		
Scale		
DWG NO.: (WM4)-2 - [3SJ-8]		REV. 0

构件编号: 3SJ-10		构件数量: 1		构件重量: 4.30	
部件编号	规格(mm)	数量	单重(kg)	共重(kg)	表面积(m ²)
M893	PL5*100	1	4.30	4.30	0.23
合计:					4.30

~~HOLD~~

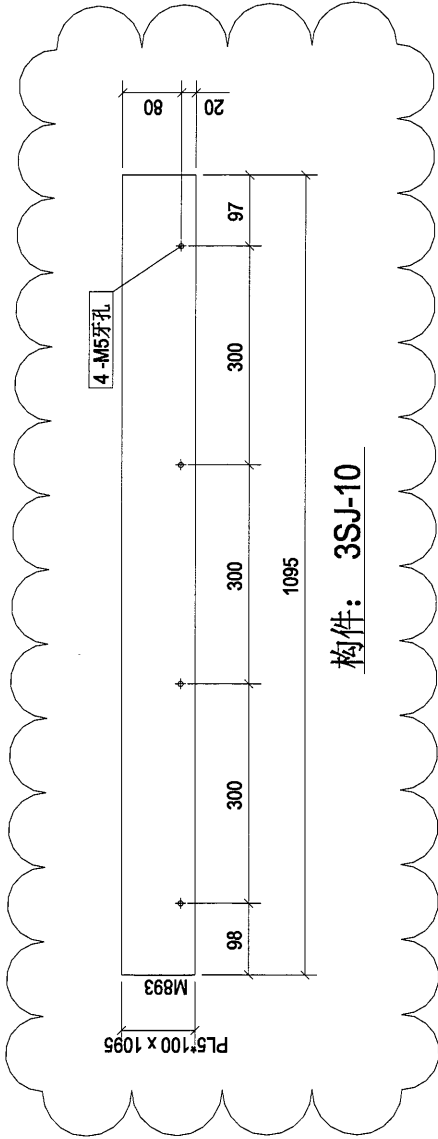


构件: 3SJ-10

0	第1次提批	2018-11-10
Rev.	Description	Date
PROJECT: PROPOSED SITE C1 DEVELOPMENT AT AREA 86, TKOTL 70 RP, TSEUNG KWAN O, NEW TERRITORIES		
CLIENT: 美特铝质有限公司 MIDI ALUMINIUM FABRICATOR LTD. Units 6-8, Sunny Industrial Centre, 1/F 60 Tin Yee Street, Chung Hong Road, Tseung Kwan O, New Territories Tel: 23489211-4 Fax: (852) 2727666		
S 银同有限公司 Silver Town Limited Tel: 0789-8335498 Fax: 0789-8335954 E-Mail: ADDRESS@silvertown.hk		
DRAWING TITLE : [3SJ-10]		
CAD File Name :		
Designed by		
Drawn by		
Reviewed by		
Approved by		
Scale		
DWG NO: (WMA)2 - [3SJ-10]		REV. 0

构件编号: 3SJ-11		构件数量: 1		构件重量: 6.32	
部件编号	规格(mm)	数量	单重(kg)	共重(kg)	表面积(m²)
M895	PL5*100	1	6.32	6.32	0.34
合计:					6.32


~~HOLD~~

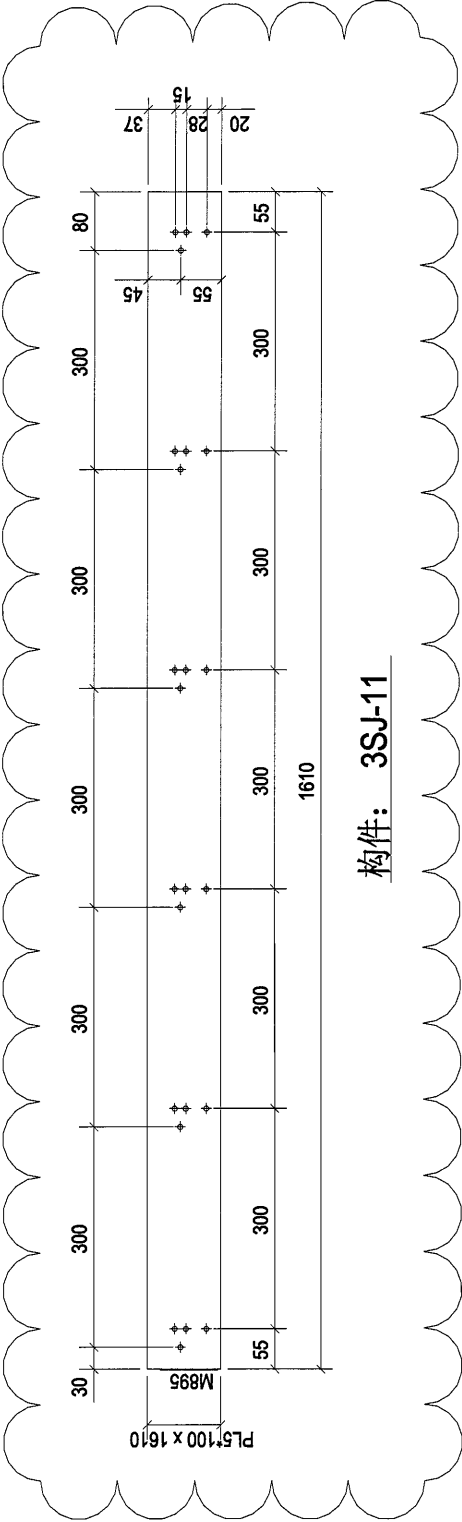

构件: 3SJ-11

0	第1次报批	2018-11-10
Rev.	Description	Date
PROJECT: PROPOSED SITE C1 DEVELOPMENT AT AREA 86, TKOIL 70 RD, TSEUNG KWAN O, NEW TERRITORIES		
CLIENT:  美特铝质有限公司 MIDI ALUMINIUM FABRICATOR LTD. Unit 6-8, Sun Jang Industrial Centre, / F 610, Chi Kuo Iang Road, Kowloon Tel: 2489211-4, Fax: (852) 2777666		
 银同有限公司 Silver Town Limited Tel: 0789-3335968 Fax: 0789-3335964 E-Mail: address@silvertown.hk, hk.com		
DRAWING TITLE : [3SJ-11]		
CAD File Name :		
Designed by		
Drawn by		
Reviewed by		
Approved by		
Scale		
DWG NO: (WVA)-2 - [3SJ-11]		REV 0


构件编号: 3SJ-12		构件数量: 1		构件重量: 3.77	
部件编号 M984	规格(mm)	数量	单重(kg)	共重(kg)	表面积(m²)
	PL6*66	1	3.77	3.77	0.18
合计: 3.77					

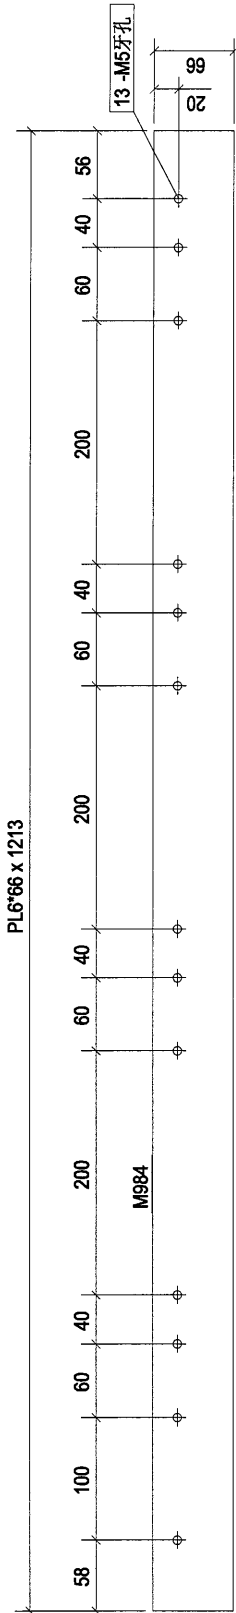

构件: 3SJ-12

0	第一次提批	2018-11-05
Rev.	Description	Date
PROJECT: PROPOSED SITE C1 DEVELOPMENT AT AREA B6, TKOTL 70 RP, TSEUNG KWAN O, NEW TERRITORIES		
CLIENT:  美特铝质有限公司 MIDI ALUMINIUM FABRICATOR LTD. Units E & G, Sunny Industrial Centre, 1/F 610, Cheong Cheong Street, Kwun Tong Tel: 23489211-4, Fax: (852) 2727666		
 银同有限公司 Silver Town Limited Tel: 43769-83351988 Fax: 43769-83359554 E-MAIL: ADONIS@silvertown.hk		
DRAWING TITLE : [3SJ-12]		
CAD File Name :		
Designed by		
Drawn by		
Reviewed by		
Approved by		
Scale		
DWG NO: (MWA)-2 - [3SJ-12]		
REV.		
0		

构件编号: 3SP-1		构件数量: 14		构件重量: 15.07	
零件编号	规格(mm)	数量	单重(kg)	共重(kg)	表面积(m²)
F82	PLT16*300	1	15.07	15.07	0.26
合计: 15.07					

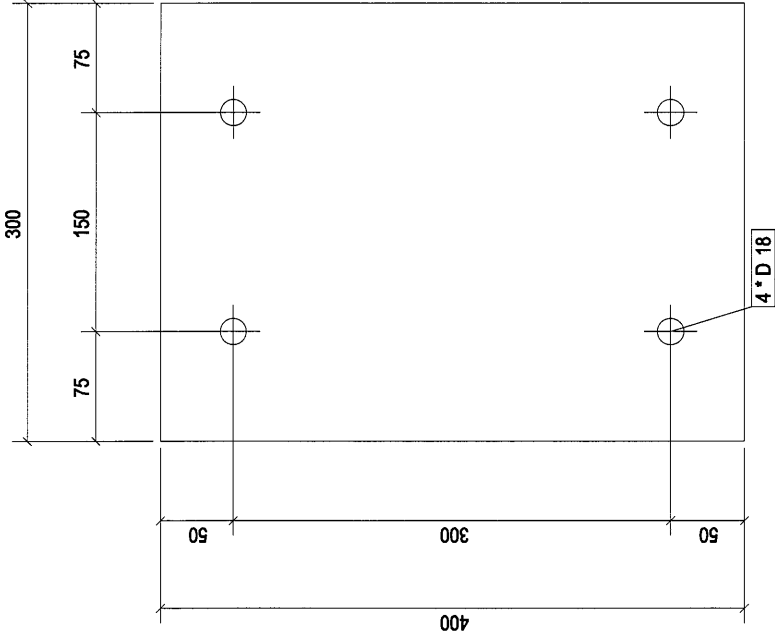


构件: 3SP-1


0	第1次报批	2018-11-05
Rev.	Description	Date
PROJECT: PROPOSED SITE C1 DEVELOPMENT AT AREA B8, TKOIL 70 RP, TSEUNG KWAN O, NEW TERRORIES		
CLIENT:  美特铝质有限公司 MIDI ALUMINUM FABRICATOR LTD. Units 6-8, Sun Hei Industrial Building, 610 Chee Koo Ling Road, Kowloon Tel:23489211-4, Fax:(852)27277666		
 银同有限公司 Silver Town Limited TAI WING STREET, TAI WING FACTORY, 235995 E-MIL: ADDRESS@silvertown.hk, HK.COM		
DRAWING TITLE : [3SP-1]		
CAD File Name :		
Designed by		
Drawn by		
Reviewed by		
Approved by		
Scale		
DWG NO: (WM4)-2 - [3SP-1]		REV. 0

材料编号:		3SU-1	构件数量:		1	构件重量:		41.93
材料编号		规格(mm)	数量		重量(kg)	共重(kg)		注(说明)
M156		RS4100*50*8	230		2.05	6.15		0.07
M384		RHS150*75*6.0	1783		35.78	35.78		0.35

合计: 41.93

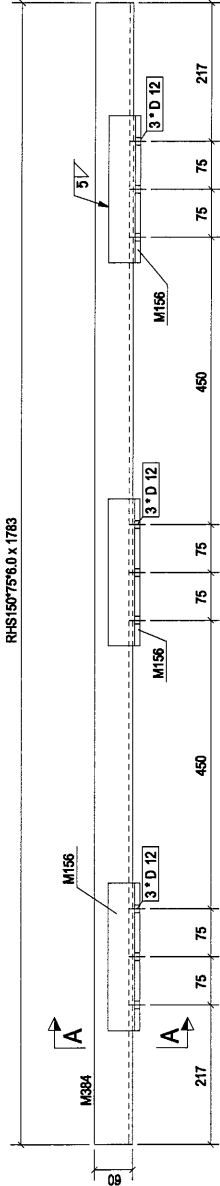


构件: 3SU-1

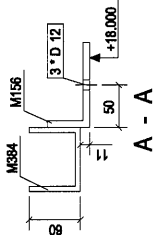


0	第一次报批	2018-07-04
Rev.	Description	Date
PROJECT: PROPOSED SITE C1 DEVELOPMENT AT AREA B8, TKOTL 70 RP, TSEUNG KWAN O, NEW TERRITORIES		
CLIENT: 美特铝质有限公司 MIDI ALUMINIUM MANUFACTURE LTD. Units 5-8 Sun Hei Industrial Centre 7/ 610 Che Kwo Ling Road, Kwun Tong Tel: 23489211-4 Fax: (852) 27272666		
S 银同有限公司 Silver Town Limited Tel: 0755-8305596 Fax: 0755-8305594 E-MAIL: JHJRESS@silvertown.com		
DRAWING TITLE : [3SU-1]		
CAD File Name :		
Designed by		
Drawn by		
Reviewed by		
Approved by		
Scale		
DWG NO: (MW4)-2 - [3SU-1]		REV. 0

构件编号:		SSU-2	构件数量:		1	构件重量:		41.90
材料编号	规格(mm)	长度(mm)	重量	单重(kg)	重量	单重(kg)	重量(kg)	长度(m)
M156	RS100*50*8	230	3	2.05	6.15	6.15	0.07	
M386	RHS150*75*6.0	1781	1	35.74	35.74	35.74	0.35	
合计:								41.90

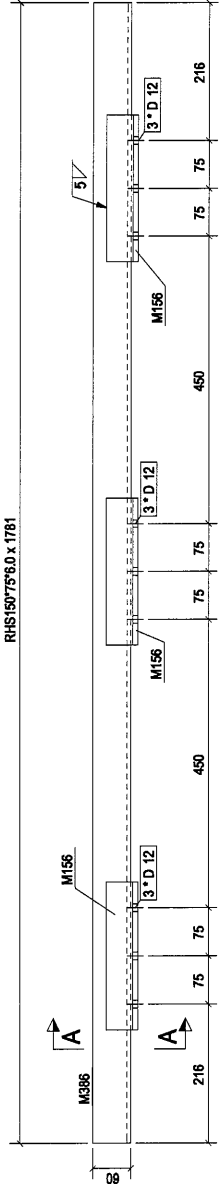


构件: 3SU-2

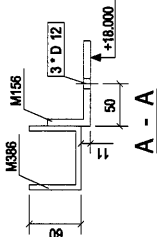


0	第1次提批	2018-07-04
Rev.	Description	Date
PROJECT: PROPOSED SITE C1 DEVELOPMENT AT AREA B8, TKOIL 70 RP, TSEUNG KWAN O, NEW TERRITORIES		
CLIENT:  美特铝质有限公司 MIDI ALUMINIUM FABRICATOR LTD. Units 5-8, Sunny Industrial Centre, 1/F 610, Cheong Cheong Street, Tseung Kwan O, New Territories Tel: 2348211-4, Fax: (852) 2727666		
 银同有限公司 Silver Town Limited Tel: 0789-8334988, Fax: 0789-8335954 E-Mail: ADMIN@silvertown.hk, HK.COM		
DRAWING TITLE : [3SU-2]		
CAD File Name :		
Designed by		
Drawn by		
Reviewed by		
Approved by		
Scale		
DWG NO: (WM4)-2 - [3SU-2]		REV
		0

材料编号:		3SU-3	构件数量:		3	构件重量:		41.97
材料编号	规格(mm)	重量(kg)	长度(mm)	数量	重量(kg)	长度(mm)	重量(kg)	
M156	RSA100*50*8	230	3	2.05	6.15	0.07		
M437	RHS150*75*6.0	1765	1	35.82	35.82	0.35		
合计:								41.97

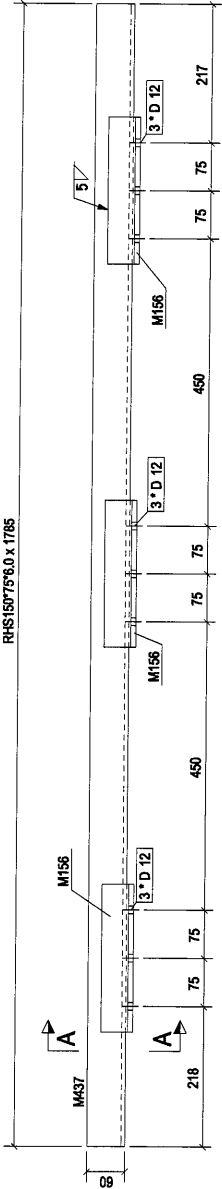


构件: 3SU-3

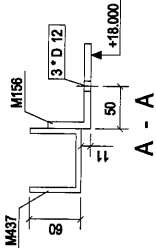


0	第一次报批	2018-07-04
Rev	Description	Date
PROJECT: PROPOSED SITE C1 DEVELOPMENT AT AREA B8, TROTIL TO RE TSEUNG KWAN O, NEW TERRITORIES		
CLIENT: 美特鋁質有限公司 MIDI ALUMINIUM FABRICATORS LTD. Units 6-8, Sunny Industrial Centre, 1/F 510 Cho Kwo Ling Road, Kowloon Tel: 2469211-4 Fax: (852) 27272686		
S 银同有限公司 Silver Town Limited Tel: 0769-83354868 Fax: 0769-83359554 E-MAIL: ADDRESS@silvertown.hk 163.COM		
DRAWING TITLE : [3SU-3]		
CAD File Name :		
Designed by		
Drawn by		
Reviewed by		
Approved by		
Scale		
DWG NO.: (WW4)-2 - [3SU-3]	REV.	0

修改说明:
1, 角码移位。

RHS150*75*6.0 x 1782

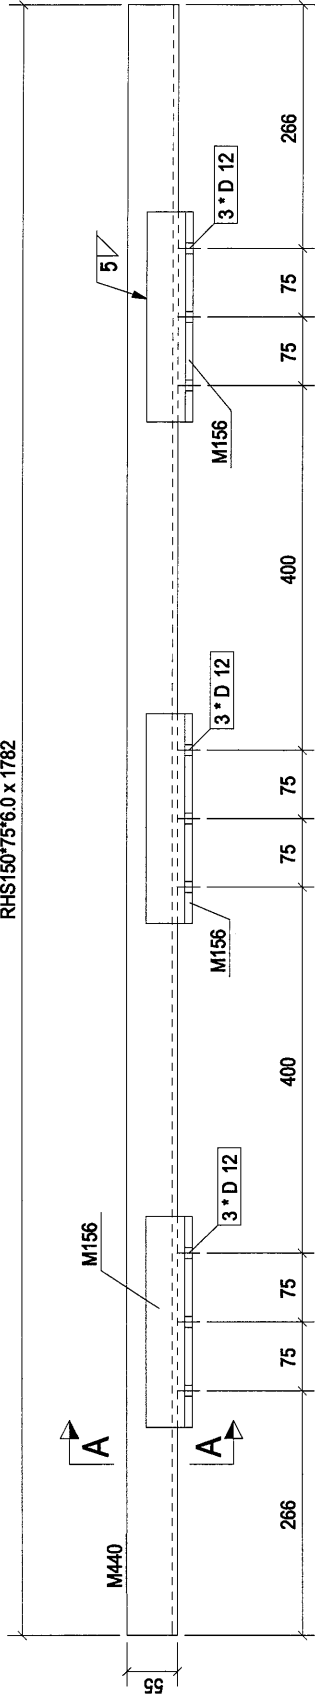


构件: 3SU-5

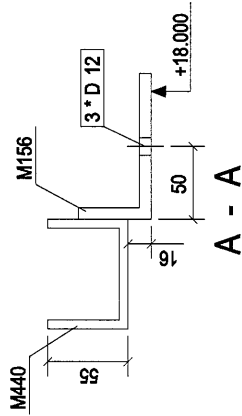

构件编号: 3SU-5		构件数量: 1		构件重量: 41.91	
部件编号	规格(mm)	数量	单重(kg)	共重(kg)	表面积(m²)
M156	RSA100*50*8	3	2.05	6.15	0.07
M440	RHS150*75*6.0	1	35.75	35.75	0.33
合计:					41.91


A	第2次报批	2018-11-05
Rev.	Description	Date
PROJECT: PROPOSED SITE C1 DEVELOPMENT AT AREA B6, TKOIL 70 RD, TSEUNG KWAN O, NEW TERRITORIES		
CLIENT: 美特铝质有限公司 MIDI ALUMINIUM FABRICATOR LTD. Units 6-8, Sunny Industrial Centre, 1/F 60 Cheong Cheong Road, Tseung Kwan O, New Territories Tel: 23489211-4 Fax: (852) 2727666		
S 银同有限公司 Silver Town Limited Tel: 0769-8335466 Fax: 0769-8335954 E-MAIL: ADDRESS@silvertown.hk		
DRAWING TITLE : [3SU-5]		
CAD File Name :		
Designed by		
Drawn by		
Reviewed by		
Approved by		
Scale		
DWG NO: (MM4)-2 - [3SU-5]		REV A

修改说明:
1, 角码移位。

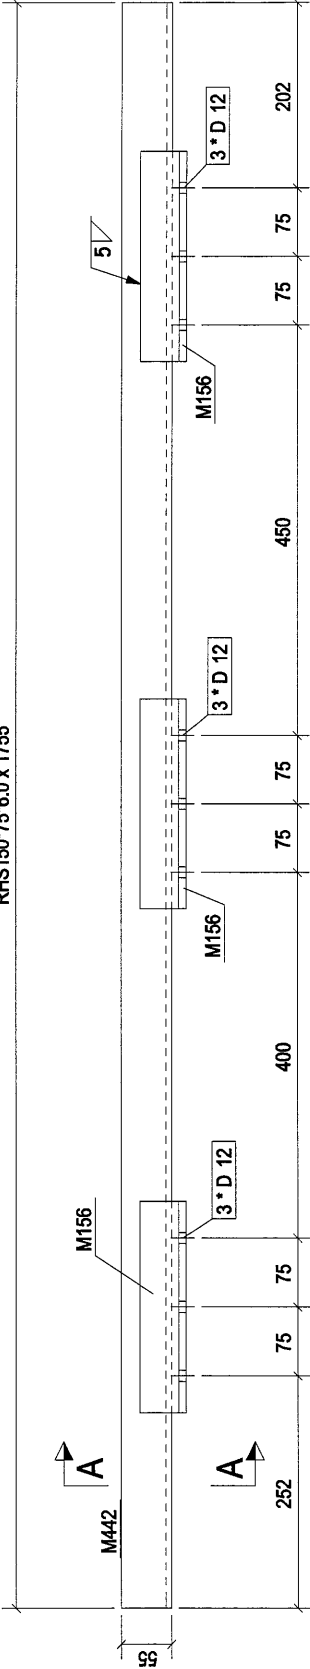

构件: 3SU-6

构件编号:		3SU-6	构件数量:		1	构件重量:		41.36
部件编号	规格(mm)		数量	长度(mm)		单重(kg)	共重(kg)	表面积(m²)
M156	RSA100*50*8		3	230		2.05	6.15	0.07
M442	RHS150*75*6.0		1	1755		35.21	35.21	0.33
合计:							41.36	

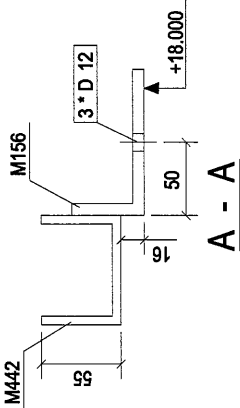


A	第2次报批	2018-11-05
Rev.	Description	Date
PROJECT: PROPOSED SITE C1 DEVELOPMENT AT AREA B6, TKOIL 70 RP, TSEUNG KWAN O, NEW TERRITORIES		
CLIENT: 美特铝质有限公司 MIDALUMINUM MANUFACTURE LTD. Units 6-8, Sun Chai Industrial Estate, 1/F 610, Chee Kwee Tsing Road, Kwai Tsing Tel: 23489211-4, Fax: (852) 27776565		
S 银同有限公司 Silver Town Limited Tel: 0789-4335968 Fax: 0789-4335954 E-MAIL: ADDRESS@silvertown.hk, 163.COM		
DRAWING TITLE : [3SU-6]		
CAD File Name :		
Designed by		
Drawn by		
Reviewed by		
Approved by		
Scale		
DWG NO: (WMA)-2 - [3SU-6]		REV
		A


修改说明:
1, 杆件加长100 (做地盘预留)。

构件编号:		3SU-7	构件数量:		1	构件重量:		44.19
部件编号	规格(mm)		数量	长度(mm)		单重(kg)	共重(kg)	表面积(m²)
M156	RSA100*50*8		3	230		2.05	6.15	0.07
M575	RHS150*75*6.0		1	1896		38.04	38.04	0.35
合计:							44.19	

1896 (RHS150*75*6.0 x 1896)


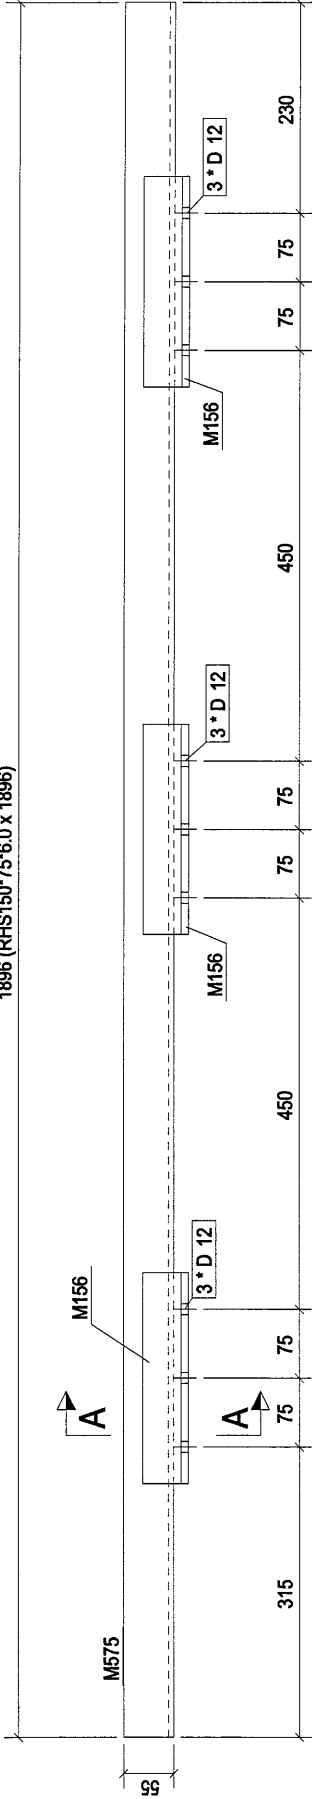


构件: 3SU-7

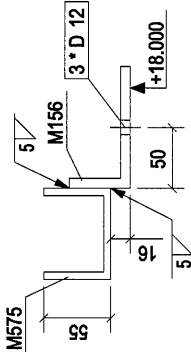

A	第2次报批	2018-11-10
Rev.	Description	Date
PROJECT:		
PROPOSED SITE C1 DEVELOPMENT AT AREA 08 TKOIL 70 RP, TSEUNG KWAN O, NEW TERRITORIES		
CLIENT:		
美特铝质有限公司 MIDI ALUMINUM MANUFACTURE LTD. Units 6-8, Sunny Industrial Centre, 1/F 610 Cha Kwo Ling Road, Kowloon Tel: 23489211-4, Fax: (852) 27727656 E-MAIL: ADDRESS@midialum.com.hk		
DRAWING TITLE :		
[3SU-7]		
CAD File Name :		
Designed by		
Drawn by		
Reviewed by		
Approved by		
Scale		
DWG NO. (WWW)-2 - [3SU-7]		
REV.		
A		


构件编号:		3SU-8	构件数量:		1	构件重量:		15.52
零件编号	规格(mm)	长度(mm)	重量	单重(kg)	共重(kg)	共重(kg)	共重(kg)	共重(kg)
M156	RHS100*50*8	230	1	2.05	2.05	2.05	0.07	0.07
M444	RHS150*75*6.0	671	1	13.47	13.47	13.47	0.13	0.13
合计:								15.52

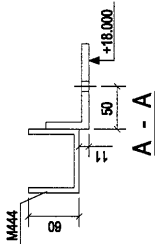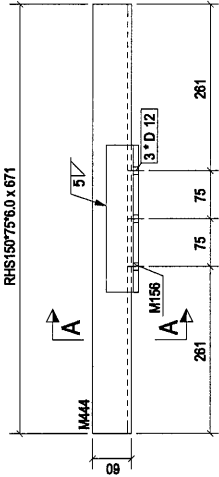


0	第1次报批	2016-07-04
Rev.	Description	Date
PROJECT: PROPOSED SITE C1 DEVELOPMENT AT AREA 86, TKOTL 70 RP, TSEUNG KWAN O, NEW TERRITORIES		
CLIENT:  美特铝质有限公司 MTD ALUMINIUM FABRICATOR LTD. Units 5-8, Sunny Industrial Centre, 1/F 510 Chee Kwan Road, Kwai Tsing Tel: 23489211-4, Fax: (852) 27727666		
 银同有限公司 Silver Town Limited Tel: 0769-8335988 Fax: 0769-8335954 E-Mail: ADDRESS@silvertown.com.hk, 153.0746		
DRAWING TITLE : [3SU-8]		
CAD File Name :		
Designed by		
Drawn by		
Reviewed by		
Approved by		
Scale		
DWG NO.: (WWW)-2 - [3SU-8]		REV. 0

修改说明:
1, 补回角码, 取消加孔。

构件编号: 3SU-9		构件数量: 1		构件重量: 41.90	
部件编号	规格(mm)	数量	单重(kg)	共重(kg)	表面积(m ²)
M156	RSA100*50*8	3	2.05	6.15	0.07
M908	RHS150*75*6.0	1	35.75	35.75	0.33
合计:					41.90

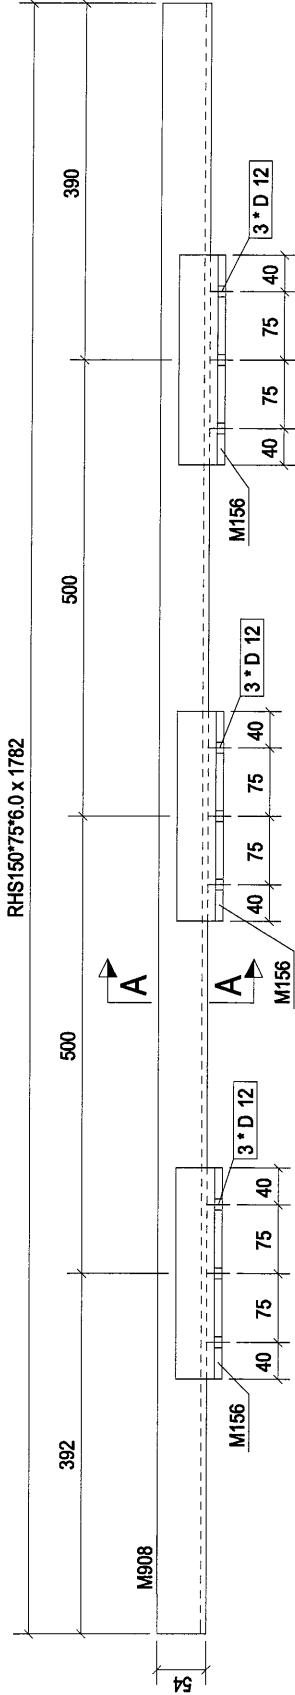


构件: 3SU-9

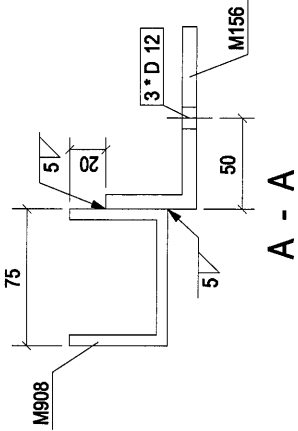


B	第3次报批	2018-11-10
Rev.	Description	Date
PROJECT: PROPOSED SITE C1 DEVELOPMENT AT AREA 88, TKOT, 70 RP, TSEUNG KWAN O, NEW TERRITORIES		
CLIENT: 美特铝质有限公司 MIDI ALUMINIUM FABRICATOR LTD. Units 6-8, Sunny Industrial Centre, 1/F 810 Chee Kwo Ling Road, Kowloon Tel: 23489211-4 Fax: (852) 2727665		
S 银同有限公司 Silver Town Limited Tel: 0769-8335968 Fax: 0769-8335954 E-MAIL: ADDRESS@silvertown.hk		
DRAWING TITLE : [3SU-9]		
CAD File Name :		
Designed by		
Drawn by		
Reviewed by		
Approved by		
Scale		
DWG NO.: (WWW)-2 - [3SU-9]		REV. B

修改说明:
1, 补回角码, 取消加孔。

构件编号: 3SU-10		构件数量: 3		构件重量: 41.83	
部件编号	规格(mm)	数量	单重(kg)	共重(kg)	表面积(m ²)
M156	RSA100*50*8	3	2.05	6.15	0.07
M907	RHS150*75*6.0	1	35.68	35.68	0.33
合计: 41.83					

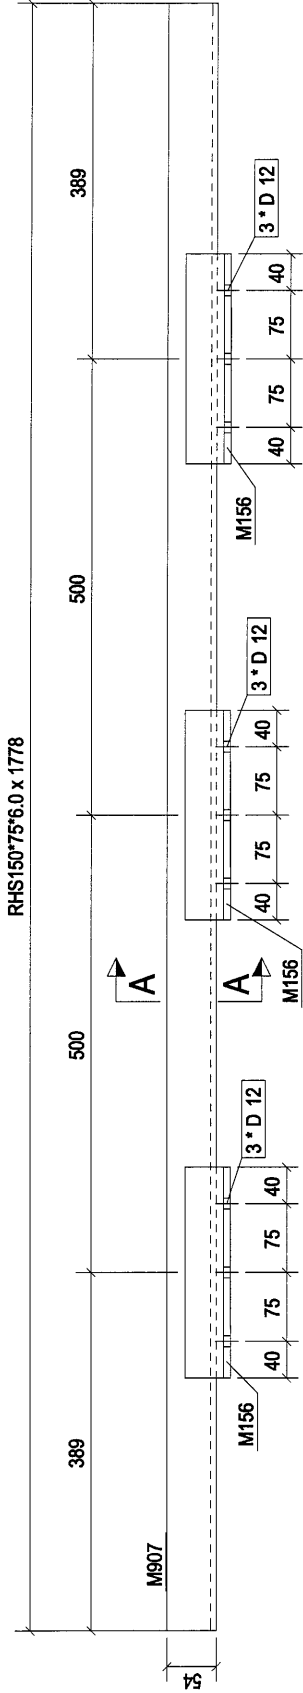


构件: 3SU-10

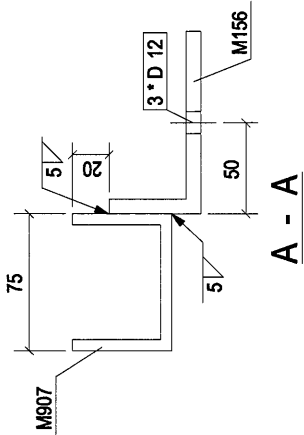


B	第3次提批	2018-11-10
Rev.	Description	Date
PROJECT: PROPOSED SITE C1 DEVELOPMENT AT AREA 86, TKOTL 70 RP, TSEUNG KWAN O, NEW TERRITORIES		
CLIENT:  美特铝质有限公司 MTDI ALUMINIUM FABRICATOR LTD. Units 6-8, Sunny Industrial Centre, 1/F 100 Cheung Cheong Road, Kwai Chung Tel: 23489211-4 Fax: (852) 2727656		
 银同有限公司 Silver Town Limited Tel: 4789-8335/4988 Fax: 4789-8335/8954 E-MAIL: ADDRESS@silvertown.hk, 161.COM		
DRAWING TITLE : [3SU-10]		
CAD File Name :		
Designed by		
Drawn by		
Reviewed by		
Approved by		
Scale		
DWG NO.: (WW4)-2 - [3SU-10]		REV B

修改说明:
1, 补回角码, 取消加孔。

构件编号: 3SU-11		构件数量: 1		构件重量: 36.39	
部件编号	规格(mm)	数量	单重(kg)	共重(kg)	表面积(m²)
M156	RSA100*50*8	230	2.05	6.15	0.07
M429	RHS150*75*6.0	1	30.23	30.23	0.28
合计:				36.39	

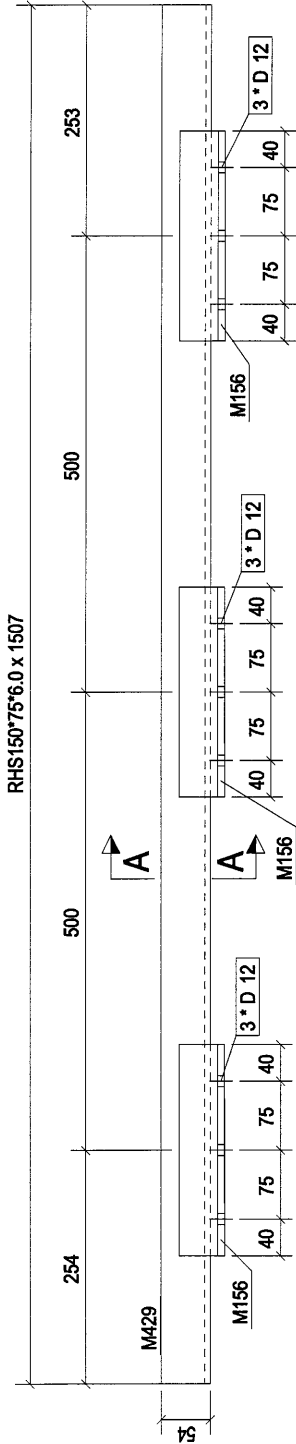


构件: 3SU-11

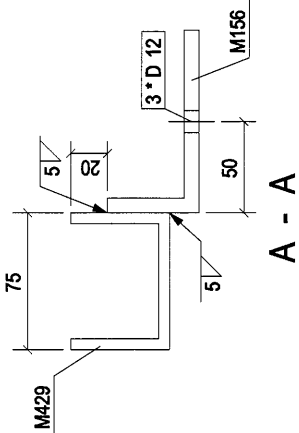

B	第3次报批	2018-11-10
Rev.	Description	Date
PROJECT: PROPOSED SITE C1 DEVELOPMENT AT AREA B6, TLOT 70 RP, TSEUNG KWAN O, NEW TERRITORIES		
CLIENT: 美特铝质有限公司 MIDI ALUMINIUM FABRICATORS LTD. Units 5-8, Sunny Industrial Centre, 1/F 810 Canton Road, Tseung Kwan O, New Territories Tel: 23480211-4 Fax: (852) 2727666		
S 银同有限公司 Silver Town Limited Tel: 0769-43354988 Fax: 0769-4335954 E-Mail: ADDRESS@silvertown.hk		
DRAWING TITLE : [3SU-11]		
CAD File Name :		
Designed by		
Drawn by		
Reviewed by		
Approved by		
Scale		
DWG NO.: (WW4)-2 - [3SU-11]		REV. B

修改说明:
1, 补回角码, 取消加孔。

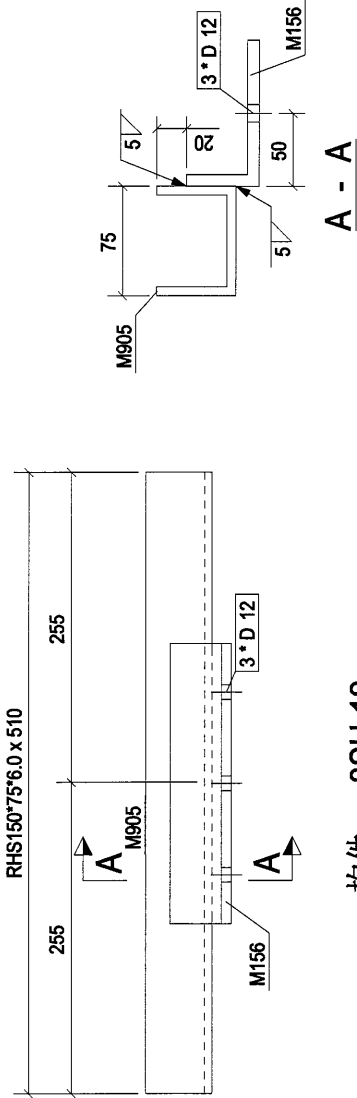


构件: 3SU-12

构件编号:		3SU-12	构件数量:		1	构件重量:		12.27
部件编号	规格(mm)		数量	单重(kg)	共重(kg)	表面积(m²)		
M156	RSA100*50*8		1	2.05	2.05	0.07		
M905	RHS150*75*6.0		1	10.22	10.22	0.10		
合计:								12.27


B	第3次报批	2018-11-10
Rev.	Description	Date
PROJECT:		
PROPOSED SITE C1 DEVELOPMENT AT AREA B8, TKOTL 70 RP, TSEUNG KWAN O, NEW TERRORIES		
CLIENT:		
美特铝质有限公司 MIDI Unit 6-8, Sunny Industrial Centre, 610 Chee Koo Ling Road, Kowloon Tel: 23489211-4 Fax: (852) 2727666		
S 银同有限公司 Silver Town Limited Tel: 23489211-4 Fax: (852) 2727666 E-MAIL: ADDRESS@silvertown.hk		
DRAWING TITLE :		
[3SU-12]		
CAD File Name :		
Designed by		
Drawn by		
Reviewed by		
Approved by		
Scale		
DWG NO: (MM4)-2 - [3SU-12]		
REV.		
B		

修改说明:
1, 补回角码, 取消加孔。

构件编号: 3SU-13		构件数量: 1		构件重量: 42.01	
部件编号	规格(mm)	数量	单重(kg)	共重(kg)	表面积(m ²)
M156	RSA100*50*8	3	2.05	6.15	0.07
M435	RHS150*75*6.0	1	35.86	35.86	0.33
合计:					42.01

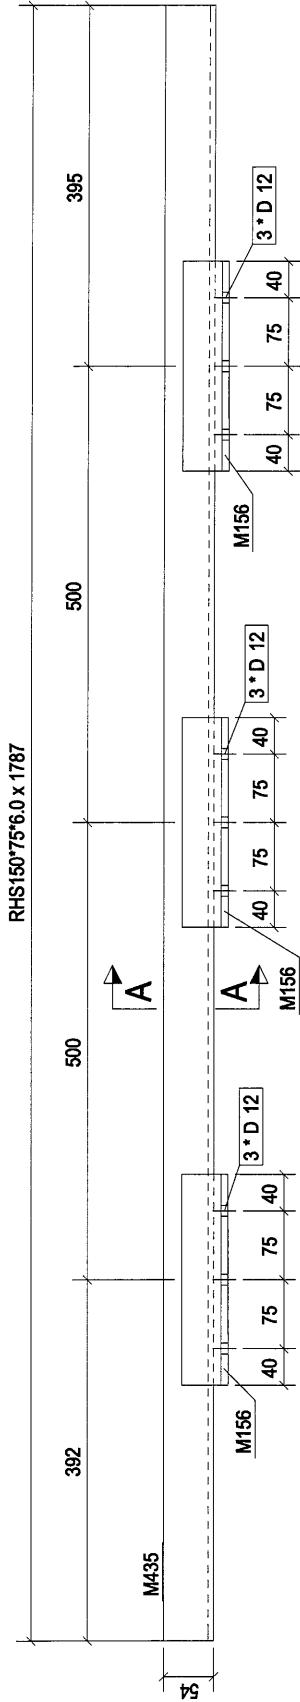


构件: 3SU-13

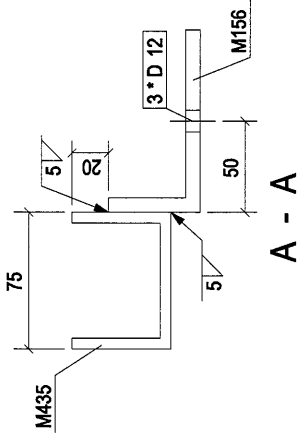


B	第3次报批	2018-11-10
Rev.	Description	Date
PROJECT: PROPOSED SITE C1 DEVELOPMENT AT AREA 86, TKOTL 70 RP, TSEUNG KWAN O, NEW TERRITORIES		
CLIENT: 美特铝业有限公司 MIDI LATHEWILL FABRICATOR LTD. Units 6-8, Sunny Industrial Centre, 7/F, 610 Chee Kwo Ling Road, Kowloon Tel: 23489211-4 Fax: (852) 2727666		
S 银同有限公司 Silver Town Limited Tel: 0758-4335866 Fax: 0758-4335854 E-MAIL: ADDRESS@silvertown.hk		
DRAWING TITLE : [3SU-13]		
CAD File Name :		
Designed by		
Drawn by		
Reviewed by		
Approved by		
Scale		
DWG NO.: (WM4)-2 - [3SU-13]		
REV. B		

修改说明:
1, 补回角码, 取消加孔。

构件编号: 3SU-16		1		构件数量:		构件重量:		34.21
部件编号	规格(mm)	数量	长度(mm)	单重(kg)	共重(kg)	表面积(m²)		
M156	RSA100*50*8	3	230	2.05	6.15	0.07		
M439	RHS150*75*6.0	1	1398	28.06	28.06	0.26		
合计:							34.21	

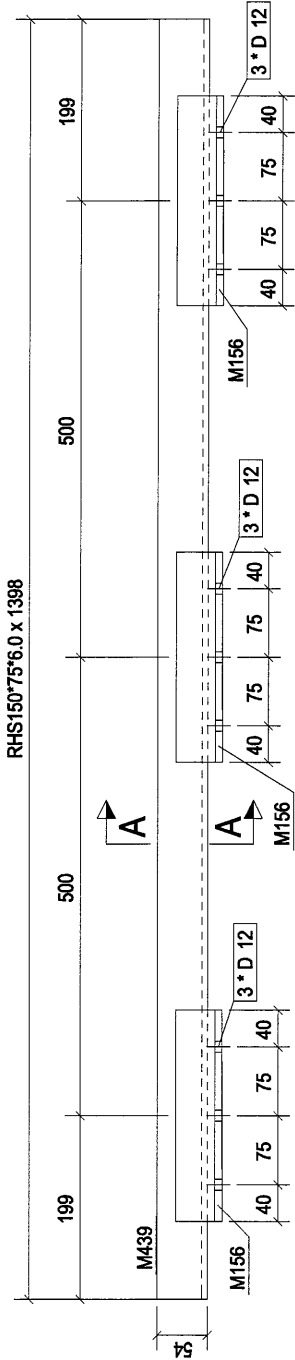

构件: 3SU-16

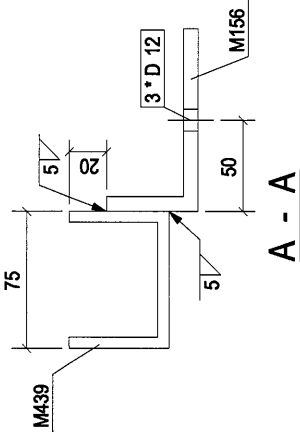

B	第3次报批	2018-11-10
Rev.	Description	Date
PROJECT:		
PROPOSED SITE C1 DEVELOPMENT AT AREA 88, TKOTL 70 RP, TSEUNG KWAN O, NEW TERRITORIES		
CLIENT:		
美特鋁質有限公司 MIDI ALUMINIUM FABRICATOR LTD. Units 6-8, Sunny Industrial Centre, 1/F 810 Che Kwo Ling Road, Kowloon Tel: 23489211-4 Fax: (852) 2727666		
银同有限公司 Silver Town Limited Tel: 0769-83354988 Fax: 0769-83359854 E-MAIL: ADDRESS@silvertown.hk		
DRAWING TITLE :		
[3SU-16]		
CAD File Name :		
Designed by		
Drawn by		
Reviewed by		
Approved by		
Scale		
DWG NO.: (WW4)-2 - [3SU-16]		
REV.		
B		