

工程指示 / 要求簡箋(E.I.)

工程指示編號：EI/ 9636 118

修改版次： B

工程編號： J836

工程名稱： 日出康城 7 期 (平台)

工程項目： Kindergarten Canopy 鐵件顏色確認 (深灰)

收件人： Maggie

發件人： 李耀輝

日期： 2018/12/14

要求提供 / 確認 事項：

- () 初步鋁料 B.M.
- () 加工拆圖，然後生產
- () 尺寸表
- () 正式鋁料 B.M.
- () 技術上資料 / 指示
- () 報價
- () 配件 B.M.
- () 樣辦或貨品說明書
- () 分判合約
- () 其他： _____

內容：

現確認 Kindergarten Canopy 之鐵件顏色做深灰色，煩請安排訂造。

(中信化工色卡號： CSC 20180911-2)

附則所確認顏色之 C.I

請在 2019/1/21 前完成上列要求。

附有關圖紙 / 文件：

4頁

以上項目為：

- 原合約工程包
- 原合約工程加 / 減賬
- 新工程報價

原因：-

分發東莞各部門：

- () 生產技術總監 連附件 () 技術部 連附件 () 生產部 連附件 () 機械設計部 連附件
- () 採購部 連附件 () 生產統籌部 連附件
- () 質檢部 連附件 () 會計部 連附件 () 報關組 連附件 () 其他 _____ 連附件

分發香港各部門：

- () 行政部 連附件 () 會計部 連附件 () 統籌部 連附件 () 工程部地盤科文 連附件
- () 採購部 連附件 () QS 部 連附件 () 維修部 連附件 () 其他 _____ 連附件

傳遞編號：

發件人簽署：

項目經理簽署：

APPENDIX 2

Hilary Ng

From: "Alex Sin" <slapfung@gmail.com>
Date: 2018年9月19日 21:28
To: <cstko2017@gmail.com>; <midi@midltd.com.hk>
Cc: <willyu@wheelockpropertieshk.com>; <benjaminchan@wheelockpropertieshk.com>; <kristin.leung@mfacade.com>; <wingau@meinhardt.com.hk>; <terrycheng@wheelockpropertieshk.com>; <jimmyfok@wheelockpropertieshk.com>; <slkwan@mtr.com.hk>; <dickson_ng@cohl.com>; "5138A" <5138a@p-t-group.com>; <joengl121@gmail.com>; <gary_yuen@cohl.com>
Attach: For 1_1.JPG; For 1_2.JPG; For 3.JPG
Subject: 5138A - Lohas Park P7 : Package A - Clarification of finish colour for window wall & clarification of detailing

Dear Bruce and Midi:

Please see attached consolidated set regarding finish colour for window wall façade, the file included the following information about finish colour:

<ftp://61.244.114.162/>

login: pt5138amcw

pw: ptftp4495

Under folder: 20180919 Colour finish for window wall

↳ Park Grey
深灰

- Samples of colour in aluminium. Please note that GMS in dark grey and aluminium in white (for typhoon proof ceiling) are still outstanding.
- Series of 3D montage to demonstrate the colour for window wall facades.
- Section of alfresco dining to demonstrate the colour. Once again to remind COBC to provide updated shop drawing of detail section, to reflect the latest detailing of decorative louvre and stone cladding.
- Skylights for kindergarten and mall.
(Same email as Confirmation on the surface finishing color for Window Wall dated on 8th Sep 2018)
- Canopies for WW1, E1, kindergarten and roof.
(Same email as Confirmation on the surface finishing color for Window Wall dated on 8th Sep 2018)
- Cooling tower façade.
(Same email as Confirmation on the surface finishing color for Window Wall dated on 10th Sep 2018)
- Sealant colour.

You are also reminded that the change of finished colour on window wall mullion to Dark Grey have been raised in the façade review meeting dated on 20th July 2018.

(Please refer to email Clarification of revision on window wall facade aluminium coating dated on


14th Sep 2018 for detail)

Furthermore, please see attached clarification of detailing for your further review and incorporate onto shop drawing.

1. Please see attached stone cladding extent and interfacing detail at E1 canopy façade. Please provide shop drawings and blow up detail.
2. The external balustrade at IE will have similar detail to FB's glass balustrade, where aluminium extrusion of 50mm (H) x 50mm (D) to the top capping and aluminium channel of 15mm (W) x 50mm (D) to side glass capping. Champagne Gold colour. Please refer to FB balustrade drawing and update IE balustrade shop drawing accordingly.
3. Please reduce the extent of cladding for skylights, both kindergarten and mall skylights, as shown in attachment in ftp link above. As discussed with Gary, Joe, Dickson and Henry on site, cladding enclosure of 120mm (W) will be sufficient to conceal FS pipes including its fixing bracket and turning connection of FS pipes. Please update the shop drawing.

Let's discuss these issues should you require.

Regards
Alex Sin

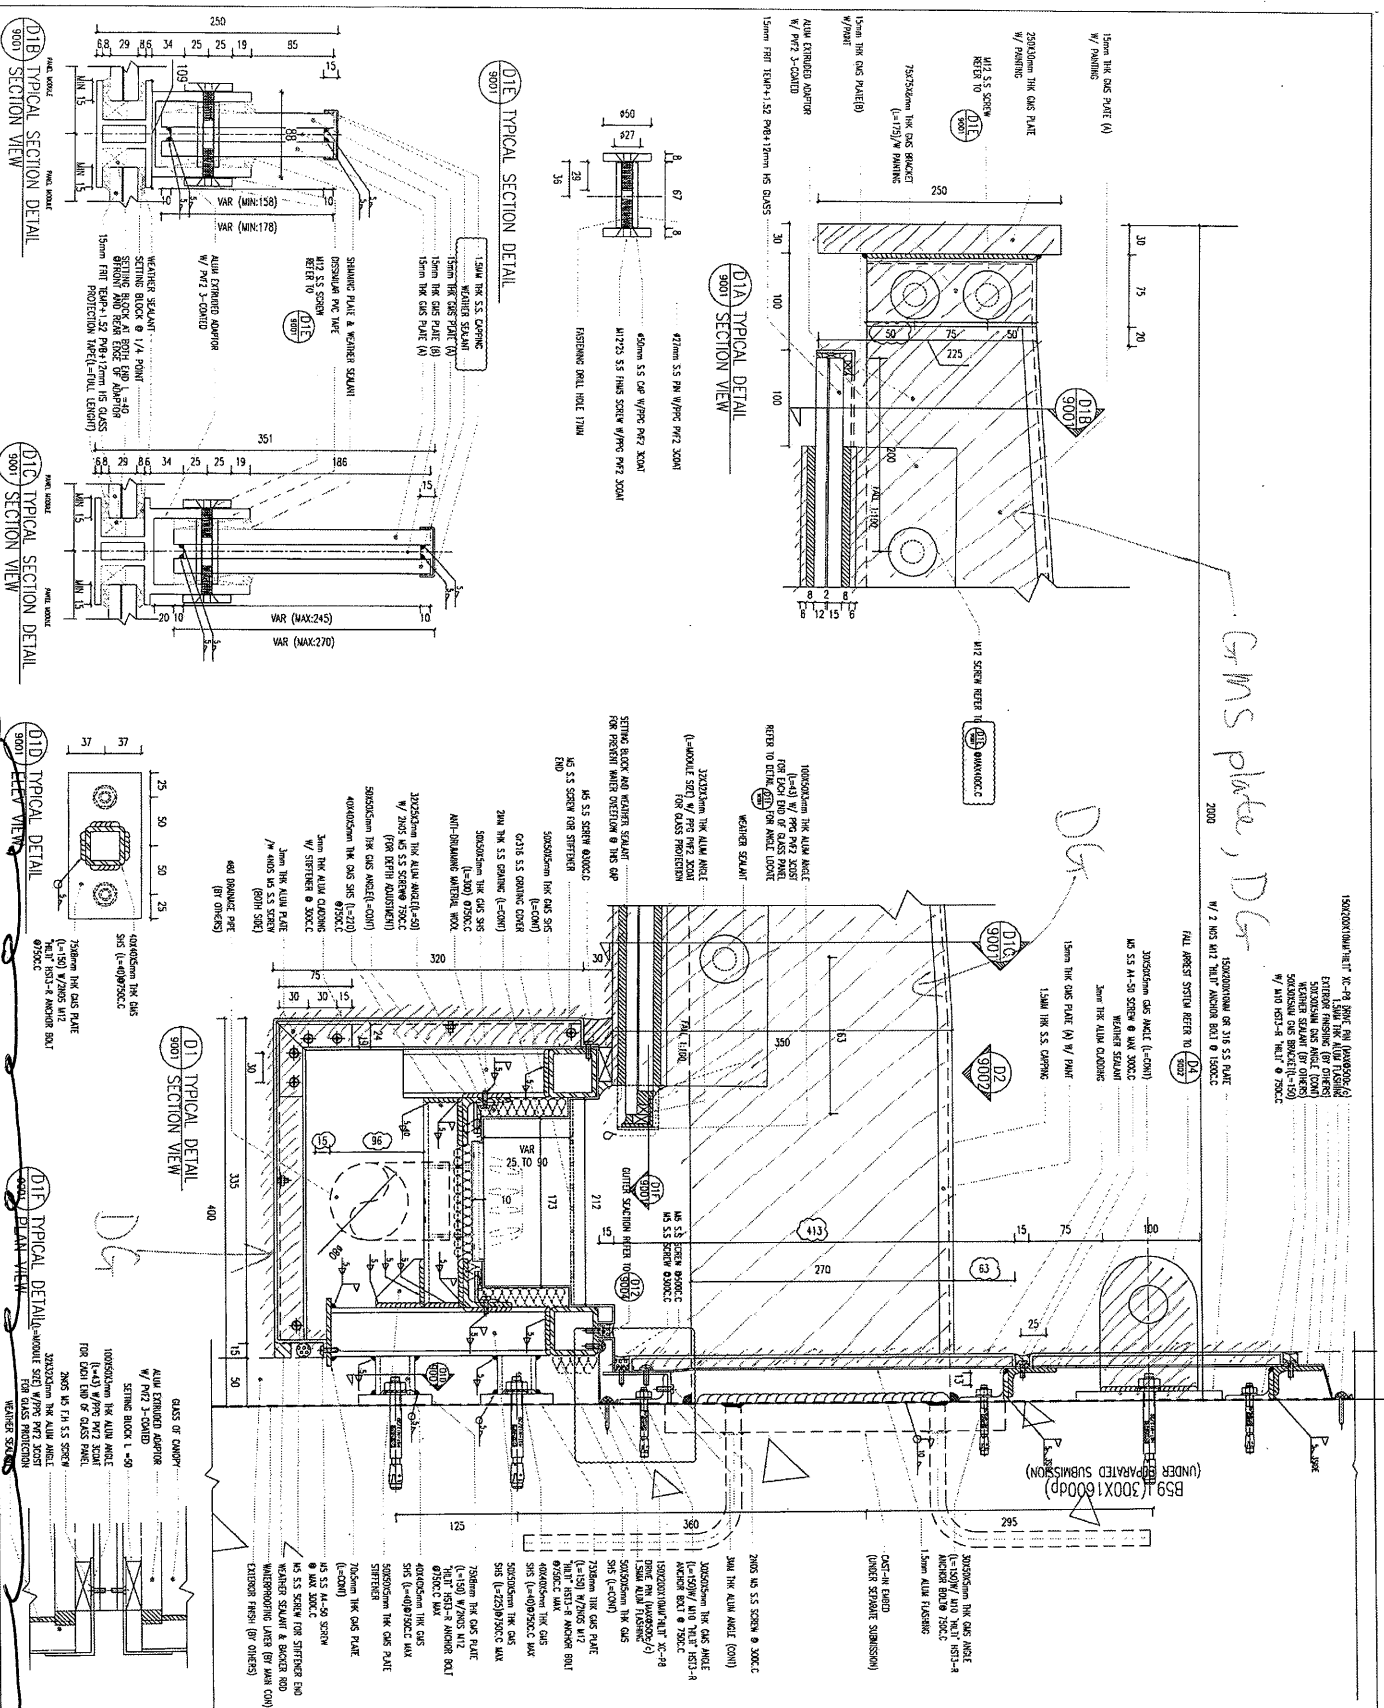

BD. REF. : 3/7/92/97/4(C1)	CLIENT : MTR	ARCHITECT : P&P Architects and Engineers Ltd P&P 建築師工程師有限公司	MAIN CONTRACTOR : CHINA OVERSEAS BUILDING CONSTRUCTION LTD.	STRUCTURAL ENGINEER : ARUP	TRACKER ENGINEER : MEINHARDT
DATE : 9-11-91	SCALE : 1:5	DRAWN BY : C.F.	CHECKED BY : M.K.	PROJECT : PROPOSED SITE C1 DEVELOPMENT AT AREA 96, TKOIL TO RP, TSIUNG KWAN O, NEW TERRORIES	TITLE : TYPICAL DETAIL FOR GLASS CANOPY AT KINDERGARTEN
NO. :	1-836	REVISIONS			
1	20-11-91	BY	CHK	DESCRIPTION	REVISIONS
2	11-12-91	BY	CHK	FOR SUBMISSION	FOR SUBMISSION
3	11-12-91	BY	CHK	FOR SUBMISSION	FOR SUBMISSION
4	13-01-92	BY	CHK	FOR SUBMISSION	FOR SUBMISSION
5	01-02-92	BY	CHK	FOR SUBMISSION	FOR SUBMISSION
6	01-02-92	BY	CHK	FOR SUBMISSION	FOR SUBMISSION
7	01-02-92	BY	CHK	FOR SUBMISSION	FOR SUBMISSION
8	01-02-92	BY	CHK	FOR SUBMISSION	FOR SUBMISSION
9	01-02-92	BY	CHK	FOR SUBMISSION	FOR SUBMISSION
10	01-02-92	BY	CHK	FOR SUBMISSION	FOR SUBMISSION

深水
DG = Dark Grey
Kinder garden canopy

GWS plate, DG