

工程指示 / 要求簡箋(E.I.)

工程指示編號：EI / 0064 / 19

修改版次：B

工程編號：J - 837

工程名稱：觀塘裕民坊

工程項目：幕牆 趟門及 FD 門玻璃(樣板層)

收件人：Maggie/生統/永林

發件人：Eric Liu

日期：21/02/2019

要求提供 / 確認 事項：

- |                                    |                                     |                               |
|------------------------------------|-------------------------------------|-------------------------------|
| <input type="checkbox"/> 初步鋁料 B.M. | <input type="checkbox"/> 加工拆圖，然後生產  | <input type="checkbox"/> 尺寸表  |
| <input type="checkbox"/> 正式鋁料 B.M. | <input type="checkbox"/> 技術上資料 / 指示 | <input type="checkbox"/> 報價   |
| <input type="checkbox"/> 配件 B.M.   | <input type="checkbox"/> 樣辦或貨品說明書   | <input type="checkbox"/> 分判合約 |
| <input type="checkbox"/> 其他：_____  |                                     |                               |

內容：

請按 B.M.訂購玻璃 (趟門及 FD 門玻璃)(樣板層)

B 版修改: 1) 此 BM 按 EI9536I，改分倉後修改

2) 已問少顏未加工，可修改

謝謝！

請在 2019/ 03 / 08 前完成上列要求。

附：12 頁 B.M.

以上項目為：

- 原合約工程包                       原合約工程加 / 減賬                       新工程報價

原因：-

分發東莞各部門：

- ( ) 生產技術總監  連附件 ( ) 技術部  連附件 ( ) 生產部  連附件 ( ) 機械設計部  連附件  
 ( ) 採購部  連附件 ( ) 生產統籌部  連附件  
 ( ) 質檢部  連附件 ( ) 會計部  連附件 ( ) 報關組  連附件 ( ) 其他 楊榮輝  連附件

分發香港各部門：

- ( ) 行政部  連附件 ( ) 會計部  連附件 ( ) 統籌部  連附件 ( ) 工程部地盤科文  連附件  
 ( ) 採購部  連附件 ( ) QS 部  連附件 ( ) 維修部  連附件 ( ) 其他 \_\_\_\_\_  連附件


傳遞編號：

HK 0425/19

發件人簽署：

項目經理簽署：

		工程號:	J837	計算:	陈俊桦	日期:	2019.1.23	送呈:		計算參考數值/所屬位置 分格				
		地盤名稱:	觀塘裕民坊	核對:	謝永林/鞠章芳	日期:	2019.1.23	副本:						
地盤用玻璃B.M.表		項目類別:	T1-T5座8F-SD門	批准:		A/C Code:								
BM編號:J837-CW-M01-S-GP04		修改版次: B版EI0064		總計玻璃面積(平方米):		455.14		此BM依據第四版施工圖計算						
序號	修改內容	玻璃圖號	顏色與類型	厚度(mm)	玻璃尺寸		數量(塊)	總面積(平方米)	使用位置	單位	樓層	分屬類型	分格寬度	分格高度
					寬度(W mm)	高度(H mm)								
1		G1-SD-101	G1	27.00	787.5	2466.0	1	1.94	T1CW G-1左	G	7/F-8/F	SD梗	907.5	2580.0
2		G1-SD-102	G1	27.00	940.0	2466.0	1	2.32	T1CW G-1右	G	7/F-8/F	SD梗	1060.0	2580.0
3		G1-SD-104	G1	27.00	847.5	2466.0	1	2.09	T1CW E-1	E	7/F-8/F	SD梗	967.5	2580.0
4		G1-SD-107	G1	27.00	815.0	2466.0	1	2.01	T1CW D-1右	D	7/F-8/F	SD梗	935	2580.0
5		G1-SD-108	G1	27.00	1160.0	2466.0	1	2.86	T1CW A-3	A	7/F-8/F	SD梗	1280.0	2580.0
6		G1-SD-109	G1	27.00	887.5	2466.0	1	2.19	T1CW A-2	A	7/F-8/F	SD梗	1007.5	2580.0
7		G1-SD-110	G1	27.00	887.5	2466.0	1	2.19	T1CWB-2	B	7/F-8/F	SD梗	1007.5	2580.0
8		G1-SD-111	G1	27.00	1310.0	2466.0	1	3.23	T1CWB-1	B	7/F-8/F	SD梗	1430.0	2580.0
9		G1-SD-112	G1	27.00	915.0	2466.0	1	2.26	T1CWC-1左	C	7/F-8/F	SD梗	1035.0	2580.0
10		G1-SD-114	G1	27.00	815.0	2466.0	1	2.01	T1CWM-2	M	7/F-8/F	SD梗	935.0	2580.0
11		G1-SD-117	G1	27.00	815.0	2466.0	1	2.01	T1CWL-1	L	7/F-8/F	SD梗	935.0	2580.0
12		G1-SD-118	G1	27.00	815.0	2466.0	1	2.01	T1CWK-2	K	7/F-8/F	SD梗	935.0	2580.0
13		G1-SD-121	G1	27.00	840.0	2466.0	1	2.07	T1CWJ-1	J	7/F-8/F	SD梗	960.0	2580.0
14		G1-SD-122	G1	27.00	1015.0	2466.0	1	2.50	T1CWH-2左	H	7/F-8/F	SD梗	1135.0	2580.0
15		G1-SD-201	G1	27.00	787.5	2466.0	1	1.94	T2CWH-1左	H	7/F-8/F	SD梗	907.5	2580.0
16		G1-SD-204	G1	27.00	815.0	2466.0	1	2.01	T2CWG-2右	G	7/F-8/F	SD梗	935.0	2580.0
17		G1-SD-205	G1	27.00	815.0	2466.0	1	2.01	T2CWF-2	F	7/F-8/F	SD梗	935.0	2580.0
18		G1-SD-208	G1	27.00	815.0	2466.0	1	2.01	T2CWE-1	E	7/F-8/F	SD梗	935.0	2580.0
19		G1-SD-211	G1	27.00	1165.0	2466.0	1	2.87	T2CWB-2左	B	7/F-8/F	SD梗	1285.0	2580.0
20		G1-SD-212	G1	27.00	787.5	2466.0	1	1.94	T2CWB-2右	B	7/F-8/F	SD梗	907.5	2580.0
21		G1-SD-213	G1	27.00	787.5	2466.0	1	1.94	T2CWA-1左	A	7/F-8/F	SD梗	907.5	2580.0
22		G1-SD-214	G1	27.00	1065.0	2466.0	1	2.63	T2CWA-1右	A	7/F-8/F	SD梗	1185.0	2580.0
23		G1-SD-216	G1	27.00	787.5	2466.0	1	1.94	T2CWM-2	M	7/F-8/F	SD梗	907.5	2580.0
24		G1-SD-217	G1	27.00	940.0	2466.0	1	2.32	T2CWM-1	M	7/F-8/F	SD梗	1060.0	2580.0

	工程號:	J837	計算:	陈俊桦	日期:	2019.1.23	送呈:		<b>計算參考數值/所屬位置 分格</b>
	地盤名稱:	觀塘裕民坊	核對:	謝永林/鞠章芳	日期:	2019.1.23	副本:		
<b>地盤用玻璃B.M.表</b>	項目類別:	T1-T5座8F-SD門	批准:				A/C Code:		
BM編號:J837-CW-M01-S-GP04	修改版次:	B版EI0064	總計玻璃面積(平方米):	455.14	此BM依據第四版施工圖計算				


序號	修改內容	玻璃圖號	顏色與類型	厚度 (mm)	玻璃尺寸		數量 (塊)	總面積 (平方米)	使用位置	單位	樓層	分屬類型	分格寬度	分格高度
					寬度(W mm)	高度(H mm)								
25		G1-SD-301	G1	27.00	1247.5	2466.0	1	3.08	T3CWF-1	F	7/F-8/F	SD梗	1367.5	2580.0
26		G1-SD-302	G1	27.00	1047.5	2466.0	1	2.58	T3CWE-1	E	7/F-8/F	SD梗	1167.5	2580.0
27		G1-SD-305	G1	27.00	865.0	2466.0	1	2.13	T3CWL-1	L	7/F-8/F	SD梗	985.0	2580.0
28		G1-SD-306	G1	27.00	815.0	2466.0	1	2.01	T3CWK-2	K	7/F-8/F	SD梗	935.0	2580.0
29		G1-SD-310	G1	27.00	1166.5	2466.0	1	2.88	T3CWH-2	H	7/F-8/F	SD梗	1480.0	2580.0
30		G1-SD-313	G1	27.00	815.0	2466.0	1	2.01	T3CWC-1	C	7/F-8/F	SD梗	935.0	2580.0
31		G1-SD-314	G1	27.00	1265.0	2466.0	1	3.12	T3CWB-2左	B	7/F-8/F	SD梗	1385.0	2580.0
32		G1-SD-315	G1	27.00	787.5	2466.0	1	1.94	T3CWB-2右	B	7/F-8/F	SD梗	907.5	2580.0
33		G1-SD-316	G1	27.00	787.5	2466.0	1	1.94	T3CWA-1左	A	7/F-8/F	SD梗	907.5	2580.0
34		G1-SD-317	G1	27.00	1165.0	2466.0	1	2.87	T3CWA-1右	A	7/F-8/F	SD梗	1285.0	2580.0
35		G1-SD-501	G1	27.00	940.0	2466.0	1	2.32	T5CWN-1	N	7/F-8/F	SD梗	1060.0	2580.0
36		G1-SD-502	G1	27.00	1140.0	2466.0	1	2.81	T5CWM-2	M	7/F-8/F	SD梗	1260.0	2580.0
37		G1-SD-503	G1	27.00	890.0	2466.0	1	2.19	T5CWL-1	L	7/F-8/F	SD梗	1010.0	2580.0
38		G1-SD-505	G1	27.00	787.5	2466.0	1	1.94	T5CWH-2下	H	7/F-8/F	SD梗	907.5	2580.0
39		G1-SD-506	G1	27.00	815.0	2466.0	1	2.01	T5CWH-1	H	7/F-8/F	SD梗	935.0	2580.0
40		G1-SD-510	G1	27.00	815.0	2466.0	1	2.01	T5CWF-1	F	7/F-8/F	SD梗	935.0	2580.0
41		G1-SD-511	G1	27.00	840.0	2466.0	1	2.07	T5CWE-2	E	7/F-8/F	SD梗	960.0	2580.0
42		G1-SD-514	G1	27.00	840.0	2466.0	1	2.07	T5CWD-1	D	7/F-8/F	SD梗	960.0	2580.0
43		G1-SD-517	G1	27.00	869.0	2466.0	1	2.14	T5CWC-1右 下	C	7/F-8/F	SD梗	989.0	2580.0
44		G1-SD-518	G1	27.00	1360.0	2466.0	1	3.35	T5CWA-3	A	7/F-8/F	SD梗	1480.0	2580.0
45						合計	44	100.79						
46		G3-SD-103	G3	27.00	640.0	2466.0	1	1.58	T1CW F-2	F	7/F-8/F	SD梗	760.0	2580.0
47	B修改寬度及款式	G1-SD-105	G1	27.00	972.5	2466.0	1	2.40	T1CW D-1左	D	7/F-8/F	SD梗	1092.5	2580.0
48		G3-SD-106	G3	27.00	647.5	2466.0	1	1.60	T1CW D-1中	D	7/F-8/F	SD梗	767.5	2580.0

		工程號:	J837	計算:	陈俊桦	日期:	2019.1.23	送呈:		計算參考數值/所屬位置 分格				
		地盤名稱:	觀塘裕民坊	核對:	謝永林/鞠章芳	日期:	2019.1.23	副本:						
地盤用玻璃B.M.表		項目類別:	T1-T5座8F-SD門	批准:				A/C Code:						
BM編號:J837-CW-M01-S-GP04		修改版次: B版EI0064		總計玻璃面積(平方米):		455.14		此BM依據第四版施工圖計算						
序號	修改內容	玻璃圖號	顏色與類型	厚度 (mm)	玻璃尺寸		數量 (塊)	總面積 (平方米)	使用位置	單位	樓層	分屬類型	分格寬度	分格高度
					寬度(W mm)	高度(H mm)								
49		G3-SD-113	G3	27.00	747.5	2466.0	1	1.84	T1CWC-1右	C	7/F-8/F	SD梗	867.5	2580.0
50		G3-SD-115	G3	27.00	647.5	2466.0	1	1.60	T1CWM-1	M	7/F-8/F	SD梗	767.5	2580.0
51		G3-SD-116	G3	27.00	647.5	2466.0	1	1.60	T1CWL-2	L	7/F-8/F	SD梗	767.5	2580.0
52		G3-SD-123	G3	27.00	687.5	2466.0	1	1.70	T1CWH-2右	H	7/F-8/F	SD梗	807.5	2580.0
53	B修改寬度及款式	G1-SD-202	G1	27.00	897.5	2466.0	1	2.21	T2CWH-1右	H	7/F-8/F	SD梗	1017.5	2580.0
54		G3-SD-203	G3	27.00	647.5	2466.0	1	1.60	T2CWG-2左	G	7/F-8/F	SD梗	767.5	2580.0
55		G3-SD-206	G3	27.00	647.5	2466.0	1	1.60	T2CWF-1	F	7/F-8/F	SD梗	767.5	2580.0
56		G3-SD-207	G3	27.00	647.5	2466.0	1	1.60	T2CWE-2	E	7/F-8/F	SD梗	767.5	2580.0
57		G3-SD-209	G3	27.00	740.0	2466.0	1	1.82	T2CWD-1	D	7/F-8/F	SD梗	860.0	2580.0
58		G3-SD-210	G3	27.00	740.0	2466.0	1	1.82	T2CWC-1	C	7/F-8/F	SD梗	860.0	2580.0
59	取消	G3-SD-215	G3	27.00	490.0	2466.0	0	0.00	T2CWN-1	N	7/F-8/F	SD梗	610.0	2580.0
60		G3-SD-218	G3	27.00	572.5	2466.0	1	1.41	T2CWL-2左	L	7/F-8/F	SD梗	692.5	2580.0
61	B修改寬度及款式	G1-SD-219	G1	27.00	847.5	2466.0	1	2.09	T2CWL-2右	L	7/F-8/F	SD梗	967.5	2580.0
62	B修改寬度及款式	G1-SD-220	G1	27.00	847.5	2466.0	1	2.09	T2CWK-1左	K	7/F-8/F	SD梗	967.5	2580.0
63		G3-SD-221	G3	27.00	585.0	2466.0	1	1.44	T2CWK-1右	K	7/F-8/F	SD梗	705.0	2580.0
64		G3-SD-222	G3	27.00	585.0	2466.0	1	1.44	T2CWJ-1左	J	7/F-8/F	SD梗	705.0	2580.0
65	B修改寬度	G3-SD-223	G3	27.00	740.0	2466.0	1	1.82	T2CWJ-1右	J	7/F-8/F	SD梗	860.0	2580.0
66		G3-SD-303	G3	27.00	715.0	2466.0	1	1.76	T3CWM-2	M	7/F-8/F	SD梗	835.0	2580.0
67		G3-SD-304	G3	27.00	647.5	2466.0	1	1.60	T3CWL-2	L	7/F-8/F	SD梗	767.5	2580.0
68		G3-SD-307	G3	27.00	647.5	2466.0	1	1.60	T3CWK-1	K	7/F-8/F	SD梗	767.5	2580.0
69		G3-SD-308	G3	27.00	740.0	2466.0	1	1.82	T3CWJ-2	J	7/F-8/F	SD梗	860.0	2580.0
70		G3-SD-309	G3	27.00	647.5	2466.0	1	1.60	T3CWJ-1	J	7/F-8/F	SD梗	767.5	2580.0
71		G3-SD-311	G3	27.00	697.5	2466.0	1	1.72	T3CWH-1	H	7/F-8/F	SD梗	817.5	2580.0
72		G3-SD-312	G3	27.00	647.5	2466.0	1	1.60	T3CWC-2	C	7/F-8/F	SD梗	767.5	2580.0


 美特鋁質 有限公司 MIDI Aluminium Fabricator Ltd.		工程號:	J837	計算:	陈俊桦	日期:	2019.1.23	送呈:		計算參考數值/所屬位置 分格				
		地盤名稱:	觀塘裕民坊	核對:	謝永林/鞠章芳	日期:	2019.1.23	副本:						
地盤用玻璃B.M.表		項目類別:	T1-T5座8F-SD門	批准:		A/C Code:								
BM編號:J837-CW-M01-S-GP04		修改版次:	B版EI0064	總計玻璃面積 (平方米):		455.14	此BM依據第四版施工圖計算							
序號	修改內容	玻璃圖號	顏色與類型	厚度 (mm)	玻璃尺寸		數量 (塊)	總面積 (平方米)	使用位置	單位	樓層	分屬類型	分格寬度	分格高度
					寬度 (W mm)	高度 (H mm)								
73		G3-SD-318	G3	27.00	696.0	2466.0	1	1.72	T3CWD-1左	D	7/F-8/F	SD梗	816.0	2580.0
74		G3-SD-319	G3	27.00	647.5	2466.0	1	1.60	T3CWD-1右	D	7/F-8/F	SD梗	767.5	2580.0
75		G3-SD-320	G3	27.00	647.5	2466.0	1	1.60	T3CWG-1左	G	7/F-8/F	SD梗	767.5	2580.0
76		G3-SD-321	G3	27.00	697.5	2466.0	1	1.72	T3CWG-1右	G	7/F-8/F	SD梗	817.5	2580.0
77		G3-SD-504	G3	27.00	592.5	2466.0	1	1.46	T5CWJK-1	JK	7/F-8/F	SD梗	712.5	2580.0
78		G3-SD-507	G3	27.00	765.0	2466.0	1	1.89	T5CWG-2	G	7/F-8/F	SD梗	885.0	2580.0
79		G3-SD-508	G3	27.00	647.5	2466.0	1	1.60	T5CWG-1	G	7/F-8/F	SD梗	767.5	2580.0
80		G3-SD-509	G3	27.00	647.5	2466.0	1	1.60	T5CWF-2	F	7/F-8/F	SD梗	767.5	2580.0
81		G3-SD-512	G3	27.00	647.5	2466.0	1	1.60	T5CWE-1	E	7/F-8/F	SD梗	767.5	2580.0
82		G3-SD-513	G3	27.00	647.5	2466.0	1	1.60	T5CWD-2	D	7/F-8/F	SD梗	767.5	2580.0
83		G3-SD-515	G3	27.00	765.0	2466.0	1	1.89	T5CWG-1左 下	C	7/F-8/F	SD梗	885.0	2580.0
84						合計	37	63.21						
85		G4-SD-103	G4	8.00	700.0	510.0	2	0.71	T1CW F-2	F	7/F-8/F	SD梗頂格	760.0	570.0
86	B修改寬度及款式	G6-SD-105	G6	8.00	1032.5	510.0	2	1.05	T1CW D-1左	D	7/F-8/F	SD梗頂格	1092.5	570.0
87		G4-SD-106	G4	8.00	707.5	510.0	2	0.72	T1CW D-1中	D	7/F-8/F	SD梗頂格	767.5	570.0
88		G4-SD-113	G4	8.00	807.5	510.0	2	0.82	T1CWC-1右	C	7/F-8/F	SD梗頂格	867.5	570.0
89		G4-SD-115	G4	8.00	707.5	510.0	2	0.72	T1CWM-1	M	7/F-8/F	SD梗頂格	767.5	570.0
90		G4-SD-116	G4	8.00	707.5	510.0	2	0.72	T1CWL-2	L	7/F-8/F	SD梗頂格	767.5	570.0
91		G4-SD-123	G4	8.00	747.5	510.0	2	0.76	T1CWH-2右	H	7/F-8/F	SD梗頂格	807.5	570.0
92	B修改寬度及款式	G6-SD-202	G6	8.00	957.5	510.0	2	0.98	T2CWH-1右	H	7/F-8/F	SD梗頂格	1017.5	570.0
93		G4-SD-203	G4	8.00	707.5	510.0	2	0.72	T2CWG-2左	G	7/F-8/F	SD梗頂格	767.5	570.0
94		G4-SD-206	G4	8.00	707.5	510.0	2	0.72	T2CWF-1	F	7/F-8/F	SD梗頂格	767.5	570.0
95		G4-SD-207	G4	8.00	707.5	510.0	2	0.72	T2CWE-2	E	7/F-8/F	SD梗頂格	767.5	570.0
96		G4-SD-209	G4	8.00	800.0	510.0	2	0.82	T2CWD-1	D	7/F-8/F	SD梗頂格	860.0	570.0

	工程號:	J837	計算:	陈俊桦	日期:	2019.1.23	送呈:		<b>計算參考數值/所屬位置 分格</b>
	地盤名稱:	觀塘裕民坊	核對:	謝永林/鞠章芳	日期:	2019.1.23	副本:		
<b>地盤用玻璃B.M.表</b>	項目類別:	T1-T5座8F-SD門	批准:				A/C Code:		
BM編號:J837-CW-M01-S-GP04	修改版次: B版EI0064	總計玻璃面積 (平方米):		455.14	此BM依據第四版施工圖計算				

序號	修改內容	玻璃圖號	顏色與類型	厚度 (mm)	玻璃尺寸		數量 (塊)	總面積 (平方米)	使用位置	單位	樓層	分屬類型	分格寬度	分格高度
					寬度 (W mm)	高度 (H mm)								
97		G4-SD-210	G4	8.00	800.0	510.0	2	0.82	T2CWC-1	C	7/F-8/F	SD梗頂格	860.0	570.0
98	取消	G4-SD-215	G4	8.00	550.0	510.0	0	0.00	T2CWN-1	N	7/F-8/F	SD梗頂格	610.0	570.0
99		G4-SD-218	G4	8.00	632.5	510.0	2	0.65	T2CWL-2左	L	7/F-8/F	SD梗頂格	692.5	570.0
100	B修改寬度及款式	G6-SD-219	G6	8.00	907.5	510.0	2	0.93	T2CWL-2右	L	7/F-8/F	SD梗頂格	967.5	570.0
101	B修改寬度及款式	G6-SD-220	G6	8.00	907.5	510.0	2	0.93	T2CWK-1左	K	7/F-8/F	SD梗頂格	967.5	570.0
102		G4-SD-221	G4	8.00	645.0	510.0	2	0.66	T2CWK-1右	K	7/F-8/F	SD梗頂格	705.0	570.0
103		G4-SD-222	G4	8.00	645.0	510.0	2	0.66	T2CWJ-1左	J	7/F-8/F	SD梗頂格	705.0	570.0
104	B修改寬度及款式	G4-SD-223	G4	8.00	800.0	510.0	2	0.82	T2CWJ-1右	J	7/F-8/F	SD梗頂格	860.0	570.0
105		G4-SD-303	G4	8.00	775.0	510.0	2	0.79	T3CWM-2	M	7/F-8/F	SD梗頂格	835.0	570.0
106		G4-SD-304	G4	8.00	707.5	510.0	2	0.72	T3CWL-2	L	7/F-8/F	SD梗頂格	767.5	570.0
107		G4-SD-307	G4	8.00	707.5	510.0	2	0.72	T3CWK-1	K	7/F-8/F	SD梗頂格	767.5	570.0
108		G4-SD-308	G4	8.00	800.0	510.0	2	0.82	T3CWJ-2	J	7/F-8/F	SD梗頂格	860.0	570.0
109		G4-SD-309	G4	8.00	707.5	510.0	2	0.72	T3CWJ-1	J	7/F-8/F	SD梗頂格	767.5	570.0
110		G4-SD-311	G4	8.00	757.5	510.0	2	0.77	T3CWH-1	H	7/F-8/F	SD梗頂格	817.5	570.0
111		G4-SD-312	G4	8.00	707.5	510.0	2	0.72	T3CWC-2	C	7/F-8/F	SD梗頂格	767.5	570.0
112		G4-SD-318	G4	8.00	756.0	510.0	2	0.77	T3CWD-1左	D	7/F-8/F	SD梗頂格	816.0	570.0
113		G4-SD-319	G4	8.00	707.5	510.0	2	0.72	T3CWD-1右	D	7/F-8/F	SD梗頂格	767.5	570.0
114		G4-SD-320	G4	8.00	707.5	510.0	2	0.72	T3CWG-1左	G	7/F-8/F	SD梗頂格	767.5	570.0
115		G4-SD-321	G4	8.00	757.5	510.0	2	0.77	T3CWG-1右	G	7/F-8/F	SD梗頂格	817.5	570.0
116		G4-SD-504	G4	8.00	652.5	510.0	2	0.67	T5CWJK-1	JK	7/F-8/F	SD梗頂格	712.5	570.0
117		G4-SD-507	G4	8.00	825.0	510.0	2	0.84	T5CWG-2	G	7/F-8/F	SD梗頂格	885.0	570.0
118		G4-SD-508	G4	8.00	707.5	510.0	2	0.72	T5CWG-1	G	7/F-8/F	SD梗頂格	767.5	570.0
119		G4-SD-509	G4	8.00	707.5	510.0	2	0.72	T5CWF-2	F	7/F-8/F	SD梗頂格	767.5	570.0
120		G4-SD-512	G4	8.00	707.5	510.0	2	0.72	T5CWE-1	E	7/F-8/F	SD梗頂格	767.5	570.0

	工程號:	J837	計算:	陈俊桦	日期:	2019.1.23	送呈:		<b>計算參考數值/所屬位置 分格</b>
	地盤名稱:	觀塘裕民坊	核對:	謝永林/鞠章芳	日期:	2019.1.23	副本:		
<b>地盤用玻璃B.M.表</b>	項目類別:	T1-T5座8F-SD門	批准:				A/C Code:		
BM編號:J837-CW-M01-S-GP04	修改版次:	B版EI0064	總計玻璃面積(平方米):	455.14	此BM依據第四版施工圖計算				

序號	修改內容	玻璃圖號	顏色與類型	厚度(mm)	玻璃尺寸		數量(塊)	總面積(平方米)	使用位置	單位	樓層	分屬類型	分格寬度	分格高度
					寬度(W mm)	高度(H mm)								
121		G4-SD-513	G4	8.00	707.5	510.0	2	0.72	T5CWD-2	D	7/F-8/F	SD梗頂格	767.5	570.0
122		G4-SD-515	G4	8.00	825.0	510.0	2	0.84	T5CWC-1左 下	C	7/F-8/F	SD梗頂格	885.0	570.0
123					合計		74	28.41						
124		G6-SD-101	G6	8.00	847.5	510.0	2	0.86	T1CW G-1左	G	7/F-8/F	SD梗頂格	907.5	570.0
125	空	空	空	空	空	空	空	空	T1CW G-1右	G	無頂格	SD梗頂格		570.0
126		G6-SD-104	G6	8.00	907.5	510.0	2	0.93	T1CW E-1	E	7/F-8/F	SD梗頂格	967.5	570.0
127		G6-SD-107	G6	8.00	875.0	510.0	2	0.89	T1CW D-1右	D	7/F-8/F	SD梗頂格	935	570.0
128		G6-SD-108	G6	8.00	1220.0	510.0	2	1.24	T1CW A-3	A	7/F-8/F	SD梗頂格	1280.0	570.0
129		G6-SD-109	G6	8.00	947.5	510.0	2	0.97	T1CW A-2	A	7/F-8/F	SD梗頂格	1007.5	570.0
130		G6-SD-110	G6	8.00	947.5	510.0	2	0.97	T1CWB-2	B	7/F-8/F	SD梗頂格	1007.5	570.0
131		G6-SD-111	G6	8.00	1370.0	510.0	2	1.40	T1CWB-1	B	7/F-8/F	SD梗頂格	1430.0	570.0
132		G6-SD-112	G6	8.00	975.0	510.0	2	0.99	T1CWC-1左	C	7/F-8/F	SD梗頂格	1035.0	570.0
133		G6-SD-114	G6	8.00	875.0	510.0	2	0.89	T1CWM-2	M	7/F-8/F	SD梗頂格	935.0	570.0
134		G6-SD-117	G6	8.00	875.0	510.0	2	0.89	T1CWL-1	L	7/F-8/F	SD梗頂格	935.0	570.0
135		G6-SD-118	G6	8.00	875.0	510.0	2	0.89	T1CWK-2	K	7/F-8/F	SD梗頂格	935.0	570.0
136		G6-SD-121	G6	8.00	900.0	510.0	2	0.92	T1CWJ-1	J	7/F-8/F	SD梗頂格	960.0	570.0
137		G6-SD-122	G6	8.00	1075.0	510.0	2	1.10	T1CWH-2左	H	7/F-8/F	SD梗頂格	1135.0	570.0
138		G6-SD-201	G6	8.00	847.5	510.0	2	0.86	T2CWH-1左	H	7/F-8/F	SD梗頂格	907.5	570.0
139		G6-SD-204	G6	8.00	875.0	510.0	2	0.89	T2CWG-2右	G	7/F-8/F	SD梗頂格	935.0	570.0
140		G6-SD-205	G6	8.00	875.0	510.0	2	0.89	T2CWF-2	F	7/F-8/F	SD梗頂格	935.0	570.0
141		G6-SD-208	G6	8.00	875.0	510.0	2	0.89	T2CWE-1	E	7/F-8/F	SD梗頂格	935.0	570.0
142		G6-SD-211	G6	8.00	1225.0	510.0	2	1.25	T2CWB-2左	B	7/F-8/F	SD梗頂格	1285.0	570.0
143		G6-SD-212	G6	8.00	847.5	510.0	2	0.86	T2CWB-2右	B	7/F-8/F	SD梗頂格	907.5	570.0
144		G6-SD-213	G6	8.00	847.5	510.0	2	0.86	T2CWA-1左	A	7/F-8/F	SD梗頂格	907.5	570.0


 美特鋁質 有限公司 MIDI Aluminium Fabricator Ltd.		工程號:	J837	計算:	陈俊桦	日期:	2019.1.23	送呈:			計算參考數值/所屬位置 分格			
		地盤名稱:	觀塘裕民坊	核對:	謝永林/鞠章芳	日期:	2019.1.23	副本:						
地盤用玻璃B.M.表		項目類別:	T1-T5座8F-SD門	批准:				A/C Code:						
BM編號:J837-CW-M01-S-GP04		修改版次: B版EI0064		總計玻璃面積(平方米):		455.14		此BM依據第四版施工圖計算						
序號	修改內容	玻璃圖號	顏色與類型	厚度 (mm)	玻璃尺寸		數量 (塊)	總面積 (平方米)	使用位置	單位	樓層	分屬類型	分格寬度	分格高度
					寬度(W mm)	高度(H mm)								
145		G6-SD-214	G6	8.00	1125.0	510.0	2	1.15	T2CWA-1右	A	7/F-8/F	SD梗頂格	1185.0	570.0
146		G6-SD-216	G6	8.00	847.5	510.0	2	0.86	T2CWM-2	M	7/F-8/F	SD梗頂格	907.5	570.0
147		G6-SD-217	G6	8.00	1000.0	510.0	2	1.02	T2CWM-1	M	7/F-8/F	SD梗頂格	1060.0	570.0
148		G6-SD-301	G6	8.00	1307.5	510.0	2	1.33	T3CWF-1	F	7/F-8/F	SD梗頂格	1367.5	570.0
149		G6-SD-302	G6	8.00	1107.5	510.0	2	1.13	T3CWE-1	E	7/F-8/F	SD梗頂格	1167.5	570.0
150		G6-SD-305	G6	8.00	925.0	510.0	2	0.94	T3CWL-1	L	7/F-8/F	SD梗頂格	985.0	570.0
151		G6-SD-306	G6	8.00	875.0	510.0	2	0.89	T3CWK-2	K	7/F-8/F	SD梗頂格	935.0	570.0
152		G6-SD-310	G6	8.00	1322.4	510.0	2	1.35	T3CWH-2	H	7/F-8/F	SD梗頂格	1480.0	570.0
153		G6-SD-313	G6	8.00	875.0	510.0	2	0.89	T3CWC-1	C	7/F-8/F	SD梗頂格	935.0	570.0
154		G6-SD-314	G6	8.00	1325.0	510.0	2	1.35	T3CWB-2左	B	7/F-8/F	SD梗頂格	1385.0	570.0
155		G6-SD-315	G6	8.00	847.5	510.0	2	0.86	T3CWB-2右	B	7/F-8/F	SD梗頂格	907.5	570.0
156		G6-SD-316	G6	8.00	847.5	510.0	2	0.86	T3CWA-1左	A	7/F-8/F	SD梗頂格	907.5	570.0
157		G6-SD-317	G6	8.00	1225.0	510.0	2	1.25	T3CWA-1右	A	7/F-8/F	SD梗頂格	1285.0	570.0
158		G6-SD-501	G6	8.00	1000.0	510.0	2	1.02	T5CWN-1	N	7/F-8/F	SD梗頂格	1060.0	570.0
159		G6-SD-502	G6	8.00	1200.0	510.0	2	1.22	T5CWM-2	M	7/F-8/F	SD梗頂格	1260.0	570.0
160		G6-SD-503	G6	8.00	950.0	510.0	2	0.97	T5CWL-1	L	7/F-8/F	SD梗頂格	1010.0	570.0
161		G6-SD-505	G6	8.00	847.5	510.0	2	0.86	T5CWH-2	H	7/F-8/F	SD梗頂格	907.5	570.0
162		G6-SD-506	G6	8.00	875.0	510.0	2	0.89	T5CWH-1	H	7/F-8/F	SD梗頂格	935.0	570.0
163		G6-SD-510	G6	8.00	875.0	510.0	2	0.89	T5CWF-1	F	7/F-8/F	SD梗頂格	935.0	570.0
164		G6-SD-511	G6	8.00	900.0	510.0	2	0.92	T5CWE-2	E	7/F-8/F	SD梗頂格	960.0	570.0
165		G6-SD-514	G6	8.00	900.0	510.0	2	0.92	T5CWD-1	D	7/F-8/F	SD梗頂格	960.0	570.0
166		G6-SD-517	G6	8.00	929.0	510.0	2	0.95	T5CWC-1右 下	C	7/F-8/F	SD梗頂格	989.0	570.0
167		G6-SD-518	G6	8.00	1420.0	510.0	2	1.45	T5CWA-3	A	7/F-8/F	SD梗頂格	1480.0	570.0
168						合計	86	43.46						

 美特鋁質 有限公司 MIDI Aluminium Fabricator Ltd.		工程號:	J837	計算:	陈俊桦	日期:	2019.1.23	送呈:		計算參考數值/所屬位置 分格				
		地盤名稱:	觀塘裕民坊	核對:	謝永林/鞠章芳	日期:	2019.1.23	副本:						
地盤用玻璃B.M.表		項目類別:	T1-T5座8F-SD門	批准:		A/C Code:								
BM編號:J837-CW-M01-S-GP04		修改版次:	B版EI0064	總計玻璃面積 (平方米):		455.14	此BM依據第四版施工圖計算							
序號	修改內容	玻璃圖號	顏色與類型	厚度 (mm)	玻璃尺寸		數量 (塊)	總面積 (平方米)	使用位置	單位	樓層	分屬類型	分格寬度	分格高度
					寬度 (W mm)	高度 (H mm)								
169		G7-SD-101	G7	17.52	936.0	2386.0	1	2.23	T1CW G-1左	G	7/F-8/F	SD推拉門	1120.0	2625.0
170		G7-SD-102	G7	17.52	876.0	2386.0	1	2.09	T1CW G-1右	G	7/F-8/F	SD推拉門	1060.0	2625.0
171	B修改寬度	G7-SD-103	G7	17.52	1196.0	2386.0	1	2.85	T1CW F-2	F	7/F-8/F	SD推拉門	1380.0	2625.0
172		G7-SD-104	G7	17.52	936.0	2386.0	1	2.23	T1CW E-1	E	7/F-8/F	SD推拉門	1120.0	2625.0
173		G7-SD-105	G7	17.52	1186.0	2386.0	1	2.83	T1CW D-1左	D	7/F-8/F	SD推拉門	1370.0	2625.0
174		G7-SD-106	G7	17.52	986.0	2386.0	1	2.35	T1CW D-1中	D	7/F-8/F	SD推拉門	1170.0	2625.0
175		G7-SD-107	G7	17.52	1186.0	2386.0	1	2.83	T1CW D-1右	D	7/F-8/F	SD推拉門	1370.0	2625.0
176		G7-SD-108	G7	17.52	1641.0	2386.0	1	3.92	T1CW A-3	A	7/F-8/F	SD推拉門	1825.0	2625.0
177		G7-SD-109	G7	17.52	936.0	2386.0	1	2.23	T1CW A-2	A	7/F-8/F	SD推拉門	1120.0	2625.0
178		G7-SD-110	G7	17.52	936.0	2386.0	1	2.23	T1CWB-2	B	7/F-8/F	SD推拉門	1120.0	2625.0
179		G7-SD-111	G7	17.52	1336.0	2386.0	1	3.19	T1CWB-1	B	7/F-8/F	SD推拉門	1520.0	2625.0
180		G7-SD-112	G7	17.52	1336.0	2386.0	1	3.19	T1CWC-1左	C	7/F-8/F	SD推拉門	1520.0	2625.0
181		G7-SD-113	G7	17.52	1036.0	2386.0	1	2.47	T1CWC-1右	C	7/F-8/F	SD推拉門	1220.0	2625.0
182		G7-SD-114	G7	17.52	1186.0	2386.0	1	2.83	T1CWM-2	M	7/F-8/F	SD推拉門	1370.0	2625.0
183		G7-SD-115	G7	17.52	986.0	2386.0	1	2.35	T1CWM-1	M	7/F-8/F	SD推拉門	1170.0	2625.0
184		G7-SD-116	G7	17.52	986.0	2386.0	1	2.35	T1CWL-2	L	7/F-8/F	SD推拉門	1170.0	2625.0
185		G7-SD-117	G7	17.52	1186.0	2386.0	1	2.83	T1CWL-1	L	7/F-8/F	SD推拉門	1370.0	2625.0
186		G7-SD-118	G7	17.52	1186.0	2386.0	1	2.83	T1CWK-2	K	7/F-8/F	SD推拉門	1370.0	2625.0
187		G7-SD-121	G7	17.52	1186.0	2386.0	1	2.83	T1CWJ-1	J	7/F-8/F	SD推拉門	1370.0	2625.0
188		G7-SD-122	G7	17.52	1336.0	2386.0	1	3.19	T1CWH-2左	H	7/F-8/F	SD推拉門	1520.0	2625.0
189		G7-SD-123	G7	17.52	936.0	2386.0	1	2.23	T1CWH-2右	H	7/F-8/F	SD推拉門	1120.0	2625.0
190		G7-SD-201	G7	17.52	986.0	2386.0	1	2.35	T2CWH-1左	H	7/F-8/F	SD推拉門	1170.0	2625.0
191		G7-SD-202	G7	17.52	1186.0	2386.0	1	2.83	T2CWH-1右	H	7/F-8/F	SD推拉門	1370.0	2625.0
192		G7-SD-203	G7	17.52	986.0	2386.0	1	2.35	T2CWG-2左	G	7/F-8/F	SD推拉門	1170.0	2625.0



		工程號:	J837	計算:	陈俊桦	日期:	2019.1.23	送呈:		計算參考數值/所屬位置 分格				
		地盤名稱:	觀塘裕民坊	核對:	謝永林/鞠章芳	日期:	2019.1.23	副本:						
地盤用玻璃B.M.表		項目類別:	T1-T5座8F-SD門	批准:		A/C Code:								
BM編號:J837-CW-M01-S-GP04		修改版次: B版EI0064		總計玻璃面積(平方米):		455.14		此BM依據第四版施工圖計算						
序號	修改內容	玻璃圖號	顏色與類型	厚度 (mm)	玻璃尺寸		數量 (塊)	總面積 (平方米)	使用位置	單位	樓層	分屬類型	分格寬度	分格高度
					寬度(W mm)	高度(H mm)								
193		G7-SD-204	G7	17.52	1186.0	2386.0	1	2.83	T2CWG-2右	G	7/F-8/F	SD推拉門	1370.0	2625.0
194		G7-SD-205	G7	17.52	1186.0	2386.0	1	2.83	T2CWF-2	F	7/F-8/F	SD推拉門	1370.0	2625.0
195		G7-SD-206	G7	17.52	986.0	2386.0	1	2.35	T2CWF-1	F	7/F-8/F	SD推拉門	1170.0	2625.0
196		G7-SD-207	G7	17.52	986.0	2386.0	1	2.35	T2CWE-2	E	7/F-8/F	SD推拉門	1170.0	2625.0
197		G7-SD-208	G7	17.52	1186.0	2386.0	1	2.83	T2CWE-1	E	7/F-8/F	SD推拉門	1370.0	2625.0
198		G7-SD-209	G7	17.52	1186.0	2386.0	1	2.83	T2CWD-1	D	7/F-8/F	SD推拉門	1370.0	2625.0
199		G7-SD-210	G7	17.52	1186.0	2386.0	1	2.83	T2CWC-1	C	7/F-8/F	SD推拉門	1370.0	2625.0
200		G7-SD-211	G7	17.52	1336.0	2386.0	1	3.19	T2CWB-2左	B	7/F-8/F	SD推拉門	1520.0	2625.0
201		G7-SD-212	G7	17.52	936.0	2386.0	1	2.23	T2CWB-2右	B	7/F-8/F	SD推拉門	1120.0	2625.0
202		G7-SD-213	G7	17.52	936.0	2386.0	1	2.23	T2CWA-1左	A	7/F-8/F	SD推拉門	1120.0	2625.0
203		G7-SD-214	G7	17.52	1336.0	2386.0	1	3.19	T2CWA-1右	A	7/F-8/F	SD推拉門	1520.0	2625.0
204	取消	G7-SD-215	G7	17.52	1186.0	2386.0	0	0.00	T2CWN-1	N	7/F-8/F	SD推拉門	1370.0	2625.0
205		G7-SD-216	G7	17.52	936.0	2386.0	1	2.23	T2CWM-2	M	7/F-8/F	SD推拉門	1120.0	2625.0
206		G7-SD-217	G7	17.52	1336.0	2386.0	1	3.19	T2CWM-1	M	7/F-8/F	SD推拉門	1520.0	2625.0
207		G7-SD-218	G7	17.52	911.0	2386.0	1	2.17	T2CWL-2左	L	7/F-8/F	SD推拉門	1095.0	2625.0
208		G7-SD-219	G7	17.52	1186.0	2386.0	1	2.83	T2CWL-2右	L	7/F-8/F	SD推拉門	1370.0	2625.0
209		G7-SD-220	G7	17.52	1186.0	2386.0	1	2.83	T2CWK-1左	K	7/F-8/F	SD推拉門	1370.0	2625.0
210		G7-SD-221	G7	17.52	1073.5	2386.0	1	2.56	T2CWK-1右	K	7/F-8/F	SD推拉門	1257.5	2625.0
211		G7-SD-222	G7	17.52	1073.5	2386.0	1	2.56	T2CWJ-1左	J	7/F-8/F	SD推拉門	1257.5	2625.0
212		G7-SD-223	G7	17.52	1186.0	2386.0	1	2.83	T2CWJ-1右	J	7/F-8/F	SD推拉門	1370.0	2625.0
213		G7-SD-301	G7	17.52	1336.0	2386.0	1	3.19	T3CWF-1	F	7/F-8/F	SD推拉門	1520.0	2625.0
214		G7-SD-302	G7	17.52	1336.0	2386.0	1	3.19	T3CWE-1	E	7/F-8/F	SD推拉門	1520.0	2625.0
215		G7-SD-303	G7	17.52	1336.0	2386.0	1	3.19	T3CWM-2	M	7/F-8/F	SD推拉門	1520.0	2625.0
216		G7-SD-304	G7	17.52	986.0	2386.0	1	2.35	T3CWL-2	L	7/F-8/F	SD推拉門	1170.0	2625.0

	工程號:	J837	計算:	陈俊桦	日期:	2019.1.23	送呈:		<b>計算參考數值/所屬位置 分格</b>
	地盤名稱:	觀塘裕民坊	核對:	謝永林/鞠章芳	日期:	2019.1.23	副本:		
<b>地盤用玻璃B.M.表</b>	項目類別:	T1-T5座8F-SD門	批准:				A/C Code:		
BM編號:J837-CW-M01-S-GP04	修改版次:	B版EI0064	總計玻璃面積(平方米):	455.14	此BM依據第四版施工圖計算				

序號	修改內容	玻璃圖號	顏色與類型	厚度 (mm)	玻璃尺寸		數量 (塊)	總面積 (平方米)	使用位置	單位	樓層	分屬類型	分格寬度	分格高度
					寬度(W mm)	高度(H mm)								
217		G7-SD-305	G7	17.52	1186.0	2386.0	1	2.83	T3CWL-1	L	7/F-8/F	SD推拉門	1370.0	2625.0
218		G7-SD-306	G7	17.52	1186.0	2386.0	1	2.83	T3CWL-2	K	7/F-8/F	SD推拉門	1370.0	2625.0
219		G7-SD-307	G7	17.52	986.0	2386.0	1	2.35	T3CWL-1	K	7/F-8/F	SD推拉門	1170.0	2625.0
220		G7-SD-308	G7	17.52	1186.0	2386.0	1	2.83	T3CWJ-2	J	7/F-8/F	SD推拉門	1370.0	2625.0
221		G7-SD-309	G7	17.52	986.0	2386.0	1	2.35	T3CWJ-1	J	7/F-8/F	SD推拉門	1170.0	2625.0
222		G7-SD-310	G7	17.52	986.0	2386.0	1	2.35	T3CWH-2	H	7/F-8/F	SD推拉門	1170.0	2625.0
223		G7-SD-311	G7	17.52	1186.0	2386.0	1	2.83	T3CWH-1	H	7/F-8/F	SD推拉門	1370.0	2625.0
224		G7-SD-312	G7	17.52	986.0	2386.0	1	2.35	T3CWC-2	C	7/F-8/F	SD推拉門	1170.0	2625.0
225		G7-SD-313	G7	17.52	1186.0	2386.0	1	2.83	T3CWC-1	C	7/F-8/F	SD推拉門	1370.0	2625.0
226		G7-SD-314	G7	17.52	1336.0	2386.0	1	3.19	T3CWB-2左	B	7/F-8/F	SD推拉門	1520.0	2625.0
227		G7-SD-315	G7	17.52	936.0	2386.0	1	2.23	T3CWB-2右	B	7/F-8/F	SD推拉門	1120.0	2625.0
228		G7-SD-316	G7	17.52	936.0	2386.0	1	2.23	T3CWA-1左	A	7/F-8/F	SD推拉門	1120.0	2625.0
229		G7-SD-317	G7	17.52	1336.0	2386.0	1	3.19	T3CWA-1右	A	7/F-8/F	SD推拉門	1520.0	2625.0
230		G7-SD-318	G7	17.52	1187.5	2386.0	1	2.83	T3CWD-1左	D	7/F-8/F	SD推拉門	1371.5	2625.0

		工程號:	J837	計算:	陈俊桦	日期:	2019.1.23	送呈:		計算參考數值/所屬位置 分格				
		地盤名稱:	觀塘裕民坊	核對:	謝永林/鞠章芳	日期:	2019.1.23	副本:						
地盤用玻璃B.M.表		項目類別:	T1-T5座8F-SD門	批准:		A/C Code:								
BM編號:J837-CW-M01-S-GP04		修改版次:	B版EI0064	總計玻璃面積(平方米):		455.14	此BM依據第四版施工圖計算							
序號	修改內容	玻璃圖號	顏色與類型	厚度 (mm)	玻璃尺寸		數量 (塊)	總面積 (平方米)	使用位置	單位	樓層	分屬類型	分格寬度	分格高度
					寬度(W mm)	高度(H mm)								
231		G7-SD-319	G7	17.52	936.0	2386.0	1	2.23	T3CWD-1右	D	7/F-8/F	SD推拉門	1120.0	2625.0
232		G7-SD-320	G7	17.52	936.0	2386.0	1	2.23	T3CWG-1左	G	7/F-8/F	SD推拉門	1120.0	2625.0
233		G7-SD-321	G7	17.52	1186.0	2386.0	1	2.83	T3CWG-1右	G	7/F-8/F	SD推拉門	1370.0	2625.0
234		G7-SD-501	G7	17.52	1361.0	2386.0	1	3.25	T5CWN-1	N	7/F-8/F	SD推拉門	1545.0	2625.0
235		G7-SD-502	G7	17.52	1361.0	2386.0	1	3.25	T5CWM-2	M	7/F-8/F	SD推拉門	1545.0	2625.0
236		G7-SD-503	G7	17.52	1361.0	2386.0	1	3.25	T5CWL-1	L	7/F-8/F	SD推拉門	1545.0	2625.0
237	B修改寬度	G7-SD-504	G7	17.52	1221.0	2386.0	1	2.91	T5CWJK-1	JK	7/F-8/F	SD推拉門	1405.0	2625.0
238		G7-SD-505	G7	17.52	986.0	2386.0	1	2.35	T5CWH-2	H	7/F-8/F	SD推拉門	1170.0	2625.0
239		G7-SD-506	G7	17.52	1211.0	2386.0	1	2.89	T5CWH-1	H	7/F-8/F	SD推拉門	1395.0	2625.0
240		G7-SD-507	G7	17.52	1186.0	2386.0	1	2.83	T5CWG-2	G	7/F-8/F	SD推拉門	1370.0	2625.0
241		G7-SD-508	G7	17.52	986.0	2386.0	1	2.35	T5CWG-1	G	7/F-8/F	SD推拉門	1170.0	2625.0
242		G7-SD-509	G7	17.52	986.0	2386.0	1	2.35	T5CWF-2	F	7/F-8/F	SD推拉門	1170.0	2625.0
243		G7-SD-510	G7	17.52	1186.0	2386.0	1	2.83	T5CWF-1	F	7/F-8/F	SD推拉門	1370.0	2625.0
244		G7-SD-511	G7	17.52	1186.0	2386.0	1	2.83	T5CWE-2	E	7/F-8/F	SD推拉門	1370.0	2625.0
245		G7-SD-512	G7	17.52	986.0	2386.0	1	2.35	T5CWE-1	E	7/F-8/F	SD推拉門	1170.0	2625.0
246		G7-SD-513	G7	17.52	986.0	2386.0	1	2.35	T5CWD-2	D	7/F-8/F	SD推拉門	1170.0	2625.0
247		G7-SD-514	G7	17.52	1186.0	2386.0	1	2.83	T5CWD-1	D	7/F-8/F	SD推拉門	1370.0	2625.0
248		G7-SD-515	G7	17.52	1386.0	2386.0	1	3.31	T5CWC-1左 下	C	7/F-8/F	SD推拉門	1570.0	2625.0
249		G7-SD-517	G7	17.52	1302.0	2386.0	1	3.11	T5CWC-1右	C	7/F-8/F	SD推拉門	1486.0	2625.0
250		G7-SD-518	G7	17.52	1361.0	2386.0	1	3.25	T5CWA-3	A	7/F-8/F	SD推拉門	1545.0	2625.0
251						合計	81	219.27						
252						總計:	322	455.14						

		工程號:	J837	計算:	陈俊桦	日期:	2019.1.23	送呈:		計算參考數值/所屬位置 分格				
		地盤名稱:	觀塘裕民坊	核對:	謝永林/鞠章芳	日期:	2019.1.23	副本:						
地盤用玻璃B.M.表		項目類別:	T1-T5座8F-SD門	批准:		A/C Code:								
BM編號:J837-CW-M01-S-GP04		修改版次:	B版EI0064	總計玻璃面積(平方米):		455.14	此BM依據第四版施工圖計算							
序號	修改內容	玻璃圖號	顏色與類型	厚度 (mm)	玻璃尺寸		數量 (塊)	總面積 (平方米)	使用位置	單位	樓層	分屬類型	分格寬度	分格高度
					寬度(W mm)	高度(H mm)								
加工注意事項/ 玻璃類型描述:		1).本表中之清片玻璃是 信義 原片，藍片玻璃是藍欣原片												
		2).本表中所有玻璃對角線尺寸偏差要求不超過負2mm。												
		3).本表中所有玻璃成品均需做雙面保護，用透明靜電膠紙加四周一寸FK白膠紙做雙面加固保護處理。												
		4).本表中所有玻璃成品均需注明室內外及其玻璃編號/使用位置/樓層，以便識別。												
		(G1)10 mm THK. TEMPERED BLUE GLASS (OUTER)+ 9 mm AIR SPACE + 8 mm THK. CLEAR TEMPERED GLASS (INNER) --- (D18110173)												
		(G3)- 10 mm THK. Heat Strengthen BLUE GLASS (OUTER)+ 9 mm AIR SPACE + 8 mm THK. TEMPERED GLASS (INNER) --- (D18110173)												
		(G4)- 8 mm THK. HEAT STRENGTHENED BLUE TINTED GLASS ( SPANDREL GLASS ) --- (D18070395)												
		(G6)- 8 mm THK. TEMPERED BLUE TINTED GLASS ( SPANDREL GLASS ) --- (D18070395)												
		(G7) 8 mm THK. BLUE GLASS (OUTER)+1.52PVB + 8 mm THK. HEAT STRENGTHENED BLUE TINTED GLASS (INNER)--- (D818110174)												

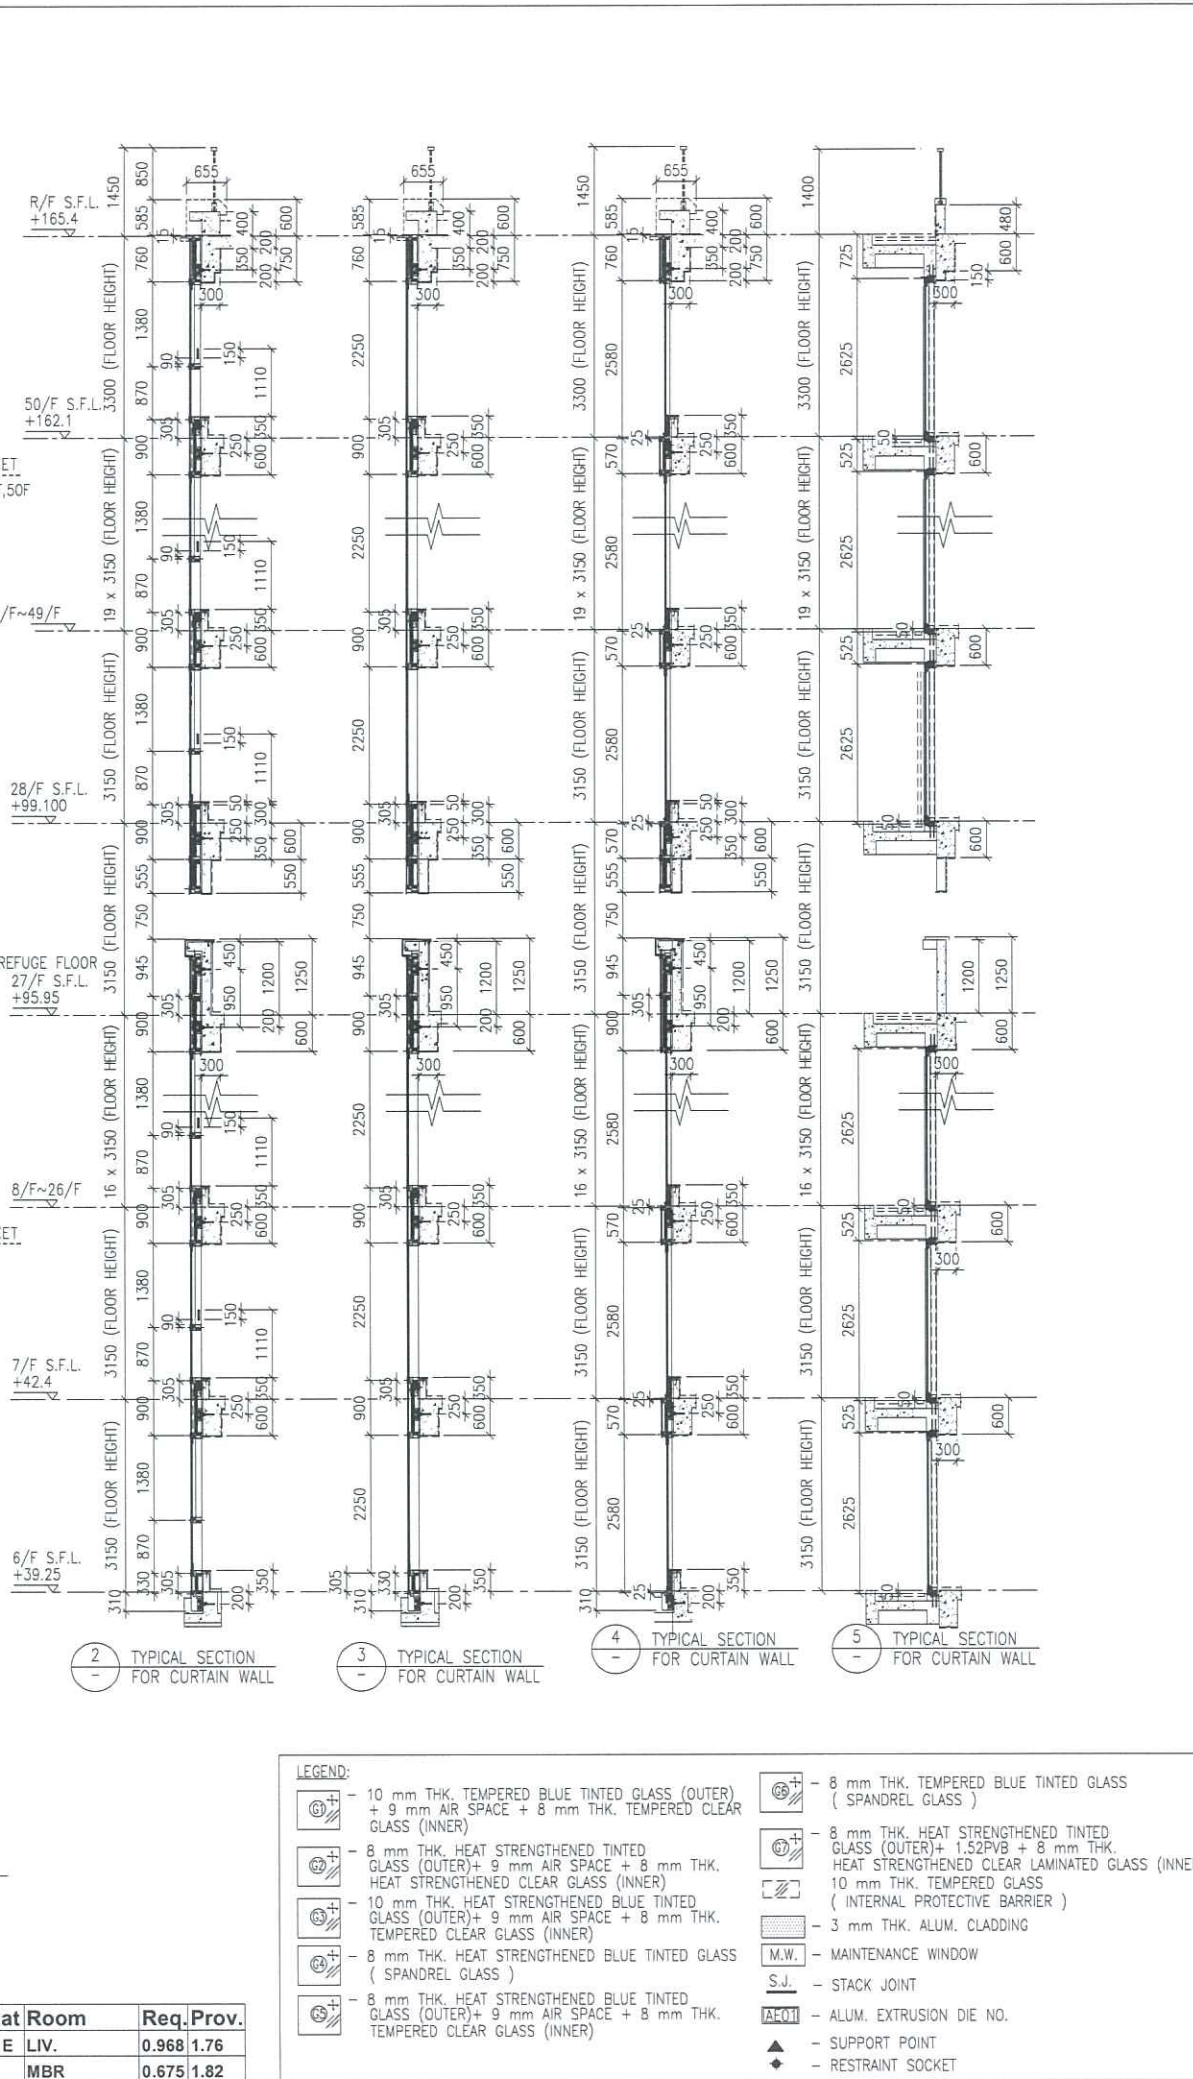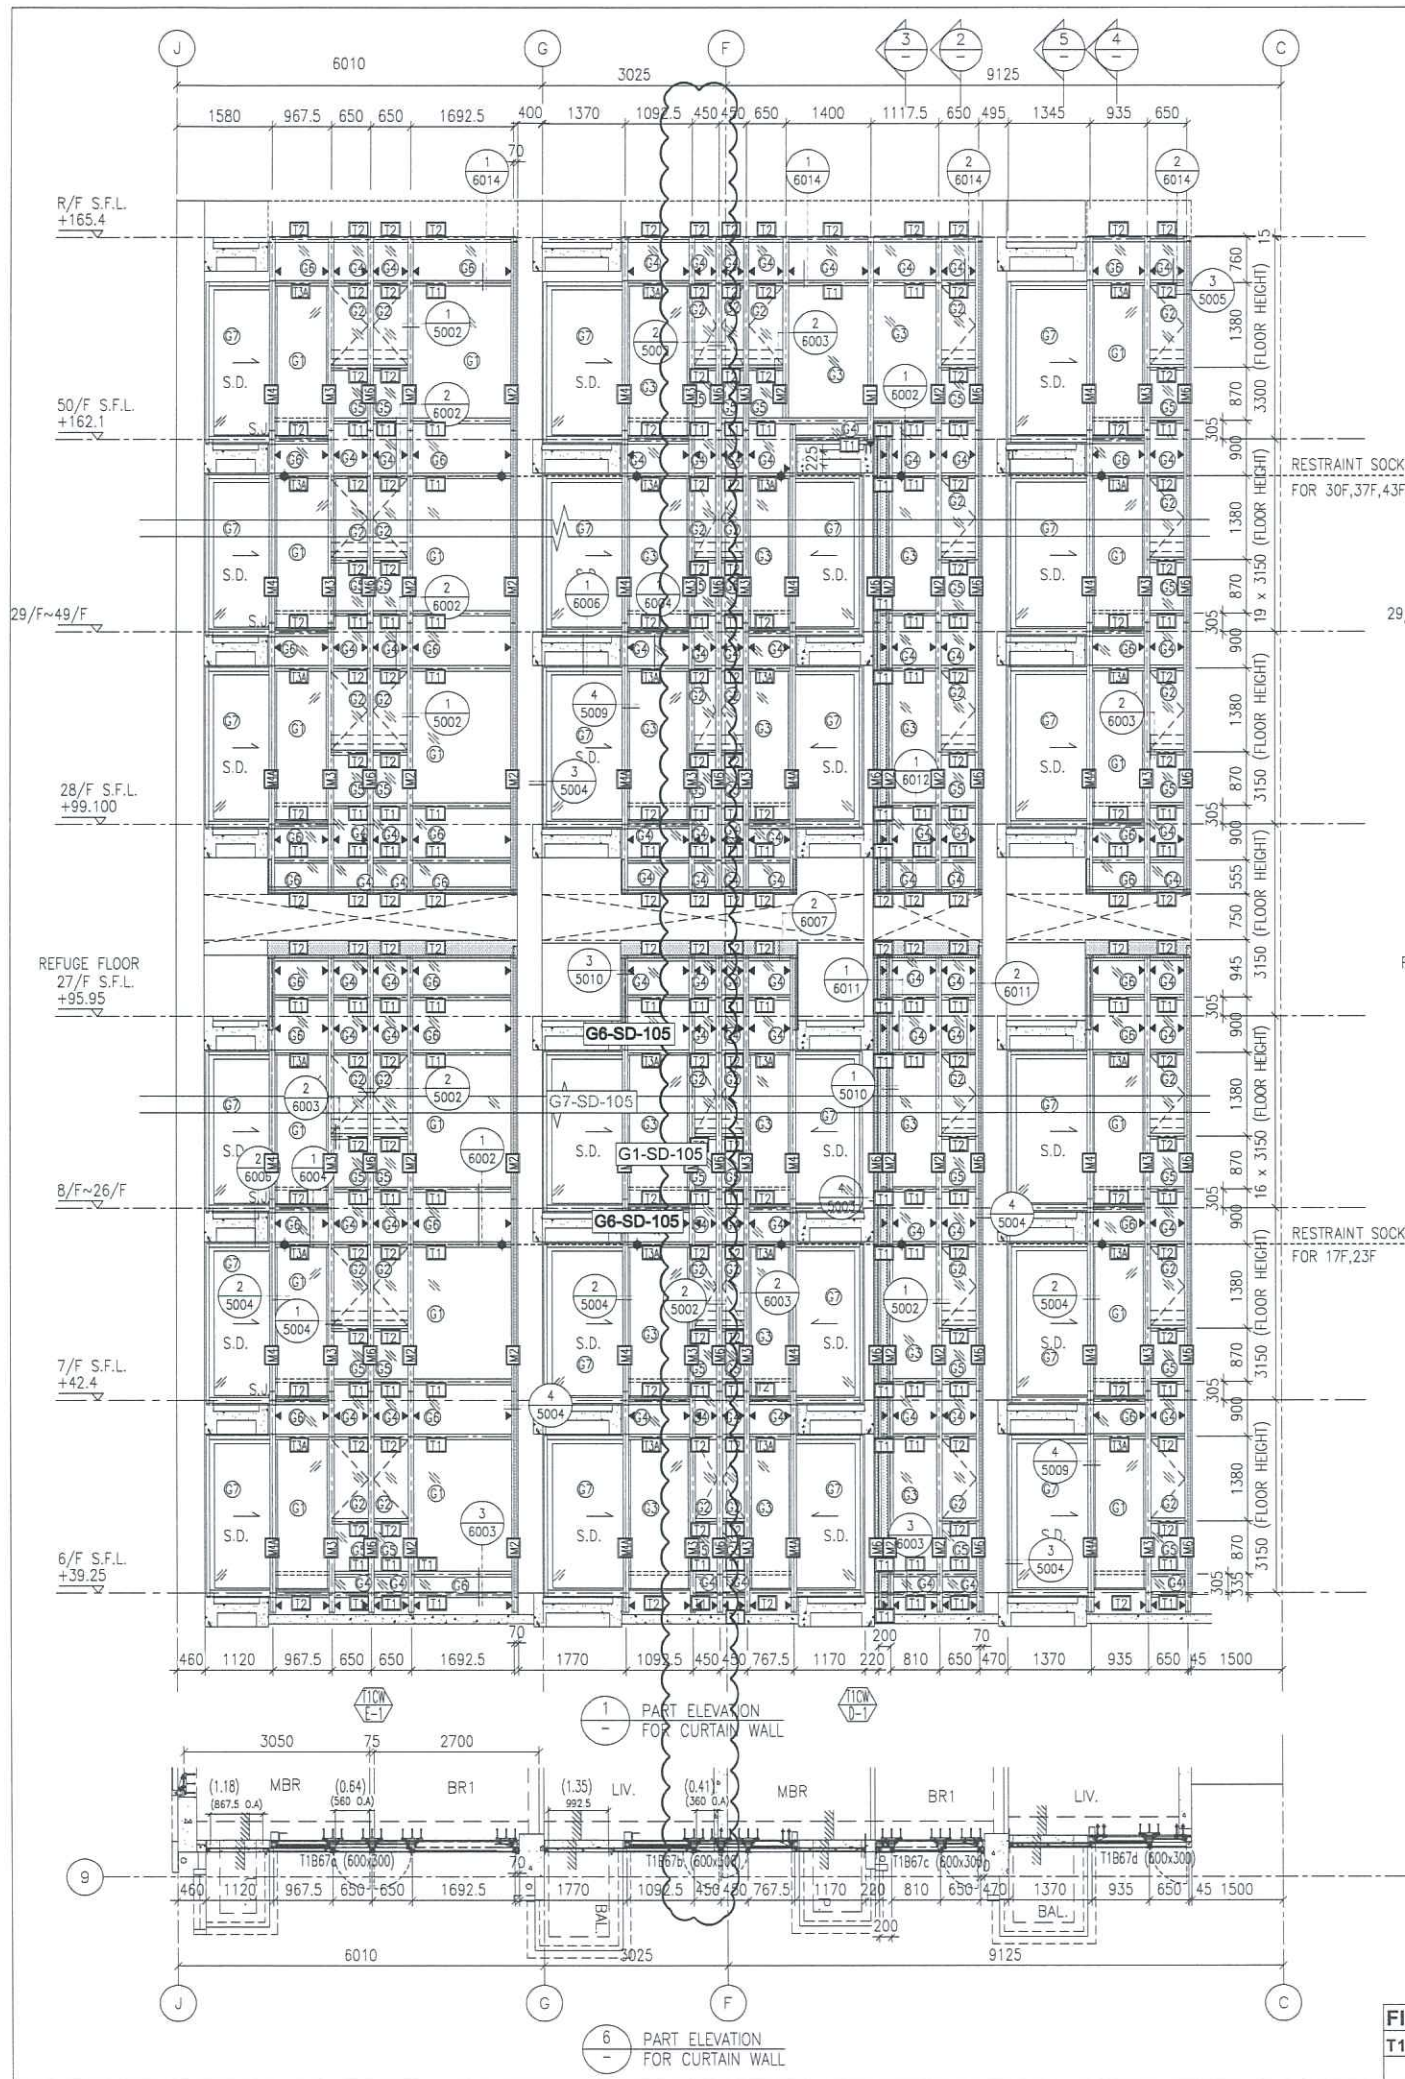

Flat Room	Req.	Prov.
T1E LIV.	0.968	1.76
MBR	0.675	1.82

- LEGEND:**
- 10 mm THK. TEMPERED BLUE TINTED GLASS (OUTER) + 9 mm AIR SPACE + 8 mm THK. TEMPERED CLEAR GLASS (INNER)
  - 8 mm THK. HEAT STRENGTHENED TINTED GLASS (OUTER) + 9 mm AIR SPACE + 8 mm THK. HEAT STRENGTHENED CLEAR GLASS (INNER)
  - 10 mm THK. HEAT STRENGTHENED BLUE TINTED GLASS (OUTER) + 9 mm AIR SPACE + 8 mm THK. TEMPERED CLEAR GLASS (INNER)
  - 8 mm THK. HEAT STRENGTHENED BLUE TINTED GLASS (SPANDREL GLASS)
  - 8 mm THK. HEAT STRENGTHENED BLUE TINTED GLASS (OUTER) + 1.52PV8 + 8 mm THK. HEAT STRENGTHENED CLEAR LAMINATED GLASS (INNER)
  - 10 mm THK. TEMPERED GLASS (INTERNAL PROTECTIVE BARRIER)
  - 3 mm THK. ALUM. CLADDING
  - MAINTENANCE WINDOW
  - STACK JOINT
  - ALUM. EXTRUSION DIE NO.
  - SUPPORT POINT
  - RESTRAINT SOCKET
  - 8 mm THK. TEMPERED BLUE TINTED GLASS (SPANDREL GLASS)

B.D. REF :

CLIENT : 信和置業有限公司 Sino Land Company Limited

ARCHITECT : WONG TUNG & PARTNERS LIMITED ARCHITECTS & PLANNERS

MAIN CONTRACTOR : CR Construction Company Limited

STRUCTURAL ENGINEER : AECOM

FAÇADE CONSULTANT : AECOM

**NOTE :**

- ALL DIMENSIONS ARE IN MM.
- ALL ELEVATIONS ARE VIEWED FROM OUTSIDE.
- ALL DIMENSIONS TO BE VERIFIED ON SITE BEFORE FABRICATION.

**LEGEND :**

- DETAIL MARK NO.
- REFER SHEET NO.
- FINISHED FLOOR LEVEL
- STRUCTURAL FLOOR LEVEL
- REVERSED DETAIL

D	22/12/2018	GENERAL REVISED
C	04/12/2018	GENERAL REVISED
B	24/11/2018	GENERAL REVISED
A	10/9/2018	GENERAL REVISED
NO	DATE	REVISED BY

JOB NO. : J-837

PROJECT : URA KWUN TONG TOWN CENTRE REDEVELOPMENT (AREA 2 & 3) AT NKIL 6514, KWUN TONG, KWLOON

TITLE : PART ELEVATION OF CURTAIN WALL AT TOWER 1

DATE : 04-JUL-18 SCALE : 1:60 (A1)

DRAWN BY : ASING CHECKED BY : -

**美特鋁質有限公司**  
MIDI ALUMINIUM FABRICATOR LTD.  
Units 6-8, Sunray Industrial Centre, 1/F  
610 Cha Kwo Ling Road, Kowloon  
Tel: 23489211-4 Fax: (852) 2727666

DWG NO. : J837-CW-2105 REV. : D

B.D. REF :

CLIENT :  
**信和置業有限公司**  
Sino Land Company Limited

ARCHITECT :  
**WONG TUNG & PARTNERS LIMITED**  
ARCHITECTS & PLANNERS

MAIN CONTRACTOR :  
**CR Construction Company Limited**

STRUCTURAL ENGINEER :  
**AECOM**

FAÇADE CONSULTANT:  
**AECOM**

NOTE :  
1. ALL DIMENSIONS ARE IN mm.  
2. ALL ELEVATIONS ARE VIEWED FROM OUTSIDE.  
3. ALL DIMENSIONS TO BE VERIFIED ON SITE BEFORE FABRICATION.

LEGEND :  
X1 - DETAIL MARK NO.  
X001 - REFER SHEET NO.  
1. F.F.L. --- FINISHED FLOOR LEVEL  
2. S.F.L. --- STRUCTURAL FLOOR LEVEL  
3. (R) --- REVERSED DETAIL



D	22/12/2018	GENERAL REVISED
C	04/12/2018	GENERAL REVISED
B	24/11/2018	GENERAL REVISED
A	10/9/2018	GENERAL REVISED
NO.	DATE	REVISED
		BY

JOB NO. : J-837  
PROJECT :  
URA KWUN TONG TOWN CENTRE  
REDEVELOPMENT (AREA 2 & 3) AT  
NKIL 6514, KWUN TONG, KWLOON

TITLE :  
PART ELEVATION  
OF CURTAIN WALL  
AT TOWER 1

DATE : 04-JUL-18 SCALE : 1:60 (A1)  
DRAWN BY : ASING CHECKED BY : -



**美特鋁質有限公司**  
MIDI ALUMINIUM FABRICATOR LTD.  
Units 6-8, Sunray Industrial Centre, 1/F  
610 Cho Kwo Ling Road, Kowloon  
Tel: 23489211-4 Fax: (852) 2727666  
DWG NO. : JB37-CW-2103 REV. : D

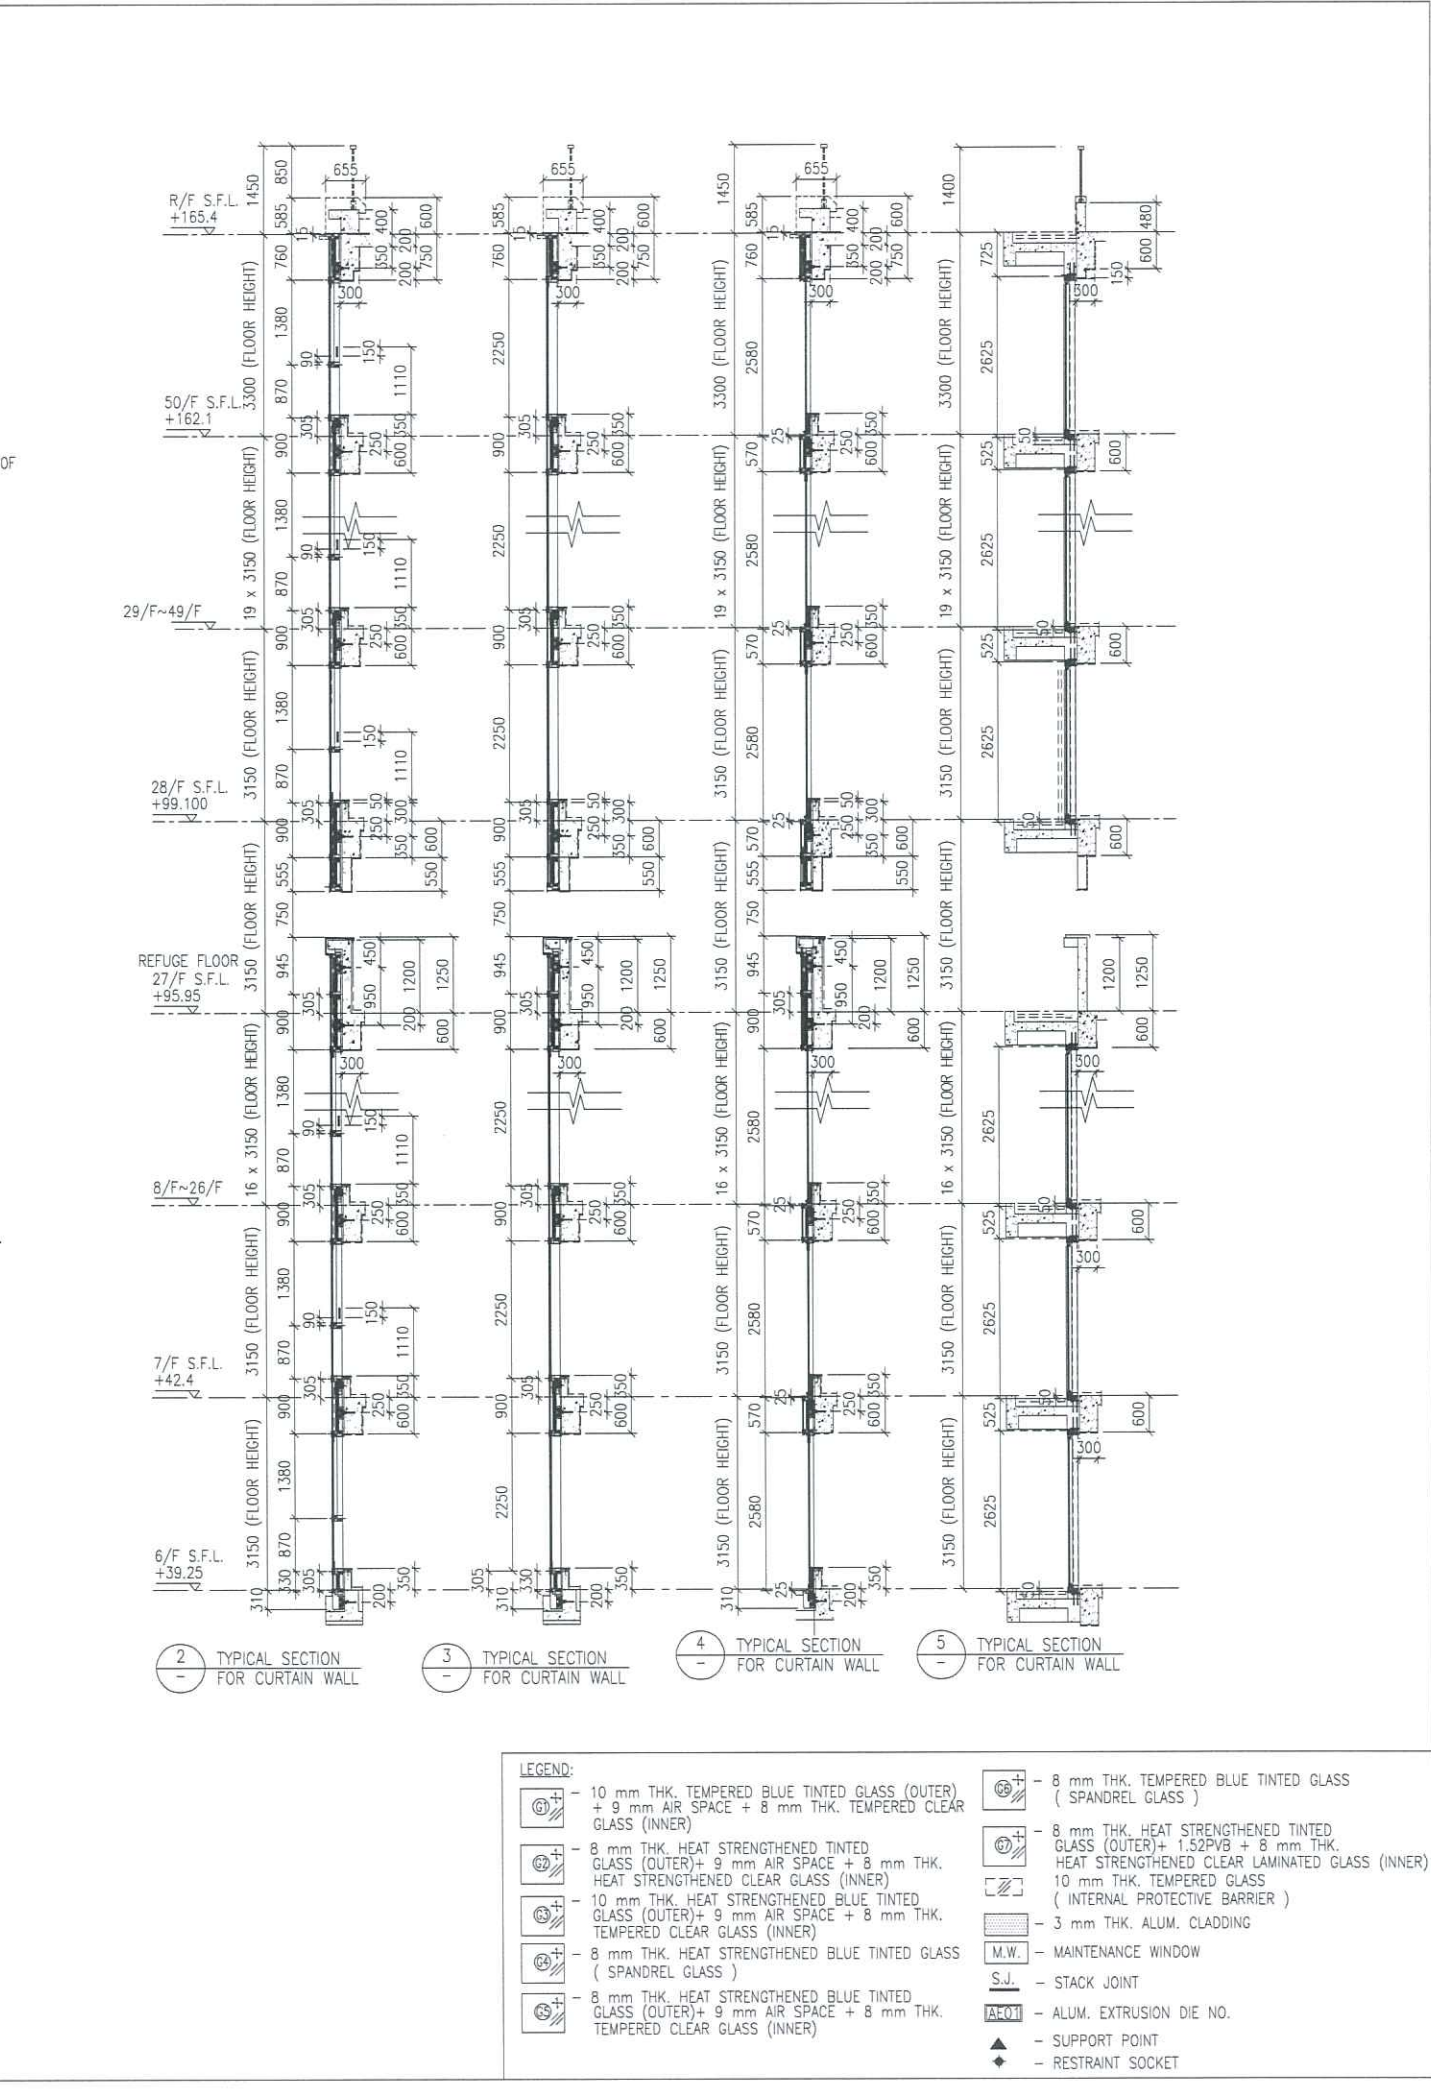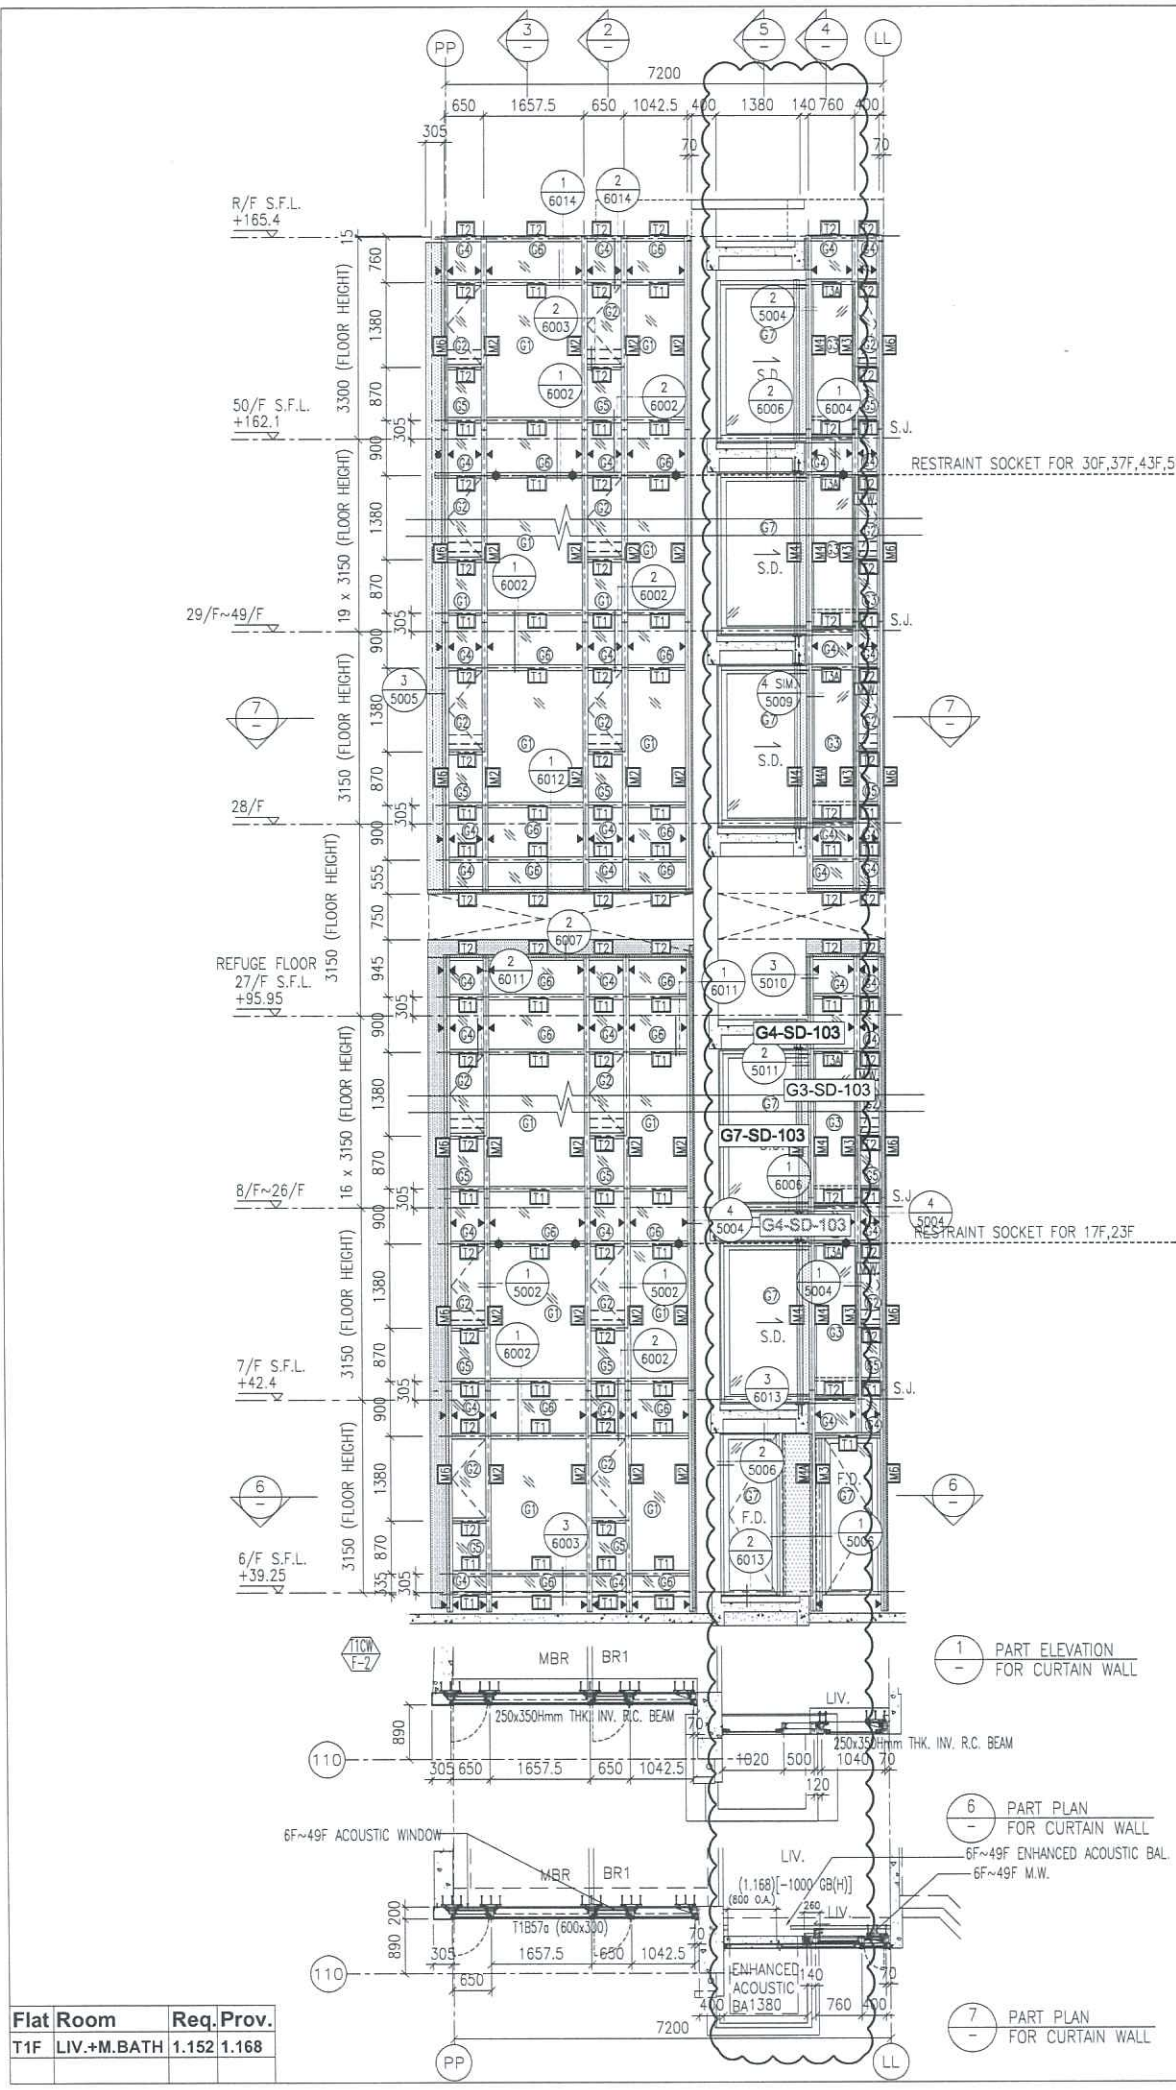

LEGEND:

- 10 mm THK. TEMPERED BLUE TINTED GLASS (OUTER) + 9 mm AIR SPACE + 8 mm THK. TEMPERED CLEAR GLASS (INNER)	- 8 mm THK. TEMPERED BLUE TINTED GLASS (SPANDREL GLASS)
- 8 mm THK. HEAT STRENGTHENED TINTED GLASS (OUTER) + 9 mm AIR SPACE + 8 mm THK. HEAT STRENGTHENED CLEAR GLASS (INNER)	- 8 mm THK. HEAT STRENGTHENED TINTED GLASS (OUTER) + 1.52PVG + 8 mm THK. HEAT STRENGTHENED CLEAR LAMINATED GLASS (INNER)
- 10 mm THK. HEAT STRENGTHENED BLUE TINTED GLASS (OUTER) + 9 mm AIR SPACE + 8 mm THK. TEMPERED CLEAR GLASS (INNER)	- 10 mm THK. TEMPERED GLASS (INTERNAL PROTECTIVE BARRIER)
- 8 mm THK. HEAT STRENGTHENED BLUE TINTED GLASS (SPANDREL GLASS)	- 3 mm THK. ALUM. CLADDING
- 8 mm THK. HEAT STRENGTHENED BLUE TINTED GLASS (OUTER) + 9 mm AIR SPACE + 8 mm THK. TEMPERED CLEAR GLASS (INNER)	- M.W. - MAINTENANCE WINDOW
	- S.J. - STACK JOINT
	- ALUM. EXTRUSION DIE NO.
	- SUPPORT POINT
	- RESTRAINT SOCKET

Flat Room	Req.Prov.
T1F LIV.+M.BATH	1.152 1.168

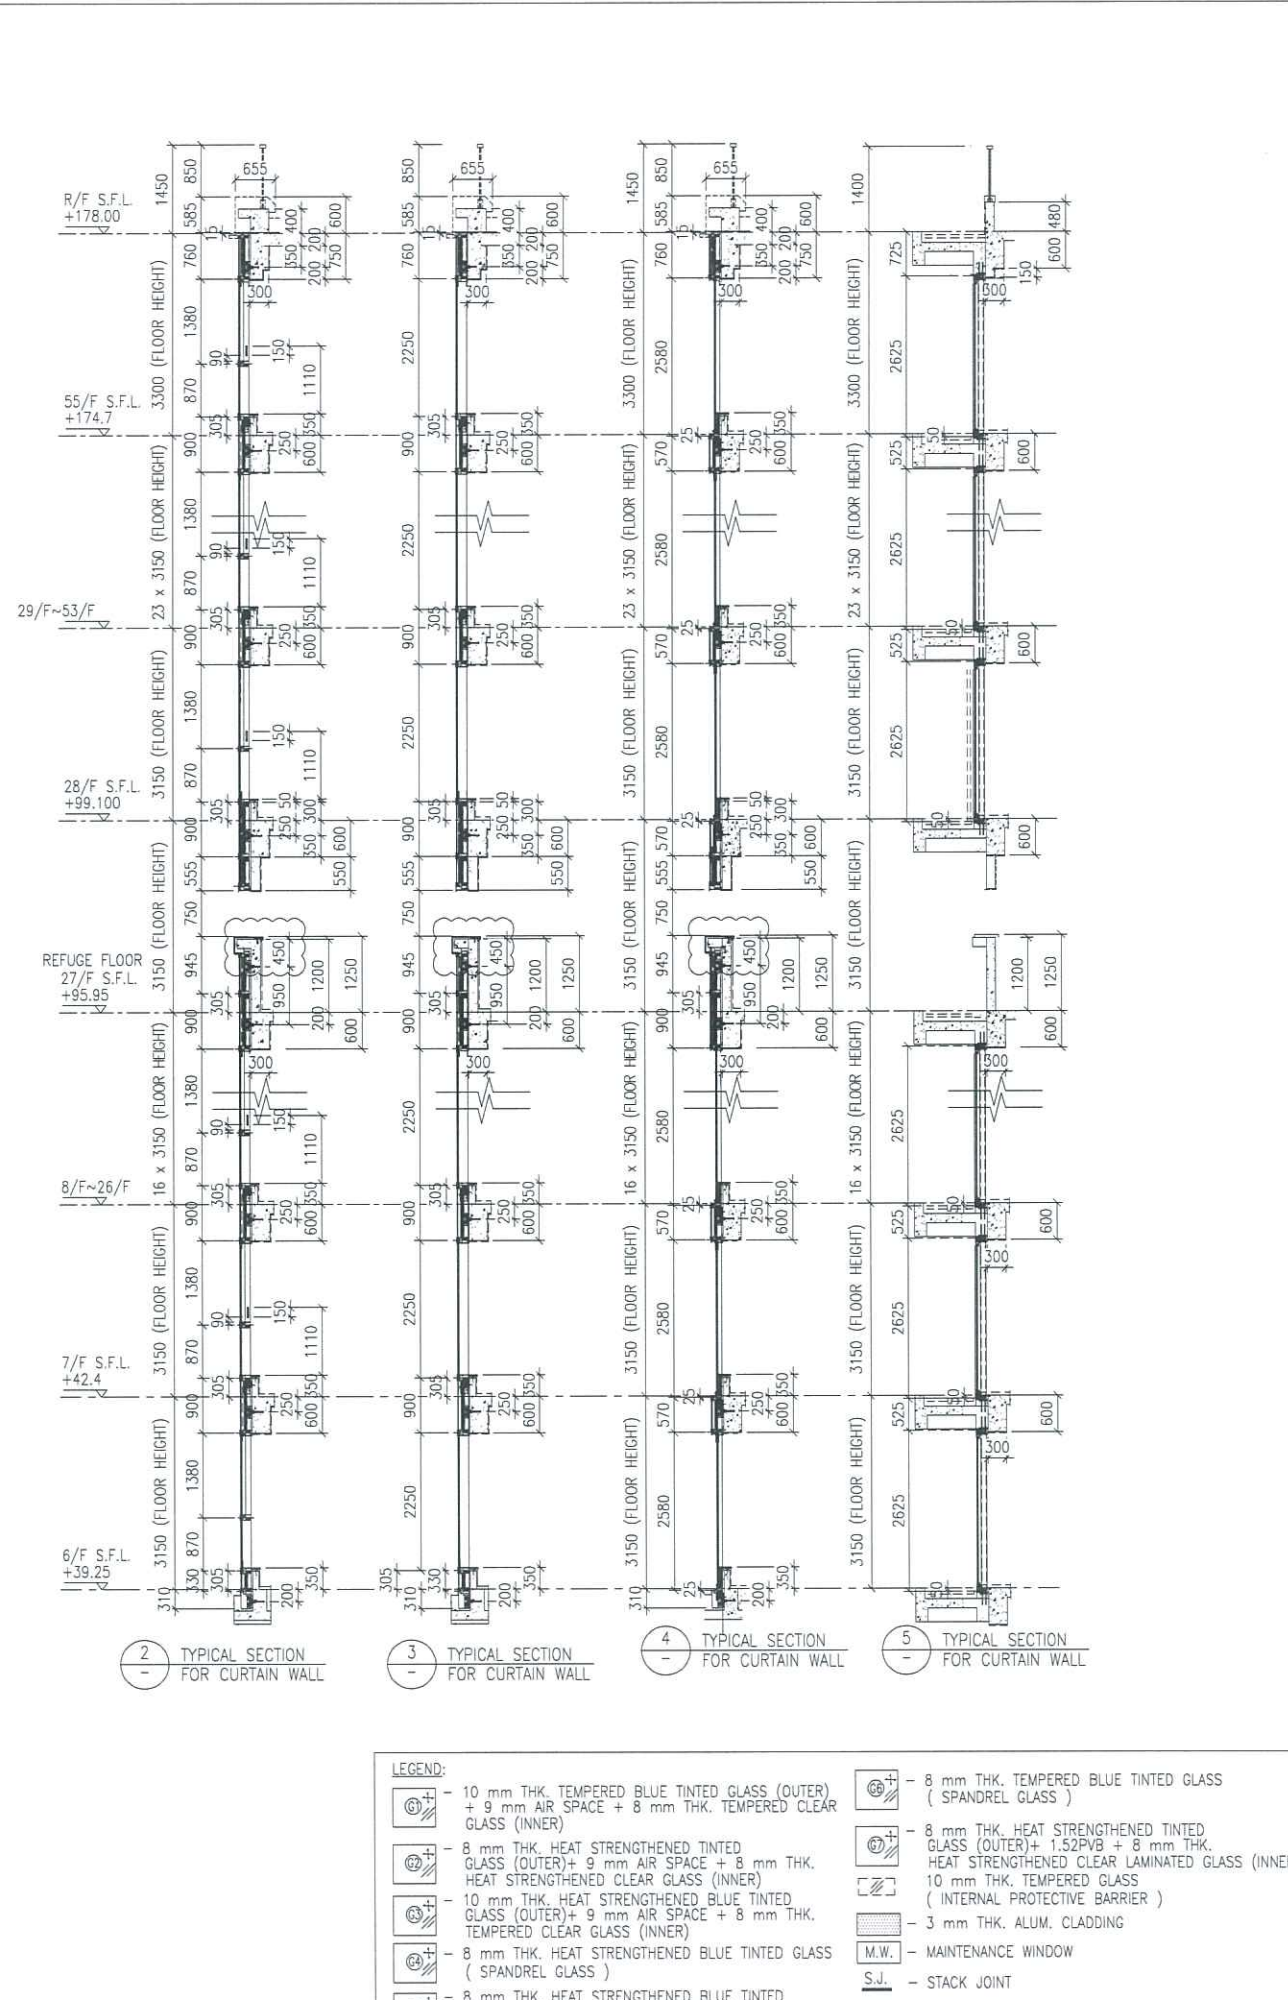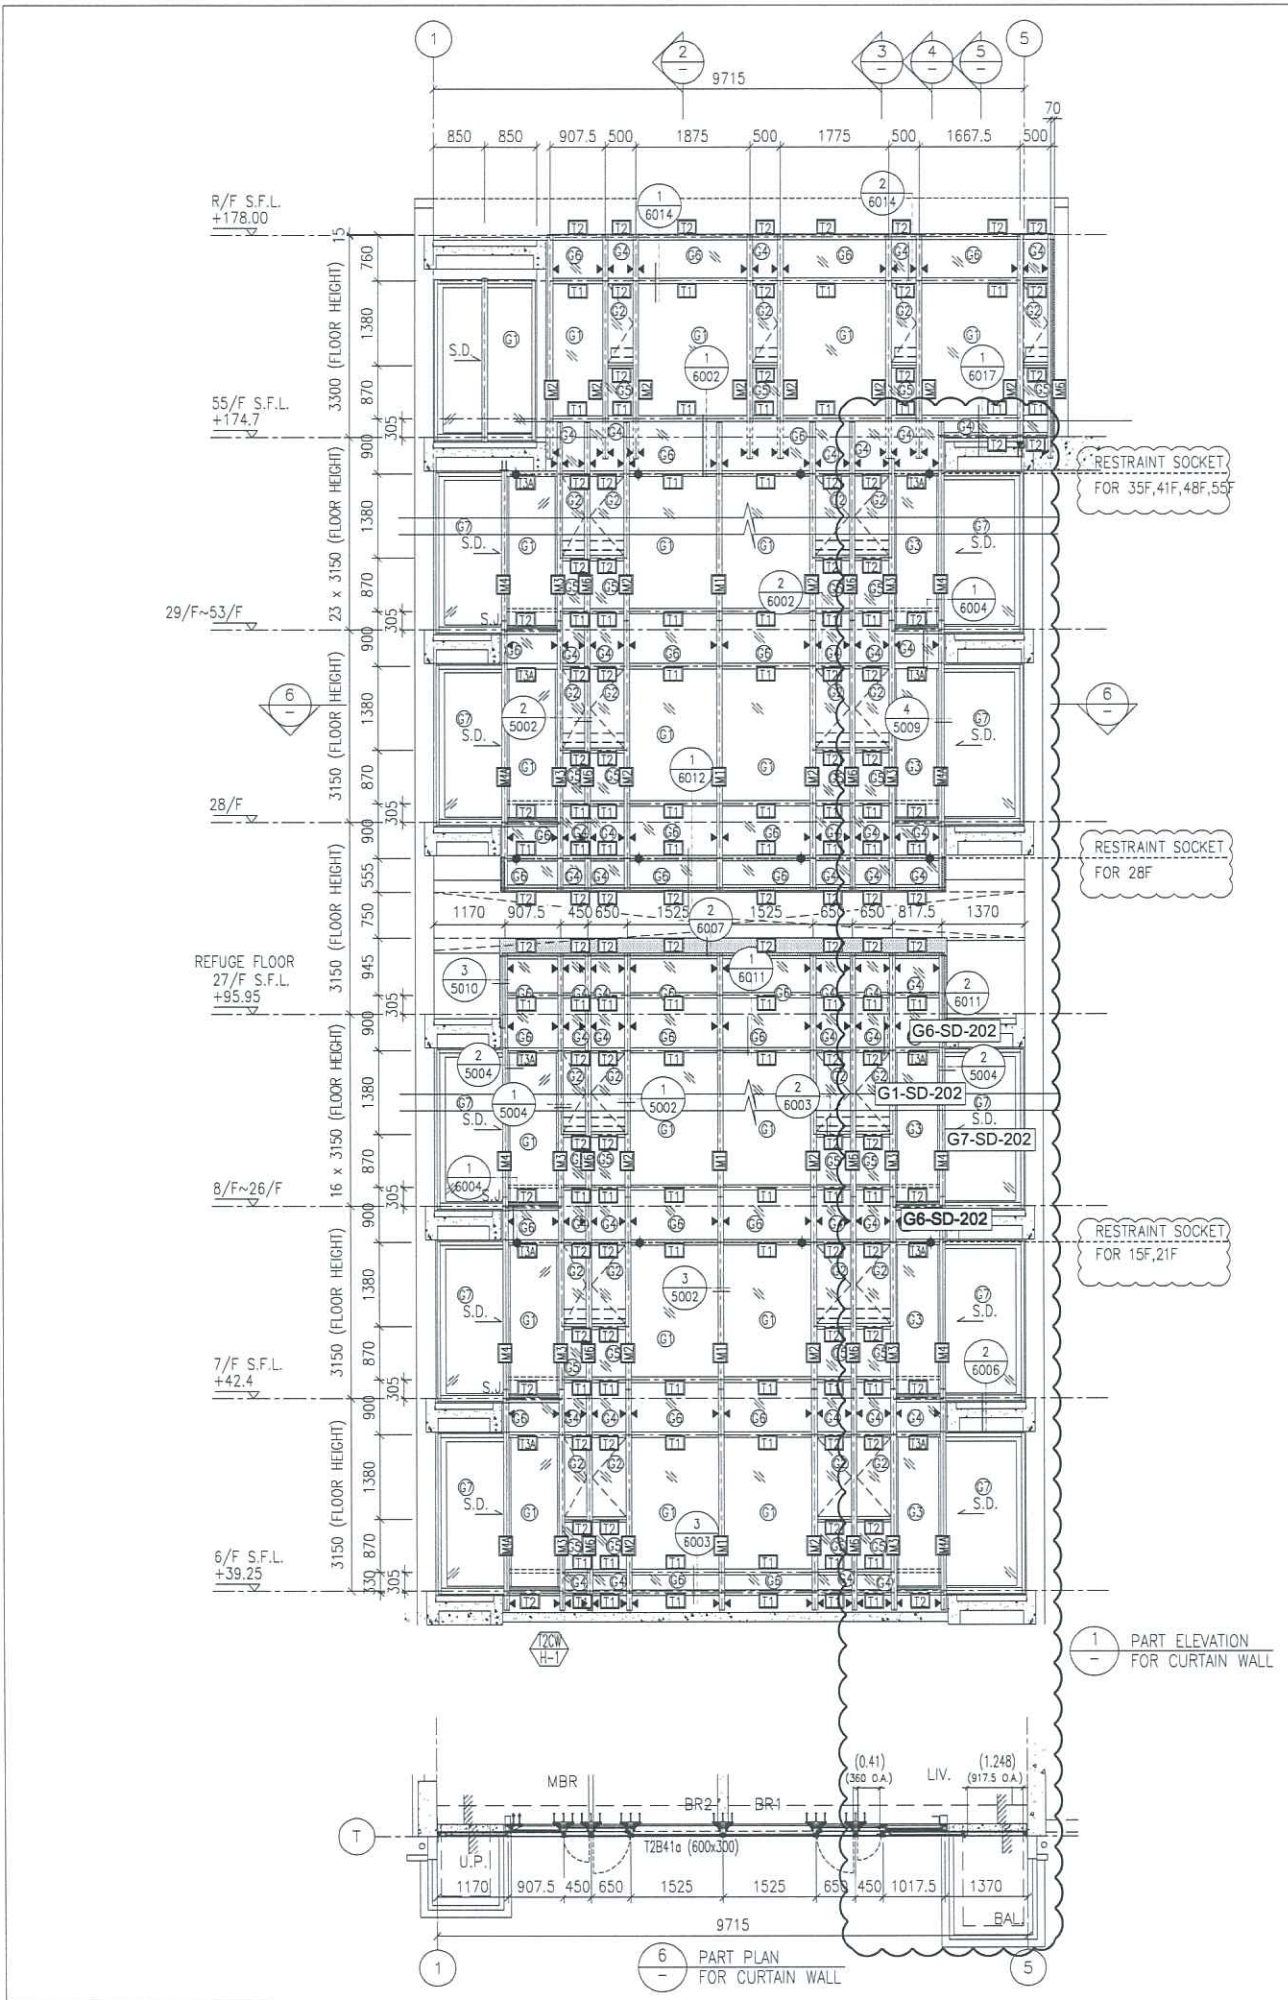

B.D. REF :

CLIENT : 信和置業有限公司 Sino Land Company Limited

ARCHITECT : WONG TUNG & PARTNERS LIMITED ARCHITECTS & PLANNERS

MAIN CONTRACTOR : CR Construction Company Limited

STRUCTURAL ENGINEER : AECOM

FAÇADE CONSULTANT : AECOM

NOTE :  
 1. ALL DIMENSIONS ARE IN mm.  
 2. ALL ELEVATIONS ARE VIEWED FROM OUTSIDE.  
 3. ALL DIMENSIONS TO BE VERIFIED ON SITE BEFORE FABRICATION.

LEGEND :  
 (X1) — DETAIL MARK NO.  
 (X001) — REFER SHEET NO.  
 1. F.F.L. — FINISHED FLOOR LEVEL  
 2. S.F.L. — STRUCTURAL FLOOR LEVEL  
 3. (R) — REVERSED DETAIL

D	22/12/2018	GENERAL REVISED
C	04/12/2018	GENERAL REVISED
B	24/11/2018	GENERAL REVISED
A	10/9/2018	GENERAL REVISED
NO.	DATE	REVISED BY

JOB NO. : J-837

PROJECT : URA KWUN TONG TOWN CENTRE REDEVELOPMENT (AREA 2 & 3) AT NKIL 6514, KWUN TONG, KWLOON

TITLE : PART ELEVATION OF CURTAIN WALL AT TOWER 2



DATE : 04-JUL-18	SCALE : 1:60 (A1)
DRAWN BY : ASING	CHECKED BY : -

美特鋁質有限公司  
 MIDI ALUMINIUM FABRICATOR LTD.  
 Units 6-8, Sunray Industrial Centre, 1/F  
 610 Cha Kwo Ling Road, Kowloon  
 Tel: 23489211-4 Fax: (852) 2727666

DWG NO. : JB37-CW-2201 REV. : D

Flat Room	Req. Prov.
T2H LIV.+M.BATH	1.535 1.658

- LEGEND:
- 10 mm THK. TEMPERED BLUE TINTED GLASS (OUTER) + 9 mm AIR SPACE + 8 mm THK. TEMPERED CLEAR GLASS (INNER)
  - 8 mm THK. HEAT STRENGTHENED TINTED GLASS (OUTER) + 9 mm AIR SPACE + 8 mm THK. HEAT STRENGTHENED CLEAR GLASS (INNER)
  - 10 mm THK. HEAT STRENGTHENED BLUE TINTED GLASS (OUTER) + 9 mm AIR SPACE + 8 mm THK. TEMPERED CLEAR GLASS (INNER)
  - 8 mm THK. HEAT STRENGTHENED BLUE TINTED GLASS ( SPANDREL GLASS )
  - 8 mm THK. HEAT STRENGTHENED BLUE TINTED GLASS (OUTER) + 9 mm AIR SPACE + 8 mm THK. TEMPERED CLEAR GLASS (INNER)
  - 8 mm THK. TEMPERED BLUE TINTED GLASS ( SPANDREL GLASS )
  - 8 mm THK. HEAT STRENGTHENED TINTED GLASS (OUTER) + 1.52PV8 + 8 mm THK. HEAT STRENGTHENED CLEAR LAMINATED GLASS (INNER)
  - 10 mm THK. TEMPERED GLASS ( INTERNAL PROTECTIVE BARRIER )
  - 3 mm THK. ALUM. CLADDING
  - M.W. - MAINTENANCE WINDOW
  - S.J. - STACK JOINT
  - ALUM. EXTRUSION DIE NO.
  - SUPPORT POINT
  - RESTRAINT SOCKET

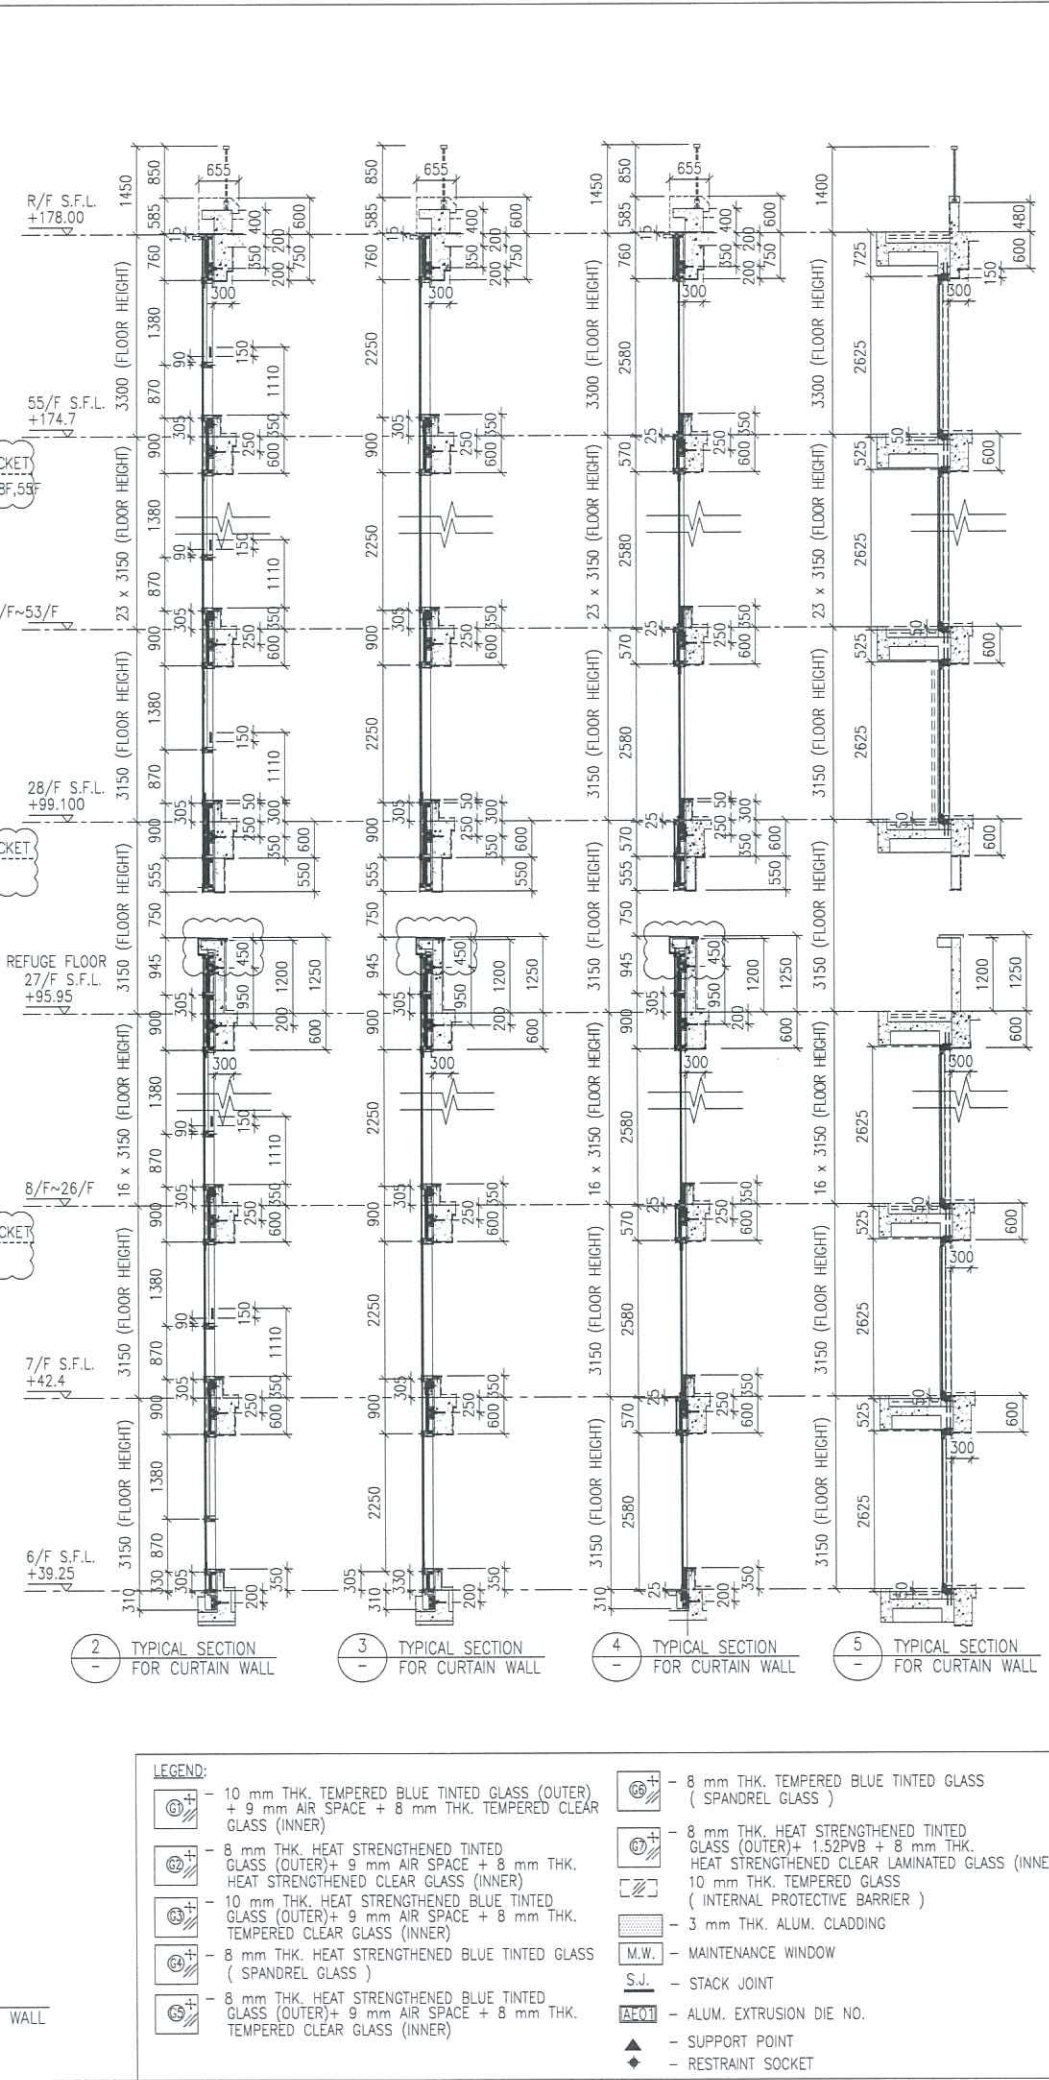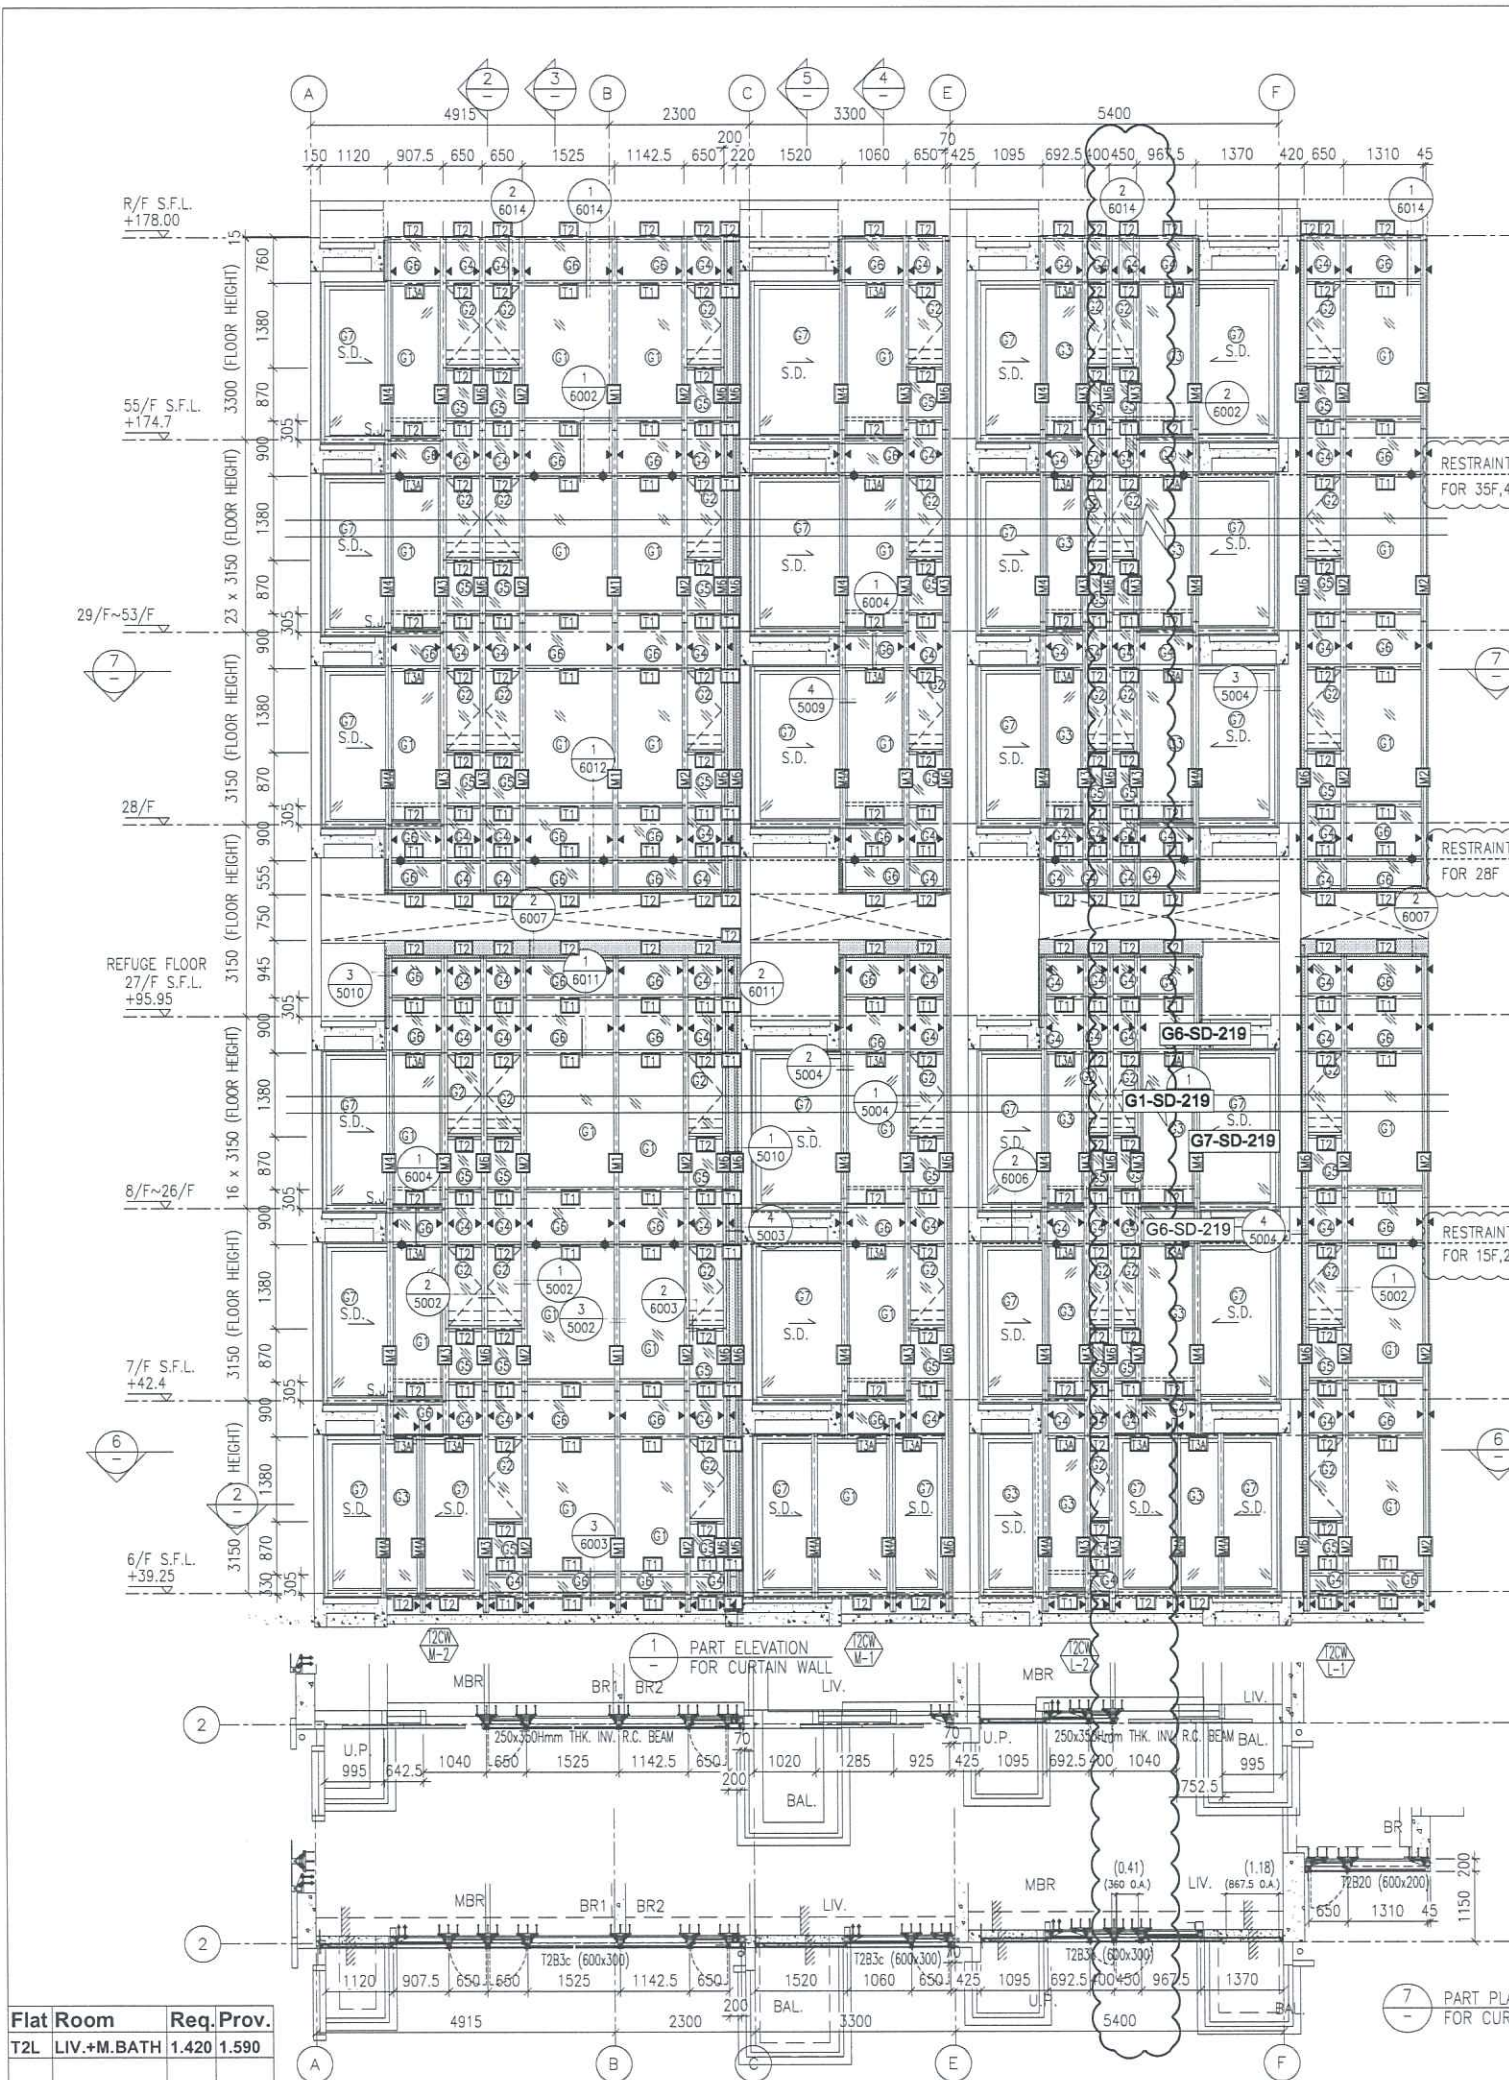

B.D. REF :

CLIENT : 信和置業有限公司 Sino Land Company Limited

ARCHITECT : WONG TUNG & PARTNERS LIMITED ARCHITECTS & PLANNERS

MAIN CONTRACTOR : CR Construction Company Limited

STRUCTURAL ENGINEER : AECOM

FAÇADE CONSULTANT : AECOM

NOTE :

1. ALL DIMENSIONS ARE IN mm.
2. ALL ELEVATIONS ARE VIEWED FROM OUTSIDE.
3. ALL DIMENSIONS TO BE VERIFIED ON SITE BEFORE FABRICATION.

LEGEND :

(X1) --- DETAIL MARK NO.  
(X001) --- REFER SHEET NO.

1. F.F.L. --- FINISHED FLOOR LEVEL
2. S.F.L. --- STRUCTURAL FLOOR LEVEL
3. (R) --- REVERSED DETAIL

D	22/12/2018	GENERAL REVISED
C	04/12/2018	GENERAL REVISED
B	24/11/2018	GENERAL REVISED
A	10/9/2018	GENERAL REVISED
NO.	DATE	REVISED BY

JOB NO. : J-837

PROJECT : URA KWUN TONG TOWN CENTRE REDEVELOPMENT (AREA 2 & 3) AT NKIL 6514, KWUN TONG, KWLOON

TITLE : PART ELEVATION OF CURTAIN WALL AT TOWER 2

DATE : 04-JUL-18 SCALE : 1:60 (A1)

DRAWN BY : ASING CHECKED BY : -

美特鋁質有限公司 MIDI ALUMINIUM FABRICATOR LTD.  
Units 6-8, Sunray Industrial Centre, 1/F  
610 Cho Kwo Ling Road, Kowloon  
Tel: 23489211-4 Fax: (852) 2727666

DWG NO. : JB37-CW-2211 REV. : D

Flat Room	Req. Prov.
T2L LIV.+M.BATH	1.420 1.590

- LEGEND :
- 10 mm THK. TEMPERED BLUE TINTED GLASS (OUTER) + 9 mm AIR SPACE + 8 mm THK. TEMPERED CLEAR GLASS (INNER)
  - 8 mm THK. HEAT STRENGTHENED TINTED GLASS (OUTER) + 9 mm AIR SPACE + 8 mm THK. HEAT STRENGTHENED CLEAR GLASS (INNER)
  - 10 mm THK. HEAT STRENGTHENED BLUE TINTED GLASS (OUTER) + 9 mm AIR SPACE + 8 mm THK. TEMPERED CLEAR GLASS (INNER)
  - 8 mm THK. HEAT STRENGTHENED BLUE TINTED GLASS (SPANDREL GLASS)
  - 8 mm THK. HEAT STRENGTHENED BLUE TINTED GLASS (OUTER) + 9 mm AIR SPACE + 8 mm THK. TEMPERED CLEAR GLASS (INNER)
  - 8 mm THK. TEMPERED BLUE TINTED GLASS (SPANDREL GLASS)
  - 8 mm THK. HEAT STRENGTHENED TINTED GLASS (OUTER) + 1.52PVB + 8 mm THK. HEAT STRENGTHENED CLEAR LAMINATED GLASS (INNER)
  - 10 mm THK. TEMPERED GLASS (INTERNAL PROTECTIVE BARRIER)
  - 3 mm THK. ALUM. CLADDING
  - M.W. --- MAINTENANCE WINDOW
  - S.J. --- STACK JOINT
  - ALU01 --- ALUM. EXTRUSION DIE NO.
  - SUPPORT POINT
  - RESTRAINT SOCKET

B.D. REF :



CLIENT :  
  
 Sino Land Company Limited

ARCHITECT :  
  
 WONG TUNG & PARTNERS LIMITED  
 ARCHITECTS & PLANNERS

MAIN CONTRACTOR :  
  
 CR Construction Company Limited

STRUCTURAL ENGINEER :  
  
 AECOM  
 FACADE CONSULTANT:  
  
 AECOM

NOTE :  
 1. ALL DIMENSIONS ARE IN MM.  
 2. ALL ELEVATIONS ARE VIEWED FROM OUTSIDE.  
 3. ALL DIMENSIONS TO BE VERIFIED ON SITE BEFORE FABRICATION.

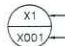
LEGEND :  
 -- DETAIL MARK NO.  
 -- REFER SHEET NO.  
 1. F.F.L. -- FINISHED FLOOR LEVEL  
 2. S.F.L. -- STRUCTURAL FLOOR LEVEL  
 3. (R) -- REVERSED DETAIL

D	22/12/2018	GENERAL REVISED
C	04/12/2018	GENERAL REVISED
B	24/11/2018	GENERAL REVISED
A	10/9/2018	GENERAL REVISED
NO	DATE	REVISED BY



JOB NO. : J-837  
 PROJECT :  
 URA KWUN TONG TOWN CENTRE  
 REDEVELOPMENT (AREA 2 & 3) AT  
 NKIL 6514, KWUN TONG, KWLOON

TITLE :  
 PART ELEVATION  
 OF CURTAIN WALL  
 AT TOWER 2




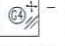




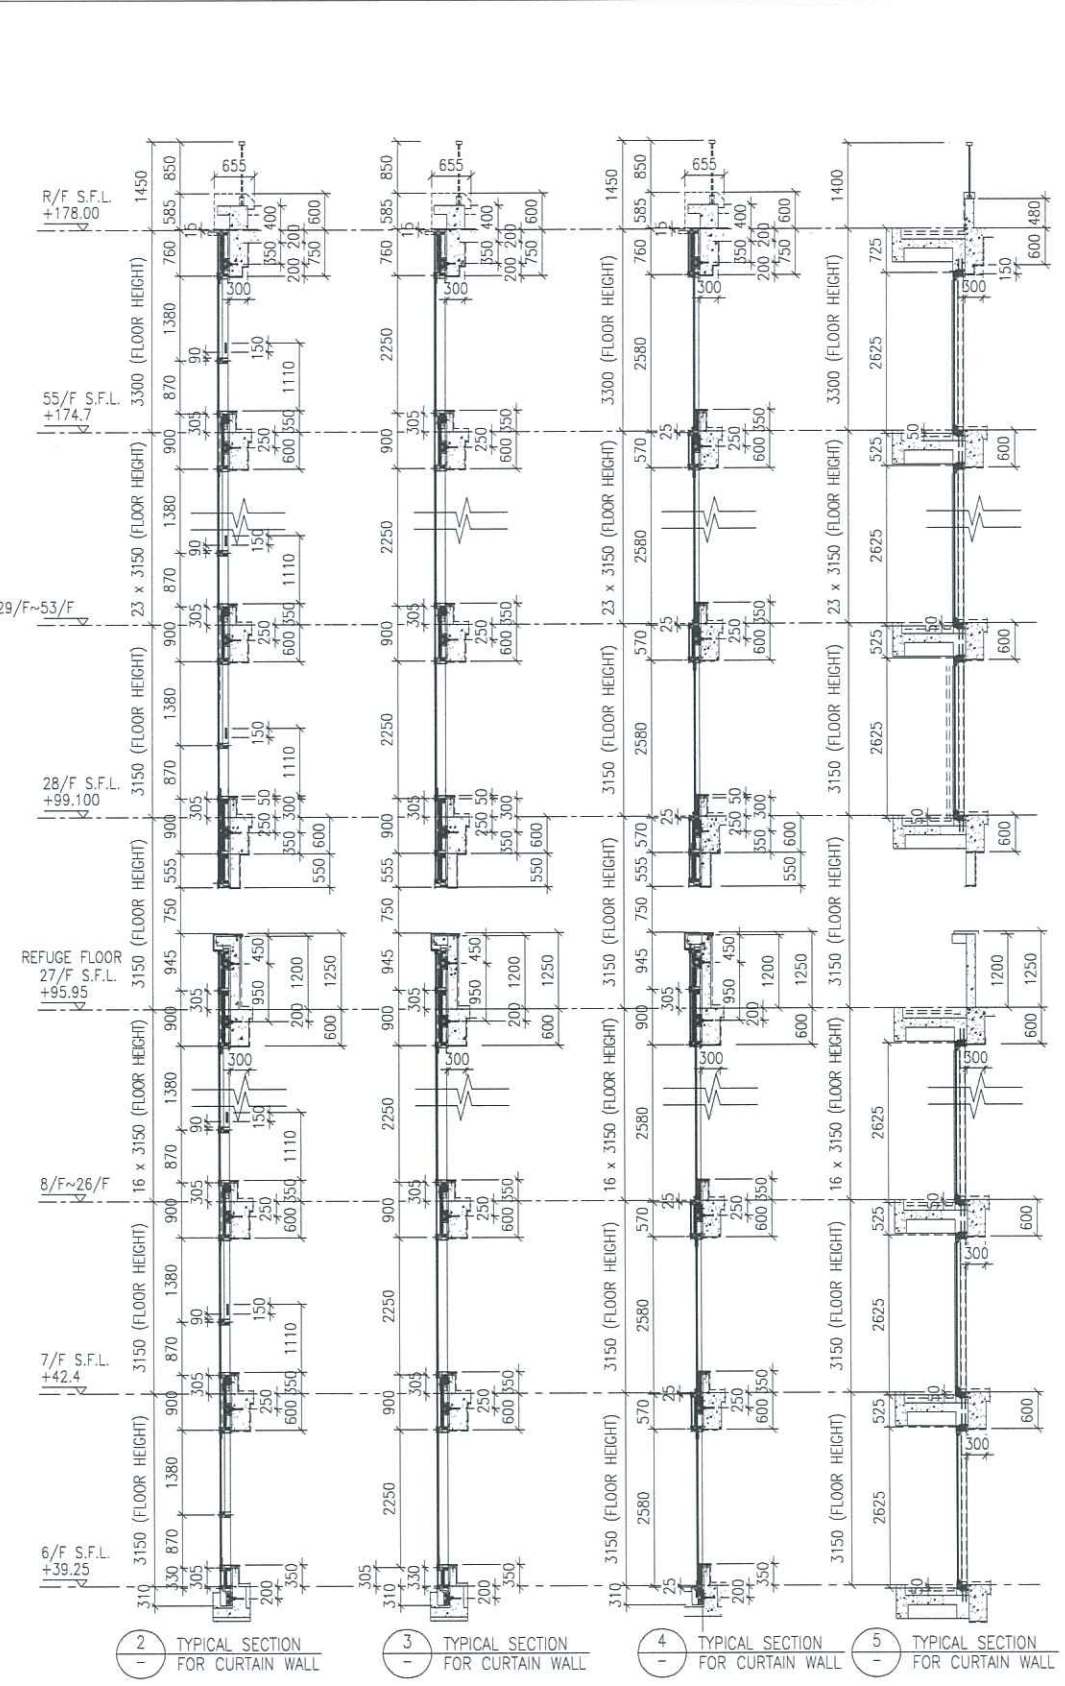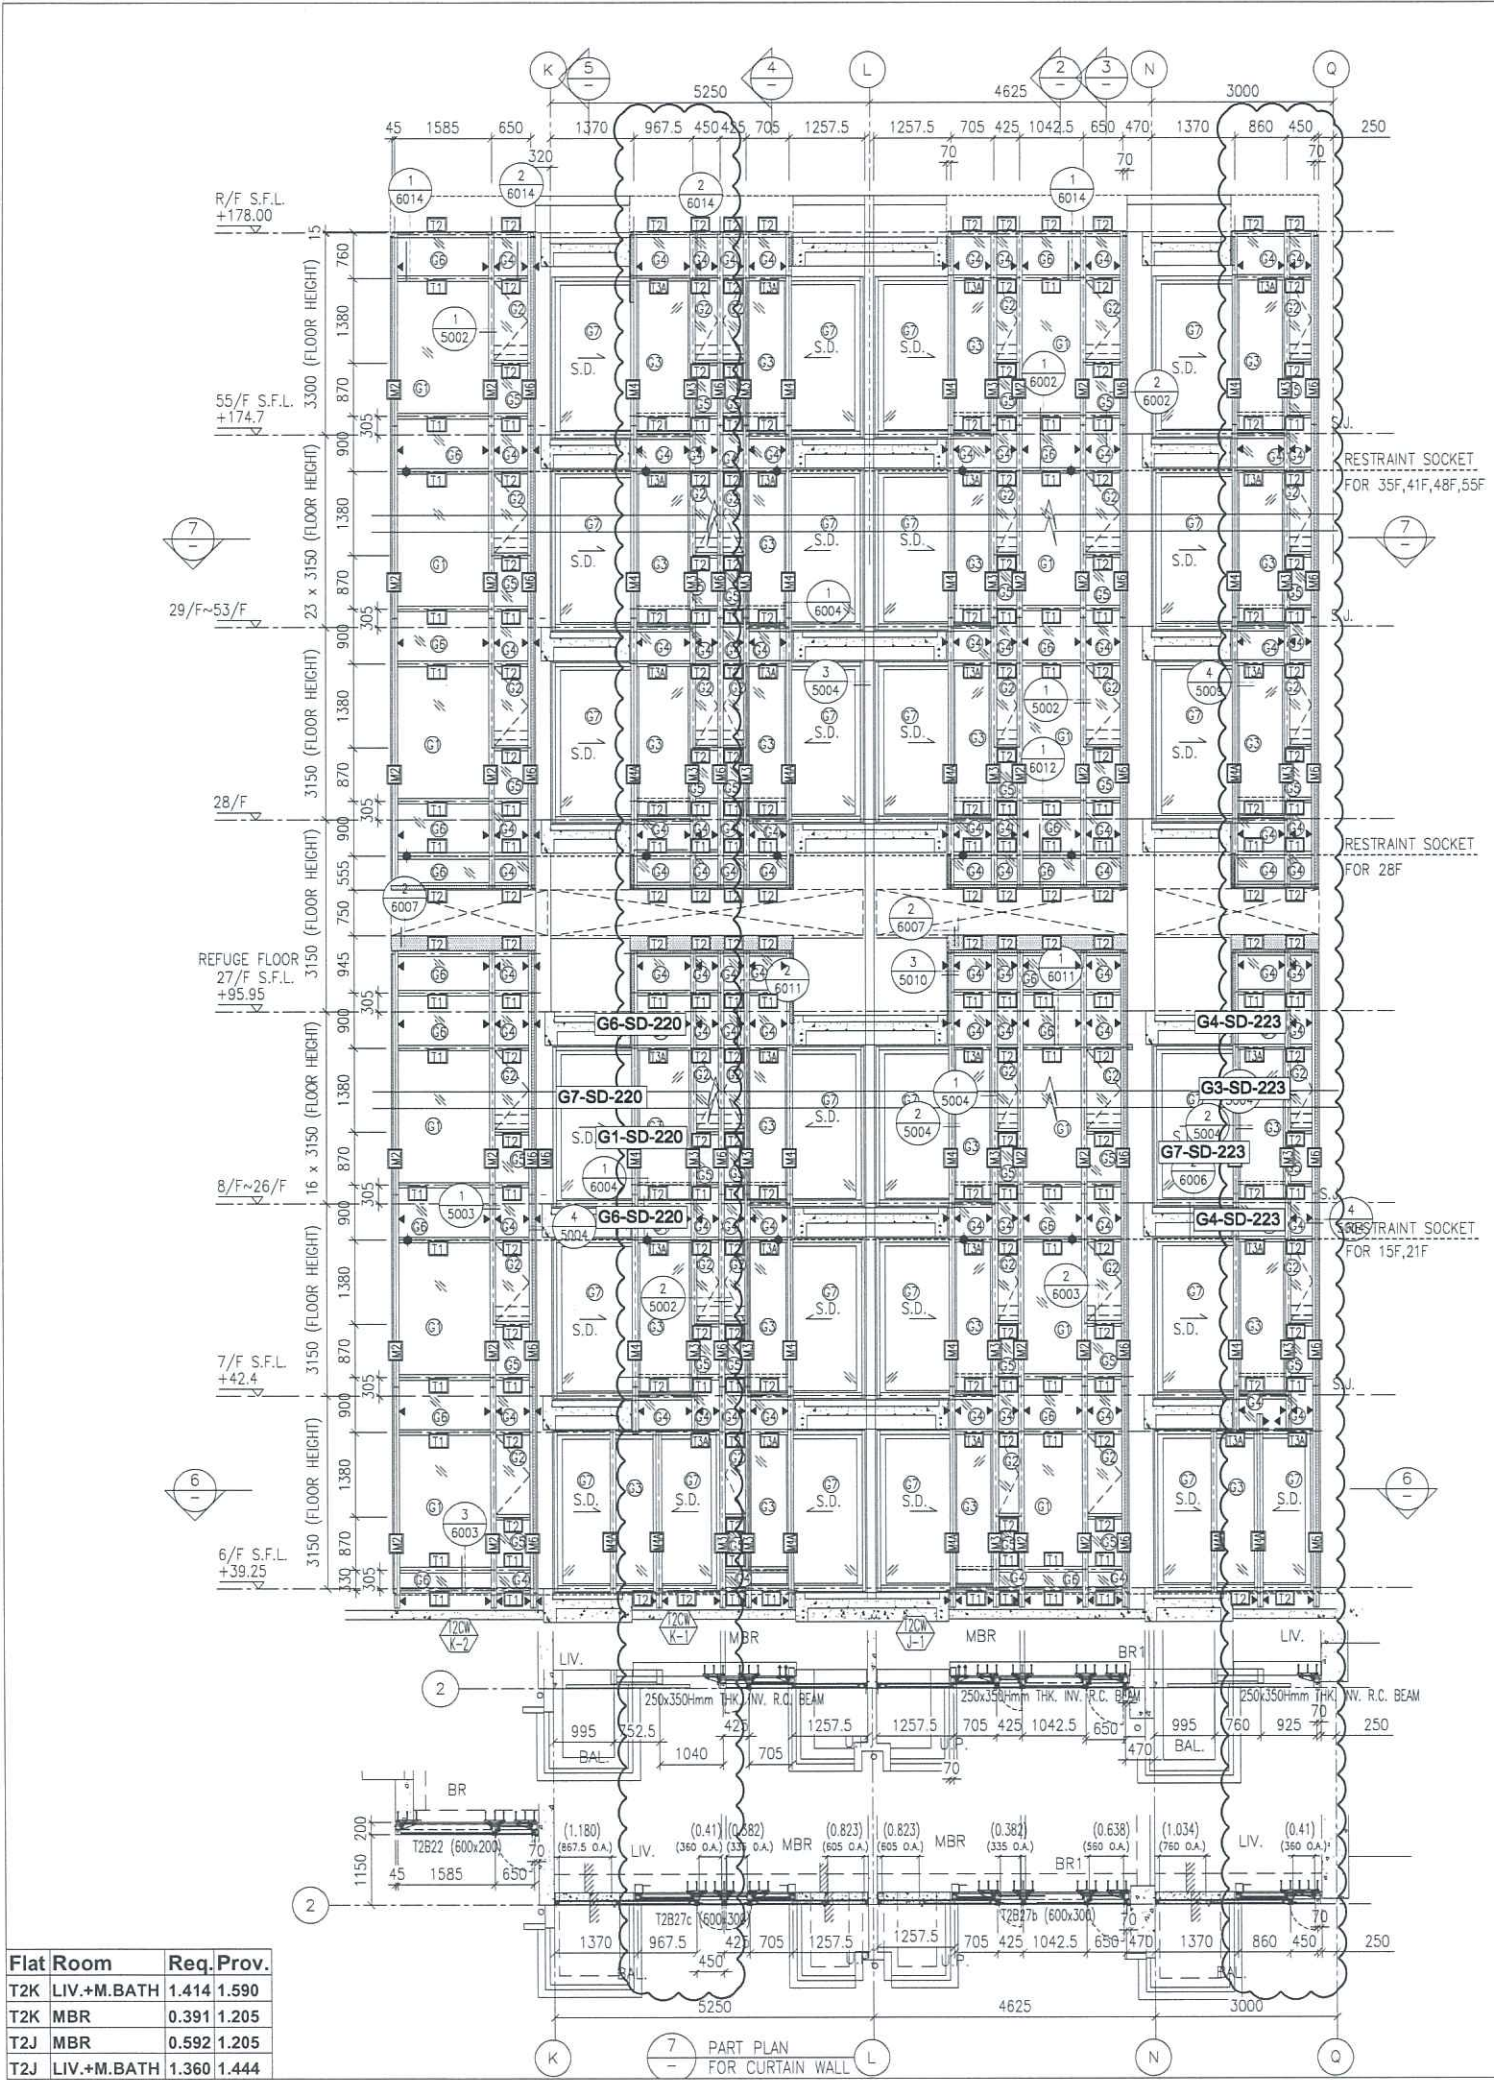





DATE : 04-JUL-18 SCALE : 1:60 (A1)  
 DRAWN BY : ASING CHECKED BY : -

  
**MIDI ALUMINIUM FABRICATOR LTD.**  
 Units 6-8, Sunray Industrial Centre, 1/F  
 610 Cho Kwo Ling Road, Kowloon  
 Tel: 23489211-4 Fax: (852) 2727666

DWG NO. : JB37-CW-2212 REV. : D

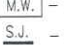

**LEGEND:**

 -  - 10 mm THK. TEMPERED BLUE TINTED GLASS (OUTER) + 9 mm AIR SPACE + 8 mm THK. TEMPERED CLEAR GLASS (INNER)
-  - 8 mm THK. HEAT STRENGTHENED TINTED GLASS (OUTER) + 9 mm AIR SPACE + 8 mm THK. HEAT STRENGTHENED CLEAR GLASS (INNER)
-  - 10 mm THK. HEAT STRENGTHENED BLUE TINTED GLASS (OUTER) + 9 mm AIR SPACE + 8 mm THK. TEMPERED CLEAR GLASS (INNER)
-  - 8 mm THK. HEAT STRENGTHENED BLUE TINTED GLASS (SPANDREL GLASS)
-  - 8 mm THK. HEAT STRENGTHENED BLUE TINTED GLASS (OUTER) + 9 mm AIR SPACE + 8 mm THK. TEMPERED CLEAR GLASS (INNER)
-  - 8 mm THK. TEMPERED BLUE TINTED GLASS (SPANDREL GLASS)
-  - 8 mm THK. HEAT STRENGTHENED TINTED GLASS (OUTER) + 1.52PVB + 8 mm THK. HEAT STRENGTHENED CLEAR LAMINATED GLASS (INNER)
-  - 10 mm THK. TEMPERED GLASS (INTERNAL PROTECTIVE BARRIER)
-  - 3 mm THK. ALUM. CLADDING
-  - M.W. - MAINTENANCE WINDOW
-  - S.J. - STACK JOINT
-  - ALUM. EXTRUSION DIE NO.
-  - SUPPORT POINT
-  - RESTRAINT SOCKET

Flat Room	Req.	Prov.
T2K LIV.+M.BATH	1.414	1.590
T2K MBR	0.391	1.205
T2J MBR	0.592	1.205
T2J LIV.+M.BATH	1.360	1.444

7 - PART PLAN FOR CURTAIN WALL

B.D. REF :

CLIENT :  
**信和置業有限公司**  
Sino Land Company Limited

ARCHITECT :  
**WONG TUNG & PARTNERS LIMITED**  
ARCHITECTS & PLANNERS

MAIN CONTRACTOR :  
**CR Construction Company Limited**

STRUCTURAL ENGINEER :  
**AECOM**

FAÇADE CONSULTANT:  
**AECOM**

NOTE :  
1. ALL DIMENSIONS ARE IN mm.  
2. ALL ELEVATIONS ARE VIEWED FROM OUTSIDE.  
3. ALL DIMENSIONS TO BE VERIFIED ON SITE BEFORE FABRICATION.

LEGEND :  
X1 --- DETAIL MARK NO.  
X001 --- REFER SHEET NO.  
1. F.F.L. --- FINISHED FLOOR LEVEL  
2. S.F.L. --- STRUCTURAL FLOOR LEVEL  
3. (R) --- REVERSED DETAIL



D	22/12/2018	GENERAL REVISED
C	04/12/2018	GENERAL REVISED
B	24/11/2018	GENERAL REVISED
A	10/9/2018	GENERAL REVISED
NO.	DATE	REVISED
		BY

JOB NO. : J-837  
PROJECT :  
URA KWUN TONG TOWN CENTRE  
REDEVELOPMENT (AREA 2 & 3) AT  
NKIL 6514, KWUN TONG, KWLOON

TITLE :  
PART ELEVATION  
OF CURTAIN WALL  
AT TOWER 5

DATE : 04-JUL-18 SCALE : 1:60 (A1)  
DRAWN BY : ASING CHECKED BY : -

**美特鋁質有限公司**  
MIDI ALUMINIUM FABRICATOR LTD.  
Units 6-8, Sunray Industrial Centre, 1/F  
610 Cha Kwo Ling Road, Kowloon  
Tel: 23489211-4 Fax: (852) 27727666  
DWG NO. : JB37-CW-2506 REV. : D

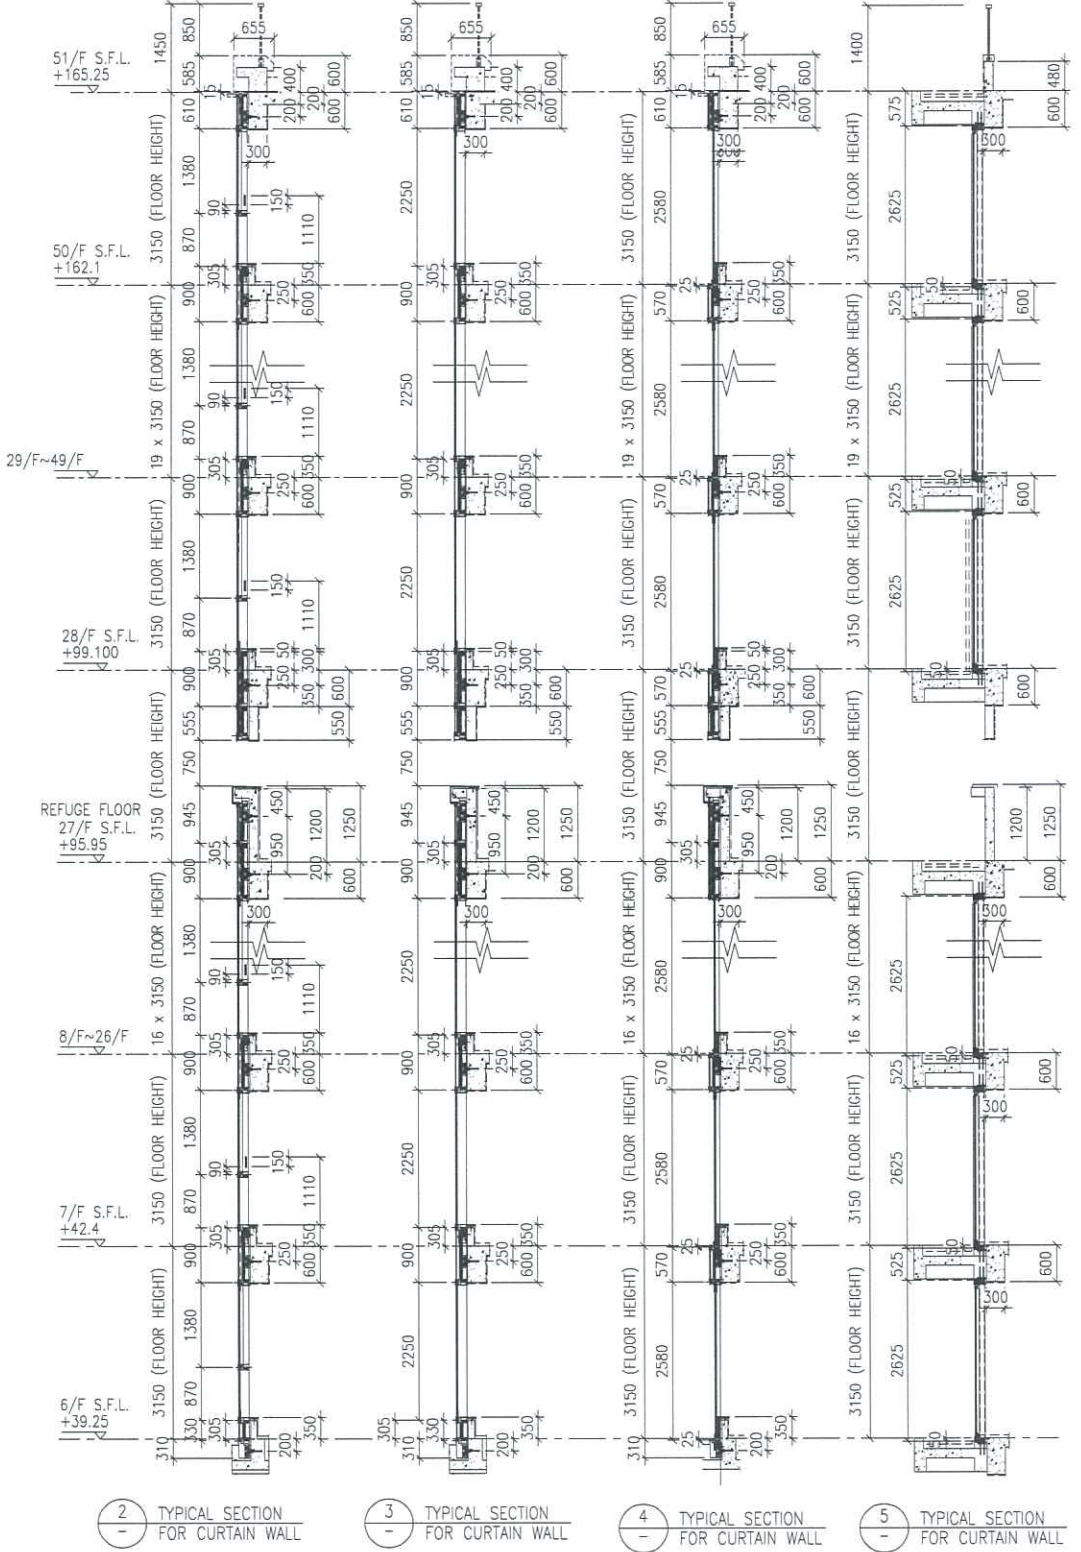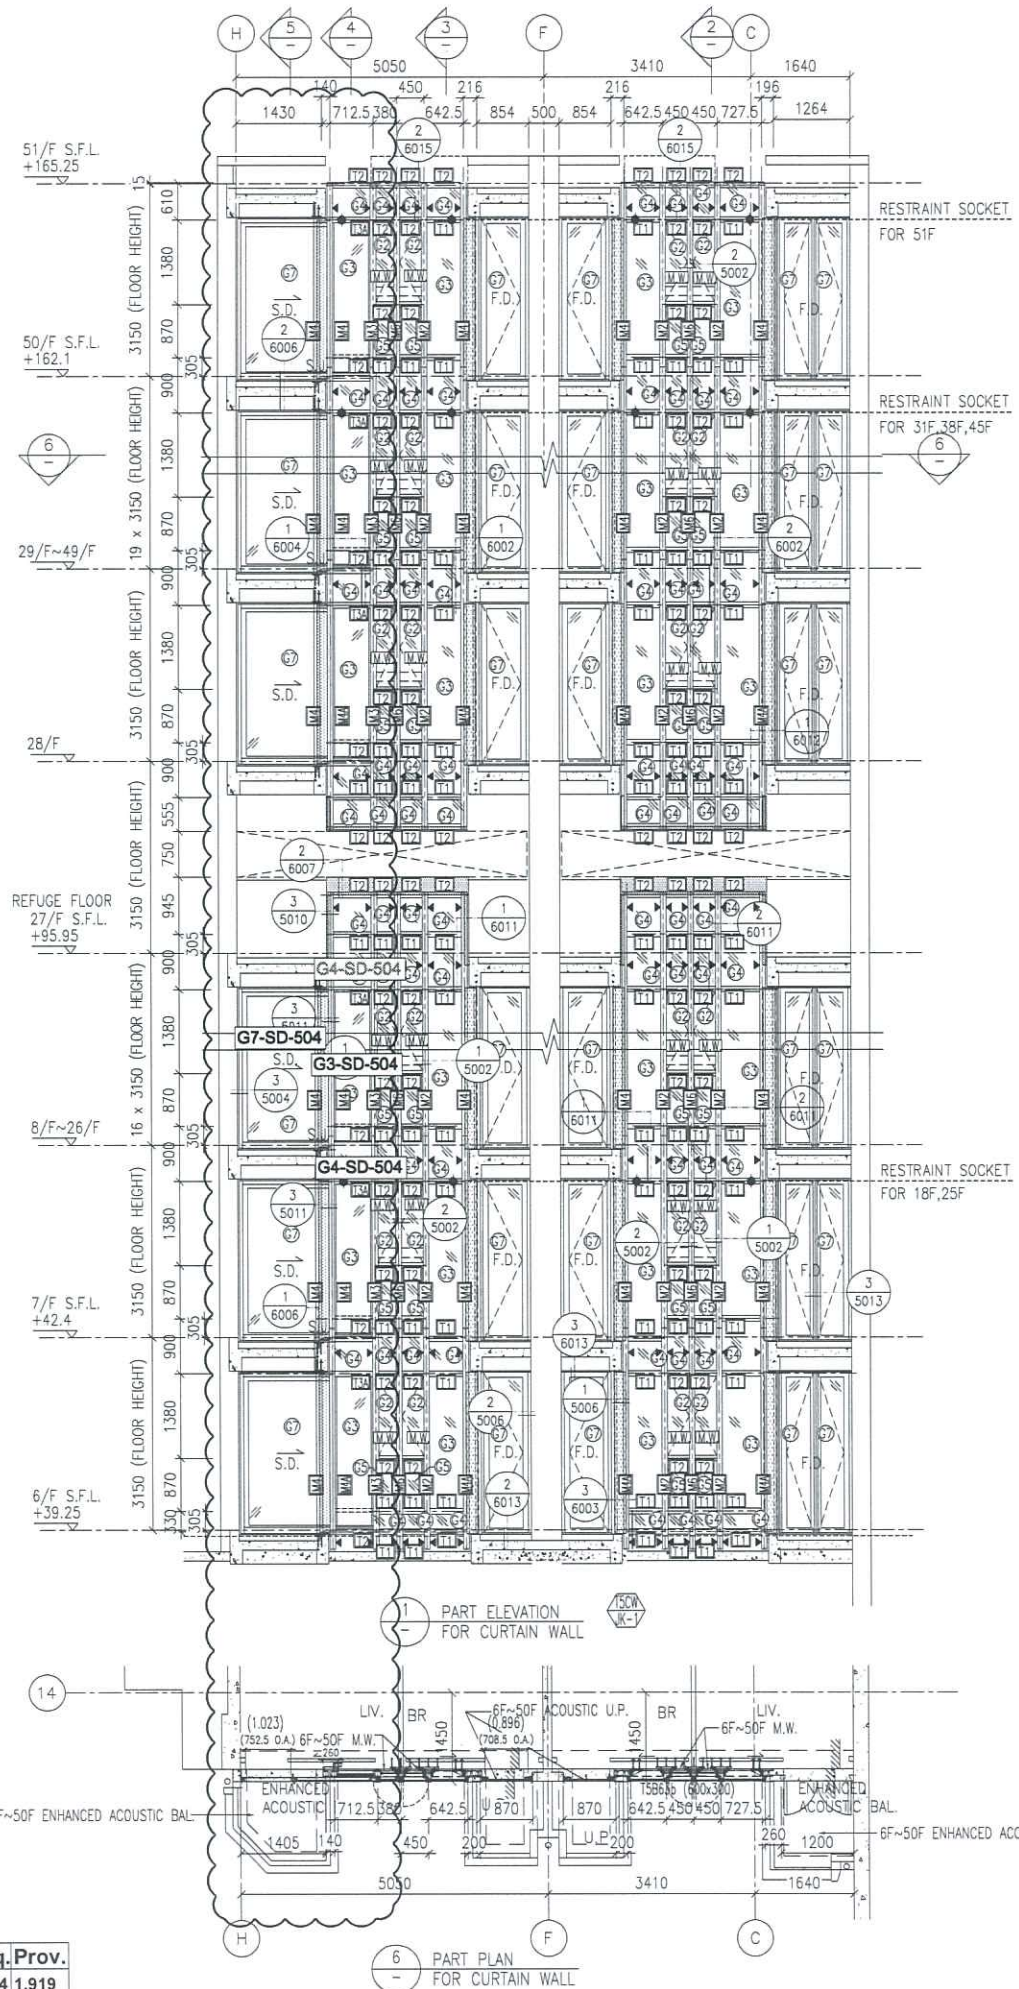

- LEGEND:
- 10 mm THK. TEMPERED BLUE TINTED GLASS (OUTER) + 9 mm AIR SPACE + 8 mm THK. TEMPERED CLEAR GLASS (INNER)
  - 8 mm THK. HEAT STRENGTHENED TINTED GLASS (OUTER) + 9 mm AIR SPACE + 8 mm THK. HEAT STRENGTHENED CLEAR GLASS (INNER)
  - 10 mm THK. HEAT STRENGTHENED BLUE TINTED GLASS (OUTER) + 9 mm AIR SPACE + 8 mm THK. TEMPERED CLEAR GLASS (INNER)
  - 8 mm THK. HEAT STRENGTHENED BLUE TINTED GLASS (SPANDREL GLASS)
  - 8 mm THK. HEAT STRENGTHENED BLUE TINTED GLASS (OUTER) + 1.52PVB + 8 mm THK. HEAT STRENGTHENED CLEAR LAMINATED GLASS (INNER)
  - 10 mm THK. TEMPERED GLASS (INTERNAL PROTECTIVE BARRIER)
  - 3 mm THK. ALUM. CLADDING
  - M.W. - MAINTENANCE WINDOW
  - S.J. - STACK JOINT
  - ALCOT - ALUM. EXTRUSION DIE NO.
  - SUPPORT POINT
  - RESTRAINT SOCKET
  - 8 mm THK. TEMPERED BLUE TINTED GLASS (SPANDREL GLASS)
  - 8 mm THK. HEAT STRENGTHENED TINTED GLASS (OUTER) + 1.52PVB + 8 mm THK. HEAT STRENGTHENED CLEAR LAMINATED GLASS (INNER)
  - 10 mm THK. TEMPERED GLASS (INTERNAL PROTECTIVE BARRIER)
  - 3 mm THK. ALUM. CLADDING
  - M.W. - MAINTENANCE WINDOW
  - S.J. - STACK JOINT
  - ALCOT - ALUM. EXTRUSION DIE NO.
  - SUPPORT POINT
  - RESTRAINT SOCKET

Flat Room	Req.	Prov.
TSK LIV.+M.BATH +BR	1.904	1.919