



工程指示 / 要求簡箋(E.I.)

工程指示編號：EI / 0106 / 19

修改版次：-

工程編號：J - 837

工程名稱：觀塘裕民坊

工程項目：幕牆 樣板層拉巴方案

收件人：永林

發件人：Eric Liu

日期：18/01/2019

□要求提供 / □確認 事項：

- | | | |
|------------------------------------|-------------------------------------|-------------------------------|
| <input type="checkbox"/> 初步鋁料 B.M. | <input type="checkbox"/> 加工拆圖，然後生產 | <input type="checkbox"/> 尺寸表 |
| <input type="checkbox"/> 正式鋁料 B.M. | <input type="checkbox"/> 技術上資料 / 指示 | <input type="checkbox"/> 報價 |
| <input type="checkbox"/> 配件 B.M. | <input type="checkbox"/> 樣辦或貨品說明書 | <input type="checkbox"/> 分判合約 |
| <input type="checkbox"/> 其他：_____ | | |

內容：

因樣板層趟門拉巴模開模未能趕及生產，
現提供樣板層趟門拉巴方案，請留意附件
謝謝！

請在 2019/ 01 / 21 前完成上列要求。

附：1 頁

以上項目為：

- 原合約工程包 原合約工程加 / 減賬 新工程報價

原因：-

分發東莞各部門：

- 生產技術總監 □連附件 技術部 連附件 *材料* 生產部 連附件 機械設計部 □連附件
 採購部 連附件 生產統籌部 連附件
 質檢部 連附件 會計部 連附件 報關組 連附件 其他 楊榮輝 □連附件

分發其他分判：

- 王禮秋 連附件

分發香港各部門：

- 行政部 □連附件 會計部 □連附件 統籌部 □連附件 工程部地盤科文 連附件
 採購部 □連附件 QS 部 連附件 維修部 □連附件 其他 _____ □連附件

傳遞編號：

HK 0174 / 19



發件人簽署：

項目經理簽署：


CUSTOMER	CUSTOMER APPROVAL	CUST PART NO.	S27
		SECTION NO.	X85657

因開模不能趕及開新模
用樣板層方架取代

樣板層方架

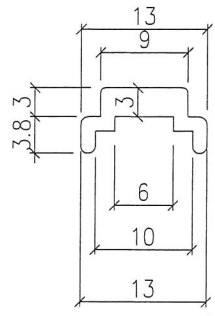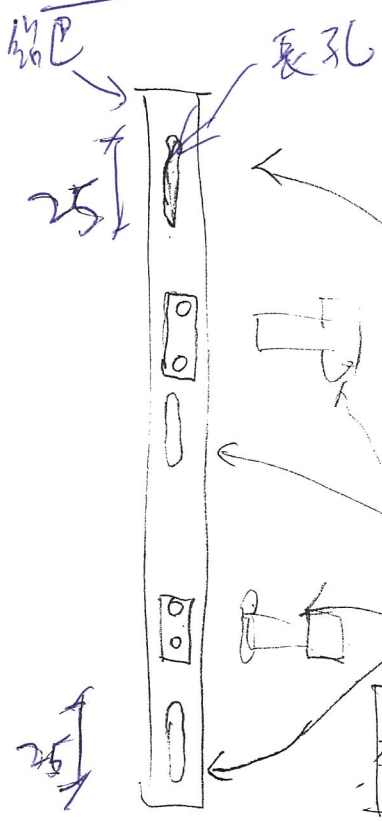

美特鋁質有限公司	
承認圖面	
日期	

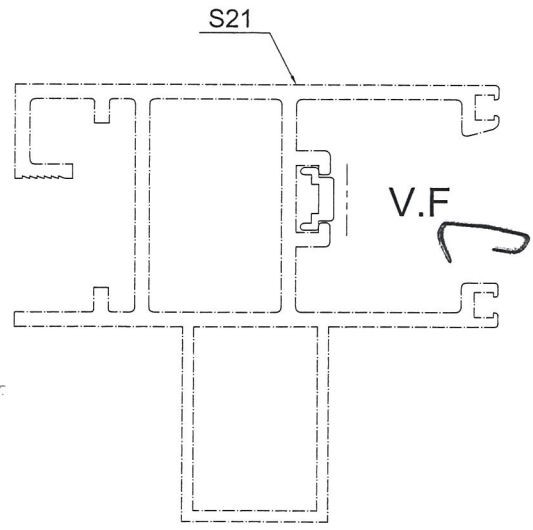

SCALE 1:1

SIGNATURE GRADEING	HIGH SIGNATURE GRADEING	C.C.DIA(MM)							
AREA (SQ MM)	43.57	UNSPECIFIED THICKNESS	-	PERIMETER (MM)	-	STANDARD		SCALE	2:1
MASS (KG/M)	-	UNSPECIFIED CORNERS	-	SURFACE AREA	-	ALLOY	6061 T6	VERSION	
COMPANY ISSUE			DRAWN	DATE	APPELLATION		-	PAGE OF	
			STANDARDIZATION	DATE					
			TO SIGN	DATE					
			AUDITING	DATE					
MARKER	MODIFY	FILE NO	SIGNATURE	DATE	APPROV				

美特鋁質有限公司
MIDI Aluminium Fabricator Ltd.