



工程指示 / 要求簡箋(E.I.)

工程指示編號：EI /0158/ 19

修改版次：

工程編號：J - 837

工程名稱：觀塘裕民坊

工程項目：幕牆 - 室內 U 槽

收件人：生統

發件人：ERIK KONG

日期：24/01/2019

□要求提供 / □確認 事項：

- | | | |
|------------------------------------|-------------------------------------|-------------------------------|
| <input type="checkbox"/> 初步鋁料 B.M. | <input type="checkbox"/> 加工拆圖，然後生產 | <input type="checkbox"/> 尺寸表 |
| <input type="checkbox"/> 正式鋁料 B.M. | <input type="checkbox"/> 技術上資料 / 指示 | <input type="checkbox"/> 報價 |
| <input type="checkbox"/> 配件 B.M. | <input type="checkbox"/> 樣辦或貨品說明書 | <input type="checkbox"/> 分判合約 |
| <input type="checkbox"/> 其他：_____ | | |

內容：

請按加工圖加生產室內 U 槽，於過年後盡快送到地盤(3 月 1 日前)可以更早最好

- 顏色:UCT803649FXL-3, 見光位做保護

- T-U-001 = 300 支, T-U-003 = 300 支

謝謝!

請在 03/01/2019 前完成上列要求。

附： 2 頁

以上項目為:

 原合約工程包
 原合約工程加 / 減賬
 新工程報價

原因：-

分發東莞各部門：

- | | | | | | | | | |
|---------------------------------|------------------------------|---|---|------------------------------|------------------------------|------------------------------|--------------------------------|------------------------------|
| <input type="checkbox"/> 生產技術總監 | <input type="checkbox"/> 連附件 | <input checked="" type="checkbox"/> 技術部 | <input checked="" type="checkbox"/> 連附件 | 永林 | <input type="checkbox"/> 生產部 | <input type="checkbox"/> 連附件 | <input type="checkbox"/> 機械設計部 | <input type="checkbox"/> 連附件 |
| <input type="checkbox"/> 採購部 | <input type="checkbox"/> 連附件 | <input checked="" type="checkbox"/> 生產統籌部 | <input checked="" type="checkbox"/> 連附件 | 梅姐 | | | | |
| <input type="checkbox"/> 質檢部 | <input type="checkbox"/> 連附件 | <input type="checkbox"/> 會計部 | <input type="checkbox"/> 連附件 | <input type="checkbox"/> 報關組 | <input type="checkbox"/> 連附件 | <input type="checkbox"/> 其他 | _____ | <input type="checkbox"/> 連附件 |

分發香港各部門：


- | | | | | | | | | |
|------------------------------|------------------------------|-------------------------------|------------------------------|------------------------------|------------------------------|---|---|------------------------------|
| <input type="checkbox"/> 行政部 | <input type="checkbox"/> 連附件 | <input type="checkbox"/> 會計部 | <input type="checkbox"/> 連附件 | <input type="checkbox"/> 統籌部 | <input type="checkbox"/> 連附件 | <input checked="" type="checkbox"/> 工程部地盤科文 | <input checked="" type="checkbox"/> 連附件 | 炳哥 |
| <input type="checkbox"/> 採購部 | <input type="checkbox"/> 連附件 | <input type="checkbox"/> QS 部 | <input type="checkbox"/> 連附件 | <input type="checkbox"/> 維修部 | <input type="checkbox"/> 連附件 | <input type="checkbox"/> 其他 | _____ | <input type="checkbox"/> 連附件 |

傳遞編號：HK 0263 / 19


發件人簽署：項目經理簽署：

VISION GLASS PANEL
(REFER TO ELEVATION)



MODULE DIMENSION
(FIXED PANEL)

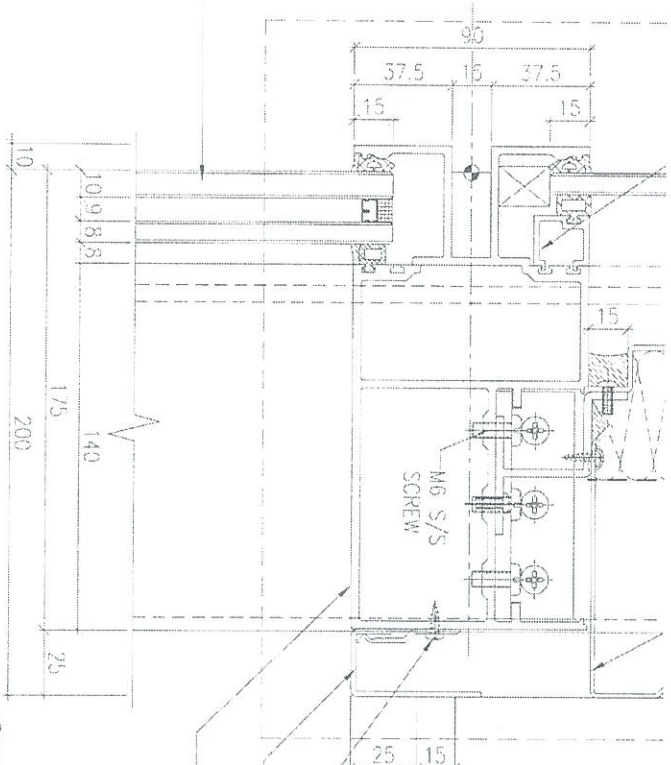

M5 S/S SCREW @ 300 C/C
2 mm HR ALUM CLADDING
ALUM. TRANSOM

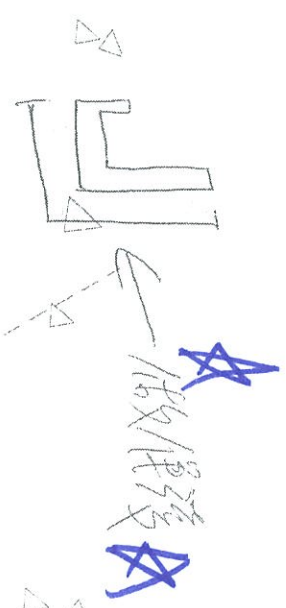

1 TYPICAL TRANSOM
CURTAIN WALL

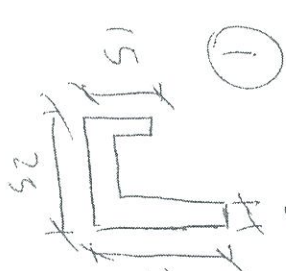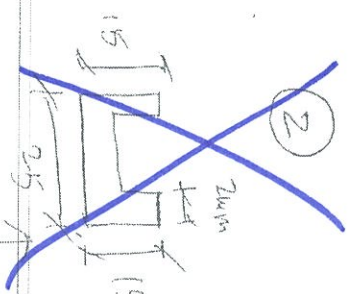

L = 2440mm

顏色: VCT803649 FXL-3
(藍色)
ALUM. GLAZING BRAD
WEATHER SEALANT WITH
ROBULL SIDED ADHESIVE TAPE
ALUM. WINDOW SASH
VISION GLASS PANEL
(REFER TO ELEVATION)


2 TYPICAL TRANSOM
CURTAIN WALL

T-V-001 厚 2mm


~~數量: 2440支~~

~~L = 2440mm~~
~~數量: 160支~~
T-V-002 厚 2mm

P.1

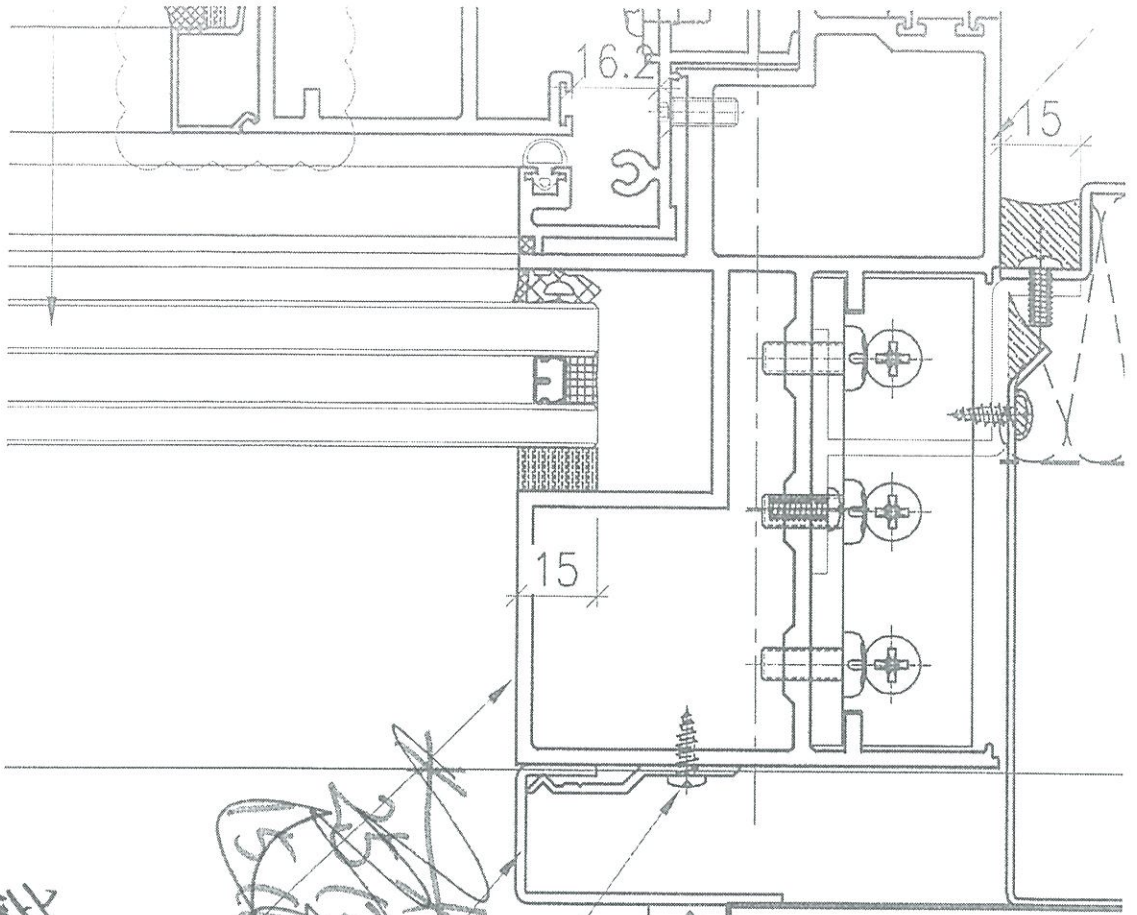

ALUM. TRANSONOM
T3A
2 mm THK ALUM. CLADDING

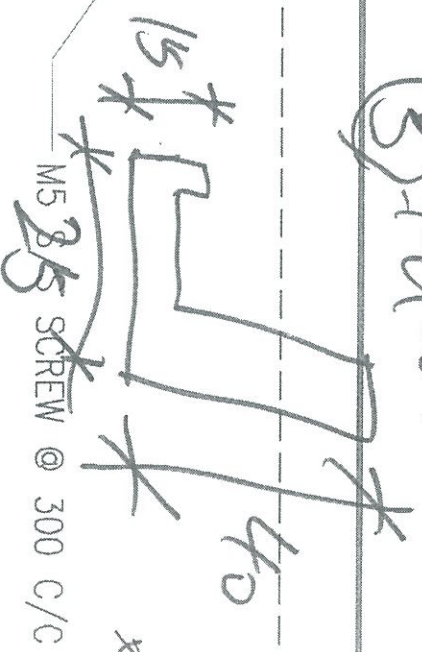

編號

③ F-U-003

室內水糟



規格 UC1803649

FKL-3

數量

400支

∠ 24x0 志

~~(做保護)~~

R2