



工程指示 / 要求簡箋(E.I.)

工程指示編號：EI / 0194 / 19

修改版次：A

工程編號：J - 837

工程名稱：觀塘裕民坊

工程項目：幕牆 趟門用背板(T1-T5)(樣板層)

收件人：生統/ 永林

發件人：Eric Liu

日期：14/02/2019

要求提供 / 確認 事項：

- | | | |
|------------------------------------|-------------------------------------|-------------------------------|
| <input type="checkbox"/> 初步鋁料 B.M. | <input type="checkbox"/> 加工拆圖，然後生產 | <input type="checkbox"/> 尺寸表 |
| <input type="checkbox"/> 正式鋁料 B.M. | <input type="checkbox"/> 技術上資料 / 指示 | <input type="checkbox"/> 報價 |
| <input type="checkbox"/> 配件 B.M. | <input type="checkbox"/> 樣辦或貨品說明書 | <input type="checkbox"/> 分判合約 |
| <input type="checkbox"/> 其他：_____ | | |

內容：

請按加工圖生產幕牆趟門用背板送廠

1) 背板要連趟門梗橫(頂底, X85574, X85572) 出貨

A 版: 則師確定背板顏色改用香檳金色(UCT803649FXL-3)

謝謝!

請在 2019/ 2 / 22 前完成上列要求。

附： 1 頁圖登，2 頁加工圖

以上項目為：

- 原合約工程包 原合約工程加 / 減賬 新工程報價

原因：-

分發東莞各部門：

- () 生產技術總監 連附件 () 技術部 連附件 *永林* () 生產部 連附件 () 機械設計部 連附件
 () 採購部 連附件 () 生產統籌部 連附件 *楊*
 () 質檢部 連附件 () 會計部 連附件 () 報關組 連附件 () 其他 楊榮輝 連附件

分發其他分判：

- () 王禮秋 連附件

分發香港各部門：

- () 行政部 連附件 () 會計部 連附件 () 統籌部 連附件 () 工程部地盤科文 連附件 *Y103*
 () 採購部 連附件 () QS 部 連附件 () 維修部 連附件 () 其他 _____ 連附件

傳遞編號：

HK0379/19

發件人簽署：
Eric Liu

項目經理簽署：
[Signature]

EG-DWG3





美特鋁質有限公司
MIDI Aluminium Fabricator Ltd.

工程號 J-837 地盤 觀塘裕民坊

工廠用

含廠用樣板, 1件

| 隔熱棉鋁板編號 | 數量 | L | MXN | A | 右SD梗 | 窗號 | 樓層位置 |
|-----------|----|--------|-------|---------|--------|----------|------|
| AG-SD-101 | 1 | 756.5 | 300 X | 2 78.25 | 907.5 | T1CWG-1左 | 8/F |
| AG-SD-102 | 1 | 909 | 250 X | 3 79.5 | 1060 | T1CWG-1右 | 8/F |
| AG-SD-103 | 1 | 609 | 250 X | 2 54.5 | 760 | T1CWF-2 | 8/F |
| AG-SD-104 | 1 | 816.5 | 250 X | 3 53.25 | 967.5 | T1CWE-1 | 8/F |
| AG-SD-106 | 1 | 941.5 | 250 X | 3 95.75 | 1092.5 | T1CWD-1左 | 8/F |
| AG-SD-107 | 1 | 784 | 300 X | 2 92 | 935 | T1CWD-1右 | 8/F |
| AG-SD-110 | 1 | 856.5 | 250 X | 3 53.25 | 1007.5 | T1CWB-2 | 8/F |
| AG-SD-111 | 1 | 1279 | 300 X | 4 39.5 | 1430 | T1CWB-1 | 8/F |
| AG-SD-116 | 1 | 616.5 | 250 X | 2 58.25 | 767.5 | T1CWL-2 | 8/F |
| AG-SD-117 | 1 | 784 | 300 X | 2 92 | 935 | T1CWL-1 | 8/F |
| AG-SD-121 | 1 | 809 | 250 X | 3 29.5 | 960 | T1CWJ-1 | 8/F |
| AG-SD-201 | 1 | 756.5 | 300 X | 2 78.25 | 907.5 | T2CWH-1左 | 8/F |
| AG-SD-203 | 1 | 616.5 | 250 X | 2 58.25 | 767.5 | T2CWG-2左 | 8/F |
| AG-SD-204 | 1 | 784 | 300 X | 2 92 | 935 | T2CWG-2右 | 8/F |
| AG-SD-207 | 2 | 616.5 | 250 X | 2 58.25 | 767.5 | T2CWE-2 | 8/F |
| AG-SD-208 | 1 | 784 | 300 X | 2 92 | 935 | T2CWE-1 | 8/F |
| AG-SD-210 | 1 | 709 | 300 X | 2 54.5 | 860 | T2CWC-1 | 8/F |
| AG-SD-213 | 1 | 756.5 | 300 X | 2 78.25 | 907.5 | T2CWA-1左 | 8/F |
| AG-SD-214 | 1 | 1034 | 300 X | 3 67 | 1185 | T2CWA-1右 | 8/F |
| AG-SD-216 | 1 | 756.5 | 300 X | 2 78.25 | 907.5 | T2CWM-2 | 8/F |
| AG-SD-217 | 1 | 909 | 250 X | 3 79.5 | 1060 | T2CWM-1 | 8/F |
| AG-SD-218 | 1 | 541.5 | 230 X | 2 40.75 | 692.5 | T2CWL-2左 | 8/F |
| AG-SD-220 | 1 | 816.5 | 250 X | 3 33.25 | 967.5 | T2CWL-1左 | 8/F |
| AG-SD-222 | 1 | 554 | 250 X | 2 27 | 705 | T2CWJ-1左 | 8/F |
| AG-SD-223 | 1 | 709 | 300 X | 2 54.5 | 860 | T2CWJ-1右 | 8/F |
| AG-SD-302 | 1 | 1016.5 | 300 X | 3 58.25 | 1167.5 | T3CWE-1左 | 8/F |
| AG-SD-304 | 1 | 616.5 | 250 X | 2 58.25 | 767.5 | T3CWL-2 | 8/F |
| AG-SD-305 | 1 | 834 | 250 X | 3 42 | 985 | T3CWL-1 | 8/F |
| AG-SD-312 | 1 | 616.5 | 250 X | 2 58.25 | 767.5 | T3CWC-2 | 8/F |
| AG-SD-313 | 1 | 784 | 300 X | 2 92 | 935 | T3CWC-1 | 8/F |
| AG-SD-316 | 1 | 756.5 | 300 X | 2 78.25 | 907.5 | T3CWA-1左 | 8/F |
| AG-SD-317 | 1 | 1134 | 250 X | 4 67 | 1285 | T3CWA-1右 | 8/F |
| AG-SD-318 | 1 | 665 | 300 X | 2 32.5 | 816 | T3CWD-1左 | 8/F |
| AG-SD-320 | 1 | 616.5 | 250 X | 2 58.25 | 767.5 | T3CWG-1左 | 8/F |
| AG-SD-501 | 1 | 909 | 250 X | 3 79.5 | 1060 | T5CWN-1 | 8/F |
| AG-SD-503 | 1 | 859 | 250 X | 3 54.5 | 1010 | T5CWL-1 | 8/F |
| AG-SD-504 | 1 | 561.5 | 250 X | 2 30.75 | 712.5 | T5CWJK-1 | 8/F |
| AG-SD-505 | 1 | 756.5 | 300 X | 2 78.25 | 907.5 | T5CWH-2 | 8/F |
| AG-SD-506 | 1 | 784 | 300 X | 2 92 | 935 | T5CWH-1 | 8/F |
| AG-SD-509 | 1 | 616.5 | 250 X | 2 58.25 | 767.5 | T5CWF-2 | 8/F |
| AG-SD-510 | 1 | 784 | 300 X | 2 92 | 935 | T5CWF-1 | 8/F |
| AG-SD-513 | 1 | 616.5 | 250 X | 2 58.25 | 767.5 | T5CWD-2 | 8/F |
| AG-SD-514 | 1 | 809 | 250 X | 3 29.5 | 960 | T5CWD-1 | 8/F |
| AG-SD-518 | 1 | 1329 | 300 X | 4 64.5 | 1480 | T5CWA-3左 | 8/F |
| 合計 | 45 | | | | | | |

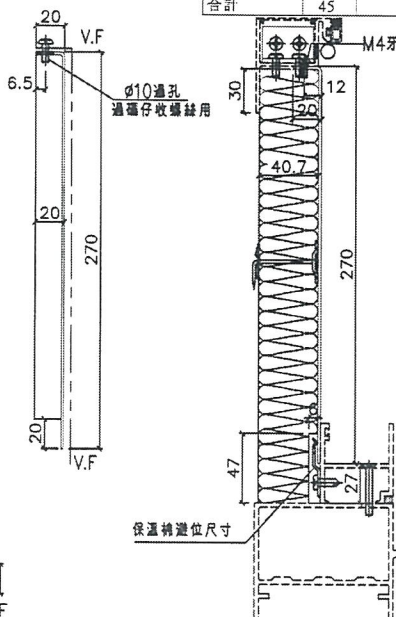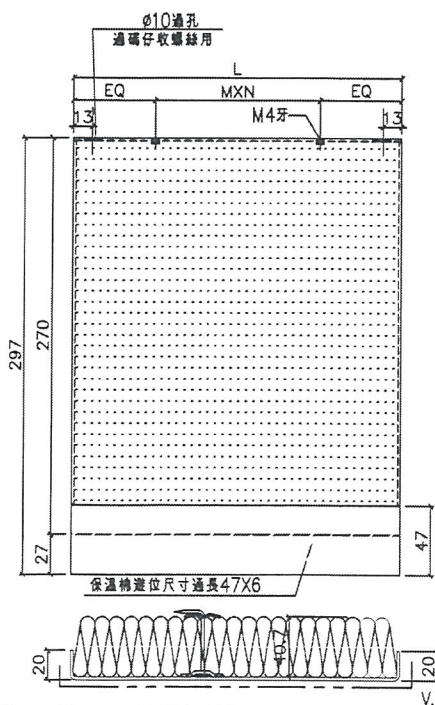

| | | | | | | | |
|----|----------------|----|-----|------------|----|-----------|--|
| 名稱 | 趟門(陽臺背板)拆圖 | 制圖 | 謝永林 | 2019.01.22 | 修改 | | |
| 材料 | 2mm厚鋁板 | 復核 | | | 日期 | | |
| 顏色 | 銀藍UCT13172XL-3 | 批准 | | | 圖號 | AG-SD-101 | |

UCT803649FXL-3
香檳金


EG-DWG3

美特鋁質有限公司
MIDI Aluminium Fabricator Ltd.

工程號 J-837 地盤 觀塘裕民坊

工廠用

| 隔熱棉鋁板編號 | 數量 | L | MXN | A | 左SD梗 | 窗號 | 樓層位置 |
|-----------|----|--------|---------|-------|--------|-----------|------|
| AG-SD-106 | 1 | 616.5 | 250 X 2 | 58.25 | 767.5 | T1CWD-1中 | 8/F |
| AG-SD-108 | 1 | 1129 | 250 X 4 | 64.5 | 1280 | T1CWA-3 | 8/F |
| AG-SD-109 | 1 | 856.5 | 250 X 3 | 53.25 | 1007.5 | T1CWA-2 | 8/F |
| AG-SD-112 | 1 | 884 | 250 X 3 | 67 | 1035 | T1CWC-1左 | 8/F |
| AG-SD-113 | 1 | 716.5 | 300 X 2 | 58.25 | 867.5 | T1CWC-1右 | 8/F |
| AG-SD-114 | 1 | 784 | 300 X 2 | 92 | 935 | T1CWM-2 | 8/F |
| AG-SD-115 | 1 | 616.5 | 250 X 2 | 58.25 | 767.5 | T1CWM-1 | 8/F |
| AG-SD-118 | 1 | 784 | 300 X 2 | 92 | 935 | T1CWK-2 | 8/F |
| AG-SD-122 | 1 | 984 | 300 X 3 | 42 | 1135 | T1CWH-2左 | 8/F |
| AG-SD-123 | 1 | 656.5 | 300 X 2 | 28.25 | 807.5 | T1CWH-2右 | 8/F |
| AG-SD-202 | 1 | 866.5 | 250 X 3 | 58.25 | 1017.5 | T2CWH-1右 | 8/F |
| AG-SD-205 | 1 | 784 | 300 X 2 | 92 | 935 | T2CWF-2 | 8/F |
| AG-SD-206 | 1 | 616.5 | 250 X 2 | 58.25 | 767.5 | T2CWF-1 | 8/F |
| AG-SD-209 | 1 | 709 | 300 X 2 | 54.5 | 860 | T2CWD-1 | 8/F |
| AG-SD-211 | 1 | 1134 | 250 X 4 | 67 | 1285 | T2CWB-2左 | 8/F |
| AG-SD-212 | 1 | 756.5 | 300 X 2 | 78.25 | 907.5 | T2CWB-2右 | 8/F |
| AG-SD-219 | 1 | 816.5 | 250 X 3 | 33.25 | 967.5 | T2CWL-2右 | 8/F |
| AG-SD-221 | 1 | 554 | 250 X 2 | 27 | 705 | T2CWK-1右 | 8/F |
| AG-SD-301 | 1 | 1216.5 | 290 X 4 | 26.25 | 1367.5 | T3CWF-1右 | 8/F |
| AG-SD-303 | 1 | 684 | 300 X 2 | 42 | 835 | T3CWM-2 | 8/F |
| AG-SD-306 | 1 | 784 | 300 X 2 | 92 | 935 | T3CWK-2 | 8/F |
| AG-SD-307 | 1 | 616.5 | 250 X 2 | 58.25 | 767.5 | T3CWK-1 | 8/F |
| AG-SD-308 | 1 | 709 | 300 X 2 | 54.5 | 860 | T3CWJ-2 | 8/F |
| AG-SD-309 | 1 | 616.5 | 250 X 2 | 58.25 | 767.5 | T3CWJ-1 | 8/F |
| AG-SD-310 | 1 | 1135.5 | 260 X 4 | 32 | 1382.5 | T3CWH-2 | 8/F |
| AG-SD-311 | 1 | 666.5 | 250 X 2 | 83.25 | 817.5 | T3CWH-1 | 8/F |
| AG-SD-314 | 1 | 1234 | 290 X 4 | 37 | 1385 | T3CWB-2左 | 8/F |
| AG-SD-315 | 1 | 756.5 | 300 X 2 | 78.25 | 907.5 | T3CWB-2右 | 8/F |
| AG-SD-319 | 1 | 616.5 | 250 X 2 | 58.25 | 767.5 | T3CWD-1右 | 8/F |
| AG-SD-321 | 1 | 666.5 | 250 X 2 | 83.25 | 817.5 | T3CWG-1右 | 8/F |
| AG-SD-502 | 1 | 1109 | 250 X 4 | 54.5 | 1260 | T5CWM-2 | 8/F |
| AG-SD-507 | 1 | 734 | 300 X 2 | 67 | 885 | T5CWG-2 | 8/F |
| AG-SD-508 | 1 | 616.5 | 250 X 2 | 58.25 | 767.5 | T5CWG-1 | 8/F |
| AG-SD-511 | 1 | 809 | 250 X 3 | 29.5 | 960 | T5CWE-2 | 8/F |
| AG-SD-512 | 1 | 616.5 | 250 X 2 | 58.25 | 767.5 | T5CWE-1 | 8/F |
| AG-SD-515 | 1 | 734 | 300 X 2 | 67 | 885 | T5CWC-1左下 | 8/F |
| AG-SD-517 | 1 | 838 | 250 X 3 | 44 | 989 | T5CWC-1右下 | 8/F |
| 合計 | 37 | | | | | | |

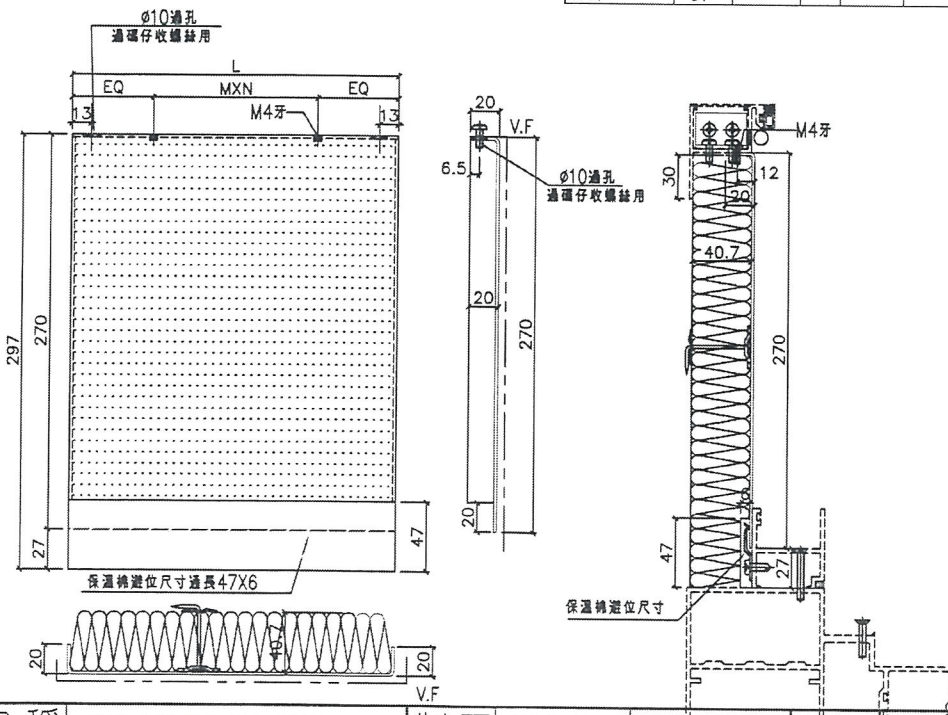

| | | | | | | | |
|----|----------------|----|-----|------------|----|-----------|--|
| 名稱 | 趟門(陽臺背板)拆圖 | 制圖 | 謝永林 | 2019.01.22 | 修改 | | |
| 材料 | 2mm厚鋁板 | 復核 | | | 日期 | | |
| 顏色 | 銀藍UCT13172XL-3 | 批准 | | | 圖號 | AG-SD-106 | |

UCT803649FL-3
香檳金

midi@midiltd.com.hk

From: Wong Wai Yee Christina <christinawong@wongtung.com>
To: "SHW" <shw@czegl.com.hk>
Copies to: WTPL - URA Kwun Tong Areas 2-3 <ura-kwuntong2-3@wongtung.com>, "patrickcheung@sino.com" <patrickcheung@sino.com>, "patrickluk@sino.com" <patrickluk@sino.com>, "clementho@sino.com" <clementho@sino.com>, "leehoiyuen@sino.com" <leehoiyuen@sino.com>, "lungkwokkeung@sino.com" <lungkwokkeung@sino.com>, "lamiyuhung@sino.com" <lamiyuhung@sino.com>, "maikailun@sino.com" <maikailun@sino.com>, "nkil6514@sino-land.com" <nkil6514@sino-land.com>, "dennis.chiu@aecom.com" <dennis.chiu@aecom.com>, "gabriel.cheung@aecom.com" <gabriel.cheung@aecom.com>, "urak7_aecom@aecom.com" <urak7_aecom@aecom.com>, "Kim.Wong@aecom.com" <Kim.Wong@aecom.com>, "midi@midiltd.com.hk" <midi@midiltd.com.hk>, "herbertthung@sino.com" <herbertthung@sino.com>
Subject: RE: NKIL 6514 [MC Tower] - Material & Sample Submission of Aluminium Backpan TM09 & TG07 (Silver Blue) (SHW/CSF/MC/A/MAT/1379)
Date sent: Wed, 30 Jan 2019 07:35:48 +0000

Dear CR and Midi,

?

Per confirmation by SINO PM last Wednesday, please use colour champagne gold backpan for the mock up floor.

?

Regards

?

Christina Wong

WONG TUNG & PARTNERS LIMITED 樓

T +852 2803 9888?D +852 2803 9763?F +852 2513 1728?W <http://www.wongtung.com>

18-F, Cityplaza 3, Taikoo Shing, Hong Kong.

?

Important Notice

This email and any attachments to it may be confidential and are intended solely for the use of the individual(s) to whom it is addressed. If you are not the intended recipient of this email, you must neither take any action based upon its contents, nor copy or show it to anyone. Please contact the sender if you believe you have received this email in error.

?

From: SHW [mailto:shw@czegl.com.hk]

Sent: 2018年12月13日 11:05

To: WTPL - URA Kwun Tong Areas 2-3; patrickcheung@sino.com; patrickluk@sino.com; clementho@sino.com; leehoiyuen@sino.com; lungkwokkeung@sino.com; lamiyuhung@sino.com; maikailun@sino.com; nkil6514@sino-land.com; dennis.chiu@aecom.com; gabriel.cheung@aecom.com; urak7_aecom@aecom.com; Kim.Wong@aecom.com; midi@midiltd.com.hk
Cc: 'SHW, Project'

Subject: NKIL 6514 [MC Tower] - Material & Sample Submission of Aluminium Backpan TM09 & TG07 (Silver Blue) (SHW/CSF/MC/A/MAT/1379)

?

Dear Ms. Kennis Chan

Please find the attached for your approval.

Original copy will be sent to your office accordingly.