



工程指示 / 要求簡箋(E.I.)

工程指示編號：EI / 0216 / 19

修改版次：A

工程編號：J - 837

工程名稱：觀塘裕民坊

工程項目：幕牆 副框及玻璃線 (T3)(大貨 10-25,29-50/F)

收件人：生統/ 永林

發件人：Eric Liu

日期：18/02/2019

要求提供 / 確認 事項：

- | | | |
|------------------------------------|-------------------------------------|-------------------------------|
| <input type="checkbox"/> 初步鋁料 B.M. | <input type="checkbox"/> 加工拆圖，然後生產 | <input type="checkbox"/> 尺寸表 |
| <input type="checkbox"/> 正式鋁料 B.M. | <input type="checkbox"/> 技術上資料 / 指示 | <input type="checkbox"/> 報價 |
| <input type="checkbox"/> 配件 B.M. | <input type="checkbox"/> 樣辦或貨品說明書 | <input type="checkbox"/> 分判合約 |
| <input type="checkbox"/> 其他：_____ | | |

內容：

請按加工圖生產背板托角、副框、玻璃線(T3)(標準層 10-25,29-50/F)供廠組裝用

A 版: 因應單玻插線加去水孔，修改加工圖

請留意: 1) 按 MO 生產(EI9959A)

2) 背板托角、副框、玻璃線要跟企橫料出貨

3) 玻璃扣蓋現場後裝

4) 因 10-12/F 企料已出貨，10-12/F 用副框 玻璃線請生產後直送地盤安裝

5) 10-12/F 橫料未出貨，請連背板托角出貨

謝謝！

請在 2019/ 2 / 28 前完成上列要求。

附：4 頁圖登，28 頁加工圖，12 頁位置圖

以上項目為：

- 原合約工程包 原合約工程加 / 減賬 新工程報價

原因：-

分發東莞各部門：

- () 生產技術總監 連附件 () 技術部 連附件 *資料* () 生產部 連附件 () 機械設計部 連附件
 () 採購部 連附件 () 生產統籌部 連附件 *物*
 () 質檢部 連附件 () 會計部 連附件 () 報關組 連附件 () 其他 楊榮輝 連附件

分發其他分判：

- () 王禮秋 連附件

分發香港各部門：

- () 行政部 連附件 () 會計部 連附件 () 統籌部 連附件 () 工程部地盤科文 連附件
 () 採購部 連附件 () QS 部 連附件 () 維修部 連附件 () 其他 _____ 連附件

傳遞編號：

HK0404 / 19

發件人簽署：

項目經理簽署：

(Handwritten signatures)

圖則登記表
DRAWING REGISTER

| |
|---|
| 工程名稱 Project Title: 觀塘裕民坊(T3座) 10F~25F,29F~50F |
| 框架式幕牆副框料拆圖 |
| 工程編號 Project No: J-837 |

| | | | | | | | | | | |
|---|-------------------------------|--|--|--|--|--|--|--|--|--|
| 年 | 接收日期 Receiving Date (適用於客戶圖則) | | | | | | | | | |
| | | | | | | | | | | |
| | | | | | | | | | | |
| 月 | | | | | | | | | | |
| | | | | | | | | | | |
| | | | | | | | | | | |
| 日 | | | | | | | | | | |
| | | | | | | | | | | |
| | | | | | | | | | | |

| | |
|--------------------|--|
| 分發予 Distributed To | |
| | |
| | |
| | |

| | | | | | | | | | | |
|---|------------------|----|--|--|--|--|--|--|--|--|
| 年 | 發出日期 Issued Date | | | | | | | | | |
| | 19 | 19 | | | | | | | | |
| | 01 | 02 | | | | | | | | |
| 月 | 31 | 18 | | | | | | | | |
| | | | | | | | | | | |
| | | | | | | | | | | |
| 日 | | | | | | | | | | |
| | | | | | | | | | | |
| | | | | | | | | | | |

| 圖則編號 Drg. No. | 圖則名稱 Drawing Title |
|------------------|-----------------------|
| ZX-XC01 | 玻璃扣蓋加工圖 |
| ZX-XC01R | 玻璃扣蓋加工圖 |
| ZX-XY01 | 玻璃扣蓋加工圖 |
| ZX-XY01R | 玻璃扣蓋加工圖 |
| UN-AM1a | 單玻插線加工圖 |
| UN-AM1a-1 | 單玻插線加工圖 (數據表) |
| UN-AM1aR | 單玻插線加工圖 |
| UN-AM1aR-1 | 單玻插線加工圖 (數據表) |
| UN-AM1b | 單玻插線加工圖 |
| UN-AM1b-1 | 單玻插線加工圖 (數據表) |
| UN-AM1bR | 單玻插線加工圖 |
| UN-AM1bR-1 | 單玻插線加工圖 (數據表) |
| UN-HM1 | 單玻插線加工圖 |
| UN-HM301 | 單玻插線加工圖 |
| UN-HM301S | 單玻插線加工圖 |
| UN-EH1 | 單玻插線加工圖 |
| UN-EH1a | 單玻插線加工圖 |
| UN-EH1R | 單玻插線加工圖 |
| UN-EH1aR | 單玻插線加工圖 |
| UN-EH301 | 單玻插線加工圖 |
| UN-EH301a | 單玻插線加工圖 |
| UN-EH302R | 單玻插線加工圖 |
| UN-EH302aR | 單玻插線加工圖 |
| UN-EH310W | 單玻插線加工圖 |
| UN-EH310aW | 單玻插線加工圖 |

| | | 修訂編號 Revision No. | | | | | | | | | |
|----|-----|----------------------|--|--|--|--|--|--|--|--|--|
| 1 | - A | | | | | | | | | | |
| 2 | - A | | | | | | | | | | |
| 3 | - A | | | | | | | | | | |
| 4 | - A | | | | | | | | | | |
| 5 | - - | | | | | | | | | | |
| 6 | - - | | | | | | | | | | |
| 7 | - - | | | | | | | | | | |
| 8 | - - | | | | | | | | | | |
| 9 | - - | | | | | | | | | | |
| 10 | - - | | | | | | | | | | |
| 11 | - - | | | | | | | | | | |
| 12 | - - | | | | | | | | | | |
| 13 | - A | | | | | | | | | | |
| 14 | - A | | | | | | | | | | |
| 15 | - A | | | | | | | | | | |
| 16 | - - | | | | | | | | | | |
| 17 | - A | | | | | | | | | | |
| 18 | - - | | | | | | | | | | |
| 19 | - A | | | | | | | | | | |
| 20 | - - | | | | | | | | | | |
| 21 | - A | | | | | | | | | | |
| 22 | - - | | | | | | | | | | |
| 23 | - A | | | | | | | | | | |
| 24 | - - | | | | | | | | | | |
| 25 | - A | | | | | | | | | | |

圖則登記表
DRAWING REGISTER

| |
|---|
| 工程名稱 Project Title: 觀塘裕民坊(T3座) 10F~25F,29F~50F |
| 框架式幕牆副框料拆圖 |
| 工程編號 Project No: J-837 |

| | | | | | | | | | | |
|---|-------------------------------|--|--|--|--|--|--|--|--|--|
| 年 | 接收日期 Receiving Date (適用於客戶圖則) | | | | | | | | | |
| | | | | | | | | | | |
| | | | | | | | | | | |
| 月 | | | | | | | | | | |
| 日 | | | | | | | | | | |

| | |
|--------------------|--|
| 分發予 Distributed To | |
| | |
| | |
| | |

| | | | | | | | | | | |
|---|------------------|----|--|--|--|--|--|--|--|--|
| 年 | 發出日期 Issued Date | | | | | | | | | |
| | 19 | 19 | | | | | | | | |
| | 01 | 02 | | | | | | | | |
| 月 | 31 | 18 | | | | | | | | |
| 日 | | | | | | | | | | |

| 圖則編號 Drg. No. | 圖則名稱 Drawing Title |
|------------------|-----------------------|
| UN-DM1a | 生梗企單玻加工圖 |
| UN-DM1a-1 | 生梗企單玻加工圖 (數據表) |
| UN-DM1aR | 生梗企單玻加工圖 |
| UN-DM1aR-1 | 生梗企單玻加工圖 (數據表) |
| UN-DM1b | 生梗企單玻加工圖 |
| UN-DM1b-1 | 生梗企單玻加工圖 (數據表) |
| UN-DM1bR | 生梗企單玻加工圖 |
| UN-DM1bR-1 | 生梗企單玻加工圖 (數據表) |
| UN-DM1d | 生梗企單玻加工圖 |
| UN-DM1d-1 | 生梗企單玻加工圖 (數據表) |
| UN-DM1dR | 生梗企單玻加工圖 |
| UN-DM1dR-1 | 生梗企單玻加工圖 (數據表) |
| UN-SM1 | 生梗企雙玻加工圖 |
| UN-SM1-1 | 生梗企雙玻加工圖 (數據表) |
| UN-SM1R | 生梗企雙玻加工圖 |
| UN-SM1R-1 | 生梗企雙玻加工圖 (數據表) |
| ZS-KG1 | 橫料扣蓋加工圖 |
| ZS-KG1-1 | 橫料扣蓋加工圖 (數據表) |
| ZS-S01b | 生梗企單玻扣蓋 |
| ZS-S01b-1 | 生梗企單玻扣蓋 |
| ZS-S01bR | 生梗企單玻扣蓋 |
| ZS-S01bR-1 | 生梗企單玻扣蓋 |
| ZS-S01d | 生梗企單玻扣蓋 |
| ZS-S01d-1 | 生梗企單玻扣蓋 |
| ZS-S01dR | 生梗企單玻扣蓋 |

| 修訂編號 Revision No. | | | | | | | | | | |
|----------------------|---|---|--|--|--|--|--|--|--|--|
| 26 | - | - | | | | | | | | |
| 27 | - | - | | | | | | | | |
| 28 | - | - | | | | | | | | |
| 29 | - | - | | | | | | | | |
| 30 | - | - | | | | | | | | |
| 31 | - | - | | | | | | | | |
| 32 | - | - | | | | | | | | |
| 33 | - | - | | | | | | | | |
| 34 | - | A | | | | | | | | |
| 35 | - | A | | | | | | | | |
| 36 | - | A | | | | | | | | |
| 37 | - | A | | | | | | | | |
| 38 | - | - | | | | | | | | |
| 39 | - | - | | | | | | | | |
| 40 | - | - | | | | | | | | |
| 41 | - | - | | | | | | | | |
| 42 | - | - | | | | | | | | |
| 43 | - | - | | | | | | | | |
| 44 | - | - | | | | | | | | |
| 45 | - | - | | | | | | | | |
| 46 | - | - | | | | | | | | |
| 47 | - | - | | | | | | | | |
| 48 | - | A | | | | | | | | |
| 49 | - | A | | | | | | | | |
| 50 | - | A | | | | | | | | |

圖則登記表
DRAWING REGISTER

| |
|---|
| 工程名稱 Project Title: 觀塘裕民坊(T3座) 10F~25F,29F~50F |
| 框架式幕牆副框料拆圖 |
| 工程編號 Project No: J-837 |

接收日期 Receiving Date (適用於客戶圖則)

| | | | | | | | | | | |
|---|--|--|--|--|--|--|--|--|--|--|
| 年 | | | | | | | | | | |
| 月 | | | | | | | | | | |
| 日 | | | | | | | | | | |

分發予 Distributed To

| |
|--|
| |
| |
| |

發出日期 Issued Date

| | | | | | | | | | | |
|---|----|----|--|--|--|--|--|--|--|--|
| 年 | 19 | 19 | | | | | | | | |
| 月 | 01 | 02 | | | | | | | | |
| 日 | 31 | 18 | | | | | | | | |

| 圖則編號 Drg. No. | 圖則名稱 Drawing Title |
|------------------|-----------------------|
| ZS-S01dR-1 | 生梗企單玻扣蓋 |
| ZS-BG1 | 生梗企雙玻扣蓋 |
| ZS-BG1-1 | 生梗企雙玻扣蓋 |
| ZS-BG1R | 生梗企雙玻扣蓋 |
| ZS-BG1R-1 | 生梗企雙玻扣蓋 |
| UN-HT1 | 背板托角加工圖 |
| UN-HT1-1 | 背板托角加工圖(數據表) |
| UN-HT1a | 背板托角加工圖 |
| UN-HT1a-1 | 背板托角加工圖(數據表) |
| UN-HT301 | 背板托角加工圖 |
| UN-HT301a | 背板托角加工圖 |
| UN-HT301S | 背板托角加工圖 |
| UN-HT301aS | 背板托角加工圖 |
| UN-HT312 | 背板托角加工圖 |
| UN-HT312a | 背板托角加工圖 |
| UN-HT310S | 背板托角加工圖 |
| UN-HT310aS | 背板托角加工圖 |
| 837-CW-2301(G) | 后裝內外蓋安裝位置圖 |
| 837-CW-2302(G) | 后裝內外蓋安裝位置圖 |
| 837-CW-2303(G) | 后裝內外蓋安裝位置圖 |
| 837-CW-2304(G) | 后裝內外蓋安裝位置圖 |
| 837-CW-2305(G) | 后裝內外蓋安裝位置圖 |
| 837-CW-2306(G) | 后裝內外蓋安裝位置圖 |
| 837-CW-2307(G) | 后裝內外蓋安裝位置圖 |
| 837-CW-2308(G) | 后裝內外蓋安裝位置圖 |

修訂編號
Revision No.

| | | | | | | | | | | |
|----|---|---|--|--|--|--|--|--|--|--|
| 51 | - | A | | | | | | | | |
| 52 | - | - | | | | | | | | |
| 53 | - | - | | | | | | | | |
| 54 | - | - | | | | | | | | |
| 55 | - | - | | | | | | | | |
| 56 | - | - | | | | | | | | |
| 57 | - | - | | | | | | | | |
| 58 | - | - | | | | | | | | |
| 59 | - | - | | | | | | | | |
| 60 | - | - | | | | | | | | |
| 61 | - | A | | | | | | | | |
| 62 | - | A | | | | | | | | |
| 63 | - | A | | | | | | | | |
| 64 | - | A | | | | | | | | |
| 65 | - | - | | | | | | | | |
| 66 | - | - | | | | | | | | |
| 67 | - | - | | | | | | | | |
| 68 | - | - | | | | | | | | |
| 69 | - | - | | | | | | | | |
| 70 | - | - | | | | | | | | |
| 71 | - | - | | | | | | | | |
| 72 | - | - | | | | | | | | |
| 73 | - | - | | | | | | | | |
| 74 | - | - | | | | | | | | |
| 75 | - | - | | | | | | | | |

圖則登記表
DRAWING REGISTER

| |
|--|
| 工程名稱 Project Title: 觀塘裕民坊(T3座) 10F~25F,29F~50F 框架式幕牆副框料拆圖 |
| 工程編號 Project No: J-837 |

接收日期 Receiving Date (適用於客戶圖則)

| | | | | | | | | | |
|---|--|--|--|--|--|--|--|--|--|
| 年 | | | | | | | | | |
| 月 | | | | | | | | | |
| 日 | | | | | | | | | |

分發予 Distributed To

| |
|--|
| |
| |
| |

發出日期 Issued Date

| | | | | | | | | | |
|---|----|----|--|--|--|--|--|--|--|
| 年 | 19 | 19 | | | | | | | |
| 月 | 01 | 02 | | | | | | | |
| 日 | 31 | 18 | | | | | | | |

| 圖則編號 Drg. No. | 圖則名稱 Drawing Title |
|------------------|-----------------------|
| 837-CW-2309(G) | 后裝內外蓋安裝位置圖 |
| 837-CW-2310(G) | 后裝內外蓋安裝位置圖 |
| 837-CW-2311(G) | 后裝內外蓋安裝位置圖 |
| 837-CW-2312(G) | 后裝內外蓋安裝位置圖 |
| 837-CW-2301 | 散料安裝位置圖 |
| 837-CW-2302 | 散料安裝位置圖 |
| 837-CW-2303 | 散料安裝位置圖 |
| 837-CW-2304 | 散料安裝位置圖 |
| 837-CW-2305 | 散料安裝位置圖 |
| 837-CW-2306 | 散料安裝位置圖 |
| 837-CW-2307 | 散料安裝位置圖 |
| 837-CW-2308 | 散料安裝位置圖 |
| 837-CW-2309 | 散料安裝位置圖 |
| 837-CW-2310 | 散料安裝位置圖 |
| 837-CW-2311 | 散料安裝位置圖 |
| 837-CW-2312 | 散料安裝位置圖 |
| UN-HM1a | 單玻插線加工圖 |
| UN-HM301a | 單玻插線加工圖 |
| UN-HM301aS | 單玻插線加工圖 |
| UN-HM301(D) | 單玻插線加工圖 |

修訂編號
Revision No.

| | | | | | | | | | |
|----|----|---|--|--|--|--|--|--|--|
| 76 | - | - | | | | | | | |
| 77 | - | - | | | | | | | |
| 78 | - | - | | | | | | | |
| 79 | - | - | | | | | | | |
| 80 | - | A | | | | | | | |
| 81 | - | A | | | | | | | |
| 82 | - | A | | | | | | | |
| 83 | - | A | | | | | | | |
| 84 | - | A | | | | | | | |
| 85 | - | A | | | | | | | |
| 86 | - | A | | | | | | | |
| 87 | - | A | | | | | | | |
| 88 | - | A | | | | | | | |
| 89 | - | A | | | | | | | |
| 90 | - | A | | | | | | | |
| 91 | - | A | | | | | | | |
| 92 | 新增 | | | | | | | | |
| 93 | 新增 | | | | | | | | |
| 94 | 新增 | | | | | | | | |
| 95 | 新增 | | | | | | | | |





美特鋁質 有限公司
MIDI Aluminium Fabricator Ltd.

工程號 J-837 地盤 觀塘裕民坊

工廠用

生窗+SD梗頂位用

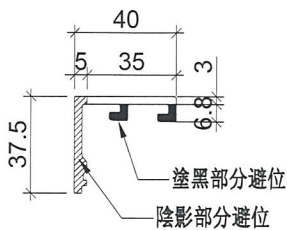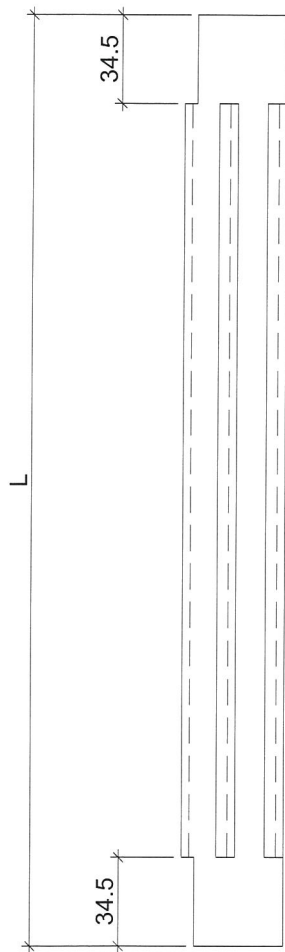

| 物料編號 | L | 層數 | 每層 | 總數量 | 分格尺寸 | 使用位置 | 樓層 |
|---------|-----|----|----|-----|----------|-----------------|-----------------|
| ZS-XC01 | 879 | 33 | 2 | 66 | 900 | T3CW-F-1 | 10F~25F,29F-50F |
| | 879 | 33 | 2 | 66 | 900 | T3CW-E-1 | 10F~25F,29F-50F |
| | 879 | 33 | 1 | 33 | 900 | T3CW-M-2 | 10F~25F,29F-50F |
| | 879 | 33 | 1 | 33 | 900 | T3CW-M-1 | 10F~25F,29F-50F |
| | 879 | 33 | 2 | 66 | 900 | T3CW-L-2 | 10F~25F,29F-50F |
| | 879 | 33 | 1 | 33 | 900 | T3CW-L-1 | 10F~25F,29F-50F |
| | 879 | 33 | 1 | 33 | 900 | T3CW-K-2 | 10F~25F,29F-50F |
| | 879 | 33 | 1 | 33 | 900 | T3CW-K-1 | 10F~25F,29F-50F |
| | 879 | 33 | 1 | 33 | 900 | T3CW-J-2 | 10F~25F,29F-50F |
| | 879 | 33 | 1 | 33 | 900 | T3CW-J-1 | 10F~25F,29F-50F |
| | 879 | 33 | 1 | 33 | 900 | T3CW-H-3 | 10F~25F,29F-50F |
| | 879 | 33 | 1 | 33 | 900 | T3CW-H-1 | 10F~25F,29F-50F |
| | 879 | 33 | 1 | 33 | 900 | T3CW-C-2 | 10F~25F,29F-50F |
| | 879 | 33 | 1 | 33 | 900 | T3CW-C-1 | 10F~25F,29F-50F |
| | 879 | 33 | 3 | 99 | 900 | T3CW-B-2 | 10F~25F,29F-50F |
| | 879 | 33 | 1 | 33 | 900 | T3CW-B-1 | 10F~25F,29F-50F |
| | 879 | 33 | 2 | 66 | 900 | T3CW-A-2 | 10F~25F,29F-50F |
| | 879 | 33 | 3 | 99 | 900 | T3CW-A-1 | 10F~25F,29F-50F |
| | 879 | 33 | 1 | 33 | 900 | T3CW-D-1 | 10F~25F,29F-50F |
| | 879 | 33 | 1 | 33 | 900 | T3CW-G-1 | 10F~25F,29F-50F |
| 879 | 33 | 1 | 33 | 900 | T3CW-F-2 | 10F~25F,29F-50F | |
| ZS-XC02 | 849 | 33 | 4 | 132 | 870 | T3CW-F-1 | 10F~25F,29F-50F |
| | 849 | 33 | 4 | 132 | 870 | T3CW-E-1 | 10F~25F,29F-50F |
| | 849 | 33 | 1 | 33 | 870 | T3CW-M-2 | 10F~25F,29F-50F |
| | 849 | 33 | 2 | 66 | 870 | T3CW-M-1 | 10F~25F,29F-50F |
| | 849 | 33 | 2 | 66 | 870 | T3CW-L-2 | 10F~25F,29F-50F |
| | 849 | 33 | 1 | 33 | 870 | T3CW-L-1 | 10F~25F,29F-50F |
| | 849 | 33 | 1 | 33 | 870 | T3CW-K-2 | 10F~25F,29F-50F |
| | 849 | 33 | 2 | 66 | 870 | T3CW-K-1 | 10F~25F,29F-50F |
| | 849 | 33 | 1 | 33 | 870 | T3CW-J-2 | 10F~25F,29F-50F |
| | 849 | 33 | 2 | 66 | 870 | T3CW-J-1 | 10F~25F,29F-50F |
| | 849 | 33 | 1 | 33 | 870 | T3CW-H-3 | 10F~25F,29F-50F |
| | 849 | 33 | 2 | 66 | 870 | T3CW-H-1 | 10F~25F,29F-50F |
| | 849 | 33 | 2 | 66 | 870 | T3CW-C-2 | 10F~25F,29F-50F |
| | 849 | 33 | 1 | 33 | 870 | T3CW-C-1 | 10F~25F,29F-50F |
| | 849 | 33 | 4 | 132 | 870 | T3CW-B-2 | 10F~25F,29F-50F |
| | 849 | 33 | 2 | 66 | 870 | T3CW-B-1 | 10F~25F,29F-50F |
| | 849 | 33 | 2 | 66 | 870 | T3CW-A-2 | 10F~25F,29F-50F |
| | 549 | 33 | 1 | 33 | 570 | T3CW-H-1 | 10F~25F,29F-50F |
| | 549 | 33 | 1 | 33 | 570 | T3CW-C-2 | 10F~25F,29F-50F |
| | 549 | 33 | 1 | 33 | 570 | T3CW-C-1 | 10F~25F,29F-50F |
| | 549 | 33 | 2 | 66 | 570 | T3CW-B-2 | 10F~25F,29F-50F |
| | 549 | 33 | 2 | 66 | 570 | T3CW-B-1 | 10F~25F,29F-50F |
| | 549 | 33 | 2 | 66 | 570 | T3CW-A-1 | 10F~25F,29F-50F |
| | 549 | 33 | 2 | 66 | 570 | T3CW-D-1 | 10F~25F,29F-50F |
| | 549 | 33 | 2 | 66 | 570 | T3CW-G-1 | 10F~25F,29F-50F |
| | 549 | 20 | 1 | 20 | 570 | T3CW-F-1 | 29F~50F |
| | 549 | 14 | 1 | 14 | 570 | T3CW-E-1 | 36F~50F |
| 549 | 19 | 1 | 19 | 570 | T3CW-M-1 | 30F~50F | |

| | | | | | | |
|----|--------------------|----|-----|------------|----|------------|
| 名稱 | 玻璃扣蓋 | 制圖 | 陳俊賢 | 2018.10.21 | 修改 | A |
| 材料 | X85558 | 復核 | 謝永林 | 2019.02.18 | 日期 | 2019.02.18 |
| 顏色 | EC-DG-S332054 (3塗) | 批准 | | | 圖號 | ZS-XC01 |



美特鋁質 有限公司
MIDI Aluminium Fabricator Ltd.

工程號



J-837

地盤

觀塘裕民坊




生窗+SD梗頂位用

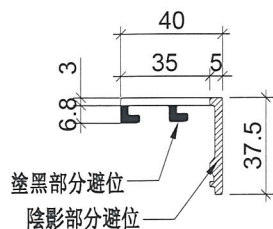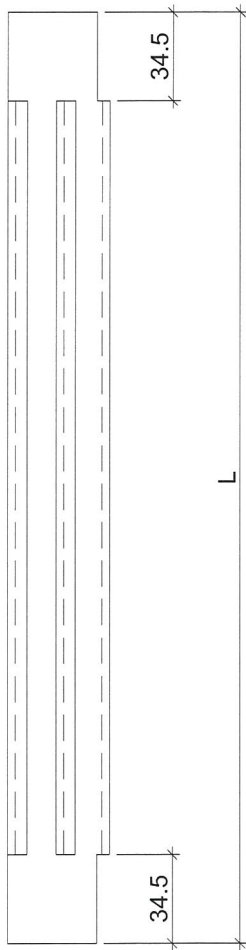

| 物料編號 | L | 層數 | 每層 | 總數量 | 分格尺寸 | 使用位置 | 樓層 |
|----------|-----|----|----|-----|----------|----------------|----------------|
| ZS-XC01R | 879 | 3 | 2 | 6 | 900 | T3CW-F-1 | 10F~25F,29-50F |
| | 879 | 3 | 3 | 9 | 900 | T3CW-E-1 | 10F~25F,29-50F |
| | 879 | 3 | 1 | 3 | 900 | T3CW-M-2 | 10F~25F,29-50F |
| | 879 | 3 | 2 | 6 | 900 | T3CW-M-1 | 10F~25F,29-50F |
| | 879 | 3 | 1 | 3 | 900 | T3CW-L-2 | 10F~25F,29-50F |
| | 879 | 3 | 1 | 3 | 900 | T3CW-L-1 | 10F~25F,29-50F |
| | 879 | 3 | 1 | 3 | 900 | T3CW-K-2 | 10F~25F,29-50F |
| | 879 | 3 | 1 | 3 | 900 | T3CW-K-1 | 10F~25F,29-50F |
| | 879 | 3 | 1 | 3 | 900 | T3CW-J-2 | 10F~25F,29-50F |
| | 879 | 3 | 1 | 3 | 900 | T3CW-J-1 | 10F~25F,29-50F |
| | 879 | 3 | 1 | 3 | 900 | T3CW-H-1 | 10F~25F,29-50F |
| | 879 | 3 | 1 | 3 | 900 | T3CW-C-2 | 10F~25F,29-50F |
| | 879 | 3 | 1 | 3 | 900 | T3CW-C-1 | 10F~25F,29-50F |
| | 879 | 3 | 2 | 6 | 900 | T3CW-B-2 | 10F~25F,29-50F |
| | 879 | 3 | 2 | 6 | 900 | T3CW-B-1 | 10F~25F,29-50F |
| | 879 | 3 | 1 | 3 | 900 | T3CW-A-2 | 10F~25F,29-50F |
| | 879 | 3 | 3 | 9 | 900 | T3CW-A-1 | 10F~25F,29-50F |
| | 879 | 3 | 1 | 3 | 900 | T3CW-D-1 | 10F~25F,29-50F |
| | 879 | 3 | 1 | 3 | 900 | T3CW-G-1 | 10F~25F,29-50F |
| | 879 | 3 | 2 | 6 | 900 | T3CW-F-2 | 10F~25F,29-50F |
| ZS-XC02R | 849 | 3 | 4 | 12 | 870 | T3CW-F-1 | 10F~25F,29-50F |
| | 849 | 3 | 4 | 12 | 870 | T3CW-E-1 | 10F~25F,29-50F |
| | 849 | 3 | 1 | 3 | 870 | T3CW-M-2 | 10F~25F,29-50F |
| | 849 | 3 | 2 | 6 | 870 | T3CW-M-1 | 10F~25F,29-50F |
| | 849 | 3 | 2 | 6 | 870 | T3CW-L-2 | 10F~25F,29-50F |
| | 849 | 3 | 1 | 3 | 870 | T3CW-L-1 | 10F~25F,29-50F |
| | 849 | 3 | 1 | 3 | 870 | T3CW-K-2 | 10F~25F,29-50F |
| | 849 | 3 | 2 | 6 | 870 | T3CW-K-1 | 10F~25F,29-50F |
| | 849 | 3 | 1 | 3 | 870 | T3CW-J-2 | 10F~25F,29-50F |
| | 849 | 3 | 1 | 3 | 870 | T3CW-J-1 | 10F~25F,29-50F |
| | 849 | 3 | 1 | 3 | 870 | T3CW-H-3 | 10F~25F,29-50F |
| | 849 | 3 | 2 | 6 | 870 | T3CW-H-1 | 10F~25F,29-50F |
| | 849 | 3 | 2 | 6 | 870 | T3CW-C-2 | 10F~25F,29-50F |
| | 849 | 3 | 1 | 3 | 870 | T3CW-C-1 | 10F~25F,29-50F |
| | 849 | 3 | 4 | 12 | 870 | T3CW-B-2 | 10F~25F,29-50F |
| | 849 | 3 | 2 | 6 | 870 | T3CW-B-1 | 10F~25F,29-50F |
| | 849 | 3 | 2 | 6 | 870 | T3CW-A-2 | 10F~25F,29-50F |
| | 849 | 3 | 4 | 12 | 870 | T3CW-A-1 | 10F~25F,29-50F |
| | 849 | 3 | 2 | 6 | 870 | T3CW-D-1 | 10F~25F,29-50F |
| | 849 | 3 | 2 | 6 | 870 | T3CW-G-1 | 10F~25F,29-50F |
| 849 | 3 | 3 | 9 | 870 | T3CW-F-2 | 10F~25F,29-50F | |
| ZS-XC03R | 549 | 3 | 1 | 3 | 570 | T3CW-F-1 | 10F~25F,29-50F |
| | 549 | 3 | 1 | 3 | 570 | T3CW-E-1 | 10F~25F,29-50F |
| | 549 | 3 | 1 | 3 | 570 | T3CW-M-2 | 10F~25F,29-50F |
| | 549 | 3 | 1 | 3 | 570 | T3CW-L-2 | 10F~25F,29-50F |
| | 549 | 3 | 1 | 3 | 570 | T3CW-L-1 | 10F~25F,29-50F |
| | 549 | 3 | 1 | 3 | 570 | T3CW-K-2 | 10F~25F,29-50F |
| | 549 | 3 | 1 | 3 | 570 | T3CW-K-1 | 10F~25F,29-50F |
| | 549 | 3 | 1 | 3 | 570 | T3CW-J-2 | 10F~25F,29-50F |
| | 549 | 3 | 1 | 3 | 570 | T3CW-J-1 | 10F~25F,29-50F |
| | 549 | 3 | 1 | 3 | 570 | T3CW-H-2 | 10F~25F,29-50F |
| | 549 | 3 | 1 | 3 | 570 | T3CW-H-1 | 10F~25F,29-50F |
| | 549 | 3 | 1 | 3 | 570 | T3CW-C-2 | 10F~25F,29-50F |
| | 549 | 3 | 1 | 3 | 570 | T3CW-C-1 | 10F~25F,29-50F |
| | 549 | 3 | 2 | 6 | 570 | T3CW-B-2 | 10F~25F,29-50F |
| | 549 | 3 | 2 | 6 | 570 | T3CW-A-1 | 10F~25F,29-50F |
| | 549 | 3 | 2 | 6 | 570 | T3CW-D-1 | 10F~25F,29-50F |
| | 549 | 3 | 2 | 6 | 570 | T3CW-G-1 | 10F~25F,29-50F |
| | 549 | 20 | 1 | 20 | 570 | T3CW-F-1 | 29F~50F |
| | 549 | 14 | 1 | 14 | 570 | T3CW-E-1 | 36F~50F |
| | 549 | 19 | 1 | 19 | 570 | T3CW-M-1 | 30F~50F |

| | | | | | | |
|----|--------------------|----|-----|------------|----|------------|
| 名稱 | 玻璃扣蓋 | 制圖 | 陳俊賢 | 2018.10.21 | 修改 | A |
| 材料 | X85558 | 復核 | 謝永林 | 2019.02.18 | 日期 | 2019.02.18 |
| 顏色 | EC-DG-S332054 (3塗) | 批準 | | | 圖號 | ZS-XC01R |

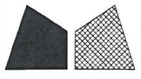

美特鋁質 有限公司
MIDI Aluminium Fabricator Ltd.

工程號



J-837

地盤

觀塘裕民坊



大梗窗位用

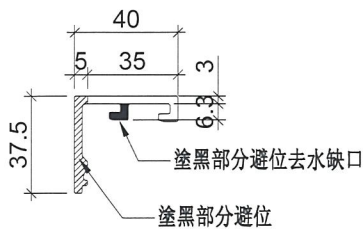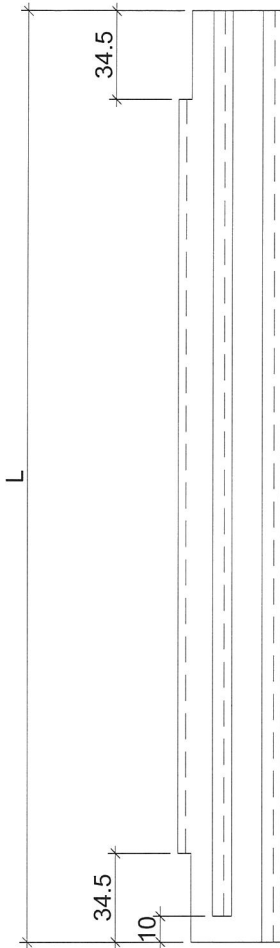

| 物料編號 | 層數 | 每層 | 窗數量 | 窗大小 | 窗型 | 樓層 |
|---------|------|----|-----|-----|------|--------------------------|
| ZS-XY01 | 879 | 33 | 2 | 66 | 900 | T3CW-F-1 10F~25F,29F~50F |
| | 879 | 33 | 2 | 66 | 900 | T3CW-E-1 10F~25F,29F~50F |
| | 879 | 33 | 1 | 33 | 900 | T3CW-M-1 10F~25F,29F~50F |
| | 879 | 33 | 1 | 33 | 900 | T3CW-B-2 10F~25F,29F~50F |
| | 879 | 33 | 1 | 33 | 900 | T3CW-B-1 10F~25F,29F~50F |
| | 879 | 33 | 1 | 33 | 900 | T3CW-A-1 10F~25F,29F~50F |
| | 879 | 33 | 1 | 33 | 900 | T3CW-F-2 10F~25F,29F~50F |
| | 879 | 13 | 1 | 13 | 900 | T3CW-F-1 10F~25F |
| | 879 | 19 | 1 | 19 | 900 | T3CW-E-1 10F~25F,29F~35F |
| | 879 | 14 | 1 | 14 | 900 | T3CW-M-1 10F~25F,29F |
| ZS-XY02 | 2229 | 33 | 2 | 66 | 2250 | T3CW-F-1 10F~25F,29F~50F |
| | 2229 | 33 | 2 | 66 | 2250 | T3CW-E-1 10F~25F,29F~50F |
| | 2229 | 33 | 1 | 33 | 2250 | T3CW-M-1 10F~25F,29F~50F |
| | 2229 | 33 | 1 | 33 | 2250 | T3CW-L-2 10F~25F,29F~50F |
| | 2229 | 33 | 1 | 33 | 2250 | T3CW-K-1 10F~25F,29F~50F |
| | 2229 | 33 | 1 | 33 | 2250 | T3CW-J-1 10F~25F,29F~50F |
| | 2229 | 33 | 1 | 33 | 2250 | T3CW-H-3 10F~25F,29F~50F |
| | 2229 | 33 | 1 | 33 | 2250 | T3CW-H-1 10F~25F,29F~50F |
| | 2229 | 33 | 1 | 33 | 2250 | T3CW-C-2 10F~25F,29F~50F |
| | 2229 | 33 | 2 | 66 | 2250 | T3CW-B-2 10F~25F,29F~50F |
| | 2229 | 33 | 1 | 33 | 2250 | T3CW-B-1 10F~25F,29F~50F |
| | 2229 | 33 | 1 | 33 | 2250 | T3CW-A-2 10F~25F,29F~50F |
| | 2229 | 33 | 2 | 66 | 2250 | T3CW-A-1 10F~25F,29F~50F |
| | 2229 | 33 | 2 | 66 | 2250 | T3CW-F-2 10F~25F,29F~50F |
| | 2229 | 13 | 1 | 13 | 2250 | T3CW-F-1 10F~25F |
| | 2229 | 20 | 1 | 20 | 2250 | T3CW-E-1 10F~25F,29F~36F |
| | 2229 | 15 | 1 | 15 | 2250 | T3CW-M-1 10F~25F,29F~30F |

| | | | | | | | |
|----|--------------------|----|-----|------------|----|------------|--|
| 名稱 | 玻璃扣蓋 | 制圖 | 陳俊賢 | 2018.10.21 | 修改 | A | |
| 材料 | X85558 | 復核 | 謝永林 | 2019.02.18 | 日期 | 2019.02.18 | |
| 顏色 | EC-DG-S332054 (3塗) | 批準 | | | 圖號 | ZS-XY01 | |



美特鋁質 有限公司
MIDI Aluminium Fabricator Ltd.

工程號



J-837

地盤

觀塘裕民坊

工廠用

大梗窗位用

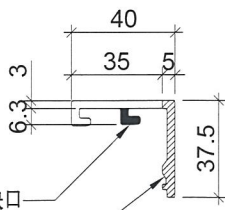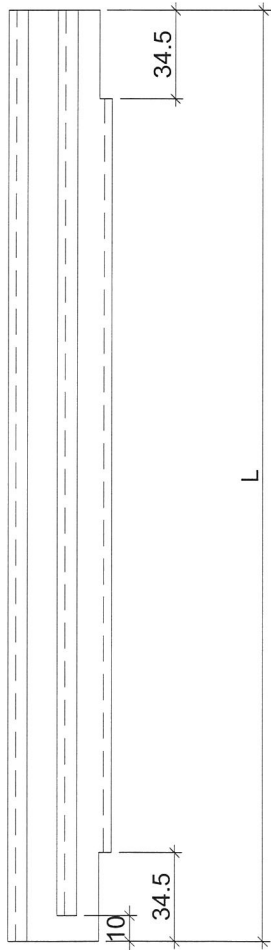

塗黑部分避位去水缺口

塗黑部分避位

| 物料編號 | L | 層數 | 每層 | 總數量 | 分格尺寸 | 使用位置 | 樓層 |
|----------|------|----|----|------|----------|-----------------|-----------------|
| ZS-XY01R | 879 | 33 | 2 | 66 | 900 | T3CW-F-1 | 10F~25F,29F~50F |
| | 879 | 33 | 1 | 33 | 900 | T3CW-E-1 | 10F~25F,29F~50F |
| | 879 | 33 | 1 | 33 | 900 | T3CW-L-2 | 10F~25F,29F~50F |
| | 879 | 33 | 1 | 33 | 900 | T3CW-H-3 | 10F~25F,29F~50F |
| | 879 | 33 | 2 | 66 | 900 | T3CW-B-2 | 10F~25F,29F~50F |
| | 879 | 33 | 1 | 33 | 900 | T3CW-A-2 | 10F~25F,29F~50F |
| | 879 | 33 | 1 | 33 | 900 | T3CW-A-1 | 10F~25F,29F~50F |
| | 879 | 13 | 1 | 13 | 900 | T3CW-F-1 | 10F~25F |
| | 879 | 19 | 1 | 19 | 900 | T3CW-E-1 | 10F~25F,29F~35F |
| | 879 | 14 | 1 | 14 | 900 | T3CW-M-1 | 10F~25F,29F |
| ZS-XY02R | 2229 | 33 | 2 | 66 | 2250 | T3CW-F-1 | 10F~25F,29F~50F |
| | 2229 | 33 | 2 | 66 | 2250 | T3CW-E-1 | 10F~25F,29F~50F |
| | 2229 | 33 | 1 | 33 | 2250 | T3CW-M-1 | 10F~25F,29F~50F |
| | 2229 | 33 | 1 | 33 | 2250 | T3CW-L-2 | 10F~25F,29F~50F |
| | 2229 | 33 | 1 | 33 | 2250 | T3CW-K-1 | 10F~25F,29F~50F |
| | 2229 | 33 | 1 | 33 | 2250 | T3CW-J-1 | 10F~25F,29F~50F |
| | 2229 | 33 | 1 | 33 | 2250 | T3CW-H-3 | 10F~25F,29F~50F |
| | 2229 | 33 | 1 | 33 | 2250 | T3CW-H-1 | 10F~25F,29F~50F |
| | 2229 | 33 | 1 | 33 | 2250 | T3CW-C-2 | 10F~25F,29F~50F |
| | 2229 | 33 | 2 | 66 | 2250 | T3CW-B-2 | 10F~25F,29F~50F |
| | 2229 | 33 | 1 | 33 | 2250 | T3CW-B-1 | 10F~25F,29F~50F |
| | 2229 | 33 | 1 | 33 | 2250 | T3CW-A-2 | 10F~25F,29F~50F |
| | 2229 | 33 | 2 | 66 | 2250 | T3CW-A-1 | 10F~25F,29F~50F |
| | 2229 | 33 | 2 | 66 | 2250 | T3CW-F-2 | 10F~25F,29F~50F |
| | 2229 | 13 | 1 | 13 | 2250 | T3CW-F-1 | 10F~25F |
| | 2229 | 20 | 1 | 20 | 2250 | T3CW-E-1 | 10F~25F,29F~36F |
| 2229 | 15 | 1 | 15 | 2250 | T3CW-M-1 | 10F~25F,29F~30F | |

| | | | | | | | |
|----|--------------------|----|-----|------------|----|------------|--|
| 名稱 | 玻璃扣蓋 | 制圖 | 陳俊賢 | 2018.10.21 | 修改 | A | |
| 材料 | X85558 | 復核 | 謝永林 | 2019.02.18 | 日期 | 2019.02.18 | |
| 顏色 | EC-DG-S332054 (3塗) | 批準 | | | 圖號 | ZS-XY01R | |






美特鋁質 有限公司
MIDI Aluminium Fabricator Ltd.

依據10067 C版修改
單插線, 開 ϕ 5去水孔

工程號 J-837 地盤 觀塘裕民坊

| 物料編號 | L | 層數 | 每層 | 總數量 | 分格尺寸 | 使用位置 | 樓層 |
|--------|-----|----|----|-----|------|----------|------------------|
| UN-HM1 | 601 | 33 | 1 | 33 | 650 | T3CW-E-1 | 10F~25F, 29F~50F |
| | 601 | 33 | 1 | 33 | 650 | T3CW-M-2 | 10F~25F, 29F~50F |
| | 601 | 33 | 1 | 33 | 650 | T3CW-L-2 | 10F~25F, 29F~50F |
| | 601 | 33 | 1 | 33 | 650 | T3CW-L-1 | 10F~25F, 29F~50F |
| | 601 | 33 | 1 | 33 | 650 | T3CW-K-2 | 10F~25F, 29F~50F |
| | 601 | 33 | 1 | 33 | 650 | T3CW-C-1 | 10F~25F, 29F~50F |
| | 601 | 33 | 2 | 66 | 650 | T3CW-B-2 | 10F~25F, 29F~50F |
| UN-HM2 | 401 | 33 | 1 | 33 | 450 | T3CW-M-1 | 10F~25F, 29F~50F |
| | 401 | 33 | 1 | 33 | 450 | T3CW-J-2 | 10F~25F, 29F~50F |
| | 401 | 33 | 1 | 33 | 450 | T3CW-B-1 | 10F~25F, 29F~50F |
| | 401 | 33 | 1 | 33 | 450 | T3CW-A-2 | 10F~25F, 29F~50F |

生窗死牆位頂用

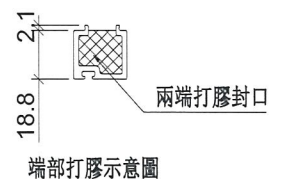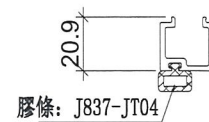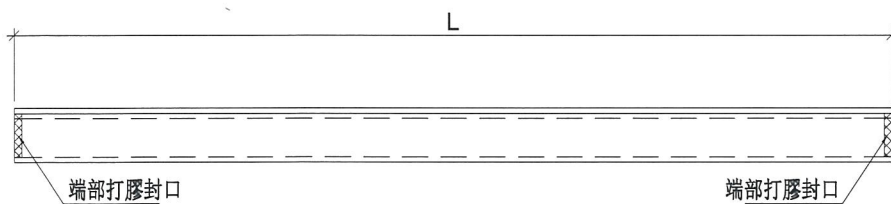

端部打膠示意圖

| | | | | | | | | |
|----|--------------------|----|-----|------------|----|------------|--|--|
| 名稱 | 單玻插線 | 制圖 | 陳俊賢 | 2018.10.21 | 修改 | A | | |
| 材料 | X85560 | 復核 | 謝永林 | 2019.02.18 | 日期 | 2019.02.18 | | |
| 顏色 | EC-DG-S332054 (3塗) | 批準 | | | 圖號 | UN-HM1 | | |






美特鋁質 有限公司
MIDI Aluminium Fabricator Ltd.

依據10067 C版修改
單插線, 開 $\phi 5$ 去水孔

工程號 J-837 地盤 觀塘裕民坊

| 物料編號 | L | 層數 | 每層 | 總數量 | 分格尺寸 | 使用位置 | 樓層 |
|----------|--------|----|----|-----|--------|----------|-----------------|
| UN-HM301 | 1017.5 | 13 | 1 | 13 | 1107.5 | T3CW-F-1 | 10F~25F |
| UN-HM302 | 1435 | 33 | 1 | 33 | 1525 | T3CW-F-1 | 10F~25F,29F~50F |
| UN-HM303 | 1435 | 33 | 1 | 33 | 1525 | T3CW-F-1 | 10F~25F,29F~50F |
| UN-HM304 | 1435 | 33 | 1 | 33 | 1525 | T3CW-E-1 | 10F~25F,29F~50F |
| UN-HM306 | 895 | 19 | 1 | 19 | 985 | T3CW-E-1 | 10F~25F,29F~35F |
| UN-HM308 | 677.5 | 14 | 1 | 14 | 767.5 | T3CW-M-1 | 10F~25F,29F |
| UN-HM316 | 1435 | 33 | 1 | 33 | 1525 | T3CW-B-2 | 10F~25F,29F~50F |

梗窗死牆位底用

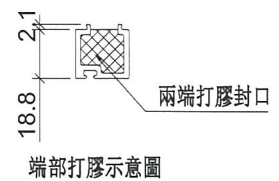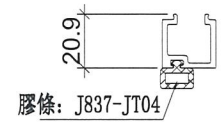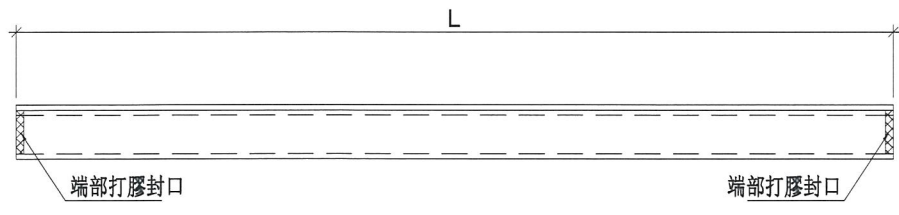

| | | | | | | | | |
|----|--------------------|----|-----|------------|----|------------|--|--|
| 名稱 | 單玻插線 | 制圖 | 陳俊賢 | 2018.10.21 | 修改 | A | | |
| 材料 | X85560 | 復核 | 謝永林 | 2019.02.18 | 日期 | 2019.02.18 | | |
| 顏色 | EC-DG-S332054 (3塗) | 批準 | | | 圖號 | UN-HM301 | | |






美特鋁質 有限公司
MIDI Aluminium Fabricator Ltd.

依據10067 C版修改
單插線, 開 ϕ 5去水孔

工程號 J-837 地盤 觀塘裕民坊

| 物料編號 | L | 層數 | 每層 | 總數量 | 分格尺寸 | 使用位置 | 樓層 |
|-----------|--------|----|----|-----|--------|----------|-----------------|
| UN-HM301S | 1318.5 | 33 | 1 | 33 | 1367.5 | T3CW-F-1 | 10F~25F,29F~50F |
| UN-HM302S | 1118.5 | 33 | 1 | 33 | 1167.5 | T3CW-E-1 | 10F~25F,29F~50F |
| UN-HM303S | 786 | 33 | 1 | 33 | 835 | T3CW-M-2 | 10F~25F,29F~50F |
| UN-HM304S | 718.5 | 33 | 1 | 33 | 767.5 | T3CW-L-2 | 10F~25F,29F~50F |
| UN-HM305S | 936 | 33 | 1 | 33 | 985 | T3CW-L-1 | 10F~25F,29F~50F |
| UN-HM306S | 886 | 33 | 1 | 33 | 935 | T3CW-K-2 | 10F~25F,29F~50F |
| UN-HM307S | 718.5 | 33 | 1 | 33 | 767.5 | T3CW-K-1 | 10F~25F,29F~50F |
| UN-HM308S | 811 | 33 | 1 | 33 | 860 | T3CW-J-2 | 10F~25F,29F~50F |
| UN-HM309S | 718.5 | 33 | 1 | 33 | 767.5 | T3CW-J-1 | 10F~25F,29F~50F |
| UN-HM310S | 1333.5 | 33 | 1 | 33 | 1480 | T3CW-H-2 | 10F~25F,29F~50F |
| UN-HM311S | 768.5 | 33 | 1 | 33 | 817.5 | T3CW-H-1 | 10F~25F,29F~50F |
| UN-HM312S | 718.5 | 33 | 1 | 33 | 767.5 | T3CW-C-2 | 10F~25F,29F~50F |
| UN-HM313S | 886 | 33 | 1 | 33 | 935 | T3CW-C-1 | 10F~25F,29F~50F |
| UN-HM314S | 1336 | 33 | 1 | 33 | 1385 | T3CW-B-2 | 10F~25F,29F~50F |
| UN-HM315S | 858.5 | 33 | 1 | 33 | 907.5 | T3CW-B-2 | 10F~25F,29F~50F |
| UN-HM316S | 858.5 | 33 | 1 | 33 | 907.5 | T3CW-A-1 | 10F~25F,29F~50F |
| UN-HM317S | 1236 | 33 | 1 | 33 | 1285 | T3CW-A-1 | 10F~25F,29F~50F |
| UN-HM318S | 767 | 33 | 1 | 33 | 816 | T3CW-D-1 | 10F~25F,29F~50F |
| UN-HM319S | 718.5 | 33 | 1 | 33 | 767.5 | T3CW-D-1 | 10F~25F,29F~50F |
| UN-HM320S | 718.5 | 33 | 1 | 33 | 767.5 | T3CW-G-1 | 10F~25F,29F~50F |
| UN-HM321S | 768.5 | 33 | 1 | 33 | 817.5 | T3CW-G-1 | 10F~25F,29F~50F |
| UN-HM322S | 1058.5 | 20 | 1 | 20 | 1107.5 | T3CW-F-1 | 29F~50F |
| UN-HM323S | 936 | 14 | 1 | 14 | 985 | T3CW-E-1 | 36F~50F |
| UN-HM324S | 718.5 | 19 | 1 | 19 | 767.5 | T3CW-M-1 | 30F~50F |

SD頂死牆位頂用

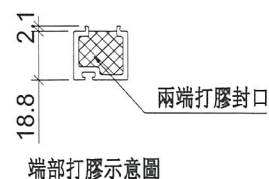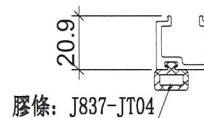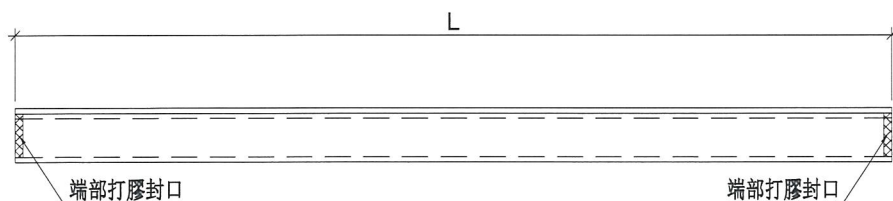

| | | | | | | | | |
|----|--------------------|----|-----|------------|----|------------|--|--|
| 名稱 | 單玻插線 | 制圖 | 陳俊賢 | 2018.10.21 | 修改 | A | | |
| 材料 | X85560 | 復核 | 謝永林 | 2019.02.18 | 日期 | 2019.02.18 | | |
| 顏色 | EC-DG-S332054 (3塗) | 批準 | | | 圖號 | UN-HM301S | | |




美特鋁質 有限公司
MIDI Aluminium Fabricator Ltd.

依據10067 C版修改
單插線, 開 $\phi 5$ 去水孔

工程號 J-837 地盤 觀塘裕民坊

| 物料編號 | L | 層數 | 每層 | 總數量 | 分格尺寸 | 使用位置 | 樓層 |
|---------|-----|----|----|-----|------|----------|------------------|
| UN-EH1a | 625 | 33 | 1 | 33 | 650 | T3CW-F-1 | 10F~25F, 29F~50F |
| | 625 | 33 | 1 | 33 | 650 | T3CW-E-1 | 10F~25F, 29F~50F |
| | 625 | 33 | 1 | 33 | 650 | T3CW-K-1 | 10F~25F, 29F~50F |
| | 625 | 33 | 1 | 33 | 650 | T3CW-J-1 | 10F~25F, 29F~50F |
| | 625 | 33 | 1 | 33 | 650 | T3CW-H-3 | 10F~25F, 29F~50F |
| | 625 | 33 | 2 | 66 | 650 | T3CW-H-1 | 10F~25F, 29F~50F |
| | 625 | 33 | 2 | 66 | 650 | T3CW-B-2 | 10F~25F, 29F~50F |
| | 625 | 33 | 1 | 33 | 650 | T3CW-A-1 | 10F~25F, 29F~50F |
| UN-EH2a | 425 | 33 | 1 | 33 | 450 | T3CW-F-1 | 10F~25F, 29F~50F |
| | 425 | 33 | 1 | 33 | 450 | T3CW-K-1 | 10F~25F, 29F~50F |
| | 425 | 33 | 1 | 33 | 450 | T3CW-J-1 | 10F~25F, 29F~50F |
| | 425 | 33 | 1 | 33 | 450 | T3CW-A-2 | 10F~25F, 29F~50F |
| | 425 | 33 | 1 | 33 | 450 | T3CW-D-1 | 10F~25F, 29F~50F |
| | 425 | 33 | 1 | 33 | 450 | T3CW-G-1 | 10F~25F, 29F~50F |
| | 425 | 33 | 1 | 33 | 450 | T3CW-F-2 | 10F~25F, 29F~50F |

SHL生窗死牆位二合一底用

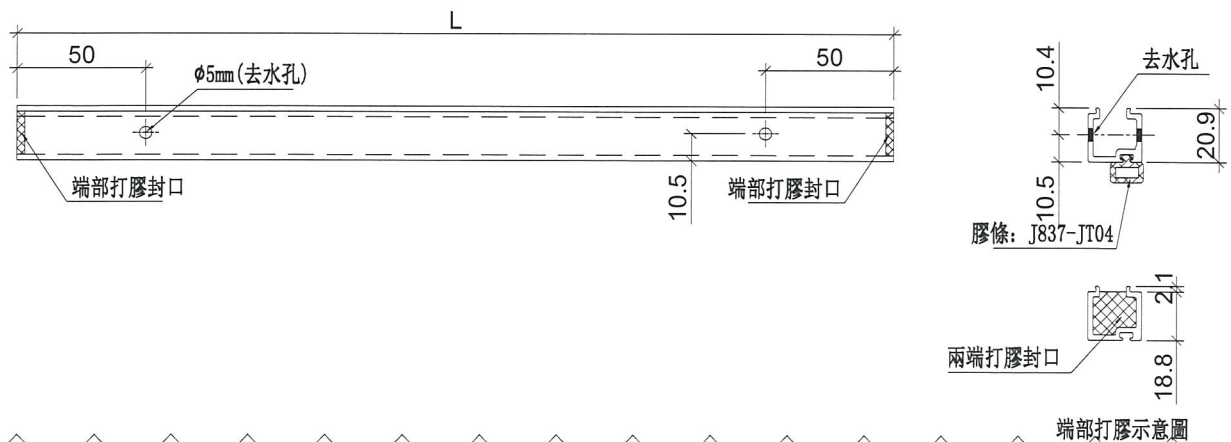

| | | | | | | | |
|----|--------------------|----|-----|------------|----|------------|--|
| 名稱 | 單玻插線 | 制圖 | 陳俊賢 | 2019.01.18 | 修改 | A | |
| 材料 | X85560 | 復核 | 謝永林 | 2019.01.21 | 日期 | 2019.02.18 | |
| 顏色 | EC-DG-S332054 (3塗) | 批准 | | | 圖號 | UN-EH1a | |






美特鋁質 有限公司
MIDI Aluminium Fabricator Ltd.

依據10067 C版修改
單插線, 開 $\phi 5$ 去水孔

工程號 J-837 地盤 觀塘裕民坊

| 物料編號 | L | 層數 | 每層 | 總數量 | 分格尺寸 | 使用位置 | 樓層 |
|-----------|-----|----|----|-----|------|----------|------------------|
| UN-EH1aR | 625 | 33 | 1 | 33 | 650 | T3CW-F-1 | 10F~25F, 29F~50F |
| | 625 | 33 | 1 | 33 | 650 | T3CW-E-1 | 10F~25F, 29F~50F |
| | 625 | 33 | 1 | 33 | 650 | T3CW-M-1 | 10F~25F, 29F~50F |
| | 625 | 33 | 1 | 33 | 650 | T3CW-C-2 | 10F~25F, 29F~50F |
| | 625 | 33 | 1 | 33 | 650 | T3CW-B-2 | 10F~25F, 29F~50F |
| | 625 | 33 | 1 | 33 | 650 | T3CW-A-1 | 10F~25F, 29F~50F |
| UN-EH2aR | 425 | 33 | 1 | 33 | 450 | T3CW-F-1 | 10F~25F, 29F~50F |
| | 425 | 33 | 1 | 33 | 450 | T3CW-E-1 | 10F~25F, 29F~50F |
| | 425 | 33 | 1 | 33 | 450 | T3CW-L-2 | 10F~25F, 29F~50F |
| | 425 | 33 | 1 | 33 | 450 | T3CW-C-2 | 10F~25F, 29F~50F |
| | 425 | 33 | 1 | 33 | 450 | T3CW-B-1 | 10F~25F, 29F~50F |
| | 425 | 33 | 1 | 33 | 450 | T3CW-D-1 | 10F~25F, 29F~50F |
| | 425 | 33 | 1 | 33 | 450 | T3CW-G-1 | 10F~25F, 29F~50F |
| | 425 | 33 | 1 | 33 | 450 | T3CW-F-2 | 10F~25F, 29F~50F |
| UN-EH16aR | 525 | 33 | 1 | 33 | 550 | T3CW-F-2 | 10F~25F, 29F~50F |

SHR生窗死牆位二合一底用

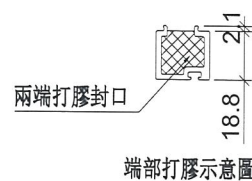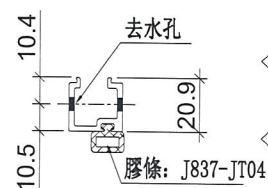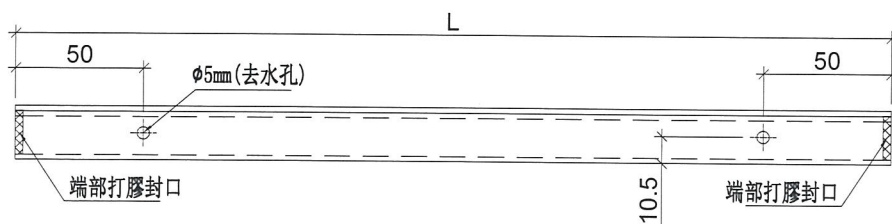

| | | | | | | | |
|----|--------------------|----|-----|------------|----|------------|--|
| 名稱 | 單玻插線 | 制圖 | 陳俊賢 | 2019.01.18 | 修改 | A | |
| 材料 | X85560 | 復核 | 謝永林 | 2019.01.21 | 日期 | 2019.02.18 | |
| 顏色 | EC-DG-S332054 (3塗) | 批准 | | | 圖號 | UN-EH1aR | |







美特鋁質 有限公司
MIDI Aluminium Fabricator Ltd.

依據10067 C版修改
單插線, 開 $\phi 5$ 去水孔

工程號 J-837 地盤 觀塘裕民坊

| 物料編號 | L | 層數 | 每層 | 總數量 | 分格尺寸 | 使用位置 | 樓層 |
|-----------|--------|----|----|-----|--------|----------|------------------|
| UN-EH309a | 1072 | 33 | 1 | 33 | 1117.5 | T3CW-L-2 | 10F~25F, 29F~50F |
| UN-EH312a | 1994.5 | 33 | 1 | 33 | 2040 | T3CW-H-3 | 10F~25F, 29F~50F |
| UN-EH315a | 1097 | 33 | 1 | 33 | 1142.5 | T3CW-B-2 | 10F~25F, 29F~50F |
| UN-EH318a | 1514.5 | 33 | 1 | 33 | 1560 | T3CW-A-2 | 10F~25F, 29F~50F |
| UN-EH319a | 1479.5 | 33 | 1 | 33 | 1525 | T3CW-A-1 | 10F~25F, 29F~50F |

梗窗死牆位二合一底用

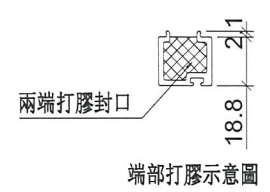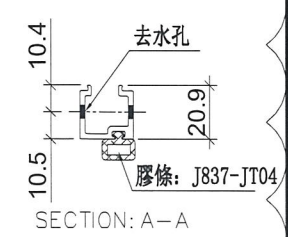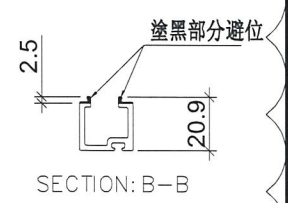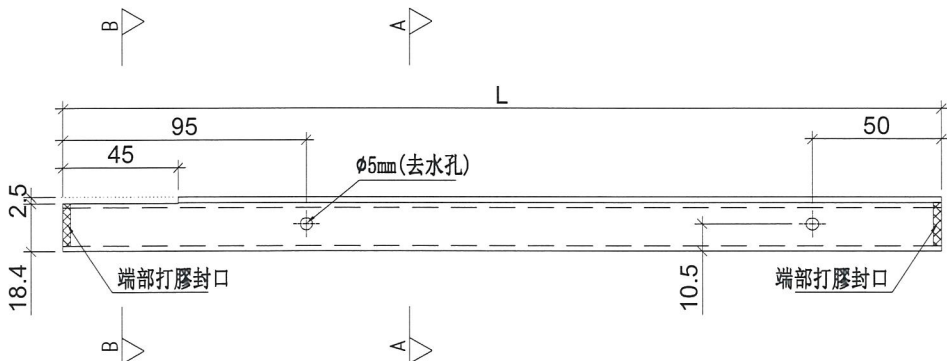


| | | | | | | | |
|----|--------------------|----|-----|------------|----|------------|--|
| 名稱 | 單玻插線 | 制圖 | 陳俊賢 | 2019.01.18 | 修改 | A | |
| 材料 | X85560 | 復核 | 謝永林 | 2019.01.21 | 日期 | 2019.02.18 | |
| 顏色 | EC-DG-S332054 (3塗) | 批准 | | | 圖號 | UN-EH301a | |

工程號 J-837 地盤 觀塘裕民坊

| 物料編號 | L | 層數 | 每層 | 總數量 | 分格尺寸 | 使用位置 | 樓層 |
|------------|--------|----|----|-----|--------|----------|------------------|
| UN-EH305aR | 1097 | 33 | 1 | 33 | 1142.5 | T3CW-E-1 | 10F~25F, 29F~50F |
| UN-EH307aR | 1072 | 33 | 1 | 33 | 1117.5 | T3CW-M-1 | 10F~25F, 29F~50F |
| UN-EH317aR | 1514.5 | 33 | 1 | 33 | 1560 | T3CW-B-1 | 10F~25F, 29F~50F |
| UN-EH320aR | 1097 | 33 | 1 | 33 | 1142.5 | T3CW-A-1 | 10F~25F, 29F~50F |
| UN-EH321aR | 1189.5 | 33 | 1 | 33 | 1235 | T3CW-F-2 | 10F~25F, 29F~50F |

梗窗死牆位二合一底用

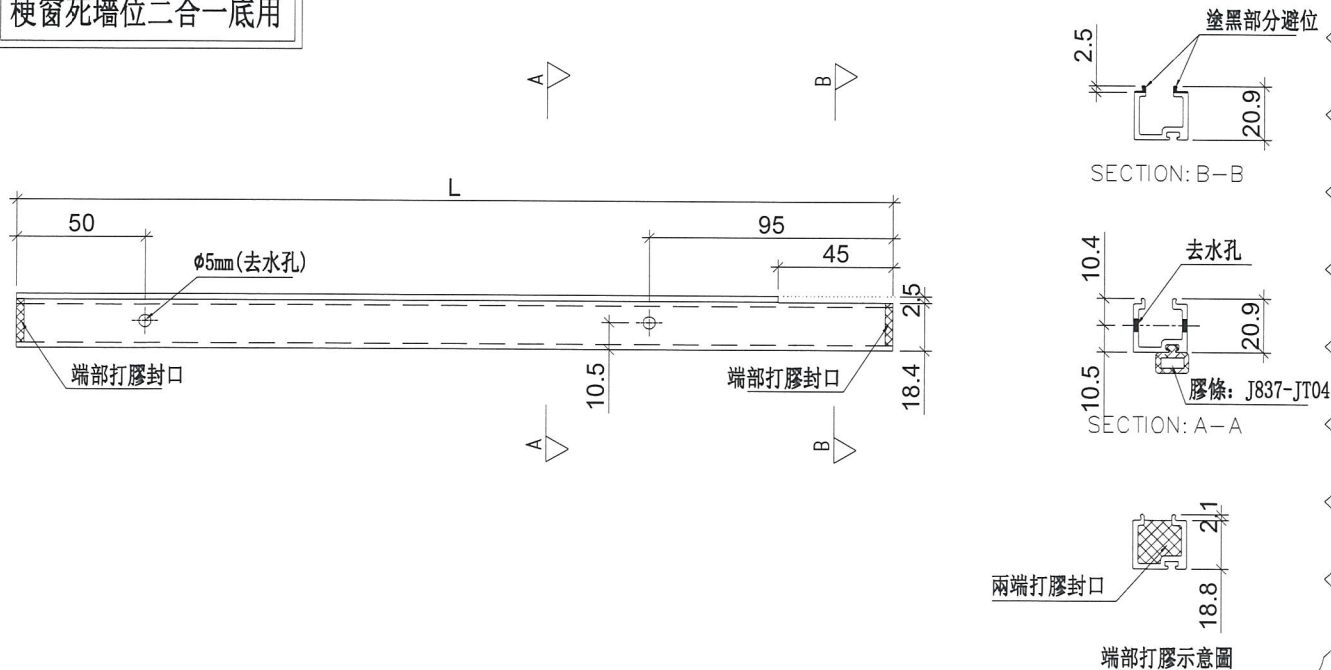

| | | | | | | | |
|----|--------------------|----|-----|------------|----|------------|--|
| 名稱 | 單玻插線 | 制圖 | 陳俊賢 | 2019.01.18 | 修改 | A | |
| 材料 | X85560 | 復核 | 謝永林 | 2019.01.21 | 日期 | 2019.02.18 | |
| 顏色 | EC-DG-S332054 (3塗) | 批准 | | | 圖號 | UN-EH302aR | |







美特鋁質 有限公司
MIDI Aluminium Fabricator Ltd.

依據10067 C版修改
單插線, 開 $\phi 5$ 去水孔

工程號 J-837 地盤 觀塘裕民坊

| 物料編號 | L | 層數 | 每層 | 總數量 | 分格尺寸 | 使用位置 | 樓層 |
|------------|--------|----|----|-----|--------|----------|------------------|
| UN-EH310aW | 1116.5 | 33 | 1 | 33 | 1117.5 | T3CW-K-1 | 10F~25F, 29F~50F |
| UN-EH311aW | 1041.5 | 33 | 1 | 33 | 1042.5 | T3CW-J-1 | 10F~25F, 29F~50F |
| UN-EH313aW | 1041.5 | 33 | 1 | 33 | 1042.5 | T3CW-H-1 | 10F~25F, 29F~50F |
| UN-EH314aW | 1116.5 | 33 | 1 | 33 | 1117.5 | T3CW-C-2 | 10F~25F, 29F~50F |
| UN-EH322aW | 1309 | 33 | 1 | 33 | 1310 | T3CW-F-2 | 10F~25F, 29F~50F |

梗窗死牆位二合一底用

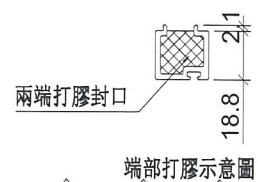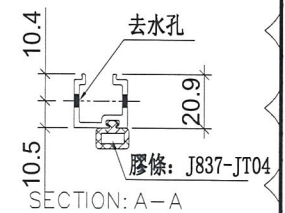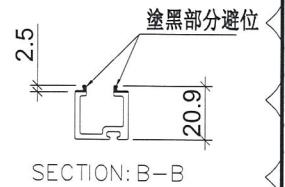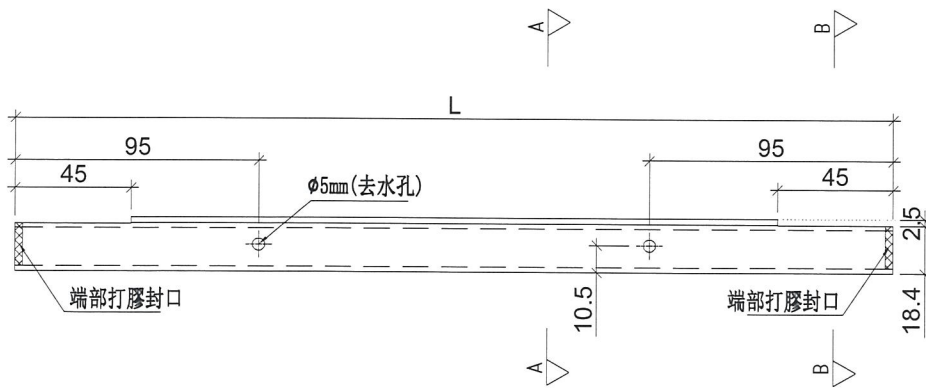

| | | | | | | | |
|----|--------------------|----|-----|------------|----|------------|--|
| 名稱 | 單玻插線 | 制圖 | 陳俊賢 | 2019.01.18 | 修改 | A | |
| 材料 | X85560 | 復核 | 謝永林 | 2019.01.21 | 日期 | 2019.02.18 | |
| 顏色 | EC-DG-S332054 (3塗) | 批准 | | | 圖號 | UN-EH310aW | |



美特鋁質 有限公司
MIDI Aluminium Fabricator Ltd.





數據表參見：UN-DM1d-1

工程號 J-837 地盤 觀塘裕民坊

工廠用

SD頂死牆位用

頂

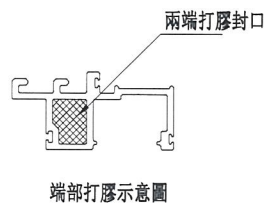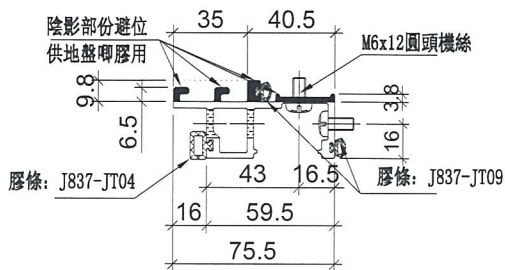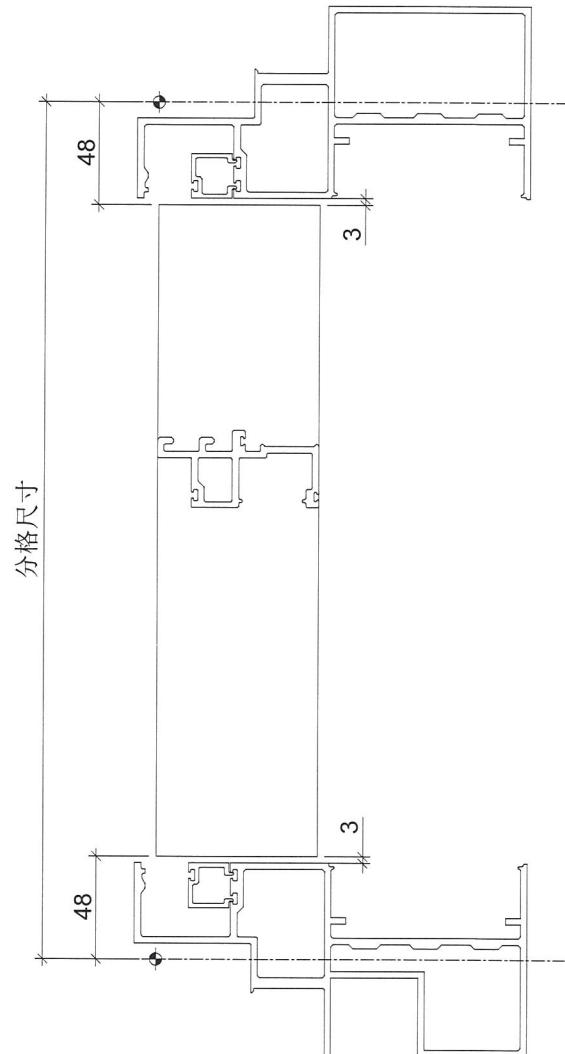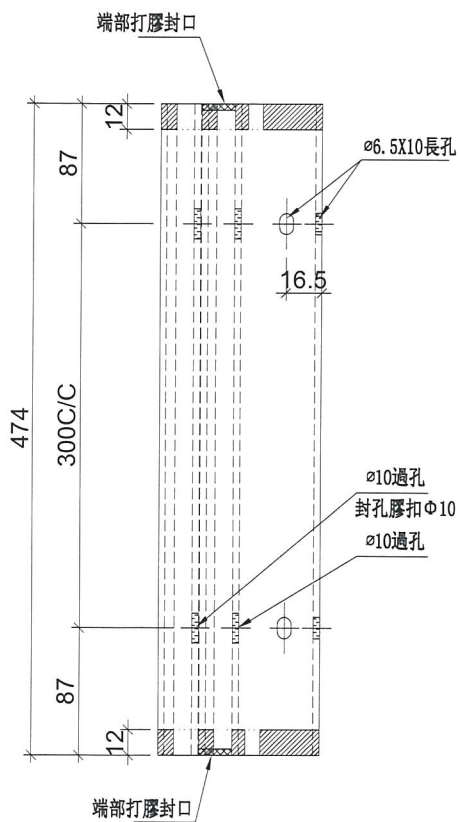

| | | | | | | | | |
|----|--------------------|----|-----|------------|----|---------|--|--|
| 名稱 | 生梗企單玻 | 制圖 | 陳俊賢 | 2018.12.21 | 修改 | | | |
| 材料 | X85561 | 復核 | 謝永林 | 2019.01.10 | 日期 | | | |
| 顏色 | EC-DG-S332054 (3塗) | 批准 | | | 圖號 | UN-DM1d | | |



美特鋁質 有限公司
MIDI Aluminium Fabricator Ltd.

拆圖參見：UN-DM1d

工程號 J-837 地盤 觀塘裕民坊

| 物料編號 | 層數 | 每層 | 數量 | 分格尺寸 | 使用位置 | 樓層 |
|---------|----|----|-----|----------|----------|-----------------|
| UN-DM1d | 33 | 1 | 33 | 570 | T3CW-F-1 | 10F-25F,29F~50F |
| | 33 | 1 | 33 | 570 | T3CW-E-1 | 10F-25F,29F~50F |
| | 33 | 1 | 33 | 570 | T3CW-M-2 | 10F-25F,29F~50F |
| | 33 | 1 | 33 | 570 | T3CW-L-2 | 10F-25F,29F~50F |
| | 33 | 1 | 33 | 570 | T3CW-L-1 | 10F-25F,29F~50F |
| | 33 | 1 | 33 | 570 | T3CW-K-2 | 10F-25F,29F~50F |
| | 33 | 1 | 33 | 570 | T3CW-K-1 | 10F-25F,29F~50F |
| | 33 | 1 | 33 | 570 | T3CW-J-2 | 10F-25F,29F~50F |
| | 33 | 1 | 33 | 570 | T3CW-J-1 | 10F-25F,29F~50F |
| | 33 | 1 | 33 | 570 | T3CW-H-2 | 10F-25F,29F~50F |
| | 33 | 1 | 33 | 570 | T3CW-H-1 | 10F-25F,29F~50F |
| | 33 | 1 | 33 | 570 | T3CW-C-2 | 10F-25F,29F~50F |
| | 33 | 1 | 33 | 570 | T3CW-C-1 | 10F-25F,29F~50F |
| | 33 | 2 | 66 | 570 | T3CW-B-2 | 10F-25F,29F~50F |
| | 33 | 2 | 66 | 570 | T3CW-A-1 | 10F-25F,29F~50F |
| | 33 | 2 | 66 | 570 | T3CW-D-1 | 10F-25F,29F~50F |
| | 33 | 2 | 66 | 570 | T3CW-G-1 | 10F-25F,29F~50F |
| | 20 | 1 | 20 | 570 | T3CW-F-1 | 29F~50F |
| | 14 | 1 | 14 | 570 | T3CW-E-1 | 36F~50F |
| 19 | 1 | 19 | 570 | T3CW-M-1 | 30F~50F | |
| 合計： | | | 746 | | | |

| | | | | | | | | |
|----|--------------------|----|-----|------------|----|------------|--|--|
| 名稱 | 生梗企單玻 | 制圖 | 陳俊賢 | 2018.12.21 | 修改 | A | | |
| 材料 | X85561 | 復核 | 謝永林 | 2019.01.10 | 日期 | 2019.02.18 | | |
| 顏色 | EC-DG-S332054 (3塗) | 批准 | | | 圖號 | UN-DM1d-1 | | |



美特鋁質 有限公司
MIDI Aluminium Fabricator Ltd.

工程號

J-837



地盤

觀塘裕民坊



數據表參見：UN-DM1dR-1

工廠用

SD頂死牆位用

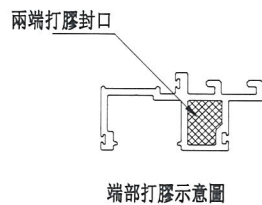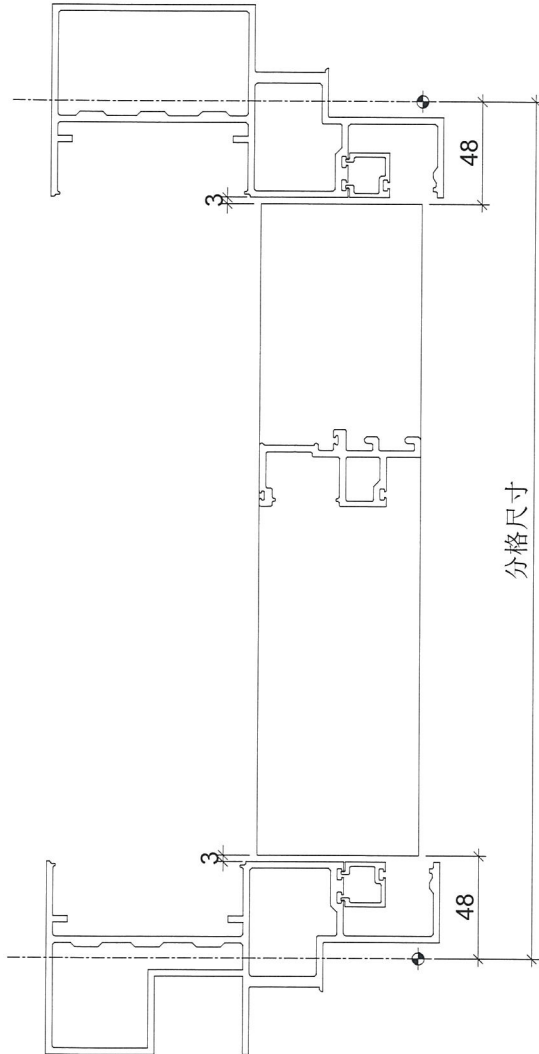

頂

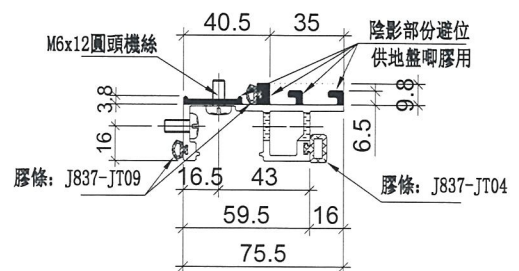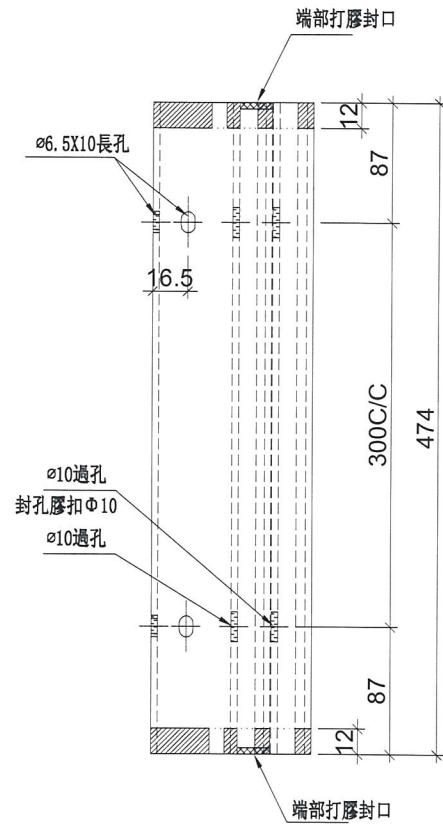

| | | | | | | | |
|----|--------------------|----|-----|------------|----|----------|--|
| 名稱 | 生梗企單玻 | 制圖 | 陳俊賢 | 2018.12.21 | 修改 | | |
| 材料 | X85561 | 復核 | 謝永林 | 2019.01.10 | 日期 | | |
| 顏色 | EC-DG-S332054 (3塗) | 批准 | | | 圖號 | UN-DM1dR | |



美特鋁質 有限公司
MIDI Aluminium Fabricator Ltd.

拆圖參見：UN-DM1dR

工程號 J-837 地盤 觀塘裕民坊

| 物料編號 | 層數 | 每層 | 數量 | 分格尺寸 | 使用位置 | 樓層 |
|----------|----|----|-----|----------|----------|-----------------|
| UN-DM1dR | 33 | 1 | 33 | 570 | T3CW-F-1 | 10F-25F,29F~50F |
| | 33 | 1 | 33 | 570 | T3CW-E-1 | 10F-25F,29F~50F |
| | 33 | 1 | 33 | 570 | T3CW-M-2 | 10F-25F,29F~50F |
| | 33 | 1 | 33 | 570 | T3CW-L-2 | 10F-25F,29F~50F |
| | 33 | 1 | 33 | 570 | T3CW-L-1 | 10F-25F,29F~50F |
| | 33 | 1 | 33 | 570 | T3CW-K-2 | 10F-25F,29F~50F |
| | 33 | 1 | 33 | 570 | T3CW-K-1 | 10F-25F,29F~50F |
| | 33 | 1 | 33 | 570 | T3CW-J-2 | 10F-25F,29F~50F |
| | 33 | 1 | 33 | 570 | T3CW-J-1 | 10F-25F,29F~50F |
| | 33 | 1 | 33 | 570 | T3CW-H-2 | 10F-25F,29F~50F |
| | 33 | 1 | 33 | 570 | T3CW-H-1 | 10F-25F,29F~50F |
| | 33 | 1 | 33 | 570 | T3CW-C-2 | 10F-25F,29F~50F |
| | 33 | 1 | 33 | 570 | T3CW-C-1 | 10F-25F,29F~50F |
| | 33 | 2 | 66 | 570 | T3CW-B-2 | 10F-25F,29F~50F |
| | 33 | 2 | 66 | 570 | T3CW-A-1 | 10F-25F,29F~50F |
| | 33 | 2 | 66 | 570 | T3CW-D-1 | 10F-25F,29F~50F |
| | 33 | 2 | 66 | 570 | T3CW-G-1 | 10F-25F,29F~50F |
| | 20 | 1 | 20 | 570 | T3CW-F-1 | 29F-50F |
| | 14 | 1 | 14 | 570 | T3CW-E-1 | 36F-50F |
| 19 | 1 | 19 | 570 | T3CW-M-1 | 30F-50F | |
| 合計： | | | 746 | | | |

| | | | | | | | | |
|----|--------------------|----|-----|------------|----|------------|--|--|
| 名稱 | 生梗企單玻 | 制圖 | 陳俊賢 | 2018.12.21 | 修改 | A | | |
| 材料 | X85561 | 復核 | 謝永林 | 2019.01.10 | 日期 | 2019.02.18 | | |
| 顏色 | EC-DG-S332054 (3塗) | 批准 | | | 圖號 | UN-DM1dR-1 | | |



美特鋁質 有限公司
MIDI Aluminium Fabricator Ltd.

數據表參見：ZS-S01d-1


工程號

J-837


地盤

觀塘裕民坊


地盤用

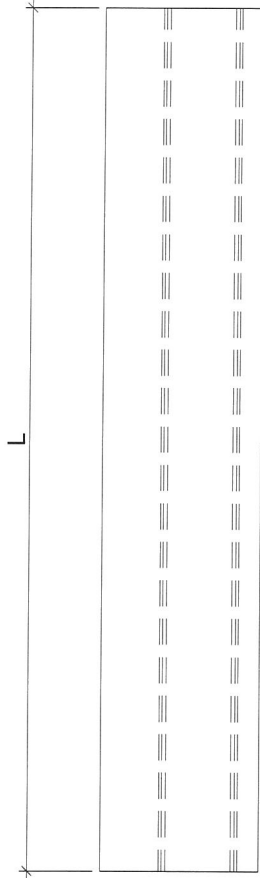

分格尺寸

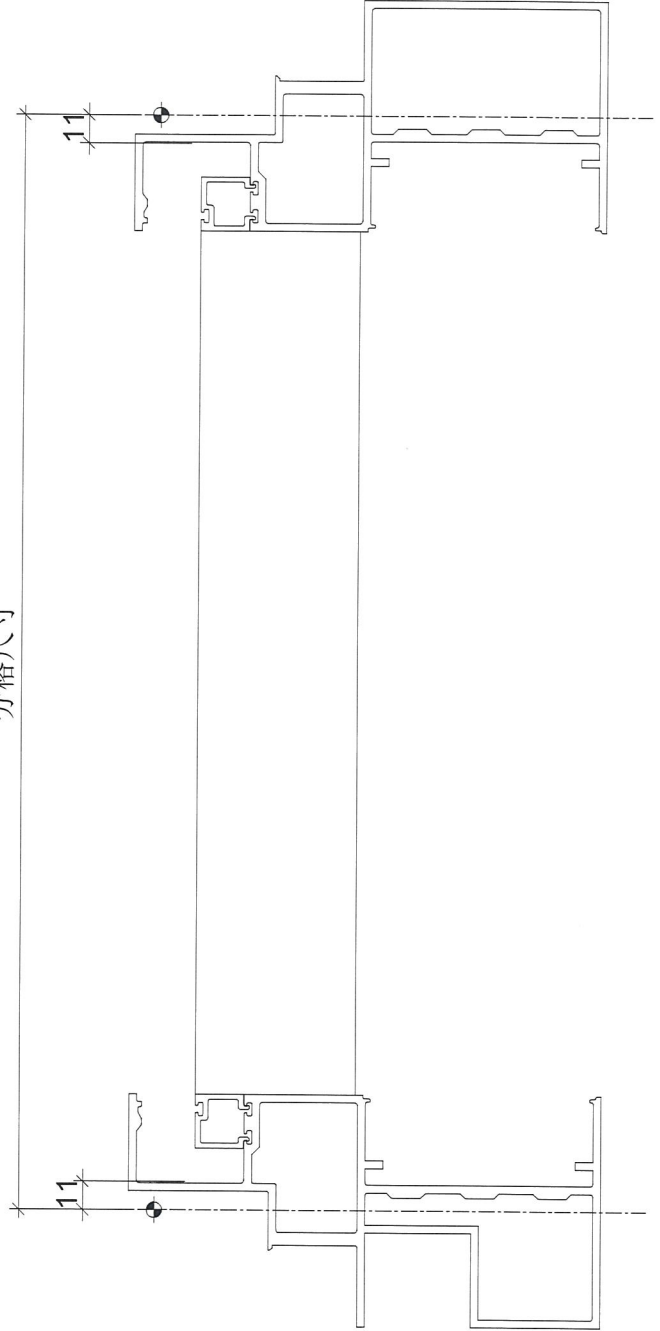

陰影部分避位

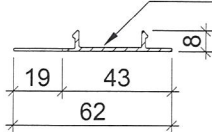

| | | | | | | | |
|----|--------------------|----|-----|------------|----|---------|--|
| 名稱 | 生梗企單玻扣蓋 | 制圖 | 陳俊賢 | 2019.01.18 | 修改 | | |
| 材料 | X85563 | 復核 | 謝永林 | 2019.01.21 | 日期 | | |
| 顏色 | EC-DG-S332054 (3塗) | 批准 | | | 圖號 | ZS-S01d | |



美特鋁質 有限公司
MIDI Aluminium Fabricator Ltd.

拆圖參見: ZS-S01d

工程號 J-837 地盤 觀塘裕民坊

| 物料編號 | L | 層數 | 每層 | 總數量 | 分格尺寸 | 使用位置 | 樓層 |
|---------|-----|----|-----|-----|----------|----------|-----------------|
| ZS-S01d | 480 | 33 | 1 | 33 | 570 | T3CW-F-1 | 10F~25F,29F~50F |
| | 480 | 33 | 1 | 33 | 570 | T3CW-E-1 | 10F~25F,29F~50F |
| | 480 | 33 | 1 | 33 | 570 | T3CW-M-2 | 10F~25F,29F~50F |
| | 480 | 33 | 1 | 33 | 570 | T3CW-L-2 | 10F~25F,29F~50F |
| | 480 | 33 | 1 | 33 | 570 | T3CW-L-1 | 10F~25F,29F~50F |
| | 480 | 33 | 1 | 33 | 570 | T3CW-K-2 | 10F~25F,29F~50F |
| | 480 | 33 | 1 | 33 | 570 | T3CW-K-1 | 10F~25F,29F~50F |
| | 480 | 33 | 1 | 33 | 570 | T3CW-J-2 | 10F~25F,29F~50F |
| | 480 | 33 | 1 | 33 | 570 | T3CW-J-1 | 10F~25F,29F~50F |
| | 480 | 33 | 1 | 33 | 570 | T3CW-H-3 | 10F~25F,29F~50F |
| | 480 | 33 | 1 | 33 | 570 | T3CW-H-1 | 10F~25F,29F~50F |
| | 480 | 33 | 1 | 33 | 570 | T3CW-C-2 | 10F~25F,29F~50F |
| | 480 | 33 | 1 | 33 | 570 | T3CW-C-1 | 10F~25F,29F~50F |
| | 480 | 33 | 2 | 66 | 570 | T3CW-B-2 | 10F~25F,29F~50F |
| | 480 | 33 | 2 | 66 | 570 | T3CW-A-1 | 10F~25F,29F~50F |
| | 480 | 33 | 2 | 66 | 570 | T3CW-D-1 | 10F~25F,29F~50F |
| | 480 | 33 | 2 | 66 | 570 | T3CW-G-1 | 10F~25F,29F~50F |
| | 480 | 20 | 1 | 20 | 570 | T3CW-F-1 | 29F~50F |
| | 480 | 14 | 1 | 14 | 570 | T3CW-E-1 | 36F~50F |
| 480 | 19 | 1 | 19 | 570 | T3CW-M-1 | 30F~50F | |
| 合計: | | | 746 | | | | |

| | | | | | | | |
|----|--------------------|----|-----|------------|----|------------|--|
| 名稱 | 生梗企單玻扣蓋 | 制圖 | 陳俊賢 | 2019.01.18 | 修改 | A | |
| 材料 | X85563 | 復核 | 謝永林 | 2019.01.21 | 日期 | 2019.02.18 | |
| 顏色 | EC-DG-S332054 (3塗) | 批准 | | | 圖號 | ZS-S01d-1 | |



美特鋁質 有限公司
MIDI Aluminium Fabricator Ltd.

數據表參見：ZS-S01dR-1



工程號

J-837


地盤

觀塘裕民坊

地盤用

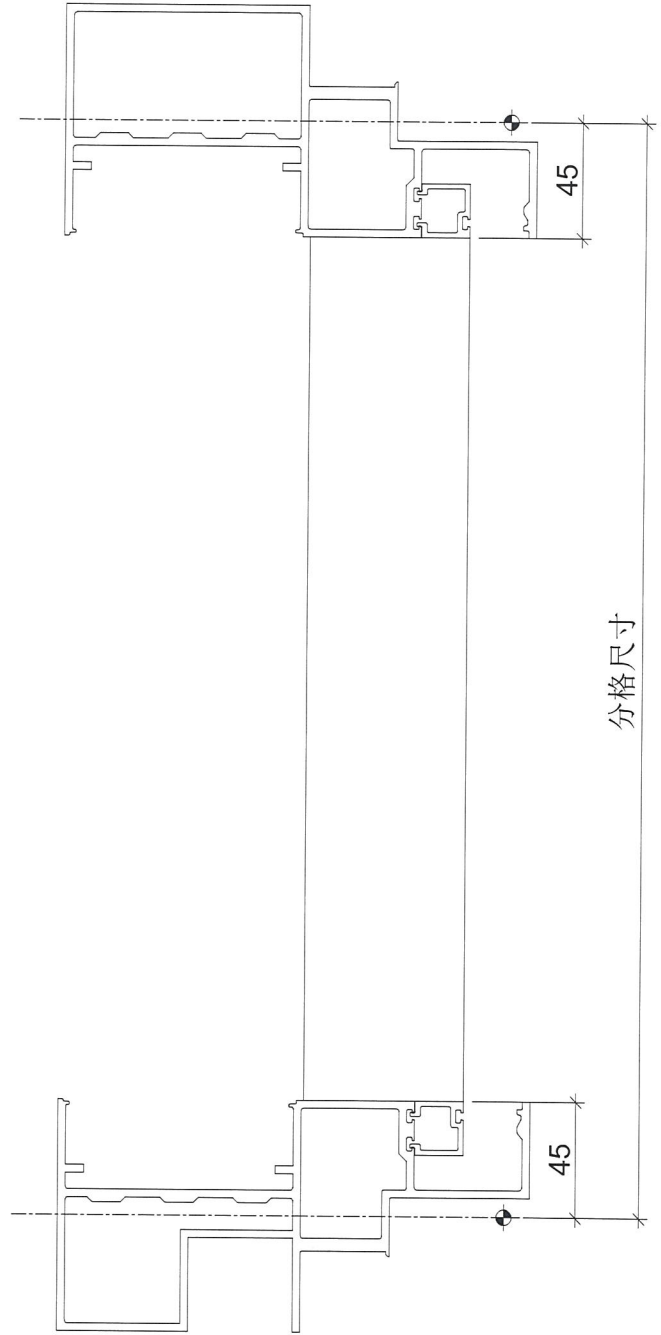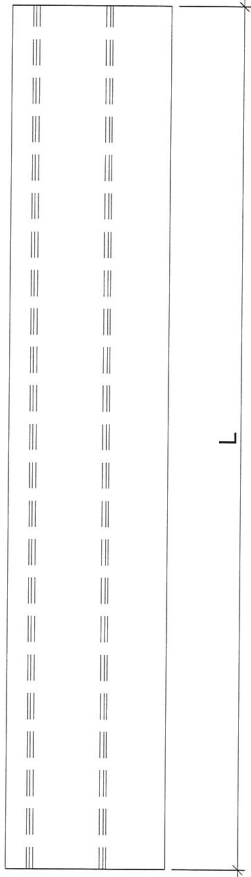

陰影部分避位

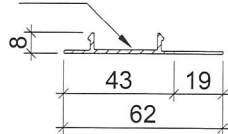

| | | | | | | | | |
|----|--------------------|----|-----|------------|----|----------|--|--|
| 名稱 | 生梗企單玻扣蓋 | 制圖 | 陳俊賢 | 2019.01.18 | 修改 | | | |
| 材料 | X85563 | 復核 | 謝永林 | 2019.01.21 | 日期 | | | |
| 顏色 | EC-DG-S332054 (3塗) | 批准 | | | 圖號 | ZS-S01dR | | |



美特鋁質 有限公司
MIDI Aluminium Fabricator Ltd.

拆圖參見：ZS-S01dR

| | | | |
|-----|-------|----|-------|
| 工程號 | J-837 | 地盤 | 觀塘裕民坊 |
|-----|-------|----|-------|

| 物料編號 | L | 層數 | 每層 | 總數量 | 分格尺寸 | 使用位置 | 樓層 |
|----------|-----|----|----|-----|----------|----------|-----------------|
| ZS-S01dR | 480 | 33 | 1 | 33 | 570 | T3CW-F-1 | 10F~25F,29F~50F |
| | 480 | 33 | 1 | 33 | 570 | T3CW-E-1 | 10F~25F,29F~50F |
| | 480 | 33 | 1 | 33 | 570 | T3CW-M-2 | 10F~25F,29F~50F |
| | 480 | 33 | 1 | 33 | 570 | T3CW-L-2 | 10F~25F,29F~50F |
| | 480 | 33 | 1 | 33 | 570 | T3CW-L-1 | 10F~25F,29F~50F |
| | 480 | 33 | 1 | 33 | 570 | T3CW-K-2 | 10F~25F,29F~50F |
| | 480 | 33 | 1 | 33 | 570 | T3CW-K-1 | 10F~25F,29F~50F |
| | 480 | 33 | 1 | 33 | 570 | T3CW-J-2 | 10F~25F,29F~50F |
| | 480 | 33 | 1 | 33 | 570 | T3CW-J-1 | 10F~25F,29F~50F |
| | 480 | 33 | 1 | 33 | 570 | T3CW-H-3 | 10F~25F,29F~50F |
| | 480 | 33 | 1 | 33 | 570 | T3CW-H-1 | 10F~25F,29F~50F |
| | 480 | 33 | 1 | 33 | 570 | T3CW-C-2 | 10F~25F,29F~50F |
| | 480 | 33 | 1 | 33 | 570 | T3CW-C-1 | 10F~25F,29F~50F |
| | 480 | 33 | 2 | 66 | 570 | T3CW-B-2 | 10F~25F,29F~50F |
| | 480 | 33 | 2 | 66 | 570 | T3CW-A-1 | 10F~25F,29F~50F |
| | 480 | 33 | 2 | 66 | 570 | T3CW-D-1 | 10F~25F,29F~50F |
| | 480 | 33 | 2 | 66 | 570 | T3CW-G-1 | 10F~25F,29F~50F |
| | 480 | 20 | 1 | 20 | 570 | T3CW-F-1 | 29F~50F |
| | 480 | 14 | 1 | 14 | 570 | T3CW-E-1 | 36F~50F |
| 480 | 19 | 1 | 19 | 570 | T3CW-M-1 | 30F~50F | |
| 合計： | | | | 746 | | | |

| | | | | | | | | |
|----|--------------------|----|-----|------------|----|------------|--|--|
| 名稱 | 生梗企單玻扣蓋 | 制圖 | 陳俊賢 | 2019.01.18 | 修改 | A | | |
| 材料 | X85563 | 復核 | 謝永林 | 2019.01.21 | 日期 | 2019.02.18 | | |
| 顏色 | EC-DG-S332054 (3塗) | 批准 | | | 圖號 | ZS-S01dR-1 | | |





美特鋁質有限公司
MIDI Aluminium Fabricator Ltd.


工程號 J-837 地盤 觀塘裕民坊

框窗死牆位底用

室外
OUTSIDE

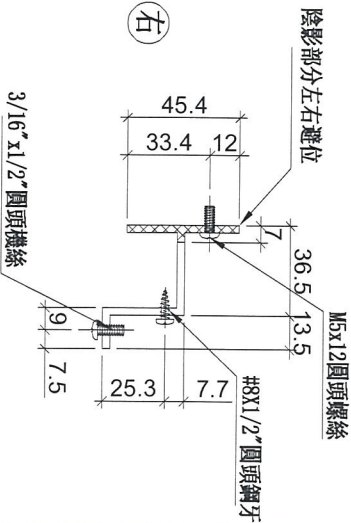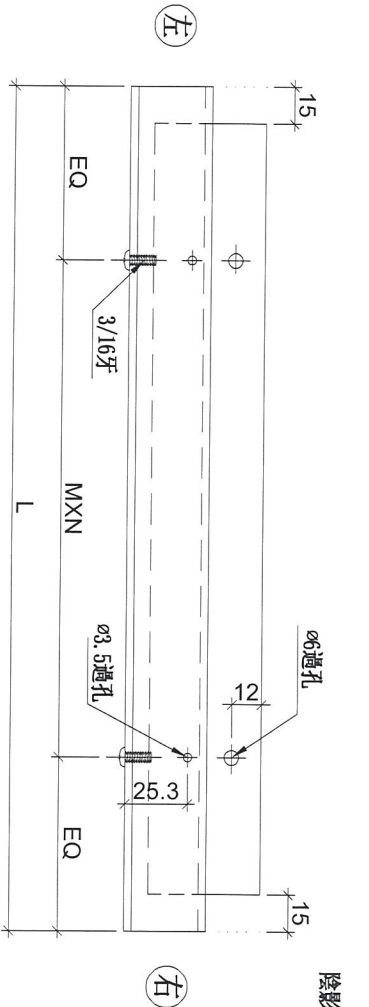

| 物料編號 | L | 層數 | 每層 | 數量 | M | X | N | EQ | 分格尺寸 | 使用位置 | 廠收背板托角編號 | 樓層 |
|----------|--------|----|----|----|-----|---|---|-------|--------|----------|----------|------------------|
| UN-HT301 | 981.5 | 13 | 1 | 13 | 300 | X | 3 | 40.75 | 1107.5 | T3CW-F-1 | UN-HT301 | 10F~25F |
| UN-HT302 | 1399 | 33 | 1 | 33 | 300 | X | 4 | 99.5 | 1525 | T3CW-F-1 | UN-HT302 | 10F~25F, 29F~50F |
| UN-HT303 | 1399 | 33 | 1 | 33 | 300 | X | 4 | 99.5 | 1525 | T3CW-F-1 | UN-HT303 | 10F~25F, 29F~50F |
| UN-HT304 | 1399 | 33 | 1 | 33 | 300 | X | 4 | 99.5 | 1525 | T3CW-F-1 | UN-HT304 | 10F~25F, 29F~50F |
| UN-HT305 | 1016.5 | 33 | 1 | 33 | 300 | X | 3 | 58.25 | 1142.5 | T3CW-F-1 | UN-HT305 | 10F~25F, 29F~50F |
| UN-HT306 | 859 | 19 | 1 | 19 | 250 | X | 3 | 54.5 | 985 | T3CW-F-1 | UN-HT306 | 10F~25F, 29F~35F |
| UN-HT307 | 991.5 | 33 | 1 | 33 | 300 | X | 3 | 45.75 | 1117.5 | T3CW-M-1 | UN-HT307 | 10F~25F, 29F~50F |
| UN-HT308 | 641.5 | 14 | 1 | 14 | 250 | X | 2 | 70.75 | 767.5 | T3CW-M-1 | UN-HT308 | 10F~25F, 29F~50F |
| UN-HT309 | 991.5 | 33 | 1 | 33 | 300 | X | 3 | 45.75 | 1117.5 | T3CW-L-2 | UN-HT309 | 10F~25F, 29F~50F |
| UN-HT310 | 991.5 | 33 | 1 | 33 | 300 | X | 3 | 45.75 | 1117.5 | T3CW-K-1 | UN-HT310 | 10F~25F, 29F~50F |
| UN-HT311 | 916.5 | 33 | 1 | 33 | 250 | X | 3 | 83.25 | 1042.5 | T3CW-J-1 | UN-HT311 | 10F~25F, 29F~50F |
| UN-HT313 | 916.5 | 33 | 1 | 33 | 250 | X | 3 | 83.25 | 1042.5 | T3CW-H-1 | UN-HT313 | 10F~25F, 29F~50F |
| UN-HT314 | 991.5 | 33 | 1 | 33 | 300 | X | 3 | 45.75 | 1117.5 | T3CW-C-2 | UN-HT314 | 10F~25F, 29F~50F |
| UN-HT315 | 1016.5 | 33 | 1 | 33 | 300 | X | 3 | 58.25 | 1142.5 | T3CW-B-2 | UN-HT315 | 10F~25F, 29F~50F |
| UN-HT316 | 1399 | 33 | 1 | 33 | 300 | X | 4 | 99.5 | 1525 | T3CW-B-2 | UN-HT316 | 10F~25F, 29F~50F |
| UN-HT317 | 1434 | 33 | 1 | 33 | 260 | X | 5 | 67 | 1560 | T3CW-B-1 | UN-HT317 | 10F~25F, 29F~50F |
| UN-HT318 | 1434 | 33 | 1 | 33 | 260 | X | 5 | 67 | 1560 | T3CW-A-2 | UN-HT318 | 10F~25F, 29F~50F |
| UN-HT319 | 1399 | 33 | 1 | 33 | 300 | X | 4 | 99.5 | 1525 | T3CW-A-1 | UN-HT319 | 10F~25F, 29F~50F |
| UN-HT320 | 1016.5 | 33 | 1 | 33 | 300 | X | 3 | 58.25 | 1142.5 | T3CW-A-1 | UN-HT320 | 10F~25F, 29F~50F |
| UN-HT321 | 1109 | 33 | 1 | 33 | 250 | X | 4 | 54.5 | 1235 | T3CW-F-2 | UN-HT321 | 10F~25F, 29F~50F |
| UN-HT322 | 1184 | 33 | 1 | 33 | 250 | X | 4 | 92 | 1310 | T3CW-F-2 | UN-HT322 | 10F~25F, 29F~50F |

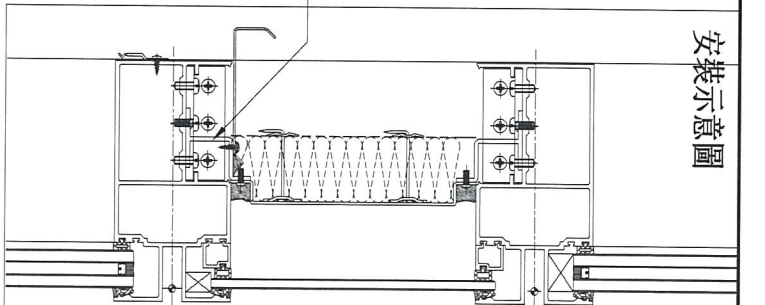

安裝示意圖

修改日期
圖號 UN-HT301

2018.12.21
2018.12.17

制圖 陳俊賢
復核 謝永林
批准


名稱 背板托角
材料 X85625
顏色 MILL



美特鋁質有限公司
MIDI Aluminium Fabricator Ltd.


工程號 J-837 地盤 觀塘裕民坊

棧窗死牆位頂用

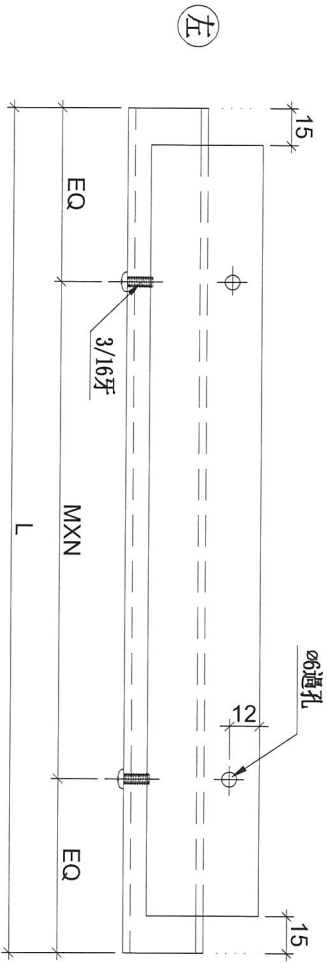


室外
OUTSIDE

陰影部分左右避位

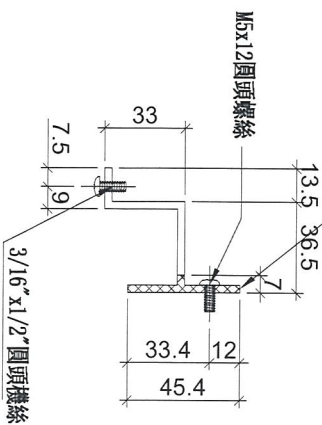

| 物料編號 | L | 層數 | 每層 | 數量 | M | X | N | EQ | 分格尺寸 | 使用位置 | 廠收背板托角編號 | 樓層 |
|-----------|--------|----|----|----|-----|---|---|-------|--------|----------|----------|------------------|
| UN-HT301a | 981.5 | 13 | 1 | 13 | 300 | X | 3 | 40.75 | 1107.5 | T3CW-F-1 | UN-HT301 | 10F~25F |
| UN-HT302a | 1399 | 33 | 1 | 33 | 300 | X | 4 | 99.5 | 1525 | T3CW-F-1 | UN-HT302 | 10F~25F, 29F~50F |
| UN-HT303a | 1399 | 33 | 1 | 33 | 300 | X | 4 | 99.5 | 1525 | T3CW-F-1 | UN-HT303 | 10F~25F, 29F~50F |
| UN-HT304a | 1399 | 33 | 1 | 33 | 300 | X | 4 | 99.5 | 1525 | T3CW-E-1 | UN-HT304 | 10F~25F, 29F~50F |
| UN-HT305a | 1016.5 | 33 | 1 | 33 | 300 | X | 3 | 58.25 | 1142.5 | T3CW-E-1 | UN-HT305 | 10F~25F, 29F~50F |
| UN-HT306a | 859 | 19 | 1 | 19 | 250 | X | 3 | 54.5 | 985 | T3CW-E-1 | UN-HT306 | 10F~25F, 29F~35F |
| UN-HT307a | 991.5 | 33 | 1 | 33 | 300 | X | 3 | 45.75 | 1117.5 | T3CW-M-1 | UN-HT307 | 10F~25F, 29F~50F |
| UN-HT308a | 641.5 | 14 | 1 | 14 | 250 | X | 2 | 70.75 | 767.5 | T3CW-M-1 | UN-HT308 | 10F~25F, 29F |
| UN-HT309a | 991.5 | 33 | 1 | 33 | 300 | X | 3 | 45.75 | 1117.5 | T3CW-L-2 | UN-HT309 | 10F~25F, 29F~50F |
| UN-HT310a | 991.5 | 33 | 1 | 33 | 300 | X | 3 | 45.75 | 1117.5 | T3CW-K-1 | UN-HT310 | 10F~25F, 29F~50F |
| UN-HT311a | 916.5 | 33 | 1 | 33 | 250 | X | 3 | 83.25 | 1042.5 | T3CW-J-1 | UN-HT311 | 10F~25F, 29F~50F |
| UN-HT313a | 916.5 | 33 | 1 | 33 | 250 | X | 3 | 83.25 | 1042.5 | T3CW-H-1 | UN-HT313 | 10F~25F, 29F~50F |
| UN-HT314a | 991.5 | 33 | 1 | 33 | 300 | X | 3 | 45.75 | 1117.5 | T3CW-C-2 | UN-HT314 | 10F~25F, 29F~50F |
| UN-HT315a | 1016.5 | 33 | 1 | 33 | 300 | X | 3 | 58.25 | 1142.5 | T3CW-B-2 | UN-HT315 | 10F~25F, 29F~50F |
| UN-HT316a | 1399 | 33 | 1 | 33 | 300 | X | 4 | 99.5 | 1525 | T3CW-B-2 | UN-HT316 | 10F~25F, 29F~50F |
| UN-HT317a | 1434 | 33 | 1 | 33 | 260 | X | 5 | 67 | 1560 | T3CW-B-1 | UN-HT317 | 10F~25F, 29F~50F |
| UN-HT318a | 1434 | 33 | 1 | 33 | 260 | X | 5 | 67 | 1560 | T3CW-A-2 | UN-HT318 | 10F~25F, 29F~50F |
| UN-HT319a | 1399 | 33 | 1 | 33 | 300 | X | 4 | 99.5 | 1525 | T3CW-A-1 | UN-HT319 | 10F~25F, 29F~50F |
| UN-HT320a | 1016.5 | 33 | 1 | 33 | 300 | X | 3 | 58.25 | 1142.5 | T3CW-A-1 | UN-HT320 | 10F~25F, 29F~50F |
| UN-HT321a | 1109 | 33 | 1 | 33 | 250 | X | 4 | 54.5 | 1235 | T3CW-F-2 | UN-HT321 | 10F~25F, 29F~50F |
| UN-HT322a | 1184 | 33 | 1 | 33 | 250 | X | 4 | 92 | 1310 | T3CW-F-2 | UN-HT322 | 10F~25F, 29F~50F |

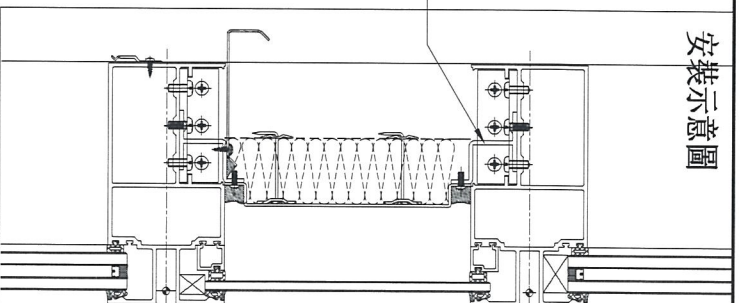

| | | | | | | |
|----|--------|----|-----|------------|----|-----------|
| 名稱 | 背板托角 | 制圖 | 陳俊賢 | 2018.12.21 | 修改 | |
| 材料 | X85625 | 復核 | 謝永林 | 2018.12.17 | 日期 | |
| 顏色 | MILL | 批准 | | | 圖號 | UN-HT301a |




美特鋁質有限公司
MIDI Aluminium Fabricator Ltd.



工程號 J-837 地盤 觀塘裕民坊

| 物料編號 | L | 樓層 | 每層 | 數量 | M | X | N | A | 分格尺寸 | 使用位置 | 廠家背板托角編號 | 樓層 |
|------------|--------|----|----|----|-----|---|---|-------|--------|----------|-----------|-----------------|
| UN-HT301aS | 1241.5 | 33 | 1 | 33 | 290 | X | 4 | 40.75 | 1367.5 | T3CW-F-1 | UN-HT301S | 10F~25F,29F~50F |
| UN-HT302aS | 1041.5 | 33 | 1 | 33 | 300 | X | 3 | 70.75 | 1167.5 | T3CW-E-1 | UN-HT302S | 10F~25F,29F~50F |
| UN-HT303aS | 709 | 33 | 1 | 33 | 300 | X | 2 | 54.5 | 835 | T3CW-M-2 | UN-HT303S | 10F~25F,29F~50F |
| UN-HT304aS | 641.5 | 33 | 1 | 33 | 250 | X | 2 | 70.75 | 767.5 | T3CW-L-2 | UN-HT304S | 10F~25F,29F~50F |
| UN-HT305aS | 859 | 33 | 1 | 33 | 250 | X | 3 | 54.5 | 985 | T3CW-L-1 | UN-HT305S | 10F~25F,29F~50F |
| UN-HT306aS | 809 | 33 | 1 | 33 | 300 | X | 2 | 104.5 | 935 | T3CW-K-2 | UN-HT306S | 10F~25F,29F~50F |
| UN-HT307aS | 641.5 | 33 | 1 | 33 | 250 | X | 2 | 70.75 | 767.5 | T3CW-K-1 | UN-HT307S | 10F~25F,29F~50F |
| UN-HT308aS | 734 | 33 | 1 | 33 | 300 | X | 2 | 67 | 860 | T3CW-J-2 | UN-HT308S | 10F~25F,29F~50F |
| UN-HT309aS | 641.5 | 33 | 1 | 33 | 250 | X | 2 | 70.75 | 767.5 | T3CW-J-1 | UN-HT309S | 10F~25F,29F~50F |
| UN-HT311aS | 691.5 | 33 | 1 | 33 | 250 | X | 2 | 95.75 | 817.5 | T3CW-H-1 | UN-HT311S | 10F~25F,29F~50F |
| UN-HT312aS | 641.5 | 33 | 1 | 33 | 250 | X | 2 | 70.75 | 767.5 | T3CW-G-2 | UN-HT312S | 10F~25F,29F~50F |
| UN-HT313aS | 809 | 33 | 1 | 33 | 300 | X | 2 | 104.5 | 935 | T3CW-G-1 | UN-HT313S | 10F~25F,29F~50F |
| UN-HT314aS | 1259 | 33 | 1 | 33 | 290 | X | 4 | 49.5 | 1385 | T3CW-B-2 | UN-HT314S | 10F~25F,29F~50F |
| UN-HT315aS | 781.5 | 33 | 1 | 33 | 300 | X | 2 | 90.75 | 907.5 | T3CW-B-1 | UN-HT315S | 10F~25F,29F~50F |
| UN-HT316aS | 781.5 | 33 | 1 | 33 | 300 | X | 2 | 90.75 | 907.5 | T3CW-A-1 | UN-HT316S | 10F~25F,29F~50F |
| UN-HT317aS | 1159 | 33 | 1 | 33 | 250 | X | 4 | 79.5 | 1285 | T3CW-A-1 | UN-HT317S | 10F~25F,29F~50F |
| UN-HT318aS | 690 | 33 | 1 | 33 | 300 | X | 2 | 45 | 816 | T3CW-D-1 | UN-HT318S | 10F~25F,29F~50F |
| UN-HT319aS | 641.5 | 33 | 1 | 33 | 250 | X | 2 | 70.75 | 767.5 | T3CW-D-1 | UN-HT319S | 10F~25F,29F~50F |
| UN-HT320aS | 641.5 | 33 | 1 | 33 | 250 | X | 2 | 70.75 | 767.5 | T3CW-G-1 | UN-HT320S | 10F~25F,29F~50F |
| UN-HT321aS | 691.5 | 33 | 1 | 33 | 250 | X | 2 | 95.75 | 817.5 | T3CW-G-1 | UN-HT321S | 10F~25F,29F~50F |
| UN-HT322aS | 981.5 | 20 | 1 | 20 | 300 | X | 3 | 40.75 | 1107.5 | T3CW-E-1 | UN-HT322S | 29F~50F |
| UN-HT323aS | 859 | 14 | 1 | 14 | 250 | X | 3 | 54.5 | 985 | T3CW-E-1 | UN-HT323S | 36F~50F |
| UN-HT324aS | 641.5 | 19 | 1 | 19 | 250 | X | 2 | 70.75 | 767.5 | T3CW-M-1 | UN-HT324S | 30F~50F |

櫥窗死牆位頂用

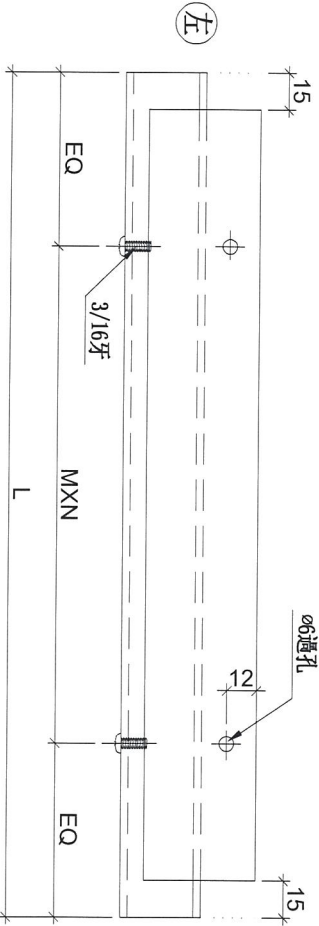

室外
OUTSIDE

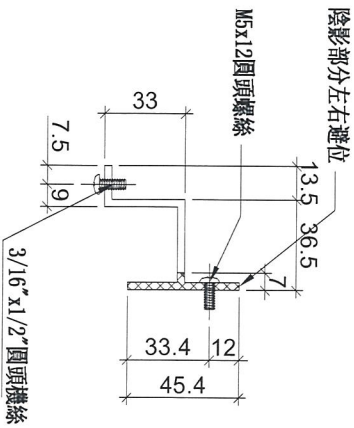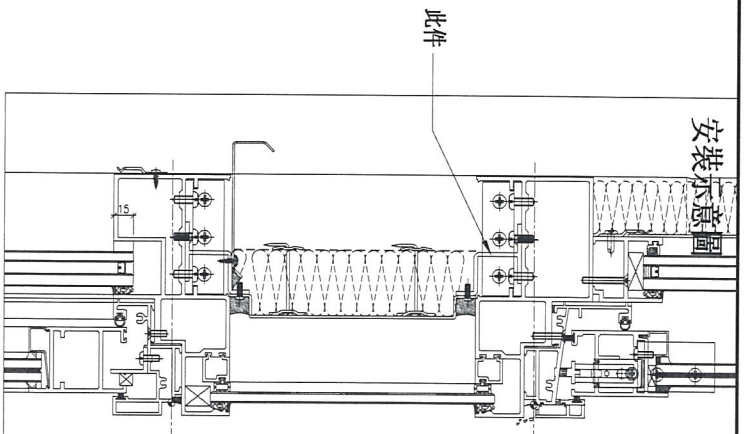

| | | | | | | |
|----|--------|----|-----|------------|----|------------|
| 名稱 | 背板托角 | 制圖 | 陳俊賢 | 2018.12.21 | 修改 | |
| 材料 | X85625 | 復核 | 謝永林 | 2018.12.17 | 日期 | |
| 顏色 | MILL | 批准 | | | 圖號 | UN-HT301aS |



美特鋁質 有限公司
MIDI Aluminium Fabricator Ltd.




依據10067 C版修改
單插線, 開 $\phi 5$ 去水孔

工程號 J-837 地盤 觀塘裕民坊

| 物料編號 | L | 層數 | 每層 | 總數量 | 分格尺寸 | 使用位置 | 樓層 |
|---------|-----|----|----|-----|------|----------|-----------------|
| UN-HM1a | 601 | 33 | 1 | 33 | 650 | T3CW-E-1 | 10F~25F,29F~50F |
| | 601 | 33 | 1 | 33 | 650 | T3CW-M-2 | 10F~25F,29F~50F |
| | 601 | 33 | 1 | 33 | 650 | T3CW-L-2 | 10F~25F,29F~50F |
| | 601 | 33 | 1 | 33 | 650 | T3CW-L-1 | 10F~25F,29F~50F |
| | 601 | 33 | 1 | 33 | 650 | T3CW-K-2 | 10F~25F,29F~50F |
| | 601 | 33 | 1 | 33 | 650 | T3CW-C-1 | 10F~25F,29F~50F |
| | 601 | 33 | 1 | 33 | 650 | T3CW-B-2 | 10F~25F,29F~50F |
| | 601 | 33 | 2 | 66 | 650 | T3CW-A-1 | 10F~25F,29F~50F |
| UN-HM2a | 401 | 33 | 1 | 33 | 450 | T3CW-M-1 | 10F~25F,29F~50F |
| | 401 | 33 | 1 | 33 | 450 | T3CW-J-2 | 10F~25F,29F~50F |
| | 401 | 33 | 1 | 33 | 450 | T3CW-B-1 | 10F~25F,29F~50F |
| | 401 | 33 | 1 | 33 | 450 | T3CW-A-2 | 10F~25F,29F~50F |

新增

生窗死牆位底用

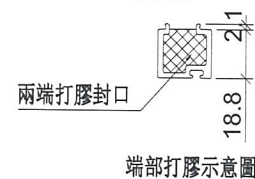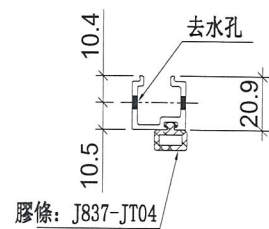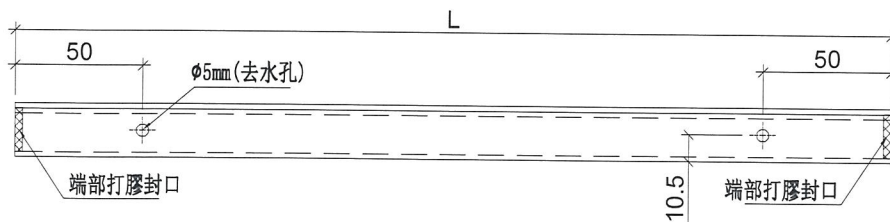

| | | | | | | | | |
|----|--------------------|----|-----|------------|----|---------|--|--|
| 名稱 | 單玻插線 | 制圖 | 陳俊賢 | 2018.10.21 | 修改 | | | |
| 材料 | X85560 | 復核 | 謝永林 | 2019.02.18 | 日期 | | | |
| 顏色 | EC-DG-S332054 (3塗) | 批准 | | | 圖號 | UN-HM1a | | |



美特鋁質 有限公司
MIDI Aluminium Fabricator Ltd.



依據10067 C版修改
單插線, 開 $\phi 5$ 去水孔

工程號 J-837 地盤 觀塘裕民坊

| 物料編號 | L | 層數 | 每層 | 總數量 | 分格尺寸 | 使用位置 | 樓層 |
|-----------|--------|----|----|-----|--------|----------|------------------|
| UN-HM301a | 1017.5 | 13 | 1 | 13 | 1107.5 | T3CW-F-1 | 10F~25F |
| UN-HM302a | 1435 | 33 | 1 | 33 | 1525 | T3CW-F-1 | 10F~25F, 29F~50F |
| UN-HM303a | 1435 | 33 | 1 | 33 | 1525 | T3CW-F-1 | 10F~25F, 29F~50F |
| UN-HM304a | 1435 | 33 | 1 | 33 | 1525 | T3CW-E-1 | 10F~25F, 29F~50F |
| UN-HM306a | 895 | 19 | 1 | 19 | 985 | T3CW-E-1 | 10F~25F, 29F~35F |
| UN-HM308a | 677.5 | 14 | 1 | 14 | 767.5 | T3CW-M-1 | 10F~25F, 29F |
| UN-HM316a | 1435 | 33 | 1 | 33 | 1525 | T3CW-B-2 | 10F~25F, 29F~50F |

新增

梗窗死牆位底用

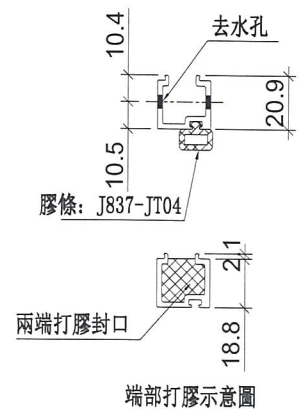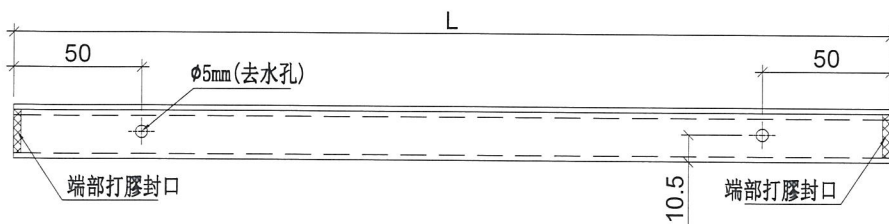

| | | | | | | | |
|----|--------------------|----|-----|------------|----|-----------|--|
| 名稱 | 單玻插線 | 制圖 | 陳俊賢 | 2018.10.21 | 修改 | | |
| 材料 | X85560 | 復核 | 謝永林 | 2019.02.18 | 日期 | | |
| 顏色 | EC-DG-S332054 (3塗) | 批準 | | | 圖號 | UN-HM301a | |



美特鋁質 有限公司
MIDI Aluminium Fabricator Ltd.



依據10067 C版修改
單插線, 開 $\phi 5$ 去水孔

工程號 J-837 地盤 觀塘裕民坊

| 物料編號 | L | 層數 | 每層 | 總數量 | 分格尺寸 | 使用位置 | 樓層 |
|------------|--------|----|----|-----|--------|----------|---|
| UN-HM301aS | 1318.5 | 26 | 1 | 26 | 1367.5 | T3CW-F-1 | 11F,12F,15F,16F,18F~22F,25F,29F,31F~33F,35F,36F,38F~42F,45F~48F,50F |
| UN-HM302aS | 1118.5 | 26 | 1 | 26 | 1167.5 | T3CW-E-1 | 11F,12F,15F,16F,18F~22F,25F,29F,31F~33F,35F,36F,38F~42F,45F~48F,50F |
| UN-HM303aS | 786 | 26 | 1 | 26 | 835 | T3CW-M-2 | 11F,12F,15F,16F,18F~22F,25F,29F,31F~33F,35F,36F,38F~42F,45F~48F,50F |
| UN-HM304aS | 718.5 | 26 | 1 | 26 | 767.5 | T3CW-L-2 | 11F,12F,15F,16F,18F~22F,25F,29F,31F~33F,35F,36F,38F~42F,45F~48F,50F |
| UN-HM305aS | 936 | 26 | 1 | 26 | 985 | T3CW-L-1 | 11F,12F,15F,16F,18F~22F,25F,29F,31F~33F,35F,36F,38F~42F,45F~48F,50F |
| UN-HM306aS | 886 | 26 | 1 | 26 | 935 | T3CW-K-2 | 11F,12F,15F,16F,18F~22F,25F,29F,31F~33F,35F,36F,38F~42F,45F~48F,50F |
| UN-HM307aS | 718.5 | 26 | 1 | 26 | 767.5 | T3CW-K-1 | 11F,12F,15F,16F,18F~22F,25F,29F,31F~33F,35F,36F,38F~42F,45F~48F,50F |
| UN-HM308aS | 811 | 26 | 1 | 26 | 860 | T3CW-J-2 | 11F,12F,15F,16F,18F~22F,25F,29F,31F~33F,35F,36F,38F~42F,45F~48F,50F |
| UN-HM309aS | 718.5 | 26 | 1 | 26 | 767.5 | T3CW-J-1 | 11F,12F,15F,16F,18F~22F,25F,29F,31F~33F,35F,36F,38F~42F,45F~48F,50F |
| UN-HM310aS | 1333.5 | 26 | 1 | 26 | 1480 | T3CW-H-2 | 11F,12F,15F,16F,18F~22F,25F,29F,31F~33F,35F,36F,38F~42F,45F~48F,50F |
| UN-HM318aS | 767 | 26 | 1 | 26 | 816 | T3CW-D-1 | 11F,12F,15F,16F,18F~22F,25F,29F,31F~33F,35F,36F,38F~42F,45F~48F,50F |
| UN-HM319aS | 718.5 | 26 | 1 | 26 | 767.5 | T3CW-D-1 | 11F,12F,15F,16F,18F~22F,25F,29F,31F~33F,35F,36F,38F~42F,45F~48F,50F |
| UN-HM320aS | 718.5 | 26 | 1 | 26 | 767.5 | T3CW-G-1 | 11F,12F,15F,16F,18F~22F,25F,29F,31F~33F,35F,36F,38F~42F,45F~48F,50F |
| UN-HM321aS | 768.5 | 26 | 1 | 26 | 817.5 | T3CW-G-1 | 11F,12F,15F,16F,18F~22F,25F,29F,31F~33F,35F,36F,38F~42F,45F~48F,50F |
| UN-HM322aS | 1058.5 | 16 | 1 | 16 | 1107.5 | T3CW-F-1 | 29F,31F~33F,35F,36F,38F~42F,45F~48F,50F |
| UN-HM323aS | 936 | 11 | 1 | 11 | 985 | T3CW-E-1 | 38F~42F,45F~48F,50F |
| UN-HM324aS | 718.5 | 15 | 1 | 15 | 767.5 | T3CW-M-1 | 31F~33F,35F,36F,38F~42F,45F~48F,50F |

新增

SD頂死牆位底用

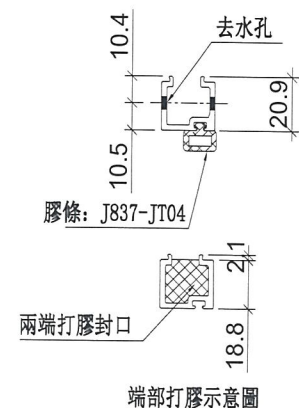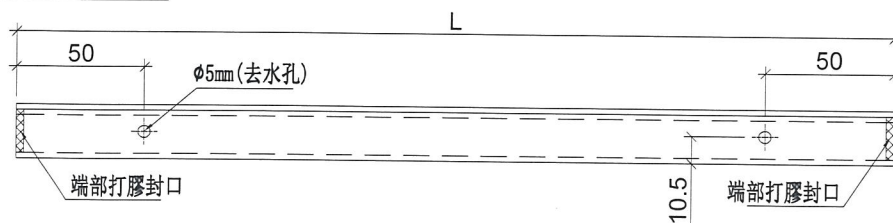

| | | | | | | | |
|----|--------------------|----|-----|--------------|----|------------|--|
| 名稱 | 單玻插線 | 制圖 | 陳俊賢 | 2018. 10. 21 | 修改 | | |
| 材料 | X85560 | 復核 | 謝永林 | 2019. 02. 18 | 日期 | | |
| 顏色 | EC-DG-S332054 (3塗) | 批准 | | | 圖號 | UN-HM301aS | |



美特鋁質 有限公司
MIDI Aluminium Fabricator Ltd.



依據10067 C版修改
單插線, 開 $\phi 5$ 去水孔

工程號 J-837 地盤 觀塘裕民坊

| 物料編號 | L | 層數 | 每層 | 總數量 | 分格尺寸 | B (左邊) | C (右邊) | 使用位置 | 樓層 |
|---------------|--------|----|----|-----|--------|--------|--------|----------|-----------------------------------|
| UN-HM301S (D) | 1318.5 | 7 | 1 | 7 | 1367.5 | 無 | 170.5 | T3CW-F-1 | 10F, 17F, 23F, 30F, 37F, 43F, 49F |
| UN-HM302S (D) | 1118.5 | 7 | 1 | 7 | 1167.5 | 170.5 | 無 | T3CW-E-1 | 10F, 17F, 23F, 30F, 37F, 43F, 49F |
| UN-HM303S (D) | 786 | 7 | 1 | 7 | 835 | 170.5 | 無 | T3CW-M-2 | 10F, 17F, 23F, 30F, 37F, 43F, 49F |
| UN-HM304S (D) | 718.5 | 7 | 1 | 7 | 767.5 | 170.5 | 無 | T3CW-L-2 | 10F, 17F, 23F, 30F, 37F, 43F, 49F |
| UN-HM305S (D) | 936 | 7 | 1 | 7 | 985 | 無 | 170.5 | T3CW-L-1 | 10F, 17F, 23F, 30F, 37F, 43F, 49F |
| UN-HM306S (D) | 886 | 7 | 1 | 7 | 935 | 無 | 170.5 | T3CW-K-2 | 10F, 17F, 23F, 30F, 37F, 43F, 49F |
| UN-HM307S (D) | 718.5 | 7 | 1 | 7 | 767.5 | 無 | 170.5 | T3CW-K-1 | 10F, 17F, 23F, 30F, 37F, 43F, 49F |
| UN-HM308S (D) | 811 | 7 | 1 | 7 | 860 | 170.5 | 無 | T3CW-J-2 | 10F, 17F, 23F, 30F, 37F, 43F, 49F |
| UN-HM309S (D) | 718.5 | 7 | 1 | 7 | 767.5 | 無 | 170.5 | T3CW-J-1 | 10F, 17F, 23F, 30F, 37F, 43F, 49F |
| UN-HM310S (D) | 1431 | 7 | 1 | 7 | 1480 | 73 | 170.5 | T3CW-H-2 | 10F, 17F, 23F, 30F, 37F, 43F, 49F |
| UN-HM311S (D) | 768.5 | 7 | 1 | 7 | 817.5 | 無 | 170.5 | T3CW-H-1 | 10F, 17F, 23F, 30F, 37F, 43F, 49F |
| UN-HM312S (D) | 718.5 | 7 | 1 | 7 | 767.5 | 170.5 | 無 | T3CW-C-2 | 10F, 17F, 23F, 30F, 37F, 43F, 49F |
| UN-HM313S (D) | 886 | 7 | 1 | 7 | 935 | 170.5 | 無 | T3CW-C-1 | 10F, 17F, 23F, 30F, 37F, 43F, 49F |
| UN-HM314S (D) | 1336 | 7 | 1 | 7 | 1385 | 170.5 | 170.5 | T3CW-B-2 | 10F, 17F, 23F, 30F, 37F, 43F, 49F |
| UN-HM315S (D) | 858.5 | 7 | 1 | 7 | 907.5 | 無 | 170.5 | T3CW-B-1 | 10F, 17F, 23F, 30F, 37F, 43F, 49F |
| UN-HM316S (D) | 858.5 | 7 | 1 | 7 | 907.5 | 170.5 | 無 | T3CW-A-1 | 10F, 17F, 23F, 30F, 37F, 43F, 49F |
| UN-HM317S (D) | 1236 | 7 | 1 | 7 | 1285 | 170.5 | 170.5 | T3CW-A-1 | 10F, 17F, 23F, 30F, 37F, 43F, 49F |
| UN-HM318S (D) | 767 | 7 | 1 | 7 | 816 | 170.5 | 無 | T3CW-D-1 | 10F, 17F, 23F, 30F, 37F, 43F, 49F |
| UN-HM319S (D) | 718.5 | 7 | 1 | 7 | 767.5 | 無 | 170.5 | T3CW-D-1 | 10F, 17F, 23F, 30F, 37F, 43F, 49F |
| UN-HM320S (D) | 718.5 | 7 | 1 | 7 | 767.5 | 170.5 | 無 | T3CW-G-1 | 10F, 17F, 23F, 30F, 37F, 43F, 49F |
| UN-HM321S (D) | 768.5 | 7 | 1 | 7 | 817.5 | 無 | 170.5 | T3CW-G-1 | 10F, 17F, 23F, 30F, 37F, 43F, 49F |
| UN-HM322S (D) | 1058.5 | 4 | 1 | 4 | 1107.5 | 170.5 | 無 | T3CW-F-1 | 30F, 37F, 43F, 49F |
| UN-HM323S (D) | 936 | 3 | 1 | 3 | 985 | 無 | 170.5 | T3CW-E-1 | 37F, 43F, 49F |
| UN-HM324S (D) | 718.5 | 3 | 1 | 3 | 767.5 | 無 | 170.5 | T3CW-M-1 | 30, 37F, 43F, 49F |

新增

SD死牆底吊船位用

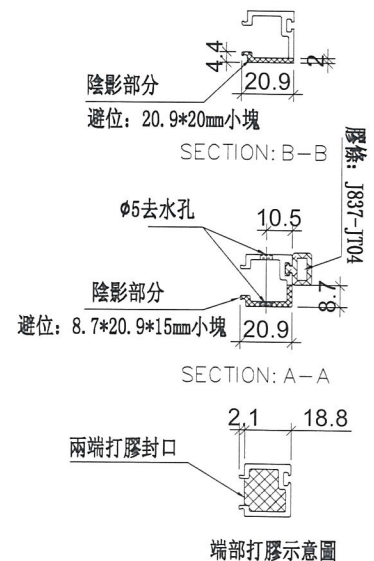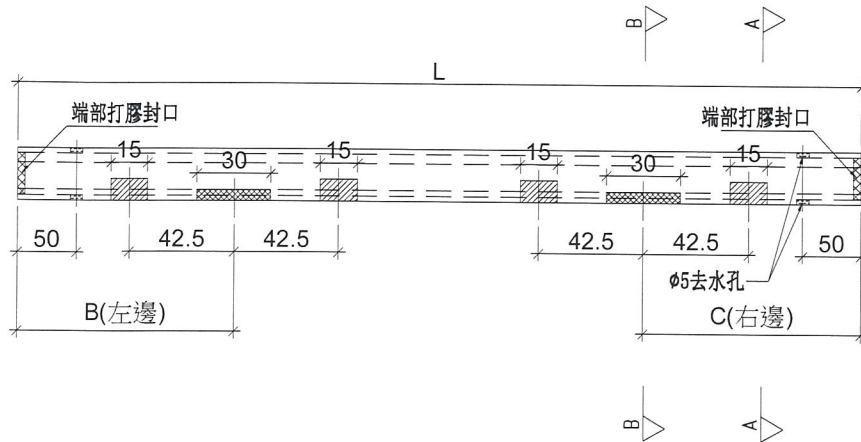

| | | | | | | | |
|----|--------------------|----|-----|------------|----|---------------|--|
| 名稱 | 單玻插線 | 制圖 | 陳俊賢 | 2019.02.15 | 修改 | | |
| 材料 | X85560 | 復核 | 謝永林 | 2019.02.18 | 日期 | | |
| 顏色 | EC-DG-S332054 (3塗) | 批准 | | | 圖號 | UN-HM301S (D) | |

EG-DWG3




美特鋁質 有限公司
MIDI Aluminium Fabricator Ltd.



工程號 J-837 地盤 觀塘裕民坊

| 總層 | 總數量 | 使用位置 | 樓層 |
|------|-----|----------|-------|
| 3 | 5 | T1CW D-1 | 7F~9F |
| 3 | 5 | T1CW C-1 | 7F~9F |
| 3 | 5 | T1CW H-2 | 7F~9F |
| 3 | 5 | T2CW C-2 | 7F~9F |
| 3 | 5 | T2CW B-2 | 7F~9F |
| 3 | 5 | T3CW B-2 | 7F~9F |
| 3 | 5 | T5CW M-2 | 7F~9F |
| 3 | 5 | T5CW C-1 | 7F~9F |
| 合計 : | 40 | | |


頂

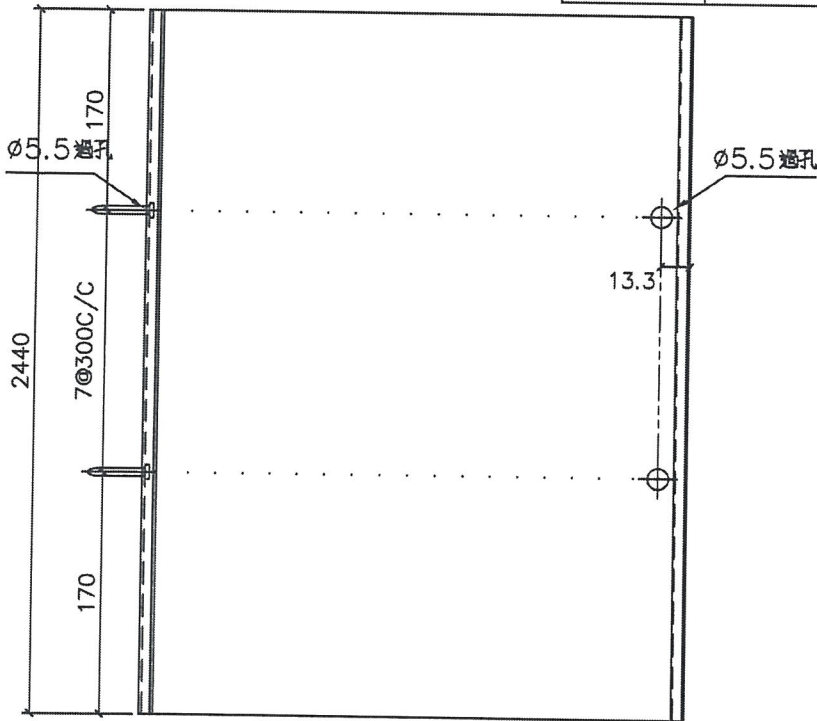

底

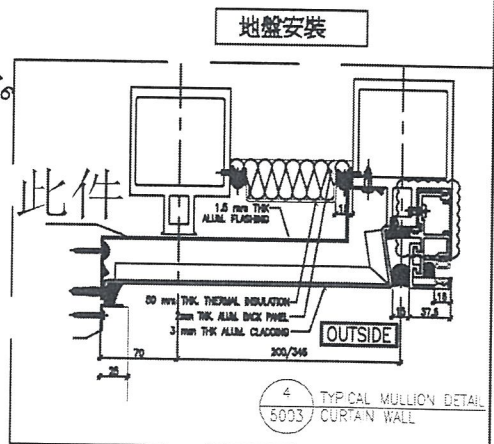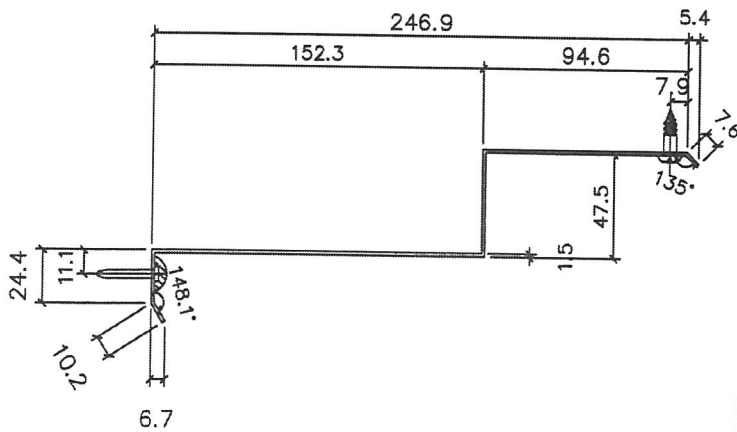

| | | | | | | | |
|----|---------|----|----|----------|----|--------|--|
| 名稱 | 防水片拆圖 | 制圖 | 韓芳 | 2019.1.9 | 修改 | | |
| 材料 | 1.5mm鋁板 | 復核 | | | 日期 | | |
| 顏色 | 銀 M711 | 批准 | | | 圖號 | FS-H02 | |

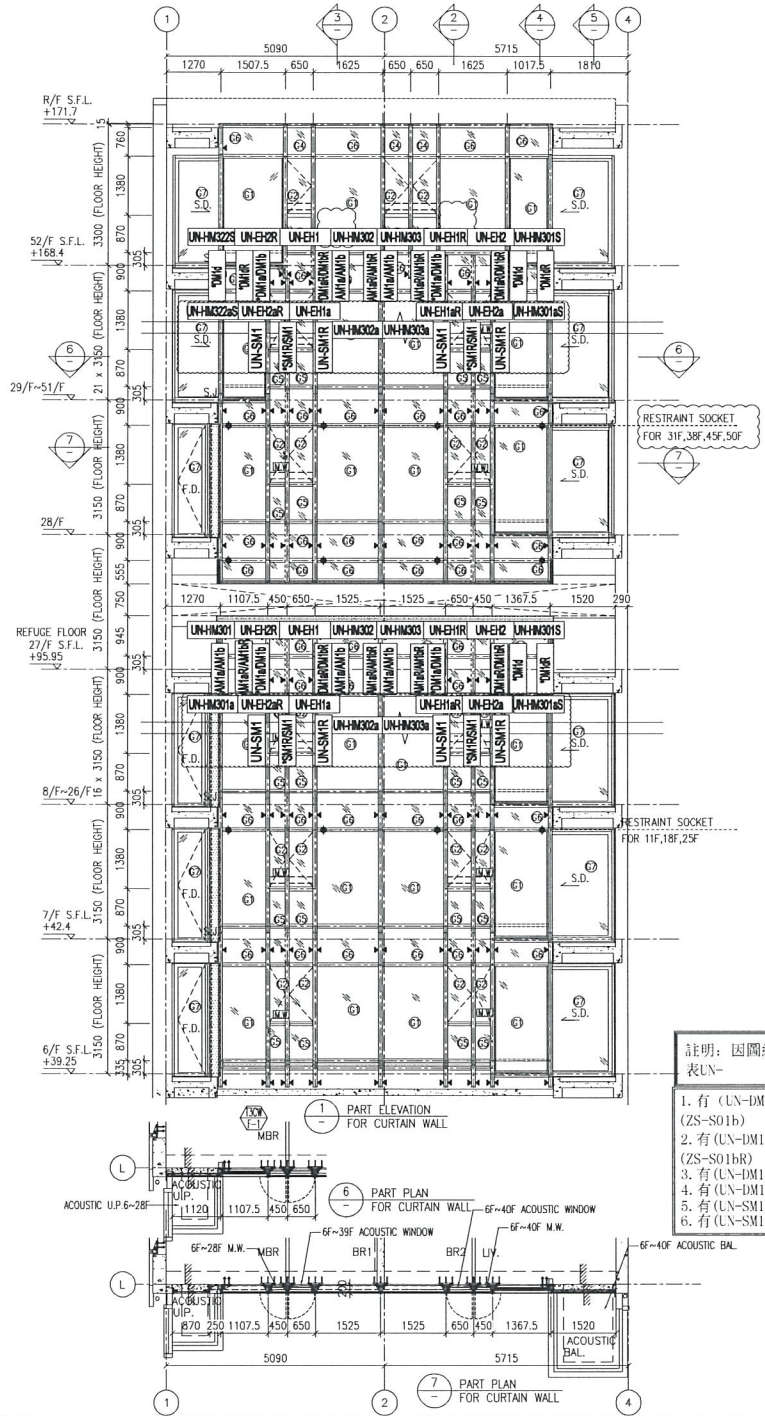

註明：因圖紙空間有限“*”代表UN-

1. 有 (UN-DM1a/UN-DM1b) 需配 (ZS-S01b)
2. 有 (UN-DM1aR/UN-DM1bR) 需配 (ZS-S01bR)
3. 有 (UN-DM1d) 需配 (ZS-S01d)
4. 有 (UN-DM1dR) 需配 (ZS-S01dR)
5. 有 (UN-SM1) 需配 (ZS-BG1)
6. 有 (UN-SM1R) 需配 (ZS-BG1R)

B.D. REF :

CLIENT :
 Sino Land Company Limited

ARCHITECT :
 WONG TUNG & PARTNERS LIMITED
 ARCHITECTS & PLANNERS

MAIN CONTRACTOR :
 CR Construction Company Limited

STRUCTURAL ENGINEER :
 AECOM

FACADE CONSULTANT:
 AECOM

NOTE :
 1. ALL DIMENSIONS ARE IN mm.
 2. ALL ELEVATIONS ARE VIEWED FROM OUTSIDE.
 3. ALL DIMENSIONS TO BE VERIFIED ON SITE BEFORE FABRICATION.

LEGEND :
 — DETAIL MARK NO.
 — REFER SHEET NO.
 1. F.F.L. — FINISHED FLOOR LEVEL
 2. S.F.L. — STRUCTURAL FLOOR LEVEL
 3. (Z) — REVERSED DETAIL


| NO. | DATE | REVISED | BY |
|-----|------------|-----------------|----|
| E | 17/01/2019 | GENERAL REVISED | |
| D | 22/12/2018 | GENERAL REVISED | |
| C | 04/12/2018 | GENERAL REVISED | |
| B | 24/11/2018 | GENERAL REVISED | |
| A | 10/9/2018 | GENERAL REVISED | |

JOB NO. : J-837
 PROJECT :
 URA KWUN TONG TOWN CENTRE
 REDEVELOPMENT (AREA 2 & 3) AT
 NKIL 6514, KWUN TONG, KWLOON

TITLE :
 PART ELEVATION
 OF CURTAIN WALL
 AT TOWER 3

DATE : 04-JUL-18 SCALE : 1:60 (A1)
 DRAWN BY : ASING CHECKED BY : -

美特鋁質有限公司
 MIDI ALUMINIUM FABRICATOR LTD.
 Units 6-8, Sunray Industrial Centre, 1/F
 610 Cho Kwo Ling Road, Kowloon
 Tel:23489211-4 Fax:(852)2727666
 DWG NO. : J837-CW-2301 REV. : E

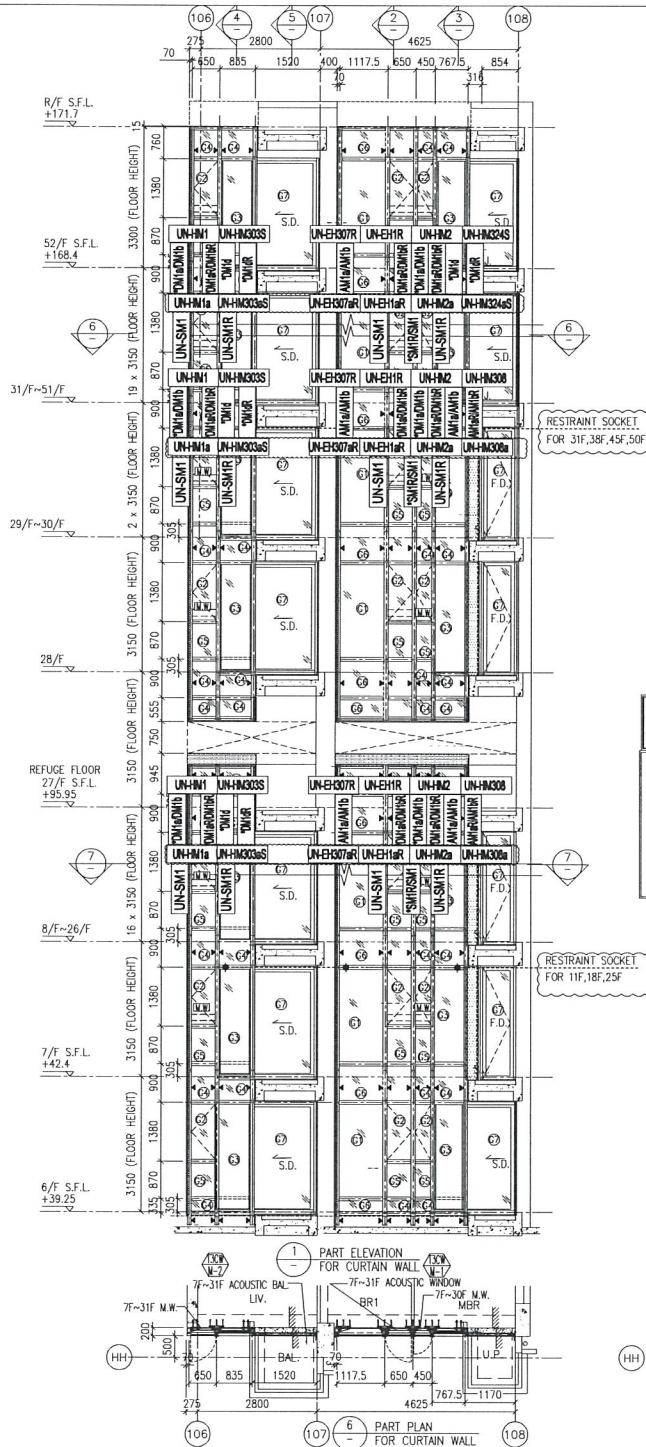

註明：因圖紙空間有限“*”代表UN-

1. 有 (UN-DM1a/UN-DM1b) 需配 (ZS-S01b)
2. 有 (UN-DM1aR/UN-DM1bR) 需配 (ZS-S01bR)
3. 有 (UN-DM1d) 需配 (ZS-S01d)
4. 有 (UN-DM1dR) 需配 (ZS-S01dR)
5. 有 (UN-SM1) 需配 (ZS-BG1)
6. 有 (UN-SM1R) 需配 (ZS-BG1R)

RESTRAINT SOCKET FOR 31F,38F,45F,50F

RESTRAINT SOCKET FOR 11F,18F,25F

B.D. REF :

CLIENT :
 信和置業有限公司
 Sino Land Company Limited

ARCHITECT :
 WONG TUNG & PARTNERS LIMITED
 ARCHITECTS & PLANNERS

MAIN CONTRACTOR :
 CR Construction Company Limited

STRUCTURAL ENGINEER :
 AECOM

FACADE CONSULTANT:
 AECOM

NOTE:
 1. ALL DIMENSIONS ARE IN mm.
 2. ALL ELEVATIONS ARE VIEWED FROM OUTSIDE.
 3. ALL DIMENSIONS TO BE VERIFIED ON SITE BEFORE FABRICATION.

LEGEND:
 DETAIL MARK NO.
 REFER SHEET NO.
 1. F.F.L. --- FINISHED FLOOR LEVEL
 2. S.F.L. --- STRUCTURAL FLOOR LEVEL
 3. (R) --- REVERSED DETAIL


| NO. | DATE | REVISION | BY |
|-----|------------|-----------------|----|
| E | 17/01/2019 | GENERAL REVISED | |
| D | 22/12/2018 | GENERAL REVISED | |
| C | 04/12/2018 | GENERAL REVISED | |
| B | 24/11/2018 | GENERAL REVISED | |
| A | 10/9/2018 | GENERAL REVISED | |

JOB NO. : J-837
 PROJECT :
 URA KWUN TONG TOWN CENTRE
 REDEVELOPMENT (AREA 2 & 3) AT
 NKIL 6514, KWUN TONG, KWLOON

TITLE :
 PART ELEVATION
 OF CURTAIN WALL
 AT TOWER 3

DATE : 04-JUL-18 SCALE : 1:60 (A1)
 DRAWN BY : ASING CHECKED BY : -

美特鋁質有限公司
 MIDI ALUMINIUM FABRICATOR LTD.
 Units 6-8, Sunray Industrial Centre, 1/F
 610 Cho Kwo Ling Road, Kowloon
 Tel:23489211-4 Fax:(852)2727666
 DWG NO. : J837-CW-2303 REV. : E

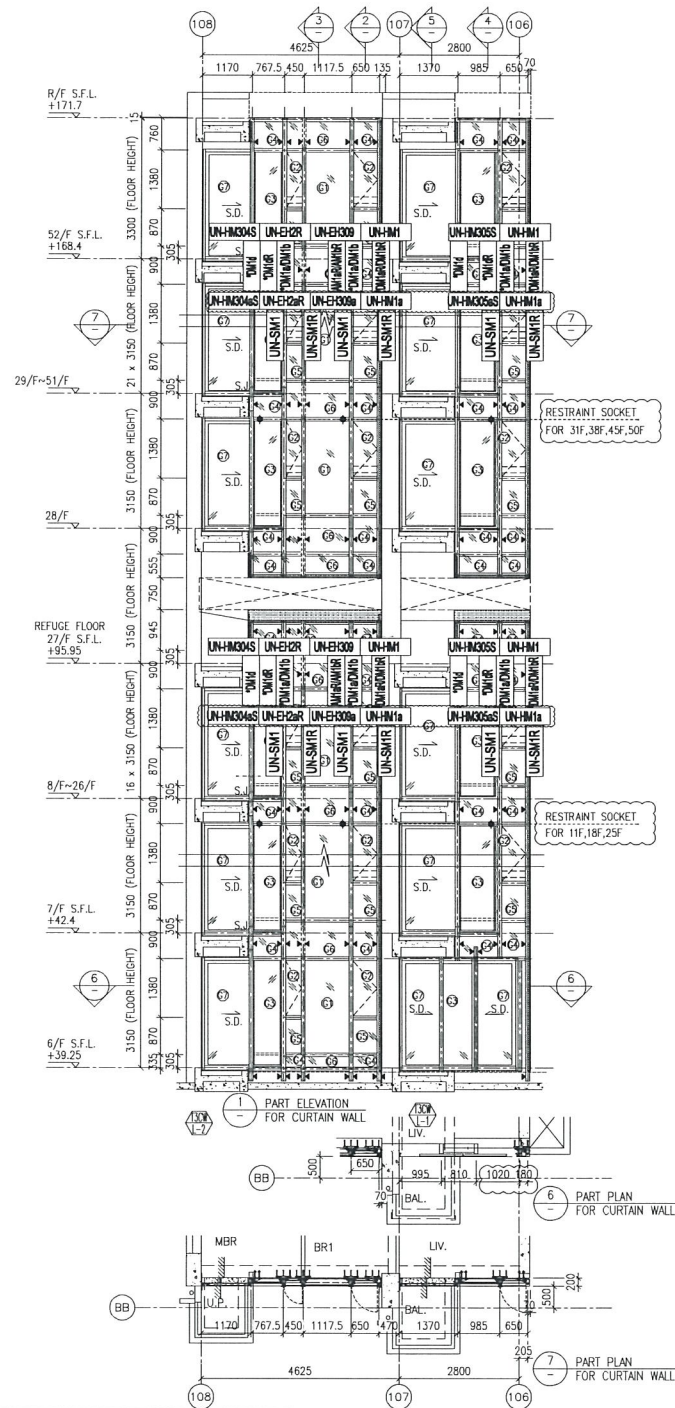

註明：因圖紙空間有限“*”代表UN-

1. 有 (UN-DM1a/UN-DM1b) 需配 (ZS-S01b)
2. 有 (UN-DM1aR/UN-DM1bR) 需配 (ZS-S01bR)
3. 有 (UN-DM1d) 需配 (ZS-S01d)
4. 有 (UN-DM1dR) 需配 (ZS-S01dR)
5. 有 (UN-SM1) 需配 (ZS-BG1)
6. 有 (UN-SM1R) 需配 (ZS-BG1R)

RESTRAINT SOCKET FOR 31F,38F,45F,50F

RESTRAINT SOCKET FOR 11F,18F,25F

B.D. REF :

CLIENT :
 信和置業有限公司
 Sino Land Company Limited

ARCHITECT :
 WONG TUNG & PARTNERS LIMITED
 ARCHITECTS & PLANNERS

MAIN CONTRACTOR :
 CR Construction Company Limited

STRUCTURAL ENGINEER :
 AECOM

FACADE CONSULTANT:
 AECOM

NOTE:
 1. ALL DIMENSIONS ARE IN mm.
 2. ALL ELEVATIONS ARE VIEWED FROM OUTSIDE.
 3. ALL DIMENSIONS TO BE VERIFIED ON SITE BEFORE FABRICATION.

LEGEND:
 X1 -- DETAIL MARK NO.
 X001 -- REFER SHEET NO.
 1. F.F.L. -- FINISHED FLOOR LEVEL
 2. S.F.L. -- STRUCTURAL FLOOR LEVEL
 3. (↔) -- REVERSED DETAIL


| NO. | DATE | REVISION | BY |
|-----|------------|-----------------|----|
| E | 17/01/2019 | GENERAL REVISED | |
| D | 22/12/2018 | GENERAL REVISED | |
| C | 04/12/2018 | GENERAL REVISED | |
| B | 24/11/2018 | GENERAL REVISED | |
| A | 10/9/2018 | GENERAL REVISED | |

JOB NO. : J-837
 PROJECT :
 URA KWUN TONG TOWN CENTRE
 REDEVELOPMENT (AREA 2 & 3) AT
 NKIL 6514, KWUN TONG, KWLOON

TITLE :
 PART ELEVATION
 OF CURTAIN WALL
 AT TOWER 3

DATE : 04-JUL-18 SCALE : 1:60 (A1)
 DRAWN BY : ASING CHECKED BY : -

英特鋁質有限公司
 MIDI ALUMINIUM FABRICATOR LTD.
 Units 6-8, Sunny Industrial Centre, 1/F
 610 Che Kwo Ling Road, Kowloon
 Tel:23489211-4 Fax:(852)27727666
 DWG NO. : J837-CW-2304 REV. : E

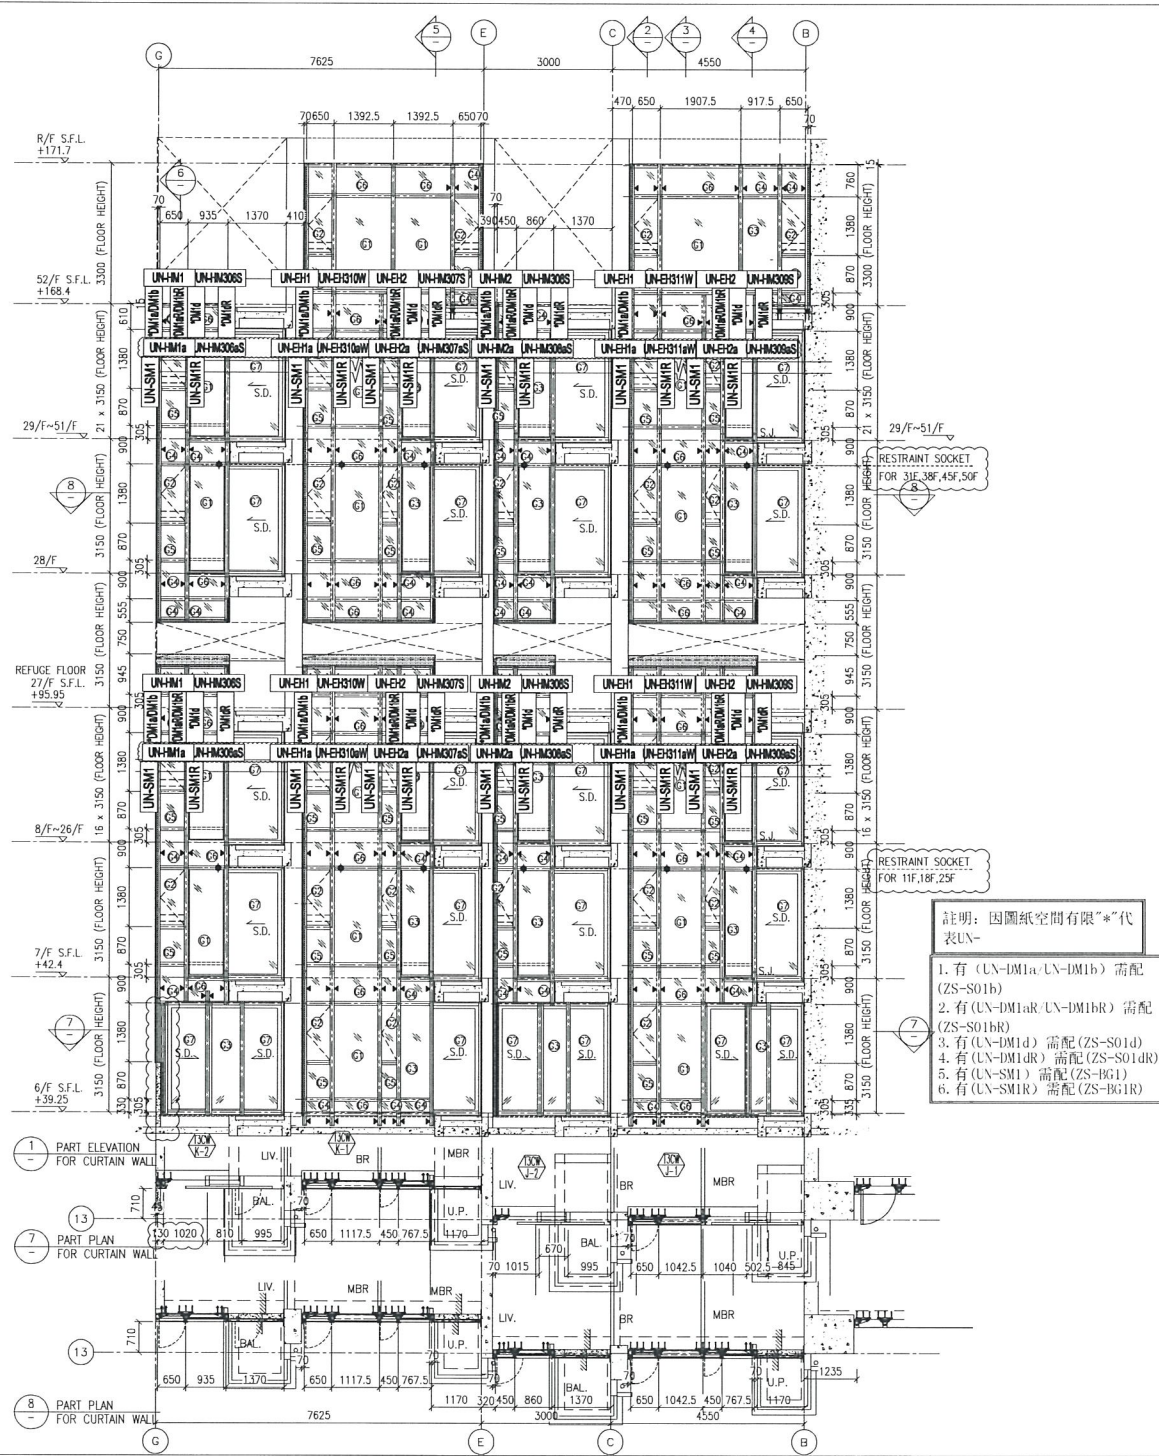

註明：因圖紙空間有限“*”代表UN-

1. 有 (UN-DM1a UN-DM1b) 需配 (ZS-S01b)
2. 有 (UN-DM1aR UN-DM1bR) 需配 (ZS-S01bR)
3. 有 (UN-DM1d) 需配 (ZS-S01d)
4. 有 (UN-DM1dR) 需配 (ZS-S01dR)
5. 有 (UN-SM1) 需配 (ZS-BG1)
6. 有 (UN-SM1R) 需配 (ZS-BG1R)

B.D. REF :

CLIENT :
 Sino Land Company Limited

ARCHITECT :
 WONG TUNG & PARTNERS LIMITED ARCHITECTS & PLANNERS

MAIN CONTRACTOR :
 CR Construction Company Limited

STRUCTURAL ENGINEER :
 AECOM

FACADE CONSULTANT :
 AECOM

NOTE :
 1. ALL DIMENSIONS ARE IN mm.
 2. ALL ELEVATIONS ARE VIEWED FROM OUTSIDE.
 3. ALL DIMENSIONS TO BE VERIFIED ON SITE BEFORE FABRICATION.

LEGEND :
 DETAIL MARK NO. REFER SHEET NO.
 1. F.F.L. — FINISHED FLOOR LEVEL
 2. S.F.L. — STRUCTURAL FLOOR LEVEL
 3. (R) — REVERSED DETAIL



| NO. | DATE | REVISED | BY |
|-----|------------|-----------------|----|
| E | 17/01/2019 | GENERAL REVISED | |
| D | 22/12/2018 | GENERAL REVISED | |
| C | 04/12/2018 | GENERAL REVISED | |
| B | 24/11/2018 | GENERAL REVISED | |
| A | 10/9/2018 | GENERAL REVISED | |

JOB NO. : J-837
 PROJECT :
 URA KWUN TONG TOWN CENTRE REDEVELOPMENT (AREA 2 & 3) AT NKIL 6514, KWUN TONG, KWLOON

TITLE :
 PART ELEVATION OF CURTAIN WALL AT TOWER 3

DATE : 04-JUL-18 SCALE : 1:60 (A1)
 DRAWN BY : ASING CHECKED BY : -

美特鋁質有限公司
 MIDI ALUMINIUM FABRICATOR LTD.
 Units 5-8, Sunray Industrial Centre, 1/F
 610 Cha Kwo Ling Road, Kowloon
 Tel: 23489211-4 Fax: (852) 27276666
 DWG NO. : JB37-CW-2305 REV. : E

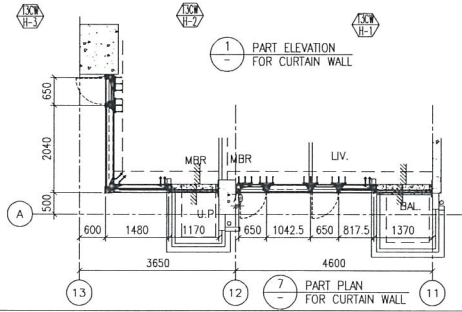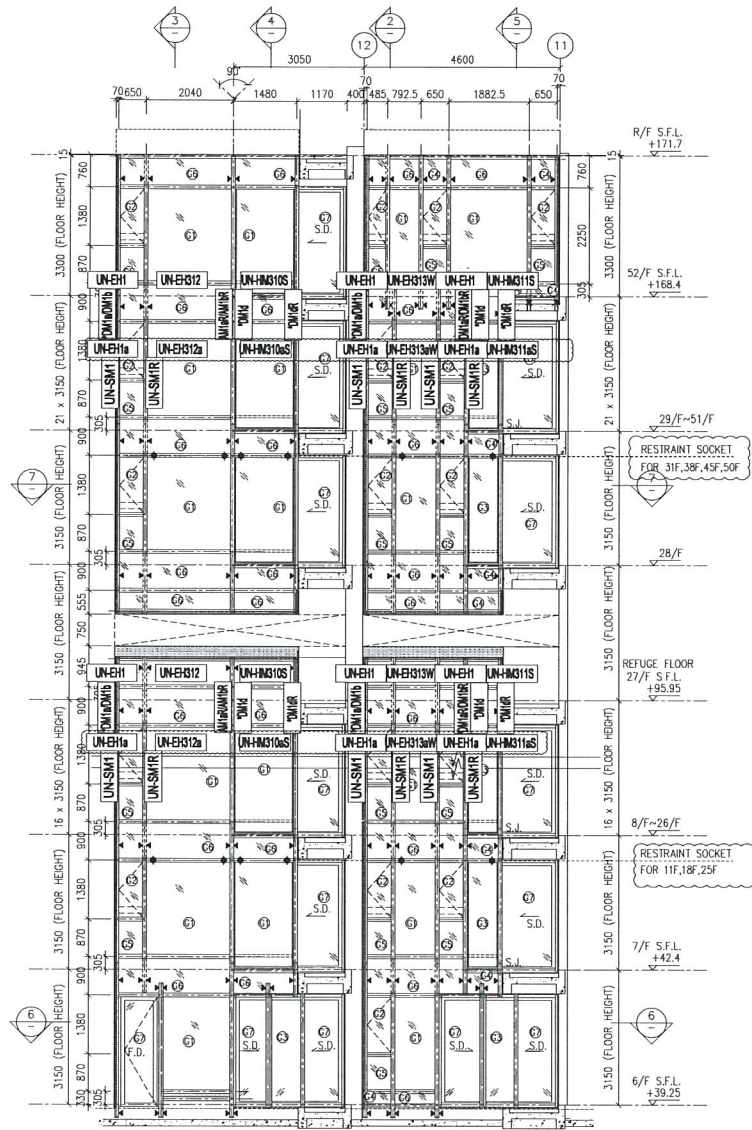

- 註明：因圖紙空間有限“*”代表U-
1. 有 (UX-DM1a/UX-DM1b) 需配 (ZS-S01b)
 2. 有 (UX-DM1aR/UX-DM1bR) 需配 (ZS-S01bR)
 3. 有 (UX-DM1d) 需配 (ZS-S01d)
 4. 有 (UX-DM1dR) 需配 (ZS-S01dR)
 5. 有 (UX-SM1) 需配 (ZS-BG1)
 6. 有 (UX-SM1R) 需配 (ZS-BG1R)

B.D. REF :

CLIENT :
 信和置業有限公司
 Sino Land Company Limited

ARCHITECT :
 WONG TUNG & PARTNERS LIMITED
 ARCHITECTS & PLANNERS

MAIN CONTRACTOR :
 CR Construction Company Limited

STRUCTURAL ENGINEER :
 ACOM

FACADE CONSULTANT:
 ACOM

NOTE :
 1. ALL DIMENSIONS ARE IN mm.
 2. ALL ELEVATIONS ARE VIEWED FROM OUTSIDE.
 3. ALL DIMENSIONS TO BE VERIFIED ON SITE BEFORE FABRICATION.

LEGEND :
 X1 -- DETAIL MARK NO.
 X001 -- REFER SHEET NO.

1. F.F.L. -- FINISHED FLOOR LEVEL
2. S.F.L. -- STRUCTURAL FLOOR LEVEL
3. (R) -- REVERSED DETAIL

| NO. | DATE | REVISION | BY |
|-----|------------|-----------------|----|
| E | 22/12/2018 | GENERAL REVISED | |
| D | 22/12/2018 | GENERAL REVISED | |
| C | 04/12/2018 | GENERAL REVISED | |
| B | 24/11/2018 | GENERAL REVISED | |
| A | 10/9/2018 | GENERAL REVISED | |

JOB NO. : J-837

PROJECT :
 URA KWUN TONG TOWN CENTRE
 REDEVELOPMENT (AREA 2 & 3) AT
 NKIL 6514, KWUN TONG, KWLOON


TITLE :
 PART ELEVATION
 OF CURTAIN WALL
 AT TOWER 3

DATE : 04-JUL-18 SCALE : 1:60 (A1)

DRAWN BY : ASING CHECKED BY : -

美特鋁質有限公司
 ALUMINIUM FABRICATOR LTD.
 Units 6-8, Sunray Industrial Centre, 1/F
 610 Cha Kwo Ling Road, Kowloon
 Tel:23489211-4 Fax:(852)27727666

DWG NO. : J837-CW-2306 REV. : E

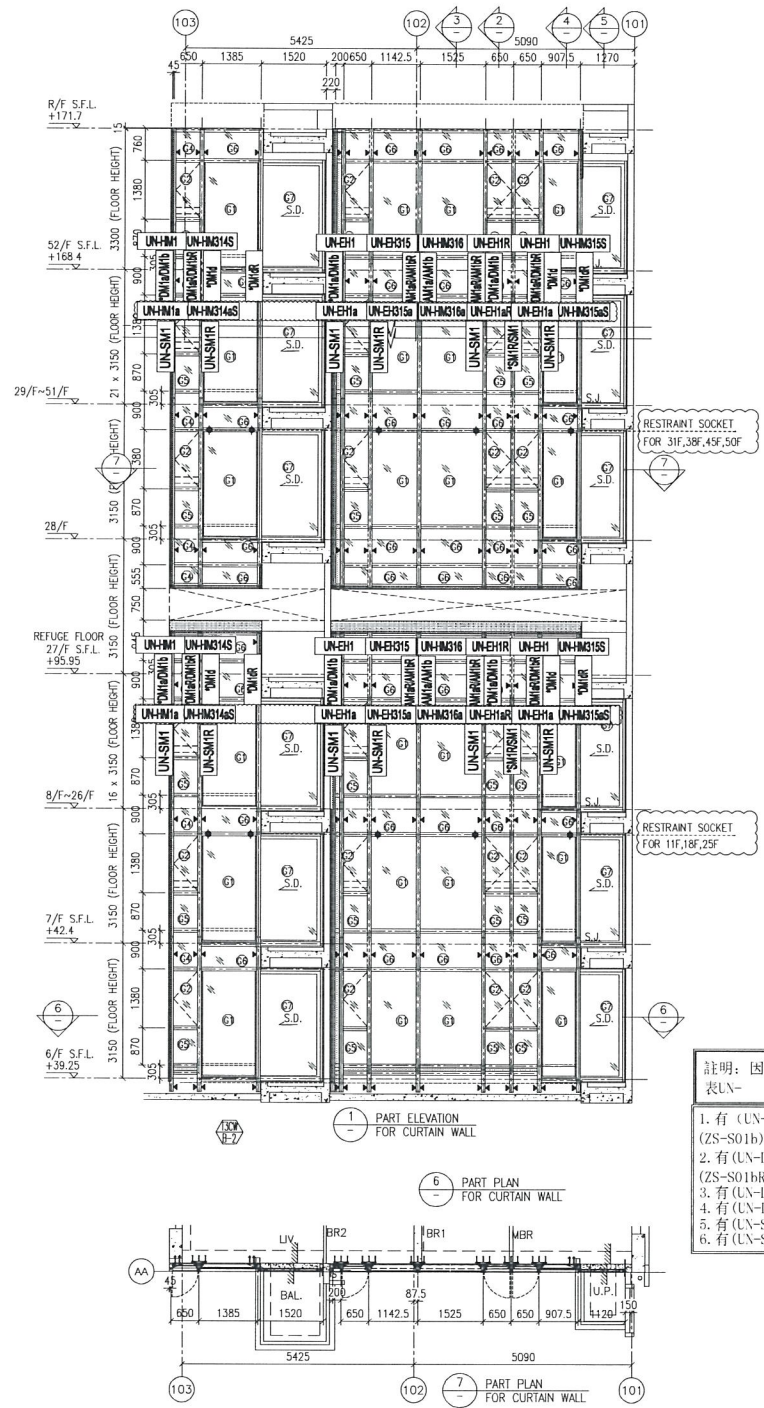

註明：因圖紙空間有限“*”代表UX-

1. 有 (UX-DM1a/UX-DM1b) 需配 (ZS-S01b)
2. 有 (UX-DM1aR/UX-DM1bR) 需配 (ZS-S01bR)
3. 有 (UX-DM1d) 需配 (ZS-S01d)
4. 有 (UX-DM1dR) 需配 (ZS-S01dR)
5. 有 (UX-SM1) 需配 (ZS-BG1)
6. 有 (UX-SM1R) 需配 (ZS-BG1R)

B.D. REF :

CLIENT :
 信和置業有限公司
 Sino Land Company Limited

ARCHITECT :
 WONG TUNG & PARTNERS LIMITED
 ARCHITECTS & PLANNERS

MAIN CONTRACTOR :
 CR Construction Company Limited

STRUCTURAL ENGINEER :
 AECOM

FACADE CONSULTANT:
 AECOM

NOTE :
 1. ALL DIMENSIONS ARE IN mm.
 2. ALL ELEVATIONS ARE VIEWED FROM OUTSIDE.
 3. ALL DIMENSIONS TO BE VERIFIED ON SITE BEFORE FABRICATION.

LEGEND :
 X1 — DETAIL MARK NO.
 X001 — REFER SHEET NO.
 1. F.F.L. — FINISHED FLOOR LEVEL
 2. S.F.L. — STRUCTURAL FLOOR LEVEL
 3. (7R) — REVERSED DETAIL


| NO. | DATE | REVISED | BY |
|-----|------------|-----------------|----|
| E | 17/01/2019 | GENERAL REVISED | |
| D | 22/12/2018 | GENERAL REVISED | |
| C | 04/12/2018 | GENERAL REVISED | |
| B | 24/11/2018 | GENERAL REVISED | |
| A | 10/9/2018 | GENERAL REVISED | |

JOB NO. : J-837
 PROJECT :
 URA KWUN TONG TOWN CENTRE
 REDEVELOPMENT (AREA 2 & 3) AT
 NKIL 6514, KWUN TONG, KWLOON

TITLE :
 PART ELEVATION
 OF CURTAIN WALL
 AT TOWER 3

DATE : 04-JUL-18 SCALE : 1:60 (A1)
 DRAWN BY : ASING CHECKED BY : -

美特鋁質有限公司
 MIDI ALUMINUM FABRICATOR LTD.
 Units 6-8, Sunray Industrial Centre, 1/F
 610 Cho Kwo Ling Road, Kowloon
 Tel:23489211-4 Fax:(852)27727666
 DWG NO. : JB37-CW-2308 REV. : E

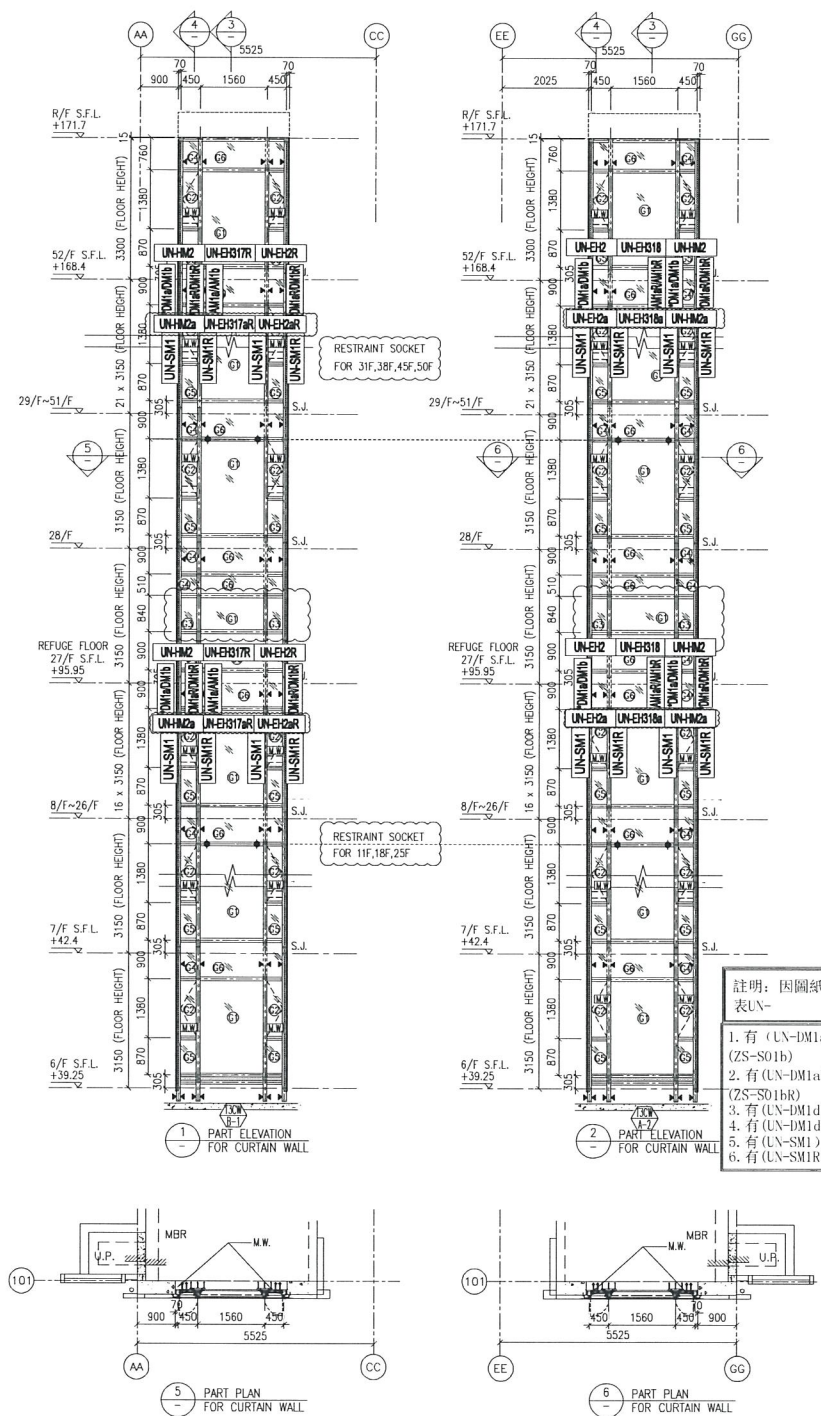

註明：因圖紙空間有限“*”代表UN-

1. 有 (UN-DM1a/UN-DM1b) 需配 (ZS-S01b)
2. 有 (UN-DM1aR, UN-DM1bR) 需配 (ZS-S01bR)
3. 有 (UN-DM1d) 需配 (ZS-S01d)
4. 有 (UN-DM1dR) 需配 (ZS-S01dR)
5. 有 (UN-SM1) 需配 (ZS-BG1)
6. 有 (UN-SM1R) 需配 (ZS-BG1R)

B.D. REF :

CLIENT :
 信和置業有限公司
 Sino Land Company Limited

ARCHITECT :
 WONG TUNG & PARTNERS LIMITED
 ARCHITECTS & PLANNERS

MAIN CONTRACTOR :
 CR Construction Company Limited

STRUCTURAL ENGINEER :
 AECOM

FACADE CONSULTANT :
 AECOM

NOTE :
 1. ALL DIMENSIONS ARE IN mm.
 2. ALL ELEVATIONS ARE VIEWED FROM OUTSIDE.
 3. ALL DIMENSIONS TO BE VERIFIED ON SITE BEFORE FABRICATION.

LEGEND :
 X1 -- DETAIL MARK NO.
 X001 -- REFER SHEET NO.

1. F.F.L. -- FINISHED FLOOR LEVEL
2. S.F.L. -- STRUCTURAL FLOOR LEVEL
3. (R) -- REVERSED DETAIL

| NO. | DATE | REVISED | BY |
|-----|------------|-----------------|----|
| E | 17/01/2019 | GENERAL REVISED | |
| D | 22/12/2018 | GENERAL REVISED | |
| C | 04/12/2018 | GENERAL REVISED | |
| B | 24/11/2018 | GENERAL REVISED | |
| A | 10/9/2018 | GENERAL REVISED | |

JOB NO. : J-837

PROJECT :
 URA KWUN TONG TOWN CENTRE
 REDEVELOPMENT (AREA 2 & 3) AT
 NKIL 6514, KWUN TONG, KWLOON


TITLE :
 PART ELEVATION
 OF CURTAIN WALL
 AT TOWER 3

DATE : 04-JUL-18 SCALE : 1:60 (A1)


DRAWN BY : ASING CHECKED BY : -

美特鋁質有限公司
 MIDI ALUMINUM FABRICATOR LTD.
 Units 6-8, Sunray Industrial Centre, 1/F
 610 Cha Kwo Ling Road, Kowloon
 Tel:23489211-4 Fax:(852)2727666

DWG NO. : J837-CW-2309 REV. : E

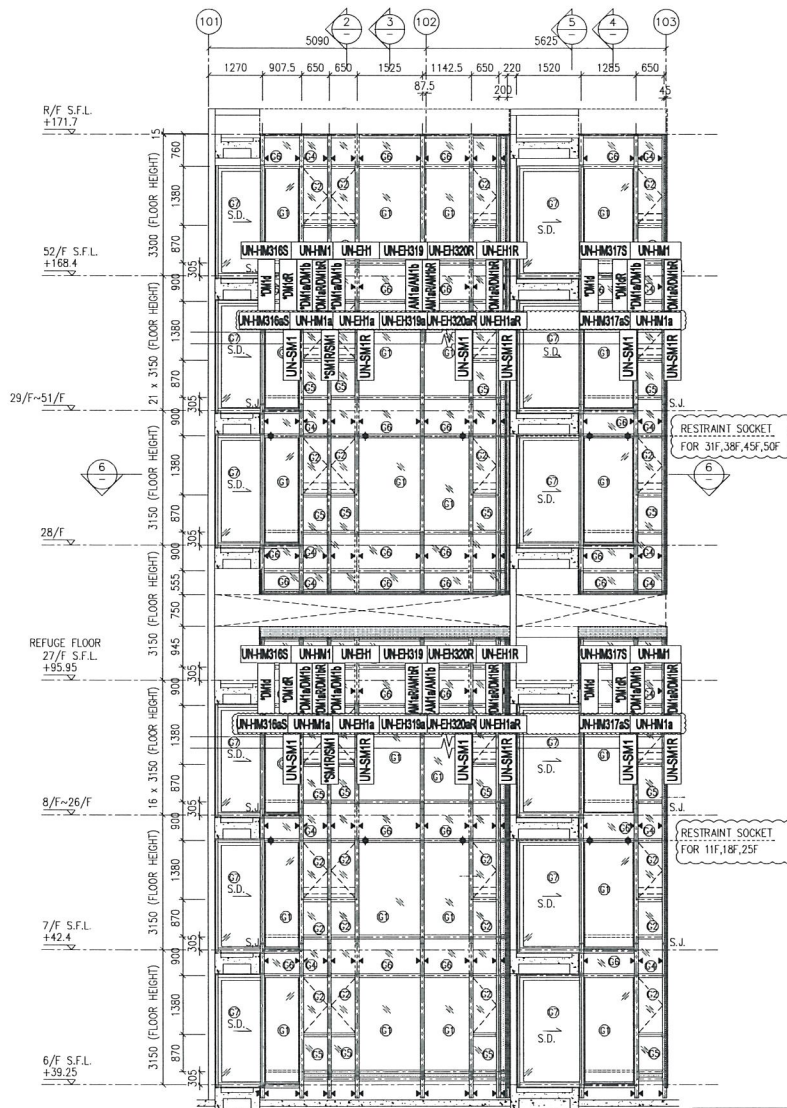

1 PART ELEVATION FOR CURTAIN WALL

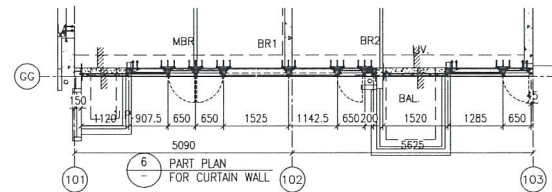

6 PART PLAN FOR CURTAIN WALL

註明：因圖紙空間有限*代表UN-

1. 有 (UN-DM1a/UN-DM1b) 需配 (ZS-S01b)
2. 有 (UN-DM1aR/UN-DM1bR) 需配 (ZS-S01bR)
3. 有 (UN-DM1d) 需配 (ZS-S01d)
4. 有 (UN-DM1dR) 需配 (ZS-S01dR)
5. 有 (UN-SM1) 需配 (ZS-BG1)
6. 有 (UN-SM1R) 需配 (ZS-BG1R)

B.D. REF :

CLIENT : 信和置業有限公司 Sino Land Company Limited

ARCHITECT : WONG TUNG & PARTNERS LIMITED ARCHITECTS & PLANNERS

MAIN CONTRACTOR : CR Construction Company Limited

STRUCTURAL ENGINEER : ACOM

FACADE CONSULTANT : ACOM

NOTE :

1. ALL DIMENSIONS ARE IN mm.
2. ALL ELEVATIONS ARE VIEWED FROM OUTSIDE.
3. ALL DIMENSIONS TO BE VERIFIED ON SITE BEFORE FABRICATION.

LEGEND :

X1 -- DETAIL MARK NO.
X001 -- REFER SHEET NO.

1. F.F.L. -- FINISHED FLOOR LEVEL
2. S.F.L. -- STRUCTURAL FLOOR LEVEL
3. (R) -- REVERSED DETAIL

| NO. | DATE | REVISED | BY |
|-----|------------|-----------------|----|
| E | 17/01/2019 | GENERAL REVISED | |
| D | 22/12/2018 | GENERAL REVISED | |
| C | 04/12/2018 | GENERAL REVISED | |
| B | 24/11/2018 | GENERAL REVISED | |
| A | 10/9/2018 | GENERAL REVISED | |

JOB NO. : J-837

PROJECT : URA KWUN TONG TOWN CENTRE REDEVELOPMENT (AREA 2 & 3) AT NKIL 6514, KWUN TONG, KWLOON


TITLE : PART ELEVATION OF CURTAIN WALL AT TOWER 3

DATE : 04-JUL-18 SCALE : 1:60 (A1)

DRAWN BY : ASING CHECKED BY : -


美特鋁質有限公司 MIDY ALUMINIUM FABRICATOR LTD.
Units 6-8, Sunray Industrial Centre, 1/F
610 Cha Kwo Ling Road, Kowloon
Tel:23489211-4 Fax:(852)2727666

DWG NO. : J837-CW-2310 REV. : E

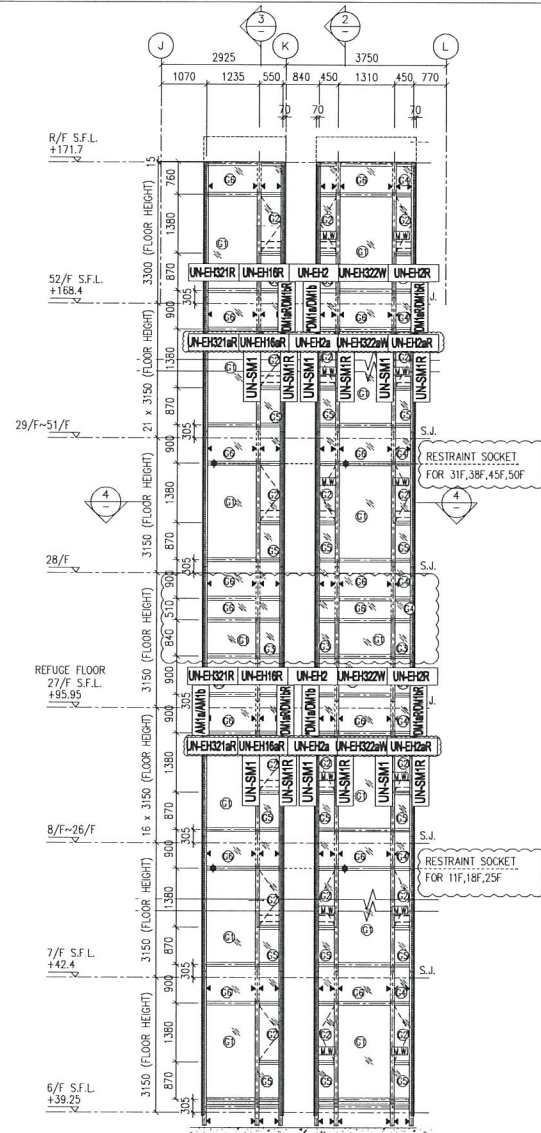

註明：因圖紙空間有限*代表UN-

1. 有 (UN-DM1a, UN-DM1b) 需配 (ZS-S01b)
2. 有 (UN-DM1aR, UN-DM1bR) 需配 (ZS-S01bR)
3. 有 (UN-DM1d) 需配 (ZS-S01d)
4. 有 (UN-DM1dR) 需配 (ZS-S01dR)
5. 有 (UN-SM1) 需配 (ZS-BG1)
6. 有 (UN-SM1R) 需配 (ZS-BG1R)

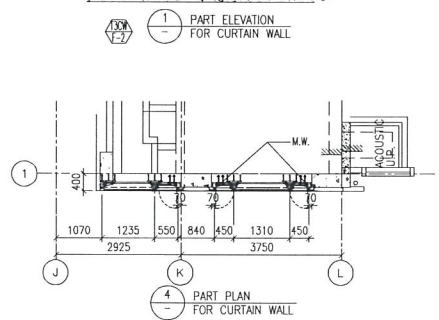

B.D. REF :

CLIENT :
 Sino Land Company Limited

ARCHITECT :
 WONG TUNG & PARTNERS LIMITED
 ARCHITECTS & PLANNERS

MAIN CONTRACTOR :
 CR Construction Company Limited

STRUCTURAL ENGINEER :
 AICOM

FACADE CONSULTANT:
 AICOM

NOTE :
 1. ALL DIMENSIONS ARE IN mm.
 2. ALL ELEVATIONS ARE VIEWED FROM OUTSIDE.
 3. ALL DIMENSIONS TO BE VERIFIED ON SITE BEFORE FABRICATION.

LEGEND :
 X1 -- DETAIL MARK NO.
 X001 -- REFER SHEET NO.
 1. F.F.L -- FINISHED FLOOR LEVEL
 2. S.F.L -- STRUCTURAL FLOOR LEVEL
 3. (R) -- REVERSED DETAIL

| NO. | DATE | REVISED | BY |
|-----|------------|-----------------|----|
| E | 17/01/2019 | GENERAL REVISED | |
| D | 22/12/2018 | GENERAL REVISED | |
| C | 04/12/2018 | GENERAL REVISED | |
| B | 24/11/2018 | GENERAL REVISED | |
| A | 10/9/2018 | GENERAL REVISED | |

JOB NO. : J-837
 PROJECT :
 URA KWUN TONG TOWN CENTRE
 REDEVELOPMENT (AREA 2 & 3) AT
 NKIL 6514, KWUN TONG, KWLOON

TITLE :
 PART ELEVATION
 OF CURTAIN WALL
 AT TOWER 3

DATE : 04-JUL-18 SCALE : 1:60 (A1)
 DRAWN BY : ASING CHECKED BY : -

美特鋁質有限公司
 MIDI ALUMINIUM FABRICATOR LTD.
 Units 6-8, Sunroy Industrial Centre, 1/F
 610 Cha Kwo Ling Road, Kowloon
 Tel:23489211-4 Fax:(852)2727666
 DWG NO. : J837-CW-2312 REV. : E