



工程指示 / 要求簡箋(E.I.)

工程指示編號：EI / 0222 / 19

修改版次：以此為準

工程編號：J - 837

工程名稱：觀塘裕民坊

工程項目：幕牆 - 安裝玻璃前和後的方案+副框

收件人：炳哥和各判頭

發件人：Erik Kong

日期：15/02/2019

要求提供 / 確認 事項：

- |                                    |                                     |                               |
|------------------------------------|-------------------------------------|-------------------------------|
| <input type="checkbox"/> 初步鋁料 B.M. | <input type="checkbox"/> 加工拆圖，然後生產  | <input type="checkbox"/> 尺寸表  |
| <input type="checkbox"/> 正式鋁料 B.M. | <input type="checkbox"/> 技術上資料 / 指示 | <input type="checkbox"/> 報價   |
| <input type="checkbox"/> 配件 B.M.   | <input type="checkbox"/> 樣辦或貨品說明書   | <input type="checkbox"/> 分判合約 |
| <input type="checkbox"/> 其他：_____  |                                     |                               |

內容：

請提供附件(安裝玻璃前和後的方案)給各鋁質安裝判頭(步驟 1,3)和玻璃安裝判頭(步驟 2)  
另有 2 頁提供鋁質安裝判頭有關副框事宜

謝謝!

請在 02/20/2019 前完成上列要求。

附：9 頁

以上項目為：

- 原合約工程包                       原合約工程加 / 減賬                       新工程報價

原因：-

分發東莞各部門：


- ( )生產技術總監 連附件    ( )技術部    連附件 永林    ( )生產部    連附件    ( )機械設計部 連附件  
( )採購部    連附件    ( )生產統籌部 連附件 梅姐  
( )質檢部    連附件    ( )會計部    連附件    ( )報關組    連附件    ( )其他 \_\_\_\_\_ 連附件


分發香港各部門：

- ( )行政部 連附件    ( )會計部 連附件    ( )統籌部 連附件    (✓)工程部地盤科文 連附件 炳哥  
( )採購部 連附件    ( )QS 部    連附件    ( )維修部 連附件    ( )其他 \_\_\_\_\_ 連附件

傳遞編號： **HK / 19**

發件人簽署：

項目經理簽署：

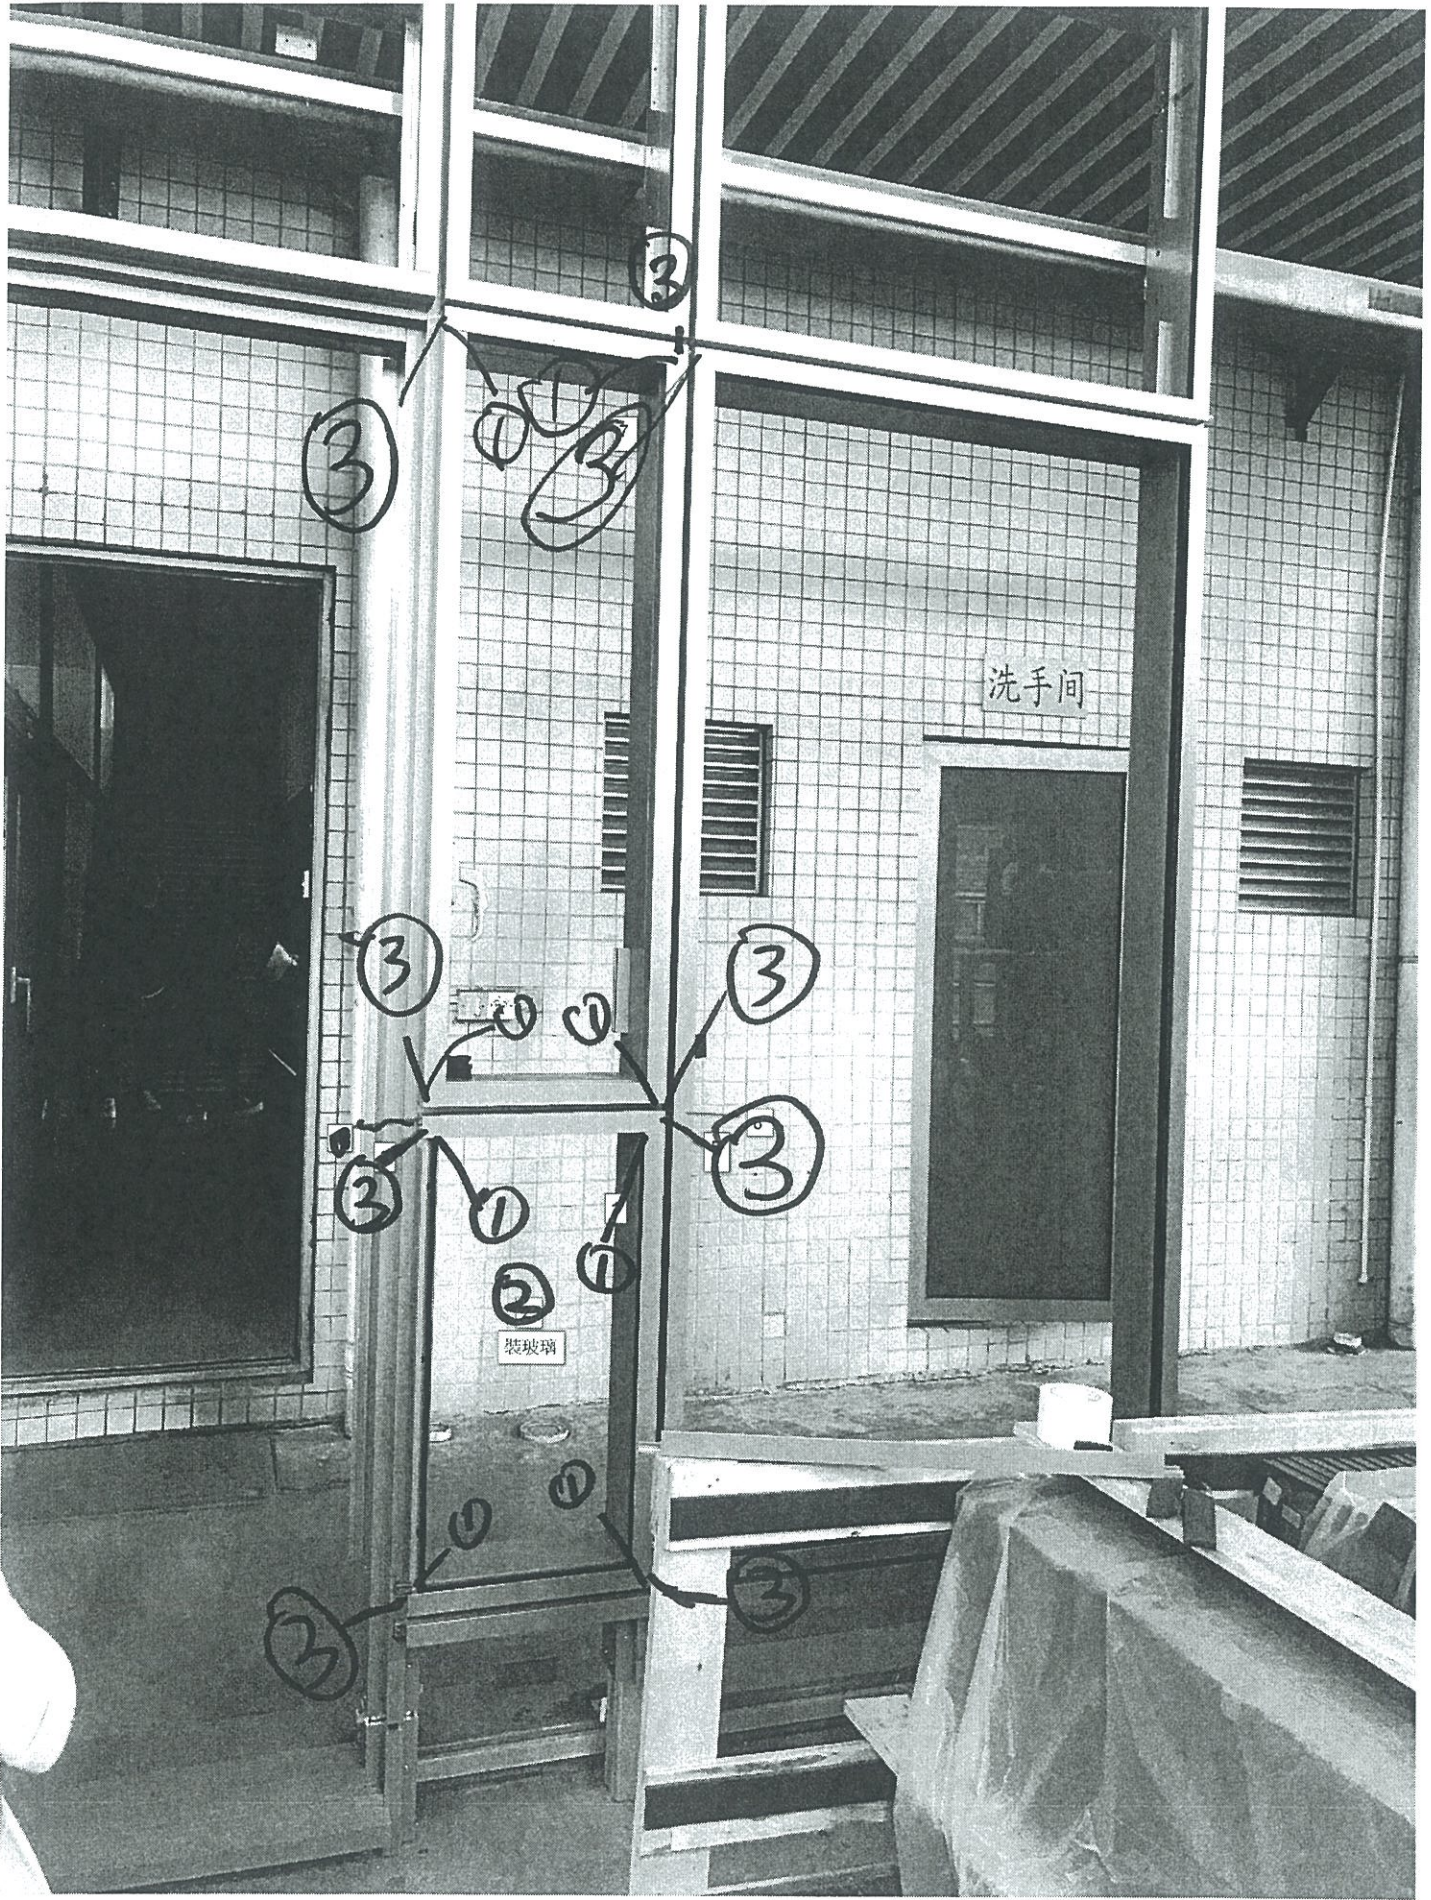


步驟 1 女唧膠拉手 (鉛質做)






# 步驟 2

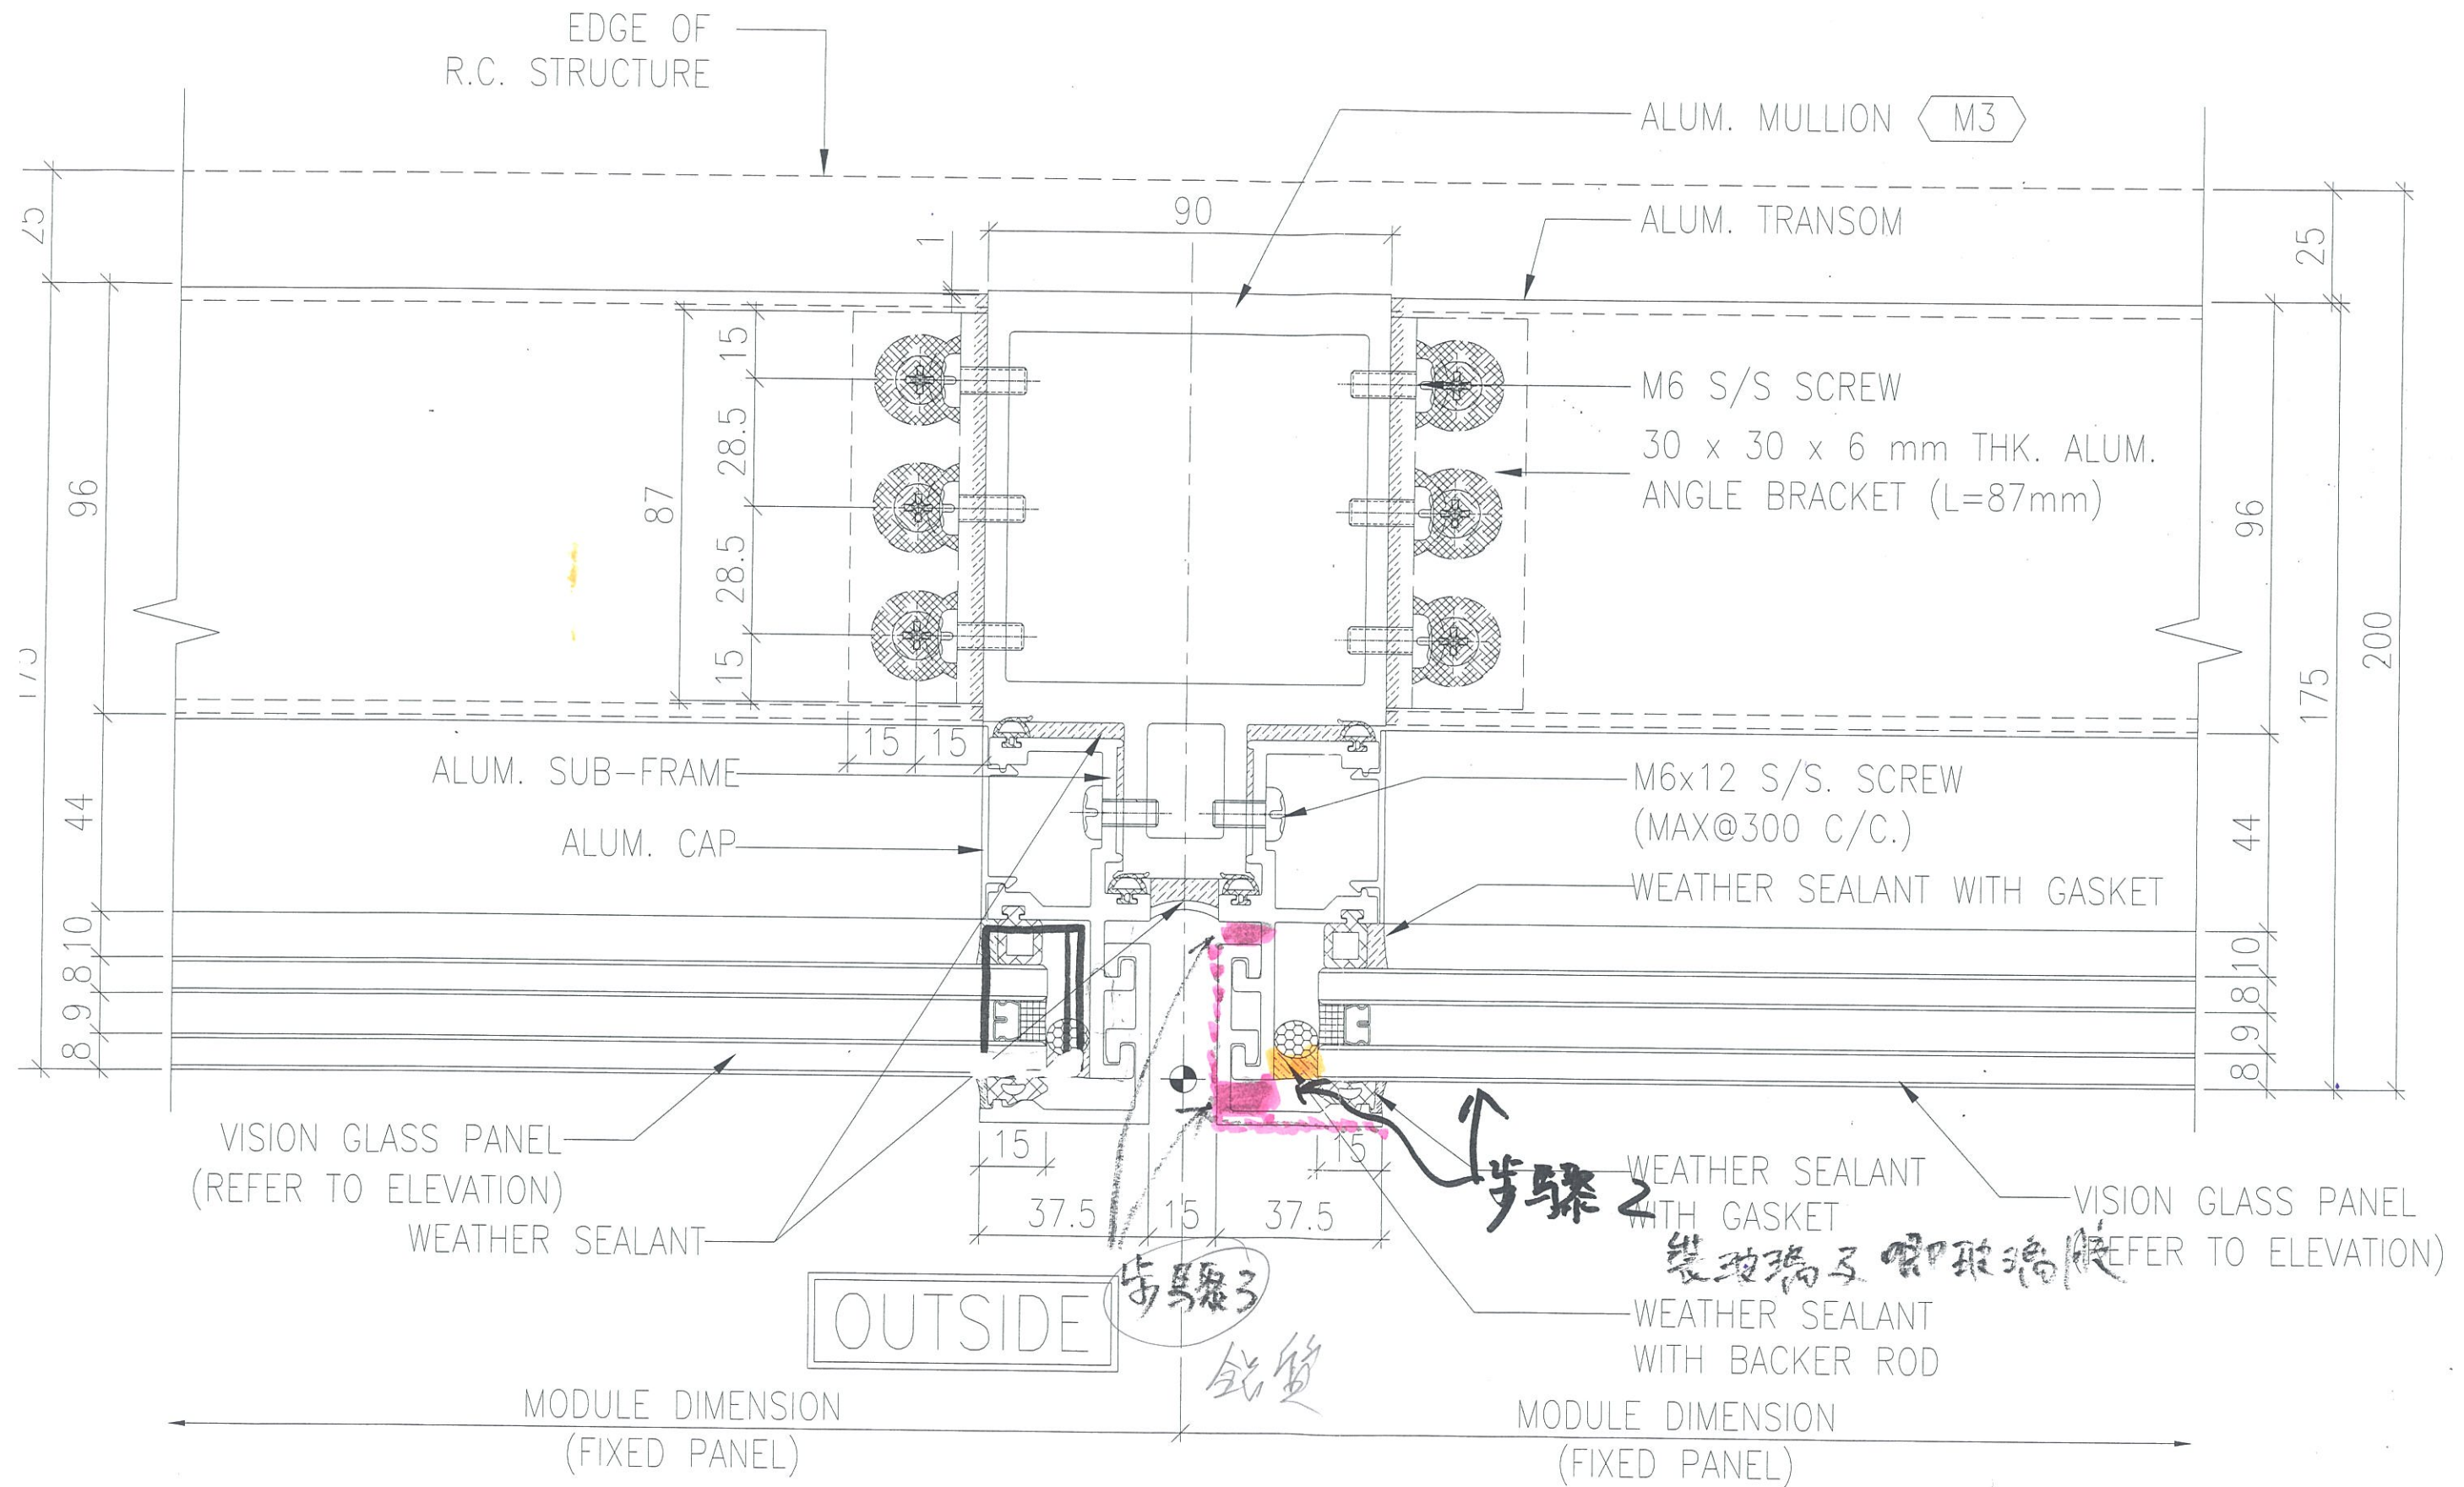

步驟

3  
(左)


打少量膠，方便日後如需要換玻璃蓋  
能把色線蓋轉易輕拆除

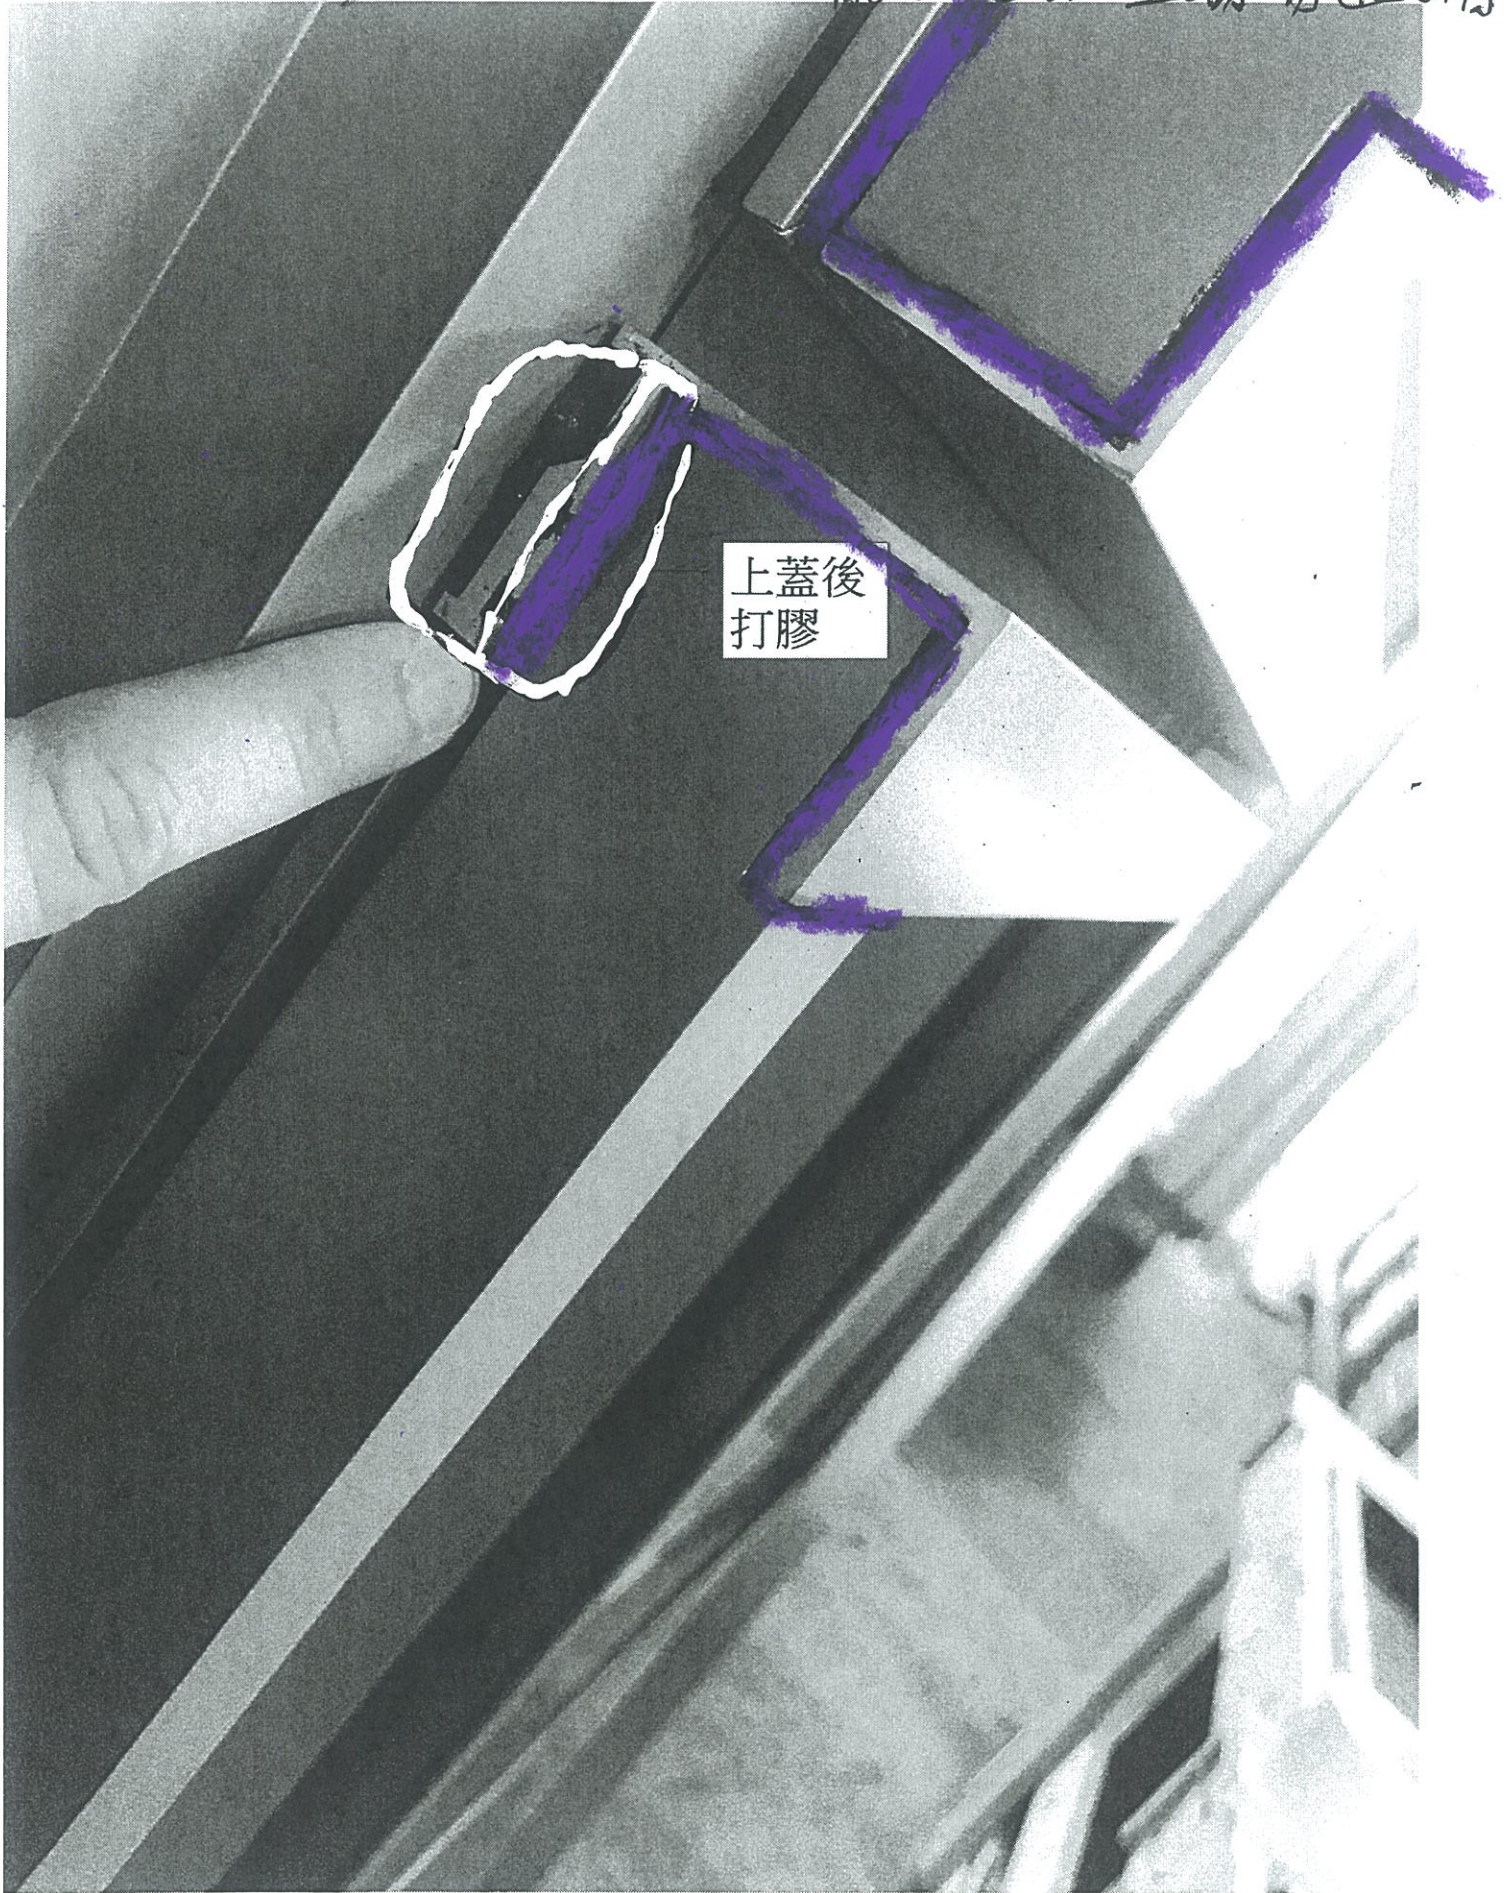


上蓋後  
打膠

步驟 3


(右)

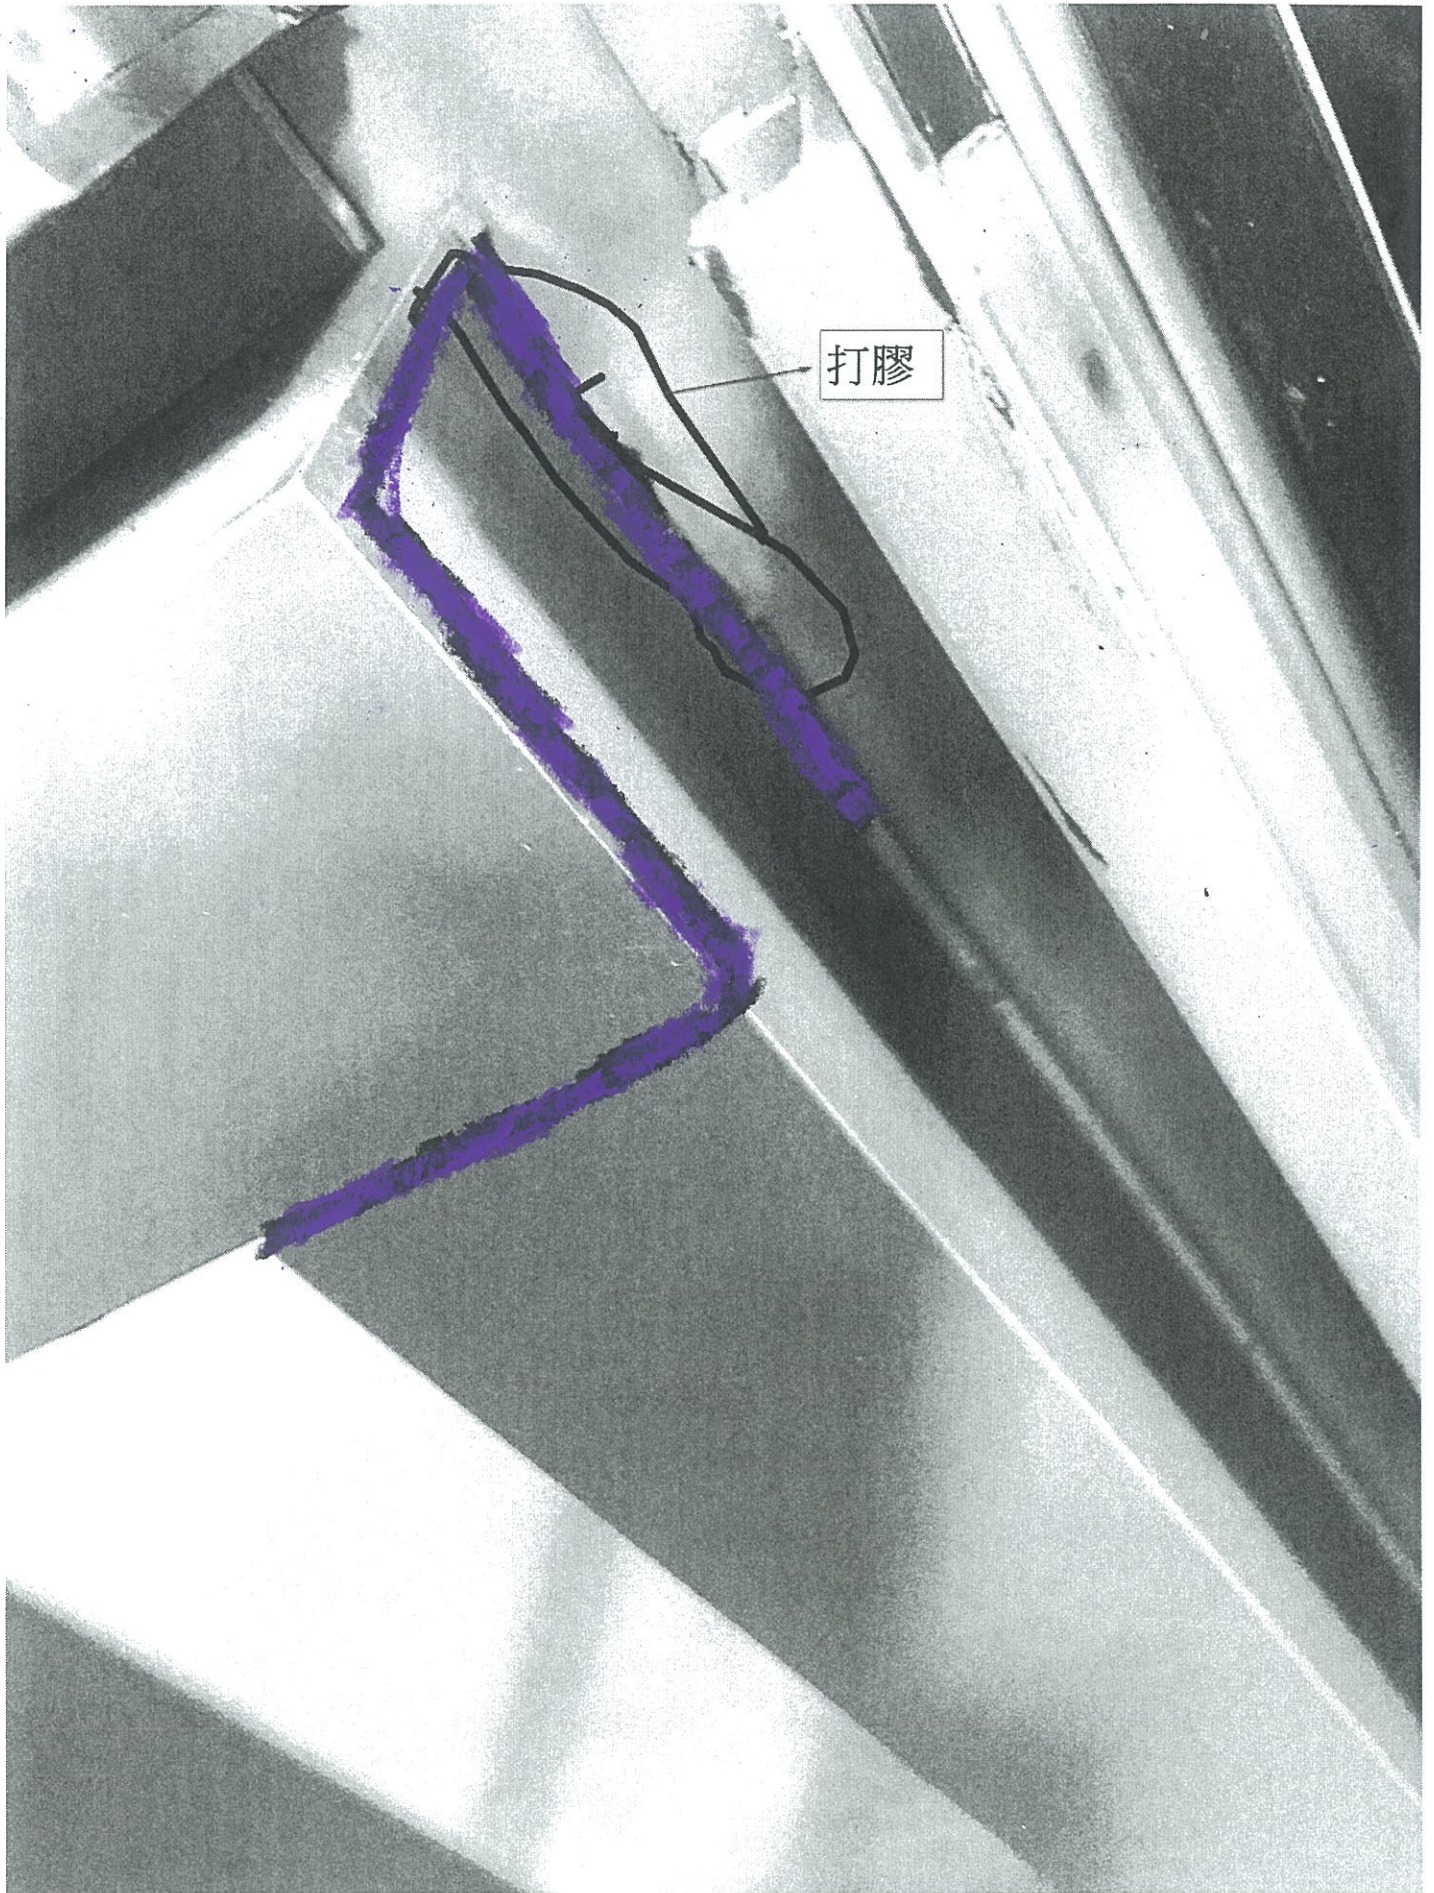

步馬聚 子 樓頂

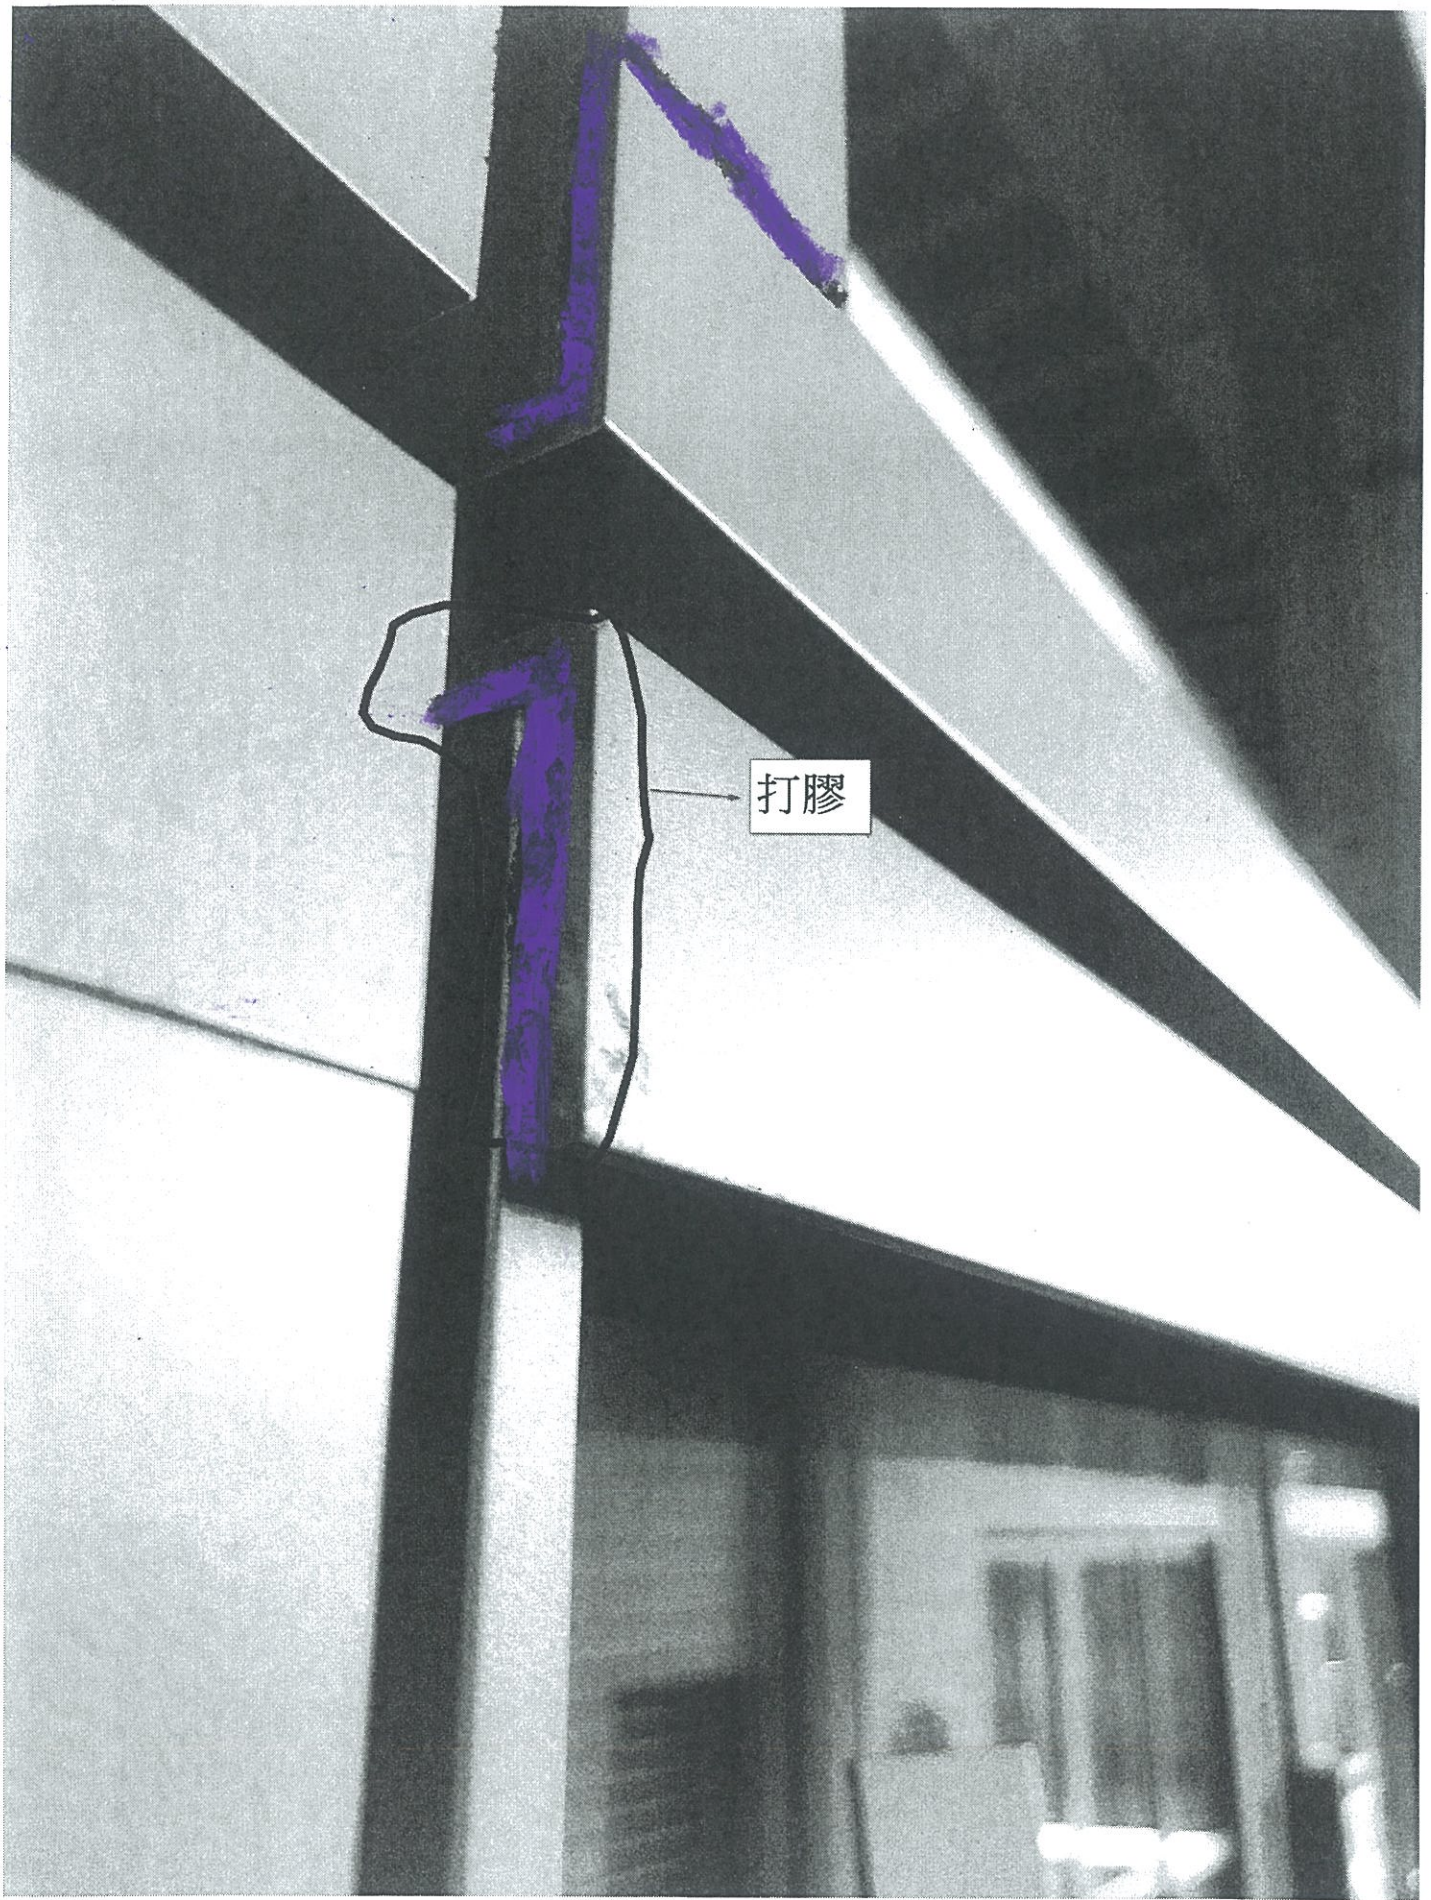

副框(鉛質)

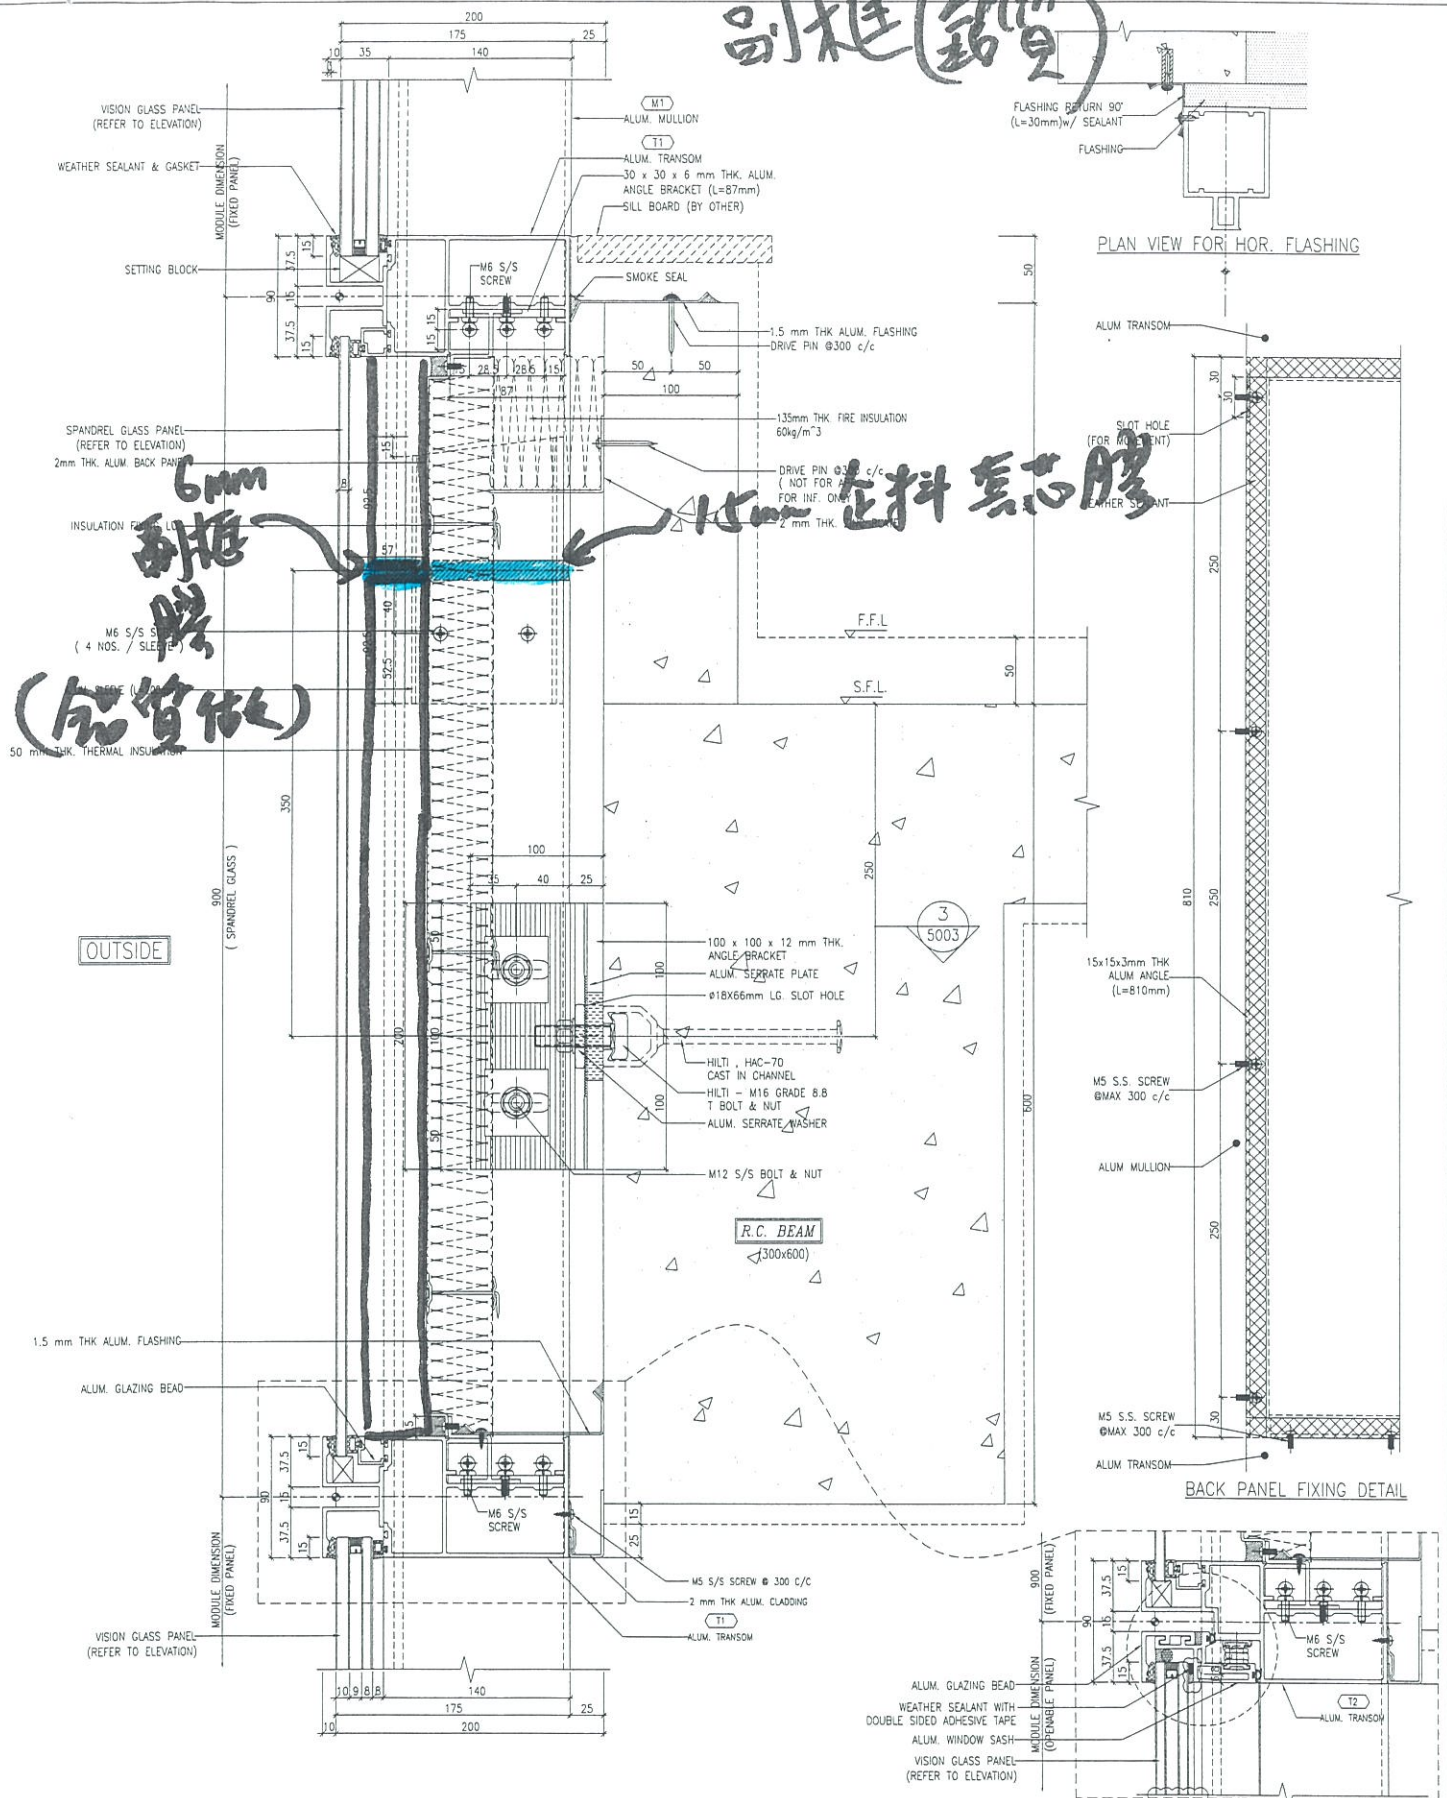

1 6002 TYPICAL TRANSOM DETAIL CURTAIN WALL

2 6002 TYPICAL TRANSOM DETAIL CURTAIN WALL

<p>DATE: 13-JUL-18 SCALE: 1:2 (A1) DRAWN BY: ASING CHECKED BY: -</p>	<p>TITLE: TYPICAL TRANSOM DETAIL FOR CURTAIN WALL</p>	<p>PROJECT: URA KWUN TONG TOWN CENTRE REDEVELOPMENT (AREA 2 &amp; 3) PHASE 1A, KWUN TONG, Kowloon</p>	<p>JOB NO.: J-837</p>	<p>REVISIONS:</p> <table border="1"> <tr> <th>NO.</th> <th>DATE</th> <th>DESCRIPTION</th> </tr> <tr> <td>D</td> <td>22/12/2018</td> <td>GENERAL REVISED</td> </tr> <tr> <td>C</td> <td>04/12/2018</td> <td>GENERAL REVISED</td> </tr> <tr> <td>B</td> <td>24/11/2018</td> <td>GENERAL REVISED</td> </tr> <tr> <td>A</td> <td>10/09/2018</td> <td>GENERAL REVISED</td> </tr> </table>	NO.	DATE	DESCRIPTION	D	22/12/2018	GENERAL REVISED	C	04/12/2018	GENERAL REVISED	B	24/11/2018	GENERAL REVISED	A	10/09/2018	GENERAL REVISED	<p>NOTE:</p> <ol style="list-style-type: none"> <li>ALL DIMENSIONS ARE IN mm.</li> <li>ALL DIMENSIONS ARE VIEWED FROM OUTSIDE UNLESS SPECIFIED OTHERWISE.</li> <li>ALL DIMENSIONS TO BE TOLERANCED ON SITE BEFORE FABRICATION.</li> </ol> <p>LEGEND:</p> <p>(A) DETAIL MARK NO. (S) REFER SHEET NO. (M) REVERSED DETAIL</p>	<p>CLIENT: 信和置業有限公司 Sino Land Company Limited</p> <p>ARCHITECT: HONG TUNG &amp; PARTNERS LIMITED ARCHITECTS &amp; PLANNERS</p> <p>MAIN CONTRACTOR: CR Construction Company Limited</p> <p>STRUCTURAL ENGINEER: AECOM</p> <p>FAÇADE CONSULTANT: AECOM</p>	<p>DB: REF: -</p>
NO.	DATE	DESCRIPTION																				
D	22/12/2018	GENERAL REVISED																				
C	04/12/2018	GENERAL REVISED																				
B	24/11/2018	GENERAL REVISED																				
A	10/09/2018	GENERAL REVISED																				

# 副框 (鋁質)

