



工程指示 / 要求簡箋(E.I.)

工程指示編號：EI / 0233 / 19

修改版次：F

工程編號：J - 837

工程名稱：觀塘裕民坊

工程項目：Plenum Box 大圖 修改

收件人：Maggie

發件人：Bessie Lau

日期：22/03/2019

要求提供 / 確認 事項：

- | | | |
|------------------------------------|-------------------------------------|-------------------------------|
| <input type="checkbox"/> 初步鋁料 B.M. | <input type="checkbox"/> 加工拆圖，然後生產 | <input type="checkbox"/> 尺寸表 |
| <input type="checkbox"/> 正式鋁料 B.M. | <input type="checkbox"/> 技術上資料 / 指示 | <input type="checkbox"/> 報價 |
| <input type="checkbox"/> 配件 B.M. | <input type="checkbox"/> 樣辦或貨品說明書 | <input type="checkbox"/> 分判合約 |
| <input type="checkbox"/> 其他：_____ | | |
- 內容：

現確定圖號 PB2118 箱號 T5P/G-K 圈起的資料(即是 F 的數值)要修改。

(此修改不收取額外費用)

已於 3 月 20 日把修改資料微信給鴻鵠吳先生。

此 EI 已電郵給鴻鵠吳先生。

請在 _____ 前完成上列要求。

附有關圖紙 / 文件：

以上項目為：

- 原合約工程包 原合約工程加 / 減賬 新工程報價

原因：-


分發東莞各部門：

- () 生產技術總監 連附件 () 技術部 連附件 () 生產部 連附件 () 機械設計部 連附件
 () 採購部 連附件 () 生產統籌部 連附件
 () 質檢部 連附件 () 會計部 連附件 () 報關組 連附件 () 其他 _____ 連附件



分發香港各部門：

- () 行政部 連附件 () 會計部 連附件 () 統籌部 連附件 () 工程部地盤科文 連附件
 () 採購部 連附件 () QS 部 連附件 () 維修部 連附件 () 其他 _____ 連附件

傳遞編號：

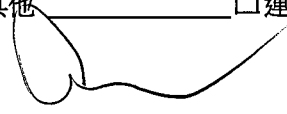發件人簽署：

項目經理簽署：

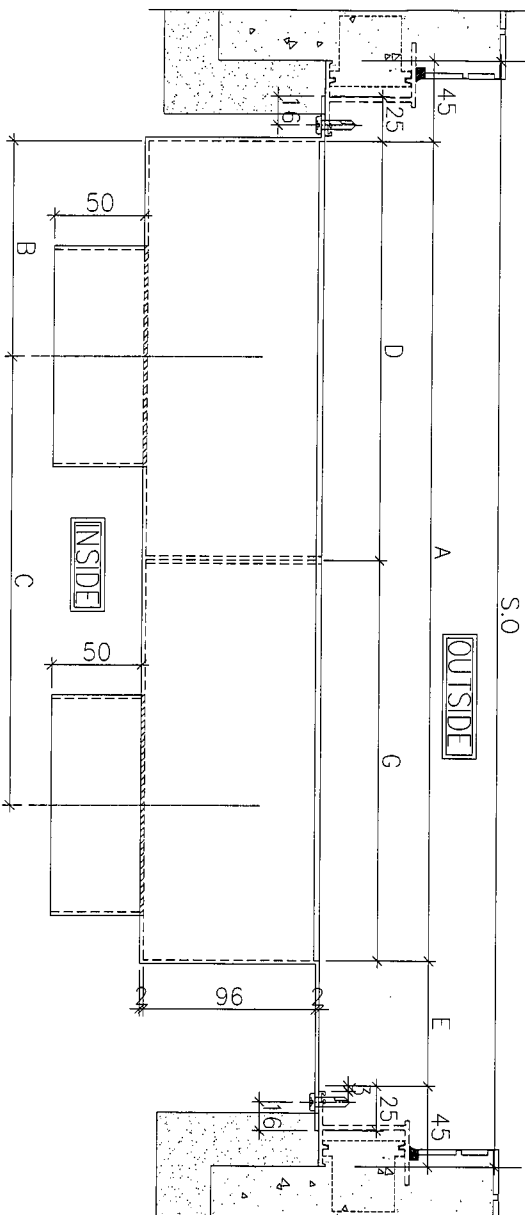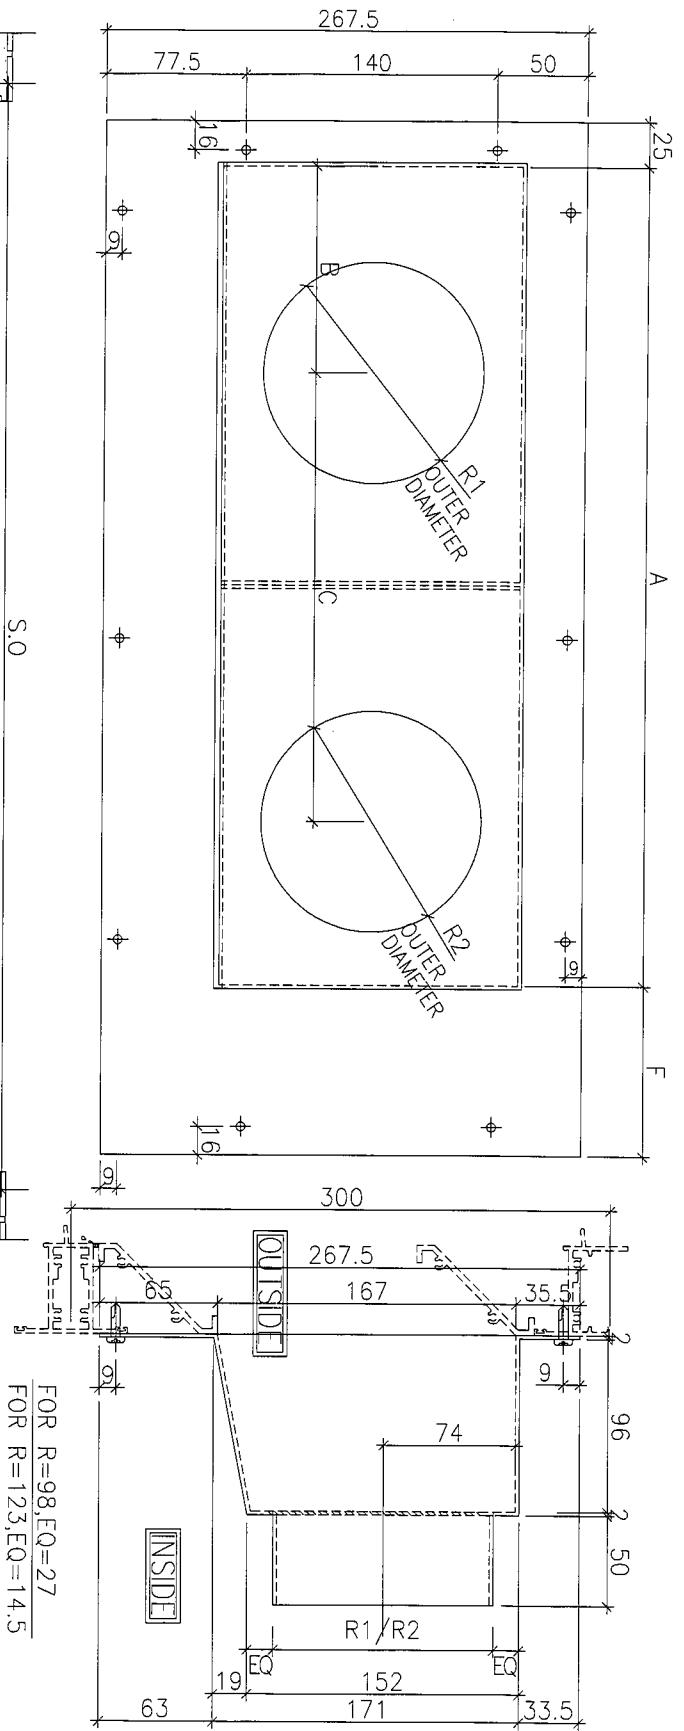

BOX NO.	S.O	A	B	C	D	E	F	G	R1	R2	QTY.	LOCATION	WINDOW NO.
T2P/E-K	1050	630	190	315	380	330	355	250	98	123	43	61°55'E	T2W/E-1
T2P/F-K	700	560	100	255	200	50	75	360	123	98	43	61°55'E	T2W/F-2
T3P/F-K	700	530	170	300	250	80	105	280	123	98	40	61°51'E	T3W/F-1
T3P/B-K	950	610	125	210	250	250	275	360	123	98	41	61°52'E	T3W/B-3
T5P/G-K	900	530	115	290	230	280	275	300	123	98	39	61°50'E	T5W/G-1
T1P/B-K	1000	610	125	305	250	300	325	360	123	98	39	61°50'E	T1W/B-1

FOR R=98, EQ=27
FOR R=123, EQ=14.5

610233E

(F=280+25=305) 修改版存仁

BOB. REF. :

CLIENT : 信和置業有限公司
Sino Land Company Limited

ARCHITECT : HOKI TUNG & PARTNERS LIMITED
WTF

MAIN CONTRACTOR : CR Construction Company Limited

STRUCTURAL ENGINEER : AECOM

FRACOR CONSULTANT :

DATE :

NO. :

REV. :

PROJECT : KOWUN TONG TOWN CENTRE
REDEVELOPMENT (AREA 2 & 3) ON
MILL 6514, KOWUN TONG, KOWLOON

TITLE : TOWER AIR PLUMBING BOX SCHEDULE
(PRELIMINARY FOR KITCHEN)

DATE : 04-JUL-18 **SCALE :** 1:1#

DRAWN BY : ZENG **CHECKED BY :** DW

DATE : 04-JUL-18

UNIT : 1-6, Sunny Industrial Centre, 1/F
1623489211-1 Fax: (852) 27221666

DATE : 04-07-18 **REV. :** A

LEGEND :

1. EFL -- FINISHED FLOOR LEVEL
2. SFL -- STRUCTURAL FLOOR LEVEL
3. @ -- REVERSED DETAIL

NOTE :

1. ALL DIMENSIONS ARE IN mm.
2. ALL ELEVATIONS ARE VIEWED FROM OUTSIDE.
3. ALL DIMENSIONS TO BE VERIFIED ON SITE.
4. ALL DIMENSIONS TO BE VERIFIED ON SITE.

DETAIL MARK NO. : (S) -- REFER SHEET NO.