



工程指示 / 要求簡箋(E.I.)

工程指示編號：EI / 0317 / 19

修改版次：D

工程編號：J - 837

工程名稱：觀塘裕民坊

工程項目：幕牆 鋁料模圖繪畫 (1 個)

收件人：Maggie

發件人：Eric Liu

日期：24/06/2019

要求提供 / 確認 事項：

- | | | |
|------------------------------------|-------------------------------------|-------------------------------|
| <input type="checkbox"/> 初步鋁料 B.M. | <input type="checkbox"/> 加工拆圖，然後生產 | <input type="checkbox"/> 尺寸表 |
| <input type="checkbox"/> 正式鋁料 B.M. | <input type="checkbox"/> 技術上資料 / 指示 | <input type="checkbox"/> 報價 |
| <input type="checkbox"/> 配件 B.M. | <input type="checkbox"/> 樣辦或貨品說明書 | <input type="checkbox"/> 分判合約 |
| <input type="checkbox"/> 其他：_____ | | |

內容：

請留意，因 EI9987 已到 J 版，無法再登記，EI0317 為 EI9987 修改版

1) 新增吊趟用鋁角碼，吊趟框組裝用 (1 個)

謝謝！

請在 2019/06/29 前完成上列要求。

附：1 頁模圖+1 頁

以上項目為：

- 原合約工程包 原合約工程加 / 減賬 新工程報價

原因：-_____

分發東莞各部門：

- () 生產技術總監 連附件 () 技術部 連附件 *永利* () 生產部 連附件 () 機械設計部 連附件
 () 採購部 連附件 () 生產統籌部 連附件 *楊*
 () 質檢部 連附件 () 會計部 連附件 () 報關組 連附件 () 其他 楊榮輝 連附件

分發其他分判：

- () 王禮秋 連附件

分發香港各部門：

- () 行政部 連附件 () 會計部 連附件 () 統籌部 連附件 () 工程部地盤科文 連附件
 () 採購部 連附件 () QS 部 連附件 () 維修部 連附件 () 其他 _____ 連附件

傳遞編號：

HK1432/19

發件人簽署：


Eric Liu

項目經理簽署：

[Signature]


類別	名稱	Page	PART	Grade	第幾DIE No.	Die No.	EI0317	A	B	C	D	E	F	G	H	I
企樑	雙樑企	1	M1	6063	T6	LH008912	X85545									
企樑	生樑企	2	M2	6063	T6	LH008913	X85546									
企樑	雙生企	3	M3	6063	T6	LH008914	X85547									
企樑	SD中企(90)	4	M4	6063	T6	LH008915	X85548									
企樑	轉角企	5	M5	6063	T6	LH0090004	X85549									
企樑	邊企	6	M6	6063	T6	LH008916	X85550									
企樑	雙生托	7	M7	6063	T6	LH008917	X85551									
企樑	雙樑橫料	8	T1	6063	T6	LH008918	X85552									
企樑	生樑橫料	9	T2	6063	T6	LH008919	X85553									
取濟	SD窗頂橫(單玻)	10	T3	6063	T6	LH008920	X85554									
企樑	SD窗頂橫(雙玻)	11	T3A	6063	T6	LH008921	X85555									
窗玉	樑橫料扣蓋	12	A01	6063	T5	LH008922	X85556									
取濟	生玉料(單玻)	13	A02	6063	T6	LH008923	X85557									
窗玉	玻璃扣蓋	14	A03	6063	T6	LH008924	X85558									
窗玉	生玉料(雙玻)	15	A04	6063	T6	LH008925	X85559									
窗玉	單玻插線	16	A05	6063	T6	LH008926	X85560									
窗玉	生樑企單玻	17	A06	6063	T6	LH008927	X85561									
窗玉	生樑企雙玻	18	A07	6063	T6	LH008928	X85562									
窗玉	生樑企單玻扣蓋	19	A08	6063	T5	LH008929	X85563									
窗玉	生樑企雙玻扣蓋	20	A09	6063	T5	LH008930	X85564									
套心	雙樑企套心	21	A10	6061	T6	LH008931	X85565									
套心	生樑企套心	22	A11	6061	T6	LH008932	X85566									
套心	雙生企套心	23	A12	6061	T6	LH008933	X85567									
套心	轉角企套心	24	A13	6061	T6	LH0090005	X85568									
企樑	轉角外蓋	25	A14	6063	T6	LH008934	X85569									
取濟	SD平台橫料(單玻)	26	S01	6063	T6	LH008935	X85570									
趟門	SD樑樑企收邊	27	S02	6063	T6	LH0090014	X85571									
趟門	SD平台橫料(雙玻)	28	S03	6063	T6	LH008936	X85572									
取濟	SD樑樑底(單玻)	29	S04	6063	T6		X85573									
趟門	SD樑樑底(雙玻)	30	S05	6063	T6	LH0090103	X85574									
取濟	SD樑企扣料(單玻)	31	S06	6063	T6		X85575									
趟門	SD樑企扣角線	32	S07	6063	T6	LH0090104	X85576									
趟門	SD樑企扣料(雙玻)	33	S08	6063	T6	LH0090105	X85577									
趟門	SD平台橫扣蓋	34	S09	6063	T5	LH008937	X85578									
趟門	SD中柱底座	35	S10	6063	T6	LH0090106	X85579									
趟門	SD中柱勾企	36	S12	6063	T6	LH0090107	X85580									
趟門	SD樑頂橫	37	S13	6063	T6	LH0090118	X85581									
趟門	SD勾企料	38	S15	6063	T6	LH0090119	X85582									
趟門	SD玉底橫	39	S16	6063	T6	LH0090120	X85583									
趟門	SD樑底橫	40	S17	6063	T5	LH0090108	X85584									
趟門	SD玉頂橫	41	S18	6063	T6	LH0090121	X85585									
趟門	SD中柱扣蓋	42	S19	6063	T6	LH0090109	X85586									
FD門	FD門樑底	43	F01	6063	T6		X85587									
FD門	FD門樑頂	44	F02	6063	T6		X85588									
FD門	FD樑企料	45	F03	6063	T5		X85589									
FD門	FD門玉料	46	F04	6063	T6		X85590									
FD門	FD門	47	F05	6063	T6		X85591									
鋁碼	固定鋁碼	48	AB01	6061	T6	LH008938	X85592									
介子	85介子	49	AB2	6061	T6	LH008939	X85593									
企樑	30*30*6鋁角	50	AB4	6061	T6	LH008940	X85594									
取濟	室外收口壓巴	51	AB5	6063	T5	LH008941	X85595									
企樑	轉角企內企	52	A15	6063	T6	LH0090006	X85596									
企樑	轉角企室內蓋	53	A16	6063	T5	LH0090007	X85597									
窗玉	拉巴	54	A17	6063	T6	LH0090013	X85598									
取濟	6+6玻璃用窗玉	55	A18	6063	T6	LH0090015	X85599									
介子	48介子	56	AB6	6061	T6	LH0090080	X85600									
趟門	中柱扣蓋(短)	57	S20	6063	T6	LH0090110	X85603									
趟門	趟門玉加拉手	58	S21	6063	T6	LH0090122	X85608									
趟門	趟門企樑厚耳	59	S22	6063	T6	LH0090111	X85604									
取濟	雙樑橫料	60	T1A	6063	T6		X85605									
趟門	玻璃扣線	61	S23	6063	T6	LH0090170	X85621									
趟門	底路軌飾線	62	S24	6063	T6	LH0090171	X85622									
趟門	底路軌(泥水用)	63	S25	6063	T6	LH0090172	X85623									
趟門	頂橫(泥水用)	64	S26	6063	T6	LH0090173	X85624									
背板	修齊板位用	65	AB7	6063	T5	LH0090174	X85625									
趟門	SD樑企扣角線	66	S07	6063	T6	LH0090176	X85626									
趟門	SD樑企扣料(雙玻)	67	S08	6063	T6	LH0090177	X85627									
窗玉	8+8窗玉	68	S07	6063	T6	LH0090212	X85638									
攝芯	攝樑企攝芯	69	S08	6063	T6	LH0090213	X85639									
窗玉	蝴蝶窗窗玉	70	A19	6063	T6	LH0090228	X85650									
窗玉	蝴蝶窗玻璃線	71	A20	6063	T6	LH0090229	X85651									
趟門	SD中柱勾企	72	S12	6063	T6	LH0090230	X85652									
FD門	加長腳門樑	73	F06	6063	T6	LH0090234	X85653									
趟門	趟門用拉巴	74	S27	6063	T6	LH0090297	X85657									
企樑	死牆二合一煙觀片	75	A21	6063	T6	LH0090326	X85662									
FD門	LAM片用玻璃線	76	F06	6063	T5	LH0090355	X85663	1								
FD門	拉巴	77	F07	6063	T5	LH0090405	X85664		1							
吊趟	吊趟外窗	78	AS1	6063	T5	LH0090427	X85665			1						
吊趟	吊趟內窗	79	AS2	6063	T5	LH0090428	X85666			1						
吊趟	吊趟外窗扣	80	AS3	6063	T5	LH0090429	X85667			1	1					
吊趟	吊趟用鋁角碼	81	AS4	6063	T5		X85668				1					
							總數	1	1	3	1	1				

CUSTOMER	CUSTOMER APPROVAL	CUST PART NO.	AS4
		SECTION NO.	X85668

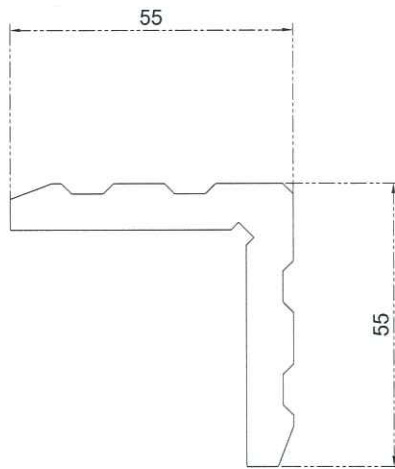

美特鋁質有限公司
承認圖面
日期 2019-6-24

SCALE 1:1

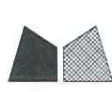SIGNATURE GRADEING	HIGH SIGNATURE GRADEING	C.C.DIA(MM)							
AREA (SQ MM)		UNSPECIFIED THICKNESS	-	PERIMETER (MM)	-	STANDARD		SCALE	1:1
MASS (KG/M)	-	UNSPECIFIED CORNERS	-	SURFACE AREA	-	ALLOY	6063 T5	VERSION	A
COMPANY ISSUE			DRAWN	DATE	APPELLATION		-	PAGE OF	
			STANDARDIZATION	DATE	 美特鋁質有限公司 MIDI Aluminium Fabricator Ltd.				
			TO SIGN	DATE					
			AUDITING	DATE					
MARKER	MODIFY	FILE NO	SIGNATURE	DATE					