



工程指示 / 要求簡箋(E.I.)

工程指示編號：EI / 0357 / 19

修改版次：-

工程編號：J - 837

工程名稱：觀塘裕民坊

工程項目：幕牆 趟門拆圖及加工注意事項

收件人：生統 任良

發件人：Eric Liu

日期：26/03/2019

要求提供 / 確認 事項：

- | | | |
|------------------------------------|-------------------------------------|-------------------------------|
| <input type="checkbox"/> 初步鋁料 B.M. | <input type="checkbox"/> 加工拆圖，然後生產 | <input type="checkbox"/> 尺寸表 |
| <input type="checkbox"/> 正式鋁料 B.M. | <input type="checkbox"/> 技術上資料 / 指示 | <input type="checkbox"/> 報價 |
| <input type="checkbox"/> 配件 B.M. | <input type="checkbox"/> 樣辦或貨品說明書 | <input type="checkbox"/> 分判合約 |
| <input type="checkbox"/> 其他：_____ | | |

內容：

按湛哥指示: 1) 止行裝置修在趟門底橫時，留意不能鑽穿底(按圖標示)

2) 止行裝置用堅朗 FK-D 型號

謝謝！

永林：請提供數量

請在 2019 / 03 / 27 前完成上列要求。

附： 3 頁

以上項目為：

- 原合約工程包 原合約工程加 / 減賬 新工程報價

原因：-

分發東莞各部門：

- () 生產技術總監 連附件 () 技術部 連附件 永林 () 生產部 連附件 () 機械設計部 連附件
 () 採購部 連附件 () 生產統籌部 連附件 梅
 () 質檢部 連附件 () 會計部 連附件 () 報關組 連附件 () 其他 楊榮輝 連附件

分發香港各部門：




- () 行政部 連附件 () 會計部 連附件 () 統籌部 連附件 () 工程部地盤科文 連附件 炳哥
 () 採購部 連附件 () QS 部 連附件 () 維修部 連附件 () 其他 _____ 連附件

傳遞編號：

HK 0722 / 19

發件人簽署：





項目經理簽署：

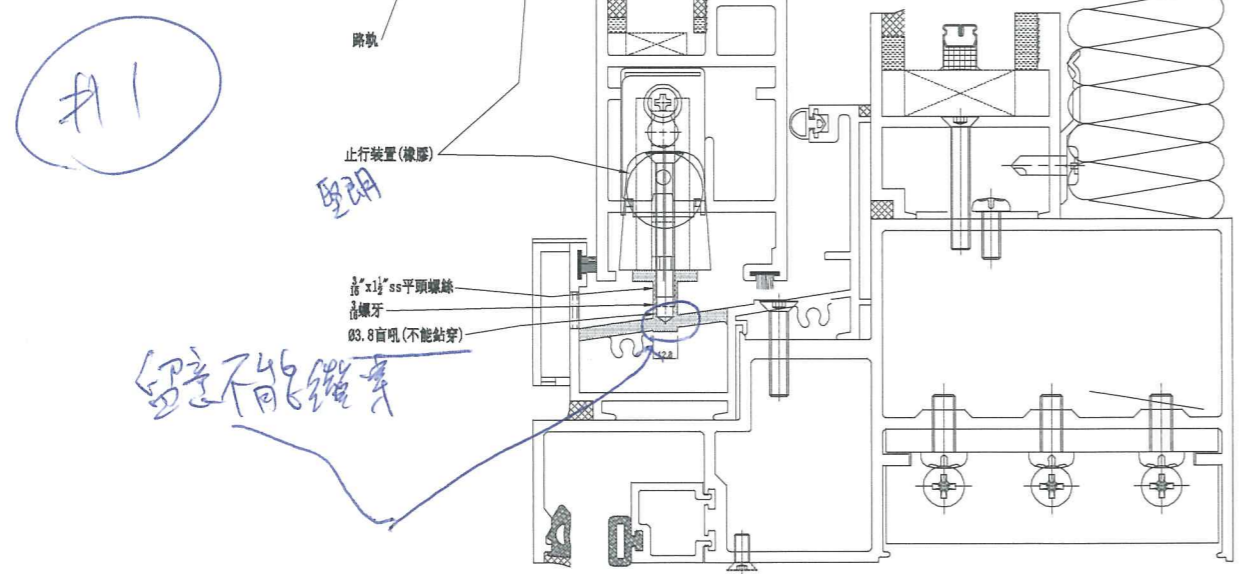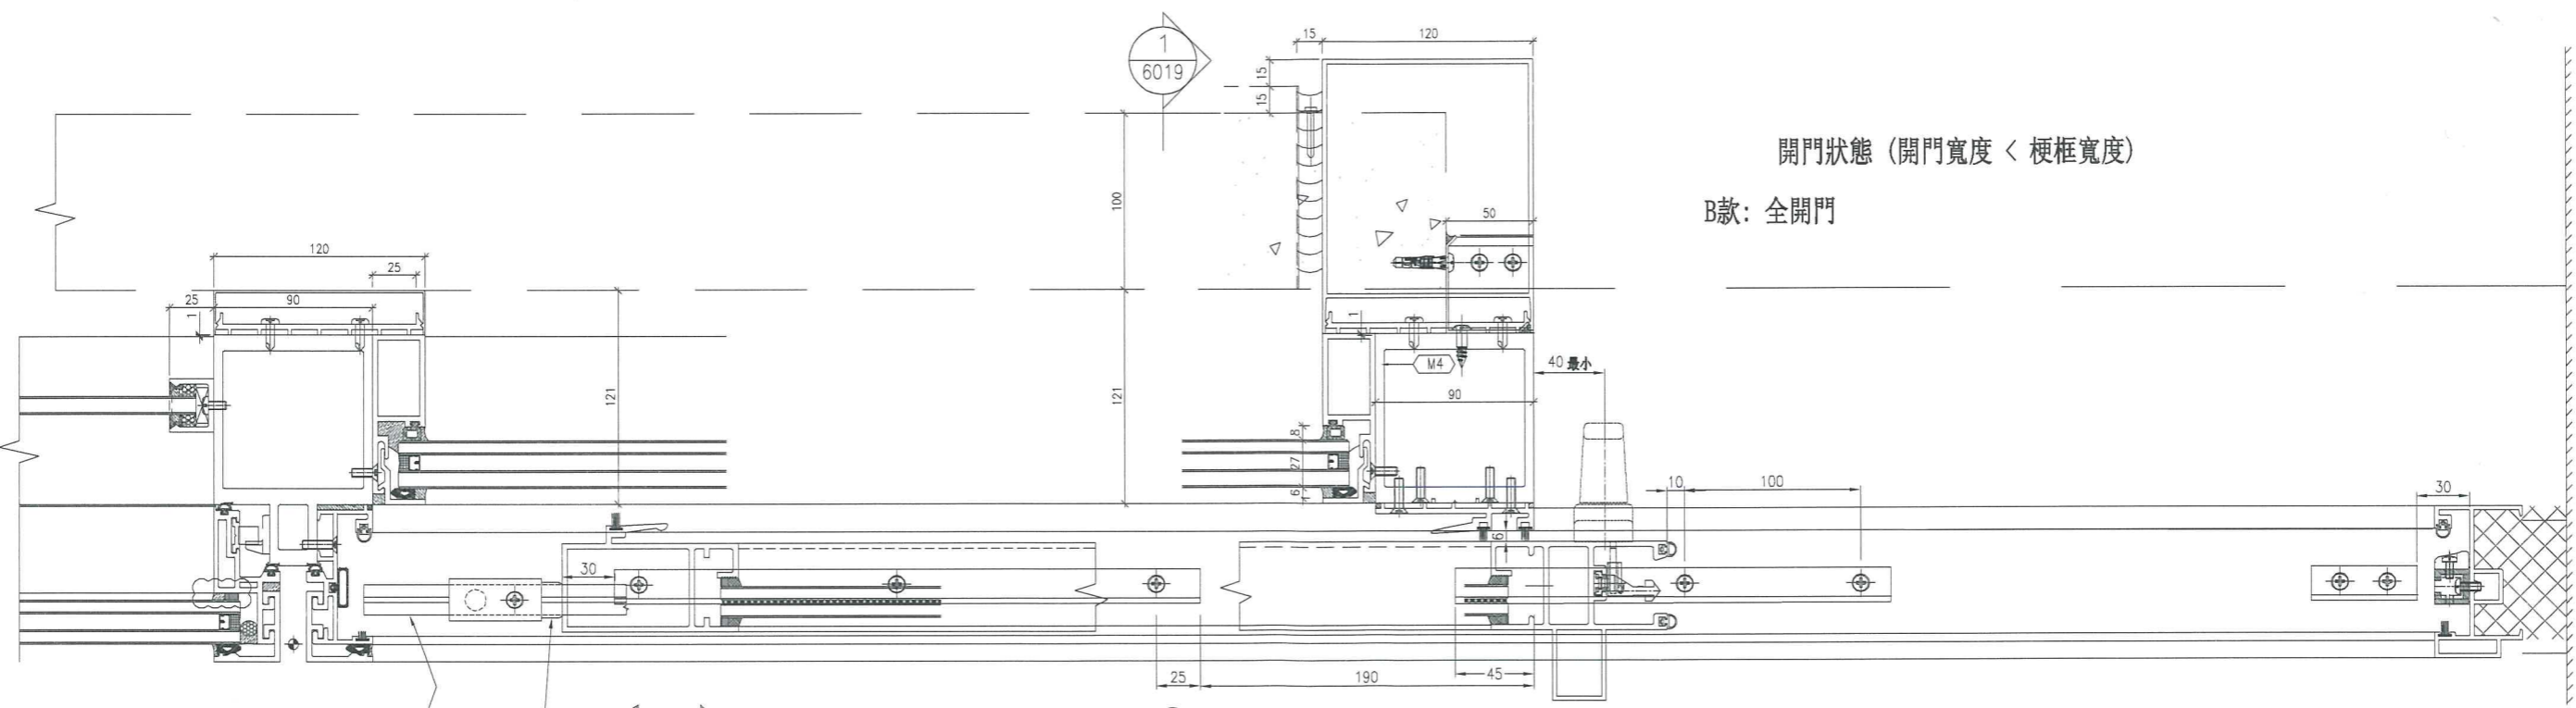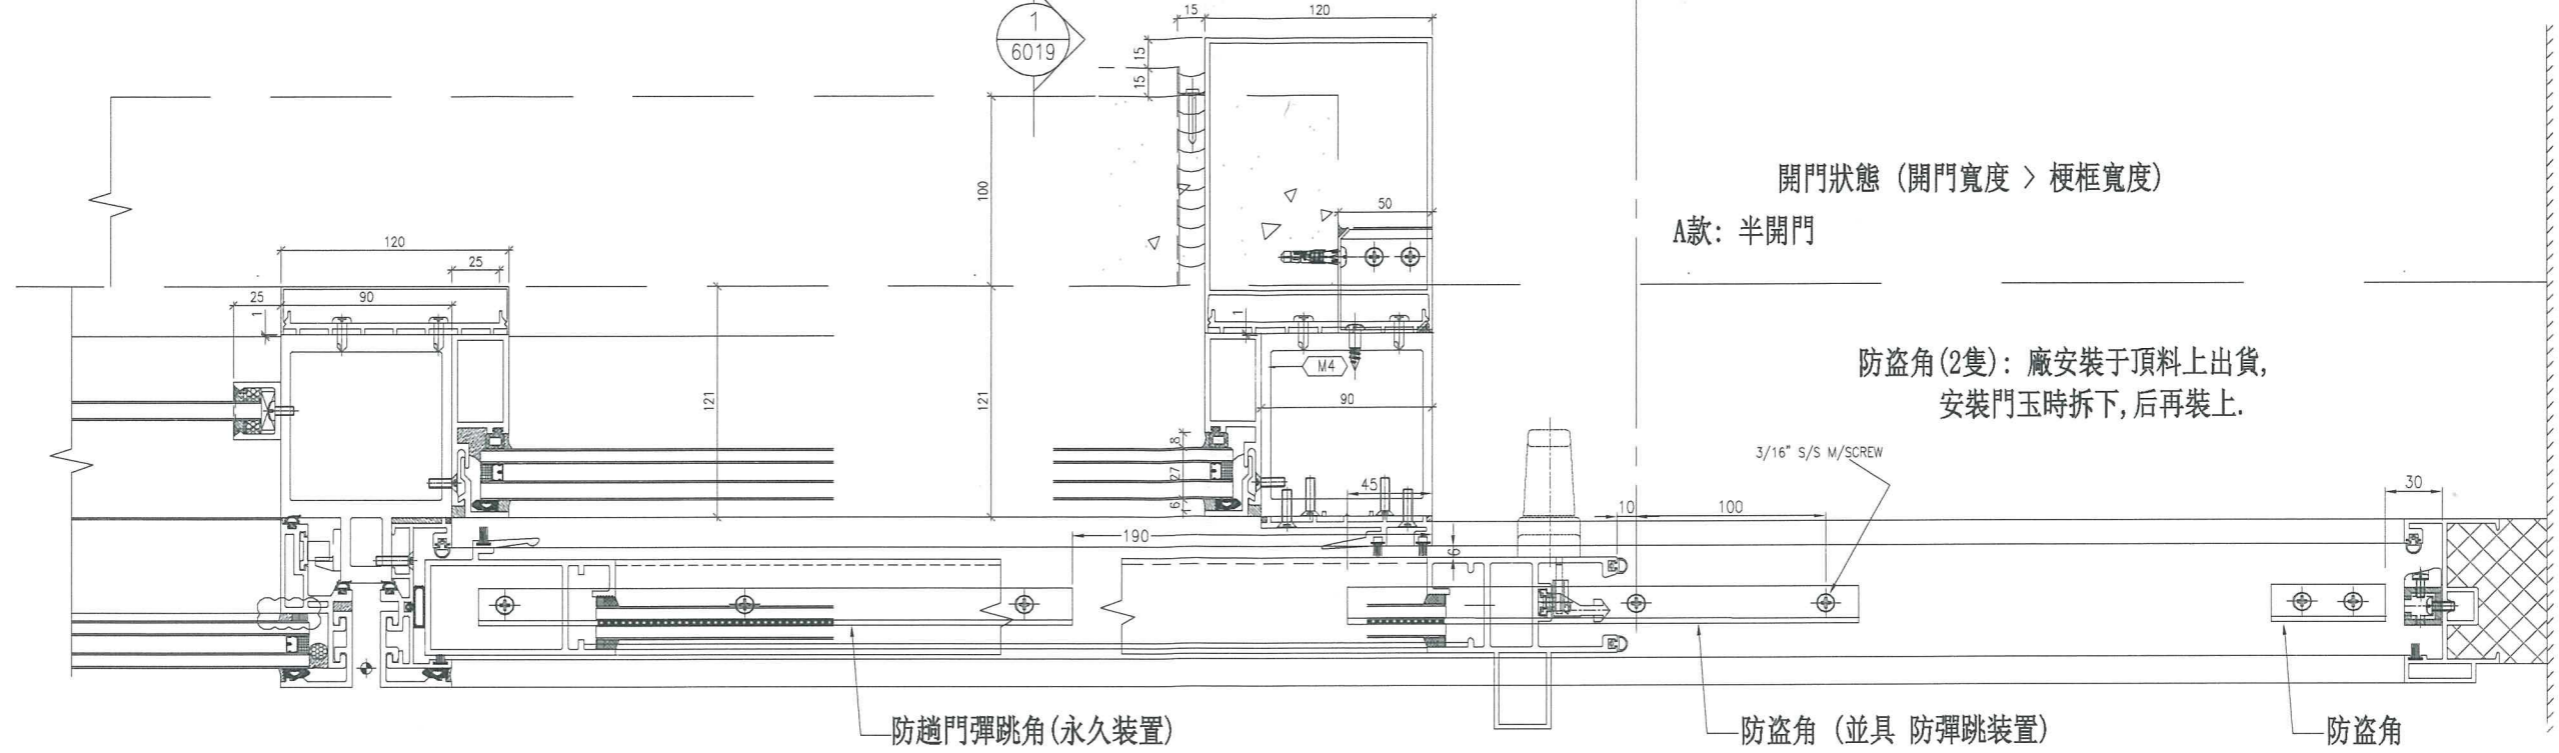

T:\Jobs\5837\3Dwg & cal\Fabrication Dwg\SD防盜防盜心停裝費.dwg

皇朝

9-2、TLM100系列 推拉系列 TLM100 Sliding Series

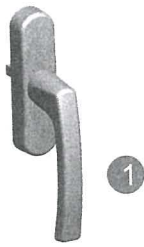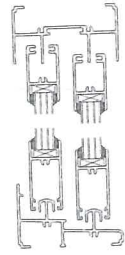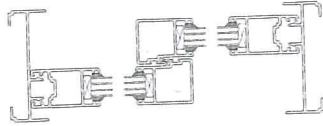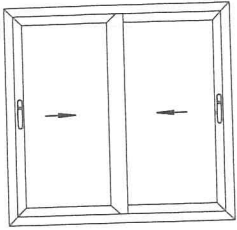

井2



止行装置

TLM100推拉系列双扇五金配件选配表 Hardware Configuration for TLM100 Series

序号 No.	配件名称 Item Name	代号 Code	数量 Quantity	备注 Mark
1	执手 Handle	P50	2	可选配 Others are available
2	传动器二 Second Transmitter	PCDQT01508	2	
3	锁扣 Locking Hook	U03B	4	
4	防撞块 Anti-strike Block	FK-A	4	
5	防撞块 Anti-strike Block	FK-B	4	
6	防撞块 Anti-strike Block	FK-D	1	
7	双滑轮 Double Roller	MLG15	4	
8	左下堵端 Left Bottom End	DG-01	2	
9	右下堵端 Right Bottom End	DG-02	2	
10	左上堵端 Left Upper End	DG-03	2	
11	右上堵端 Right Upper End	DG-04	2	
12	防盗块 Anti-theft Piece	FDK	1	


配置说明:

- ★适用于普铝2001推拉门型材系列。
- ★可根据不同型材选配五金件,以上配置仅供参考。

Instruction:

- ★Suitable for 2001 series sliding door with ordinary aluminium profile.
- ★Flexible hardware configuration based on different profile.

滑轮 MLG15 Roller MLG15

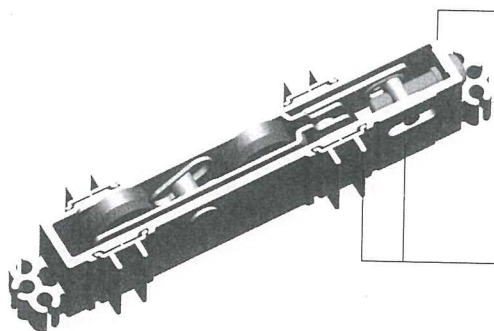


铝质金属外壳, 可根据实际型材的需求加工成不同的高度尺寸

The aluminium-pressed shell can be made to different height according to the requirements of profile

配合型材轨道, 轮子可加工形状:

Roller shape can be as follows according to profile

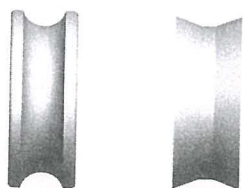

- ①所需滑轮宽度在19mm(含)的时, 可直接使用
- ②所需滑轮宽度位于19mm~31mm时需增加滑轮副盖(需加工), 具体配置情况请与我们技术服务人员联系

- ①The roller could be used directly when its width is 19mm
- ②Extra device (needs process) is needed when the width of the roller is between 19mm to 31mm