



工程指示 / 要求簡箋(E.I.)

工程指示編號：EI/0672/19

修改版次：-

工程編號：J-837

工程名稱：觀塘裕民坊

工程項目：幕牆 浴室位防水片+收口鋁板(大貨 T1-T5, 7-50/F) (在樓)

收件人：生統 / 永材

發件人：Eric Liu

日期：5/6/2019

要求提供 / 確認 事項：

- |                                    |                                     |                               |
|------------------------------------|-------------------------------------|-------------------------------|
| <input type="checkbox"/> 初步鋁料 B.M. | <input type="checkbox"/> 加工拆圖，然後生產  | <input type="checkbox"/> 尺寸表  |
| <input type="checkbox"/> 正式鋁料 B.M. | <input type="checkbox"/> 技術上資料 / 指示 | <input type="checkbox"/> 報價   |
| <input type="checkbox"/> 配件 B.M.   | <input type="checkbox"/> 樣辦或貨品說明書   | <input type="checkbox"/> 分判合約 |
| <input type="checkbox"/> 其他：_____  |                                     |                               |

內容：

請按加工圖生產浴室位防水片送地盤安裝 (在樓款)

1) 每 10 層 1 批，8 樓已在 EI0551 出單

謝謝！ 2) 分層包裝

請在 2019/06/30 前完成上列要求。

附：- 1頁，12頁加工圖，7頁位圖

以上項目為：

- 原合約工程包                       原合約工程加 / 減賬                       新工程報價

原因：-

分發東莞各部門：

- ( ) 生產技術總監  連附件    (✓) 技術部  連附件 永材    ( ) 生產部     連附件    ( ) 機械設計部  連附件  
 ( ) 採購部     連附件    (✓) 生產統籌部  連附件 柏    ( ) 質檢部     連附件    ( ) 會計部     連附件    ( ) 報關組     連附件    ( ) 其他 楊榮輝  連附件

分發其他分判：

- ( ) 王禮秋  連附件

分發香港各部門：

- ( ) 行政部  連附件    ( ) 會計部  連附件    ( ) 統籌部  連附件    (✓) 工程部地盤科文  連附件 火哥  
 ( ) 採購部  連附件    ( ) QS 部  連附件    ( ) 維修部  連附件    ( ) 其他 \_\_\_\_\_  連附件

傳遞編號：

HK 1335/19

發件人簽署：

項目經理簽署：

Bath Room. flushing.

按座包禁

TYP.

坐 (ei 103)

橫 (ei 455 類)

T1 A

Case 1 + Case 2

ei 455

T2 M

Case 1 + Case 2

ei 455

T3 F


Case 1 + Case 3

ei 455

T5 A

Case 1 + Case 3

ei 455

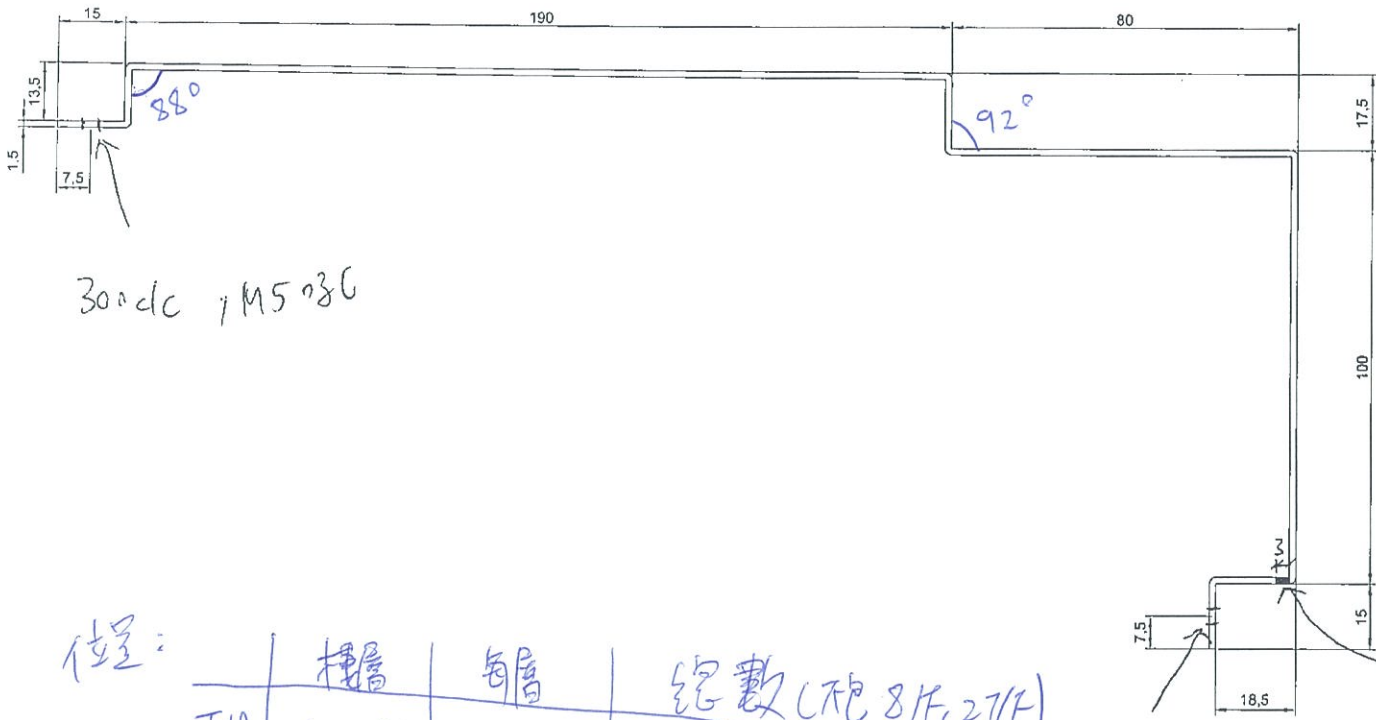

圖號 = BNF-001

F.5 um 鍍板

L = 2440 mm

料號 = ~~ASPT~~  
UCT803649 FXL-3

~~5件~~

~~12件~~

164件

滴水孔

每10層一批

300 mic, M5 螺絲

300 mic  
M5 螺絲 打膠蓋


位置:

	標層	每層	總數 (不含 8件, 27件)
T1A	6-50/F	1	38
T2M	6-55/F	1	42
T3F	6-52/F	1	39
T5A	6-51/F	1	40

159 + 5 後備  
= 164

E20455  
HK 0877

按現場覆數修改尺寸

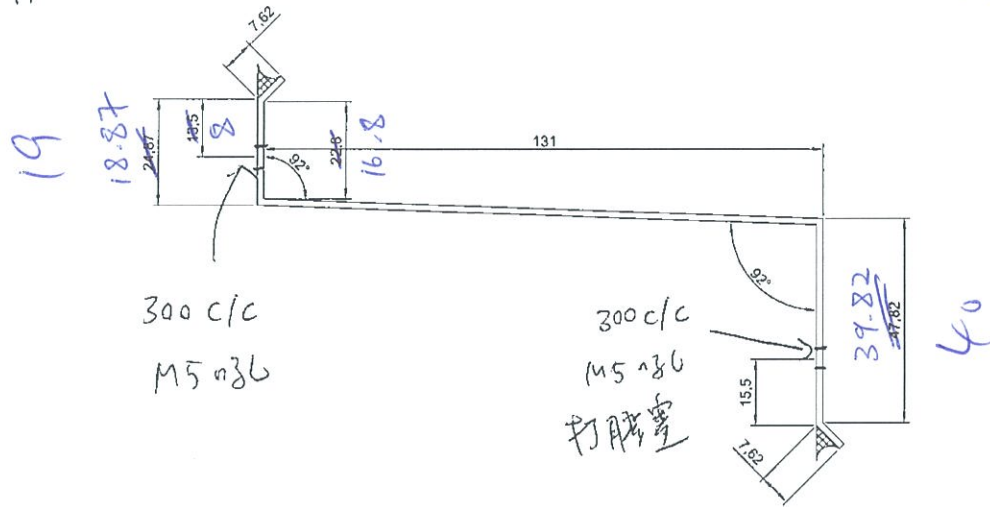

圖號: BIVF-002

1.5mm 鋁板

L=2440mm

顏色 = Mill

位置 =

	樓層	每層	總數 (不含31F, 27F)
T1A	6-50/F	1	38
T2M	6-55/F	1	42
T3F	6-52/F	1	39
T5A	6-51/F	1	40

~~5件~~ ~~12件~~

164 件

每10層一批

159+5 備


=164

8樓已出 (E20551)


TA, T2M, T3F, T5A

# CASE 1 - OPTION 2

穩圖

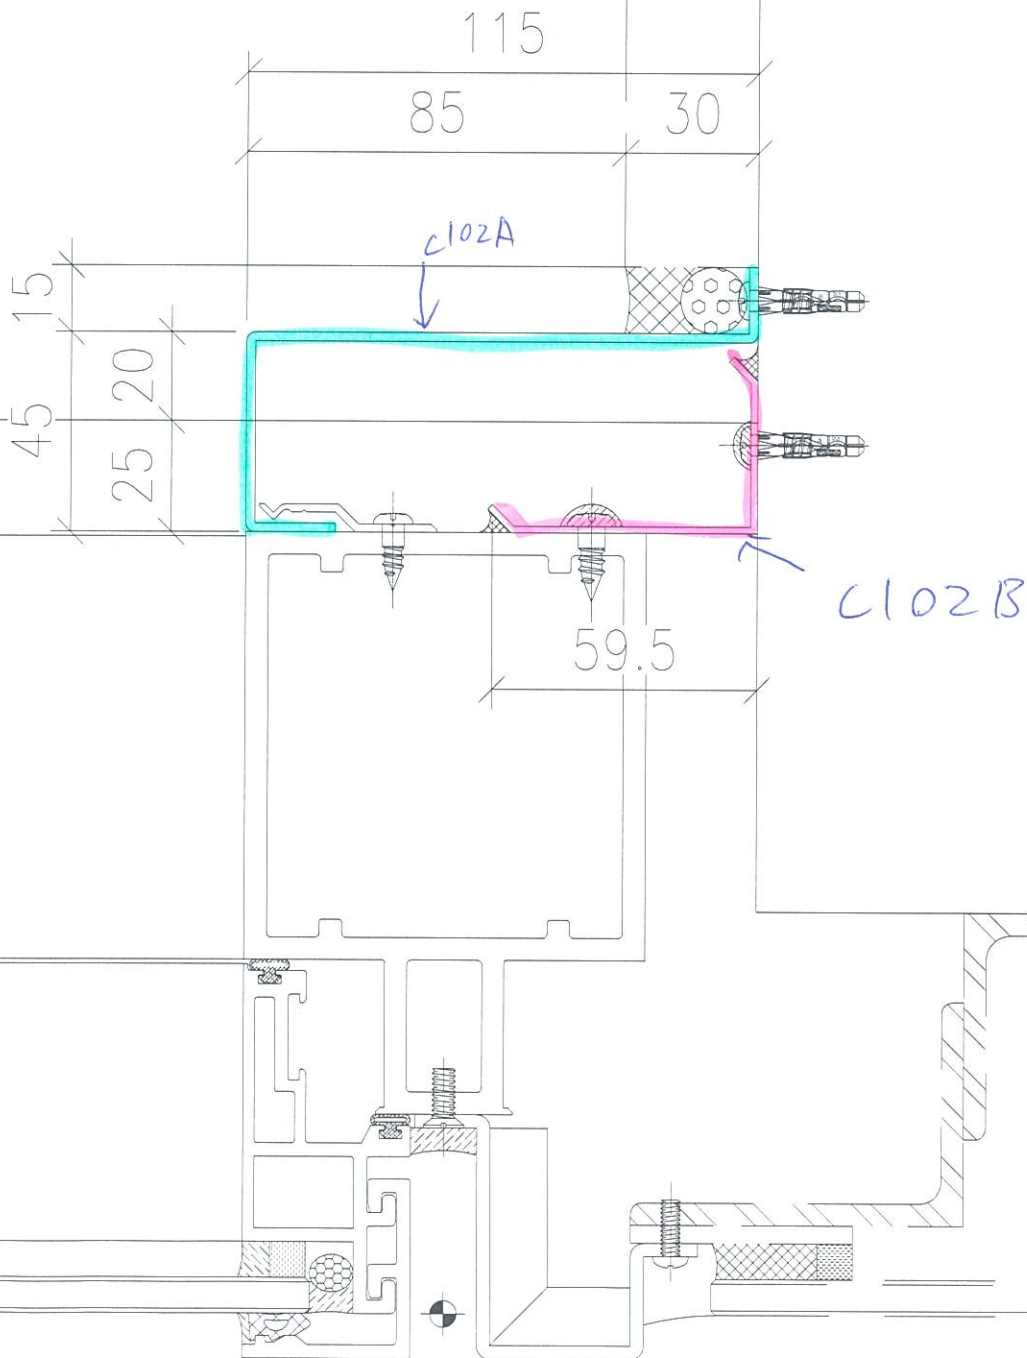

# CASE 1 - OPTION 2

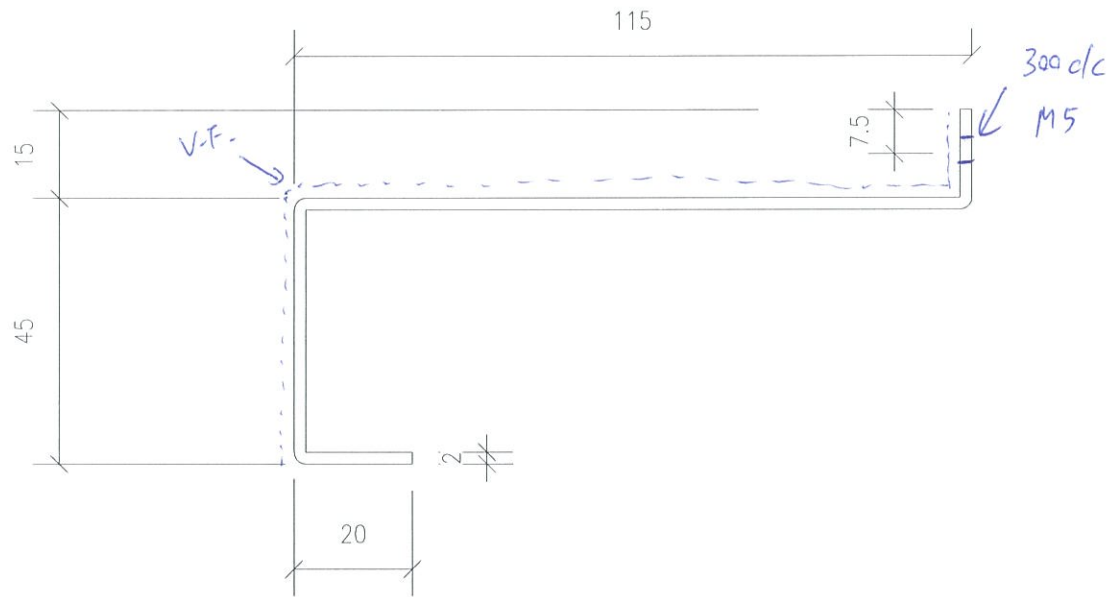

	每層	總共	擱層
T1A	1	38	6-50/F
T2M	1	42	6-55/F
T3F	1	39	6-51/F
T5A	1	40	6-52/F

159+58線筒

不連 8/F, 27/F

顏色: UCT803649 FXL-3

1.5mm 鋁板

L: 2440


數量: 164件

圖號: J837-C102A

# CASE 1-OPTION 2

	每層	總數	樓層
T1A	1	38	6-50/F
T2M	1	42	6-55/F
T3F	1	39	6-51/F
T5A	1	40	6-52/F

167+13

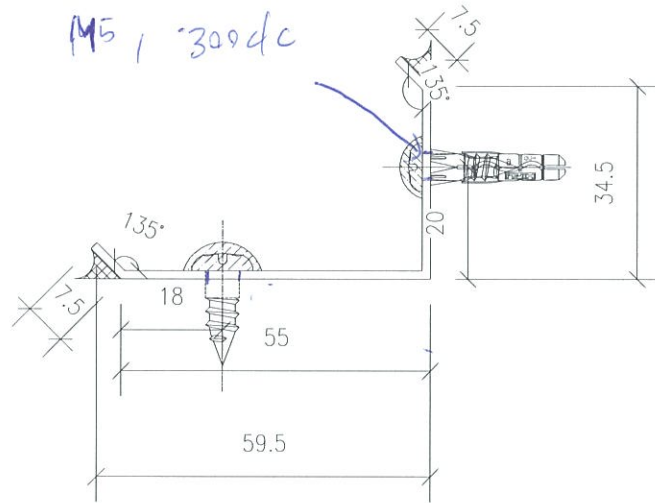

~~154+13~~

規格 = ~~154+13~~ M11

1.5mm 銘板

L = 2440

數量 = 164 (159+5後備)


圖號 = J837-C102B

T1A


CASE 2-OPTION 3

接圖

T1A, T2M月

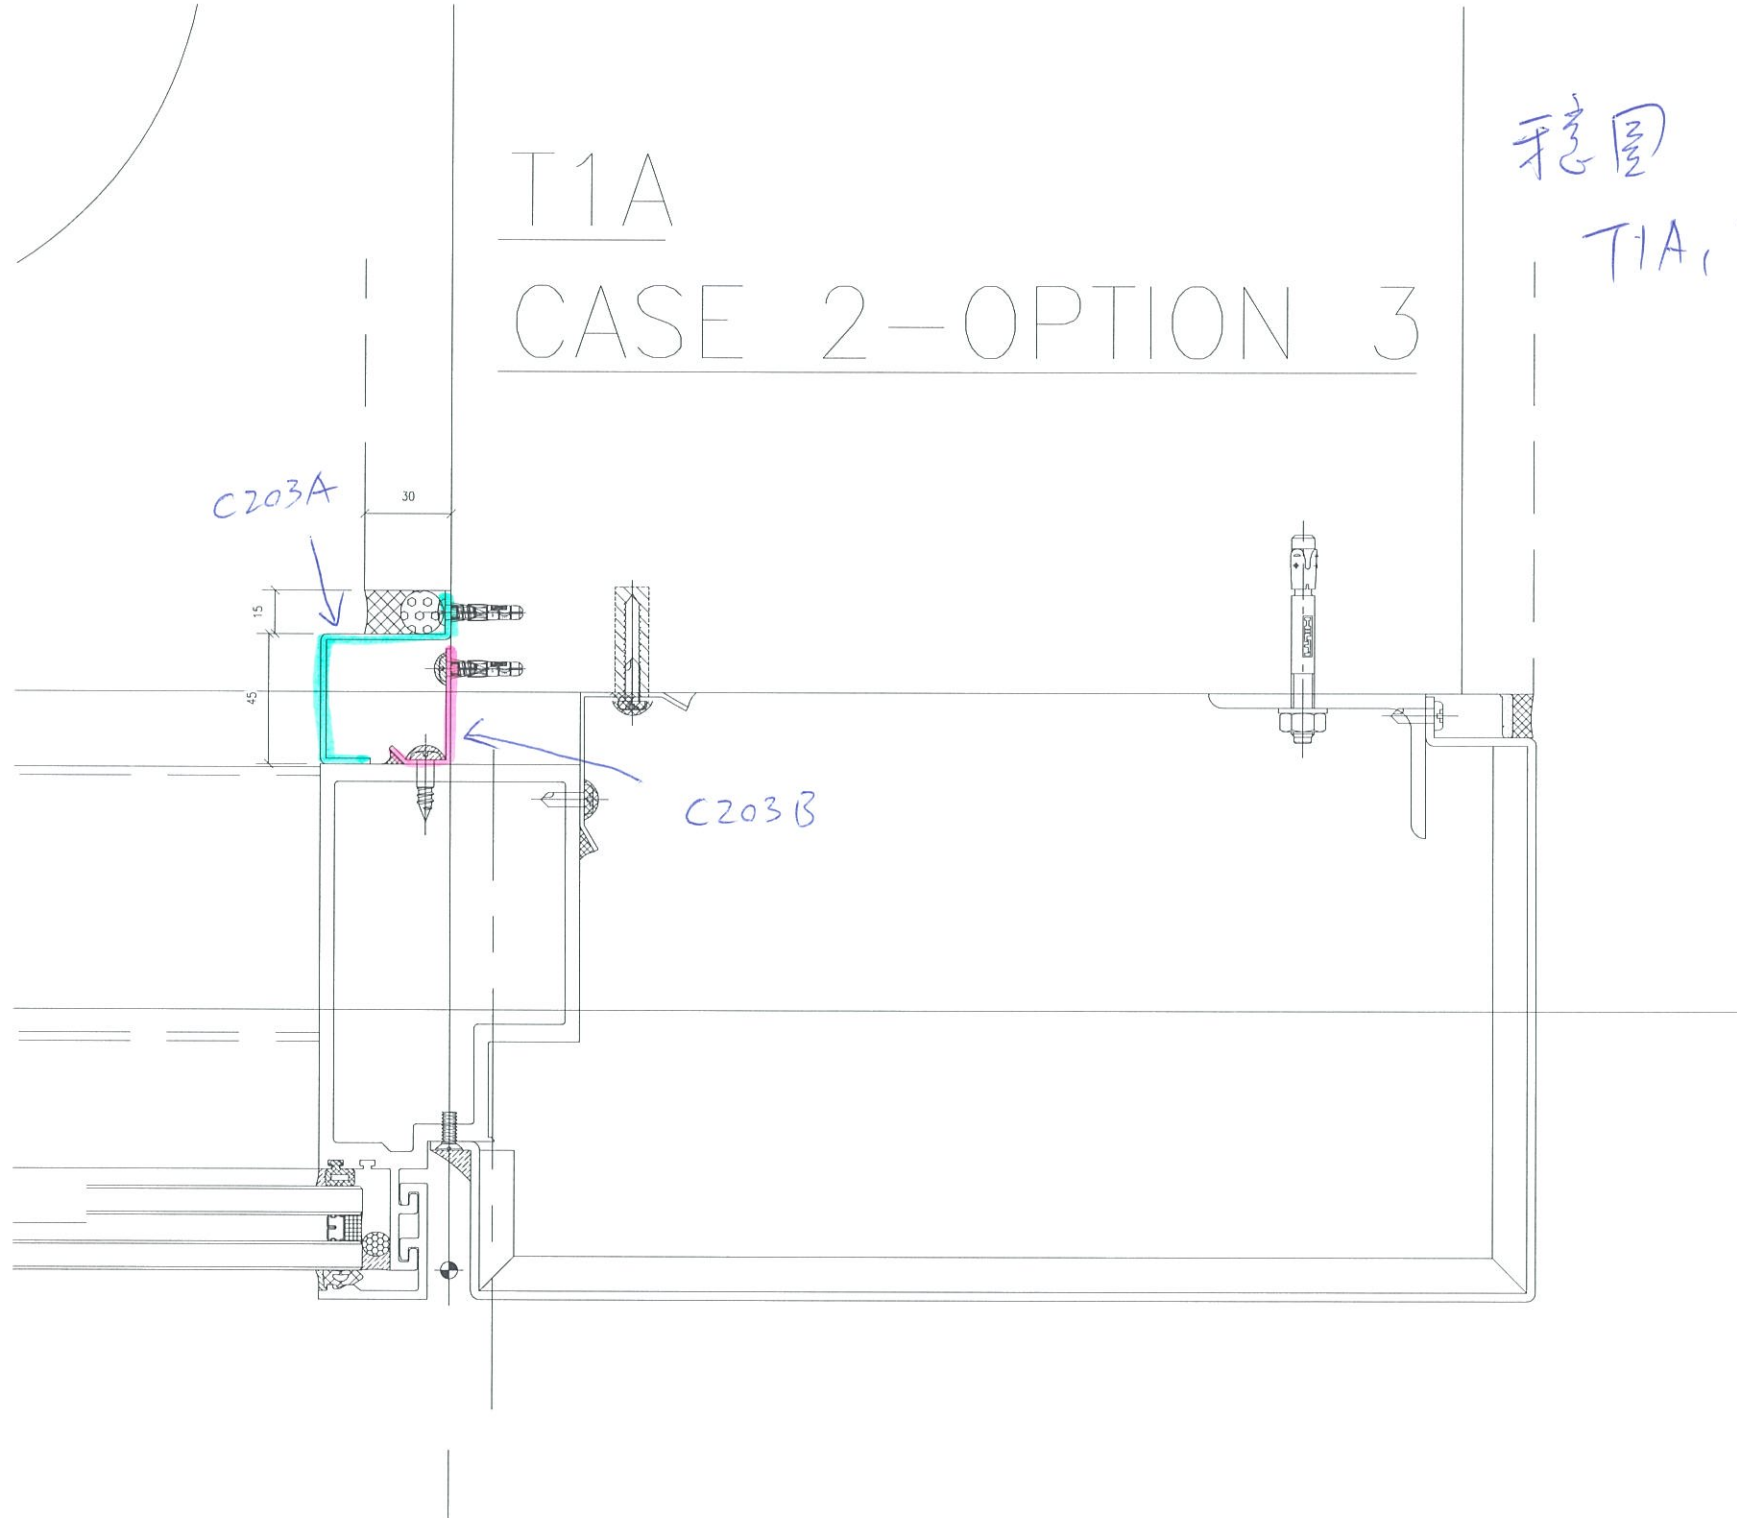

# CASE 2-OPTION 3

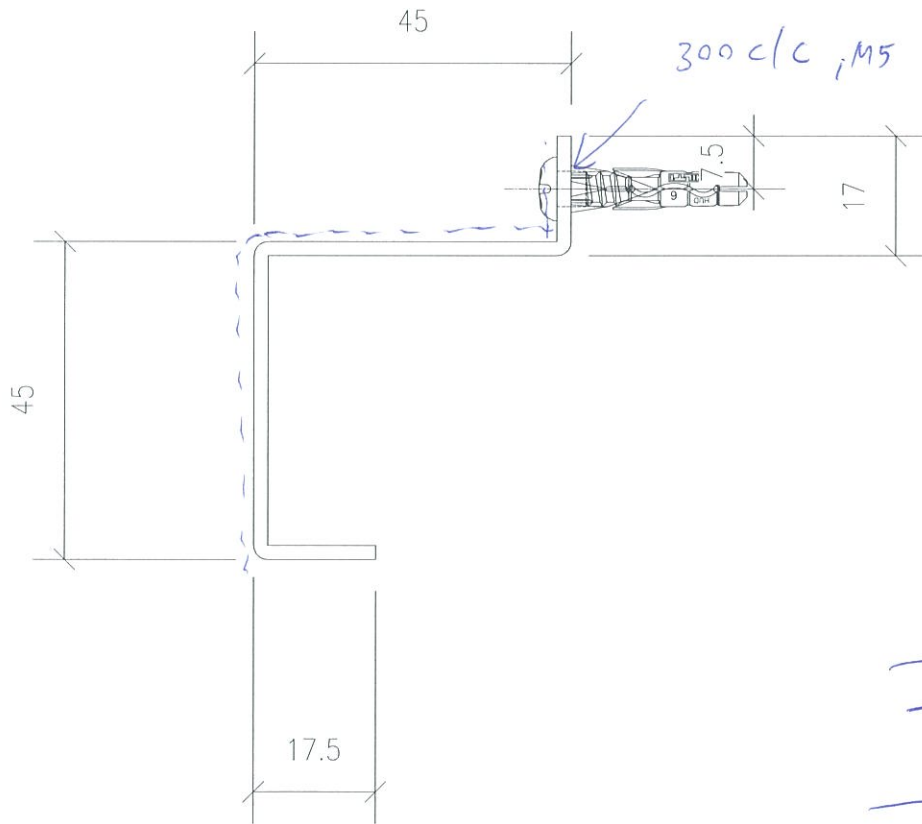

顏色 = UCT803649FXL-3

1.5mm 鋁板

L = 2440


數量 = 85 (80+5修備)

圖號 = J837-C203A

	每層	總共	樓層
T1A	1	38	6-50/F
T2M	1	42	6-55/F

不包 8/F, 27/F

# CASE 2-OPTION 3

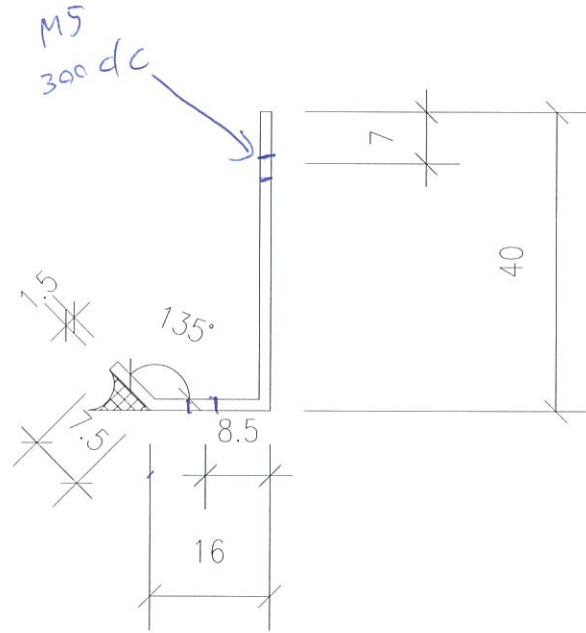

規格 = M5 11

1.5mm 鋁板

L = 2440


數量 = 85 (80+5 後備)

圖號 = J837-C203B


	每層	總共	樓層
T1A	1	38	6-50/F
T2/M	1	42	6-55/F

不包括 8/F, 27/F.

# CASE 3-OPTION 2

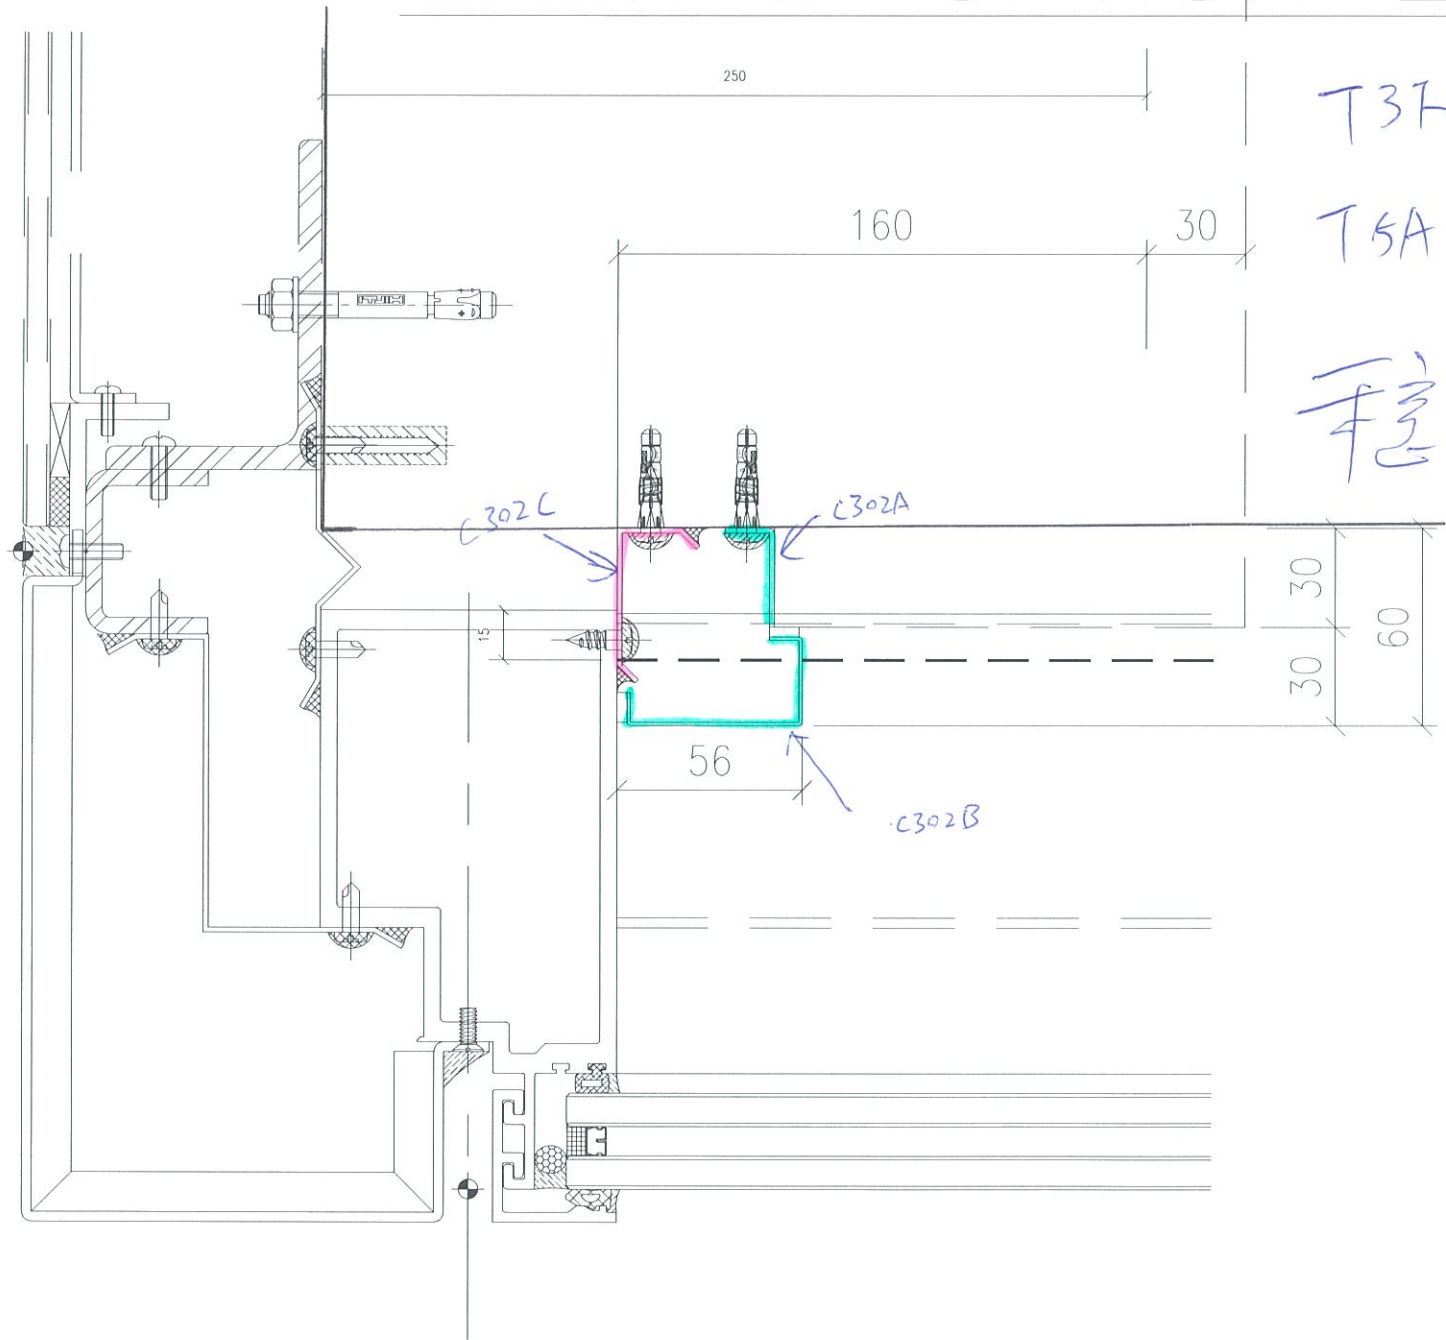

# CASE 3-OPTION 2

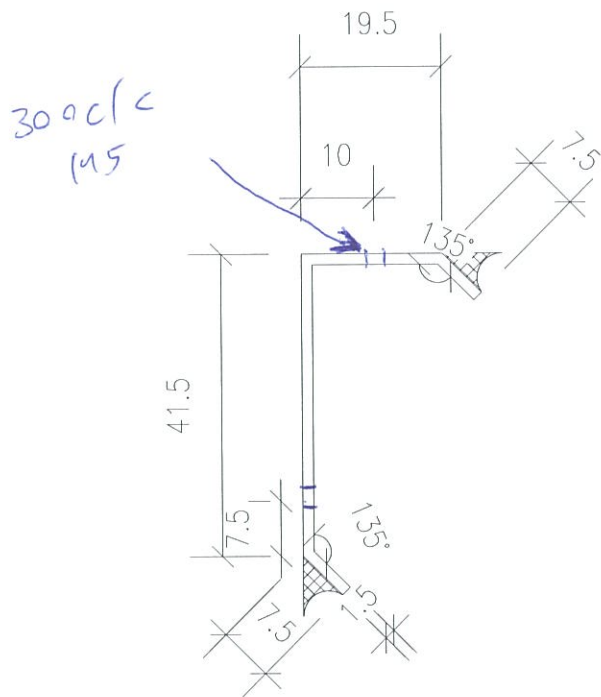

料號: M-11

1.5mm 鋁板

L = 2440


數量: 84件 (79+5的備)

圖號: J837-BF-C302C

	每層	總共	樓層
T3F	1	39	6-51/F
T3A	1	40	6-52/F

不包 81F, 271F

# CASE 3-OPTION 2

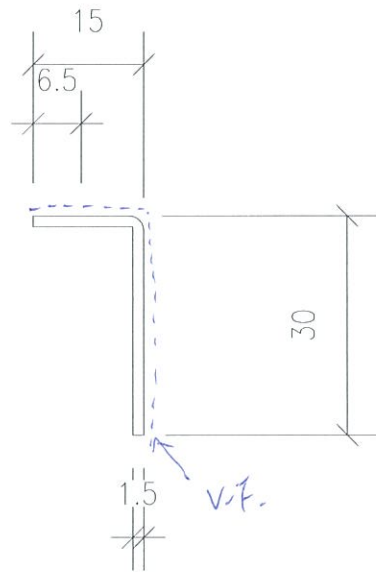

數量: 84 (79+5後備)

L = 2440

顏色: UCT803649 • FXL-3


1.5 mm 鋁板

圖號: J837-BF-C302A

	每層	總共	標層
T3F	1	39	6-51/F
T5A	1	40	6-52/F

不包 08/F, 27/F

# CASE 3-OPTION 2

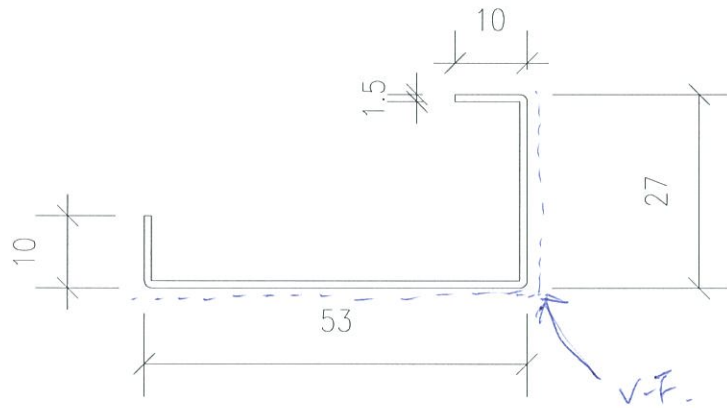

1.5 mm 鋁板

顏色: VCT 803649 FXL-3

L: 2440

數量: 84 (79+5後備)


圖號: J837-BF-C302B

	每層	總共	樓層
T3F	1	39	6-51/F
T5A	1	40	6-52/F

不包 6/F, 27/F





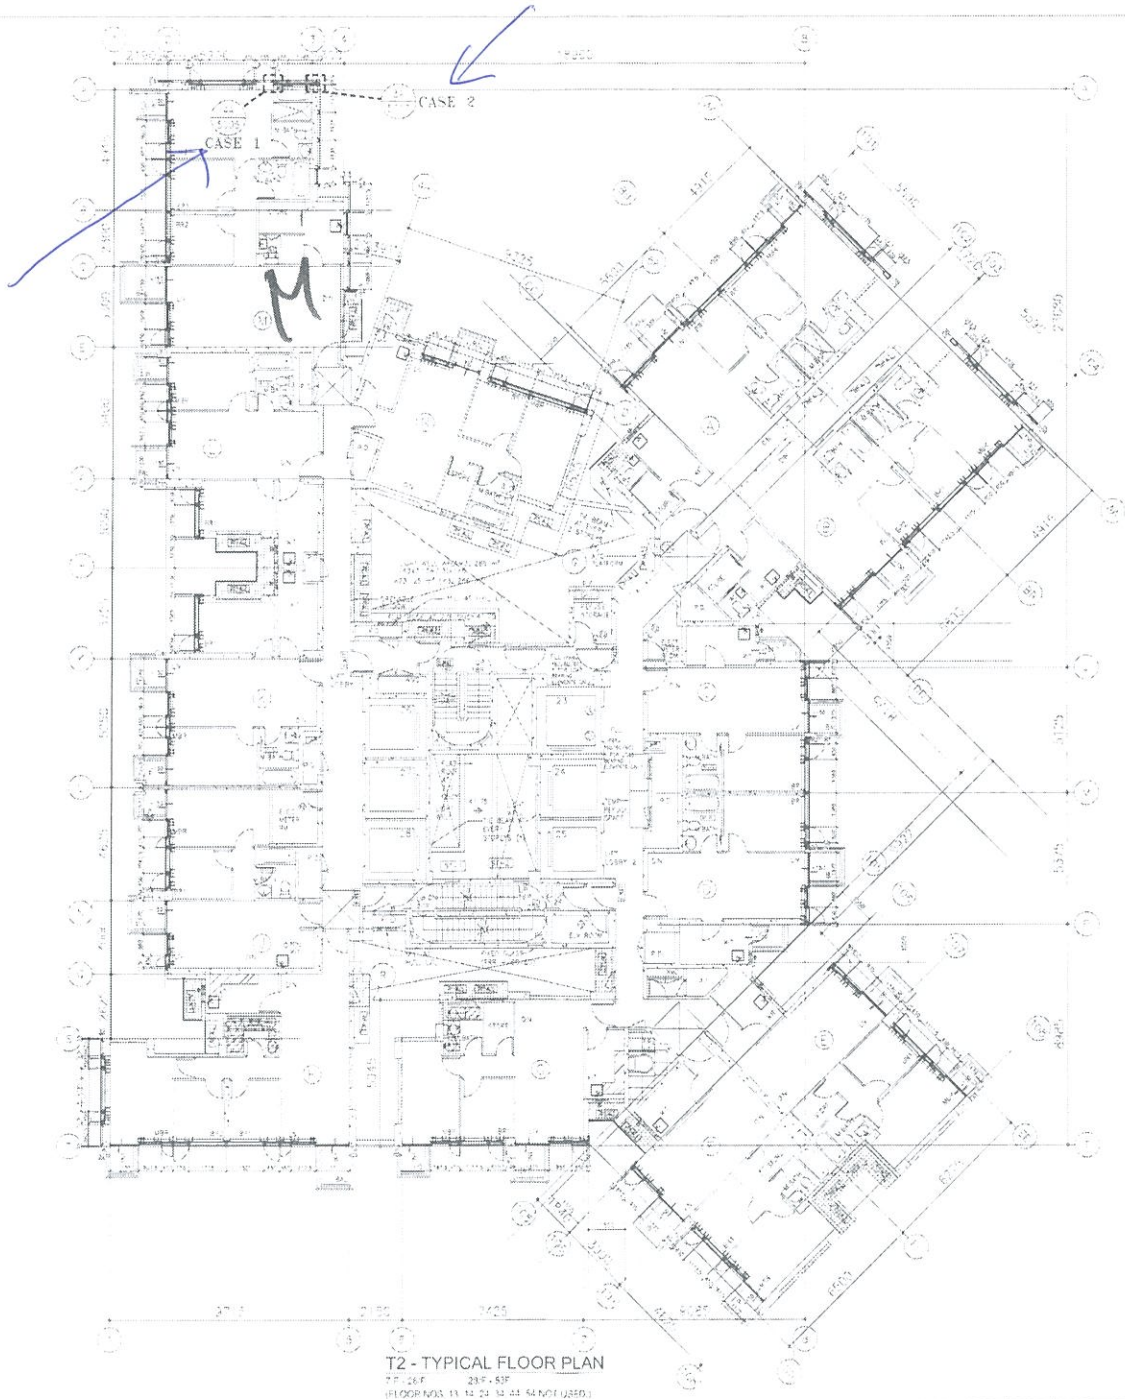

T2 - TYPICAL FLOOR PLAN  
 77' - 28'6" 28'6" - 63'  
 (FLOOR NOS. 13, 14, 24, 34, 44, 54, 64, 74, 84)

CLIENT  
 信和置業有限公司  
 Sino Land Company Limited

ARCHITECT  
 WONG TUNG & PARTNERS LIMITED  
 ARCHITECTS & PLANNERS

MAIN CONTRACTOR  
 CR Construction Company Limited

STRUCTURAL ENGINEER  
 ACOM

MECHANICAL ENGINEER  
 ACOM

- NOTES
1. ALL DIMENSIONS ARE IN MM
  2. ALL ELEVATIONS ARE LEVISED FROM OUTSIDE
  3. ALL DIMENSIONS @ 20% ENLARGED ON SITE BEFORE FABRICATING

- LEGEND
- DIMENSION MARK UP
  - REFER SHEET NO.
  - FINISHING FLOOR LEVEL
  - STRUCTURE FLOOR LEVEL
  - REFER SHEET NO.

**TLM**  
**74P**

FLOOR NUMBER	FINISHING FLOOR LEVEL	STRUCTURE FLOOR LEVEL
13	11.470	11.470
14	11.570	11.570
15	11.670	11.670
100	20.170	20.170

PROJECT NO. 1019-008  
 SHEET NO. 74P

PROJECT  
 1019-008 TOWER 2  
 1019-008 TOWER 2  
 1019-008 TOWER 2

DATE: 2018-08-10  
 DRAWN BY: KONG  
 CHECKED BY: [Signature]

MECHANICAL ENGINEER  
 MIDI ENGINEERING LIMITED  
 1019-008 TOWER 2  
 1019-008 TOWER 2  
 1019-008 TOWER 2

CLIENT  
 信和置業有限公司  
 Sin Hoi Land Company Limited

ARCHITECT  
 WONG TUNG & PARTNERS LIMITED  
 ARCHITECTS & PLANNERS

MAIN CONTRACTOR  
 CR Construction Company Limited

STRUCTURAL ENGINEER  
 ACCOM

ARCHITECTURAL CONSULTANT  
 ACCOM

NOTES

1. ALL DIMENSIONS ARE IN MM
2. ALL ELEVATIONS ARE GIVEN FROM OUTSIDE
3. ALL DIMENSIONS TO BE VERIFIED ON SITE BEFORE FABRICATION

LEGEND

- DETAIL MARK NO
- REFER SHEET NO
- FINISHED FLOOR LEVEL
- STRUCTURAL FLOOR LEVEL
- ROOF LEVEL

13 TYP

FLOOR NUMBER	FINISHED FLOOR LEVEL
00	62.400
01	61.500
02	60.700
03	59.700
04	58.700
50	12.700

GENERAL REVISION

NO.	DATE	DESCRIPTION
1	12/28/2018	GENERAL REVISION
2	01/11/2019	AS NOTED
3	02/05/2019	AS NOTED

PROJECT


TRADE MARK TONG TONG CENTRE  
 HUI DEWU DEVELOPMENT (PART 2) OF 30/F  
 18/F, 19/F, 20/F, 21/F, 22/F, 23/F, 24/F

THE TOTAL FLOOR PLANS  
 OF COURTS WALL  
 AT 18/F TO 24/F

SCALE: 1/200


DATE: 03/11/2018

PROJECT NO: 1837-13-1102

 基特建築有限公司  
 MIDI ARCHITECTURE LIMITED  
 11/F, 12/F, 13/F, 14/F, 15/F, 16/F, 17/F, 18/F, 19/F, 20/F, 21/F, 22/F, 23/F, 24/F  
 18/F, 19/F, 20/F, 21/F, 22/F, 23/F, 24/F  
 18/F, 19/F, 20/F, 21/F, 22/F, 23/F, 24/F  
 18/F, 19/F, 20/F, 21/F, 22/F, 23/F, 24/F



T3 - TYPICAL FLOOR PLAN  
 7/F - 28/F 28/F - 51/F  
 (FLOOR NOS 13, 14, 21, 24 ARE NOT USED)

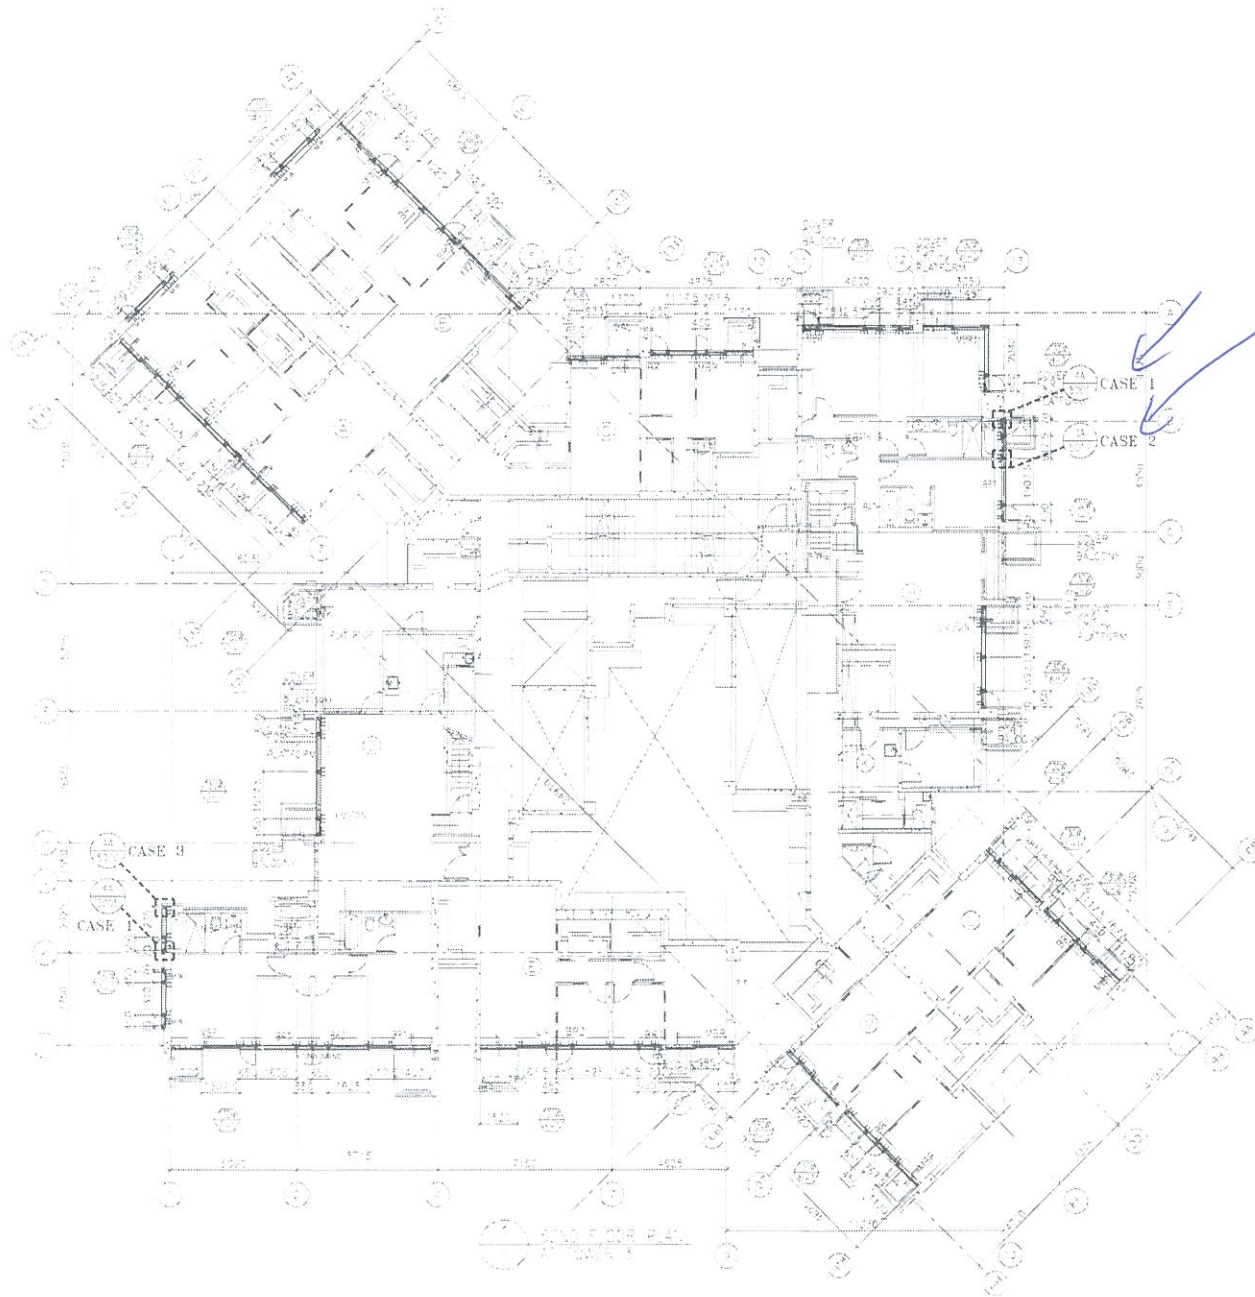

NO. 100

CLIENT  
 信和置業有限公司  
 Ind. Land Company Limited

ARCHITECT  
 WONG TUNG & PARTNERS LIMITED  
 ARCHITECTS & PLANNERS

DATE CONTRACTOR  
 CR Construction Company Limited

STRUCTURAL ENGINEER  
 ACCOM

MECHANICAL CONSULTANT  
 ACCOM

NOTES  
 1. ALL DIMENSIONS ARE IN MM.  
 2. ALL ELEVATIONS ARE VIEWED FROM OUTSIDE.  
 3. ALL DIMENSIONS TO BE VERIFIED ON SITE BEFORE CONSTRUCTION.

LEGEND  
 100% FINISH AND PAINT  
 REFER SHEET NO.  
 1. FINISH - FINISH AND PAINT LEVEL  
 2. FINISH - FINISH AND PAINT LEVEL  
 3. FINISH - FINISH AND PAINT LEVEL

NO.	DATE	REVISION
1	2011/12/14	GENERAL NOTES
2	2011/12/14	GENERAL REVISION
3	2011/12/14	GENERAL REVISION
4	2011/12/14	GENERAL REVISION

PROJECT  
 4/F-5/F CURTAIN WALL REPAIR WORK AT  
 100% FINISH AND PAINT LEVEL

DATE 2011/12/14  
 DRAWN BY ABING  
 CHECKED BY

MECHANICAL CONSULTANT  
 MIDY MECHANICAL ENGINEERING CORPORATION  
 10/F, 100, QUEEN'S ROAD EAST, HONG KONG  
 TEL: 2525 1111 FAX: 2525 1112  
 WWW.MIDY.COM.HK

T:\architect\100% Finish And Paint\100% Finish And Paint\100% Finish And Paint\100% Finish And Paint.dwg, 15/11/11



