



工程指示 / 要求簡箋(E.I.)

工程指示編號：EI 0067

修改版次：

工程編號：J837

工程名稱：觀塘重建住宅項目- 平台

工程項目：3/F 平台 Window Wall 百葉-雀仔網樣板

收件人：羅小姐/ 林哥

發件人：Johnny

日期：2019/01/11

要求提供 / 確認 事項：

- | | | |
|------------------------------------|-------------------------------------|-------------------------------|
| <input type="checkbox"/> 初步鋁料 B.M. | <input type="checkbox"/> 加工拆圖，然後生產 | <input type="checkbox"/> 尺寸表 |
| <input type="checkbox"/> 正式鋁料 B.M. | <input type="checkbox"/> 技術上資料 / 指示 | <input type="checkbox"/> 報價 |
| <input type="checkbox"/> 配件 B.M. | <input type="checkbox"/> 樣辦或貨品說明書 | <input type="checkbox"/> 分判合約 |
| <input type="checkbox"/> 其他：_____ | | |

內容：

請提供以下雀仔網樣板 x 3 份 (300x300mm)

G.M.S WIRE MESH 6*6*1mm 需噴灰色

*大貨預算數量約 1.44(H) 250m(L)-> "需待完成 BM 確認" (由廠完成加工出貨)

請在 25/01/2018 前完成上列要求。

附有關圖紙 / 文件：

以上項目為：

- 原合約工程包 原合約工程加 / 減賬 新工程報價

原因：-

分發東莞各部門：

- 生產技術總監 連附件 技術部 連附件 生產部 連附件 機械設計部 連附件
 採購部 連附件 生產統籌部 連附件
 質檢部 連附件 會計部 連附件 報關組 連附件 其他 _____ 連附件


分發香港各部門：


- 行政部 連附件 會計部 連附件 統籌部 連附件 工程部地盤科文 連附件
 採購部 連附件 QS 部 連附件 維修部 連附件 其他 _____ 連附件

傳遞編號：


發件人簽署：Johnny

項目經理簽署：PP.

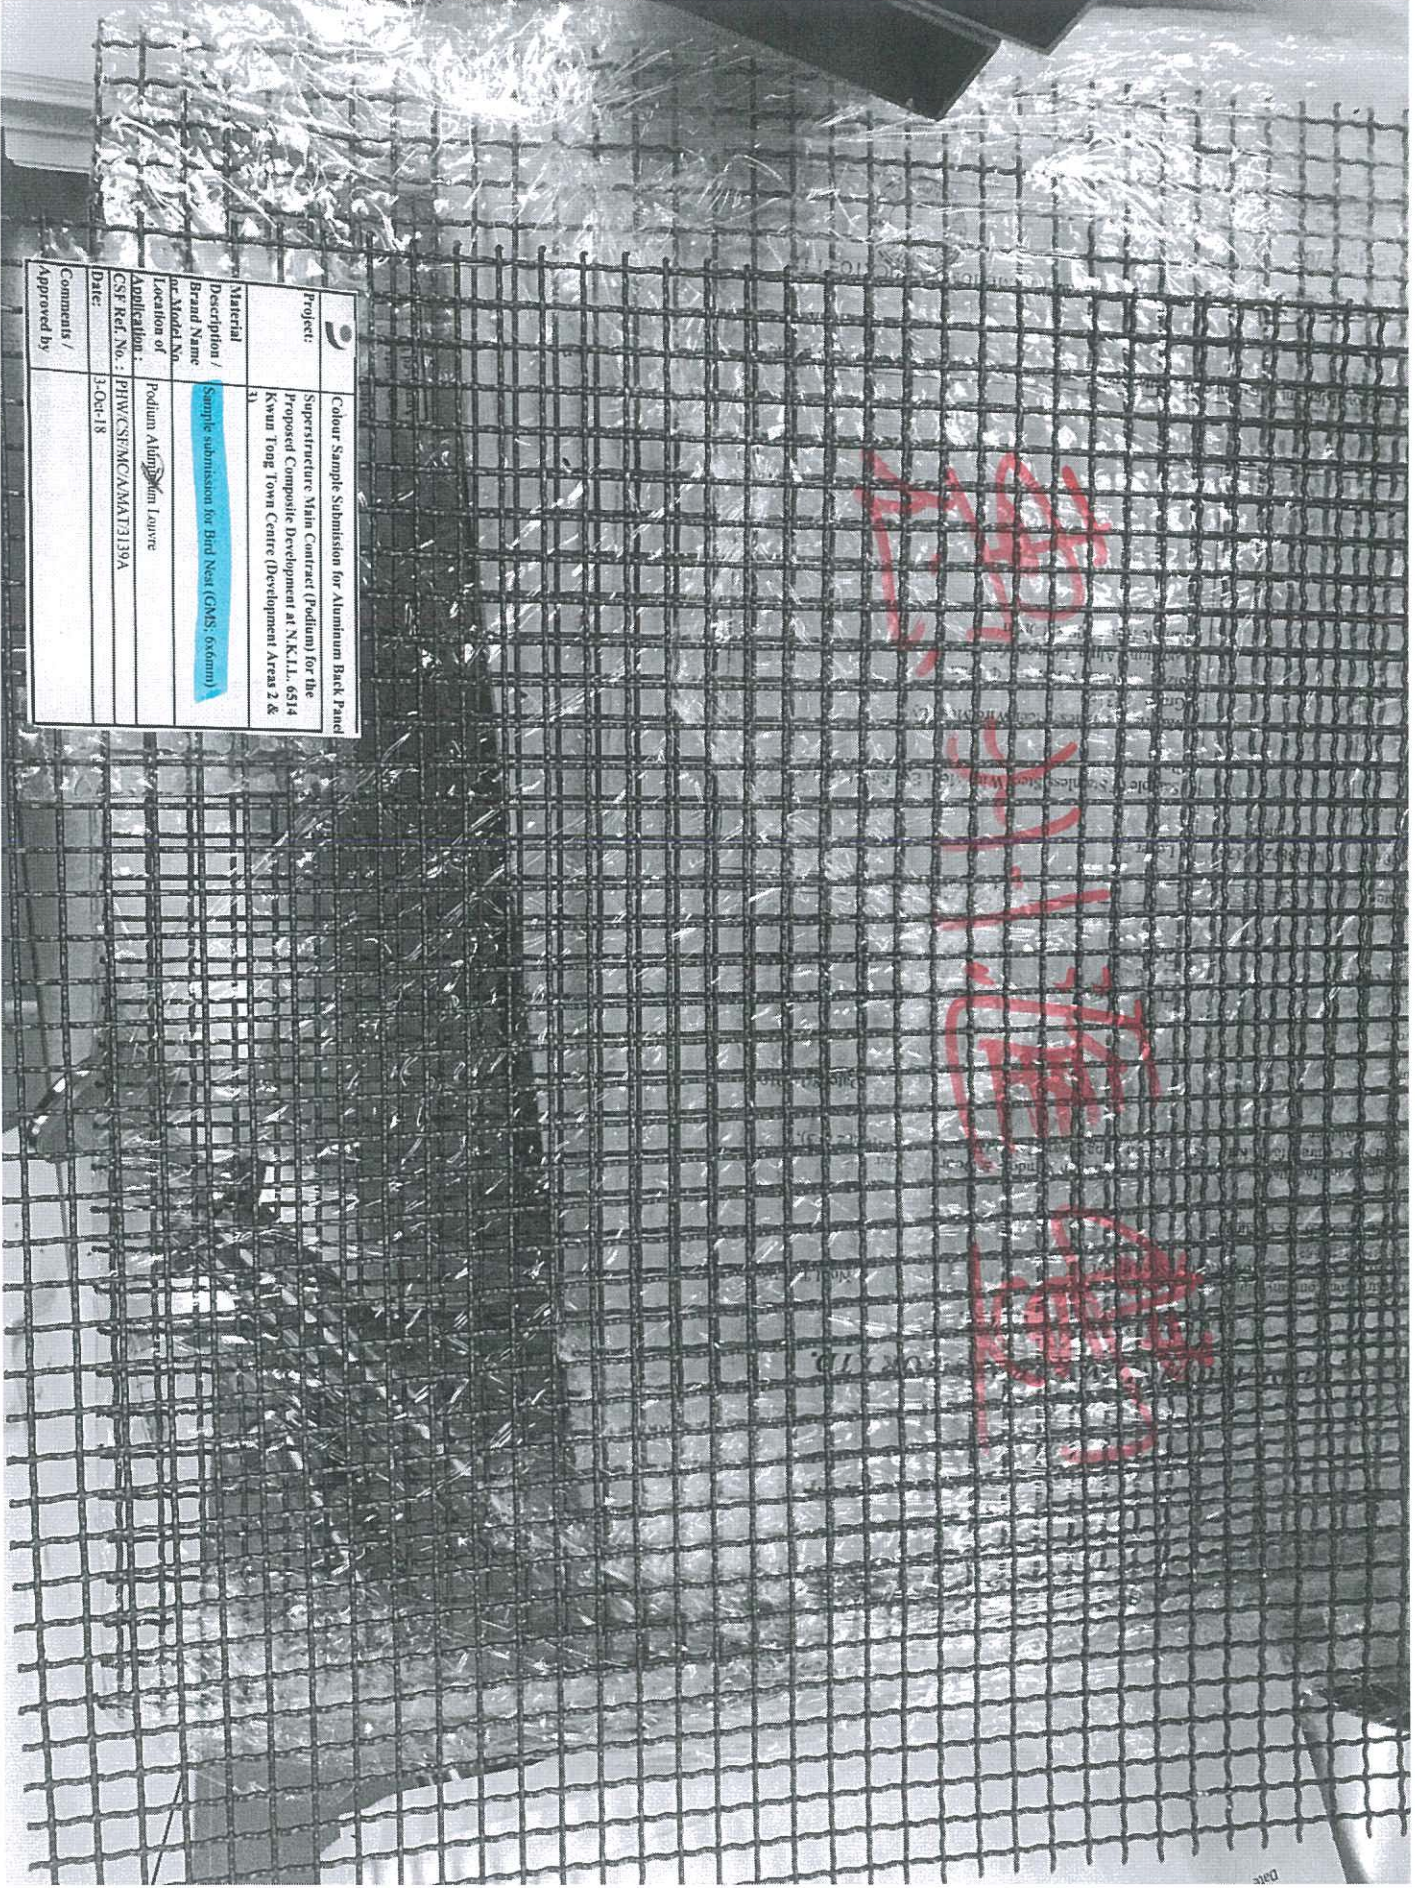



	Colour Sample Submission for Aluminium Back Panel
Project:	Superstructure Main Contract (Podium) for the Proposed Composite Development at N.K.L.L. 6514 Kwun Tong Town Centre (Development Areas 2 & 3)
Material	
Description / Brand Name or Model No	Sample submission for Bird Nest (GNS: 6x6mm)
Location of Application:	Podium Aluminium Louvre
GSE Ref. No.:	PHW/GSE/MC/MAT/139A
Date:	1-Oct-18
Comments / Approved by	

3/4 Total Around
 1,44(CH) x 2.50m(L)

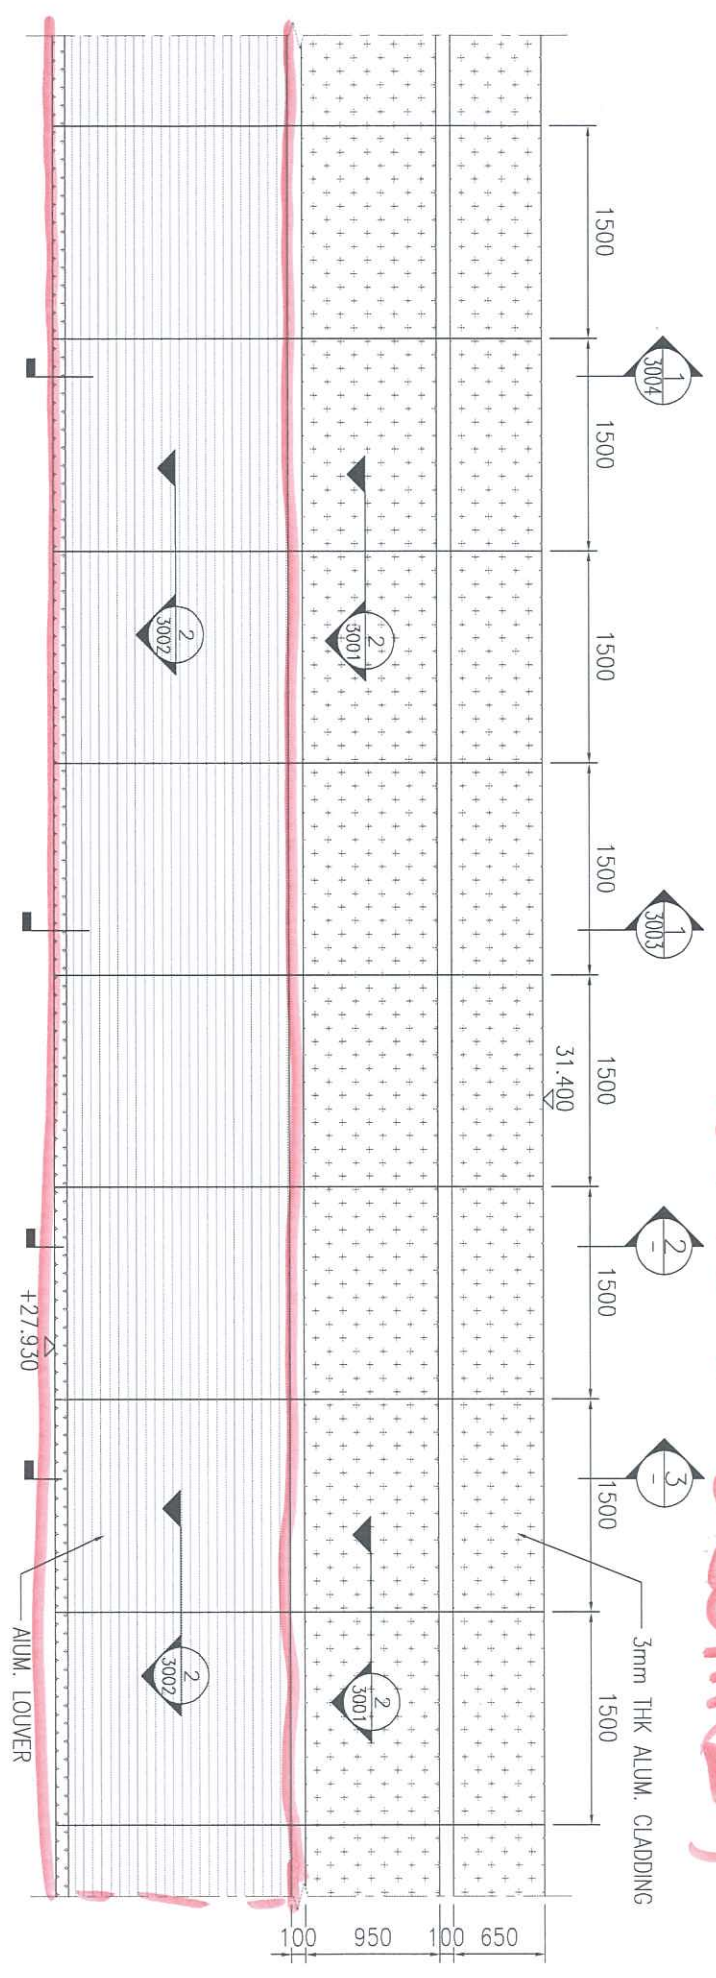

1 ELEVATION
 OF ALUM. FEATURE

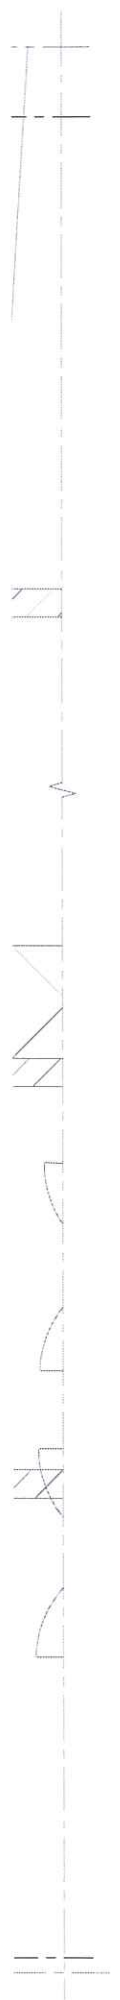

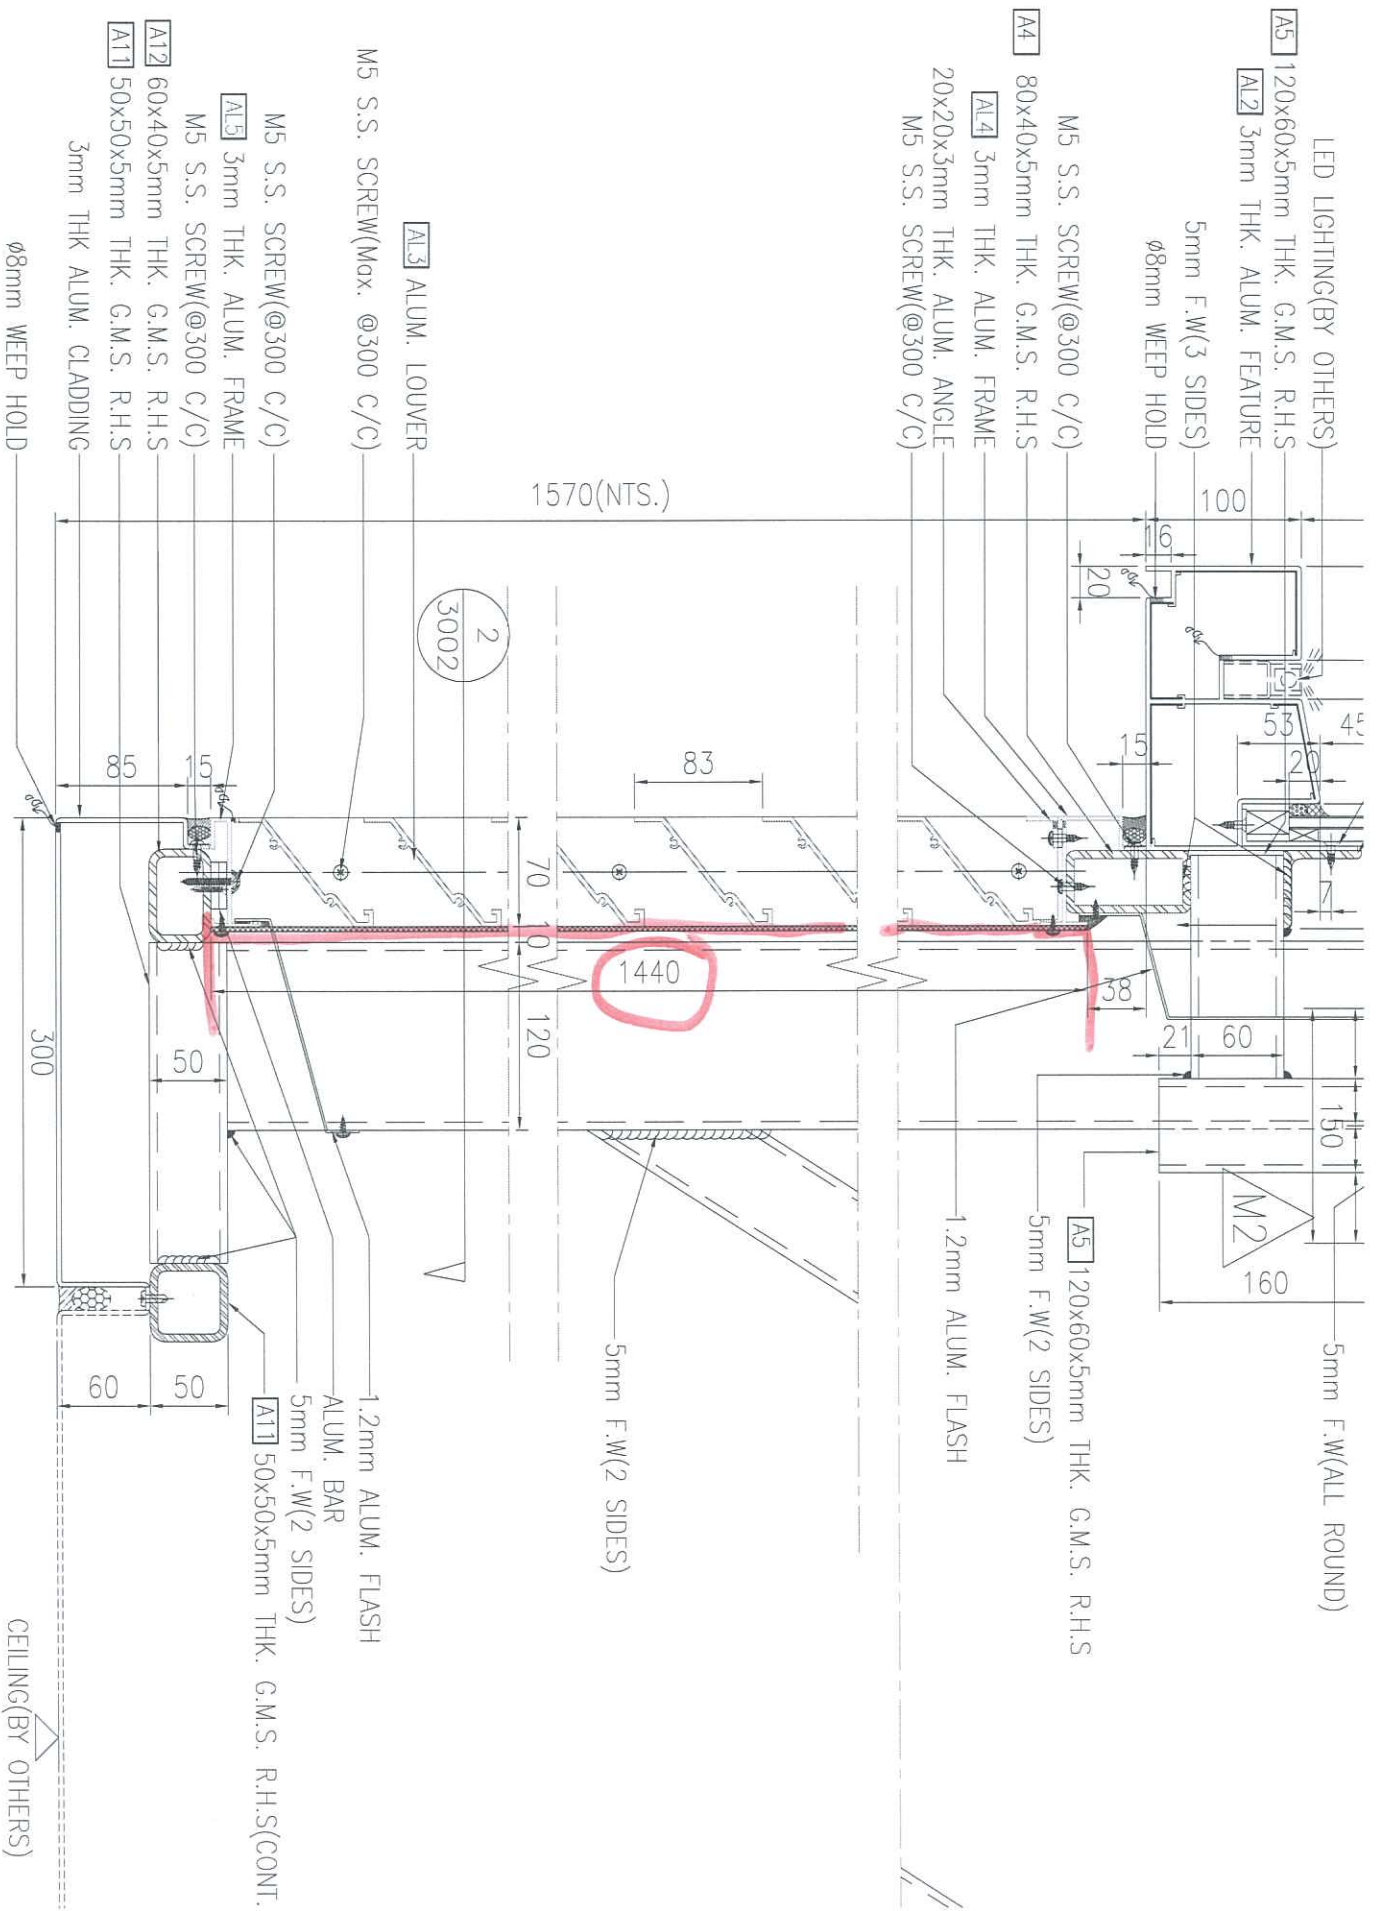

1
3002a
DETAIL OF ALUM. FEATURE AND CLADDING
(TYPE 2)