



工程指示 / 要求簡箋(E.I.)

工程指示編號：EI/0090/19

修改版次：H

工程編號：J837 平台

工程名稱：觀塘 裕民坊

工程項目：平台 Canopy 雨棚

廠用鋁料 BM

收件人：生統/Maggie

發件人：Leung Hin Wai

日期：25/6-2019下午

要求提供 / 確認 事項：

- | | | |
|------------------------------------|-------------------------------------|-------------------------------|
| <input type="checkbox"/> 初步鋁料 B.M. | <input type="checkbox"/> 加工拆圖，然後生產 | <input type="checkbox"/> 尺寸表 |
| <input type="checkbox"/> 正式鋁料 B.M. | <input type="checkbox"/> 技術上資料 / 指示 | <input type="checkbox"/> 報價 |
| <input type="checkbox"/> 配件 B.M. | <input type="checkbox"/> 樣辦或貨品說明書 | <input type="checkbox"/> 分判合約 |
| <input type="checkbox"/> 其他：_____ | | |

內容：確認一頁榮陽拉彎圖。

請在_____前完成上列要求。

附：1 + 1 頁

以上項目為：

- 原合約工程包 原合約工程加 / 減賬 新工程報價

原因：-

分發東莞各部門：

- () 生產技術總監 連附件 () 技術部 連附件 () 生產部 連附件 () 機械設計部 連附件
 () 採購部 連附件 () 生產統籌部 連附件
 () 質檢部 連附件 () 會計部 連附件 () 報關組 連附件 () 其他 _____ 連附件

分發香港各部門：

- () 行政部 連附件 () 會計部 連附件 () 統籌部 連附件 () 工程部地盤科文 連附件
 (/) 採購部 連附件 () QS 部 連附件 () 維修部 連附件 () 其他 _____ 連附件

傳遞編號

74K 1467


發件人簽署：

項目經理簽署：

CUSTOMER	HONGKONG CO.	CUSTOMER APPROVAL	CUST PART NO.	YP-XC-LH1b
			SECTION NO.	LH0090291(F09)


此面为外圆

美特铝质有限公司	
承認圖面	
日期	25/6-2016

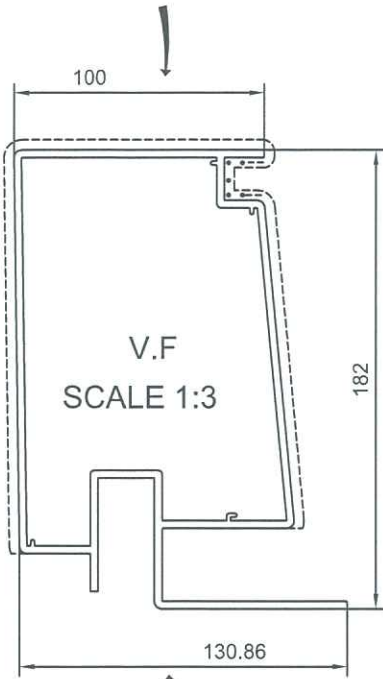

SECTION A-A

此面为内圆

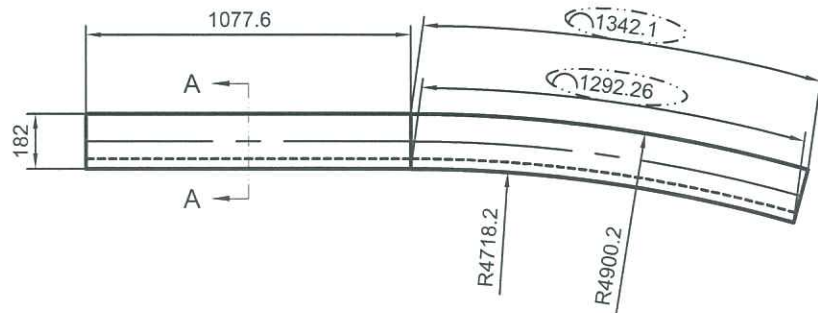

技术要求:

- 1.平面度偏差0~3.0mm;
- 2.扭拧度偏差0~5.0mm;
- 3.角度变形±1.5°;
- 4.产品未注公差±3.0mm;
- 5.允许两端各预留10mm钳口位。

Total weight: 13.595 kg/pcs

Unspecified Fabricated Tolerance: ±3.0

拉弯前展开长度: 2394.78 mm

外弧长度: 2419.7 mm

SIGNATURE GRADEING	HIGH SIGNATURE GRADEING	C.C.DIA(MM)	Ø227.73						
AREA (SQ MM)	2094.91	UNSPECIFIED THICKNESS	3±0.25	PERIMETER (MM)	836.34	STANDARD	BS EN755	SCALE	1:25
MASS (KG/M)	5.677	UNSPECIFIED CORNERS	R 0.3	SURFACE AREA	443.17	ALLOY	6063-T6	VERSION	B
COMPANY ISSUE		A	DRAWN	陈晓舒	DATE	2019-06-25	APPELLATION	-	PAGE OF
			STANDARDIZATION		DATE				
			TO SIGN	陈国提	DATE				
			AUDITING		DATE				
MARKER	MODIFY	FILE NO	SIGNATURE	DATE	APPROV	DATE			



PANASIA ALUMINUM (CHINA) LIMITED