



工程指示 / 要求簡箋(E.I.)

工程指示編號：EI/2017 修改版次：D
 工程編號：J837 平台 工程名稱：觀塘 裕民坊平台
 工程項目：趟摺門(天窗位置)
 收件人：生鏡 發件人：Leung Hin Wai 日期：31/07/2020

要求提供 / 確認 事項：

- | | | |
|------------------------------------|-------------------------------------|-------------------------------|
| <input type="checkbox"/> 初步鋁料 B.M. | <input type="checkbox"/> 加工拆圖，然後生產 | <input type="checkbox"/> 尺寸表 |
| <input type="checkbox"/> 正式鋁料 B.M. | <input type="checkbox"/> 技術上資料 / 指示 | <input type="checkbox"/> 報價 |
| <input type="checkbox"/> 配件 B.M. | <input type="checkbox"/> 樣辦或貨品說明書 | <input type="checkbox"/> 分判合約 |
| <input type="checkbox"/> 其他：_____ | | |

內容：
 請訂購 6 幅趟摺門，交地盤。
 不包玻璃，要香檳金色。

(7月31日地盤復尺修改)

請在 _____ 前完成上列要求。

附：1+6頁

以上項目為：

- 原合約工程包 原合約工程加 / 減賬 新工程報價

原因：-

分發東莞各部門：

- () 生產技術總監 連附件 () 技術部 連附件 () 生產部 連附件 () 機械設計部 連附件
 () 採購部 連附件 () 生產統籌部 連附件
 () 質檢部 連附件 () 會計部 連附件 () 報關組 連附件 () 其他 _____ 連附件

分發香港各部門：



- () 行政部 連附件 () 會計部 連附件 () 統籌部 連附件 () 工程部地盤科文(柄) 連附件
 () 採購部 連附件 () QS 部 連附件 () 維修部 連附件 () 其他 _____ 連附件

傳遞編號：HK1631

發件人簽署：
 項目經理簽署：


OK

✓

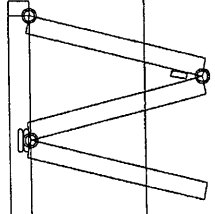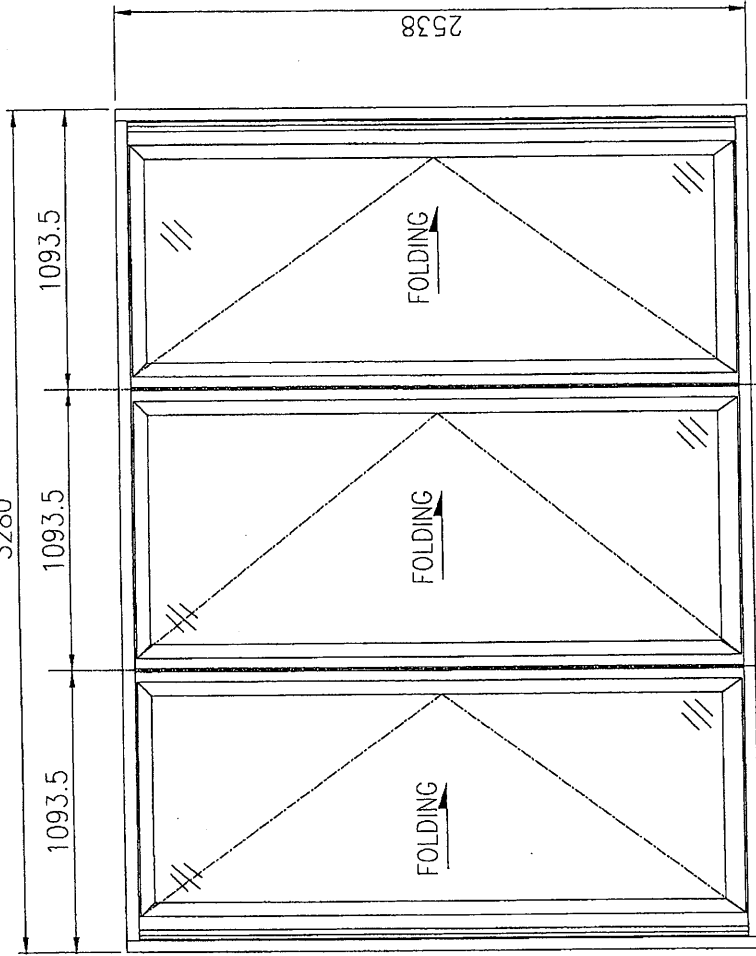


OUTSIDE

WINDOW MARK			
LOCATION :	PODIUM 5/F SKYLIGHT	COLOR :	-
GLAZING :	12mm THK. LOW IRON TEMPERED GLASS	QUANTITY :	1
		PROVIDED GLAZING AREA :	- m ²
		PROVIDED OPENABLE AREA :	- m ²
		REMARK :	

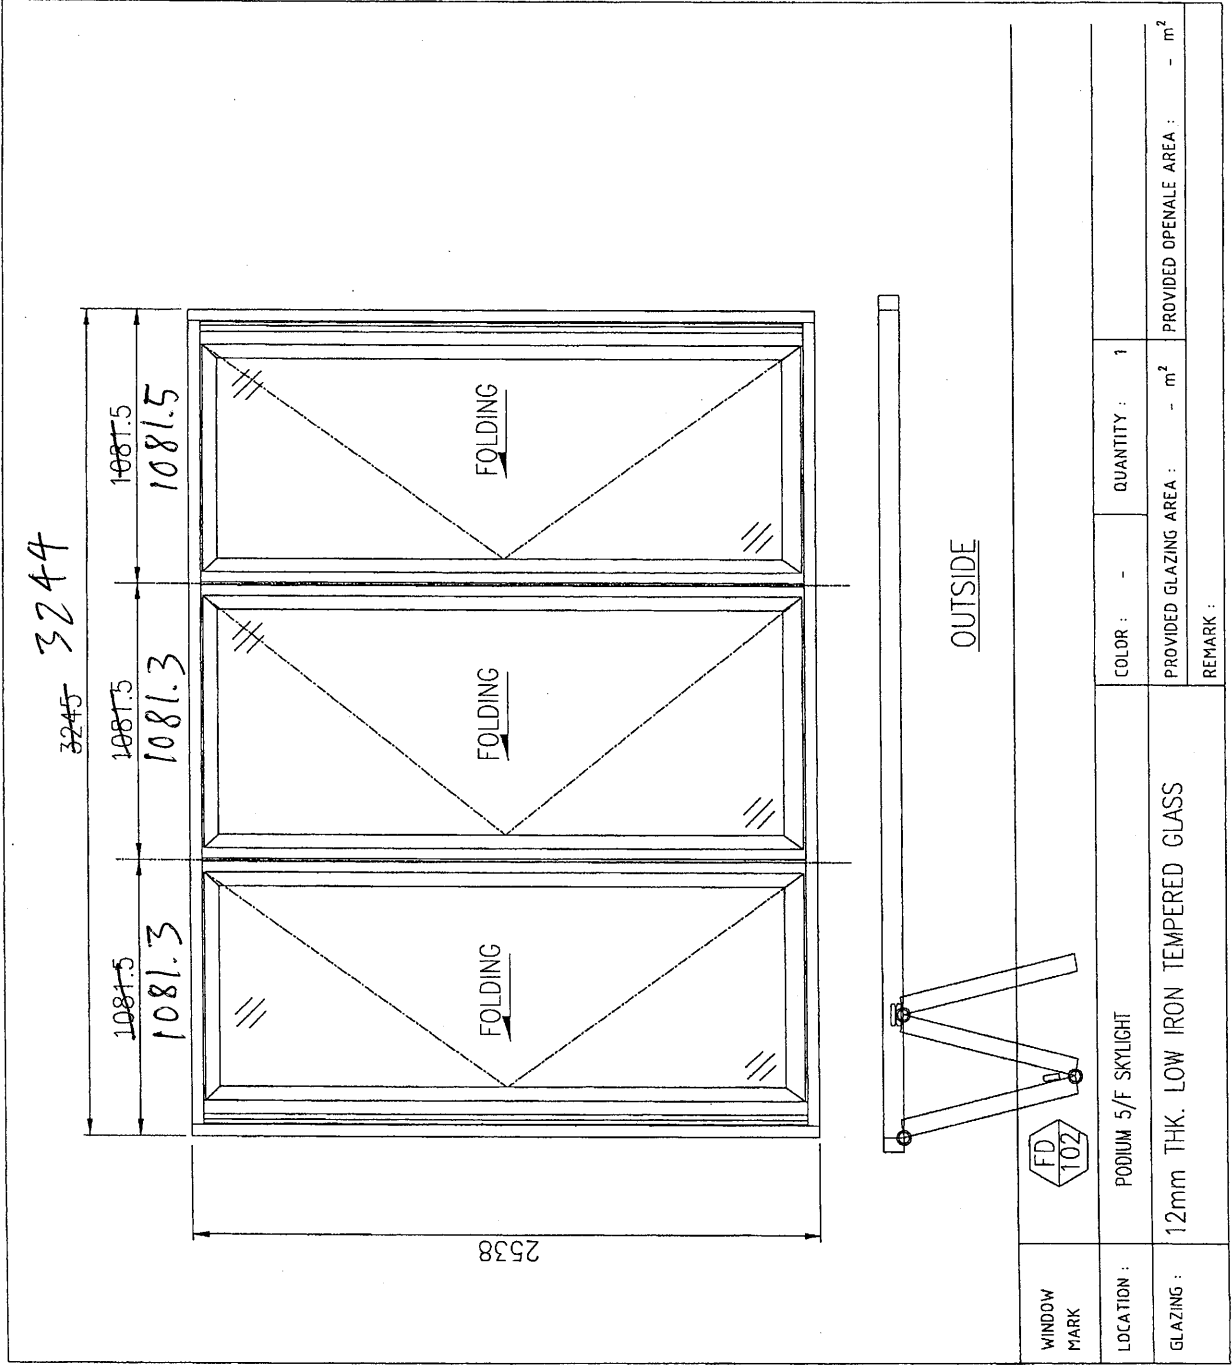

WINDOW MARK	FD 102	
LOCATION :	PODIUM 5/F SKYLIGHT	
GLAZING :	12mm THK. LOW IRON TEMPERED GLASS	
	COLOR : -	QUANTITY : 1
	PROVIDED GLAZING AREA : - m ²	PROVIDED OPENABLE AREA : - m ²
	REMARK :	

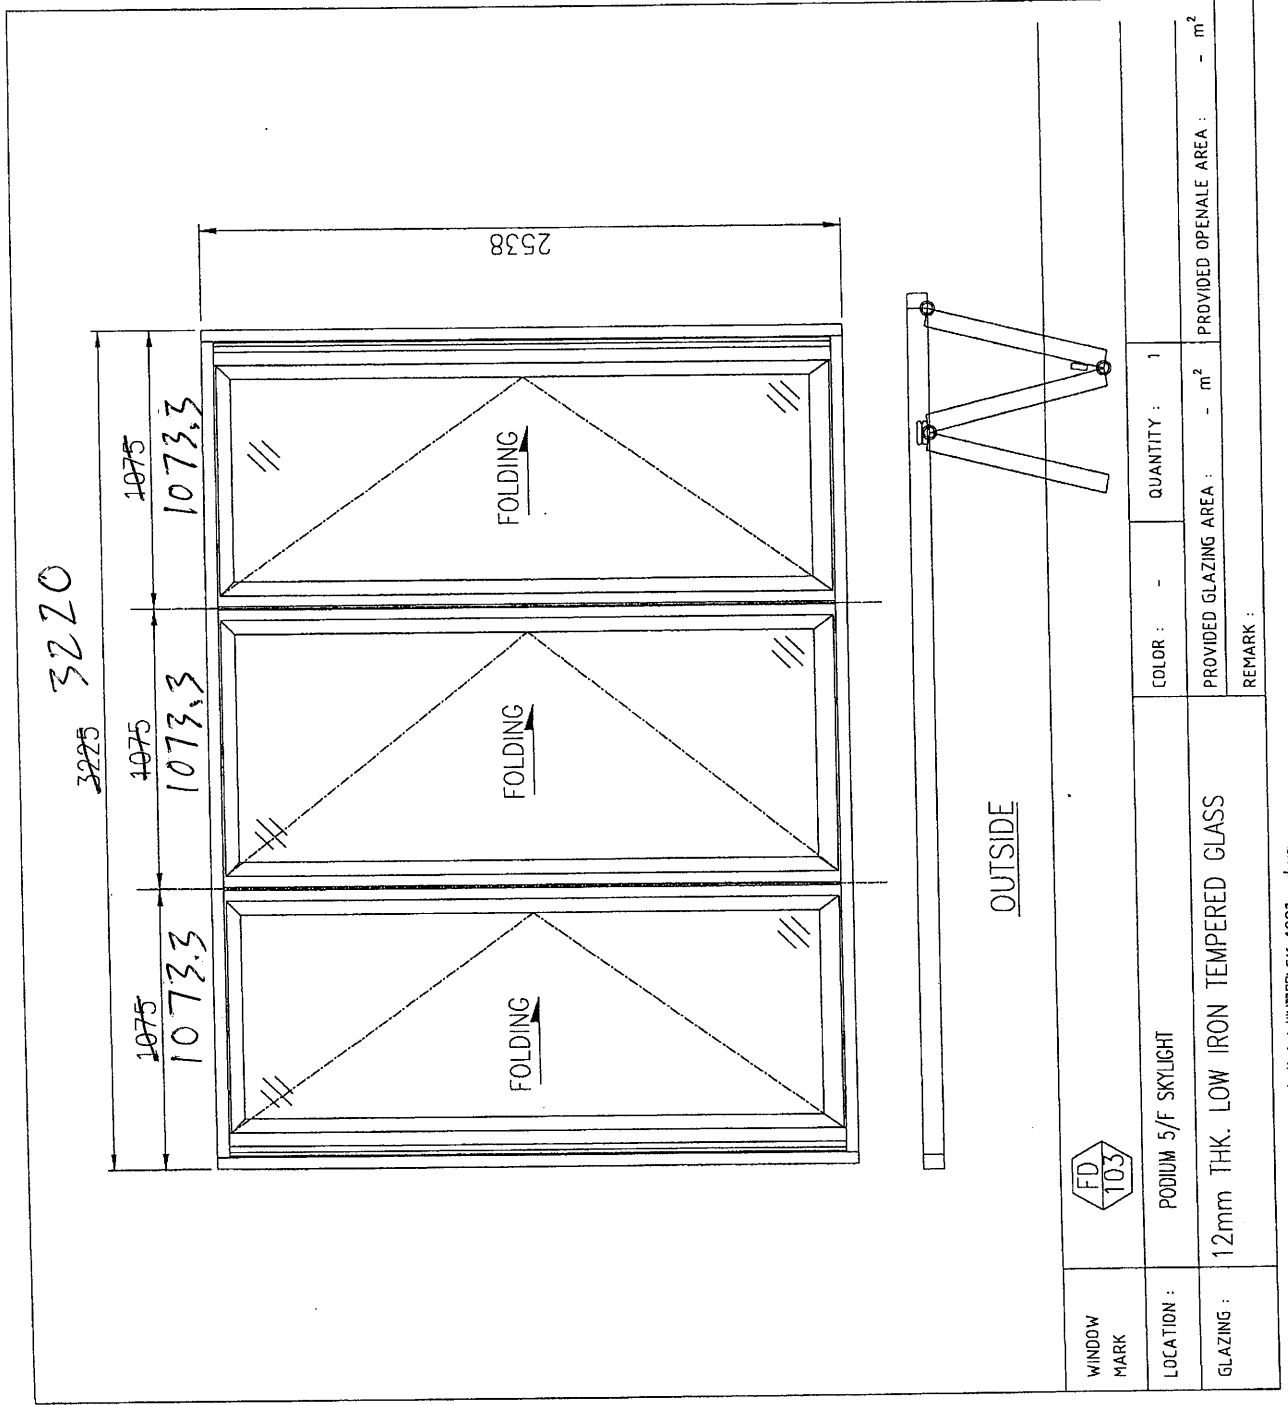

FD
103

WINDOW
MARK

PODIUM 5/F SKYLIGHT

LOCATION :


GLAZING : 12mm THK. LOW IRON TEMPERED GLASS

COLOR : - QUANTITY : 1

PROVIDED GLAZING AREA : - m²



PROVIDED OPERABLE AREA : - m²

REMARK :

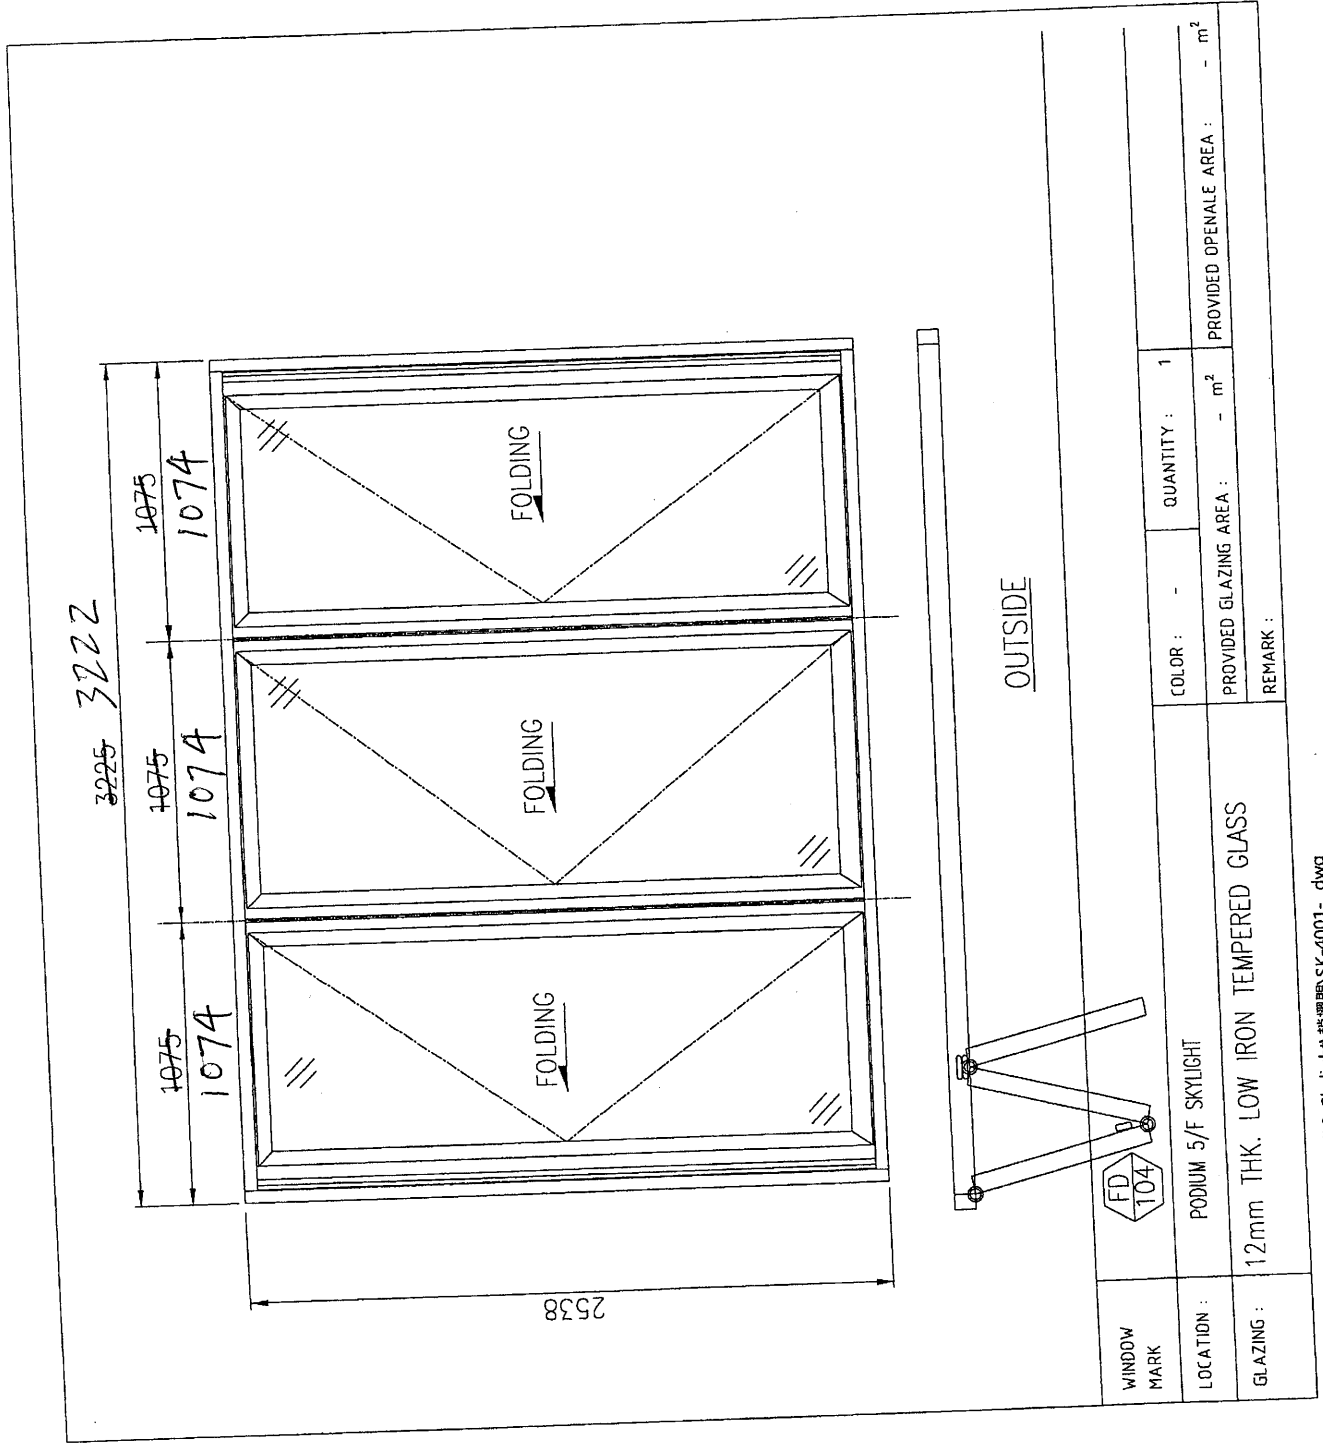


WINDOW MARK	FD 104	COLOR :	-	QUANTITY :	1	PROVIDED OPENALE AREA :	- m ²
LOCATION :	PODIUM 5/F SKYLIGHT						
GLAZING :	12mm THK. LOW IRON TEMPERED GLASS						
REMARK :		PROVIDED GLAZING AREA :	-		m ²		

3243

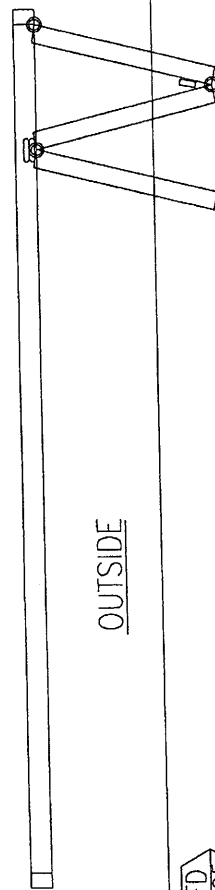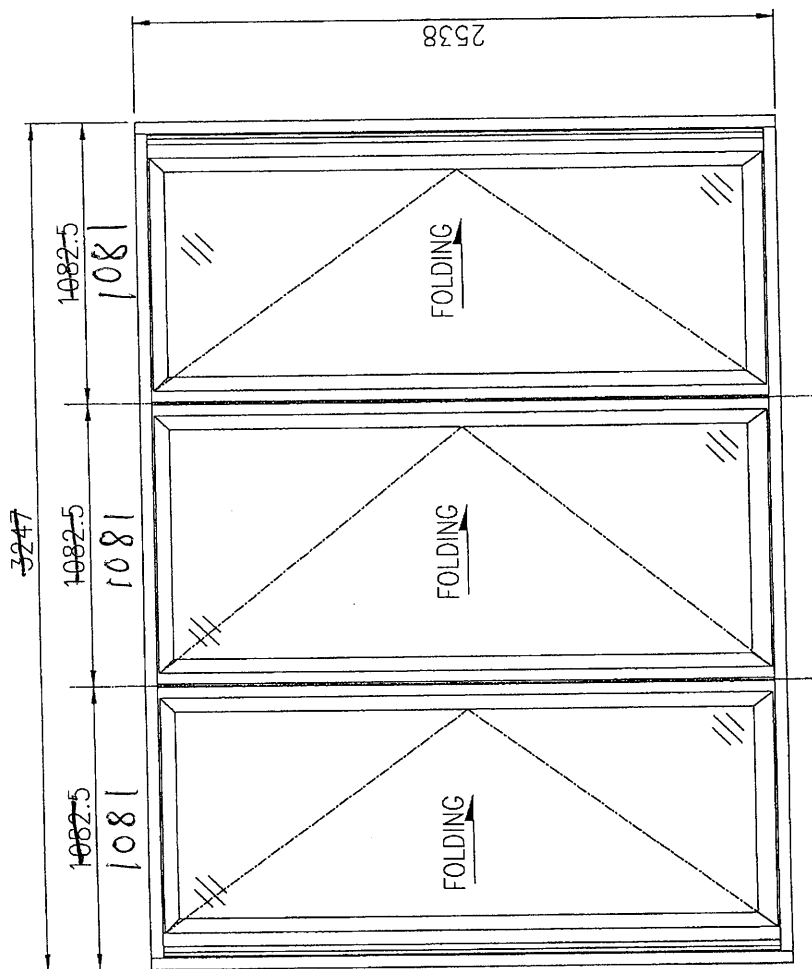

OUTSIDE

WINDOW MARK		COLOR : -	QUANTITY : 1
LOCATION :	PODIUM 5/F SKYLIGHT	PROVIDED GLAZING AREA : - m ²	PROVIDED OPENABLE AREA : - m ²
GLAZING :	12mm THK. LOW IRON TEMPERED GLASS	REMARK :	

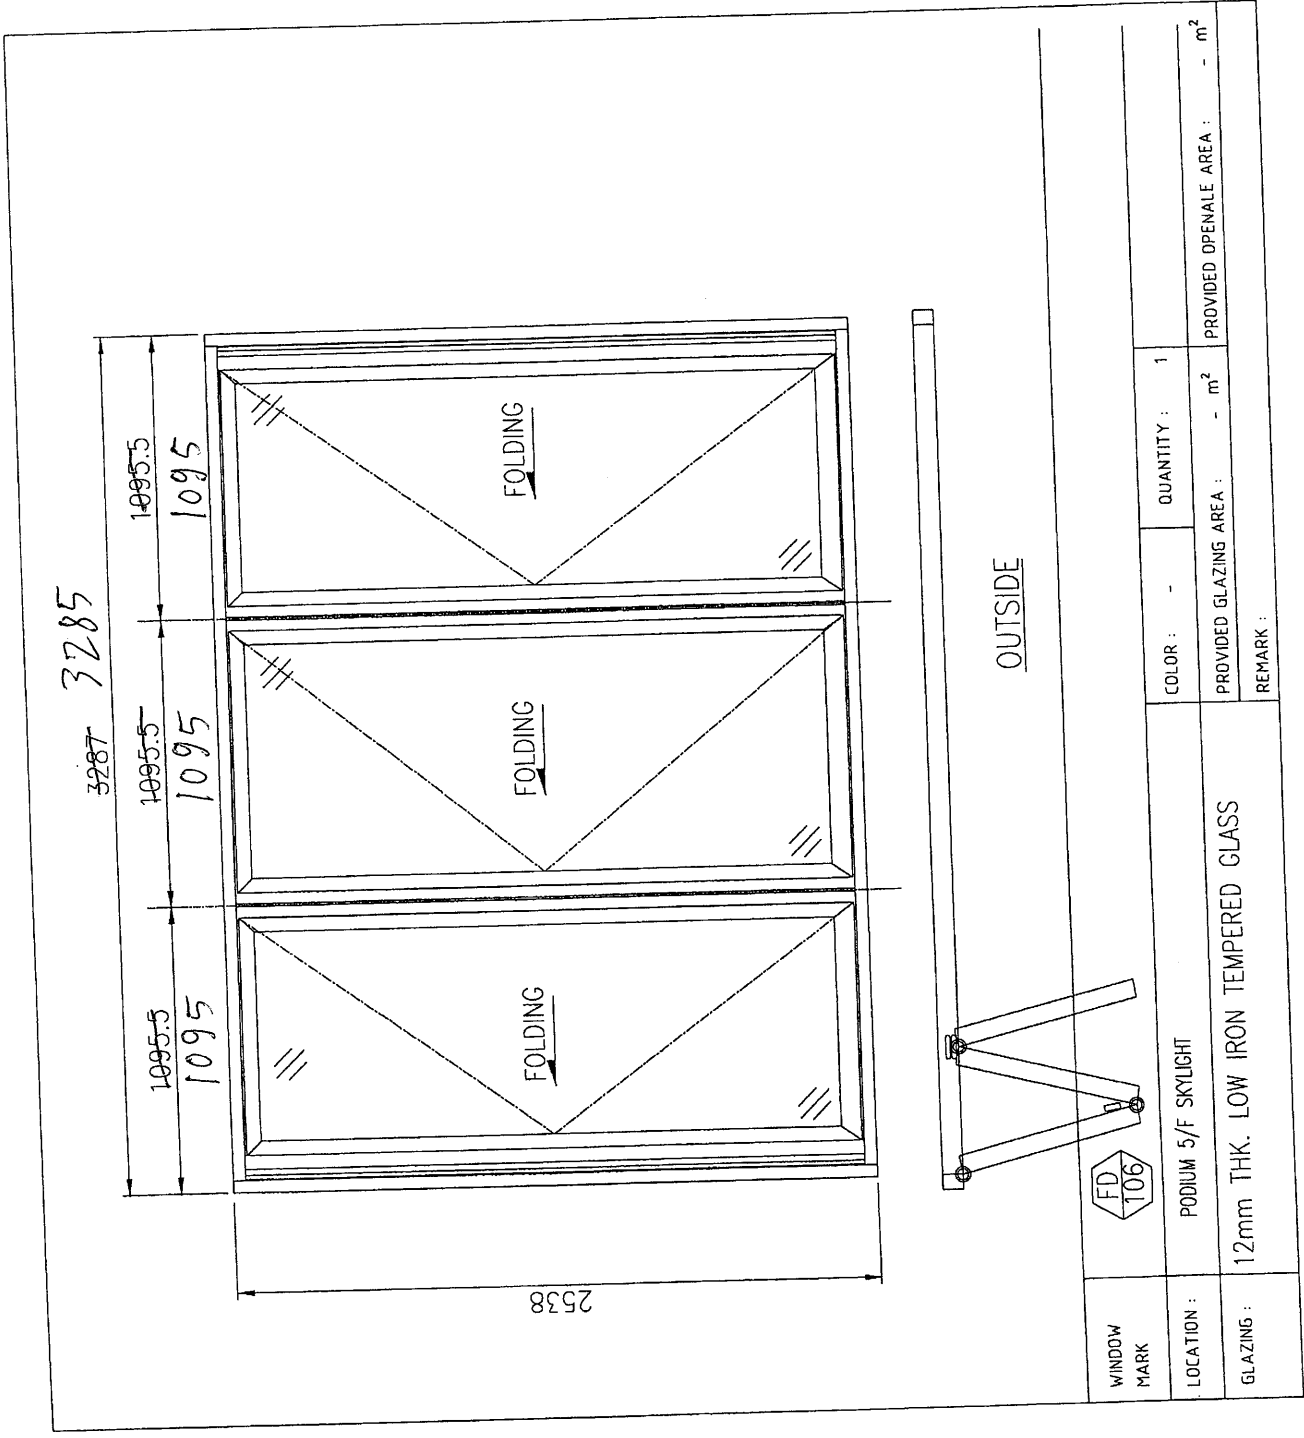

WINDOW MARK	FD TO 106		COLOR : -	QUANTITY : 1	PROVIDED OPENABLE AREA : - m ²
LOCATION :	PODIUM 5/F SKYLIGHT				
GLAZING :	12mm THK. LOW IRON TEMPERED GLASS				
PROVIDED GLAZING AREA :			- m ²		REMARK :