



工程指示編號：EI / 2137

修改版次：-

工程編號：J837 平台

工程名稱：觀塘 裕民坊平台

工程項目：按排地盤驗焊

(Skylight 項目)

收件人：Maggie

發件人：Leung Hin Wai

日期：16/7-2020

要求提供 / 確認 事項：

- | | | |
|------------------------------------|-------------------------------------|-------------------------------|
| <input type="checkbox"/> 初步鋁料 B.M. | <input type="checkbox"/> 加工拆圖，然後生產 | <input type="checkbox"/> 尺寸表 |
| <input type="checkbox"/> 正式鋁料 B.M. | <input type="checkbox"/> 技術上資料 / 指示 | <input type="checkbox"/> 報價 |
| <input type="checkbox"/> 配件 B.M. | <input type="checkbox"/> 樣辦或貨品說明書 | <input type="checkbox"/> 分判合約 |
| <input type="checkbox"/> 其他：_____ | | |

內容：

地盤驗焊 100%目測、100%磁粉

位置附圖紅圈和箭咀

請在_____前完成上列要求。

附：

1+3頁

以上項目為：

原合約工程包

原合約工程加 / 減賬

新工程報價

原因：-

分發東莞各部門：

- | | | | | | | | |
|---------------------------------|------------------------------|--------------------------------|------------------------------|------------------------------|------------------------------|-----------------------------------|------------------------------|
| <input type="checkbox"/> 生產技術總監 | <input type="checkbox"/> 連附件 | <input type="checkbox"/> 技術部 | <input type="checkbox"/> 連附件 | <input type="checkbox"/> 生產部 | <input type="checkbox"/> 連附件 | <input type="checkbox"/> 機械設計部 | <input type="checkbox"/> 連附件 |
| <input type="checkbox"/> 採購部 | <input type="checkbox"/> 連附件 | <input type="checkbox"/> 生產統籌部 | <input type="checkbox"/> 連附件 | | | | |
| <input type="checkbox"/> 質檢部 | <input type="checkbox"/> 連附件 | <input type="checkbox"/> 會計部 | <input type="checkbox"/> 連附件 | <input type="checkbox"/> 報關組 | <input type="checkbox"/> 連附件 | <input type="checkbox"/> 其他 _____ | <input type="checkbox"/> 連附件 |

分發香港各部門：

- | | | | | | | | |
|------------------------------|------------------------------|-------------------------------|------------------------------|------------------------------|------------------------------|--|---|
| <input type="checkbox"/> 行政部 | <input type="checkbox"/> 連附件 | <input type="checkbox"/> 會計部 | <input type="checkbox"/> 連附件 | <input type="checkbox"/> 統籌部 | <input type="checkbox"/> 連附件 | <input checked="" type="checkbox"/> 工程部地盤科文(柄) | <input checked="" type="checkbox"/> 連附件 |
| <input type="checkbox"/> 採購部 | <input type="checkbox"/> 連附件 | <input type="checkbox"/> QS 部 | <input type="checkbox"/> 連附件 | <input type="checkbox"/> 維修部 | <input type="checkbox"/> 連附件 | <input type="checkbox"/> 其他 _____ | <input type="checkbox"/> 連附件 |

傳遞編號：

發件人簽署：

項目經理簽署：

B.D. REF :
 U.S. : Under Separated Submission
 S1 : 400X100X10mm THK DMS S16 (U.S.S.)
 S2 : 250X150X10mm THK DMS S16 (U.S.S.)

CLIENT : 信和置业有限公司
 Sino Land Company Limited

ARCHITECT : WONG TUNG & PARTNERS LIMITED
 ARCHITECTS

MAIN CONTRACTOR : CK Construction Company Limited

STRUCTURAL ENGINEER : AECOM

FAÇADE CONSULTANT : AECOM

NOTE :
 1. ALL DIMENSIONS ARE IN MM.
 2. ALL ELEVATIONS ARE VIEWED FROM OUTSIDE.
 3. ALL DIMENSIONS TO BE VERIFIED ON SITE BEFORE FABRICATION.

LEGEND :
 (A1) - DETAIL MARK NO.
 (A2) - REFER SHEET NO.

1. F.F.L. - FINISHED FLOOR LEVEL
 2. F.F.L. + 100 - FINISHED FLOOR LEVEL + 100
 3. F.F.L. - 100 - FINISHED FLOOR LEVEL - 100
 4. R.F.F.L. - REVERSED DETAIL

LEGEND :
 S1 : 100X100X6.3mm THK DMS S16
 S2a : 150X100X6.3mm THK DMS S16
 S2b : 120X120X6mm THK DMS S16
 S4 : 200X100X6.3mm THK DMS S16
 S5 : 130X130X10mm THK DMS ANGLE
 S7 : 100X75X10mm THK DMS ANGLE
 S8 : 250X150X10mm THK DMS ANGLE
 S11 : 300X300X10mm THK DMS S16
 S12 : 200X200X10mm THK DMS S16
 S13 : 250X150X10mm THK DMS S16

NO. DATE INDEXED BY
 JOB NO. J-837
 PROJECT : LURA KWUN TONG TOWN CENTRE
 REDEVELOPMENT (AREA 2 & 3) AT
 MKL B514, KWUN TONG, HWL LOON

TITLE : TYPICAL DETAIL FOR SKYLIGHT


DATE : 10-05-2020 SCALE : 1/10
 DRAWN BY : ASING CHECKED BY :
 DATE : 10-05-2020

THE WORKS DESCRIBED IN THIS DRAWING ARE THE PROPERTY OF WONG TUNG & PARTNERS LIMITED. NO PART OF THIS DRAWING IS TO BE REPRODUCED OR TRANSMITTED IN ANY FORM OR BY ANY MEANS, ELECTRONIC OR MECHANICAL, INCLUDING PHOTOCOPYING, RECORDING, OR BY ANY INFORMATION STORAGE AND RETRIEVAL SYSTEM, WITHOUT THE WRITTEN PERMISSION OF THE FIRM. ANY UNAUTHORIZED REPRODUCTION OR TRANSMISSION IS STRICTLY PROHIBITED.


NEW DRAWING

FOR BD SUBMISSION


PWG NO. : JB37 - BD-SK-4005 REV. : -

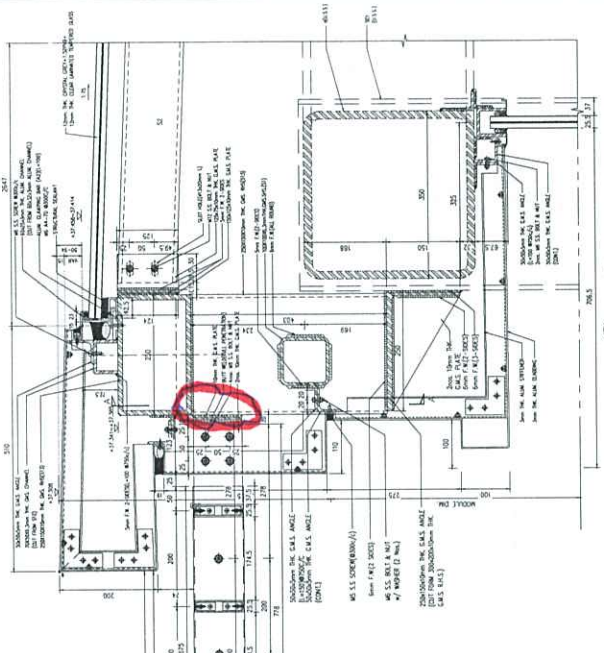

SECTION DETAIL OF SKYLIGHT (1-4)

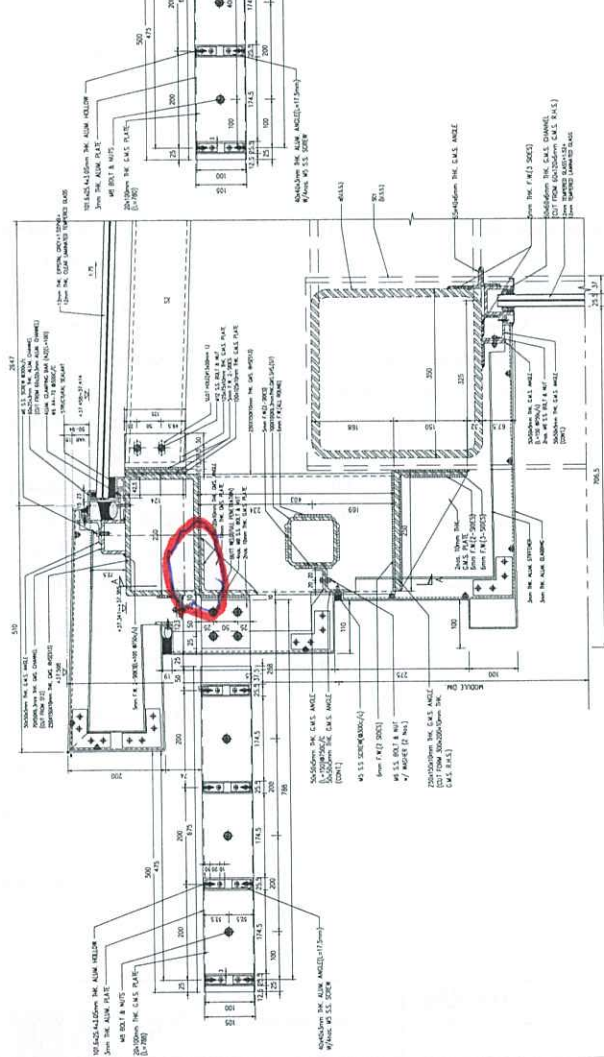

SECTION DETAIL OF SKYLIGHT (1-4)

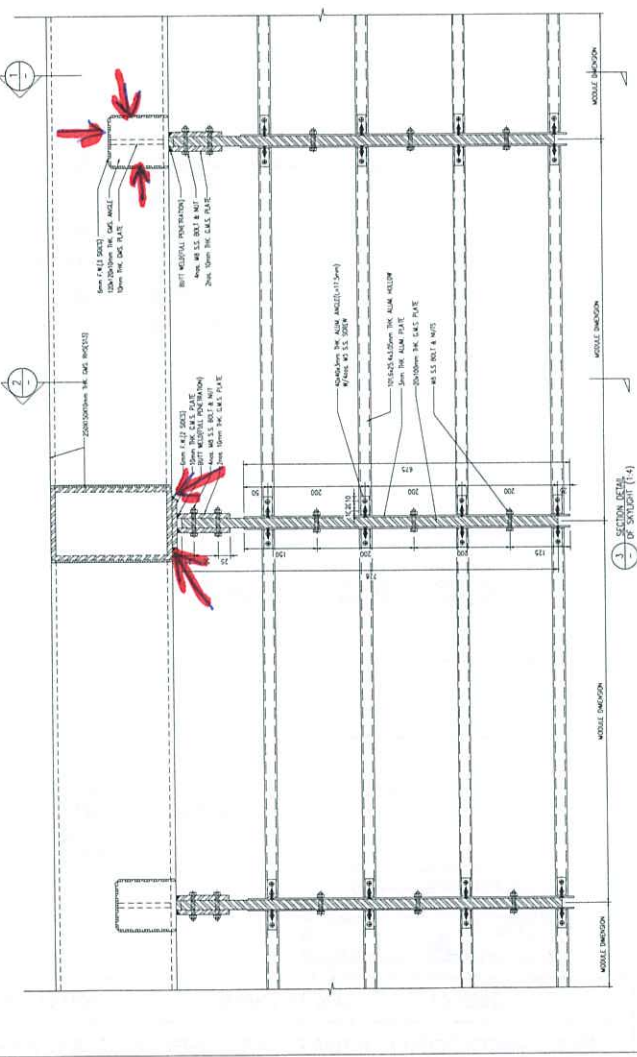

SECTION DETAIL OF SKYLIGHT (1-4)

B.D. REF :
 USS : Under Separated Submission
 S/C : 60040000mm THK CAS S/S
 or 50035000mm THK CAS S/S (0.55)
 or 50035000mm THK CAS S/S (0.53)

CLIENT : 怡和置業有限公司
 Sino Land Company Limited

ARCHITECT : WONG TUNG & PARTNERS LIMITED
 ARCHITECT PLANNERS

MAIN CONTRACTOR : CR Construction Company Limited

STRUCTURAL ENGINEER : AECOM

FRAME CONSULTANT : AECOM

NOTE:
 1. ALL DIMENSIONS ARE IN mm.
 2. ALL ELEVATIONS ARE VIEWED FROM OUTSIDE.
 3. ALL DIMENSIONS TO BE VERIFIED ON SITE BEFORE FABRICATION.

LEGEND:
 (VT) DETAIL MARK NO.
 (NS) FINISHED SHEET NO.
 1. FEEL -- FINISHED FLOOR LEVEL
 2. SEFL -- STRUCTURAL FLOOR LEVEL
 3. (R) -- REVERSED DETAIL


LEGEND:
 S1: 100X100x6mm THK CAS S/S
 S2: 150X150x6mm THK CAS S/S
 S3: 200X200x6mm THK CAS S/S
 S4: 200X200x6mm THK CAS S/S
 S5: 100X75x10mm THK CAS ANGLE
 S6: 100X75x10mm THK CAS ANGLE
 S7: 100X75x10mm THK CAS ANGLE
 S8: 250X100x10mm THK CAS ANGLE
 S11: 150X150x6mm THK CAS S/S
 S12: 200X200x6mm THK CAS S/S
 S13: 250X100x10mm THK CAS S/S

JOB NO : J-837
 PROJECT : URA KWUN TONG TOWN CENTRE
 REDEVELOPMENT (AREA 2 & 3) AT
 NKIL 8514, KWUN TONG, KAWLOON

TITLE : TYPICAL DETAIL FOR SKYLIGHT

DATE : 10-05-2020 SCALE : 1/11 (A1)
 DRAWN BY : ASING CHECKED BY :
 MIDLAND ALUMINUM FABRICATOR LTD.
 610 Che Kwo Ling Road, Kowloon
 Tel: 2489311-4 Fax: (852) 7772665

PWC NO : JB37 - BD-SK-4002 REV : A

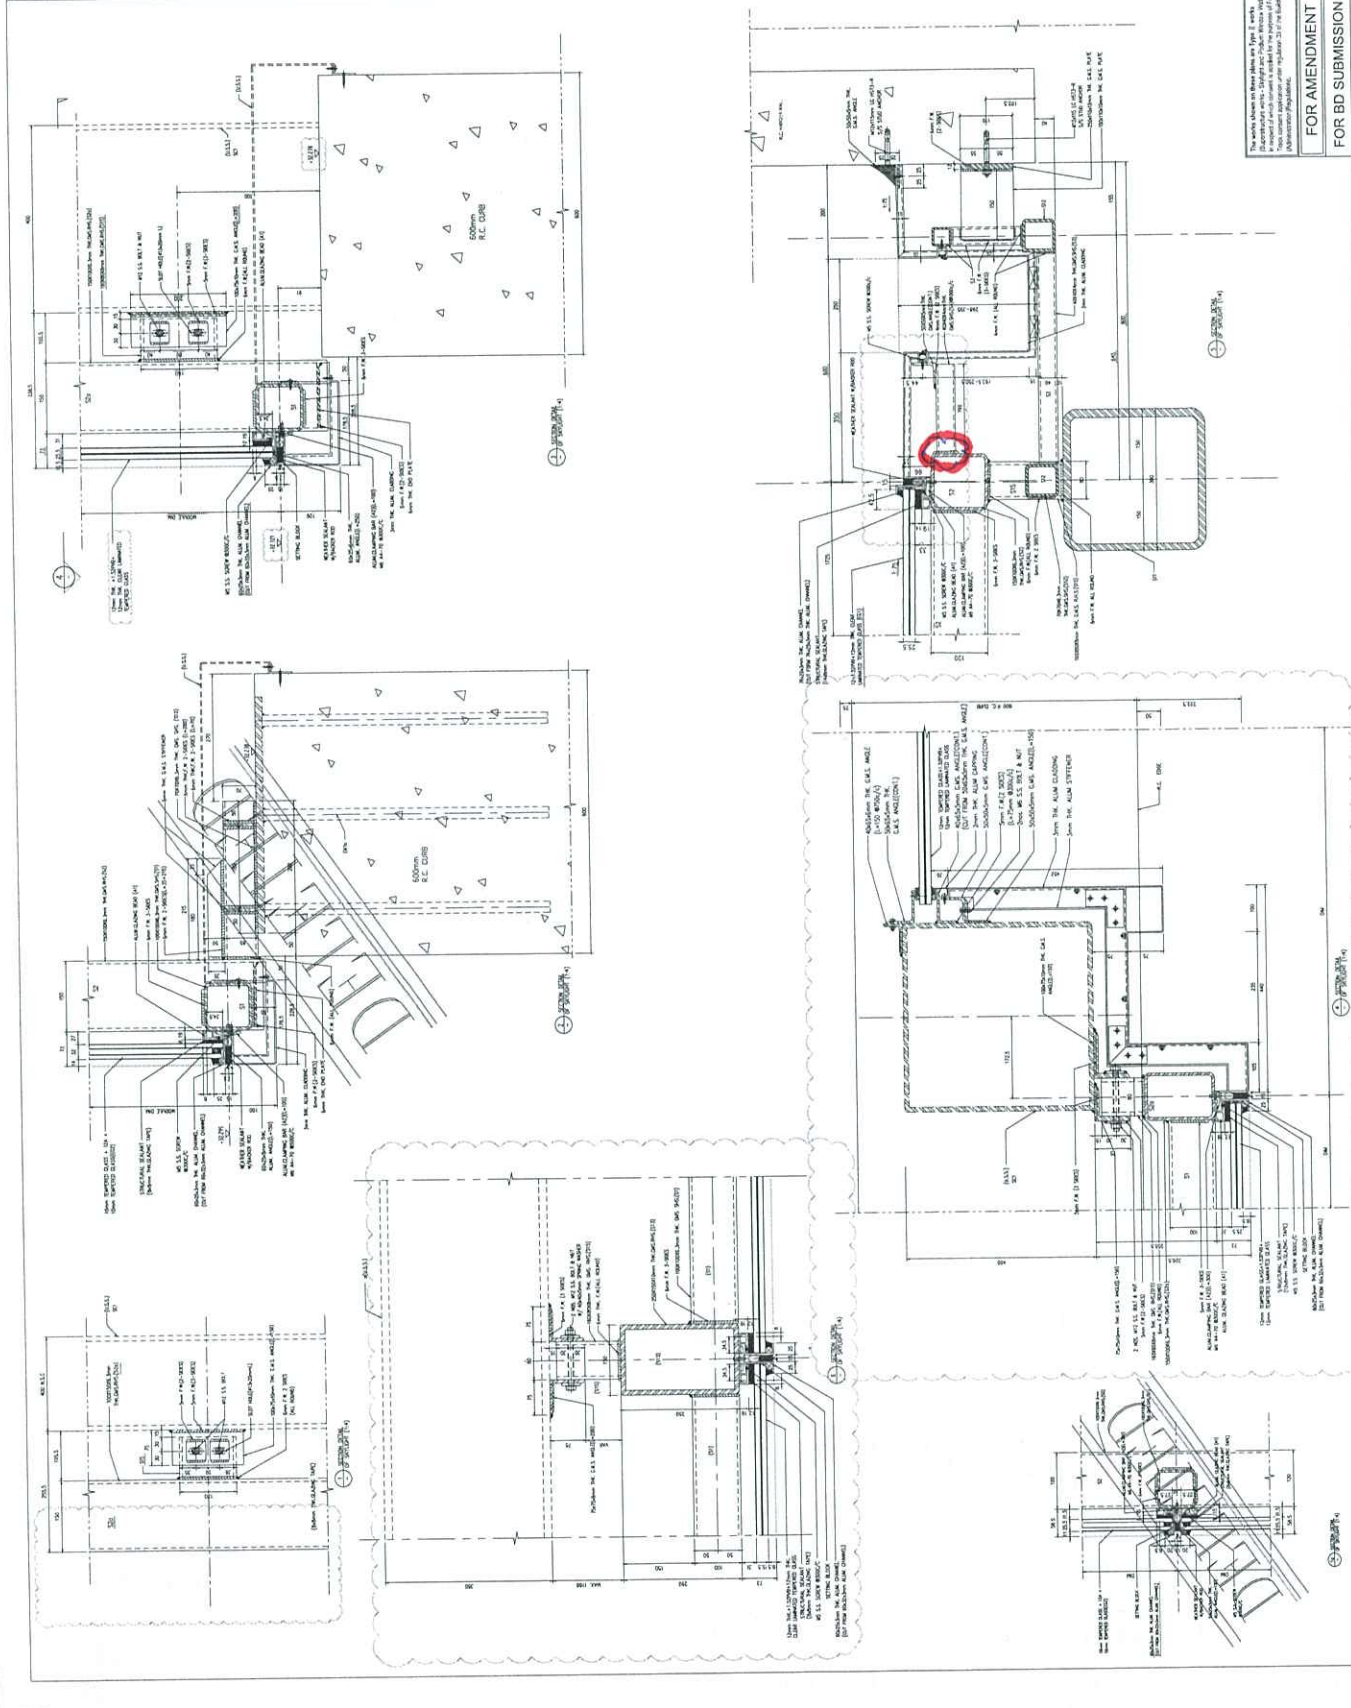

FOR AMENDMENT
 FOR BD SUBMISSION

