


1894

1120

1894

317

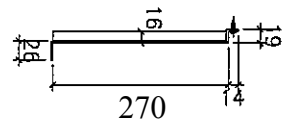

頂

SI 2555

J837-VO-001


3/F 後加鋁摺件



3mm 厚鋁板

顏色: UCT803649FXL-3(香檳金)

數量: 共 1 件


本物

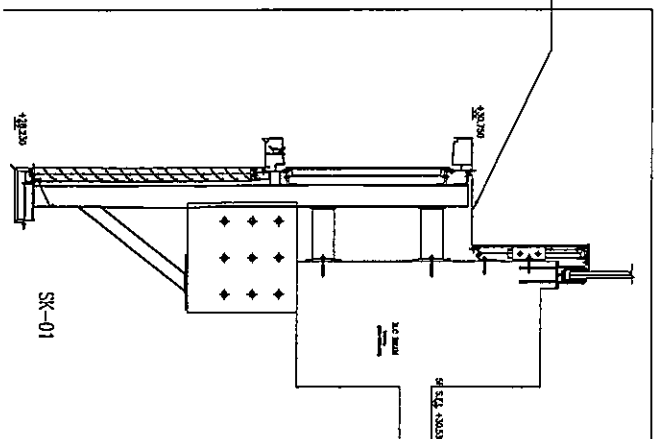


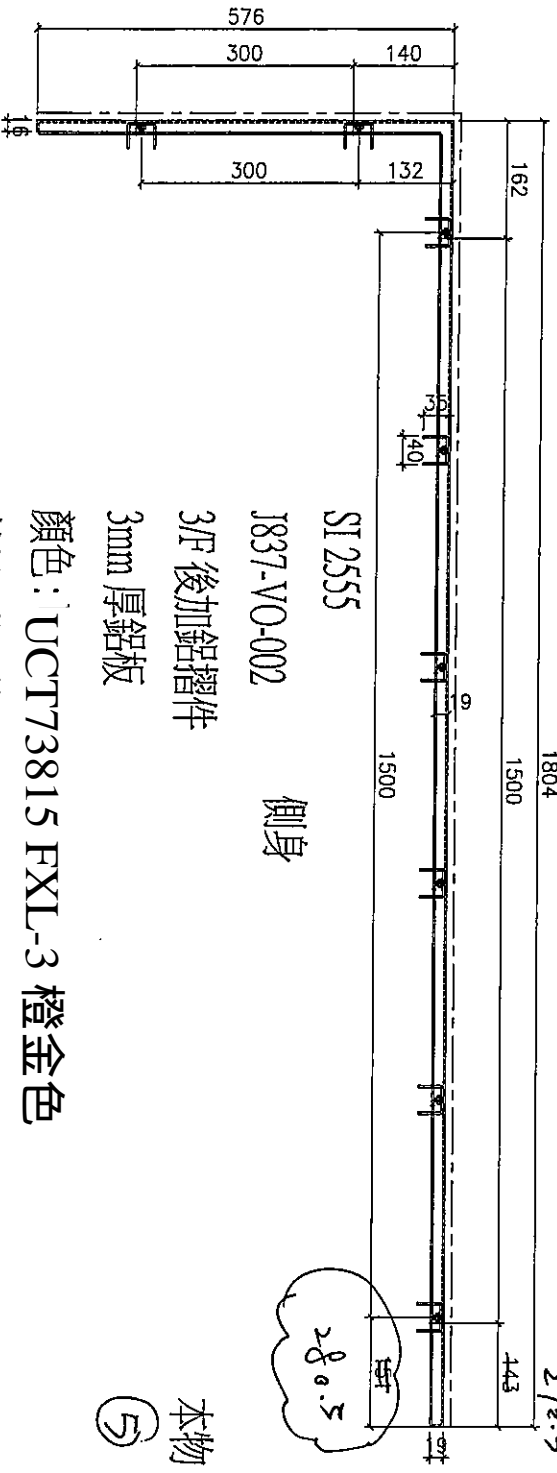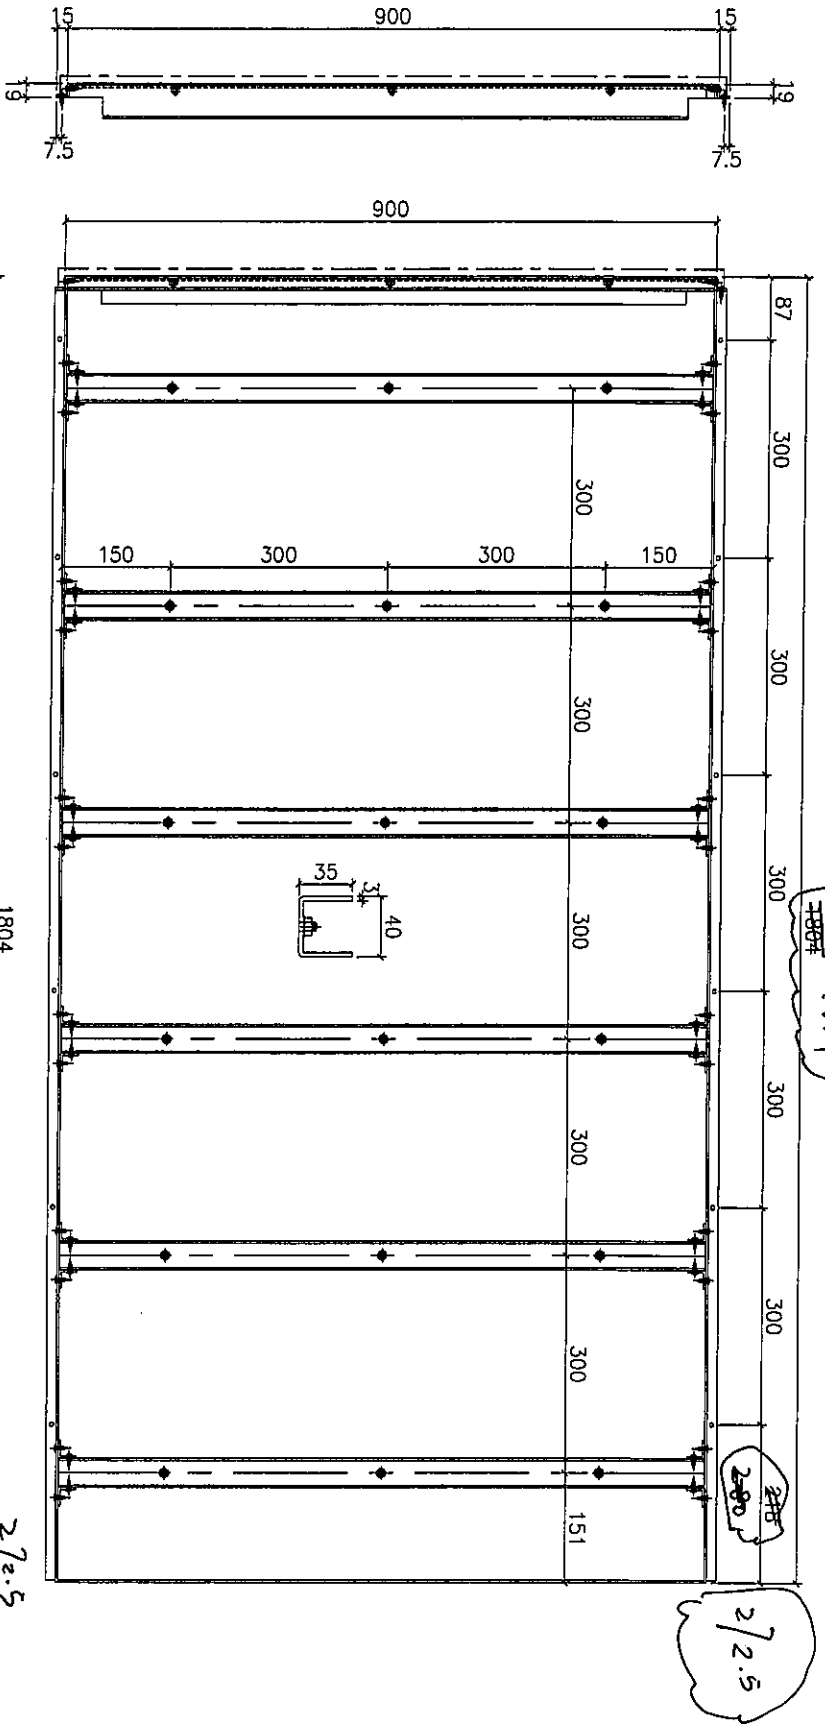

SI 2555
 J837-VO-002
 3/F 後加鋁摺件
 3mm 厚鋁板
 顏色: UCT73815 FXL-3 橙金色
 數量: 共 1 件

本物
 ⑤

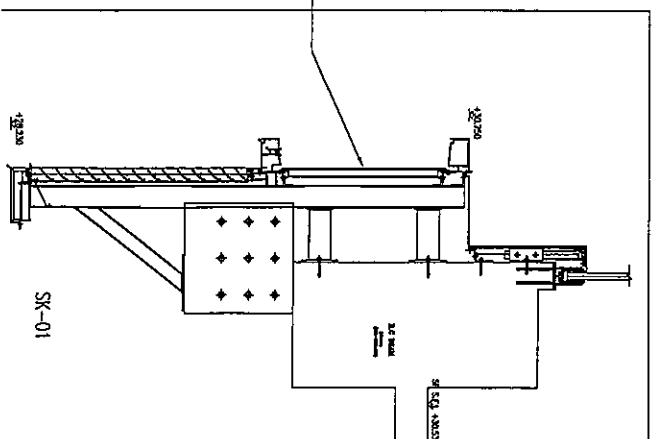

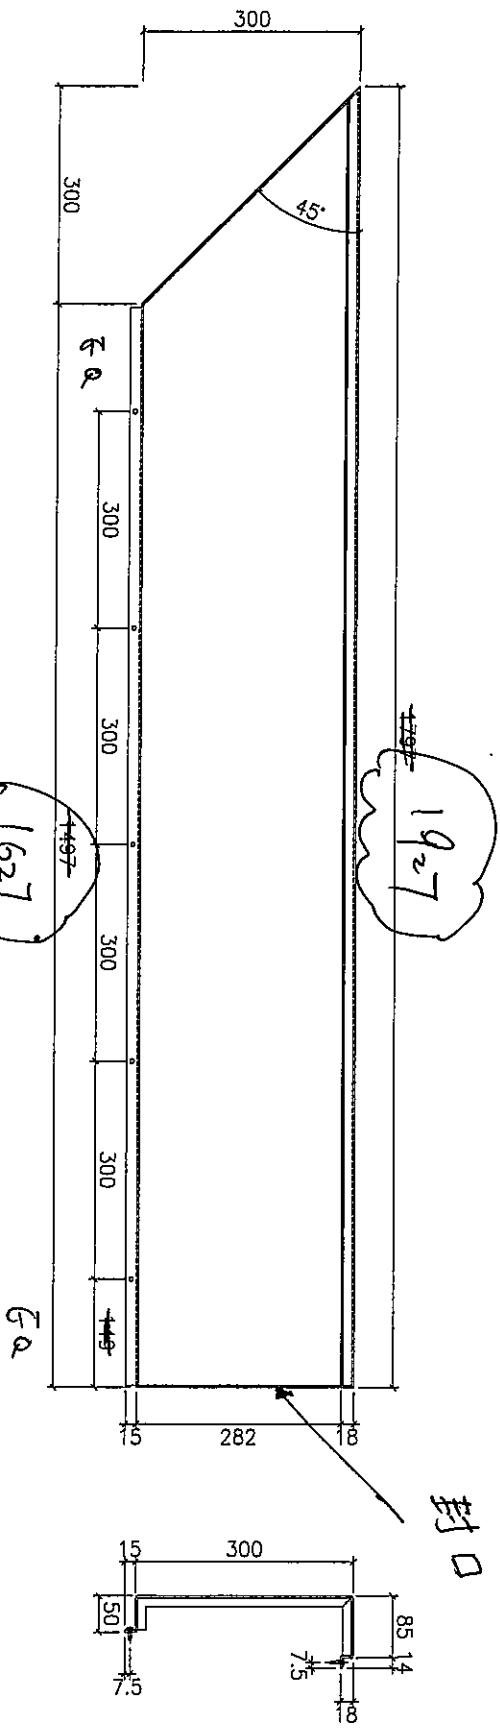

底

SI 2555

J837-VO-003


3F 後加鋁摺件



3mm 厚鋁板

顏色: UCT73815 FXL-3 橙金色

數量: 共 1 件


3-1
本物


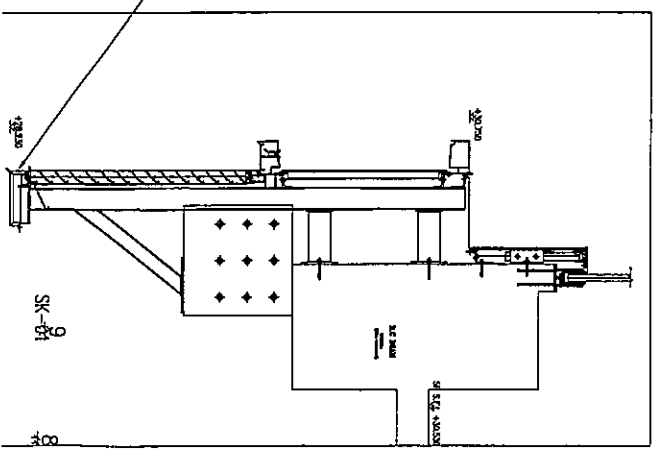


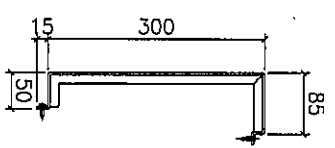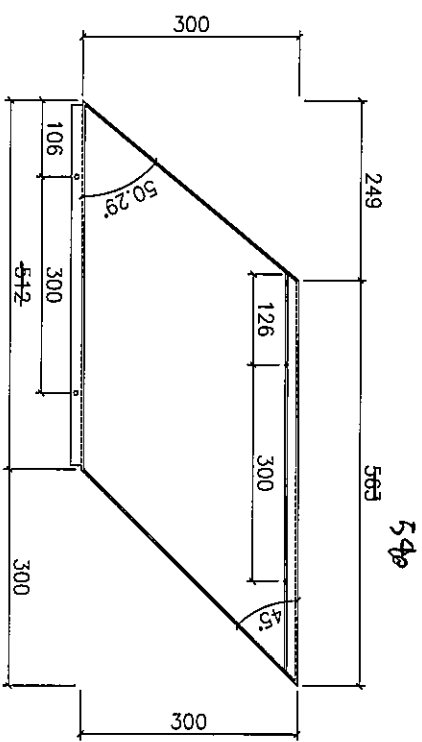

底
 SI 2555
 J837-SP-004
 3/F 後加鋁摺件
 3mm 厚鋁板
 顏色：UCT73815 FXL-3 橙金色
 數量：共 1 件

本物
 3-2

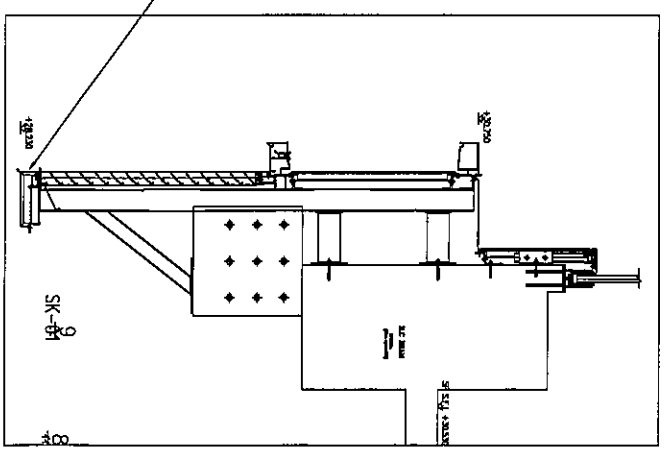

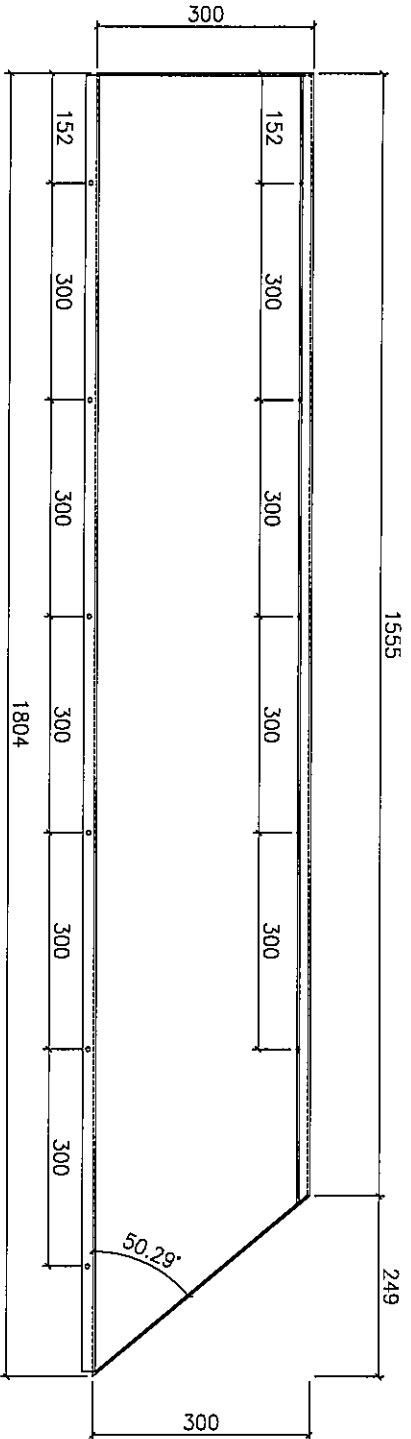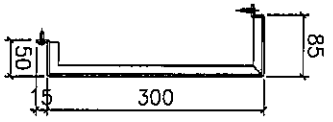

底

SI 2555

J837-SP-005

3/F 後加鋁摺件

3mm 厚鋁板

顏色: UCT73815 FXL-3 橙金色

數量: 共 1 件

3-3
本物

