

工程指示 / 要求簡箋(E.I.)

工程指示編號：EI / 1035 / 19

修改版次：-

工程編號：J - 837

工程名稱：觀塘裕民坊

工程項目：Glass Cladding 防水片 (5003-2 remedail case)

收件人：生統

發件人：Eric Liu

日期：05/09/2019

要求提供 / 確認 事項：

- |                                    |                                     |                               |
|------------------------------------|-------------------------------------|-------------------------------|
| <input type="checkbox"/> 初步鋁料 B.M. | <input type="checkbox"/> 加工拆圖，然後生產  | <input type="checkbox"/> 尺寸表  |
| <input type="checkbox"/> 正式鋁料 B.M. | <input type="checkbox"/> 技術上資料 / 指示 | <input type="checkbox"/> 報價   |
| <input type="checkbox"/> 配件 B.M.   | <input type="checkbox"/> 樣辦或貨品說明書   | <input type="checkbox"/> 分判合約 |
| <input type="checkbox"/> 其他：_____  |                                     |                               |

內容：

請按加工圖生產 Glass Cladding 防水片 (5003-2 remedail case)送地盤安裝

因應判頭公差使用。

謝謝！

請在 2019 / 09 / 10 前完成上列要求。

附：1 頁加工圖

以上項目為：

- 原合約工程包                       原合約工程加 / 減賬                       新工程報價

原因：-

分發東莞各部門：

- ( )生產技術總監 連附件 (✓)技術部 連附件 ( )生產部 連附件 ( )機械設計部 連附件  
 ( )採購部 連附件 (✓)生產統籌部 連附件  
 ( )質檢部 連附件 ( )會計部 連附件 ( )報關組 連附件 ( )其他 楊榮輝 連附件

分發香港各部門：

- ( )行政部 連附件 ( )會計部 連附件 ( )統籌部 連附件 (✓)工程部地盤科文 連附件 炳哥  
 ( )採購部 連附件 ( )QS 部 連附件 ( )維修部 連附件 ( )其他 \_\_\_\_\_ 連附件

傳遞編號：

HK 1947 / 19

發件人簽署：

項目經理簽署：

V-2960 数

25

~~25.5~~


h<sub>2</sub> h<sub>1</sub> 0.35  
1967

2.19.9.5

post

1.5 mm

mill

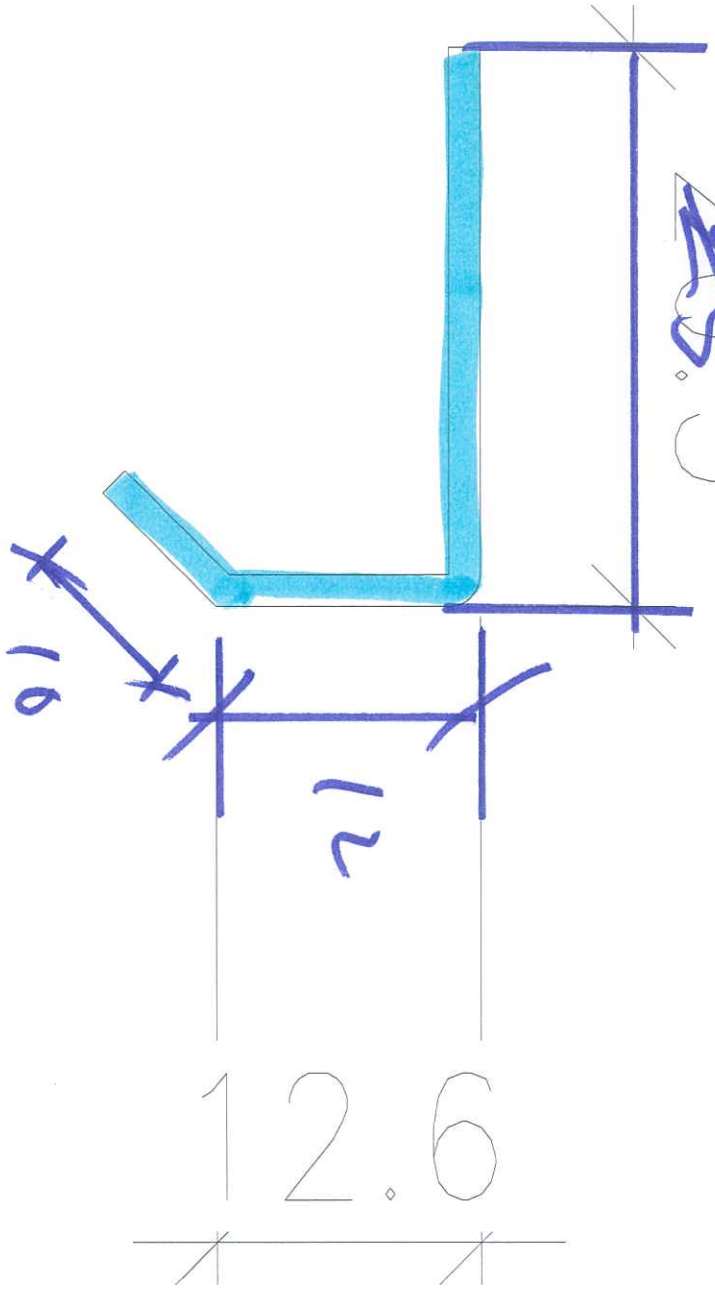

GC 5003/2

钢化 G.C



midi@midiltd.com.hk

---

*From:* midi@midiltd.com.hk <midi@midiltd.com.hk>  
*To:* kim.Wong@aecom.com, Daisy.Lau@aecom.com  
*Subject:* Re: NKIL6514 - Curtain Wall NSC - Remedial case for Glass Cladding flashing(2/5003  
*Copies to:* lpk.midi@gmail.com, lwc.midi@gmail.com,  
xyf.midi@gmail.com, cpm.midi@gmail.com,  
cch.midi@gmail.com, nsy.midi@gmail.com,  
wenfu1994@icloud.com  
*Date sent:* Thu, 05 Sep 2019 15:11:53 +0800

Dear Kim, Tim

Attached is the revised remedial case for Glass Cladding flashing (2/5003) for your information.  
Please check. Thank You.

Regards,

Yuen

---

*From:* 賡賡賡賡賡賡midi@midiltd.com.hk <midi@midiltd.com.hk>  
*To:* 賡賡賡賡賡賡賡kim.Wong@aecom.com, Daisy.Lau@aecom.com  
*Subject:* 賡賡賡賡賡燦KIL6514 - Curtain Wall NSC - Remedial case for Glass Cladding  
flashing(2/5003)  
*Copies to:* 賡賡賡賡燻pk.midi@gmail.com, lwc.midi@gmail.com,  
賡賡賡賡賡賡賡燻yf.midi@gmail.com, cpm.midi@gmail.com,  
賡賡賡賡賡賡賡燻ch.midi@gmail.com, nsy.midi@gmail.com,  
賡賡賡賡賡賡賡燻enfu1994@icloud.com  
*Date sent:* 賡賡賡賡燻ed, 04 Sep 2019 14:45:54 +0800

Dear Kim, Tim

Attached is the remedial case for Glass Cladding flashing (2/5003) for your information.  
Please check. Thank You.

Regards,

Eric

Attachments: T:\Jobs\J-837\7 E mail &Letter\to CR\20190904\_gc flashing remedial case  
(2.5003)\20190904\_GC flashing remedial case(2.5003).pdf

Attachments: T:\Jobs\J-837\7 E mail & Letter\to CR\20190905 flashing remedail case GC  
5003-2\20190905 flashing remedail case GC 5003-2.pdf