



工程指示 / 要求簡箋(E.I.)

工程指示編號：EI / 1278 / 19

修改版次：-

工程編號：J - 837

工程名稱：觀塘裕民坊

工程項目：幕牆 趟門框底更換毛條分判 + 趟門框更換膠條分判

收件人：Maggie / 偉哥

發件人：Eric Liu

日期：27/11/2019

□要求提供 / □確認 事項：

- | | | |
|------------------------------------|-------------------------------------|-------------------------------|
| <input type="checkbox"/> 初步鋁料 B.M. | <input type="checkbox"/> 加工拆圖，然後生產 | <input type="checkbox"/> 尺寸表 |
| <input type="checkbox"/> 正式鋁料 B.M. | <input type="checkbox"/> 技術上資料 / 指示 | <input type="checkbox"/> 報價 |
| <input type="checkbox"/> 配件 B.M. | <input type="checkbox"/> 樣辦或貨品說明書 | <input type="checkbox"/> 分判合約 |
| <input type="checkbox"/> 其他：_____ | | |

內容：

- (1) 因趟門底框位置，按湛哥意見需要更換 6x10mm 毛條才能順趟 + 趟門在(室內方向)
- (2) 趟門頂框，因當時生產完成 M01-M04 時，837-SDG-52 膠條仍未回廠
只有 M05 趟門框有在廠做新膠條，需安排現場更換 M01-M04 膠條
- 謝謝。 請安排分判 / 維修組更換

請在 2019/12/2 前完成上列要求。

★裝門玉前要做好

附：4頁趟門框玉膠條毛條使用位置

以上項目為：

- | | | |
|---------------------------------|--------------------------------------|--------------------------------|
| <input type="checkbox"/> 原合約工程包 | <input type="checkbox"/> 原合約工程加 / 減賬 | <input type="checkbox"/> 新工程報價 |
|---------------------------------|--------------------------------------|--------------------------------|

原因：-

分發東莞各部門：

- | | | | | | | | | |
|---------------------------------|------------------------------|--------------------------------|------------------------------|----|------------------------------|------------------------------|--------------------------------|---------------------------------|
| <input type="checkbox"/> 生產技術總監 | <input type="checkbox"/> 連附件 | <input type="checkbox"/> 技術部 | <input type="checkbox"/> 連附件 | 永林 | <input type="checkbox"/> 生產部 | <input type="checkbox"/> 連附件 | <input type="checkbox"/> 機械設計部 | <input type="checkbox"/> 連附件 |
| <input type="checkbox"/> 採購部 | <input type="checkbox"/> 連附件 | <input type="checkbox"/> 生產統籌部 | <input type="checkbox"/> 連附件 | 梅 | | | | |
| <input type="checkbox"/> 質檢部 | <input type="checkbox"/> 連附件 | <input type="checkbox"/> 會計部 | <input type="checkbox"/> 連附件 | | <input type="checkbox"/> 報關組 | <input type="checkbox"/> 連附件 | <input type="checkbox"/> 其他 | 小羅 <input type="checkbox"/> 連附件 |


分發香港各部門：

- | | | | | | | | | |
|------------------------------|------------------------------|-------------------------------|------------------------------|---|---|---|---|------------------------------|
| <input type="checkbox"/> 行政部 | <input type="checkbox"/> 連附件 | <input type="checkbox"/> 會計部 | <input type="checkbox"/> 連附件 | <input type="checkbox"/> 統籌部 | <input type="checkbox"/> 連附件 | <input checked="" type="checkbox"/> 工程部地盤科文 | <input checked="" type="checkbox"/> 連附件 | 炳哥 / 民 / 豪 |
| <input type="checkbox"/> 採購部 | <input type="checkbox"/> 連附件 | <input type="checkbox"/> QS 部 | <input type="checkbox"/> 連附件 | <input checked="" type="checkbox"/> 維修部 | <input checked="" type="checkbox"/> 連附件 | <input type="checkbox"/> 其他 | _____ | <input type="checkbox"/> 連附件 |


傳遞編號：

發件人簽署：

項目經理簽署：

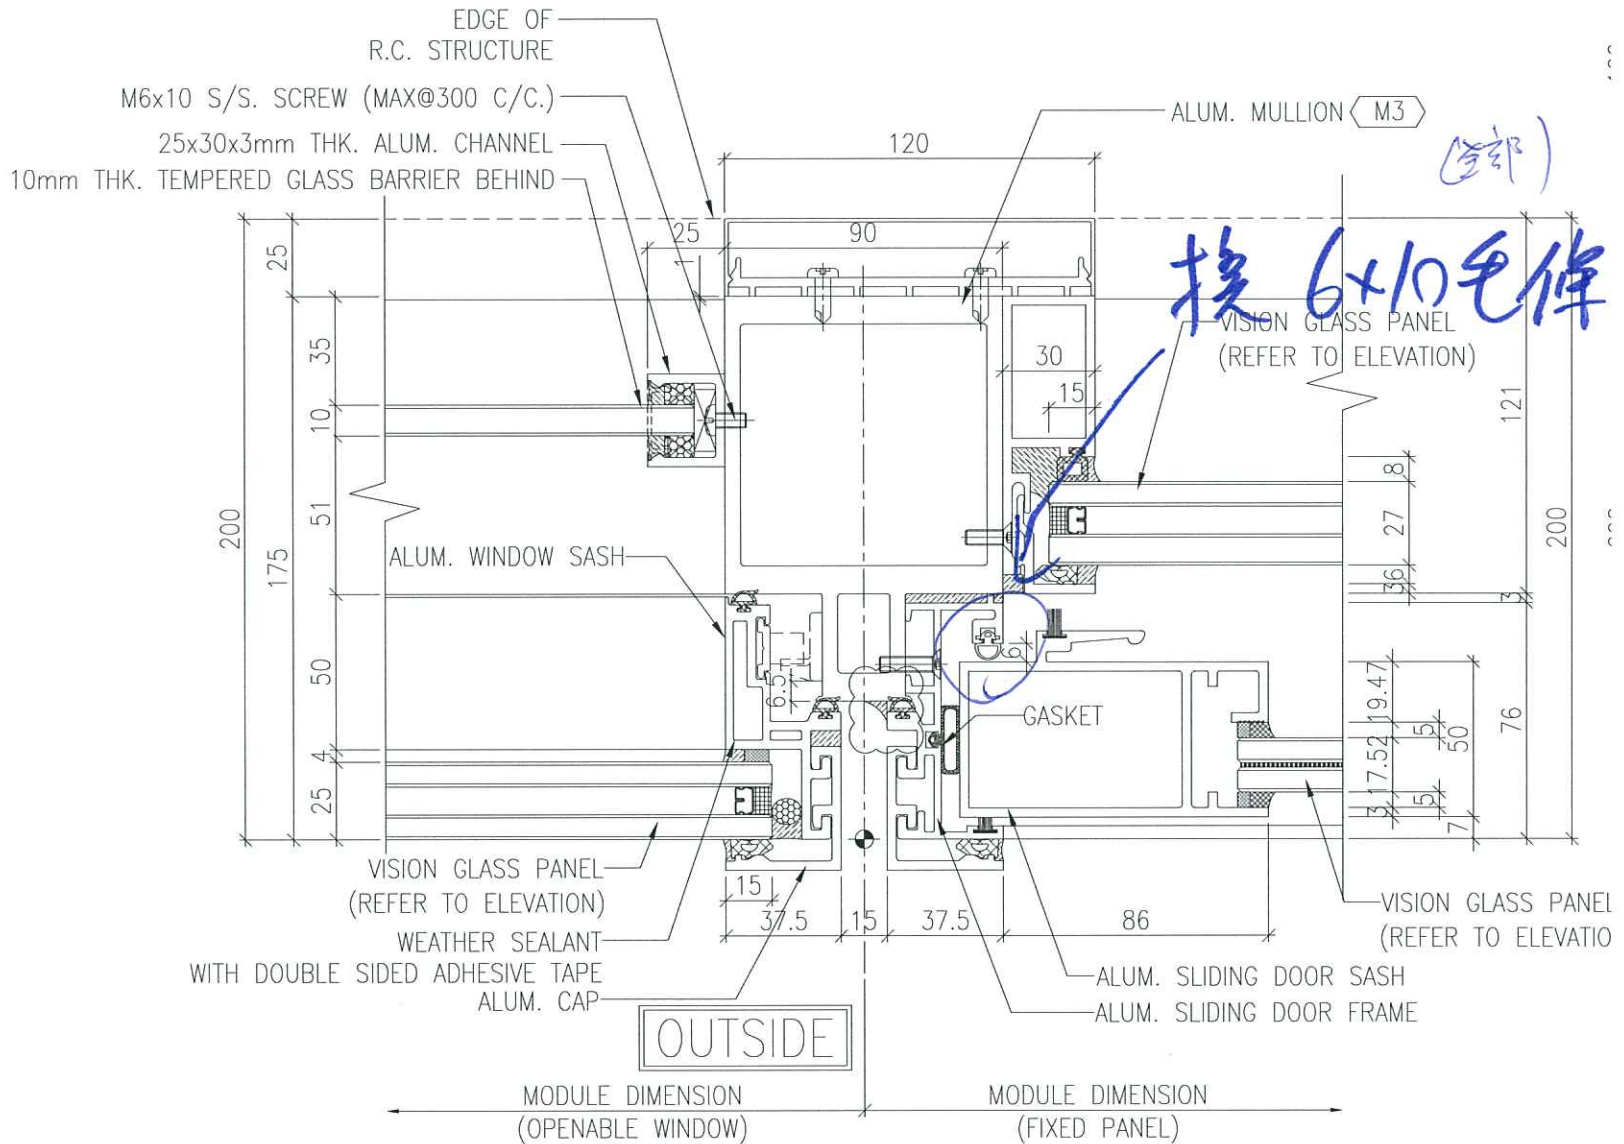


1
5004 TYPICAL MULLION DETAIL
CURTAIN WALL

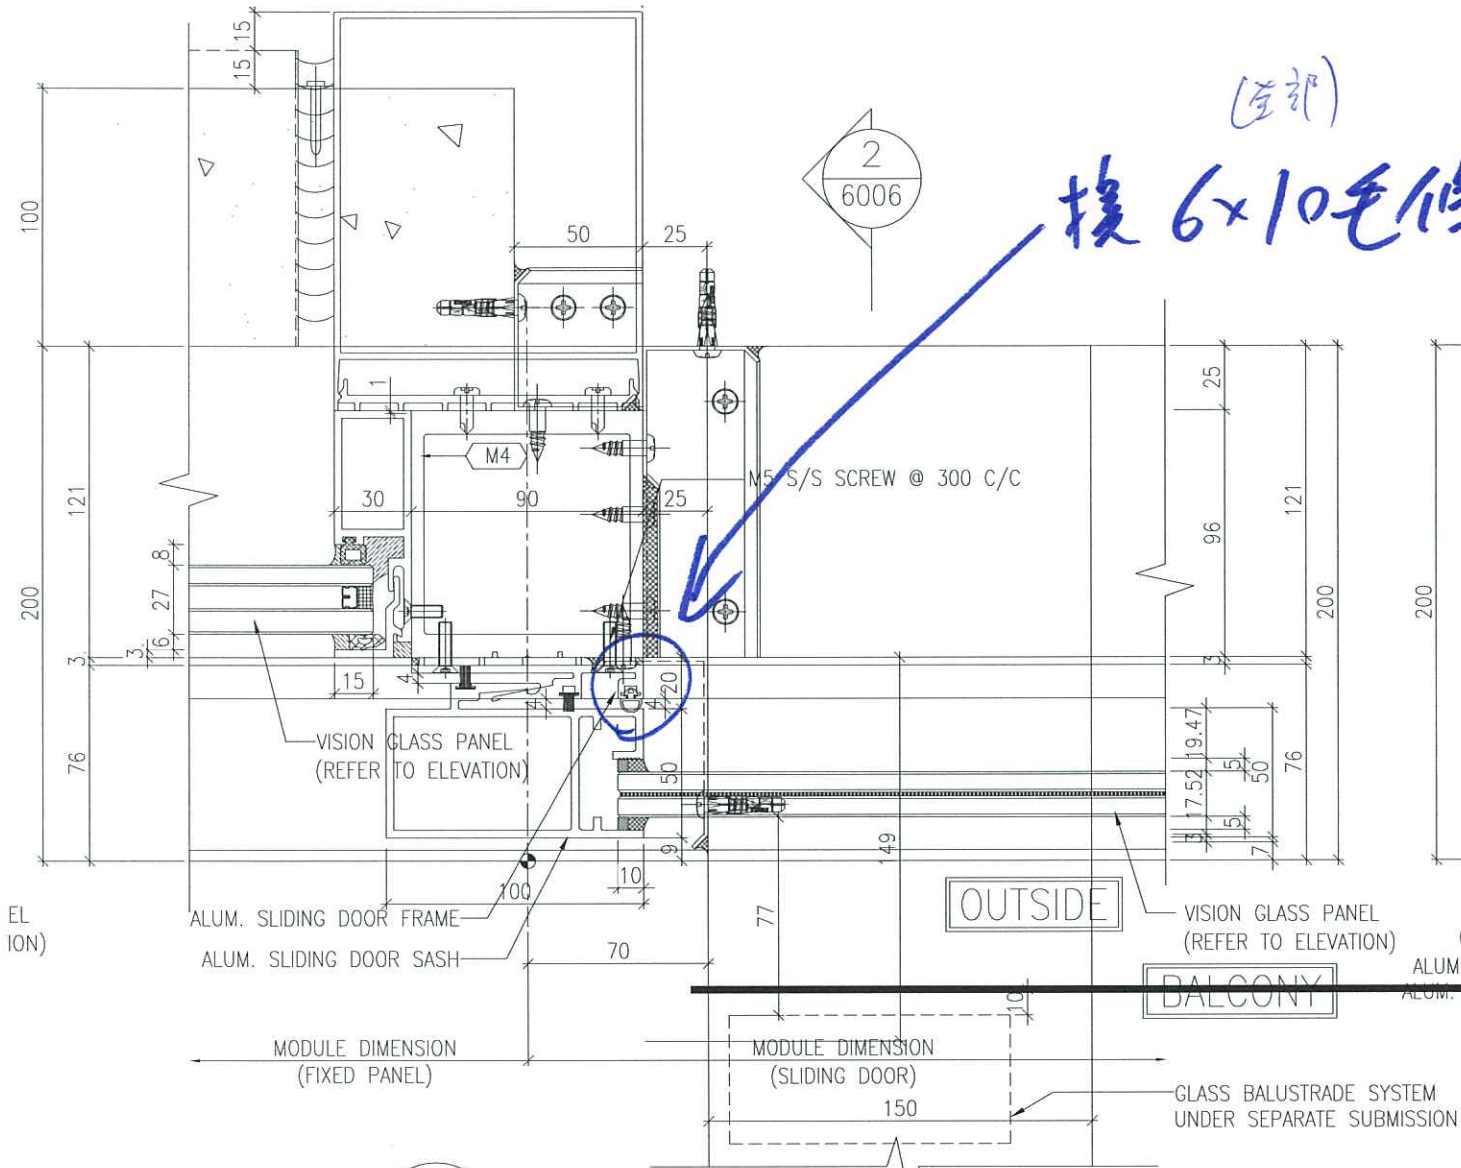

(全部)

接 6x10毛條

2 TYPICAL MULLION DETAIL
5004 CURTAIN WALL

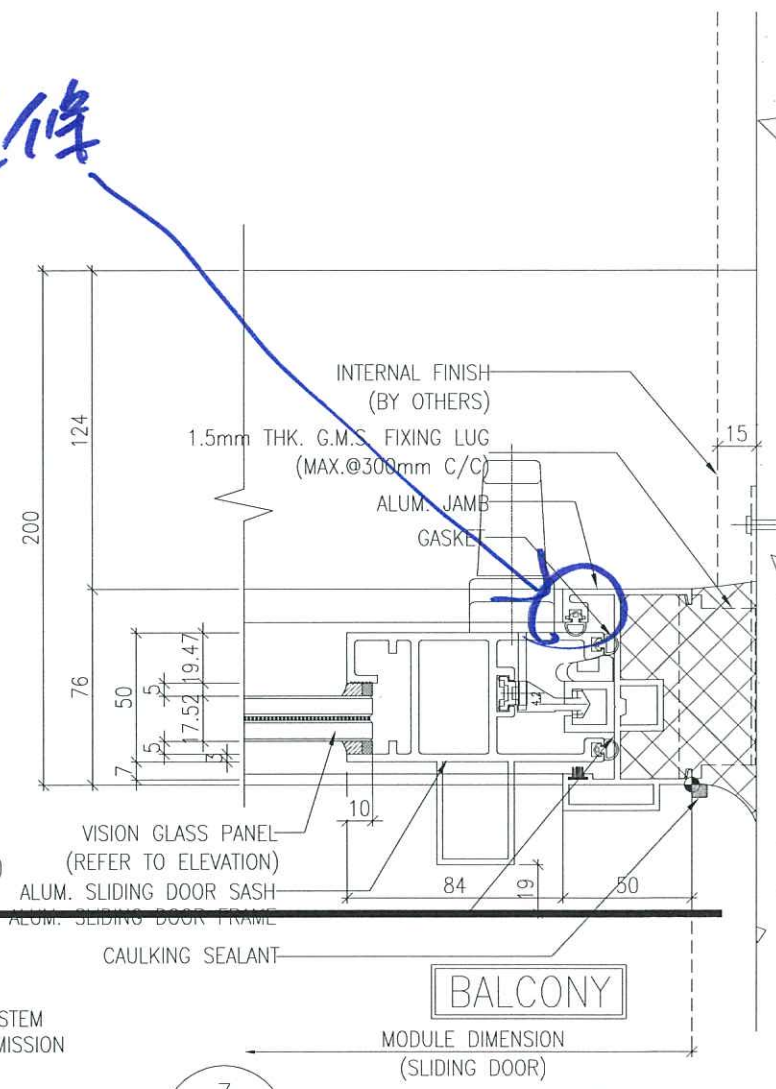

3 TYPICAL MULLION DETAIL
5004 CURTAIN WALL

VISION GLASS PANEL
(REFER TO ELEVATION)

MODULE DIMENSION
(SLIDING DOOR)

ALUM. GLAZING BEAD

WEATHER SEALANT WITH
DOUBLE SIDED ADHESIVE TAPE

SETTING BLOCK


ALUM. SLIDING DOOR SASH

ALUM. SLIDING DOOR FRAME

T2
ALUM. TRANSOM

30 x 30 x 6 mm THK. ALUM.
ANGLE BRACKET (L=87mm)

VISION GLASS PANEL

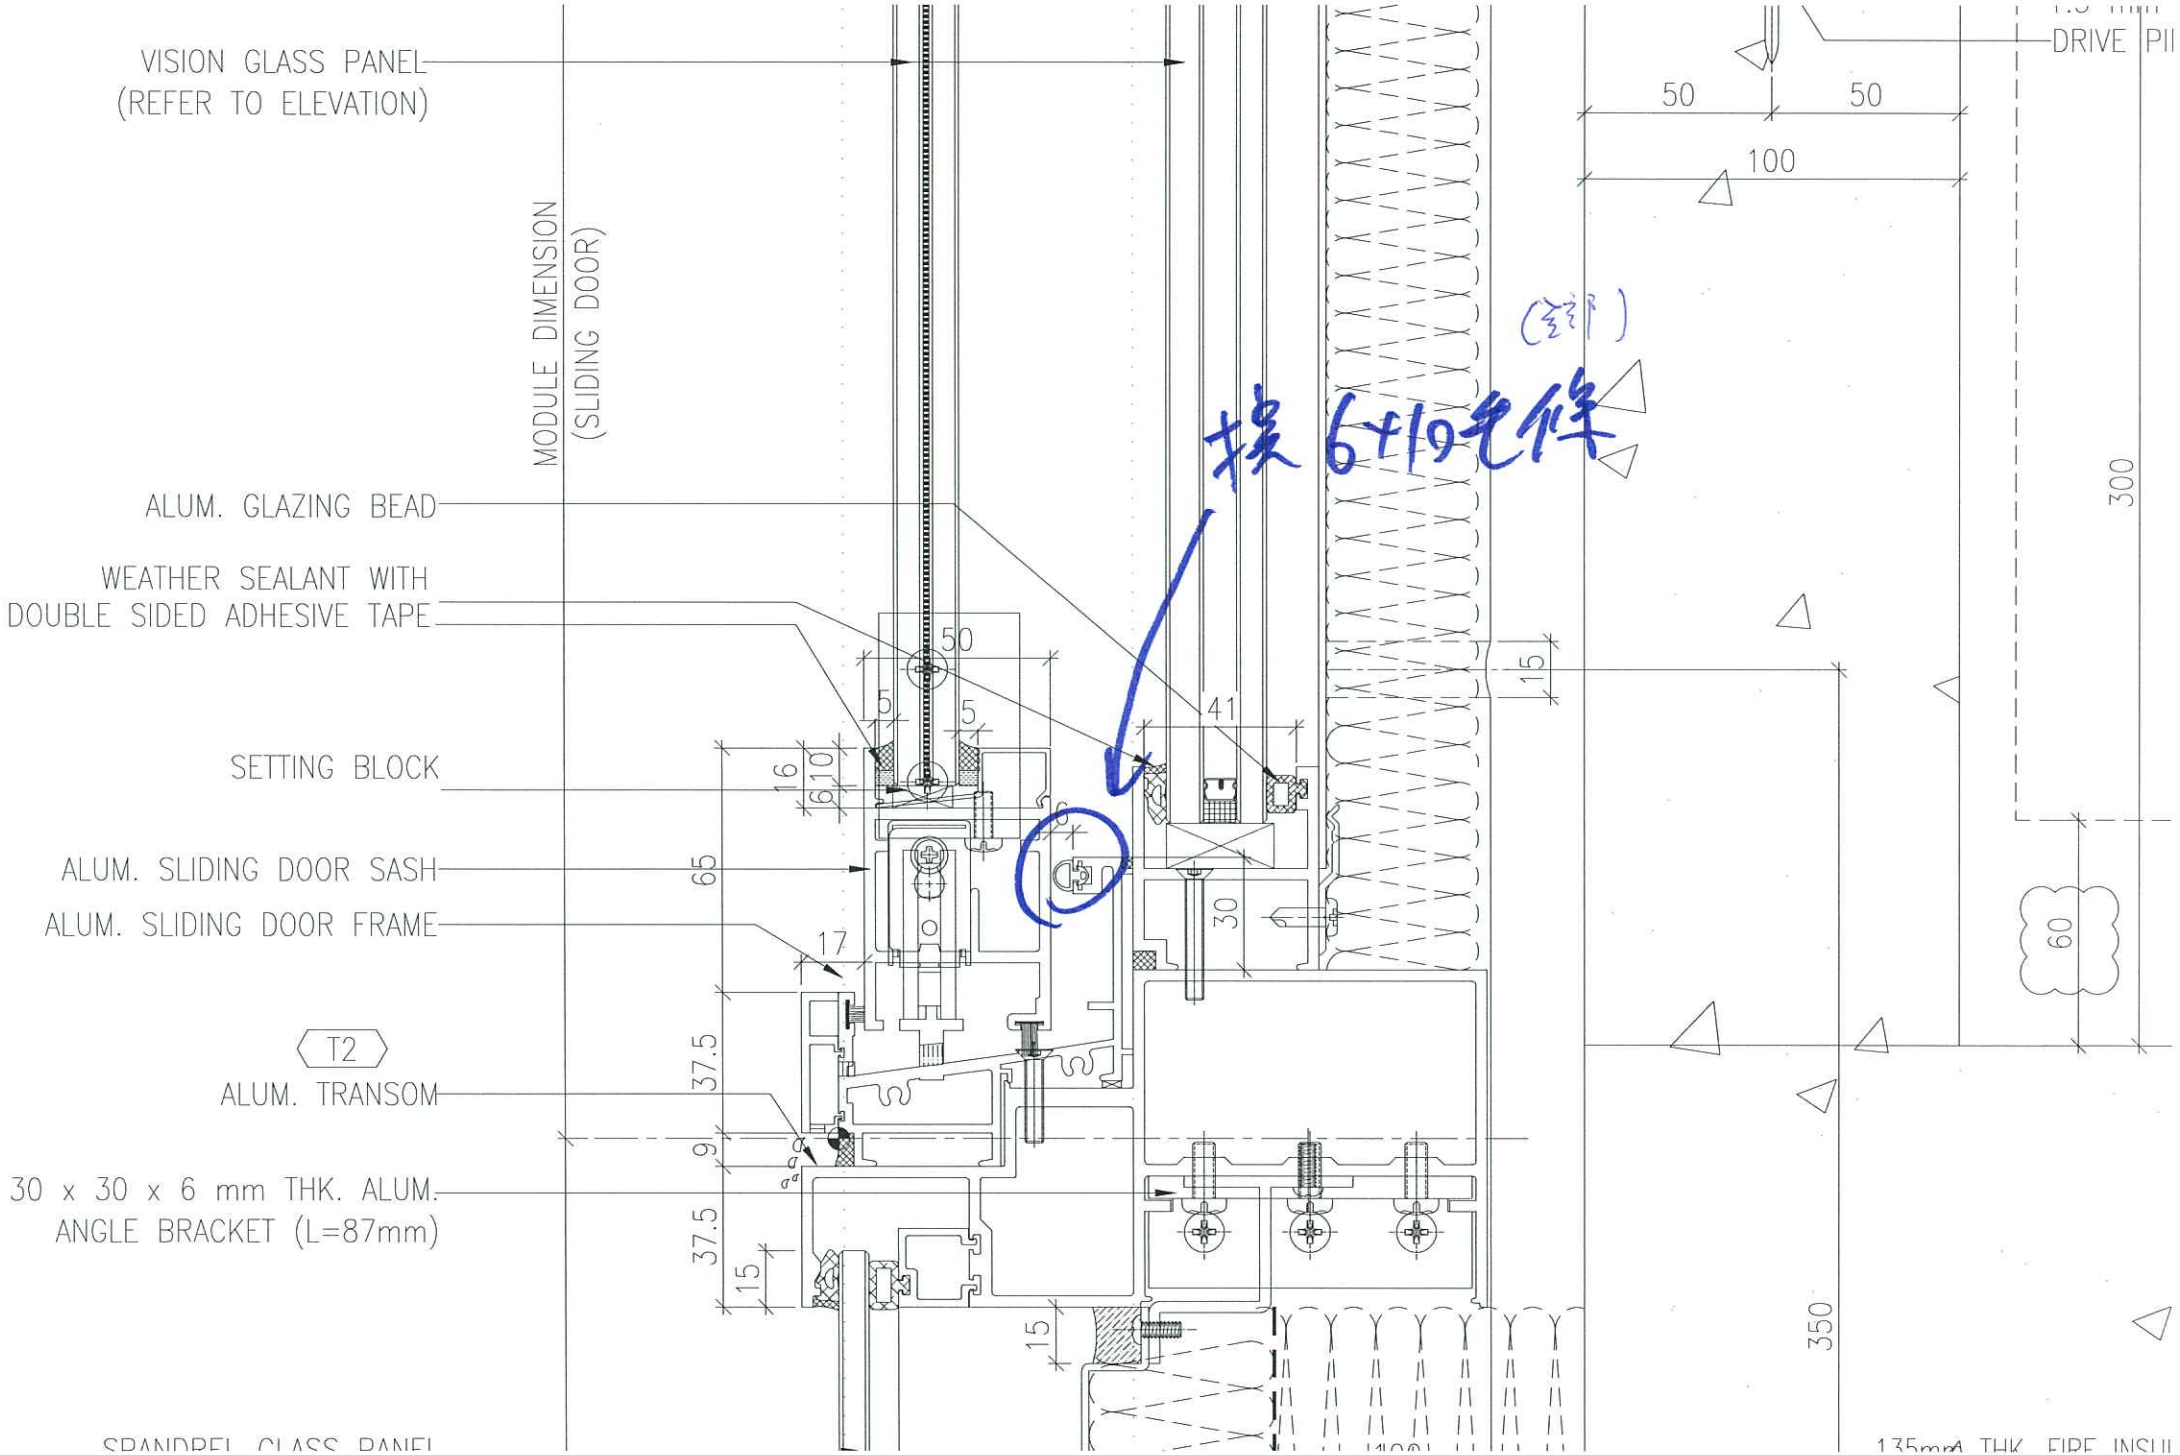

換6+10気條
(全部)

DRIVE PII

300

60

350

135mm THK FIVE INCH

