

工程指示 / 要求簡箋(E.I.)

工程指示編號：EI / 1497 / 20

修改版次：-

工程編號：J - 837

工程名稱：觀塘裕民坊

工程項目：特式層 窗門 access panel 拆圖資料 (包 insitu 及 facade 窗)

收件人：生統 / 永林

發件人：Eric Liu

日期：04/02/2020

要求提供 / 確認 事項：

- | | | |
|------------------------------------|-------------------------------------|-------------------------------|
| <input type="checkbox"/> 初步鋁料 B.M. | <input type="checkbox"/> 加工拆圖，然後生產 | <input type="checkbox"/> 尺寸表 |
| <input type="checkbox"/> 正式鋁料 B.M. | <input type="checkbox"/> 技術上資料 / 指示 | <input type="checkbox"/> 報價 |
| <input type="checkbox"/> 配件 B.M. | <input type="checkbox"/> 樣辦或貨品說明書 | <input type="checkbox"/> 分判合約 |
| <input type="checkbox"/> 其他：_____ | | |

內容：

請按已覆尺資料拆圖，特式層共 23 隻門窗
 13 隻已覆尺可拆圖，10 隻待定 (已覆尺款放行生產)
 生統：請覆核鋁料使用量，現有廠存是否足夠使用 23 隻窗
 謝謝！

請在 2020 / 02 / 22 前完成上列要求。

附：1 頁覆尺統計，32 頁覆尺數

以上項目為：

- 原合約工程包 原合約工程加 / 減賬 新工程報價

原因：-

分發東莞各部門：

- () 生產技術總監 連附件 () 技術部 連附件 永林 () 生產部 連附件 () 機械設計部 連附件
 () 採購部 連附件 () 生產統籌部 連附件 梅
 () 質檢部 連附件 () 會計部 連附件 () 報關組 連附件 () 其他 楊榮輝 連附件

分發香港各部門：

- () 行政部 連附件 () 會計部 連附件 () 統籌部 連附件 () 工程部地盤科文 連附件 炳哥
 () 採購部 連附件 () QS 部 連附件 () 維修部 連附件 () 其他 _____ 連附件

傳遞編號：

HK0139 / 20

發件人簽署：

項目經理簽署：

放行錄

el.

有無Lourve	Dwg No.	status	Type	Window Mark	Floor	Room	location	dwg W	H	現場 W	H	GBP W
無	#1	ok按圖	Door	T1W D-6	50/F	A	BAL	950	2550	990	2560	950
有	#2	ok按圖	Win	T1W 50A-KIT	50/F	A	KIT	1150	1445	ok	ok	1150
無	#3	REVIEW	Stairdoor	T1W 50A	50/F	A	STAIR	750	2250	750	2250	750
無	#4	??	GC +WIN+door	T1W 50A-LIV-2	50/F	A	LIV					
無	#5	ok按圖	Access	T1W LMR-01	LMR			750	1200	ok	ok	750
無	#6	REVIEW	Stairdoor	T2W 55G	55/F	G	STAIR	750	2250	890	2250	750
無	#7	DEL	Access	T2W LMR-01	LMR			DEL	DEL	DEL	DEL	/
有	#8	??	Win	T3W H-3	52/F	H	STORE	900	1445	未有	未有	???
有	#9	ok按圖	Win	T3W 52D-KIT	52/F	D	KIT	1250	1445	ok	ok	1250
有	#10	ok按圖	Win	T3W 52H-KIT	52/F	H	KIT	1250	1445	ok	ok	1250
無	#11	ok按圖	Win+Door	T3W 52H-LIV-2	52/F	H	LIV	1500	2250	1470	2200	1500
無	#12	REVIEW	Stairdoor	T3W 52D	52/F	D	STAIR	750	2250	970	2600	875
無	#13	REVIEW	Stairdoor	T3W 52H	52/F	H	STAIR	750	2250	900	2170	750
有	#14	ok按圖	Win	T5W 51A MBATH-2	51/F	A	BATH	585	1395	ok	ok	585
有	#15	ok按圖	Win	T5W 51A MBATH-3	51/F	A	BATH	650	1950	ok	ok	650
有	#16	ok按圖	Win	T5W 51A-KIT	51/F	A	KIT	950	1445	ok	ok	950
無	#17	REVIEW	Stairdoor	T5W 51A	51/F	A	STAIR	750	2250	900	2230	750
無	#18	DEL	Access	T5W LMR-01	LMR			DEL	DEL	DEL	DEL	/
無	#19	REVIEW	Win	T2W SA-01	55/F	G		700	1130			700
無	#20	跟現場	Access	T2W SA-02	Roof					750	1200	700
無	#21	跟現場	Access	T3W APR-01	Roof	Stair				750	1200	750

precast into insitu

有無Lourve	Dwg No.	status	Type	Window Mark	Floor	Room	location	dwg W	H	現場 W	H	GBP W
無		??	Win	T2W 55G-BR3	55/F	G	BR	1765	1370	??	??	
無		??	Access	T2W 55F-6	55/F	Corridor	Corridor	790	1190	??	??	
無	✓	ok按圖	Win	T3W 52H-BR2	52/F	H	BR	1240	1370	1250	1370	1200+40
無	✓	ok按圖	Win	T3W 52D-Liv	52/F	D	Liv	1465	2285	1470	2280	1425+40

①

PROJECT :

UC/3P091/837

7

URA KWUN TONG TOWN CENTRE
REDEVELOPMENT (AREA 2 & 3) AT NKIL 6514, KWUN TONG, KOWLOON

廖嘉偉

TO = ERIK LIU

地盤複尺圖公司

(過年前)

⊗

TITLE : SHOP DRAWING FOR
IN SITU ALUMINIUM WINDOW (FOR TOWER 1 TO TOWER 5) (FOR SPECIAL UNITS)


DATE: 26- AUG - 2019



2


DRAWING SUBMISSION REGISTER

PROJECT: URA KWUN TONG TOWN CENTRE REDEVELOPMENT (AREA 2 & 3) AT NHK 6514, KWUN TONG, KOWLOON	DATE OF ISSUE							SUBMISSION STATE (FOR B.D./A.S.D)	SUBMISSION STATE (FOR CLIENT / CONSULTANT)	SUBMISSION STATE (FOR ARCHITECT)	FABRICATION / CONSTRUCTION STATE												
	ISSUE	01	02	03	04	05	06	07	AP - APPROVED AC - APPROVED SUB. TO CONDITION NA - NOT APPROVED	AP - APPROVED AC - APPROVED SUB. TO CONDITION NA - NOT APPROVED	AP - APPROVED AC - APPROVED SUB. TO CONDITION NA - NOT APPROVED	ISSUE TO CHINA OFFICE	ISSUE TO SITE	ISSUE TO SUB-CONTRACTOR									
	DAY	08	09	10	11	12	13	14															
	MONTH	01	02	03	04	05	06	07															
YEAR	18	19	20	21	22	23	24																
DRAWING TITLE	DWG. NO.	REVISIONS							COMMENT DATE	REV.	STATE	COMMENT DATE	REV.	STATE	COMMENT DATE	REV.	STATE	REV.	DATE	REV.	DATE	REV.	DATE
COVERPAGE	J837-W-0000	-	A	B	C	D	E	F															
DRAWING SUBMISSION REGISTER	J837-W-0001	-	A	B	C	D	E	F															
DRAWING SUBMISSION REGISTER	J837-W-0002	-	A	B	C	D	E	F															
GENERAL NOTE OF ALUM. WINDOW	J837-W-0003	-	-	A	B	C	C	C															
GENERAL NOTE OF ALUM. WINDOW	J837-W-0003A																						
SECTION PROFILE FOR ALUM. WINDOW	J837-W-0004	-	-	A	A	A	A	A															
SECTION PROFILE FOR ALUM. WINDOW	J837-W-0005																						
TYPICAL ALUM. WINDOW SCHEDULE	J837-W-2101	-	A	B	B	C	C	C															
TYPICAL ALUM. WINDOW SCHEDULE	J837-W-2102	-	A	B	B	C	C	C															
TYPICAL ALUM. WINDOW SCHEDULE	J837-W-2103	-	A	B	B	C	C	C															
TYPICAL ALUM. WINDOW SCHEDULE	J837-W-2104	-	A	B	B	C	C	C															
TYPICAL ALUM. WINDOW SCHEDULE	J837-W-2105	-	A	B	B	C	C	C															
TYPICAL ALUM. WINDOW SCHEDULE	J837-W-2106	-	A	B	B	C	C	C															
TYPICAL ALUM. WINDOW SCHEDULE	J837-W-2107	-	A	B	B	C	C	C															
TYPICAL ALUM. WINDOW SCHEDULE	J837-W-2108																						
TYPICAL ALUM. WINDOW SCHEDULE	J837-W-2109																						
TYPICAL ALUM. WINDOW SCHEDULE	J837-W-2110																						
TYPICAL ALUM. WINDOW SCHEDULE	J837-W-2201	-	A	B	C	C	C	C															
TYPICAL ALUM. WINDOW SCHEDULE	J837-W-2202	-	A	B	B	B	B	B															
TYPICAL ALUM. WINDOW SCHEDULE	J837-W-2203	-	A	B	B	C	C	C															
TYPICAL ALUM. WINDOW SCHEDULE	J837-W-2204	-	A	B	B	C	C	C															
TYPICAL ALUM. WINDOW SCHEDULE	J837-W-2205	-	A	B	B	C	C	C															
TYPICAL ALUM. WINDOW SCHEDULE	J837-W-2206	-	A	B	B	C	C	C															
TYPICAL ALUM. WINDOW SCHEDULE	J837-W-2207	-	A	B	B	C	D	D															
TYPICAL ALUM. WINDOW SCHEDULE	J837-W-2306	-	A	A	B	C	C	D															
TYPICAL ALUM. WINDOW SCHEDULE	J837-W-2307																						
TYPICAL ALUM. WINDOW SCHEDULE	J837-W-2308																						
TYPICAL ALUM. WINDOW SCHEDULE	J837-W-2309																						
TYPICAL ALUM. WINDOW SCHEDULE	J837-W-2309																						
TYPICAL ALUM. WINDOW SCHEDULE	J837-W																						

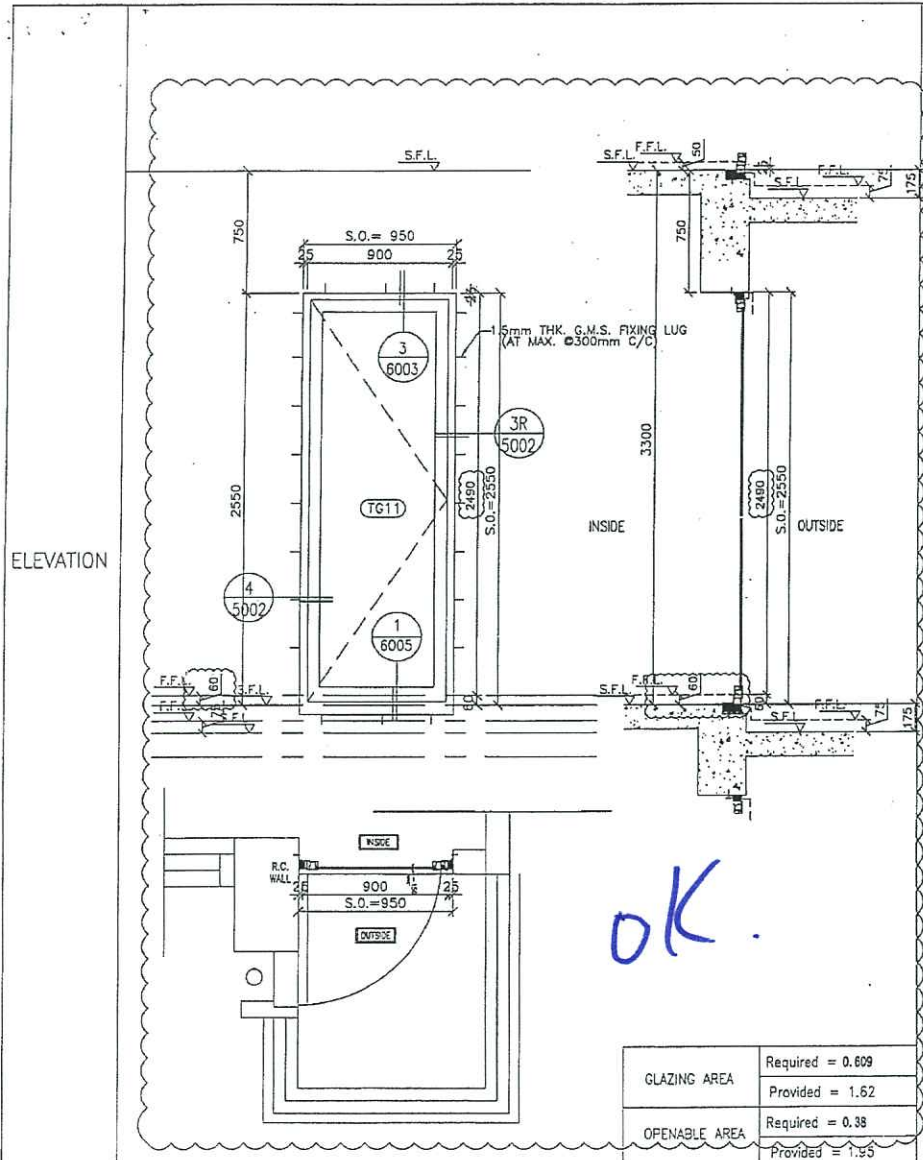

OK.

GLAZING AREA	Required = 0.609
	Provided = 1.62
OPENABLE AREA	Required = 0.38
	Provided = 1.95

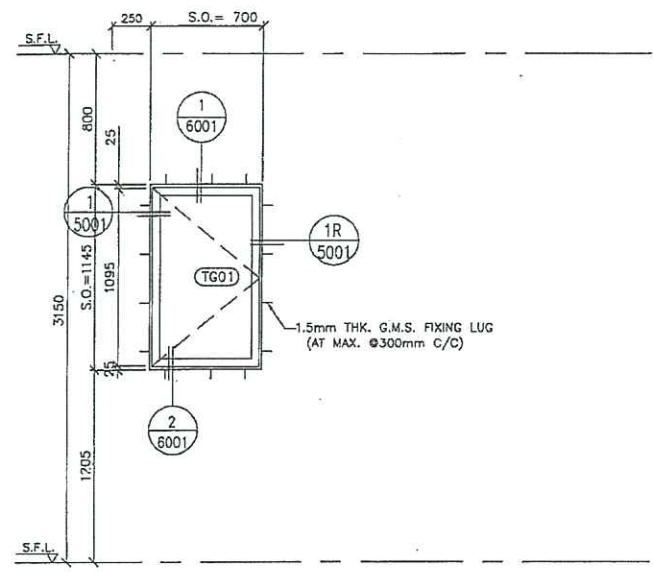

GLAZING AREA	Required =
	Provided = 0.4
OPENABLE AREA	Required =
	Provided = 0.49

WINDOW MARK	T1W D-6
SECTION :	50mm ALUM. SECTION
QTY.	1 NOS.
LOCATION :	T1 50/F FLAT A DOOR TO BALCONY
GLAZING	8mm THK CLEAR TEMPERED GLASS
REMARK :	

WINDOW MARK	T1W E3
SECTION :	50mm ALUM. SECTION
QTY.	39 NOS. (TYPICAL)
LOCATION :	T1 6/F-26/F, 28/F-50/F FLAT E STORE
GLAZING	8mm blue tinted etched frosted tempered glass
REMARK :	

B.D. REF :

CLIENT : 德利置業有限公司 Sino Land Company Limited

ARCHITECT : WONG TUNG & PARTNERS LIMITED ARCHITECTS & PLANNERS

MAIN CONTRACTOR : CR Construction Company Limited

STRUCTURAL ENGINEER : AECOM

FACADE CONSULTANT :

NOTE :

1. ALL DIMENSIONS ARE IN mm.
2. ALL ELEVATIONS ARE VIEWED FROM OUTSIDE.
3. ALL DIMENSIONS TO BE VERIFIED ON SITE BEFORE FABRICATION.

LEGEND :

① -- DETAIL MARK NO.
 ② -- REFER SHEET NO.

1. F.F.L -- FINISHED FLOOR LEVEL
2. S.F.L -- STRUCTURAL FLOOR LEVEL
3. (⊖) -- REVERSED DETAIL

C	2015/2/18	BY ARCHITECT DRAWING	1/25
F	2015/2/18	BY ARCHITECT DRAWING	1/25
A	2015/2/18	BY ARCHITECT DRAWING	1/25
NO.	DATE	REVISED	BY

JOB NO. : J-837

PROJECT : URA KWUN TONG TOWN CENTRE REDEVELOPMENT (AREA 2 & 3) AT NKIL 8514, KWUN TUNG, KOWLOON


TITLE : ALUM. WINDOW SCHEDULE (FOR T1)

DATE : 09-JUL-18 SCALE : 1:##


DRAWN BY : Zeng CHECKED BY : DW

MIDI ALUMINIUM FABRICATOR LTD.
 Units 5-8, Sunny Industrial Centre, 1/F
 410 Cheong Yee Road, Kowloon
 Tel: 23489211-4 Fax: (852) 27212668


DWG NO. : JB37-W-2107 REV. : 9

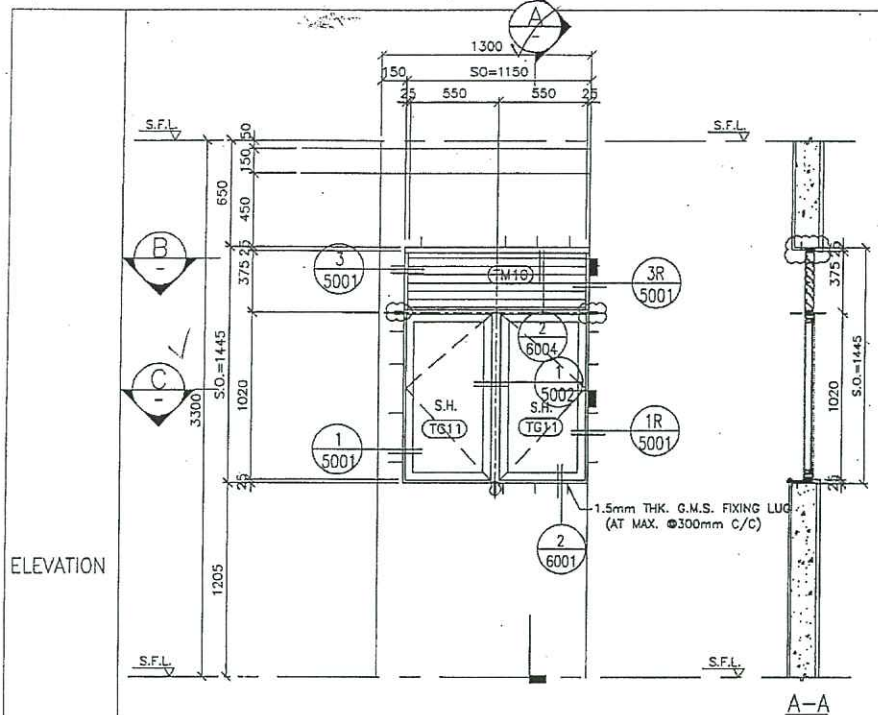


A-A

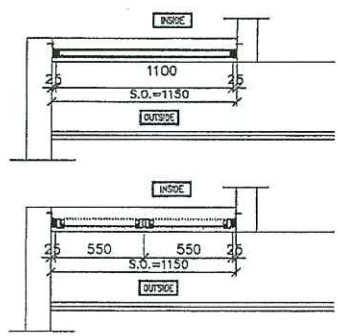

GLAZING AREA	Required = 0.77 Provided = 0.783
OPENABLE AREA	Required = 0.481 Provided = 0.925

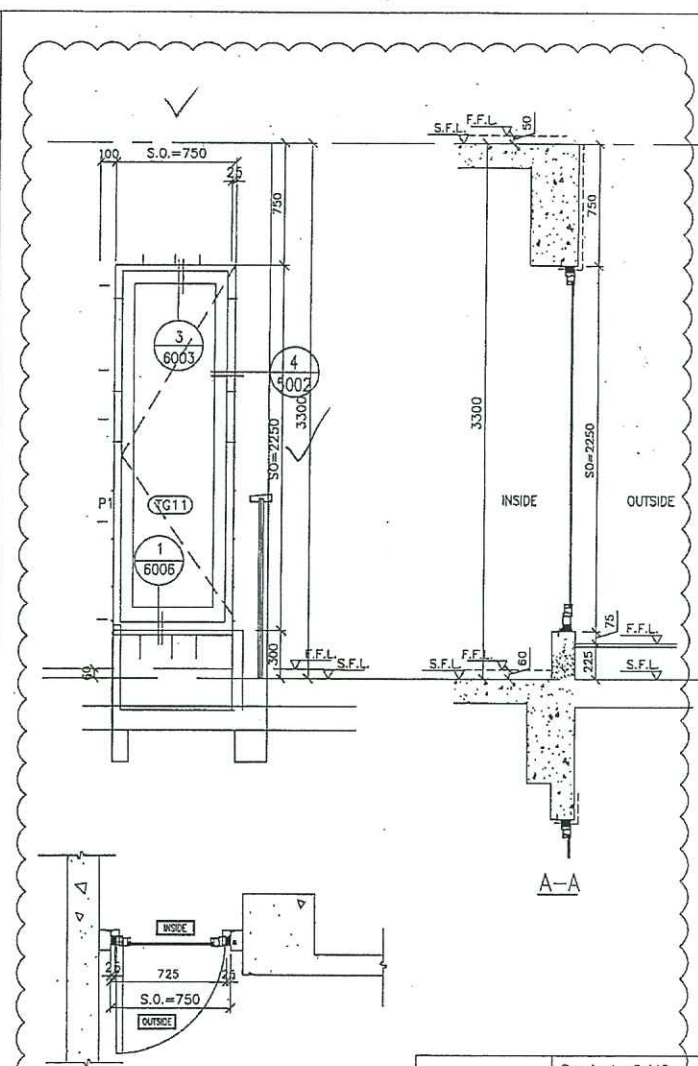

A-A

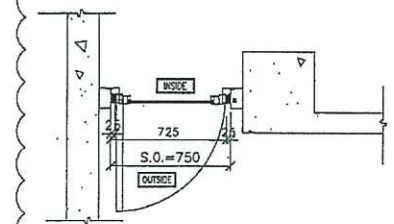

GLAZING AREA	Required = 0.448 Provided = 1.06
OPENABLE AREA	Required = 0.28 Provided = 1.27

ELEVATION

B.O. REF :

CLIENT : 德利置業有限公司
Sino Land Company Limited

ARCHITECT : WONG TUNG & PARTNERS LIMITED
ARCHITECTS & PLANNERS
WT

MAIN CONTRACTOR : CR Construction Company Limited

STRUCTURAL ENGINEER : AECOM

FACADE CONSULTANT :

NOTE :
1. ALL DIMENSIONS ARE IN mm.
2. ALL ELEVATIONS ARE VIEWED FROM OUTSIDE.
3. ALL DIMENSIONS TO BE VERIFIED ON SITE BEFORE FABRICATION.

LEGEND :
① -- DETAIL MARK NO.
② -- REFER SHEET NO.
1. F.F.L. -- FINISHED FLOOR LEVEL
2. S.F.L. -- STRUCTURAL FLOOR LEVEL
3. Ⓢ -- REVERSED DETAIL.

DATE	2019/01	BY	WICKET CHANG	CHK	
NO.		DATE		REVISION	BY

JOB NO. : J-837

PROJECT : URA KWUN TONG TOWN CENTRE REDEVELOPMENT (AREA 2 & 3) AT NKIL 6514, KWUN TONG, KOWLOON

TITLE : ALUM. WINDOW SCHEDULE (FOR T1)

DATE : 09-JUL-18 SCALE : 1:30

DRAWN BY : Zeng CHECKED BY : DW

MIDI ALUMINIUM FABRICATOR LTD.
Units 6-8, Sunway Industrial Centre, 1/F
810 Che Kwo Ling Road, Kowloon
Tel: 23455211-4 Fax: (852) 2727656


DWG NO. : JB37-14-2108 REV. : A

ok
#2 ✓

#3 X

(6)

ELEVATION

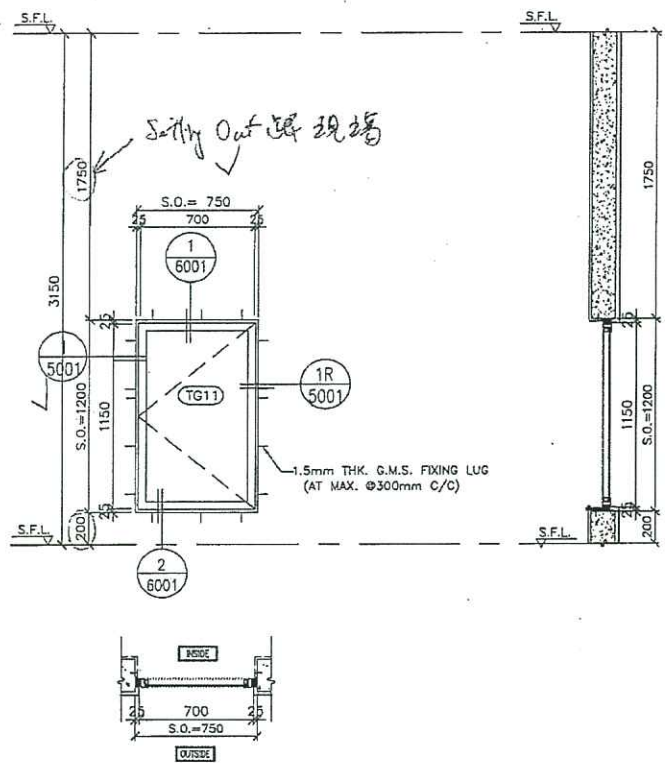

GLAZING AREA	Required =
	Provided = 0.602
OPENABLE AREA	Required =
	Provided = 0.689

WINDOW MARK

SECTION : 30mm ALUM. SECTION

QTY. 1 NOS. (TYPICAL)

LOCATION : T1 LIFT MACHINE ROOMS

GLAZING 8mm THK ACID ETCHED FROSTED TEMPERED GLASS

REMARK :

Handwritten notes: #5, A-c 0.55, jpani, and a blue checkmark.

B.D. REF :

TYPE OF MULLIONS :

CLIENT : Sino Land Company Limited

ARCHITECT : WONG TUNG & PARTNERS LIMITED ARCHITECTS & PLANNERS

MAIN CONTRACTOR : CR Construction Company Limited

STRUCTURAL ENGINEER : AECOM

FAÇADE CONSULTANT :

NOTE :

1. ALL DIMENSIONS ARE IN mm.
2. ALL ELEVATIONS ARE VIEWED FROM OUTSIDE.
3. ALL DIMENSIONS TO BE VERIFIED ON SITE BEFORE FABRICATION.

LEGEND :

— DETAIL MARK NO.
 — REFER SHEET NO.

1. F.F.L. — FINISHED FLOOR LEVEL
2. S.F.L. — STRUCTURAL FLOOR LEVEL
3. — REVERSED DETAIL

NO.	DATE	REVISED	BY

JOB NO. : J-837

PROJECT : URA KWUN TONG TOWN CENTRE REDEVELOPMENT (AREA 2 & 3) AT NKIL 6514, KWUN TONG, KOWLOON


TITLE : ALUM. WINDOW SCHEDULE (FOR T1)

DATE : 09-JUL-18 SCALE : 1:30


DRAWN BY : Zeng CHECKED BY : DW

MIDI ALUMINIUM FABRICATOR LTD.
 810 Chee Woong Road, Kowloon
 Tel: 2439211-4 Fax: 652727366

DWG NO. : JB37-W-2110 REV. : -


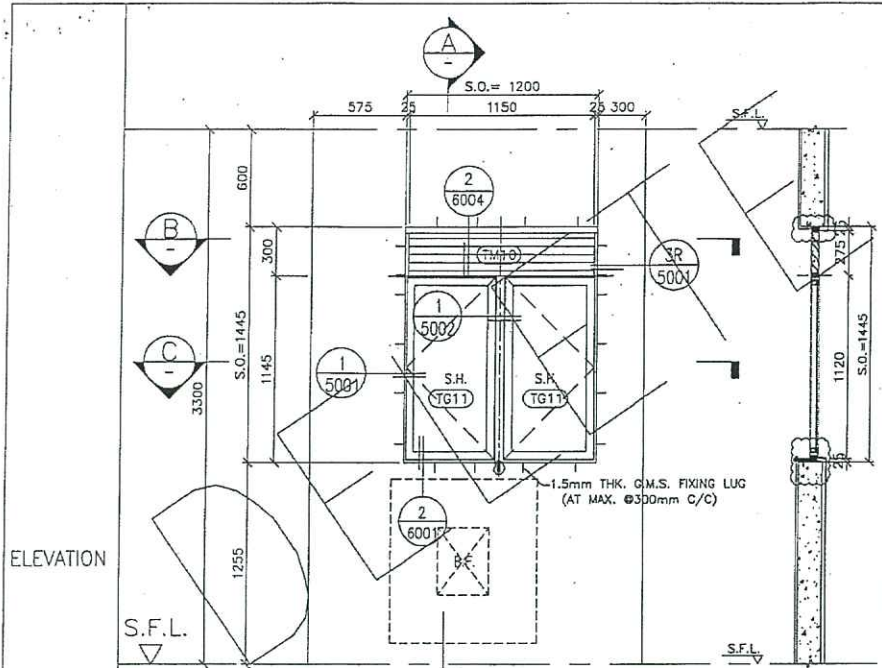


ELEVATION

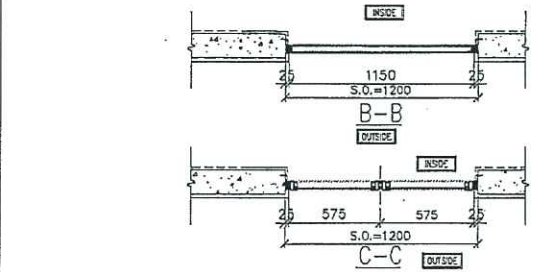

REPLACED BY T2W/55G-KIT INCORPORATED INTO SHOP DRAWING FOR PRECAST WINDOWS (DWG NO: J837-PW-2212)

GLAZING AREA	Required =
	Provided = 1.04
OPENABLE AREA	Required =
	Provided = 1.08

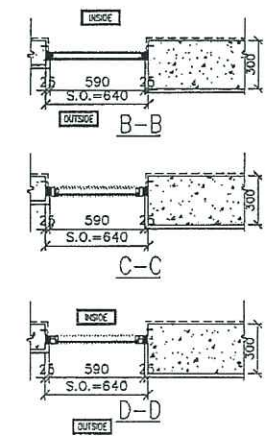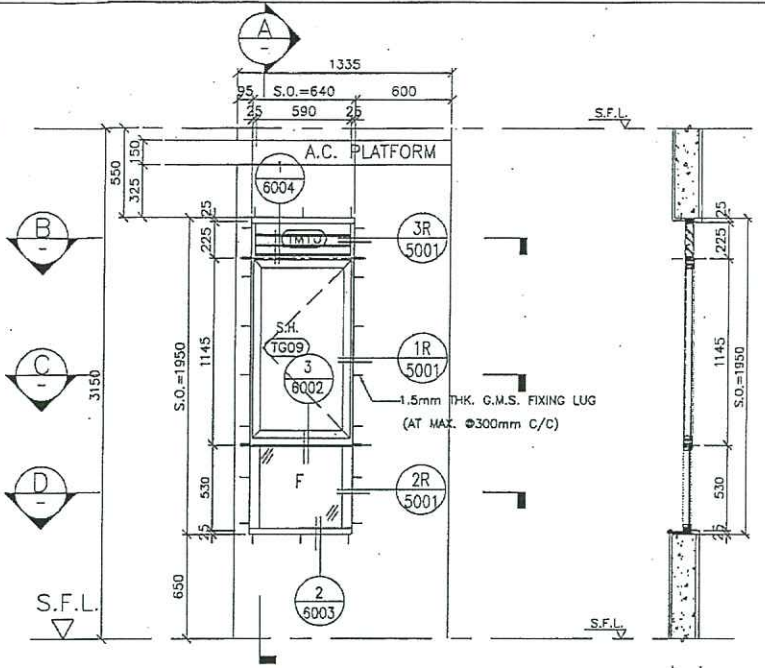

GLAZING AREA	Required = 0.344
	Provided = 0.71
OPENABLE AREA	Required = 0.344
	Provided = 0.57

B.D. REF :

CLIENT : 信和置業有限公司
Sino Land Company Limited

ARCHITECT : WONG TUNG & PARTNERS LIMITED
ARCHITECTS & PLANNERS

MAIN CONTRACTOR : CR Construction Company Limited

STRUCTURAL ENGINEER : AECOM

FAÇADE CONSULTANT :

NOTE :

- ALL DIMENSIONS ARE IN MM.
- ALL ELEVATIONS ARE VIEWED FROM OUTSIDE.
- ALL DIMENSIONS TO BE VERIFIED ON SITE BEFORE FABRICATION.

LEGEND :

(X1) - DETAIL MARK NO.
(2201) - REFER SHEET NO.

- F.F.L. - FINISHED FLOOR LEVEL.
- S.F.L. - STRUCTURAL FLOOR LEVEL.
- (⊖) - REVERSED DETAIL.

NO.	DATE	BY	REVISION	BY
1	2019/07/18	BY ARCHITECT DRAWING		2/24
2	2019/07/20	BY ARCHITECT DRAWING		2/24
3	2019/07/21	BY ARCHITECT DRAWING		2/24
4	2019/07/22	BY ARCHITECT DRAWING		2/24

JOB NO. : J-837

PROJECT : UPA KWUN TONG TOWN CENTRE REDEVELOPMENT (AREA 2 & 3) AT NKIL 6514, KWUN TONG, KOWLOON

TITLE : ALUM. WINDOW SCHEDULE (FOR T2)

DATE : 08-JUL-18 SCALE : 1:50

DRAWN BY : Zeng CHECKED BY : DW



美特鋁業有限公司
MIDI ALUMINIUM FABRICATOR LTD.
Units 6-8, Sunny Industrial Centre, 1/F
510 Che Yee Ling Road, Tseung Kwan O, New Territories
Tel: 23492111-4 Fax: 2342727666

DWG NO. : J837-W-2207 REV. : 0

WINDOW MARK	T2W G-4	Palate
SECTION :	50mm ALUM. SECTION	50mm ALUM. SECTION
QTY.	1 NOS. (TYPICAL)	42 NOS. (TYPICAL)
LOCATION :	55/F FLAT G KITCHEN	T2 6/F-26/F, 28/F-53/F FLAT H BATHROOM
GLAZING	MIN. 8mm THK. CLEAR TEMPERED GLASS	MIN. 8mm THK ACID ETCHED FROSTED TEMPERED GLASS
REMARK :		

WINDOW MARK	T2W H-1	TYP
SECTION :	50mm ALUM. SECTION	50mm ALUM. SECTION
QTY.	1 NOS. (TYPICAL)	42 NOS. (TYPICAL)
LOCATION :	55/F FLAT G KITCHEN	T2 6/F-26/F, 28/F-53/F FLAT H BATHROOM
GLAZING	MIN. 8mm THK. CLEAR TEMPERED GLASS	MIN. 8mm THK ACID ETCHED FROSTED TEMPERED GLASS
REMARK :		

ELEVATION

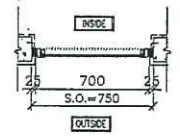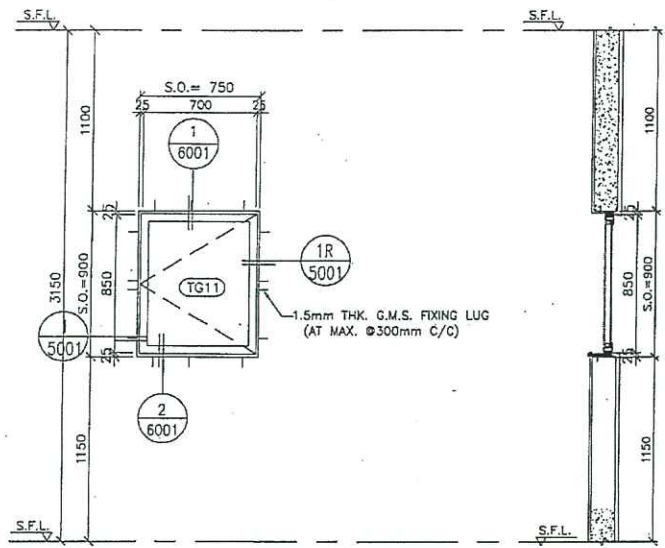

GLAZING AREA	Required =
	Provided = 0.427
OPENABLE AREA	Required =
	Provided = 0.498

WINDOW MARK



X. deleted Access Panel

SECTION :

50mm ALUM. SECTION

QTY. :

1 NOS. (TYPICAL)

LOCATION :

T2 LIFT MACHINE ROOMS

GLAZING :

8mm THK ACID ETCHED FROSTED TEMPERED GLASS

REMARK :

B.D. REF. :

TYPE OF MILLIONS :

CLIENT : 信和置業有限公司 Sino Land Company Limited

ARCHITECT : WONG TUNG & PARTNERS LIMITED ARCHITECTS & PLANNERS

MAIN CONTRACTOR : CR Construction Company Limited

STRUCTURAL ENGINEER : AECOM

FACADE CONSULTANT :

NOTE :





- ALL DIMENSIONS ARE IN mm.
- ALL ELEVATIONS ARE VIEWED FROM OUTSIDE.
- ALL DIMENSIONS TO BE VERIFIED ON SITE BEFORE FABRICATION.

LEGEND :

1R 5001 — DETAIL MARK NO.
6001 — REFER SHEET NO.

- F.F.L. — FINISHED FLOOR LEVEL
- S.F.L. — STRUCTURAL FLOOR LEVEL
- ⊗ — REVERSED DETAIL

NO.	DATE	REVISION	BY
JOB NO. : J-837			
PROJECT : URA KWUN TONG TOWN CENTRE REDEVELOPMENT (AREA 2 & 3) AT NKIL 8514, KWUN TONG, KOWLOON			
TITLE : ALUM. WINDOW SCHEDULE (FOR T1)			
DATE : 09-JUL-16	SCALE : 1:20		
DRAWN BY : Zeng			
CHECKED BY : DW			
英特鋁質有限公司 MIDI ALUMINIUM FABRICATOR LTD. Units 6-8, Sunway Industrial Centre, 1/F 510 Che Kae Lok Road, Newland HK-2248211-4 Fax:8522722555			
DWG NO. : JS37-W-2214			REV. : -

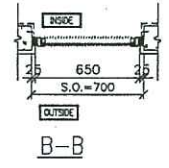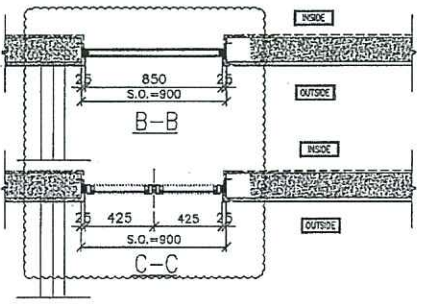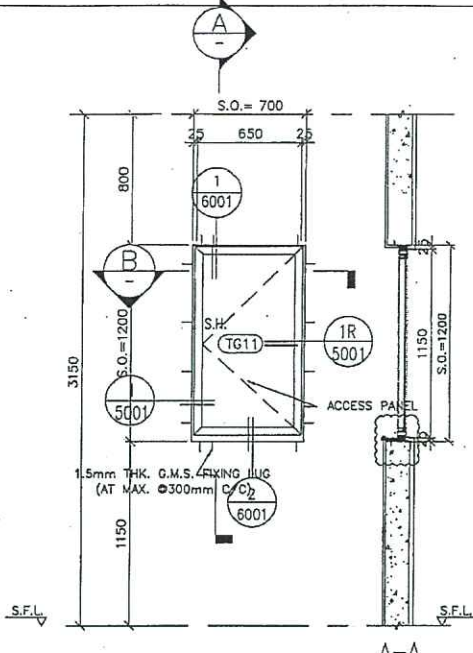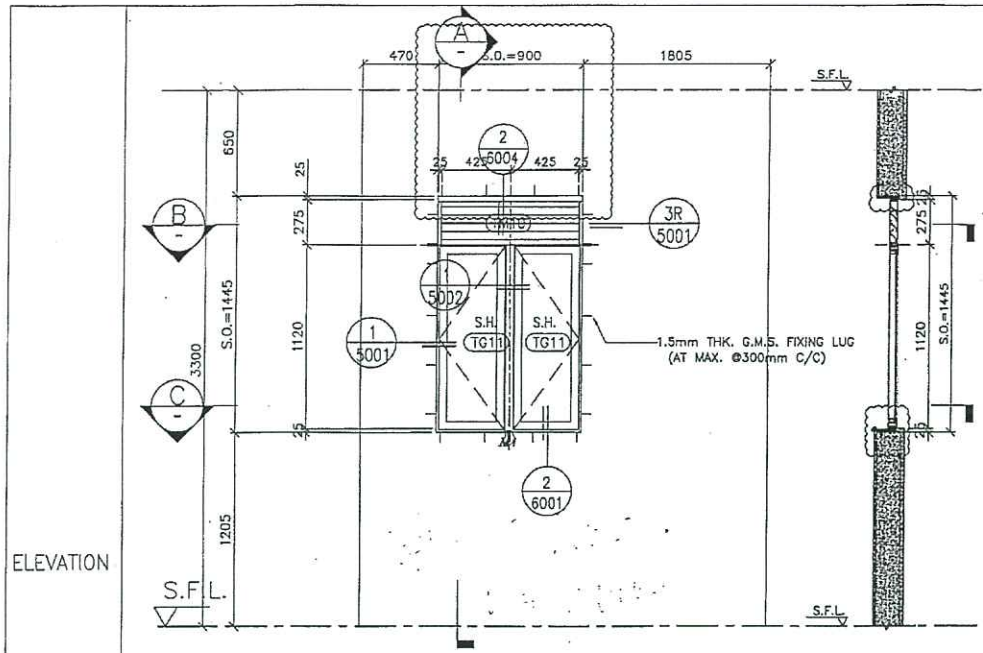

ELEVATION

GLAZING AREA	Required =
	Provided = 1.04
OPENABLE AREA	Required =
	Provided = 1.08

GLAZING AREA	Required =
	Provided = 0.396
OPENABLE AREA	Required =
	Provided = 0.473

WINDOW MARK	T3W H-3	HP X
SECTION :	50mm ALUM. SECTION	
QTY.	1 NOS.	
LOCATION :	T3 52/F FLAT H KITCHEN (Store)	
GLAZING	8mm THK. CLEAR TEMPERED GLASS	
REMARK :		

WINDOW MARK	T3W 3	HP
SECTION :	50mm ALUM. SECTION	
QTY.	41 NOS. (TYPICAL)	
LOCATION :	T3 6/F-26/F, 28/F-52/F COMMON CORRIDOR	
GLAZING	8mm THK ACID ETCHED FROSTED TEMPERED GLASS	
REMARK :	OPENABLE WINDOW	

B.D. REF :

CLIENT : 德和置業有限公司
Sino Land Company Limited

ARCHITECT : WONG TUNG & PARTNERS LIMITED
ARCHITECT & PLANNERS
WT

MAIN CONTRACTOR : CR Construction Company Limited

STRUCTURAL ENGINEER : AECOM

FACADE CONSULTANT :

NOTE :
1. ALL DIMENSIONS ARE IN mm.
2. ALL ELEVATIONS ARE VIEWED FROM OUTSIDE.
3. ALL DIMENSIONS TO BE VERIFIED ON SITE BEFORE FABRICATION.

LEGEND :
X1 --- DETAIL MARK NO.
REF --- REFER SHEET NO.

1. F.F.L. --- FINISHED FLOOR LEVEL
2. S.F.L. --- STRUCTURAL FLOOR LEVEL
3. (R) --- REVERSED DETAIL

6	2016/02/1	BY ARCHITECT CHANGE	2nos
7	2016/02/1	BY ARCHITECT CHANGE	2nos
8	2016/11/28	BY ARCHITECT CHANGE	2nos
9	2016/07/27	BY ARCHITECT CHANGE	2nos

JOB NO. : J-837


PROJECT : URA KWUN TONG TOWN CENTRE REDEVELOPMENT (AREA 2 & 3) AT NKIL 6514, KWUN TONG, KOWLOON

TITLE : ALUM. WINDOW SCHEDULE (FOR T3)


DATE : 09-JUL-18 SCALE : 1:30
DRAWN BY : Zeng CHECKED BY : DW

MIDI ALUMINUM FABRICATOR LTD.
Unit 6-8 Sunny Industrial Centre, 1/F
610 Che Kwo Ling Road, Kowloon
Tel: 23489211-4 Fax: (852) 27278558

DRG NO. : J537-IW-2306 REV. : D

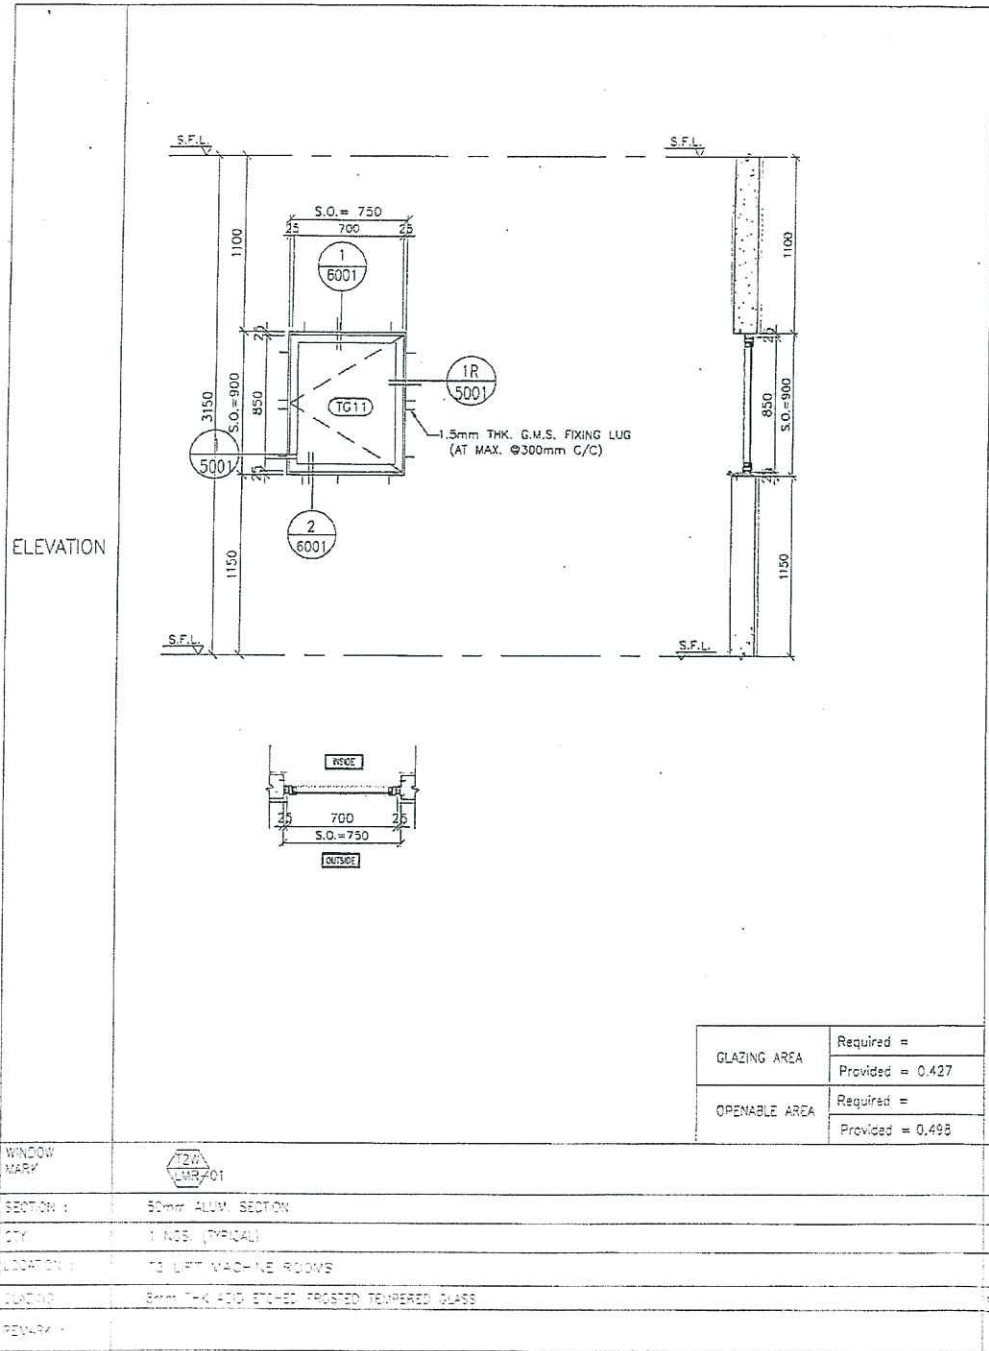

GLAZING AREA	Required =
	Provided = 0.427
OPENABLE AREA	Required =
	Provided = 0.498

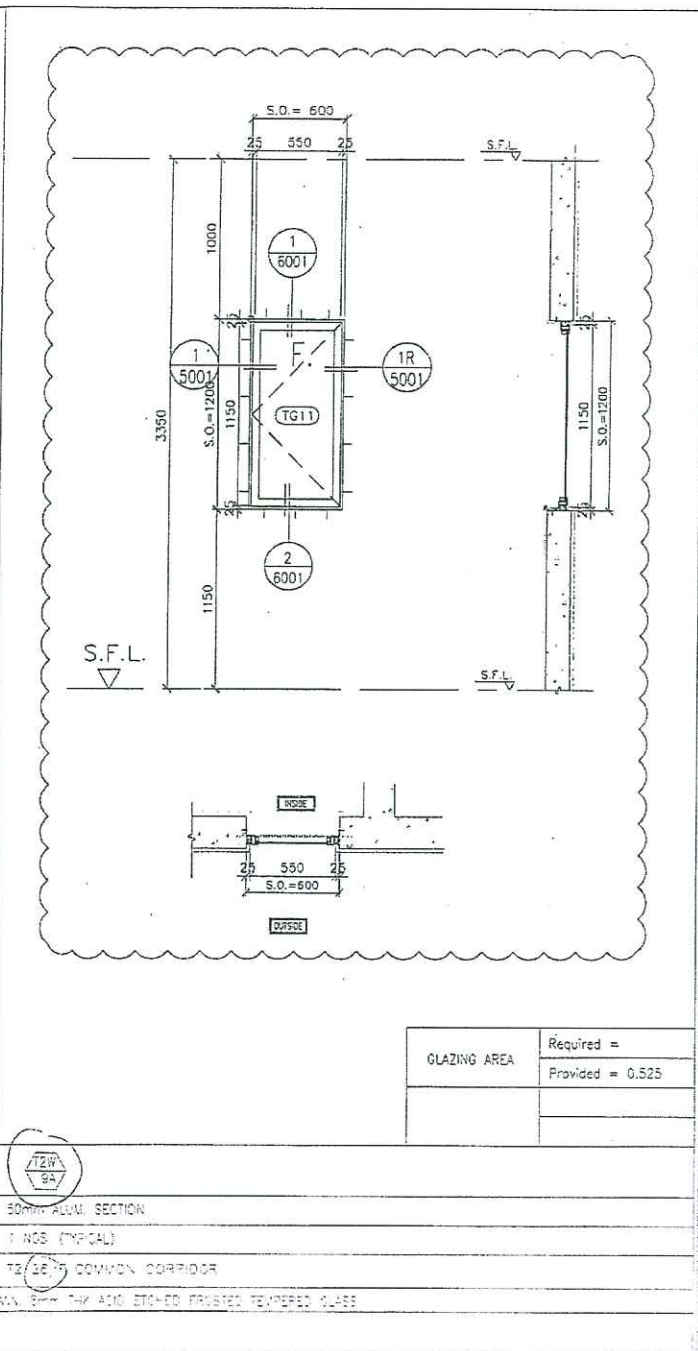

GLAZING AREA	Required =
	Provided = 0.525
OPENABLE AREA	Required =
	Provided =

S.D. REF.:

CLIENT: 信和置業有限公司
Sino Land Company Limited

ARCHITECT: WONG TUNG & PARTNERS LIMITED
ARCHITECTS & PLANNERS
WT

MAIN CONTRACTOR: CR Construction Company Limited

STRUCTURAL ENGINEER: AECOM

FACADE CONSULTANT:

NOTE:
1. ALL DIMENSIONS ARE IN mm.
2. ALL ELEVATIONS ARE VIEWED FROM OUTSIDE.
3. ALL DIMENSIONS TO BE VERIFIED ON SITE BEFORE FABRICATION.

LEGEND:
① -- DETAIL MARK NO.
② -- REFER SHEET NO.

1. F.F.L. -- FINISHED FLOOR LEVEL
2. S.F.L. -- STRUCTURAL FLOOR LEVEL
3. (Z) -- REVERSED DETAIL.

BY ARCHITECT	DATE	CHK
BY ARCHITECT	DATE	CHK
BY	DATE	CHK

JOB NO.: J-837

PROJECT: URBAN KWUN TONG TOWN CENTRE REDEVELOPMENT (AREA 2 & 3) AT NKHL 9514, KWUN TONG, HONGKONG

TITLE: ALUM. WINDOW SCHEDULE (FOR T2)

DATE: 09-JUL-18 SCALE: 1:100





DRAWN BY: Zeng CHECKED BY: J.C.H.

信和置業有限公司
MIDI ALUMINIUM FABRICATOR LTD.
Unit 8-3, Fung Yee Industrial Centre, 170 Shek Lei Street, Shek Kwan, Tuen Mun, New Territories, Hong Kong

2018-07-18 09:27:44 001 B

WINDOW MARK	T2W LMB-701
SECTION	50mm ALUM. SECTION
QTY	1 NOS. (TYPICAL)
LOCATION	T2 LIFT MACHINE ROOMS
GLAZING	8mm THK. ACID ETCHED FROSTED TEMPERED GLASS
REMARK	

WINDOW MARK	T2W SA
SECTION	50mm ALUM. SECTION
QTY	1 NOS. (TYPICAL)
LOCATION	T2 COMMON CORRIDOR
GLAZING	8mm THK. ACID ETCHED FROSTED TEMPERED GLASS
REMARK	

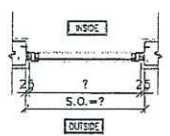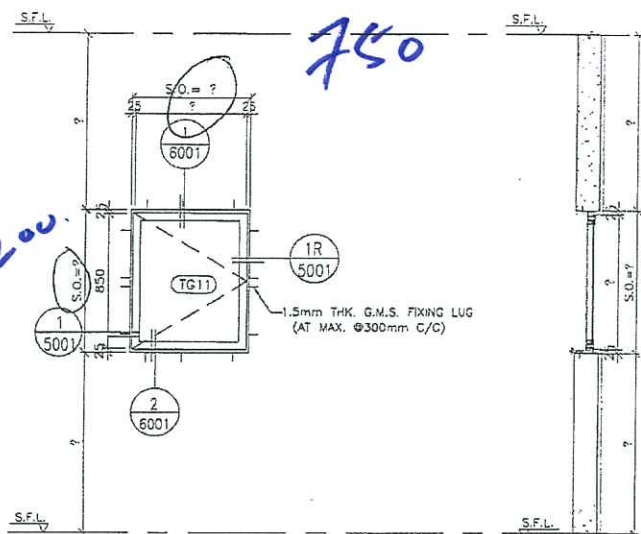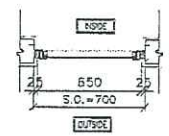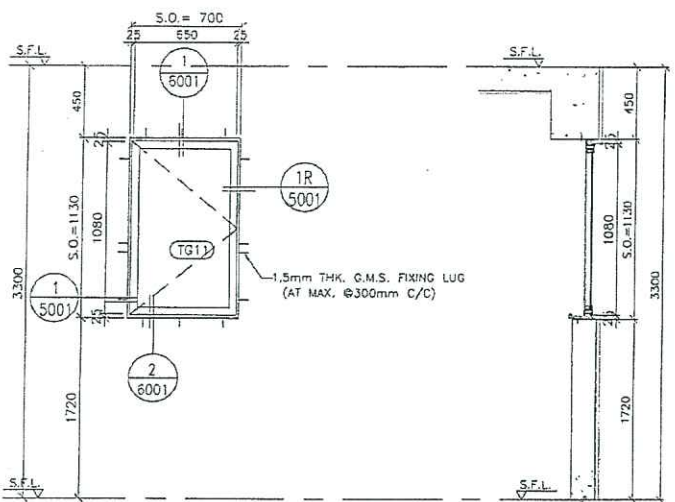

GLAZING AREA	Required =
	Provided = 0.581
OPENABLE AREA	Required =
	Provided = 0.644

GLAZING AREA	Required =
	Provided = ?
OPENABLE AREA	Required =
	Provided = ?

WINDOW MARK




#19. X

SECTION : 50mm ALUM. SECTION
 CITY : HONG KONG (TYPICAL)
 LOCATION : TO BE AT STAIR CASE

GLAZING : 6mm THK AGC E-10 ED FROSTED TEMPERED GLASS

REMARK :

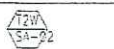

check as-built

SECTION : 50mm ALUM. SECTION
 CITY : HONG KONG (TYPICAL)
 LOCATION : TO BE ACCESS PANEL AT ROOF

GLAZING : 6mm THK AGC E-10 ED FROSTED TEMPERED GLASS

REMARK :

B.D. REF :

CLIENT : 恒和五業有限公司
Sing Land Company Limited

ARCHITECT : WONG TUNG & PARTNERS LIMITED
ARCHITECTS & PLANNERS
WT

MAIN CONTRACTOR : CR Construction Company Limited

STRUCTURAL ENGINEER : AECOM

FACADE CONSULTANT :

NOTE :

- ALL DIMENSIONS ARE IN mm.
- ALL ELEVATIONS ARE VIEWED FROM OUTSIDE.
- ALL DIMENSIONS TO BE VERIFIED ON SITE BEFORE FABRICATION.

LEGEND :

(AT) DETAIL MARK NO.
 (REF) REFER SHEET NO.

- F.F.L. -- FINISHED FLOOR LEVEL
- S.F.L. -- STRUCTURAL FLOOR LEVEL
- (R) -- REVERSED DETAIL

NO.	DATE	REVISED	BY

JOB NO. : J-837

PROJECT : UFA KWUN TONG TOWN CENTRE REDEVELOPMENT (AREA 2 & 3) AT NHK 6814, KWUN TONG, KOWLOON


TITLE : ALUM. WINDOW SCHEDULE (FOR T2)

DATE : 08-JUL-18 SCALE : 1:100




DRAWN BY : Dery CHEN CHECKED BY : JZW

MIDI ARCHITECTURE & INTERIORS LTD.
 401-41 5/F, 5/F, TRADES CENTER, 1/F
 610 CHONG YEE STREET, KOWLOON
 HONG KONG

DWG NO. : 1807-14-0210

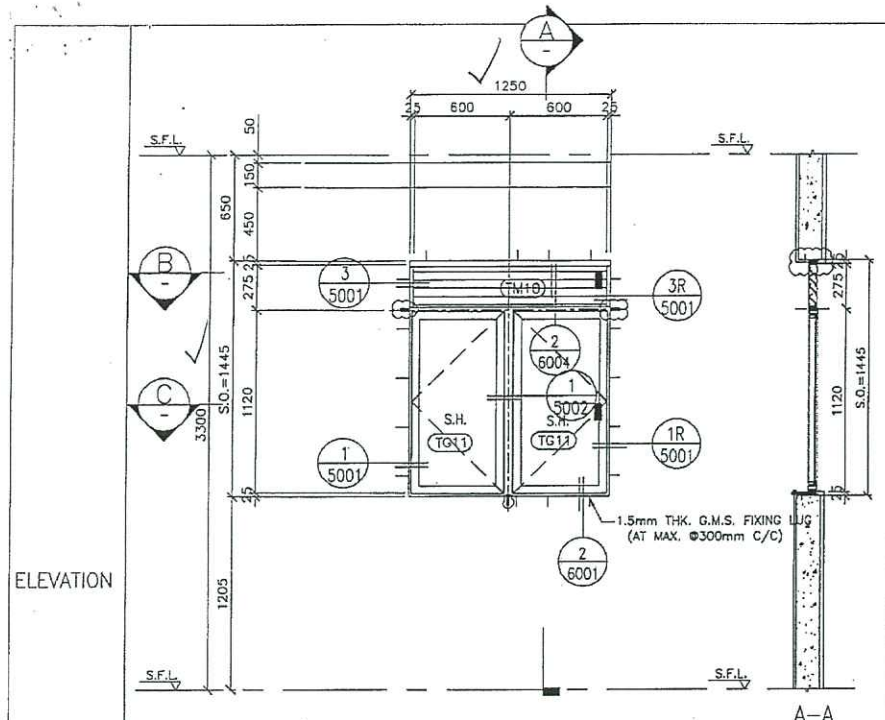

ELEVATION

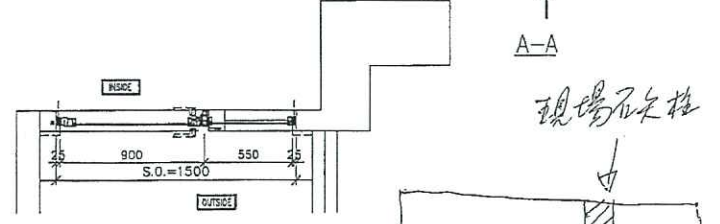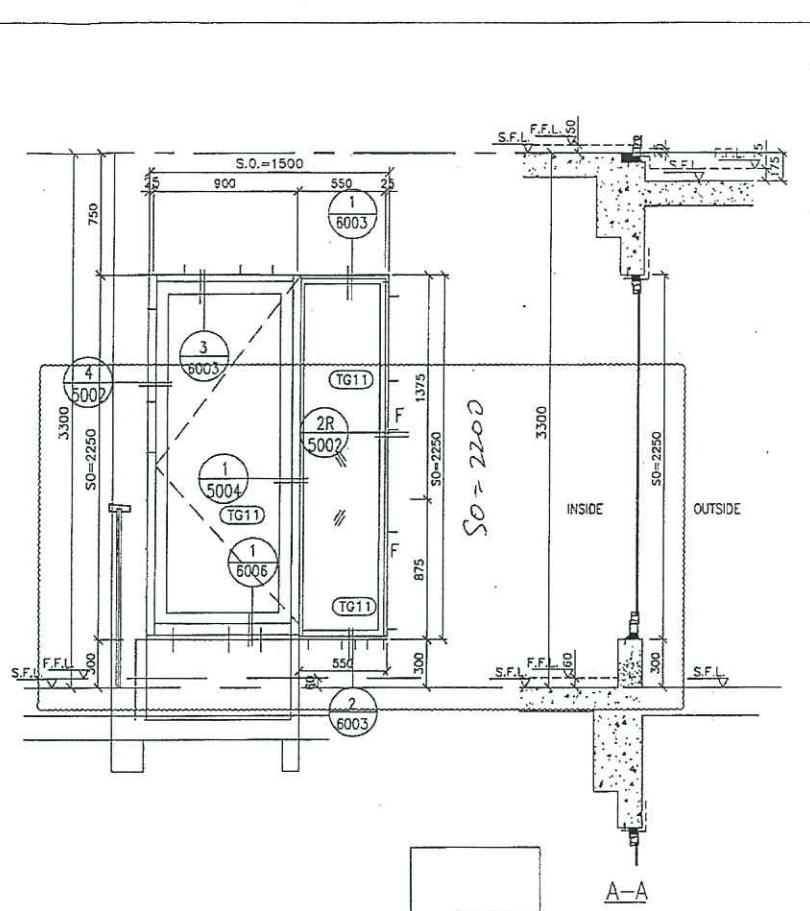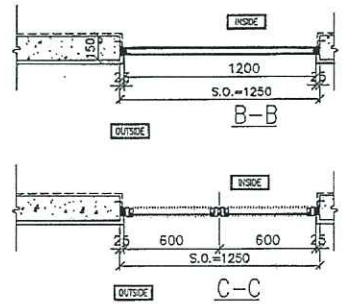

GLAZING AREA	Required = 0.781 Provided = 1.08	GLAZING AREA	Required = 0.969 Provided = 1.08
OPENABLE AREA	Required = 0.488 Provided = 1.13	OPENABLE AREA	Required = 0.606 Provided = 1.13

WINDOW MARK	T3W 52D KIT ✓ H9	T3W 52H KIT ✓ H10	T3W 52H LIV-2 ✓ SC=
SECTION :	50mm ALUM. SECTION	50mm ALUM. SECTION	50mm ALUM. SECTION
QTY.	1 NOS.	1 NOS.	1 NOS.
LOCATION :	T3 52F FLAT D, KITCHEN	T3 52F FLAT H, KITCHEN	T3 52F FLAT H, LIV.
GLAZING	8mm THK CLEAR TEMPERED GLASS	8mm THK CLEAR TEMPERED GLASS	8mm THK CLEAR TEMPERED GLASS
REMARK :			

B.O. REF :

CLIENT : 信和置業有限公司 Sino Land Company Limited

ARCHITECT : WONG TUNG & PARTNERS LIMITED ARCHITECT & PLANNERS

MAIN CONTRACTOR : CR Construction Company Limited

STRUCTURAL ENGINEER : AECOM

FACADE CONSULTANT :

NOTE :

- ALL DIMENSIONS ARE IN mm.
- ALL ELEVATIONS ARE VIEWED FROM OUTSIDE.
- ALL DIMENSIONS TO BE VERIFIED ON SITE BEFORE FABRICATION.

LEGEND :

① DETAIL MARK NO.
② REFER SHEET NO.

1. F.F.L. --- FINISHED FLOOR LEVEL
2. S.F.L. --- STRUCTURAL FLOOR LEVEL
3. Ⓜ --- REVERSED DETAIL

B	2019/01	BY ARCHITECT	2019
A	2019/03	BY ARCHITECT	2019
NO.	DATE	REVISED	BY

JOB NO. : J-837

PROJECT : LURA KWUN TONG TOWN CENTRE REDEVELOPMENT (AREA 2 & 3) AT NKIL 6514, KWUN TONG, KOHLOON

TITLE : ALUM. WINDOW SCHEDULE (FOR T3)

DATE : 09-JUL-18 SCALE : 1:30

DRAWN BY : Zeng CHECKED BY : DW

MIDI 美特鋁質有限公司
Units 6-8, Sunray Industrial Centre, 1/F
E10 Che Kwa Ling Road, Kowloon
Tel: 2469211-4 Fax: 2521272766



DWG NO. : JB37-W-2307 REV. : B

(14)

現場石夾孔 970 x 2600
有格頭

現場石夾孔 900 x 2170
有格頭

ELEVATION

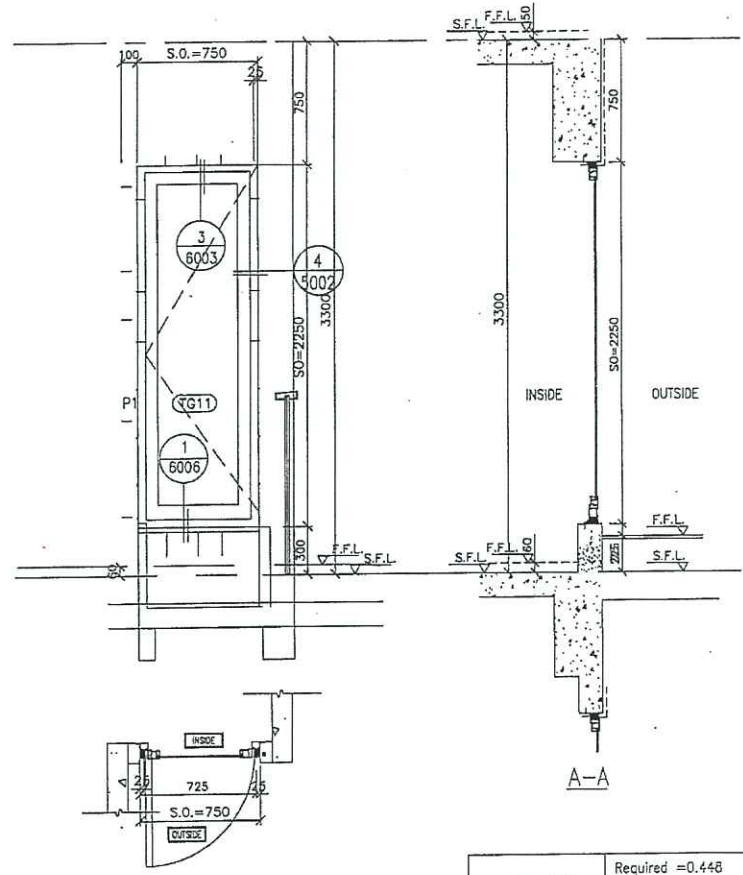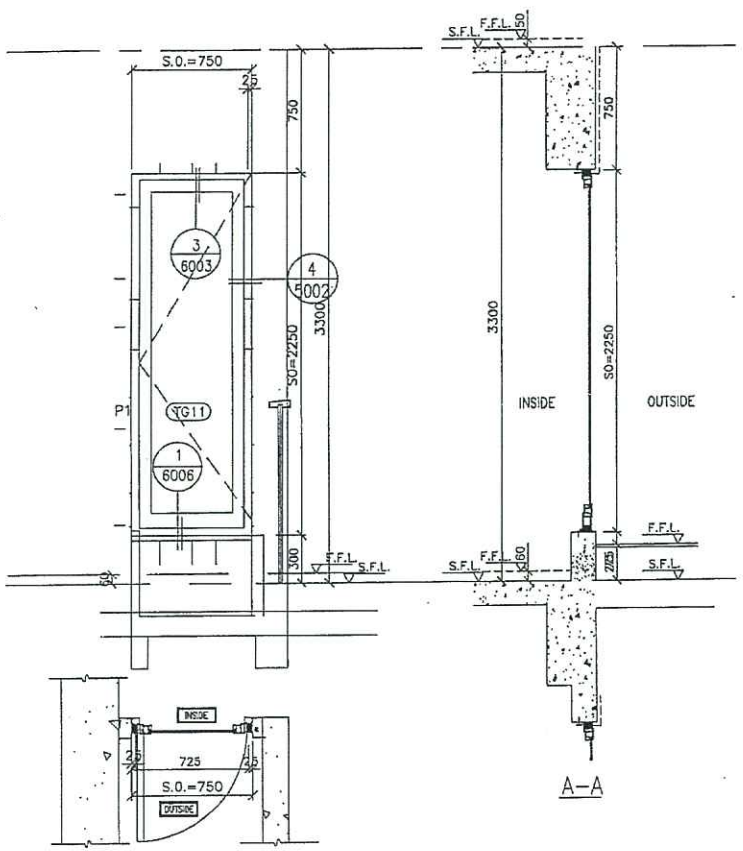

GLAZING AREA	Required = 0.448
	Provided = 1.06
OPENABLE AREA	Required = 0.28
	Provided = 1.27

GLAZING AREA	Required = 0.448
	Provided = 1.06
OPENABLE AREA	Required = 0.28
	Provided = 1.27

WINDOW MARK	T3W 52D	412 X
SECTION :	50mm ALUM. SECTION	
QTY.	1 NOS.	
LOCATION :	T3 52/F FLAT D STAIRCASE	
GLAZING	8mm THK CLEAR TEMPERED GLASS	
REMARK :		

WINDOW MARK	T3W 52H	413 X
SECTION :	50mm ALUM. SECTION	
QTY.	1 NOS.	
LOCATION :	T3 52/F FLAT H STAIRCASE	
GLAZING	8mm THK CLEAR TEMPERED GLASS	

B.D. REF :

CLIENT :
信和置業有限公司
Sino Land Company Limited

ARCHITECT :
WONG TUNG & PARTNERS LIMITED
ARCHITECTS & PLANNERS
WT

MAIN CONTRACTOR :
CR Construction Company Limited

STRUCTURAL ENGINEER :
AECOM

FACADE CONSULTANT :

NOTE :
1. ALL DIMENSIONS ARE IN MM.
2. ALL ELEVATIONS ARE VIEWED FROM OUTSIDE.
3. ALL DIMENSIONS TO BE VERIFIED ON SITE BEFORE FABRICATION.

LEGEND :
① - DETAIL MARK NO.
② - REFER SHEET NO.
1. F.F.L. - FINISHED FLOOR LEVEL.
2. S.F.L. - STRUCTURAL FLOOR LEVEL.
3. (Z) - REVERSED DETAIL.

NO.	DATE	REVISION	BY

JOB NO. : J-537

PROJECT :
URSA KWUN TONG TOWN CENTRE
REDEVELOPMENT (AREA 2 & 3) AT
NKIL 6514, KWUN TONG, KOWLOON

TITLE :
ALUM. WINDOW SCHEDULE
(FOR 412, 413)


DATE : 08-JUL-18 SCALE : 1:30

DRAWN BY : Zeng CHECKED BY : DW

英特鋁業有限公司
MIDI ALUMINIUM FABRICATOR LTD.
Units 6-8, Sunray Industrial Centre, 1/F
610 Ona Kwo Ling Road, Kowloon
Tel: 23469211-4 Fax: (852) 2727886

DWG NO. : JB37-IW-2308 REV. : -

ELEVATION

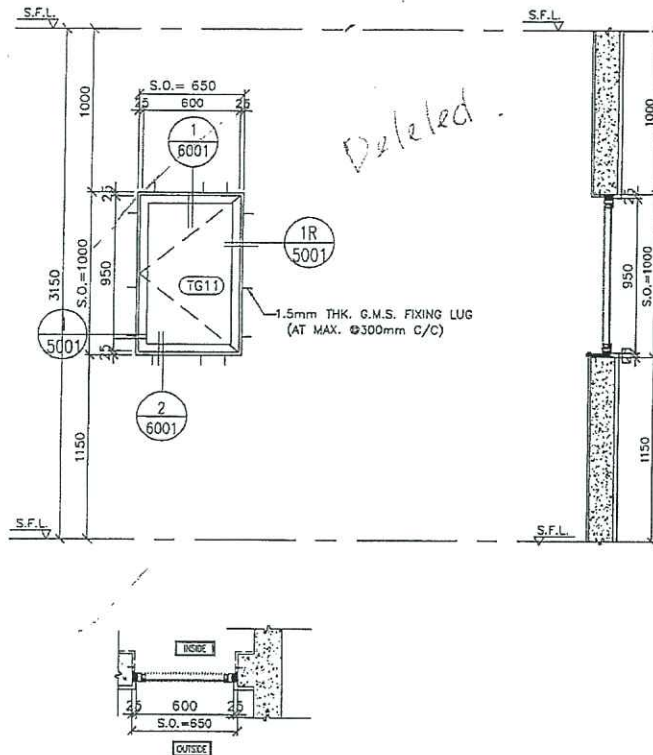

2019.11.22

GLAZING AREA	Required =
	Provided = 0.402
OPENABLE AREA	Required =
	Provided = 0.473

WINDOW MARK	Deleted
SECTION :	50mm ALUM. SECTION
QTY.	1 NOS. (TYPICAL)
LOCATION :	T3 LIFT MACHINE ROOMS
GLAZING	8mm THK ACID ETCHED FROSTED TEMPERED GLASS
REMARK :	

B.D. REF :

TYPE OF MULLIONS :

CLIENT : Sino Land Company Limited

ARCHITECT : WONG TUNG & PARTNERS LIMITED ARCHITECTS & PLANNERS

MAIN CONTRACTOR : CR Construction Company Limited

STRUCTURAL ENGINEER : AECOM

FACADE CONSULTANT :

NOTE :

1. ALL DIMENSIONS ARE IN mm.
2. ALL ELEVATIONS ARE VIEWED FROM OUTSIDE.
3. ALL DIMENSIONS TO BE VERIFIED ON SITE BEFORE FABRICATION.

LEGEND :

① - DETAIL MARK NO.
② - REFER SHEET NO.

1. F.F.L. - FINISHED FLOOR LEVEL
2. S.F.L. - STRUCTURAL FLOOR LEVEL
3. (R) - REVERSED DETAIL

NO.	DATE	REVISION	BY

JOB NO. : J-837

PROJECT : URA KWUN TONG TOWN CENTRE REDEVELOPMENT (AREA 2 & 3) AT NKIL 6514, KWUN TONG, KOWLOON


TITLE : ALUM. WINDOW SCHEDULE (FOR T3 T3)

DATE : 09-JUL-18 SCALE : 1:30


DRAWN BY : Zeng CHECKED BY : DW

英特鋁質有限公司
MIDI ALUMINIUM FABRICATOR LTD.
Units E-8, Szang Industrial Centre, 1/F
810 Chee Nee Ling Road, Kowloon
Tel: 23489211-4 Fax: (852) 27272668



DWG NO. : J837-W-2309 REV. : -

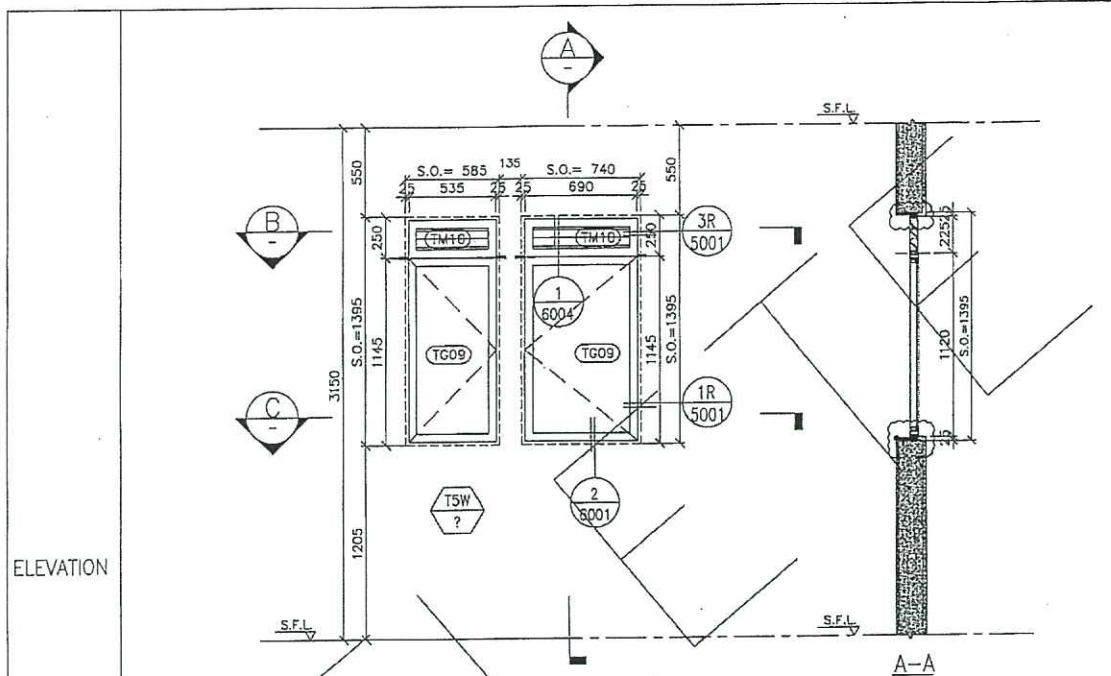

ELEVATION

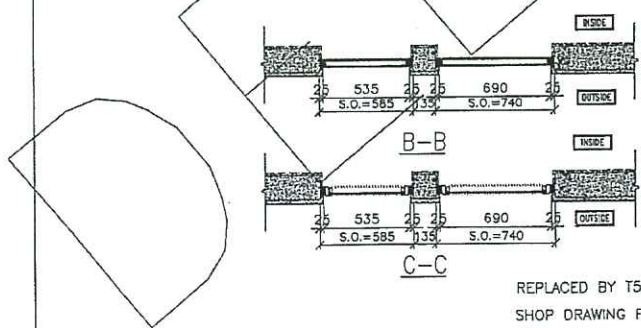

REPLACED BY T5W/51A M-BATH-2. INCORPORATED INTO SHOP DRAWING FOR IN-SITU WINDOWS (DWG NO: J837-IW-2508)

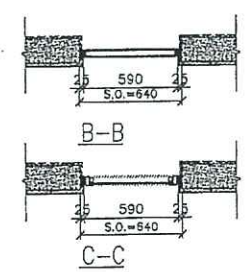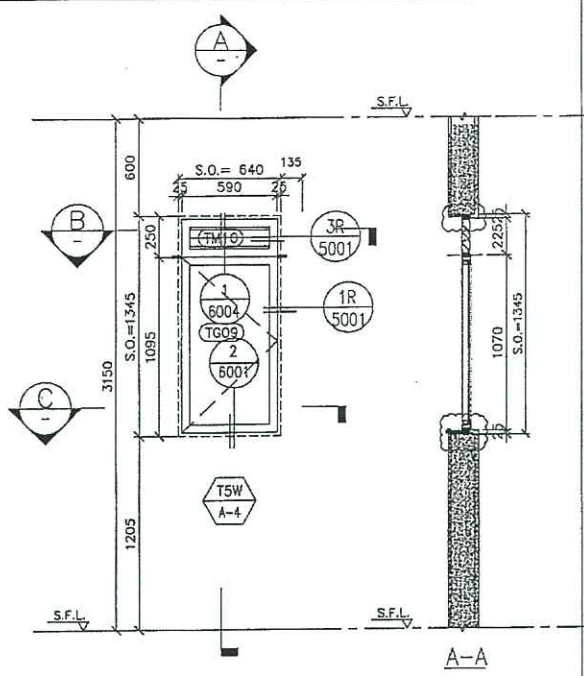

GLAZING AREA	Required =
	Provided = 0.42
OPENABLE AREA	Required =
	Provided = 0.50

GLAZING AREA	Required =
	Provided = 0.48
OPENABLE AREA	Required =
	Provided = 0.66

GLAZING AREA	Required = 0.105
	Provided = 0.58
OPENABLE AREA	Required = 0.105
	Provided = 0.55

WINDOW MARK	T5W M-BATH	T5W A-4
SECTION :	50mm ALUM. SECTION	50mm ALUM. SECTION
QTY.	1 NOS.	36 NOS. (TYPICAL)
LOCATION :	T5 51/F FLAT M BATH AND BATH1	T5 7/F-26/F, 28/F-50/F FLAT(A) BATH
GLAZING	8mm THK ACID ETCHED FROSTED TEMPERED GLASS	8mm THK ACID ETCHED FROSTED TEMPERED GLASS
REMARK :		

DATE :	09-JUL-15	SCALE :	1:30
DRAWN BY :	Zeng	CHECKED BY :	DM
 MIDI ALUMINIUM FABRICATOR LTD. Units 6-8, Suiyee Industrial Centre, 1/F 510 Che Kwo Ling Road, Kowloon Tel: (852) 27272565			
DWG NO. :	J837-IW-2504	REV. :	D

B.D. REF. :

CLIENT : 世和置業有限公司 Sino Land Company Limited

ARCHITECT : WONG TUNG & PARTNERS LIMITED ARCHITECTS & PLANNERS

MAIN CONTRACTOR : CR Construction Company Limited

STRUCTURAL ENGINEER : AECOM

FAÇADE CONSULTANT :

NOTE :

- ALL DIMENSIONS ARE IN mm.
- ALL ELEVATIONS ARE VIEWED FROM OUTSIDE.
- ALL DIMENSIONS TO BE VERIFIED ON SITE BEFORE FABRICATION.

LEGEND :

21 — DETAIL MARK NO.
6004 — REFER SHEET NO.

- F.F.L. — FINISHED FLOOR LEVEL
- S.F.L. — STRUCTURAL FLOOR LEVEL
- ⊗ — REVERSED DETAIL

D	2014/03/26	BY ARCHITECT COMPANY	2mg
C	2014/03/24	BY ARCHITECT COMPANY	2mg
B	2014/01/23	BY ARCHITECT COMPANY	2mg
A	2014/01/09	BY ARCHITECT COMPANY	2mg


JOB NO. : J-837

PROJECT : URA KWUN TONG TOWN CENTRE REDEVELOPMENT (AREA 2 & 3) AT NKIL 6514, KWUN TONG, KOWLOON


TITLE : ALUM. WINDOW SCHEDULE (FOR T5)

TO BE INCORPORATED INTO
SHOP DRAWING FOR CURTAIN WALL

ELEVATION

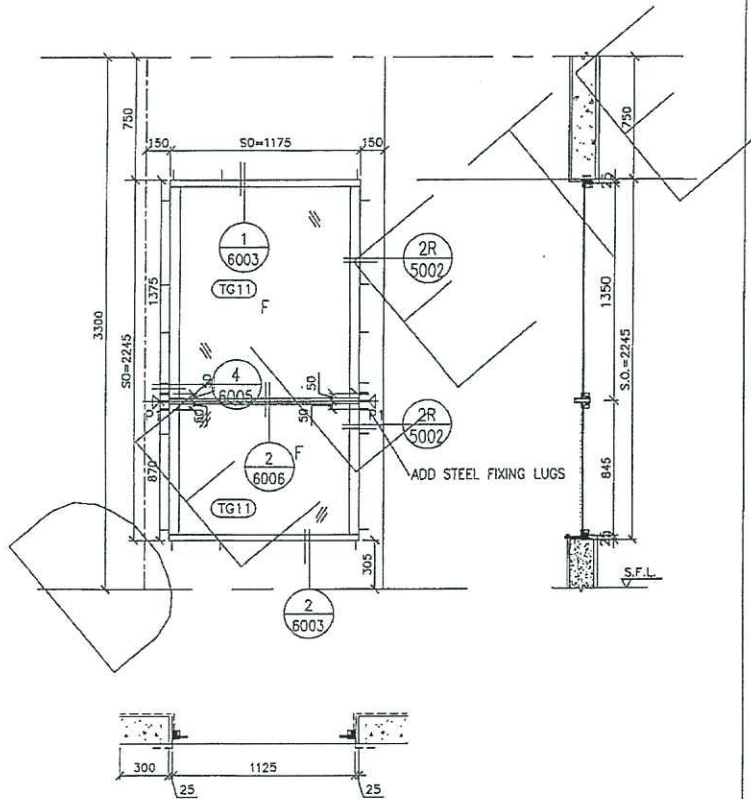

GLAZING AREA	Required =
	Provided = 1.40
OPENABLE AREA	Required =
	Provided = 0

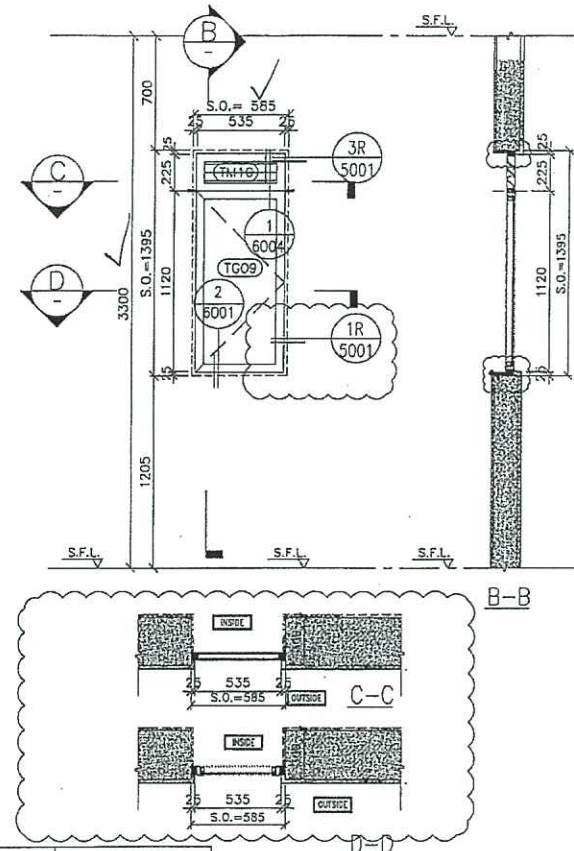

GLAZING AREA	Required = 0.336
	Provided = 0.38
OPENABLE AREA	Required = 0.336
	Provided = 0.46

WINDOW MARK	T5W 51A-LV
SECTION :	50mm ALUM. SECTION
QTY.	1 NOS.
LOCATION :	T5 51/F FLAT A LV.
GLAZING	6mm THK CLEAR TEMPERED GLASS
REMARK :	

WINDOW MARK	T5W 51A-M-BATH-2
SECTION :	50mm ALUM. SECTION
QTY.	1 NOS.
LOCATION :	T5 51/F FLAT A M-BATH 2
GLAZING	6mm THK ADD ETCHED FROSTED TEMPERED GLASS
REMARK :	

B.D. REF :

CLIENT :
信和置業有限公司
Sino Land Company Limited

ARCHITECT :
WONG TUNG & PARTNERS LIMITED
ARCHITECTS & PLANNERS
WT

MAIN CONTRACTOR :
CR Construction Company Limited

STRUCTURAL ENGINEER :
AECOM

FACADE CONSULTANT :

NOTE :
1. ALL DIMENSIONS ARE IN mm.
2. ALL ELEVATIONS ARE VIEWED FROM OUTSIDE.
3. ALL DIMENSIONS TO BE VERIFIED ON SITE BEFORE FABRICATION.

LEGEND :
① -- DETAIL MARK NO.
② -- REFER SHEET NO.
1. F.F.L -- FINISHED FLOOR LEVEL
2. S.F.L -- STRUCTURAL FLOOR LEVEL
3. (R) -- REVERSED DETAIL

A	DATE/NO.	BY	APPROVED	CHK
NO.	DATE	DESIGN	REVIEW	BY

JOB NO. : J-B37

PROJECT :
URA KWUN TONG TOWN CENTRE
REDEVELOPMENT (AREA 2 & 3) AT
NKL 6514, KWUN TONG, KOWLOON



TITLE :
ALUM. WINDOW SCHEDULE
(FOR T5)

DATE : 09-JUL-18 SCALE : 1:30
DRAWN BY : Zeng CHECKED BY : DW



WING TUNG & PARTNERS LIMITED
ALUMINIUM FABRICATOR LTD.
Units 5-8, Sunny Industrial Centre, 1/F
810 Che Kwo Ling Road, Kowloon
Tel: 23459211-4 Fax: 2521272865

DWG NO. : JB37-W-2508 REV. : B

ELEVATION

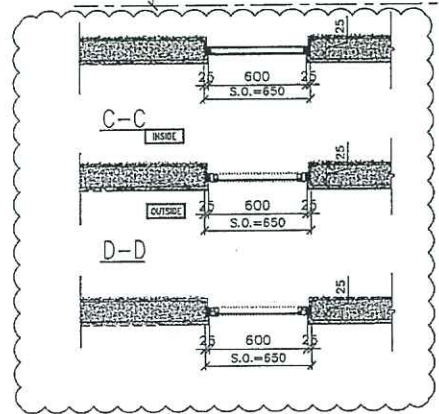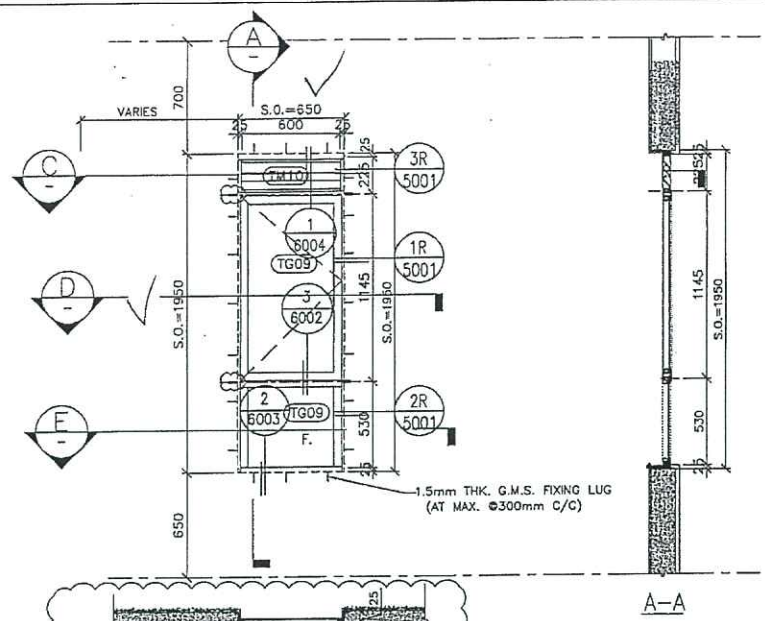

GLAZING AREA	Required = 0.352
	Provided = 0.71
OPENABLE AREA	Required = 0.352
	Provided = 0.58

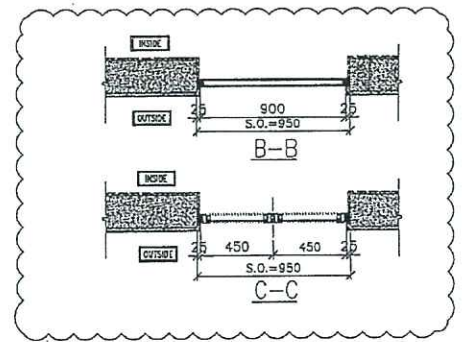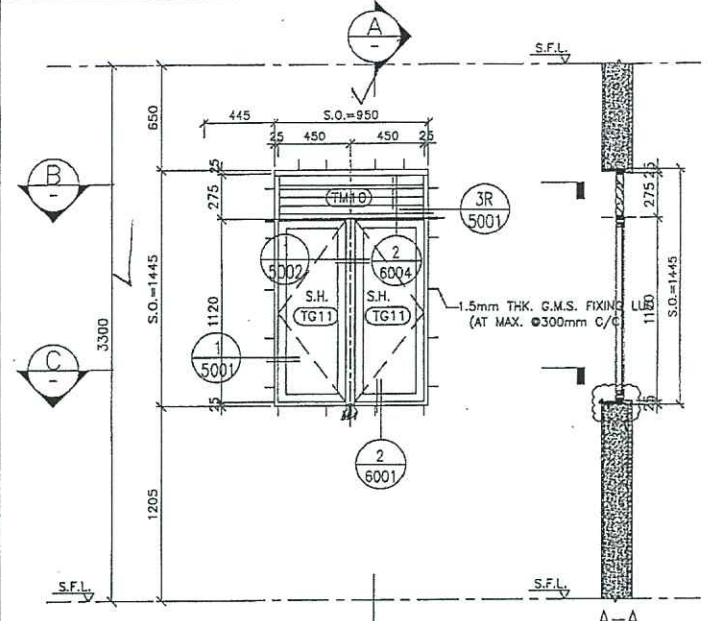

GLAZING AREA	Required = 0.683
	Provided = 0.78
OPENABLE AREA	Required = 0.427
	Provided = 0.61

WINDOW MARK	TSW 51A M-BATH-3	#15 ✓
SECTION :	50mm ALUM. SECTION	
QTY.	1 NOS.	
LOCATION :	TS 51/F FLAT A M-BATH 3	
GLAZING	8mm THK ACID ETCHED FROSTED TEMPERED GLASS	
REMARK :		

WINDOW MARK	TSW 51A-KY	#16 ✓
SECTION :	50mm ALUM. SECTION	
QTY.	1 NOS.	
LOCATION :	TS 51/F FLAT A KITCHEN	
GLAZING	8mm THK CLEAR TEMPERED GLASS	
REMARK :		

B.O. REF :

CLIENT : 恆和置業有限公司
Sino Land Company Limited

ARCHITECT : WONG TUNG & PARTNERS LIMITED
ARCHITECTS & PLANNERS

MAIN CONTRACTOR : CR Construction Company Limited

STRUCTURAL ENGINEER : AECOM

FACADE CONSULTANT :

NOTE :

1. ALL DIMENSIONS ARE IN mm.
2. ALL ELEVATIONS ARE VIEWED FROM OUTSIDE.
3. ALL DIMENSIONS TO BE VERIFIED ON SITE BEFORE FABRICATION.

LEGEND :

(X1) DETAIL MARK NO.
(REF) REFER SHEET NO.

1. F.F.L. -- FINISHED FLOOR LEVEL
2. S.F.L. -- STRUCTURAL FLOOR LEVEL
3. (R) -- REVERSED DETAIL

DATE	2014/7/1	BY	MOHAMED GHAFOR	CHK	
NO.	ACC		REVIS		BY

JOB NO. : J-B37

PROJECT : URA KWUN TONG TOWN CENTRE REDEVELOPMENT (AREA 2 & 3) AT NKIL 6514, KWUN TONG, KOWLOON

TITLE : ALUM. WINDOW SCHEDULE (FOR TS)

DATE : 09-JUL-18 SCALE : 1:30


DRAWN BY : Zeng CHECKED BY : DW

MIDI ALUMINIUM FABRICATOR LTD.
Units 6-8, Sunny Industrial Centre, 1/F
210 Che Kwo Ling Road, Kowloon
Tel: 21482111-4 Fax: (852) 27215656

DWG NO. : JB37-1W-2509 REV. : A

現場石夾孔 900 x 2230.
未落格頭.

ELEVATION

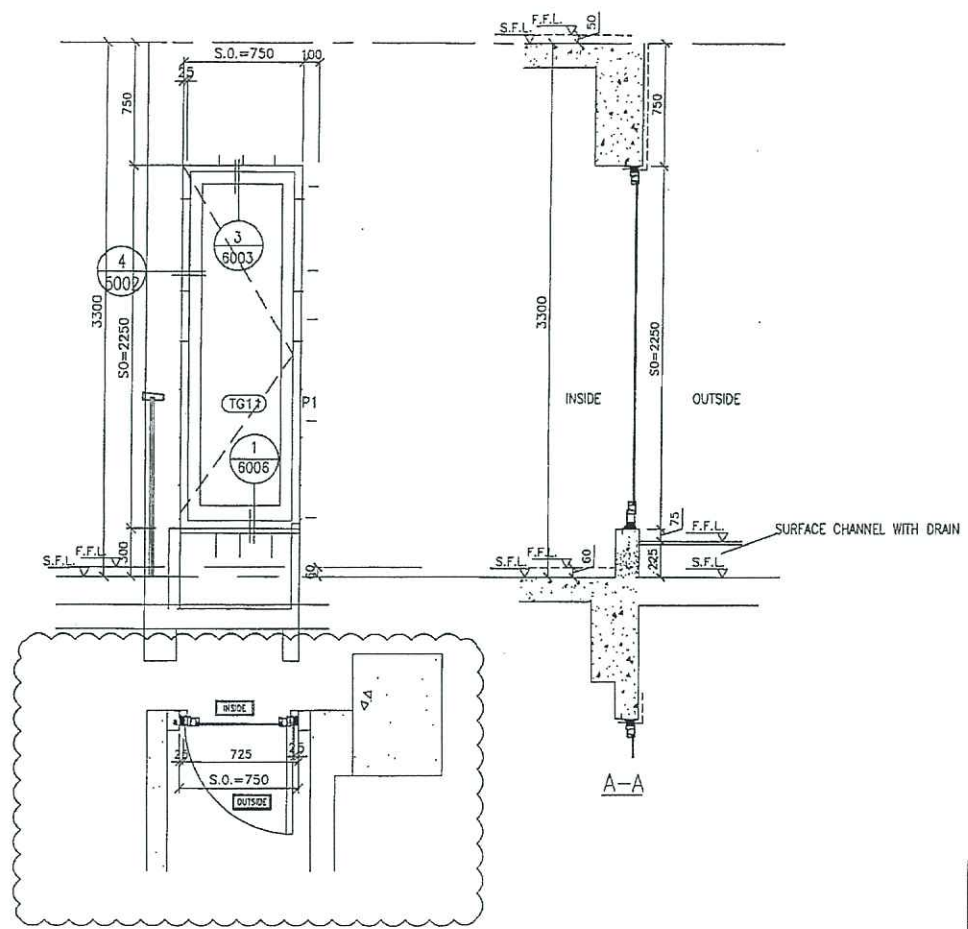

GLAZING AREA	Required = 0.448
	Provided = 1.05
OPENABLE AREA	Required = 0.28
	Provided = 1.27

WINDOW MARK	T5W 51A
SECTION :	50mm ALUM. SECTION
QTY.	1 NOS.
LOCATION :	T5 51/F FLAT A STAIRCASE
GLAZING	8mm THK CLEAR TEMPERED GLASS
REMARK :	

117 X

B.D. REF :

CLIENT : 信和置業有限公司
Sino Land Company Limited

ARCHITECT : WONG TUNG & PARTNERS LIMITED
ARCHITECTS & PLANNERS
WT

MAIN CONTRACTOR : CR Construction Company Limited

STRUCTURAL ENGINEER : AECOM

FACADE CONSULTANT :

NOTE :

- ALL DIMENSIONS ARE IN mm.
- ALL ELEVATIONS ARE VIEWED FROM OUTSIDE.
- ALL DIMENSIONS TO BE VERIFIED ON SITE BEFORE FABRICATION.

LEGEND :

DT -- DETAIL MARK NO.
R/S -- REFER SHEET NO.

- F.F.L -- FINISHED FLOOR LEVEL
- S.F.L -- STRUCTURAL FLOOR LEVEL
- ② -- REVERSED DETAIL

A	2018/7/21	BY ARCHITECT ENGINEER	DWG
NO.	SHT	SHEET	21

JOB NO. : J-637

PROJECT : URA KWUN TONG TOWN CENTRE REDEVELOPMENT (AREA 2 & 3) AT NKIL 6514, KWUN TONG, KOWLOON

TITLE : ALUM. WINDOW SCHEDULE (FOR T5)


DATE : 09-JUL-18 SCALE : 1:30

DRAWN BY : Zeng CHECKED BY : DW

英特姆有限公司
MIDI ALUMINIUM FABRICATOR LTD.
Units 5-8, Sunny Industrial Centre, 1/F
610 Che Kwo Ling Road, Kowloon
Tel: 23489211-4 Fax: (852) 27727566

DWG NO. : JB37-W-2510 RDV. : -

ELEVATION

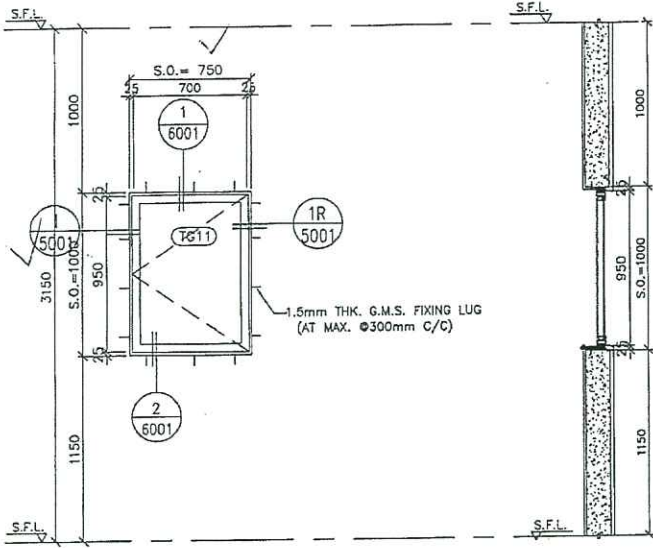

Painted.

#18 X

GLAZING AREA	Required =
	Provided = 0.486
OPENABLE AREA	Required =
	Provided = 0.562

WINDOW MARK



SECTION : 50mm ALUM. SECTION
 QTY. 1 NOS. (TYPICAL)
 LOCATION : T5 LIFT MACHINE ROOMS
 GLAZING 8mm THK ACID ETCHED FROSTED TEMPERED GLASS
 REMARK :

B.D. REF :

TYPE OF MULLIONS :
 ML 65-100-1000-SECTION

CLIENT :
 信和置業有限公司
 Sino Land Company Limited

ARCHITECT :
 WONG TUNG & PARTNERS LIMITED
 ARCHITECTS & PLANNERS

MAIN CONTRACTOR :
 CR Construction Company Limited


STRUCTURAL ENGINEER :
 AECOM






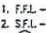

FACADE CONSULTANT:

NOTE :
 1. ALL DIMENSIONS ARE IN mm.
 2. ALL ELEVATIONS ARE VIEWED FROM OUTSIDE.
 3. ALL DIMENSIONS TO BE VERIFIED ON SITE BEFORE FABRICATION.

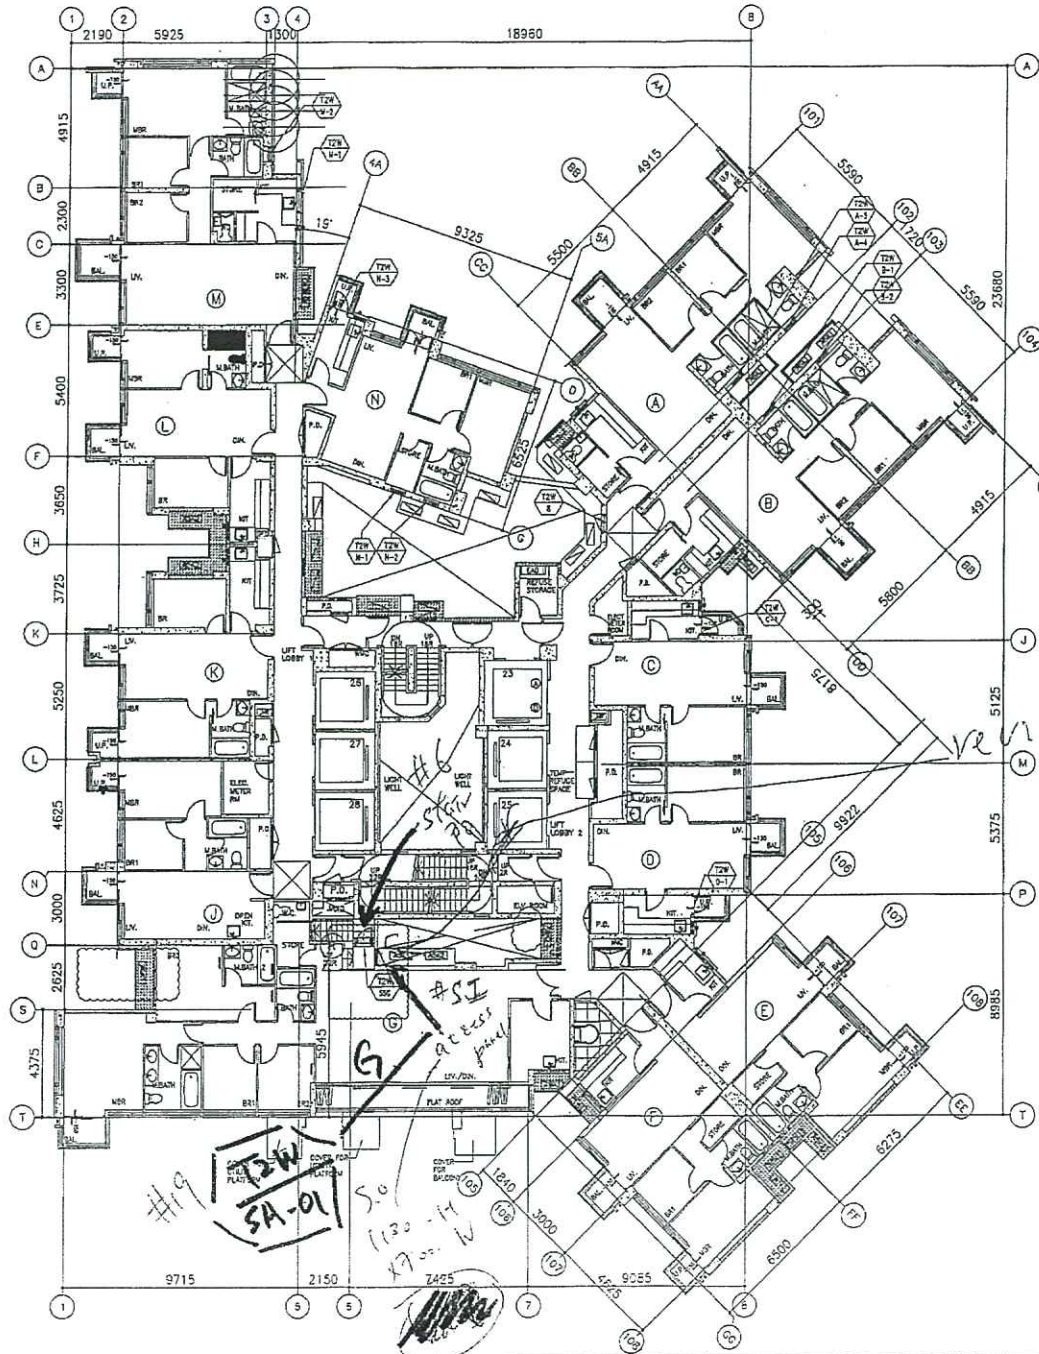
LEGEND :
 DETAIL MARK NO.
 REFER SHEET NO.
 1. F.F.L. -- FINISHED FLOOR LEVEL
 2. S.F.L. -- STRUCTURAL FLOOR LEVEL
 3. (2) -- REVERSED DETAIL.

NO.	DATE	REVISION	BY
JOB NO. :	J-837		
PROJECT :	URA KWUN TONG TOWN CENTRE REDEVELOPMENT (AREA 2 & 3) AT NKIL 6514, KWUN TONG, KOWLOON		
TITLE :	ALUM. WINDOW SCHEDULE (FOR T1)		
DATE :	05-JUL-13	SCALE :	1:30
DRAWN BY :	Zeng	CHECKED BY :	DW
英特鋁質有限公司 MIDI ALUMINIUM FABRICATION LTD. Units 5-8, Sunny Industrial Centre, 1/F 810 Chee Koo Ling Road, Kwai Tsing Tel: 23482111-4 Fax: (852) 27272666			
DWG NO. :	J837-W-2511	REV. :	-



B.D. REF :																																																	
CLIENT :  信和置业有限公司 Sino Land Company Limited																																																	
ARCHITECT :  WONG TUNG & PARTNERS LIMITED ARCHITECTS & PLANNERS																																																	
MAIN CONTRACTOR :  CR Construction Company Limited																																																	
STRUCTURAL ENGINEER :  AECOM																																																	
FACADE CONSULTANT:																																																	
NOTE : 1. ALL DIMENSIONS ARE IN mm. 2. ALL ELEVATIONS ARE VIEWED FROM OUTSIDE. 3. ALL DIMENSIONS TO BE VERIFIED ON SITE BEFORE FABRICATION.																																																	
LEGEND :  DETAIL MARK NO.  REFER SHEET NO. 1. F.F.L. -- FINISHED FLOOR LEVEL 2. S.F.L. -- STRUCTURAL FLOOR LEVEL 3. (2) -- REVERSED DETAIL																																																	
<table border="1"> <tr> <td>NO</td> <td>DATE</td> <td>BY ARCHITECT</td> <td>CHKD</td> </tr> <tr> <td>1</td> <td>2011-4-15</td> <td>BY ARCHITECT</td> <td>Zeng</td> </tr> <tr> <td>2</td> <td>2011-4-25</td> <td>BY ARCHITECT</td> <td>Zeng</td> </tr> <tr> <td>3</td> <td>2011-5-10</td> <td>BY ARCHITECT</td> <td>Zeng</td> </tr> <tr> <td>4</td> <td>2011-5-10</td> <td>BY ARCHITECT</td> <td>Zeng</td> </tr> <tr> <td>5</td> <td>2011-5-10</td> <td>BY ARCHITECT</td> <td>Zeng</td> </tr> </table>	NO	DATE	BY ARCHITECT	CHKD	1	2011-4-15	BY ARCHITECT	Zeng	2	2011-4-25	BY ARCHITECT	Zeng	3	2011-5-10	BY ARCHITECT	Zeng	4	2011-5-10	BY ARCHITECT	Zeng	5	2011-5-10	BY ARCHITECT	Zeng	<table border="1"> <tr> <td>NO</td> <td>DATE</td> <td>BY ARCHITECT</td> <td>CHKD</td> </tr> <tr> <td>1</td> <td>2011-4-15</td> <td>BY ARCHITECT</td> <td>Zeng</td> </tr> <tr> <td>2</td> <td>2011-4-25</td> <td>BY ARCHITECT</td> <td>Zeng</td> </tr> <tr> <td>3</td> <td>2011-5-10</td> <td>BY ARCHITECT</td> <td>Zeng</td> </tr> <tr> <td>4</td> <td>2011-5-10</td> <td>BY ARCHITECT</td> <td>Zeng</td> </tr> <tr> <td>5</td> <td>2011-5-10</td> <td>BY ARCHITECT</td> <td>Zeng</td> </tr> </table>	NO	DATE	BY ARCHITECT	CHKD	1	2011-4-15	BY ARCHITECT	Zeng	2	2011-4-25	BY ARCHITECT	Zeng	3	2011-5-10	BY ARCHITECT	Zeng	4	2011-5-10	BY ARCHITECT	Zeng	5	2011-5-10	BY ARCHITECT	Zeng
NO	DATE	BY ARCHITECT	CHKD																																														
1	2011-4-15	BY ARCHITECT	Zeng																																														
2	2011-4-25	BY ARCHITECT	Zeng																																														
3	2011-5-10	BY ARCHITECT	Zeng																																														
4	2011-5-10	BY ARCHITECT	Zeng																																														
5	2011-5-10	BY ARCHITECT	Zeng																																														
NO	DATE	BY ARCHITECT	CHKD																																														
1	2011-4-15	BY ARCHITECT	Zeng																																														
2	2011-4-25	BY ARCHITECT	Zeng																																														
3	2011-5-10	BY ARCHITECT	Zeng																																														
4	2011-5-10	BY ARCHITECT	Zeng																																														
5	2011-5-10	BY ARCHITECT	Zeng																																														
CASE NO. : J-837																																																	
PROJECT : URA KWUN TONG TOWN CENTRE REDEVELOPMENT (AREA 2 & 3) AT NKIL 6514, KWUN TONG, KOWLOON																																																	
TITLE : FULL PLAN LAYOUT (FOR T2 55/F FLOOR PLAN)																																																	
DATE : 09-JUL-18	SCALE : 1:200																																																
DRAWN BY : Zeng	CHECKED BY : DW																																																
 英特鋁質有限公司 MIDI ALUMINIUM FABRICATOR LTD. Units 6-8, Sunny Industrial Centre, 1/F #10 Cheong Yee Ling Road, Yau-wan Tel: 23493211-4 Fax: (852) 2727556																																																	
DWG NO. : JB37-NY-3203	REV : D																																																

T2 - 55/F FLOOR PLAN

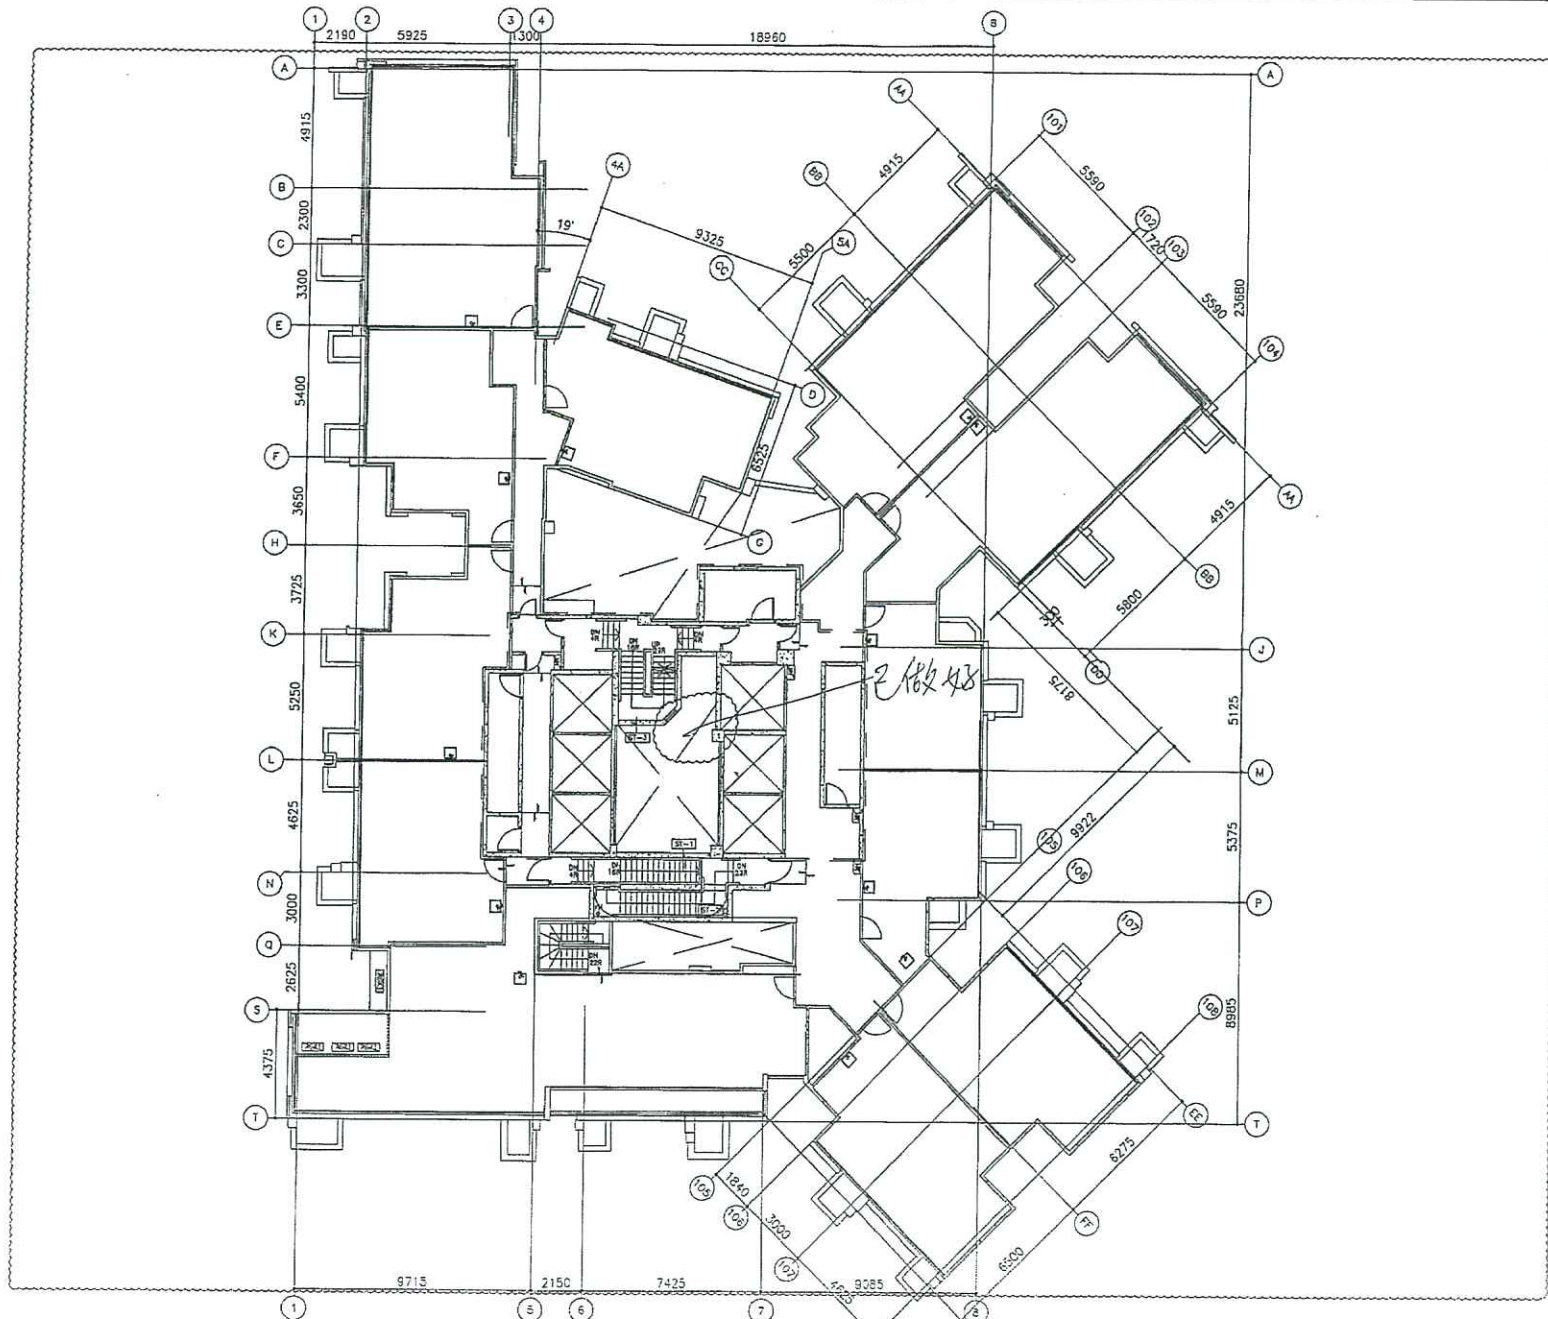

T2 - ROOF PLAN

T2 - ROOF PLAN

B.O. REF :

CLIENT : 信和置業有限公司
Sino Land Company Limited


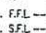
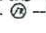
ARCHITECT : WONG TUNG & PARTNERS LIMITED
ARCHITECTS & PLANNERS
WT

MAIN CONTRACTOR : CR Construction Company Limited

STRUCTURAL ENGINEER : **AECOM**

FACADE CONSULTANT :

NOTE :
1. ALL DIMENSIONS ARE IN mm.
2. ALL ELEVATIONS ARE VIEWED FROM OUTSIDE.
3. ALL DIMENSIONS TO BE VERIFIED ON SITE BEFORE FABRICATION.

LEGEND :
 DETAIL MARK NO.
 REFER SHEET NO.
 1. F.F.L. --- FINISHED FLOOR LEVEL
 2. S.F.L. --- STRUCTURAL FLOOR LEVEL
 3.  --- REVERSED DETAIL

NO.	DATE	BY ARCHITECT/CONTRACTOR	REVISION	BY

JOB NO. : J-837

PROJECT : LURA KWUN TONG TOWN CENTRE REDEVELOPMENT (AREA 2 & 3) AT NKIL 6514, KWUN TONG, KOWLOON





TITLE : FULL PLAN LAYOUT (FOR T2 ROOF PLAN)

DATE : 09-JUL-13 SCALE : 1:200

DRAWN BY : Zeng CHECKED BY : DW


信和置業有限公司
MIDI MANAGEMENT PRACTICE LTD.
Units 5-6, Sunray Industrial Centre, 7/F
610 Chee Kwo Ling Road, Kowloon
Tel: 23488211-4 Fax: (852) 27275586

DWG NO. : JS37-W-320-2 REV. : A

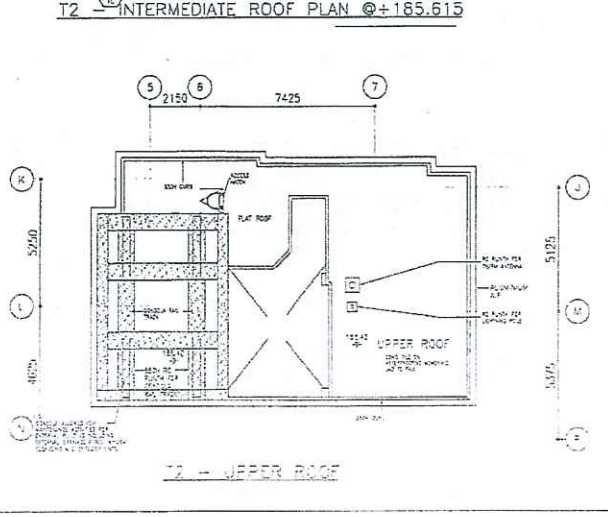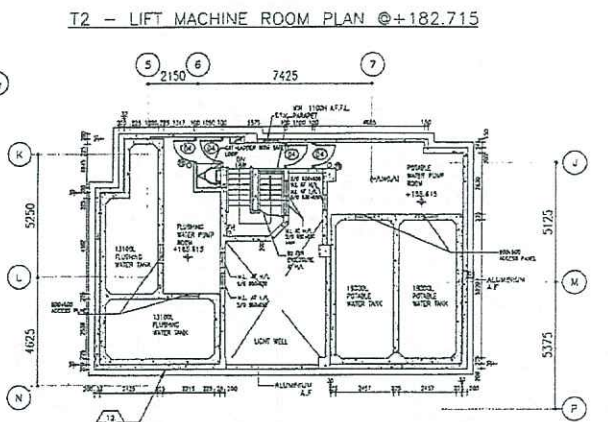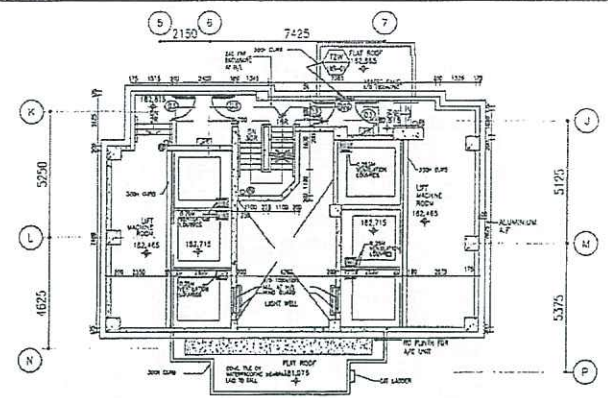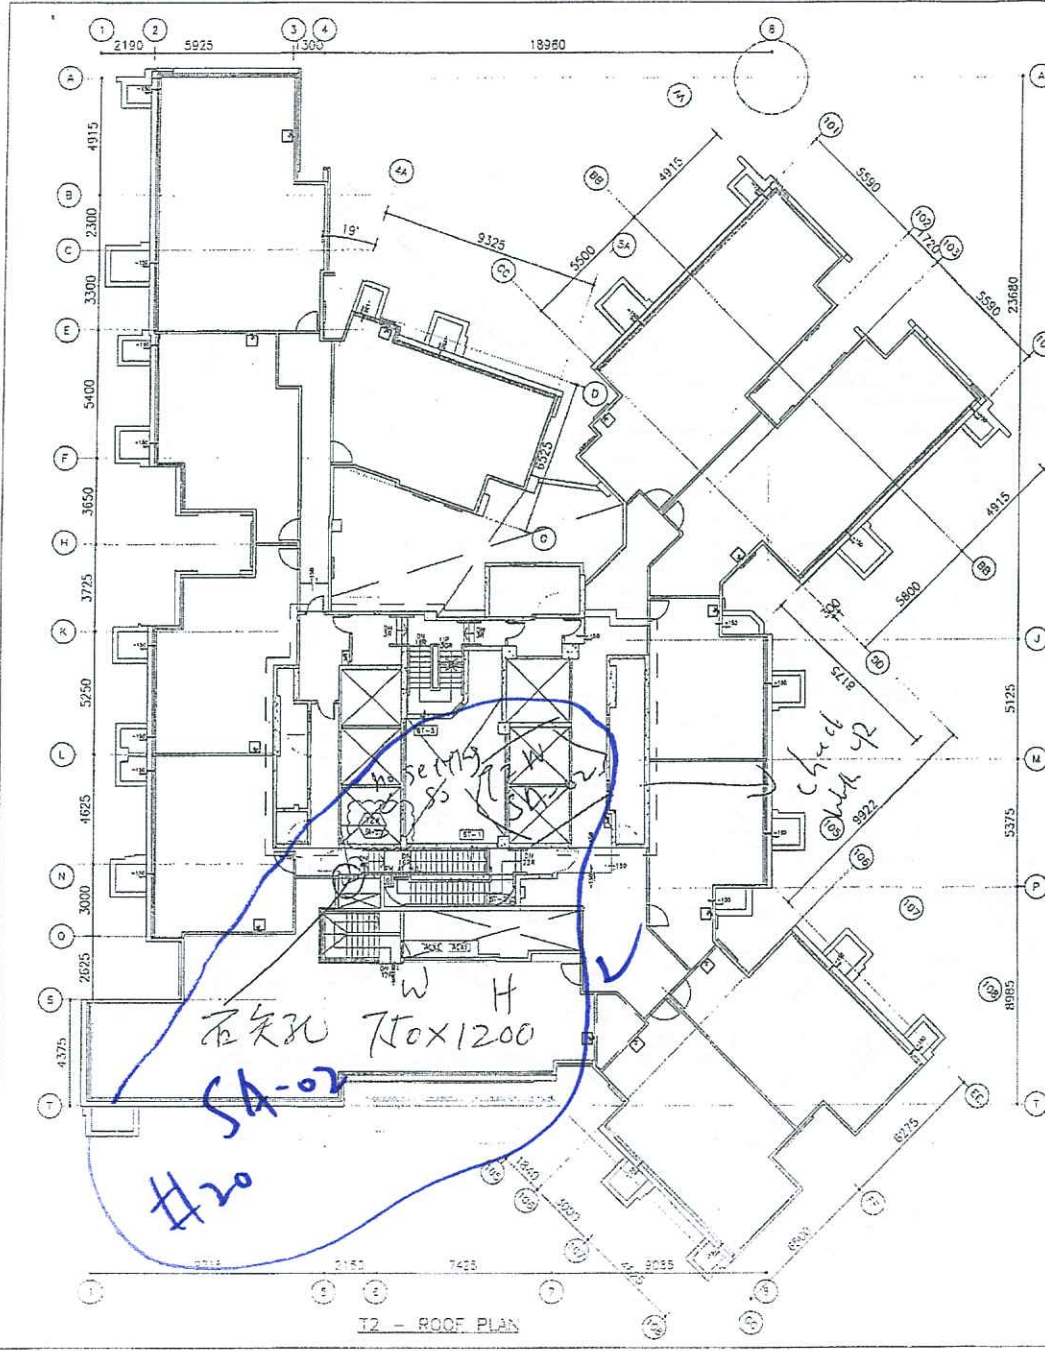

E.D. REF :	
CLIENT : 信和置業有限公司 Sino Land Company Limited	
ARCHITECT : WONG TUNG & PARTNERS LIMITED ARCHITECTS & PLANNERS	
MAIN CONTRACTOR : CR Construction Company Limited	
STRUCTURAL ENGINEER : AECOM	
FACADE CONSULTANT:	
NOTE: 1. ALL DIMENSIONS ARE IN mm. 2. ALL DIMENSIONS ARE VIEWED FROM OUTSIDE. 3. ALL DIMENSIONS TO BE VERIFIED ON SITE BEFORE FABRICATION.	
LEGEND: ① --- DETAIL MARK NO. ② --- REFER SHEET NO.	
1. F.F.L --- FINISHED FLOOR LEVEL 2. S.F.L --- STRUCTURAL FLOOR LEVEL 3. Ⓞ --- REVERSED DETAIL	
1: 2000/1	BY ARCHITECT GROUP
DATE: 09-JUL-18	SCALE: 1:1000
JOB NO.: J-537	
PROJECT: URA KWUN TONG TOWN CENTRE REDEVELOPMENT (AREA 2 & 3) AT MKII 8514, KWUN TONG, KOWLOON	
TITLE: FULL PLAN LAYOUT (FDP 12 ROOF PLAN)	
DRAWN BY: Dany	
CHECKED BY: D.A.	
英中建築有限公司 MIDI ARCHITECTS & PLANNERS LTD. UNIT 502, 5/F, 210 HING KONG STREET, KOWLOON 870 THE WATSON ROAD, HONG KONG TEL: 23489211-12 FAX: 23489211-886 C/O: NO. 1837-19-8225	
SHEET NO. 4	

右窗圖
現場尺寸
W
H
1250 X 1370

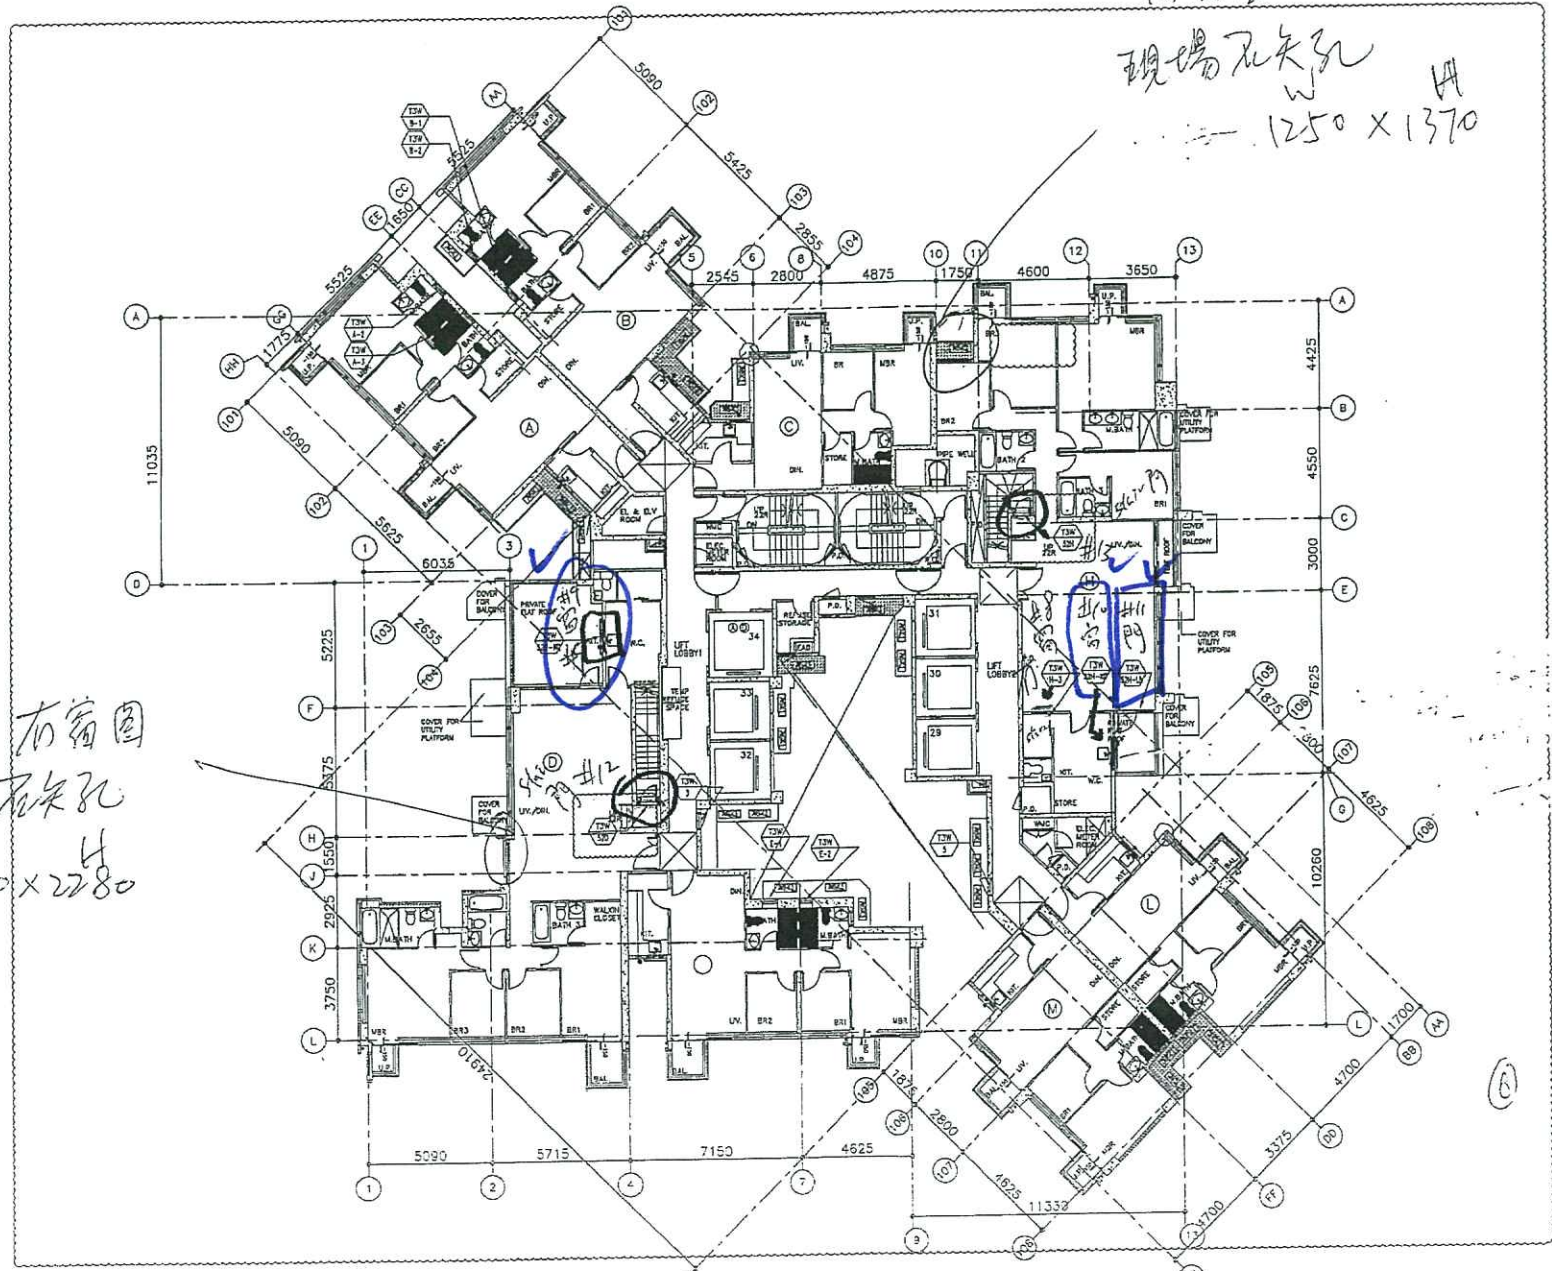

右窗圖
現場尺寸
W
H
1470 X 2280

B.D. REF :

CLIENT :
 Sino Land Company Limited

ARCHITECT :
 WONG TUNG & PARTNERS LIMITED ARCHITECTS & PLANNERS

MAIN CONTRACTOR :
 CR Construction Company Limited

STRUCTURAL ENGINEER :
 AECOM

FACADE CONSULTANT :

NOTE :
 1. ALL DIMENSIONS ARE IN mm.
 2. ALL ELEVATIONS ARE VIEWED FROM OUTSIDE.
 3. ALL DIMENSIONS TO BE VERIFIED ON SITE BEFORE FABRICATION.

LEGEND :
 DETAIL MARK NO.
 REFER SHEET NO.

1. F.F.L. -- FINISHED FLOOR LEVEL
 2. S.F.L. -- STRUCTURAL FLOOR LEVEL
 3. -- REVERSED DETAIL

D	2014-01-16	BY ARCHITECT DRAWING	2x4
C	2014-01-26	BY ARCHITECT DRAWING	2x4
B	2014-01-29	BY ARCHITECT DRAWING	2x4
A	2014-02-13	BY ARCHITECT DRAWING	2x4
NO.	DATE	ISSUED	BY

JOB NO. : J-637

PROJECT :
 URA KWUN TONG TOWN CENTRE REDEVELOPMENT (AREA 2 & 3) AT NKIL 6514, KWUN TONG, KOWLOON

TITLE :
 FULL PLAN LAYOUT (FOR T3 52/F FLOOR PLAN)

DATE : 09-JUL-18 SCALE : 1:200

DRAWN BY : Zeng CHECKED BY : DW



黃騰 銘 實 有 限 公 司
 WONG TUNG & PARTNERS LIMITED ARCHITECTS & PLANNERS
 UNIT 8-9, Sunny Industrial Centre, 1/F
 810 Chee Kwong Road, Kowloon
 Tel: 23482111-4 Fax: 23217727888

DWG NO. : JB37-IW-3303 REV. : D


T3 - 52/F FLOOR PLAN

現場尺寸 750 x 1200


9

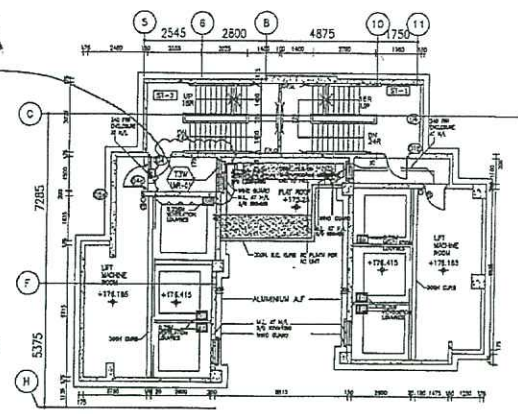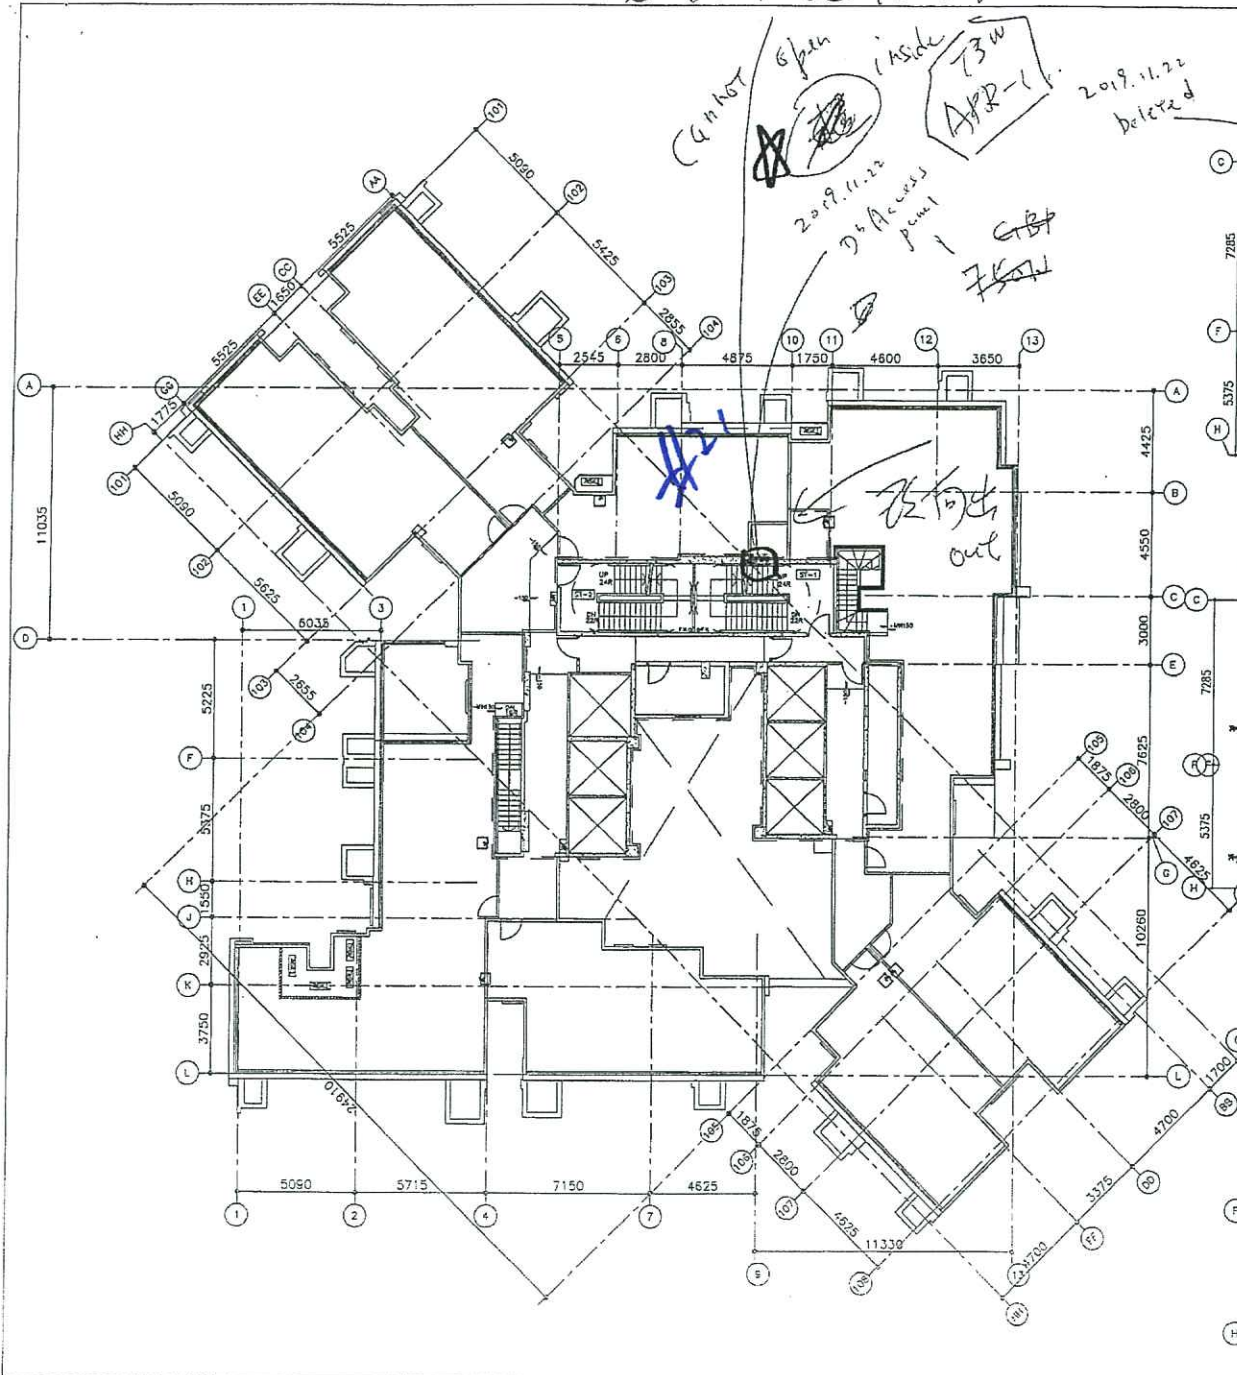

T3 - LIFT MACHINE ROOM PLAN @+176.415

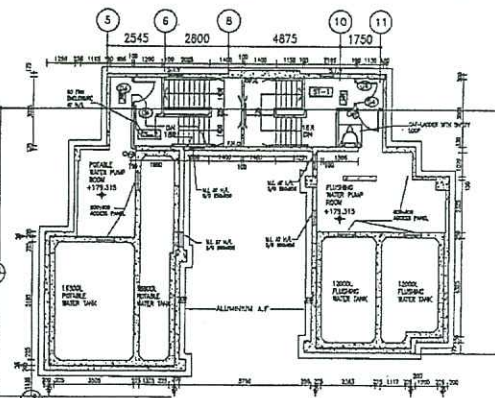

T3 - INTERMEDIATE ROOF @+179.315

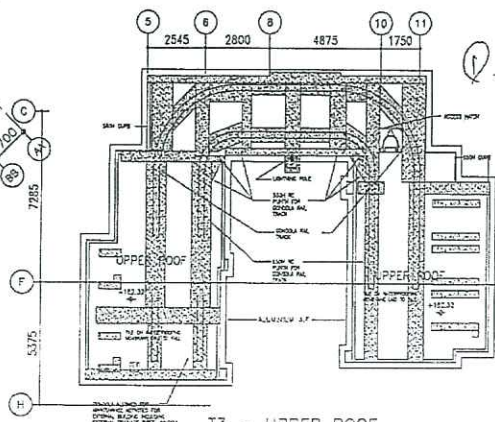

T3 - UPPER ROOF

B.D. REF :

CLIENT : 信和置業有限公司
Sino Land Company Limited

ARCHITECT : WONG YONG & PARTNERS LIMITED
ARCHITECTS & PLANNERS
WT

MAIN CONTRACTOR : CR Construction Company Limited

STRUCTURAL ENGINEER : AECOM

FAÇADE CONSULTANT :

NOTE :

1. ALL DIMENSIONS ARE IN mm.
2. ALL ELEVATIONS ARE VIEWED FROM OUTSIDE.
3. ALL DIMENSIONS TO BE VERIFIED ON SITE BEFORE FABRICATION.

LEGEND :

① DETAIL MARK NO. REFER SHEET NO.

1. F.F.L. — FINISHED FLOOR LEVEL
2. S.F.L. — STRUCTURAL FLOOR LEVEL
3. Ⓜ — REVERSED DETAIL

NO.	DATE	REVISED	BY

JOB NO. : J-B37

PROJECT : URA KWUN TONG TOWN CENTRE REDEVELOPMENT (AREA 2 & 3) AT NKHL 6514, KWUN TONG, KOWLOON


TITLE : FULL PLAN LAYOUT (FOR T3 ROOF PLAN)

DATE : 05-JUL-18 SCALE : 1:200

DRAWN BY : Zeng CHECKED BY : LW


MIDI ALUMINIUM FABRICATOR LTD.
UNIT 6-8, Sunny Industrial Centre, 1/F
610 Chee Koo Ling Road, Kowloon
Tel: 23459211-4 Fax: 234512727655


DWG NO. : J-B37-IW-3304 REV. : —

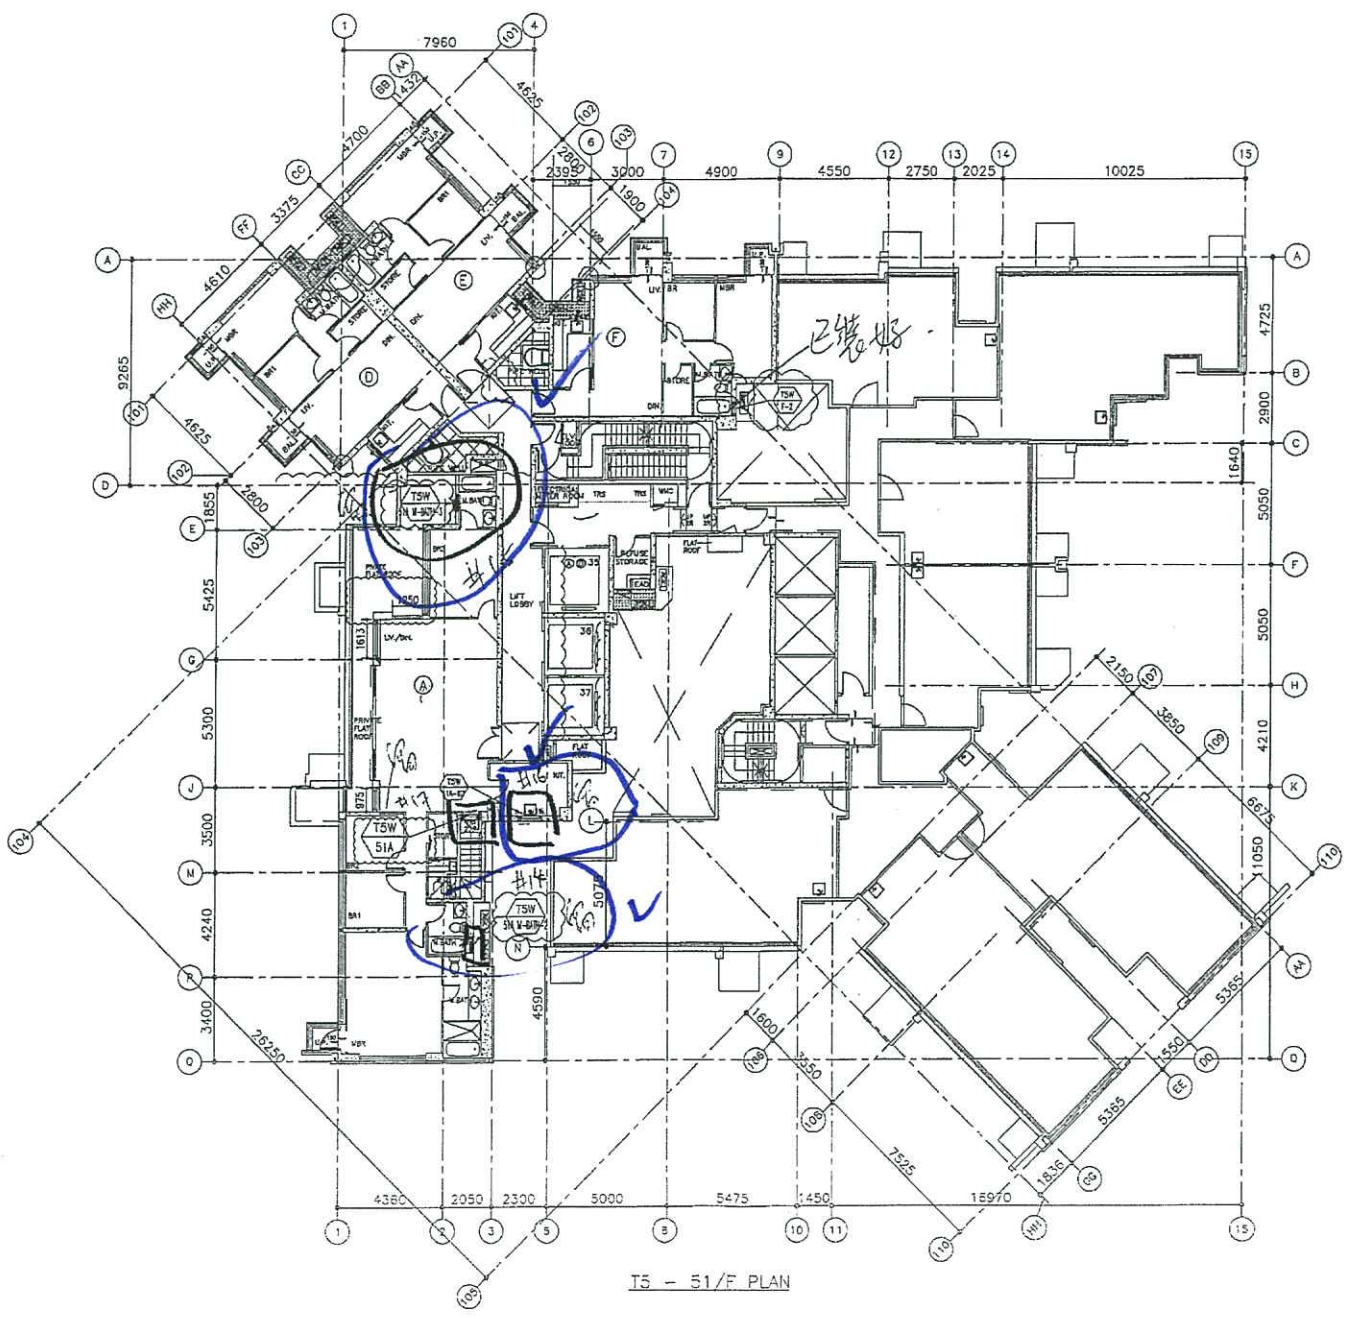



TS - 51/F PLAN

B.D. REF :

CLIENT :
 信和置業有限公司
 Sino Land Company Limited


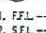
ARCHITECT :
 WONG TUNG & PARTNERS LIMITED
 ARCHITECTS & PLANNERS

MAIN CONTRACTOR :
 CR Construction Company Limited

STRUCTURAL ENGINEER :
 AECOM

FACADE CONSULTANT:

NOTE :
 1. ALL DIMENSIONS ARE IN mm.
 2. ALL ELEVATIONS ARE VIEWED FROM OUTSIDE.
 3. ALL DIMENSIONS TO BE VERIFIED ON SITE BEFORE FABRICATION.

LEGEND :
 — DETAIL MARK NO.
 — REFER SHEET NO.

1. F.F.L. — FINISHED FLOOR LEVEL
 2. S.F.L. — STRUCTURAL FLOOR LEVEL
 3. — REVERSED DETAIL

A	2011-4-25	BY ARCHITECT COMPANY	2011
NO.	DATE	FOR	BY


JOB NO. : J-637

PROJECT :
 URA KWUN TONG TOWN CENTRE
 REDEVELOPMENT (AREA 2 & 3) AT
 NKIL 6514, KWUN TONG, KOWLOON



TITLE :
 FULL PLAN LAYOUT
 (FOR T5 51/F FLOOR PLAN)

DATE : 09-JUL-18 SCALE : 1:200


DRAWN BY : Zeng CHECKED BY : ZW

 美特鋁質有限公司
 MIDI ALUMINIUM FABRICATOR LTD.
 Units 6-8, Suiway Industrial Centre, 1/F
 61C Che Kwo Ling Road, Kowloon
 Tel: 23489211-4 Fax: (852) 2727855

DWG NO. : JS37-IW-3564 REV. : A

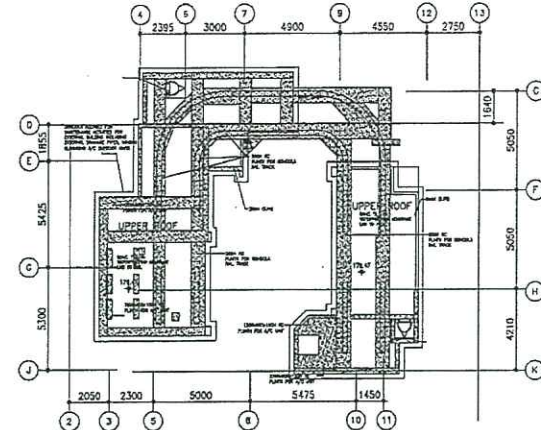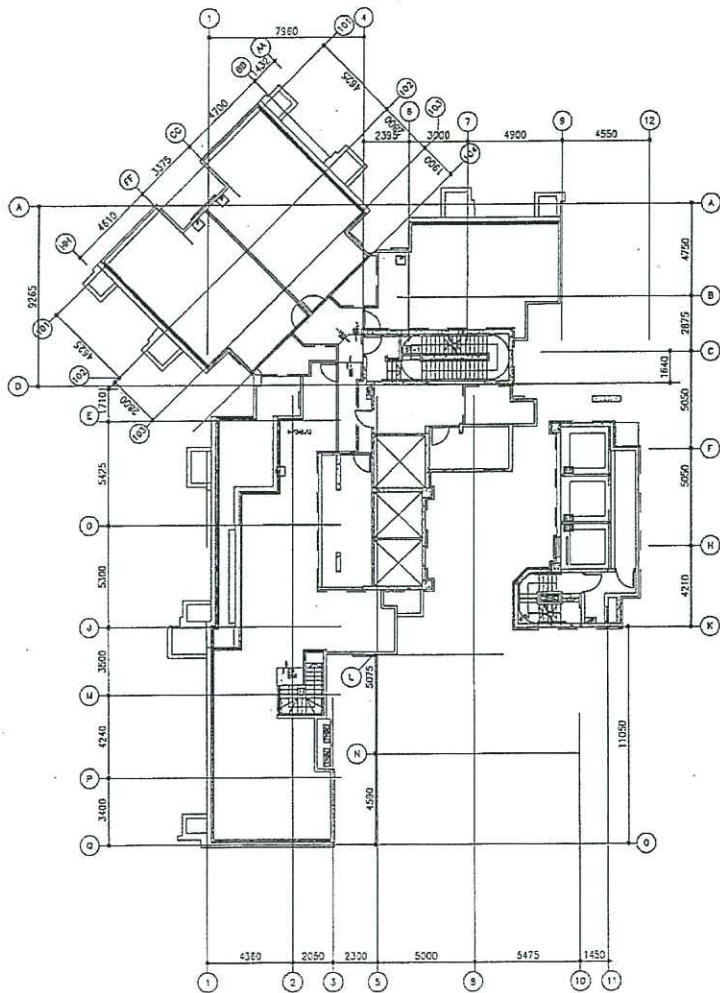

T5 - UPPER ROOF PLAN

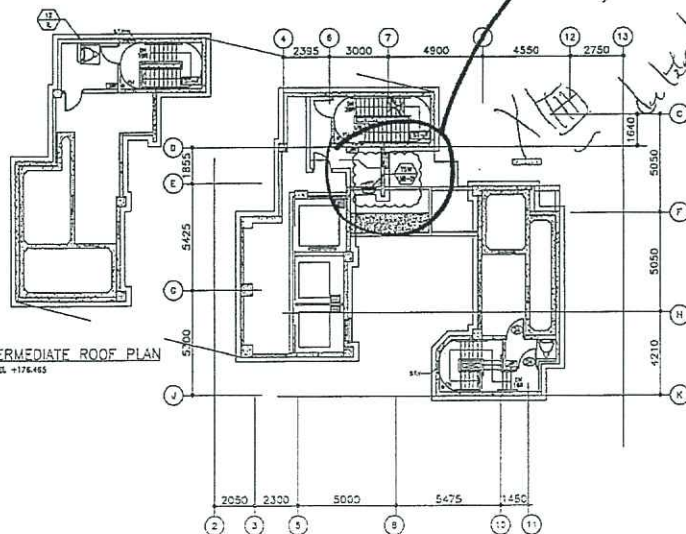

T5 - INTERMEDIATE ROOF PLAN
AT LEVEL +176.465

T5 - LIFT MACHINE ROOM PLAN
AT LEVEL +173.215

B.D. REF :			
CLIENT : 恒和置业有限公司 Sino Land Company Limited			
ARCHITECT : WING TUNG & PARTNERS LIMITED ARCHITECTS & PLANNERS WT			
MAIN CONTRACTOR : CR Construction Company Limited			
STRUCTURAL ENGINEER : AECOM			
FACADE CONSULTANT :			
NOTE : 1. ALL DIMENSIONS ARE IN mm. 2. ALL ELEVATIONS ARE VENED FROM OUTSIDE. 3. ALL DIMENSIONS TO BE VERIFIED ON SITE BEFORE FABRICATION.			
LEGEND : ① --- DETAIL MARK NO. ② --- REFER SHEET NO. 1. F.F.L. --- FINISHED FLOOR LEVEL 2. S.F.L. --- STRUCTURAL FLOOR LEVEL 3. ⑦ --- REVERSED DETAIL			
NO.	DATE	NOISS	BY
JOB NO. :	J-637		
PROJECT : URA KWUN TONG TOWN CENTRE REDEVELOPMENT (AREA 2 & 3) AT NKIL 6514, KWUN TONG, KOWLOON			
TITLE : FULL PLAN LAYOUT (FOR T5 ROOF PLAN)			
DATE :	08-JUL-18	SCALE :	1:200
DRAWN BY : Zeng		CHECKED BY : DW	
恒和置业有限公司 WING TUNG & PARTNERS LIMITED Units 6-8, Sunray Industrial Centre, 7/F 810 Chee Kwo Ling Road, Kowloon Tel: 23492111-4 Fax: (852) 27272868			
DWG NO. :	J637-04-3505	REV. :	-


PROJECT :

URA KWUN TONG TOWN CENTRE
REDEVELOPMENT (AREA 2 & 3) AT NKIL 6514, KWUN TONG, KOWLOON

Uc/39056 /837
3


TITLE : SHOP DRAWING FOR PRECAST WINDOW CHANGES TO IN SITU
FOR TOWER 1 TO TOWER 5

DATE: 23 - JULY - 2019

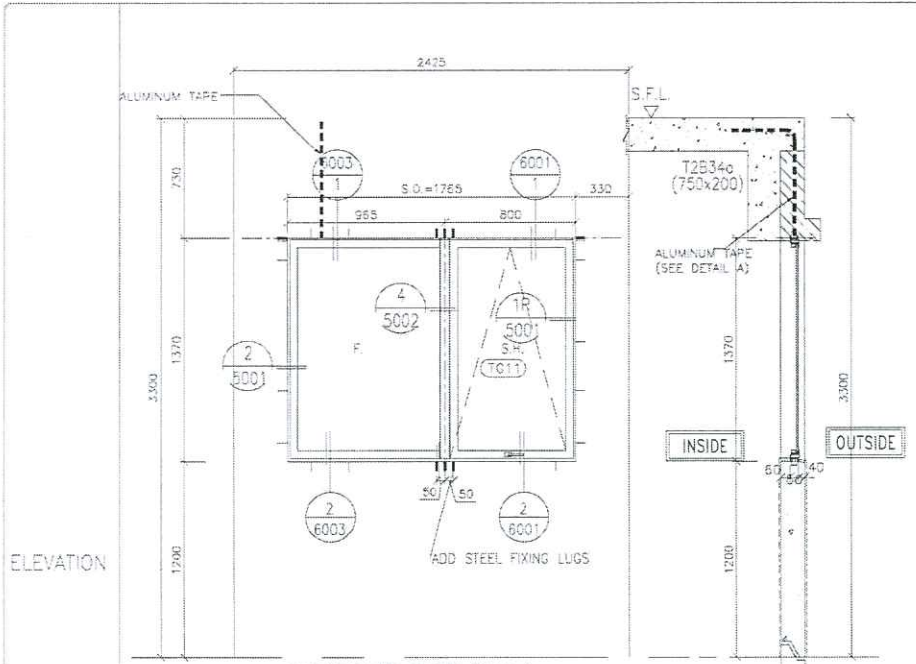

ELEVATION

PRECAST FACADE NO: T2PF-55F-H-5

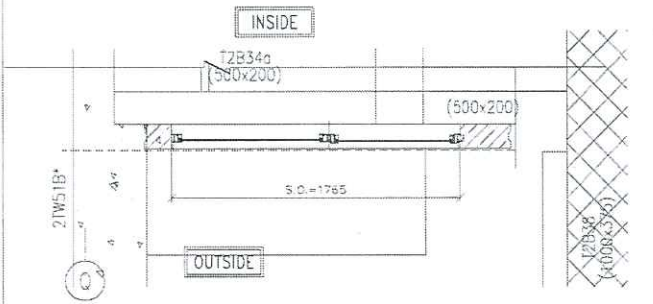


GLAZING AREA	Required = 0.83
	Provided = 1.94
OPENABLE AREA	Required = 0.855
	Provided = 1.35


NEW S.O.	1785(W)*1370(H)
ORIGINAL S.O.	1725(W)*1330(H)

Handwritten note: 大行窗

WINDOW MARK	
SECTION :	50mm ALUM. SECTION
QTY.	1 NOS.
LOCATION :	T2 55/F FLAT G BR3
GLAZING	8mm THK. CLEAR TEMPERED GLASS
REMARK :	

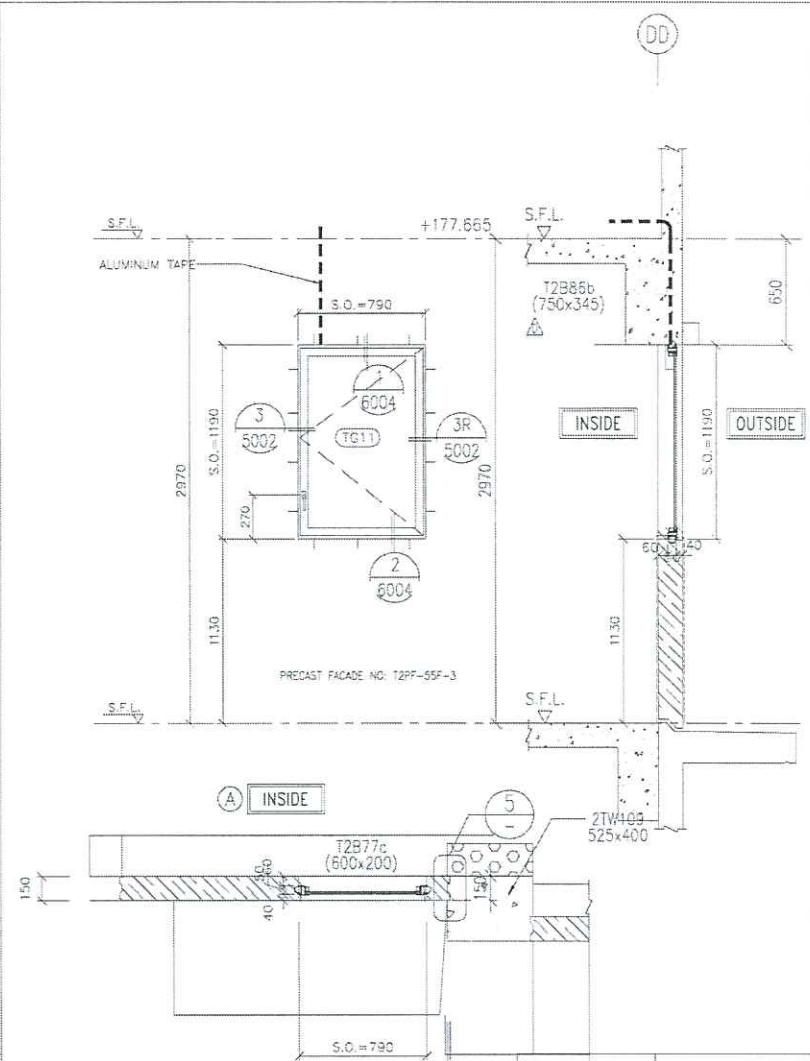

PRECAST FACADE NO: T2PF-55F-3

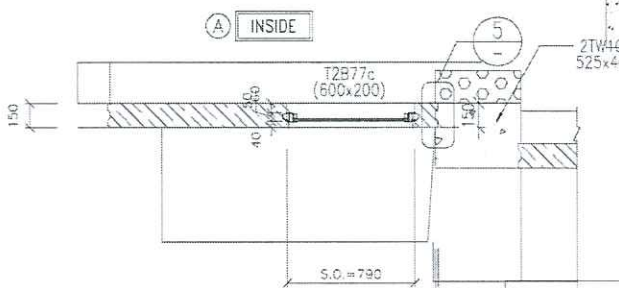

GLAZING AREA	Required = 0.83
	Provided = 1.94
OPENABLE AREA	Required = 0.855
	Provided = 1.35

NEW S.O.	790(W)*1190(H)
ORIGINAL S.O.	750(W)*1150(H)

Handwritten note: 大行窗

WINDOW MARK	
SECTION :	50mm ALUM. SECTION
QTY.	1 NOS. (55F)
LOCATION :	55/F COMMON CORRIDOR (TO BE CONFIRMED)
GLAZING	8mm THK ACID ETCHED FROSTED TEMPERED GLASS
REMARK :	OPENABLE WINDOW

B.D. REF.

CLIENT : 信和置業有限公司
Sino Land Company Limited

ARCHITECT : WONG TUNG & PARTNERS LIMITED
ARCHITECTS & PLANNERS


MAIN CONTRACTOR : CR Construction Company Limited

STRUCTURAL ENGINEER : AECOM


FACADE CONSULTANT :

- NOTE:
1. ALL DIMENSIONS ARE IN mm
 2. ALL ELEVATIONS ARE VIEWED FROM OUTSIDE
 3. ALL DIMENSIONS TO BE VERIFIED ON SITE BEFORE FABRICATION.
- LEGEND:
- (M) - DETAIL MARK NO.
 - (R/S) - REFER SHEET NO.
1. F.F.L. - FINISHED FLOOR LEVEL
 2. S.F.L. - STRUCTURAL FLOOR LEVEL
 3. (R) - REVERSED DETAIL

NO.	DATE	REVISED	BY
JOB NO. :	J-837		
PROJECT :	SURA KWUN TONG TOWN CENTRE REDEVELOPMENT (AREA 2 & 3) AT NKIL 5514, KWUN TONG, KOWLOON		
TITLE :	ALUM. WINDOW SCHEDULE (FOR T2)		
DATE :	30-AUG-18	SCALE :	1:30
DRAWN BY :	Zeng	CHECKED BY :	DW
 MIDI ALUMINIUM FABRICATOR LTD. Units 6-8, Suiyay Industrial Centre, 1/F 816 Che Kwo Ling Road, Kowloon Tel: 23489211-4, Fax: 852127727666			
DWG NO. :	JB37-Prd-2211	REV. :	-

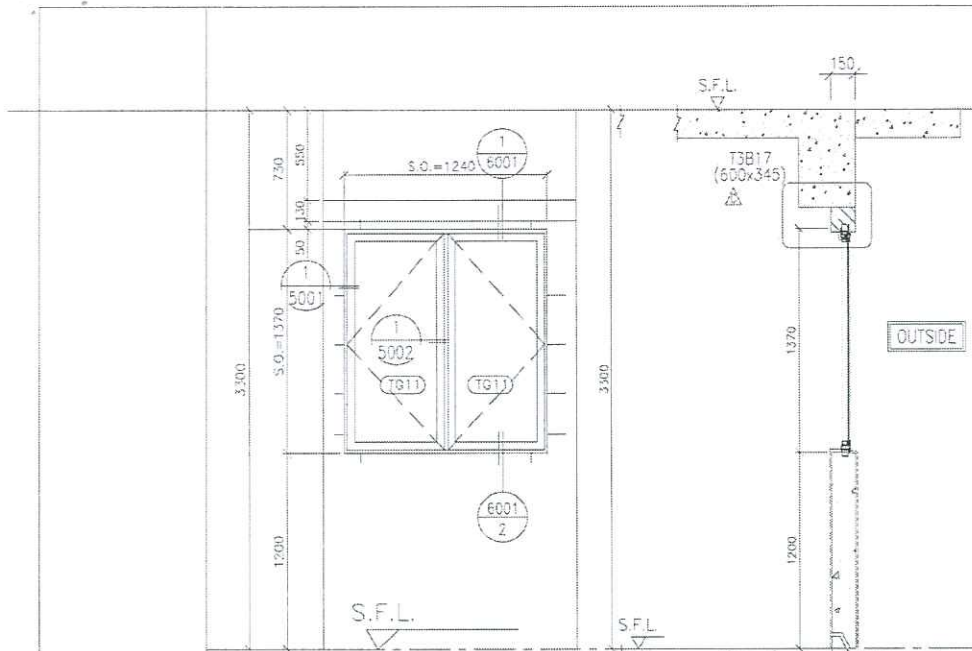


PRECAST FACADE NO:T3PF-52F-H-1

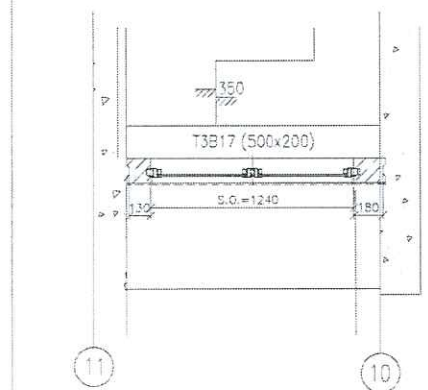


NEW S.O.	1240(W)*1370(H)
ORIGINAL S.O.	1200(W)*1330(H)

GLAZING AREA	Required = 0.616
	Provided = 1.33
OPENABLE AREA	Required = 0.385
	Provided = 1.25

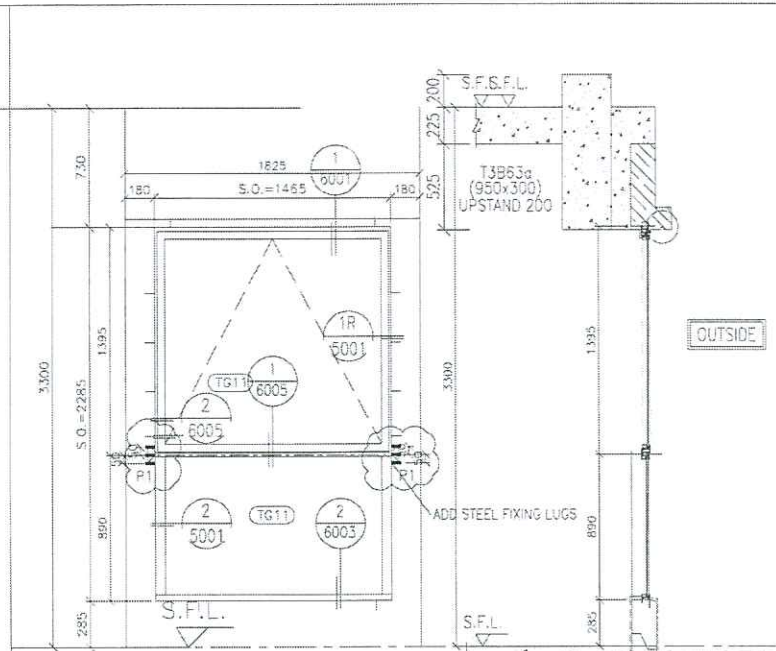

PRECAST FACADE NO:T3PF-52F-F-3

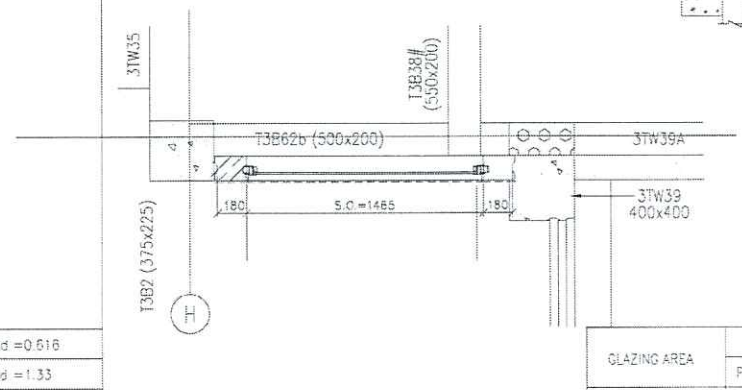

NEW S.O.	1465(W)*2285(H)
ORIGINAL S.O.	1425(W)*2245(H)

GLAZING AREA	Provided = 1.33
	Required = 1.33
OPENABLE AREA	Provided = 1.25
	Required = 1.25

RD. REF :

CLIENT : 信和置業有限公司
Sino Land Company Limited

ARCHITECT : WONG TUNG & PARTNERS LIMITED
ARCHITECTS & PLANNERS

MAIN CONTRACTOR : CR Construction Company Limited

STRUCTURAL ENGINEER : AECOM

FACADE CONSULTANT :

NOTE :

- ALL DIMENSIONS ARE IN mm.
- ALL ELEVATIONS ARE VIEWED FROM OUTSIDE.
- ALL DIMENSIONS TO BE VERIFIED ON SITE BEFORE FABRICATION.

LEGEND :

① - DETAIL MARK NO.
② - REFER SHEET NO.

- F.F.L. - FINISHED FLOOR LEVEL
- S.F.L. - STRUCTURAL FLOOR LEVEL
- ⊗ - REVERSED DETAIL

NO.	DATE	NO/NO	BY

JOB NO. : J-837

PROJECT : URA HWUN TONG TOWN CENTRE REDEVELOPMENT (AREA 2 & 3) AT NKIL 6914, HWUN TONG, KOWLOON

TITLE : ALUM. WINDOW SCHEDULE (FOR T3)

DATE : 30-AUG-18 SCALE : 1:8#


DRAWN BY : Zeng CHECKED BY : DW

MIDI ALUMINIUM FABRICATOR LTD.
Units 6-8, Sunny Industrial Centre, 1/F
910 Chee Kwai Road, Kowloon
Tel: 23489211-4 Fax: (852) 23727666

DWG NO. : J837-PIW-2312 REV. : -

WINDOW MARK	T3W 52F-BR2 ✓
SECTION :	50mm ALUM. SECTION
QTY :	1 NOS.
LOCATION :	T3 52F UNIT H BR2
GLAZING :	8mm THK. CLEAR TEMPERED GLASS
REMARK :	

WINDOW MARK	T3W 52F-D ✓
SECTION :	50mm ALUM. SECTION
QTY :	1 NOS.
LOCATION :	T3 52F UNIT D LIV.
GLAZING :	8mm THK CLEAR TEMPERED GLASS
REMARK :	

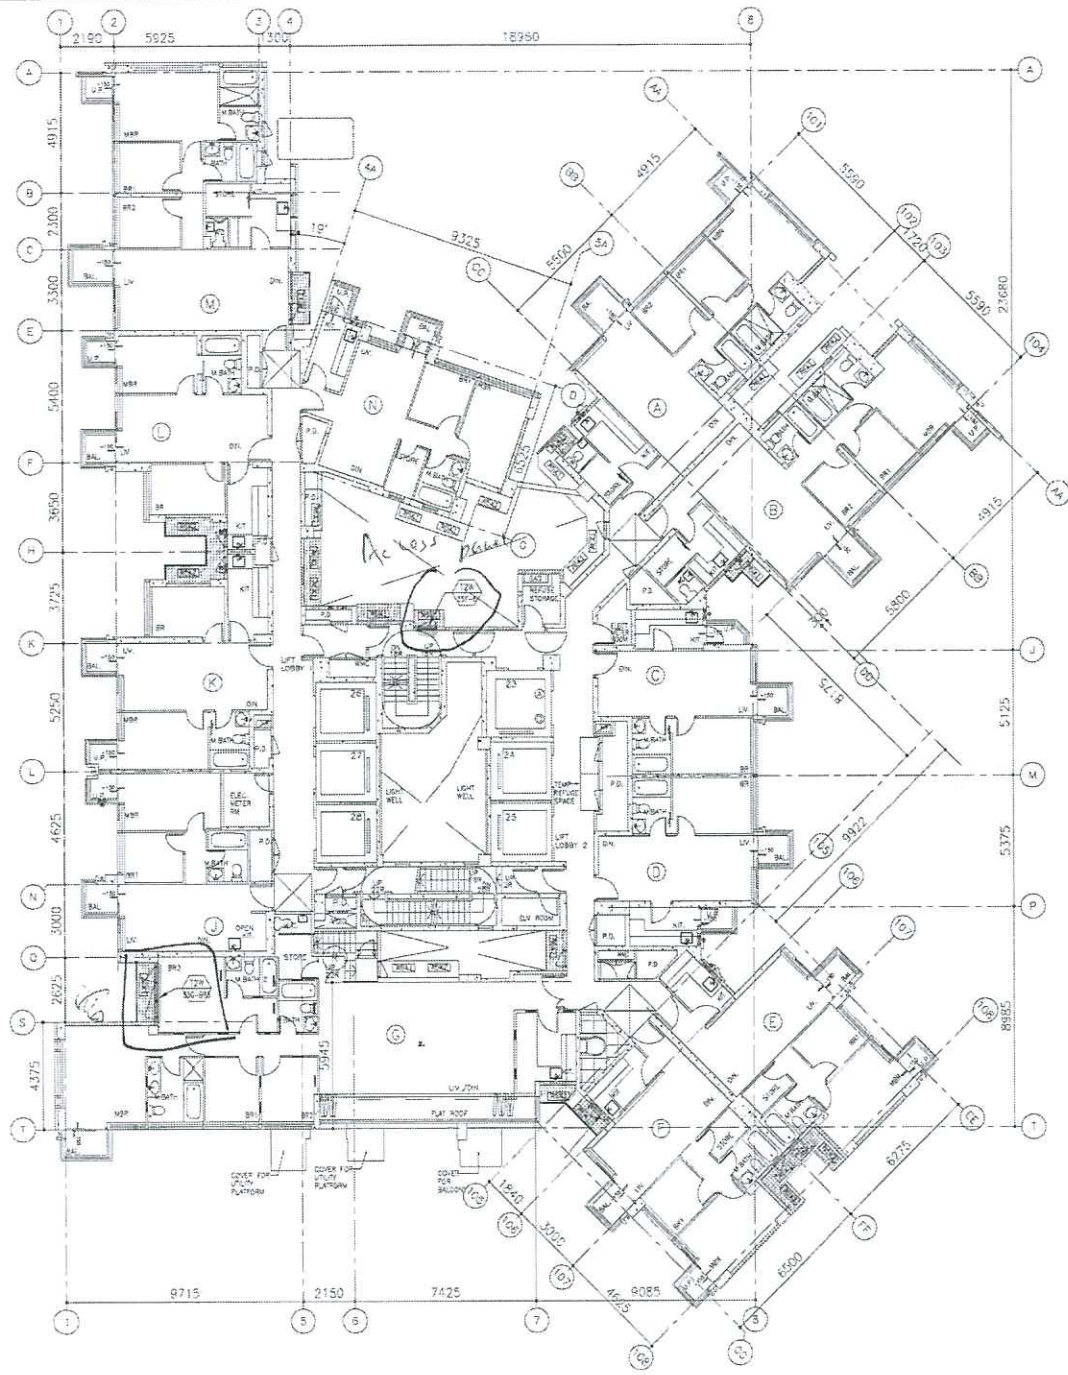

T2 - 55/F FLOOR PLAN









B.O. REF.			
CLIENT: 怡和置業有限公司 Sino Land Company Limited			
ARCHITECT: WONG TUNG & PARTNERS LIMITED ARCHITECTS & PLANNERS			
MAIN CONTRACTOR: CR Construction Company Limited			
STRUCTURAL ENGINEER: AECOM			
FACADE CONSULTANT:			
NOTE: 1. ALL DIMENSIONS ARE IN mm. 2. ALL ELEVATIONS ARE VEKED FROM OUTSIDE. 3. ALL DIMENSIONS TO BE VERIFIED ON SITE BEFORE FABRICATION.			
LEGEND: X1 --- METAL MARK NO. X200 --- REFER SHEET NO. 1. FFL --- FINISHED FLOOR LEVEL 2. S.F.L --- STRUCTURAL FLOOR LEVEL 3. --- REVERSED DETAIL.			
NO.	DATE	REVISION	BY
JOB NO.: J-537			
PROJECT: UFA KWUN TONG TOWN CENTRE REDEVELOPMENT (AREA 2 & 3) AT NWIL BS14, KWUN TONG, KOWLOON			
TITLE: FULL PLAN LAYOUT (FOR T2 55/F FLOOR PLAN)			
DATE: 30-AUG-18	SCALE: 1:##		
DRAWN BY: Zeng	CHECKED BY: DW		
英特鋁質有限公司 Units B-8, Sunray Industrial Centre, 1/F 810 Che Kwo Ling Road, Kwai Tsing Tel: 23482611-4 Fax: (852) 2727698			
DWG NO.: JB37-PIW-3203 REV.:			

72



T3

T3 - 52/F FLOOR PLAN

B.D. REF.			
CLIENT:  信和置業有限公司 Sino Land Company Limited			
ARCHITECT:  WONG TUNG & PARTNERS LIMITED ARCHITECTS & PLANNERS			
MAIN CONTRACTOR:  CR Construction Company Limited			
STRUCTURAL ENGINEER:  AECOM			
FACADE CONSULTANT:			
NOTES: 1. ALL DIMENSIONS ARE IN mm. 2. ALL ELEVATIONS ARE VIEWED FROM OUTSIDE. 3. ALL DIMENSIONS TO BE VERIFIED ON SITE BEFORE FABRICATION.			
LEGEND:  DETAIL MARK NO.  REVERSED SHEET NO. 1. F.F.L. --- FINISHED FLOOR LEVEL 2. S.F.L. --- STRUCTURAL FLOOR LEVEL 3.  --- REVERSED DETAIL			
NO.	DATE	REVISED	BY
JOB NO.: J-537			
PROJECT: URA KWUN TONG TOWN CENTRE REDEVELOPMENT (AREA 2 & 3) AT NKIL 6814, KWUN TONG, KOWLOON			
TITLE: FULL PLAN LAYOUT (FOR T3 52/F FLOOR PLAN)			
DATE: 30-AUG-18		SCALE: 1:##	
DRAWN BY: Zeng		CHECKED BY: DW	
 美特鋁質有限公司 MIDI ALUMINIUM FABRICATOR LTD. Units 5-8, Sunny Industrial Centre, 7/F 610 Ona Kwai Ling Road, Kowloon Tel: 23488211-4 Fax: (852) 27277666			
Dwg No.: J537-PW-3303			REV.: