

工程指示 / 要求簡箋(E.I.)

工程指示編號：EI / 1673 / 20

修改版次：C

工程編號：J - 837

工程名稱：觀塘裕民坊

工程項目：Glass Cladding 後加玻璃面飾線(T1-T5)(大貨)

收件人：生統 / 永林

發件人：Eric Liu

日期：15/05/2020

要求提供 / 確認 事項：

- | | | |
|------------------------------------|-------------------------------------|-------------------------------|
| <input type="checkbox"/> 初步鋁料 B.M. | <input type="checkbox"/> 加工拆圖，然後生產 | <input type="checkbox"/> 尺寸表 |
| <input type="checkbox"/> 正式鋁料 B.M. | <input type="checkbox"/> 技術上資料 / 指示 | <input type="checkbox"/> 報價 |
| <input type="checkbox"/> 配件 B.M. | <input type="checkbox"/> 樣辦或貨品說明書 | <input type="checkbox"/> 分判合約 |
| <input type="checkbox"/> 其他：_____ | | |

內容：

請按加工圖生產飾線送地盤安裝

Glass cladding 後加玻璃面飾線

優先生產三層數量送地盤安裝

C 版: 1) 修改加工圖，飾線在廠加 EI1692 鐵件出貨，用膠黏，留意必須穩固不能鬆脫，以免安裝時因鐵件掉落造成意外

2) T1E 生窗位置不用做此飾線，減少數量

謝謝！

請在 2020 / 05 / 20 前完成上列要求。

25號到地盤首批，10座包裝

附： 1 頁圖登，5 頁加工圖，1 頁位置圖

以上項目為：

- 原合約工程包 原合約工程加 / 減賬 新工程報價

原因：-

分發東莞各部門：

- () 生產技術總監 連附件 () 技術部 連附件 () 永林 連附件 () 生產部 連附件 () 機械設計部 連附件
 () 採購部 連附件 () 生產統籌部 連附件 () 梅 連附件
 () 質檢部 連附件 () 會計部 連附件 () 報關組 連附件 () 其他 楊榮輝 連附件

分發香港各部門：

- () 行政部 連附件 () 會計部 連附件 () 統籌部 連附件 () 工程部地盤科文 連附件 () 其他 連附件
 () 採購部 連附件 () QS 部 連附件 () 維修部 連附件 () 其他 連附件

傳遞編號：

HK0840 / 20

發件人簽署：

項目經理簽署：


圖則登記表 DRAWING REGISTER										
工程名稱 Project Title: 觀塘裕民坊 Glass Cladding T1-T5後加裝飾條					接收日期 Receiving Date (適用於客戶圖則)					
工程編號 Project No: J-837					年					
分發予 Distributed To					月					
					日					
					年	20	20	20		
					月	3	4	4		
					日	30	9	29		
圖則編號 Drg. No.	圖則名稱 Drawing Title	修訂編號 Revision No.								
TB-H900	裝飾條加工圖	1	-	-	A					
TB-H900-1	裝飾條加工圖 (數據表)	2	-	A	B					
TB-L900	裝飾條加工圖	3	-	-	A					
TB-L900-1	裝飾條加工圖 (數據表)	4	-	A	-					
TB-H2250	裝飾條加工圖	5	-	-	A					
TB-H2250-1	裝飾條加工圖 (數據表)	6	-	A	-					
TB-L2250	裝飾條加工圖	7	-	-	A					
TB-L2250-1	裝飾條加工圖 (數據表)	8	-	A	-					
J837-GC-2101	位置圖	9	-	-	A					
J837-GC-2102	位置圖	10	-	-	-					
J837-GC-2201	位置圖	11	-	-	-					
J837-GC-2202	位置圖	12	-	-	-					
J837-GC-2301	位置圖	13	-	-	-					
J837-GC-2501	位置圖	14	-	-	-					
J837-GC-2502	位置圖	15	-	-	-					




美特鋁質有限公司
MIDI Aluminium Fabricator Ltd.

工程號 J-837 | 地盤 | 觀塘裕民坊


數據表參見: TB-H900-1

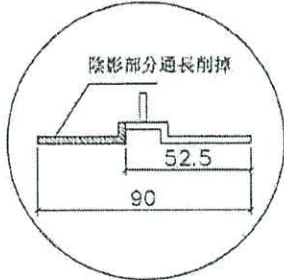



削料示意圖

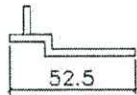

剖圖 B-B

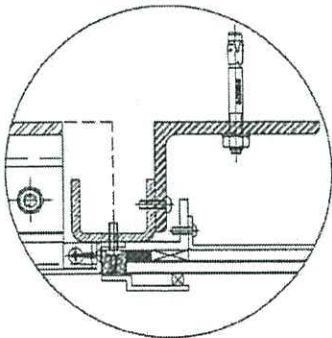

安裝示意

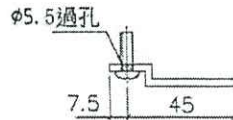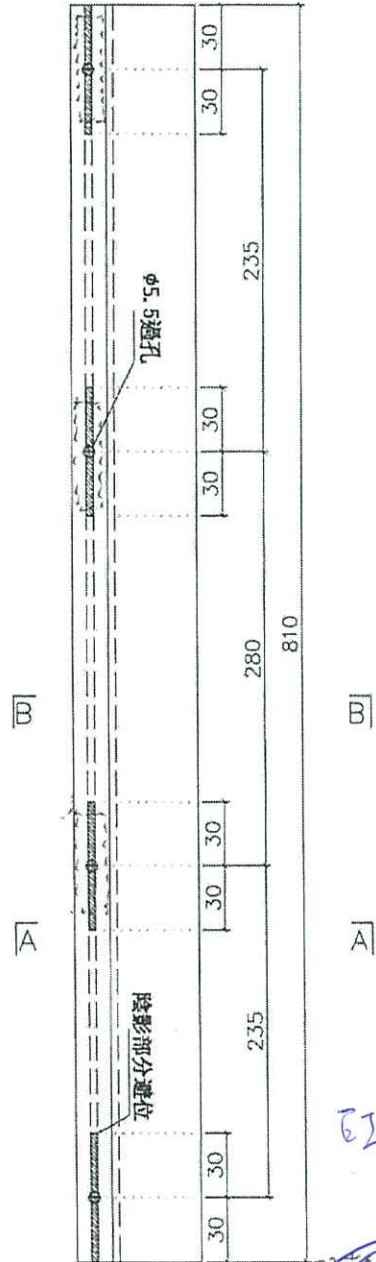

剖圖 A-A

EJ1692

↓
鐵件
12x12
L=50mm
用膠塞密封孔位
牛膠圈

名稱	小單元玻璃企外裝飾蓋	制圖	柯慶余	2020.3.25	修改	A	
材料	X85676	復核	謝永林	2020.3.25	日期	20.5.15	
顏色	EC-DG-S332054 (3塗)	批准	Jason		圖號	TB-H900	



工程號 J-837 | 地盤 觀塘裕民坊

拆圖參見: TB-H900

物料編號	總數量	總樓層	每層 (支)	樓層	位置	分格
TB-H900	156	39	4	7~50F	T1CW -H-1	900
TB-H900	156	39	4	7~50F	T1CW -G-2	900
TB-H900	273	39	7	7~50F	T1CW -E-2	900
TB-H900	156	39	4	7~50F	T1CW -A-1	900
TB-H900	156	39	4	7~50F	T1CW -B-3	900
TB-H900	258	43	6	7~55F	T2CW -H-2	900
TB-H900	172	43	4	7~55F	T2CW -B-1	900
TB-H900	172	43	4	7~55F	T2CW -A-2	900
TB-H900	86	43	2	7~55F	T2CW -M-1	900
TB-H900	86	43	2	7~55F	T2CW -M-2	900
TB-H900	172	43	4	7~55F	T2CW -M-3	900
TB-H900	164	41	4	7~52F	T3CW -B-1	900
TB-H900	164	41	4	7~52F	T3CW -A-2	900
TB-H900	328	41	8	7~52F	T3CW -F-2	900
TB-H900	156	39	4	7~50F	T5CW -M-1	900
TB-H900	156	39	4	7~50F	T5CW -L-2	900
TB-H900	156	39	4	7~50F	T5CW -A-2	900
TB-H900	78	39	2	7~50F	T5CW -A-1	900
TB-H900	312	39	8	7~50F	T5CW -H-3	900
總數	3357					

修改樓層數量


名稱	小單元玻璃企外裝飾蓋	制圖	柯慶余	2020.3.25	修改	A	B	
材料	X85676	復核	謝永林	2020.3.25	日期	2020.4.9	2020.4.29	
顏色	EC-DG-S332054(三塗)	批准	Jason		圖號	TB-H900-1		



美特鋁質有限公司
MIDI Aluminium Fabricator Ltd.

工程號 J-837 | 地盤 | 觀塘裕民坊


數據表參見: TB-L900-1

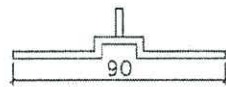

剖圖 B-B


B

A

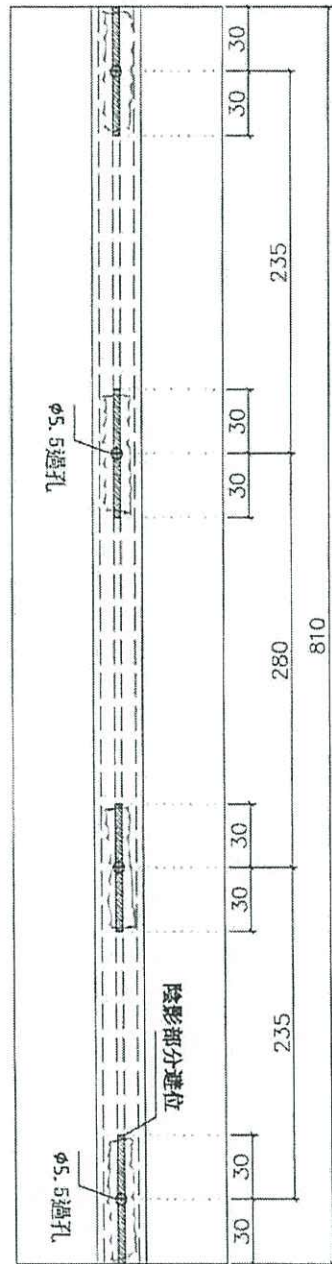


B

A

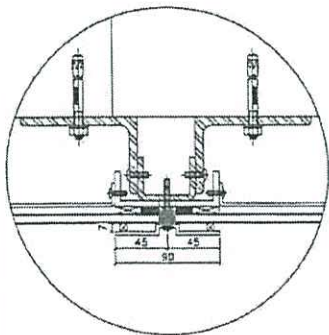

安裝示意

E21692
↓
12x12 鐵件
L=50mm
避位
用膠黏, 膠避開孔位
1x1mm 膠圈

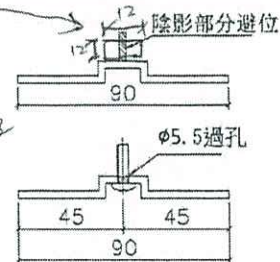

剖圖 A-A

名稱	小單元玻璃企外裝飾蓋	制圖	柯慶余	2020.3.25	修改	A		
材料	X85676	復核	謝永林	2020.3.25	日期	20.5.15		
顏色	EC-DG-S332054 (3種)	批准	Jason		圖號	TB-L900		


EG-DWG3




美特鋁質有限公司
MIDI Aluminium Fabricator Ltd.

工程號 J-837 | 地盤 觀塘裕民坊


數據表參見: TB-H2250-1

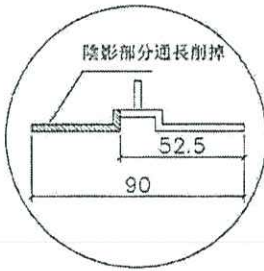



削料示意圖

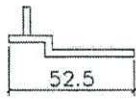

剖圖 B-B

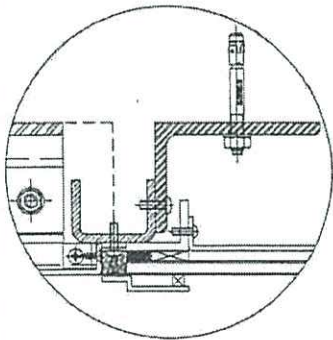


安裝示意

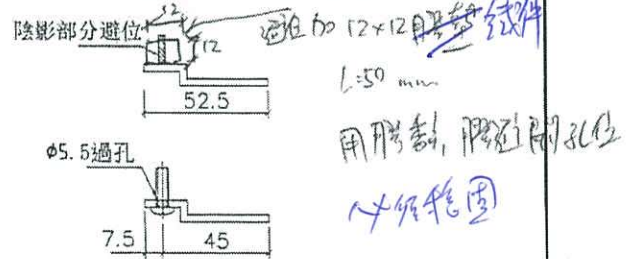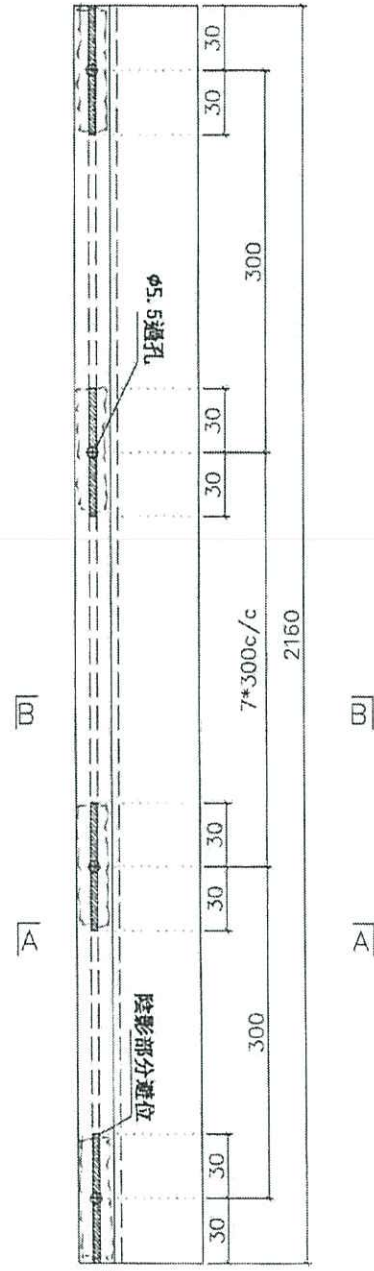

剖圖 A-A

名稱	小單元玻璃企外裝飾蓋	制圖	柯慶余	2020.3.25	修改	A		
材料	X85676	復核	謝永林	2020.3.25	日期	20.5.15		
顏色	EC-DG-S332054 (3塗)	批准	Jason		圖號	TB-H2250		


EG-DWG3

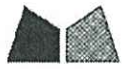


美特鋁質有限公司
MIDI Aluminium Fabricator Ltd.

工程號 J-837 | 地盤 觀塘裕民坊

數據表參見: TB-L2250-1

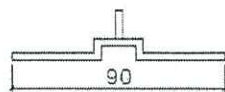


剖圖 B-B

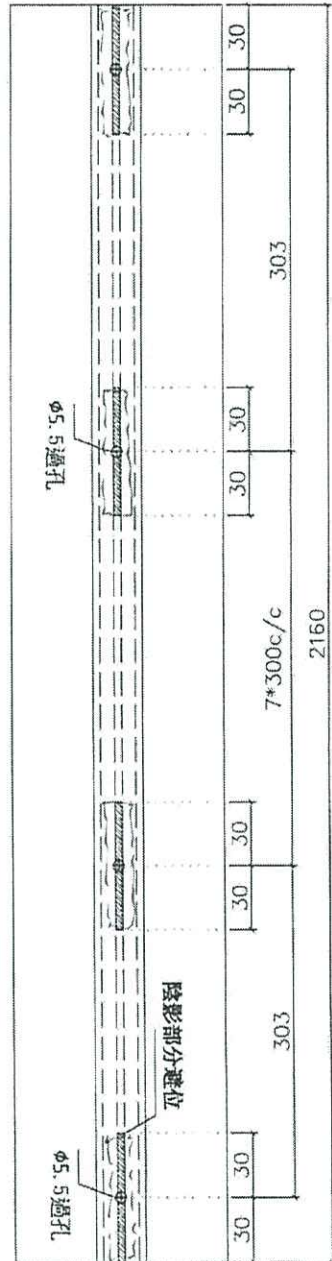


B

A

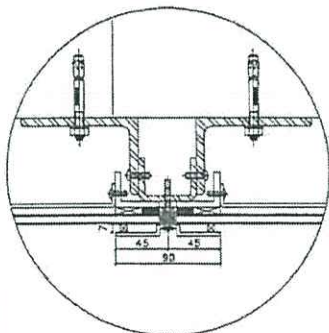


安裝示意

621692
 ↓
 避位位置如
 12x12 膠墊 全鐵粒
 L=50mm
 用膠墊, 膠邊開子位
 中膠墊團

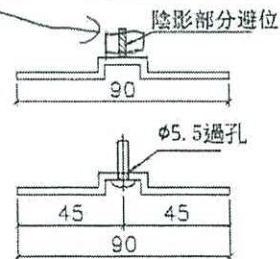

剖圖 A-A

名稱	小單元玻璃企外裝飾蓋	制圖	柯慶余	2020.3.25	修改	A		
材料	X85676	復核	謝永林	2020.3.25	日期	20-3-15		
顏色	EC-DG-S332054 (3#)	批准	Jason		圖號	TB-L2250		

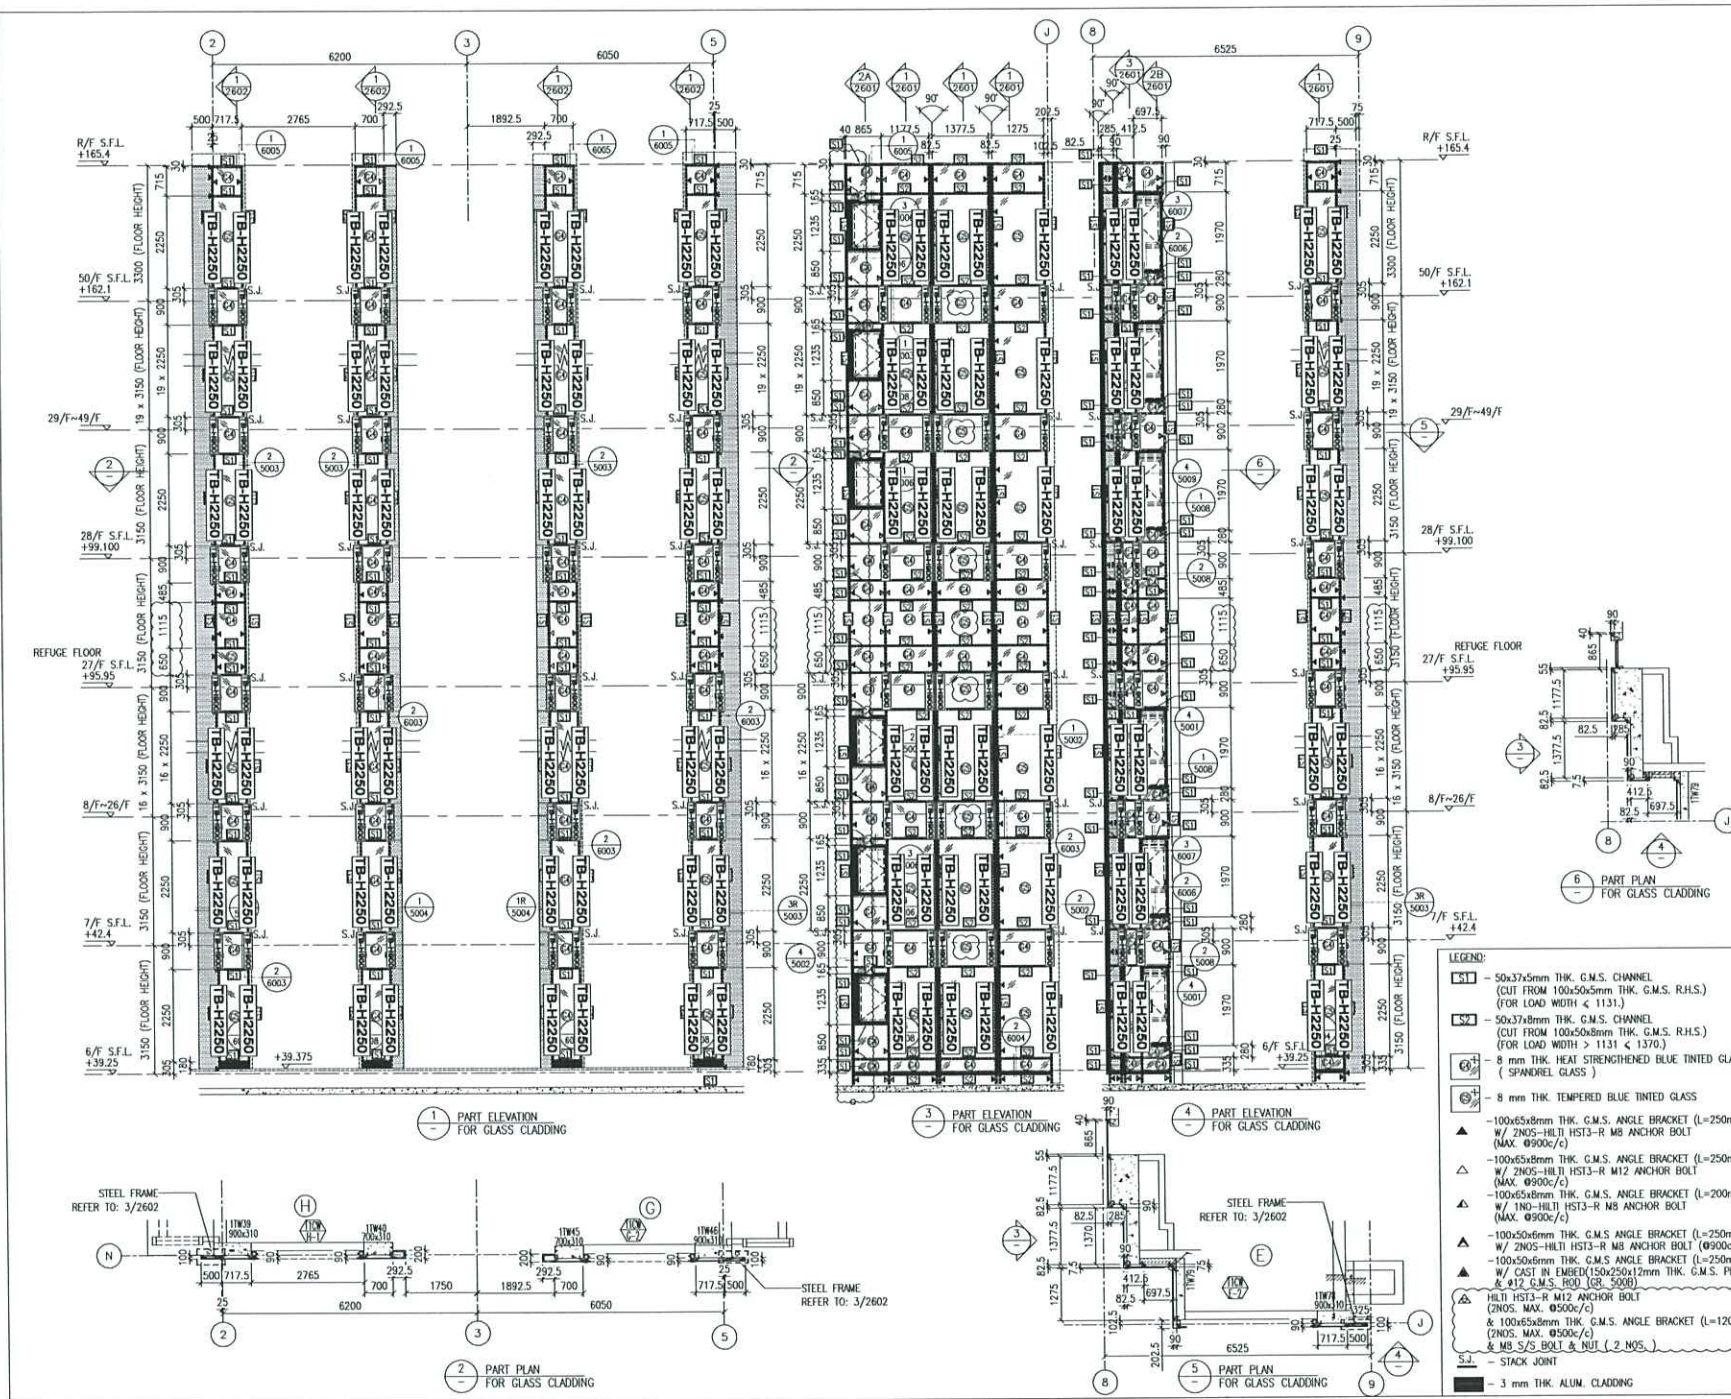

- LEGEND:**
- ST1 - 50x37x5mm THK. G.M.S. CHANNEL (CUT FROM 100x50x5mm THK. G.M.S. R.H.S.) (FOR LOAD WIDTH < 1131)
 - ST2 - 50x37x8mm THK. G.M.S. CHANNEL (CUT FROM 100x50x8mm THK. G.M.S. R.H.S.) (FOR LOAD WIDTH > 1131)
 - 8 mm THK. HEAT STRENGTHENED BLUE TINTED GLASS (SPANDREL GLASS)
 - 8 mm THK. TEMPERED BLUE TINTED GLASS
 - 100x65x8mm THK. G.M.S. ANGLE BRACKET (L=250mm) W/ 2NOS-HLTI HST3-R MB ANCHOR BOLT (MAX. Ø900c/c)
 - 100x65x8mm THK. G.M.S. ANGLE BRACKET (L=250mm) W/ 2NOS-HLTI HST3-R M12 ANCHOR BOLT (MAX. Ø900c/c)
 - 100x65x8mm THK. G.M.S. ANGLE BRACKET (L=200mm) W/ 1NO-HLTI HST3-R MB ANCHOR BOLT (MAX. Ø900c/c)
 - 100x50x6mm THK. G.M.S. ANGLE BRACKET (L=250mm) W/ 2NOS-HLTI HST3-R MB ANCHOR BOLT (Ø900c/c)
 - 100x50x6mm THK. G.M.S. ANGLE BRACKET (L=250mm) W/ CAST IN EMBED (150x250x12mm THK. G.M.S. PLATE & Ø12 G.M.S. ROD (Ø8, 5006))
 - HLTI HST3-R M12 ANCHOR BOLT (2NOS. MAX. Ø500c/c)
 - 8 100x65x8mm THK. G.M.S. ANGLE BRACKET (L=120mm) (2NOS. MAX. Ø850c/c) & M8 S/S BOLT & NUT (2 NOS.)
 - S.S. - STACK JOINT
 - 3 mm THK. ALUM. CLADDING

B.D. REF. :

CLIENT : 信和置業有限公司
Sino Land Company Limited

ARCHITECT : WONG TUNG & PARTNERS LIMITED
ARCHITECTS & PLANNERS

MAIN CONTRACTOR : CR Construction Company Limited

STRUCTURAL ENGINEER : AECOM

FACADE CONSULTANT : AECOM

NOTE :

1. ALL DIMENSIONS ARE IN mm.
2. ALL ELEVATIONS ARE VIEWED FROM OUTSIDE.
3. ALL DIMENSIONS TO BE VERIFIED ON SITE BEFORE FABRICATION.

LEGEND :

- X1 - DETAIL MARK NO.
- X001 - REFER SHEET NO.

1. F.F.L. - FINISHED FLOOR LEVEL
2. S.F.L. - STRUCTURAL FLOOR LEVEL
3. (P) - REVERSED DETAIL

C	NO.	DATE	REVISION	BY
	30/1/2019	GENERAL REVISED		
	17/11/2018	GENERAL REVISED		
	15/10/2018	GENERAL REVISED		

JOB NO. : J-837

PROJECT : URA KWUN TONG TOWN CENTRE REDEVELOPMENT (AREA 2 & 3) AT NKIL 6514, KWUN TONG, KWLOON

TITLE : PART ELEVATION OF GLASS CLADDING AT TOWER 1

DATE : 04-JUL-18 SCALE : 1:60 (A1)

DRAWN BY : ASING CHECKED BY : -

美特鋁質有限公司
MIDI ALUMINIUM FABRICATOR LTD.
Units 6-8, Sunray Industrial Centre, 1/F
610 Che Kwo Ling Road, Kwloon
Tel:23489211-4 Fax:(852)27127666

DWG NO. : JB37-GC-2101 REV. : C