

工程指示 / 要求簡箋(E.I.)

工程指示編號：EI / 2183 / 20

修改版次：-

工程編號：J - 837

工程名稱：觀塘裕民坊

工程項目：幕牆 玻璃(T2,55G 廁所用欄河玻璃)

收件人：Maggie / 生統 / 永林

發件人：Eric Liu

日期：24/07/2020

要求提供 / 確認 事項：

- () 初步鋁料 B.M. () 加工拆圖，然後生產 () 尺寸表
- () 正式鋁料 B.M. () 技術上資料 / 指示 () 報價
- () 配件 B.M. () 樣辦或貨品說明書 () 分判合約
- () 其他：_____

內容：

請按 BM 訂購玻璃送地盤安裝

因 T2,55G 位置，按 BD 要求浴缸至生窗欄河頂需要有 1100mm 高欄河玻璃高度需要加大

謝謝！

請在 2020/07/ 30 前完成上列要求。

附：1 頁 BM，2 頁相，1 頁大圖樣，1 頁位置圖

以上項目為：

- 原合約工程包 原合約工程加 / 減賬 新工程報價

原因：-

分發東莞各部門：

- () 生產技術總監 連附件 () 技術部 連附件 *可* () 生產部 連附件 () 機械設計部 連附件
- () 採購部 連附件 () 生產統籌部 連附件 *均*
- () 質檢部 連附件 () 會計部 連附件 () 報關組 連附件 () 其他 _____ 連附件

分發香港各部門：

- () 行政部 連附件 () 會計部 連附件 () 統籌部 連附件 () 工程部地盤科文 連附件 *大向哥*
- () 採購部 連附件 () QS 部 連附件 () 維修部 連附件 () 其他 _____ 連附件

傳遞編號：


發件人簽署：


HK 1543 /20

項目經理簽署：

 美特鋁質有限公司 MIDI Aluminium Fabricator Ltd.		工程號: J837	計算: 陈俊桦	日期: 2019.7.25	送呈: 胡哥	計算參考數值/所屬位置分格												
地盤名稱: 觀塘裕民坊		核對: 謝永林/利春媚	日期: 2019.8.23	副本:														
地盤用玻璃B.M.表		項目類別: 幕牆/特式層	批准: Jason	A/C Code:														
BM編號:837-CW-M01-S-GP09		修改版次:	總計玻璃面積 (平方米):	0.28														
序號	修改內容	玻璃圖號	顏色與類型	厚度 (mm)	玻璃尺寸		數量 (塊)	總面積 (平方米)	使用位置	單位	樓層	分屬類型	分格1	分格2	分格3	總數	分格高度	每层
					寬度 (W mm)	高度 (H mm)												
1		LH-77	欄河玻璃頂底需精磨邊	10.0	812.5	340.0	1	0.28	T2CWH-1	H	55F	欄河	922.5				340.0	1
2					合計:		1	0.28										
加工注意事項 /玻璃類型描述:		1).本表中之清片玻璃是 信義 原片, 藍片玻璃是藍欣原片																
		2).本表中所有玻璃對角線尺寸偏差要求不超過負2mm。																
		3).本表中玻璃要求粗磨邊處理並倒棱角, 欄河玻璃頂底要精磨邊, 而所有玻璃之入爐方向需保持一致。																
		4).本表中所有玻璃成品均需做雙面保護, 用透明靜電膠紙加四周一寸FK白膠紙做雙面加固保護處理。																
		5).本表中所有玻璃成品均需注明室內外及其玻璃編號/使用位置/樓層, 以便識別。																
		(LH-欄河玻璃)10 mm THK. TEMPERED GLASS (INTERNAL PROTECTIVE BARRIER). (D18061223)																

EG-DWG4

 美特鋁質有限公司 MIDI Aluminium Fabricator Ltd.				類別	物料號		
修改				制圖 陳俊樺	2019.4.20	圖號 LH-G(欄河玻璃)	
日期				復核		數量 見BOM表	
				批准		位置	

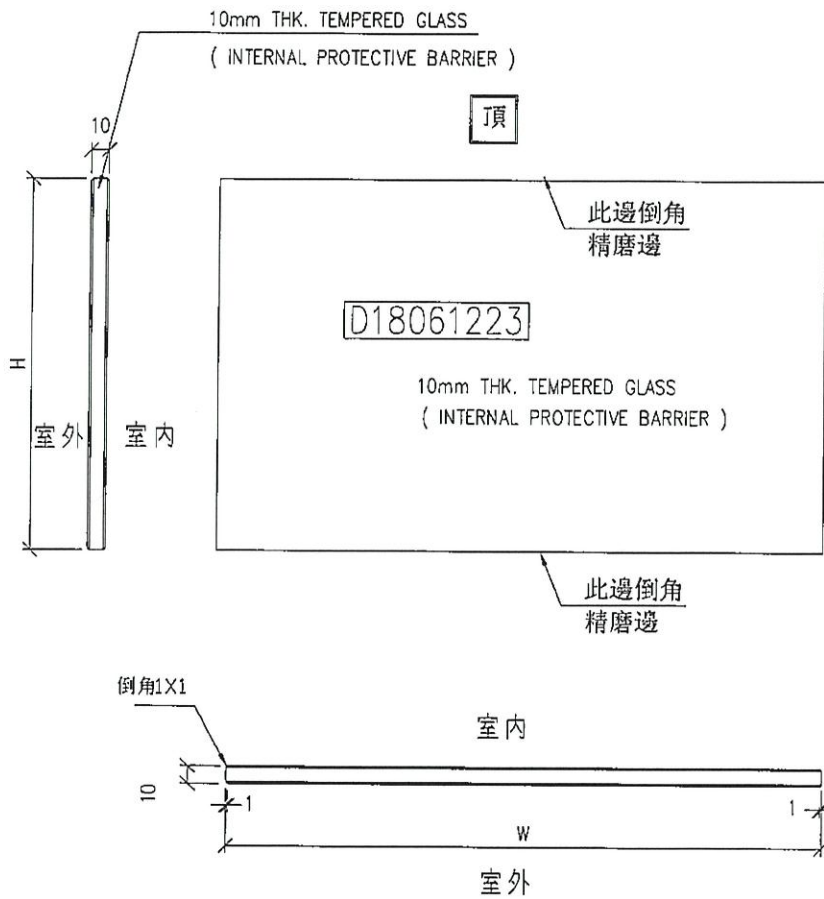

工程號	J-837	地盤	觀塘裕民坊	附 件	<div style="border: 1px solid black; border-radius: 50%; width: 30px; height: 30px; display: flex; align-items: center; justify-content: center;">8</div>
名稱	玻璃加工圖		採用		
材料	10mm THK. TEMPERED GLASS		地盤		
顏色	(INTERNAL PROTECTIVE BARRIER)		工廠		





910-
915

4/6/202
1255G M
BRI



T2 - 55/F FLOOR PLAN

NOTE:
1. ALL CANOPIES TO BE COMPLETED WITH CEMENT SAND RENDERING ON WATERPROOFING MEMBRANE LAID TO FALL.

NOTE:
1. * THE BEAM TO BE LOCATED AT 9/F, 12/F, 17/F, 20/F, 23/F (REFUGE FLOOR), 30/F, 33/F, 37/F, 40/F, 43/F, 47/F, 50/F, 53/F (13 NOS ACCOUNTABLE GFA)
2. ALL BALCONIES TO BE COMPLETED WITH MIN. 1100H A.F.F.L. TEMPERED GLASS RAILING.
3. ALL UTILITIES PLATFORMS TO BE COMPLETED WITH MIN. 1100H A.F.F.L. OPEN TEMPERED GLASS BALUSTRADE
4. ALL EXTERNAL P.D. TO BE ACCESS BY B.M.U. FOR MAINTENANCE.
5. UNLESS OTHERWISE SPECIFIED, ALL DIMENSIONS AND ANNOTATIONS TO BE SIMILAR TO B/A10/16.

B.D. REFERENCE NUMBER:
BD 2/4023/12(Pt II)

NOTES
DO NOT SCALE DRAWING, FIGURED DIMENSIONS ARE TO BE FOLLOWED.
READ THIS DRAWING IN CONNECTION WITH GENERAL ARCHITECTURAL PLANS, STRUCTURAL PLANS, AND OTHER RELATED DRAWINGS. THE ARCHITECT SHALL BE NOTIFIED IMMEDIATELY OF ANY DISCREPANCY FOUND THEREIN.
COPYRIGHT OF THIS DRAWING RESERVED BY ARCHITECT.

- LEGEND :
- SUNKEN SLAB (350mm DEPTH)
 - SUNKEN SLAB (375mm DEPTH)
 - SUNKEN SLAB (250mm DEPTH)
 - SUNKEN SLAB (50mm DEPTH)
 - FLUE APERTURE TO BE PROVIDED ACCORDINGLY.
 - PRECAST FACADE (P.F.)

NO.	DATE	REVISIONS	DESIGNED	CHECKED	DRAWN	SCALE
06	05/20	GBP AMENDMENT				
05	08/19	GBP AMENDMENT				
04	05/19	GBP AMENDMENT				
03	10/18	GBP AMENDMENT				
02	04/18	GBP AMENDMENT				
01	01/18	GBP AMENDMENT				
00	09/17	GBP AMENDMENT				



WONG TUNG & PARTNERS LIMITED
ARCHITECTS & PLANNERS
18th Floor, Cityplaza 3, Taikoo Shing, Hong Kong
T 852-2803 9888 F 852-2513 1728 www.wongtung.com

PROJECT:
URA KWUN TONG TOWN
CENTRE REDEVELOPMENT
(AREA 2 & 3) AT
NKIL 6514,
KWUN TONG, KOWLOON

TITLE:
T2
55/F FLOOR PLAN

DATE	SCALE
10/2015	1:100
DRAFTED (HPC)	CHECKED (ELC)
DESIGNED (HPC)	REVIEWED (ST)
JOB NO. 31690	DRAWING NO. B/A10/16A
	REV. NO. (06)

AMENDED PLAN

The works shown on these plans are typical works (Building Works) in respect of which consent is applied for the purpose of 'Year Track consent' application under regulation 33 of the Building (Administration) Regulations.

