



工程指示 / 要求簡箋(E.I.)

工程指示編號：EI / 3026 / 21

修改版次：-

工程編號：J - 837

工程名稱：觀塘裕民坊

工程項目：窗仔 T5N-40F 廚房窗(補)(WI)

收件人：生統

發件人：Eric Liu

日期：29/01/2021

要求提供 / 確認 事項：

- | | | |
|------------------------------------|-------------------------------------|-------------------------------|
| <input type="checkbox"/> 初步鋁料 B.M. | <input type="checkbox"/> 加工拆圖，然後生產 | <input type="checkbox"/> 尺寸表 |
| <input type="checkbox"/> 正式鋁料 B.M. | <input type="checkbox"/> 技術上資料 / 指示 | <input type="checkbox"/> 報價 |
| <input type="checkbox"/> 配件 B.M. | <input type="checkbox"/> 樣辦或貨品說明書 | <input type="checkbox"/> 分判合約 |
| <input type="checkbox"/> 其他：_____ | | |

內容：

請按加工圖生產鋁窗送地盤安裝用 (現場覆尺套框安裝)

現場平水不付，需補窗現場更換，已有 WI 15775 (見附件)

謝謝

請在 2021/ 2 / 5 前完成上列要求。

附：頁

以上項目為：

- 原合約工程包 原合約工程加 / 減賬 新工程報價

分發東莞各部門：

- () 生產技術總監 連附件 () 技術部 連附件 () 生產部 連附件 () 機械設計部 連附件
 () 採購部 連附件 (✓) 生產統籌部 連附件 *楊* ✓
 () 質檢部 連附件 () 會計部 連附件 () 報關組 連附件 () 其他 楊榮輝 連附件

分發香港各部門：

- () 行政部 連附件 () 會計部 連附件 () 統籌部 連附件 () 工程部地盤科文 連附件 *楊*
 (✓) 採購部 連附件 () QS 部 連附件 () 維修部 連附件 () 其他 _____ 連附件

傳遞編號：

HK 0244 / 21

發件人簽署：
Eric Liu


項目經理簽署：
ppz



美特鋁質 有限公司
MIDI Aluminium Fabricator Ltd.


工程號 J837 地盤 觀塘裕民坊

W	數量	使用位置
560	6	T1W-E-1
560	10	T5W-H-4
560	6	T3W-F-3
合計	共22幅	

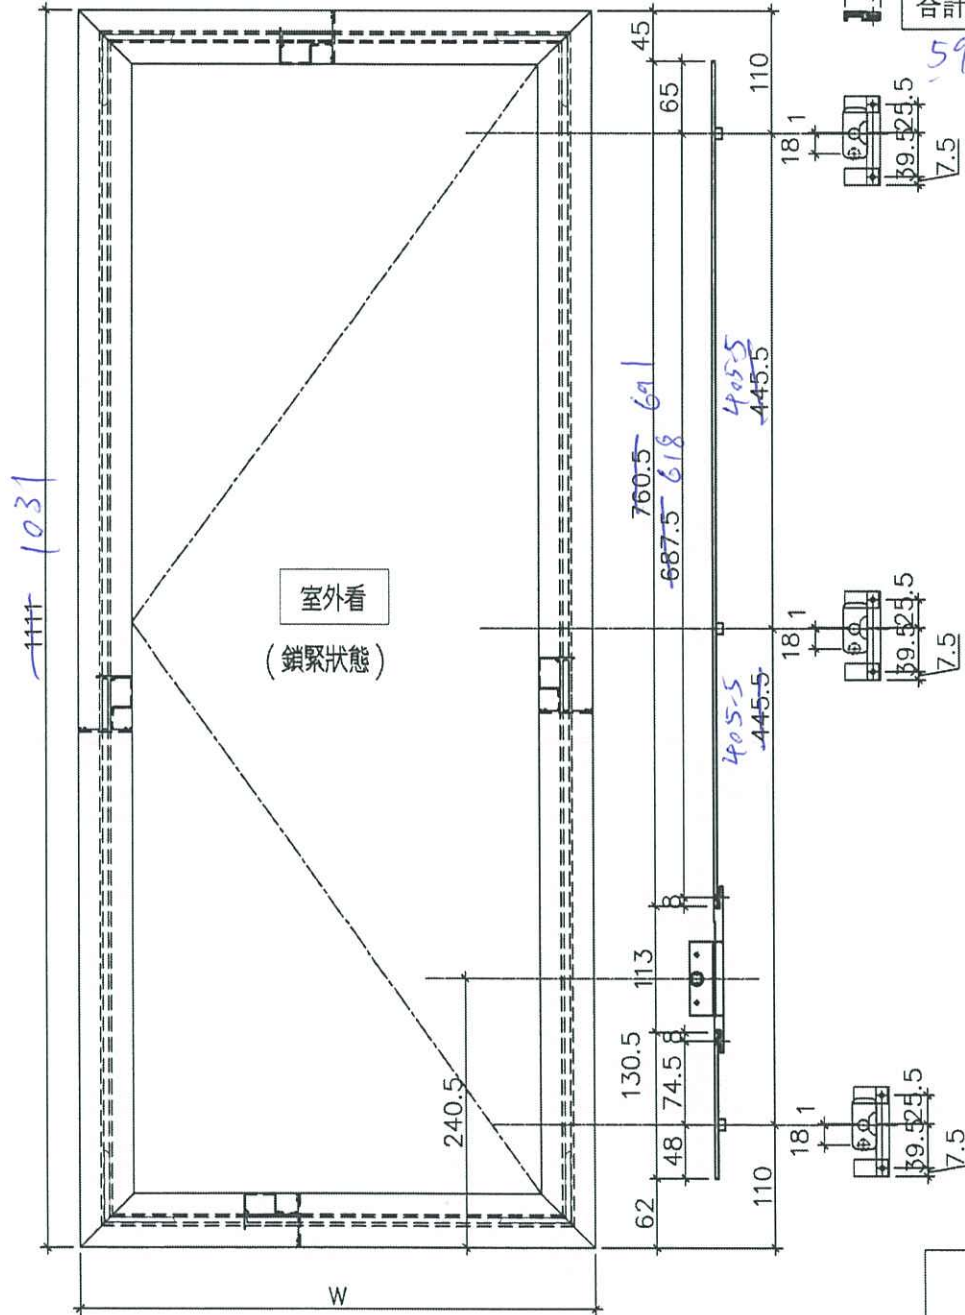


598 1 T5W-N-3

多點鎖壓板示意圖

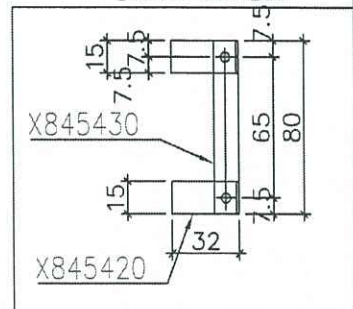

名稱	多點鎖放樣圖	制圖	鞠章芳	2018.10.22	修改		
材料	14*3鋁/X845420/X845430	復核	謝永林	2018.10.25	日期		
顏色	EC-DG-S332054 (3塗)	批准			圖號	837-FYA2	

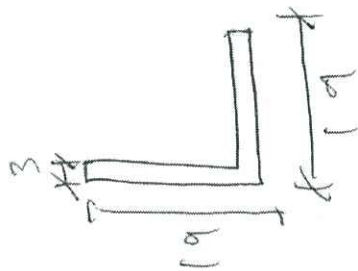



$L = 1800 \text{ mm}$

4支

Material

規格: ~~T5-48F PW-01~~
T5-40N PW-01

前料表

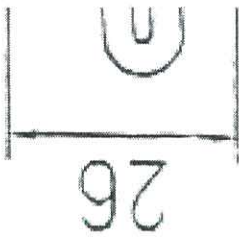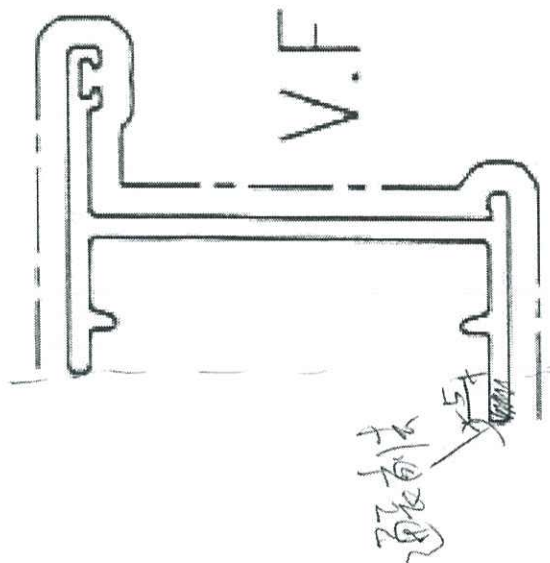

模號: X846370

名稱: 生邊企

合金狀態: 6063-T5

重量: 0.733KG/M

V.F.: 144




模號:

名稱:

合金狀態:

重量:

V.F.:

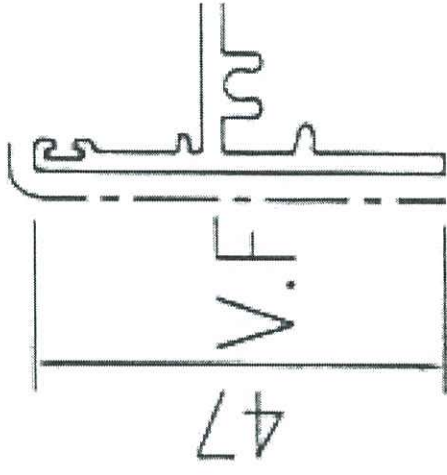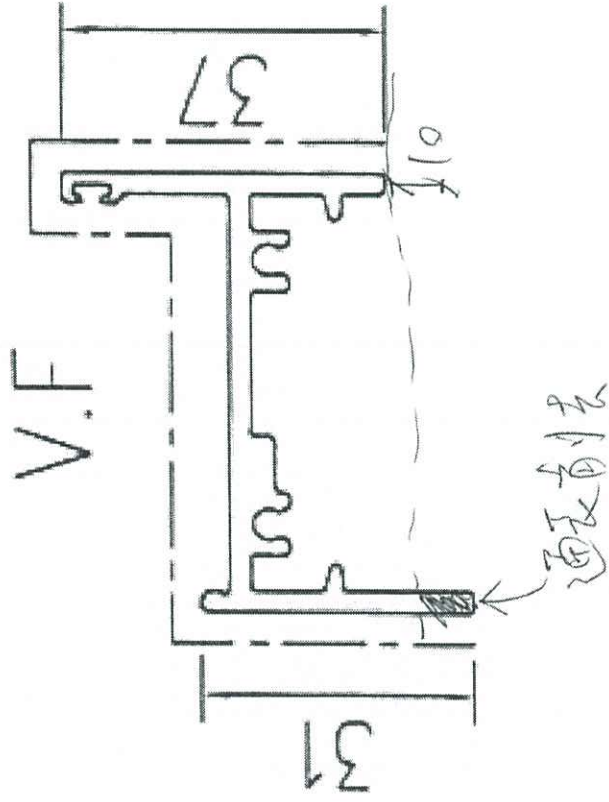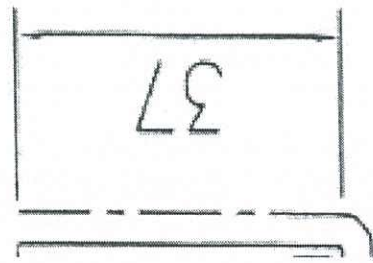

生窗/百葉)

模號: X846400 /

名稱: 生底橫

合金狀態: 6063-T5


重量: 0.022 kg/m

模號:)

名稱:)


合金狀態: (

重量:)

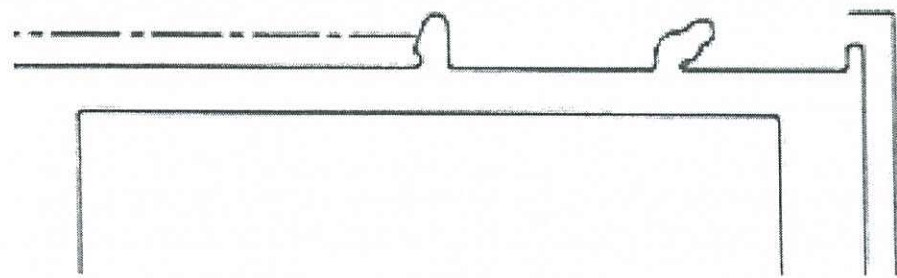



X848890 ✓

上海

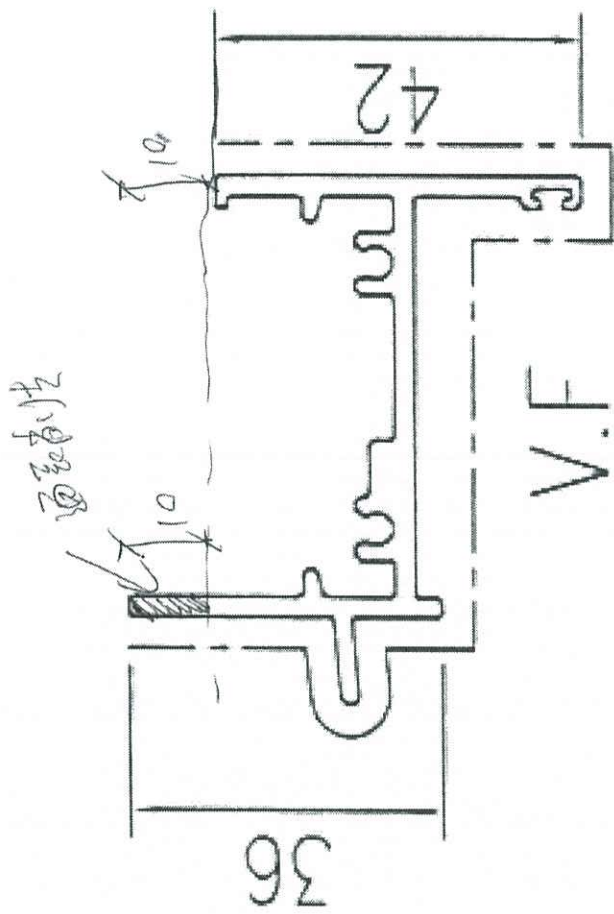

模號: X846010

上海

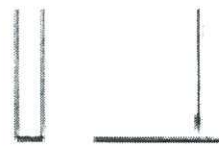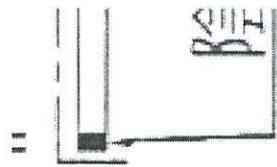

模號:]

夕環:]

工程 Superstructure Main Contract (Tower)
for the Proposed Composite Development at N.K.I.L. 6514
Project: Kwun Tong Town Centre (Development Areas 2 & 3)

分判商工作指令
Work Instruction to Sub-Contractor



華營建築有限公司
CR CONSTRUCTION COMPANY LIMITED

致 To: 美特
工地 Project: SHW

日期 Date: 21/01/2021
編號 Ref: SHW/3.10/WI15775

現指示貴公司須組織所需資源按時進行及完成下列工程。
You are instructed to provide the necessary resource(s) to execute and complete the following works:

- 包工料 Labour, and Material 淨工、機械及工具 Labour, equipment, and tools
 淨料 Material only 淨機械 Plant only 其他 Others: _____

工程概要

Subject: T5 40/F N單位 廚房佛沙窗改正窗框

工程內容及位置

Works Description and Location T5 需貴判派遣人手到場40/F N單位 廚房因佛沙窗平水不對固需改正窗框

- 附件 Attachment: 圖則 Drawing (s): _____
 業主/財師指示 ERU/AI: _____
 其他文件 Others: 照片及位置圖

附註 Remarks:

預計開工日期
Tentative start date: _____

地盤總管/施工經理 Site Agent / Construction Manager
日期 Date: _____

預計完工日期
Tentative finish date: _____

項目經理 Project Manager
日期 Date: _____

附註 Remarks: 以上指引只作一般施工記錄，不構成本公司對該指引之工程費用或支出承擔任何責任。
This instruction shall be treated as an instruction record to proceed with the Works, and will not be taken as a confirmation for payment.
如有報價、加減工程及合約索償，分判商需於兩星期內呈交有關資料給合約部以便按合約條款處理。
Any quotation, variation, or monetary claim generated by this instruction, the sub-contractor shall submit to Contract Department with release supporting information within two weeks for processing in accordance with sub-contract provisions.

內部文件 For internal use only

此部份由工程部署報 This section to be completed by Works Department

工作原因
Cause of work _____

- 責任 Responsibility 業主 Employer 總承判商 Main Contractor 分判商 S/C
 指定分判商 NSC 其他 Others

指示發起人
Instruction Initiator SO CHUN KI
日期 Date: 21/01/2021

此部份由合約部署報 This section to be completed by Contracts Department

合約

總承建合約
Main Contract
原總承建合約工程包
Included in Main Contract
 總承建合約加減工程
Main Contract's variation
合約索償
Contract claim

分判合約
Sub-contract
戰工
Day works
原分判合約工程包
Sub-contract Works
 原分判合約加減工程/質量質度
SUB-CONTRACTOR'S
variation claim from subcontractor

其他
Others
應扣其他分判商(請註明)
Contra charge to others: _____
新工程/廢工，請於兩星期內呈交報
New/Abortive Works, please quote within
 指定分判商
Named Sub-contractor/NSC

21/1/21


15-40N 廚房

3x19x19 鋁角

1米4支

櫃要四邊去腳

櫃連玉及玻璃

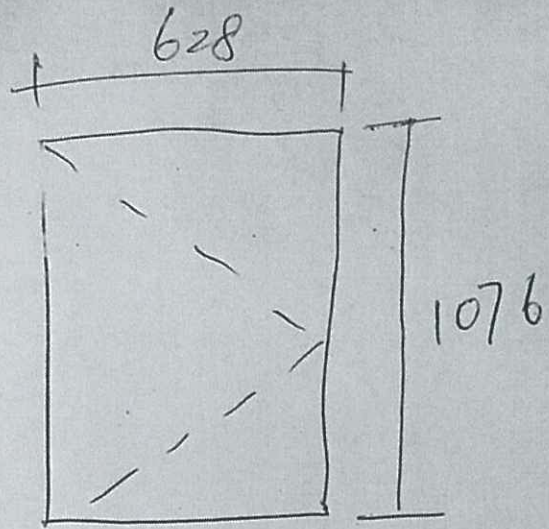

室內看