

工程指示 / 要求簡箋(E.I.)

工程指示編號：EI / 9487 / 18

修改版次：B

工程編號：J - 837

工程名稱：觀塘裕民坊

工程項目：佛沙窗 - 修改拆圖

收件人：生統 / 永林

發件人：Bessie

日期：29/10/2018

要求提供 / 確認 事項：

- () 初步鋁料 B.M. () 加工拆圖，然後生產 () 尺寸表
- () 正式鋁料 B.M. () 技術上資料 / 指示 () 報價
- () 配件 B.M. () 樣辦或貨品說明書 () 分判合約
- () 其他：_____

內容：

佛沙窗 T1W/E-2 的 SO 有變 (根據 wong036 及 SI041)，現附上更新之施工圖 J837-PW-2104，煩請先提供更新之第一批及第二批佛沙窗大貨拆圖

附 PDF 及 CAD 檔 (PW-2104 copy from 3rd submission.dwg)

請在 30/10/18 前完成上列要求。

附： 頁

以上項目為：

- 原合約工程包 原合約工程加 / 減賬 新工程報價

原因：-

分發東莞各部門：

- () 生產技術總監 連附件 (/) 技術部 連附件 () 生產部 連附件 () 機械設計部 連附件
- () 採購部 連附件 (/) 生產統籌部 連附件
- () 質檢部 連附件 () 會計部 連附件 () 報關組 連附件 () 其他 _____ 連附件

分發香港各部門：


- () 行政部 連附件 () 會計部 連附件 () 統籌部 連附件 () 工程部地盤科文 連附件
- () 採購部 連附件 () QS 部 連附件 () 維修部 連附件 () 其他 _____ 連附件

傳遞編號：

發件人簽署：

項目經理簽署：

ELEVATION

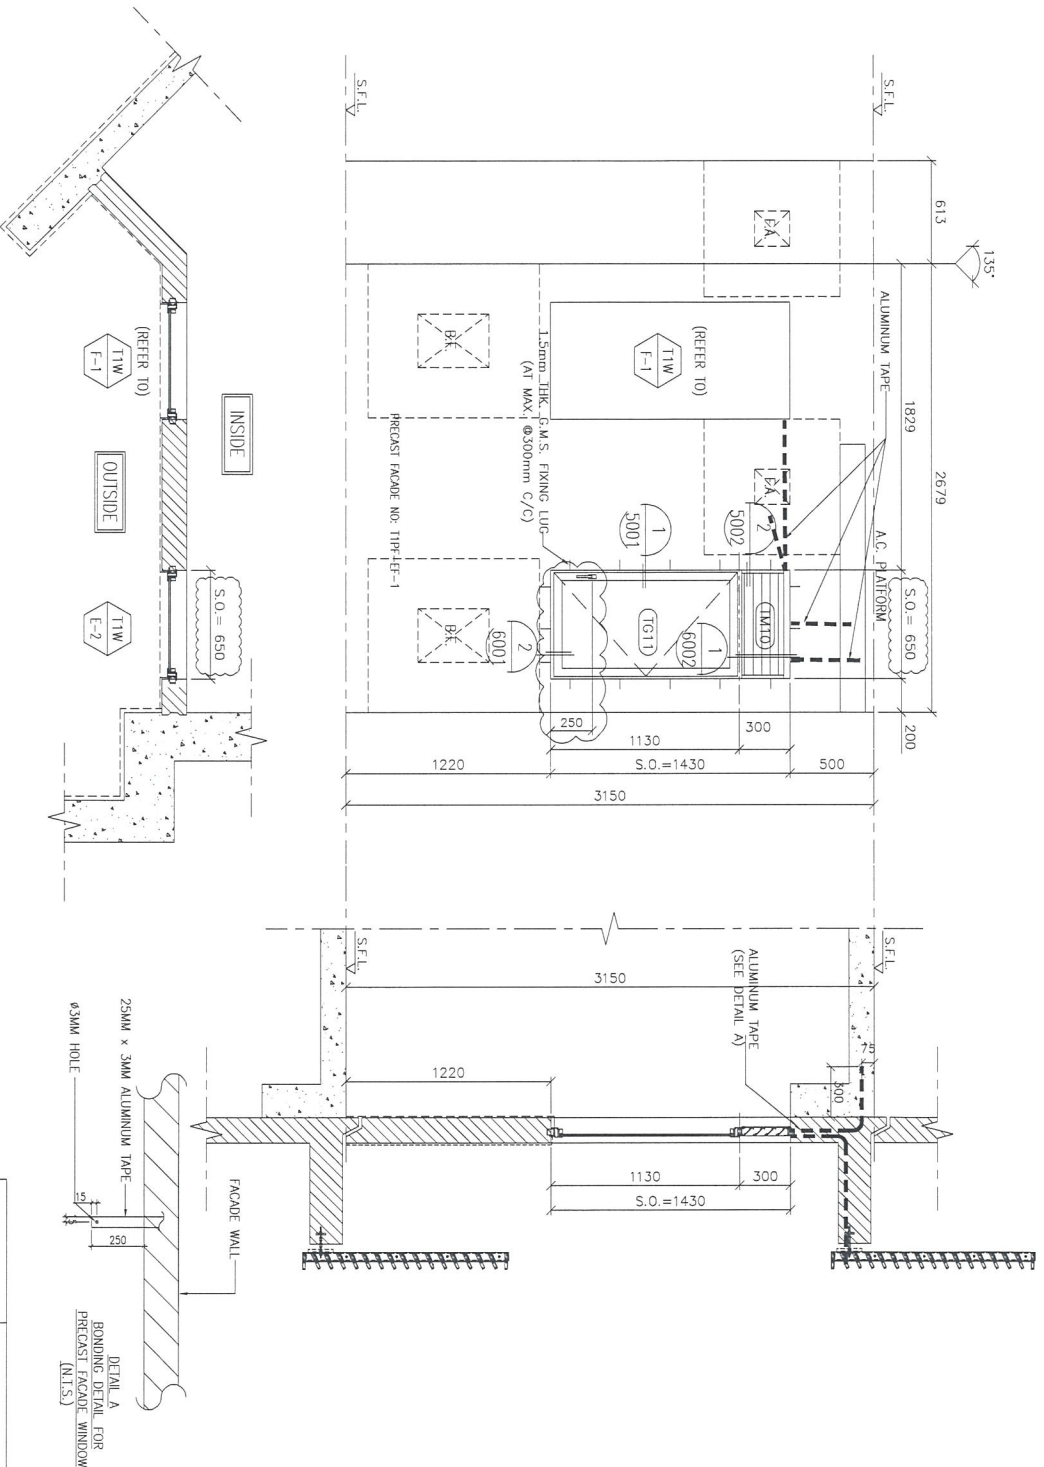

GLAZING AREA	Required = 0.478
	Provided = 0.566
OPENABLE AREA	Required = 0.297
	Provided = 0.651

WINDOW MARK	50mm ALUM. SECTION 39 NOS. (TYPICAL) TTW E-2
SECTION :	50mm ALUM. SECTION 39 NOS. (TYPICAL)
LOCATION :	6/F-26/F, 28/F-50/F FLAT E KITCHEN
GLAZING	8mm THK CLEAR TEMPERED GLASS
REMARK :	

B.O. REF :

CLIENT :
信和置業有限公司
Sino Land Company Limited

ARCHITECT :
WTF
WONG TUNG FONG ARCHITECTS & ENGINEERS

MAIN CONTRACTOR :
CR Construction Company Limited

STRUCTURAL ENGINEER :
AECOM

FACADE CONSULTANT:

NOTE:
1. DIMENSIONS ARE IN mm.
2. ALL ELEVATIONS ARE VIEWED FROM OUTSIDE.
3. ALL DIMENSIONS TO BE VERIFIED ON SITE BEFORE FABRICATION.

LEGEND:
X1 DETAIL MARK NO.
X2 REFER SHEET NO.
1. F.F.L. -- FINISHED FLOOR LEVEL
2. S.F.L. -- STRUCTURAL FLOOR LEVEL
3. (N) -- REVERSED DETAIL

NO	DATE	BY ARCHITECT COMMENT	BY ARCHITECT COMMENT	Zone
1	20/06/17			Zone
2	20/07/18			Zone

JOB NO. : J-837
PROJECT :
UYA KWUN TONG TOWN CENTRE
REDEVELOPMENT (AREA 2 & 3) AT
NKL 5514, KWUN TONG, KOWLOON

TITLE :
ALUM. WINDOW SCHEDULE
(FOR 11)

DRAWN BY : Zeng
CHECKED BY : DW
SCALE : 1:30

美特鋁質有限公司
M.T.D. ALUMINIUM FABRICATOR LTD.
Units 5-8, Shun Lee Industrial Building,
510 Che Koo Ling Road, Kowloon
Tel: (852) 27727866 Fax: (852) 27727866
DWG NO. : 0837-PW-2104 REV. : B