



工程指示 / 要求簡箋(E.I.)

工程指示編號：EI/9639/18

修改版次：-

工程編號：J-837

工程名稱：觀塘裕民坊

工程項目：佛沙窗 修改拆圖(T3W 窗方向)

收件人：生統 / 謝永林

發件人：Eric Liu

日期：21/08/2018

□要求提供 / □確認 事項：

- | | | |
|------------------------------------|-------------------------------------|-------------------------------|
| <input type="checkbox"/> 初步鋁料 B.M. | <input type="checkbox"/> 加工拆圖，然後生產 | <input type="checkbox"/> 尺寸表 |
| <input type="checkbox"/> 正式鋁料 B.M. | <input type="checkbox"/> 技術上資料 / 指示 | <input type="checkbox"/> 報價 |
| <input type="checkbox"/> 配件 B.M. | <input type="checkbox"/> 樣辦或貨品說明書 | <input type="checkbox"/> 分判合約 |
| <input type="checkbox"/> 其他：_____ | | |

內容：

請按則師 COMMENT 修改佛沙窗拆圖(第 2 份則師 COMMENT, 20180821)

T3W/K-1 佛沙窗開窗方向有改。

謝謝。

請在 2018 / 08 / 22 前完成上列要求。

附：1 頁

以上項目為：

- | | | |
|---------------------------------|--------------------------------------|--------------------------------|
| <input type="checkbox"/> 原合約工程包 | <input type="checkbox"/> 原合約工程加 / 減賬 | <input type="checkbox"/> 新工程報價 |
|---------------------------------|--------------------------------------|--------------------------------|

原因：-

分發東莞各部門：

- | | | | | | | | |
|---------------------------------|------------------------------|---|---|------------------------------|------------------------------|--------------------------------|------------------------------------|
| <input type="checkbox"/> 生產技術總監 | <input type="checkbox"/> 連附件 | <input checked="" type="checkbox"/> 技術部 | <input checked="" type="checkbox"/> 連附件 | <input type="checkbox"/> 生產部 | <input type="checkbox"/> 連附件 | <input type="checkbox"/> 機械設計部 | <input type="checkbox"/> 連附件 |
| <input type="checkbox"/> 採購部 | <input type="checkbox"/> 連附件 | <input checked="" type="checkbox"/> 生產統籌部 | <input checked="" type="checkbox"/> 連附件 | | | | |
| <input type="checkbox"/> 質檢部 | <input type="checkbox"/> 連附件 | <input type="checkbox"/> 會計部 | <input type="checkbox"/> 連附件 | <input type="checkbox"/> 報關組 | <input type="checkbox"/> 連附件 | <input type="checkbox"/> 其他 | _____ <input type="checkbox"/> 連附件 |

分發香港各部門：

- | | | | | | | | |
|------------------------------|------------------------------|-------------------------------|------------------------------|------------------------------|------------------------------|----------------------------------|------------------------------------|
| <input type="checkbox"/> 行政部 | <input type="checkbox"/> 連附件 | <input type="checkbox"/> 會計部 | <input type="checkbox"/> 連附件 | <input type="checkbox"/> 統籌部 | <input type="checkbox"/> 連附件 | <input type="checkbox"/> 工程部地盤科文 | <input type="checkbox"/> 連附件 |
| <input type="checkbox"/> 採購部 | <input type="checkbox"/> 連附件 | <input type="checkbox"/> QS 部 | <input type="checkbox"/> 連附件 | <input type="checkbox"/> 維修部 | <input type="checkbox"/> 連附件 | <input type="checkbox"/> 其他 | _____ <input type="checkbox"/> 連附件 |

傳遞編號：

HK 1280 / 18

發件人簽署：

項目經理簽署：








HK 1280

J837


2018.8.21

謝永林收

ELEVATION

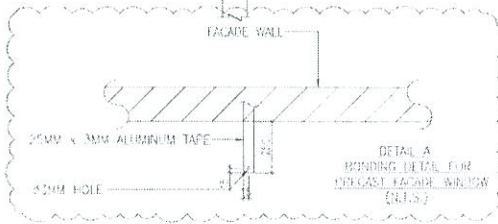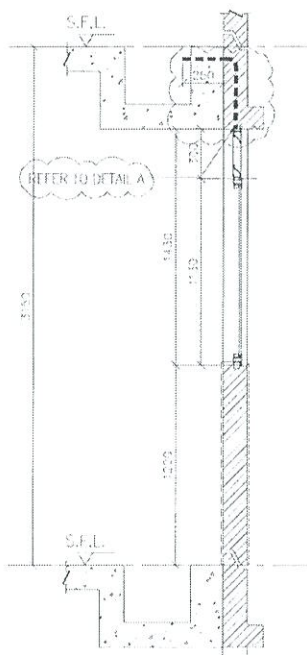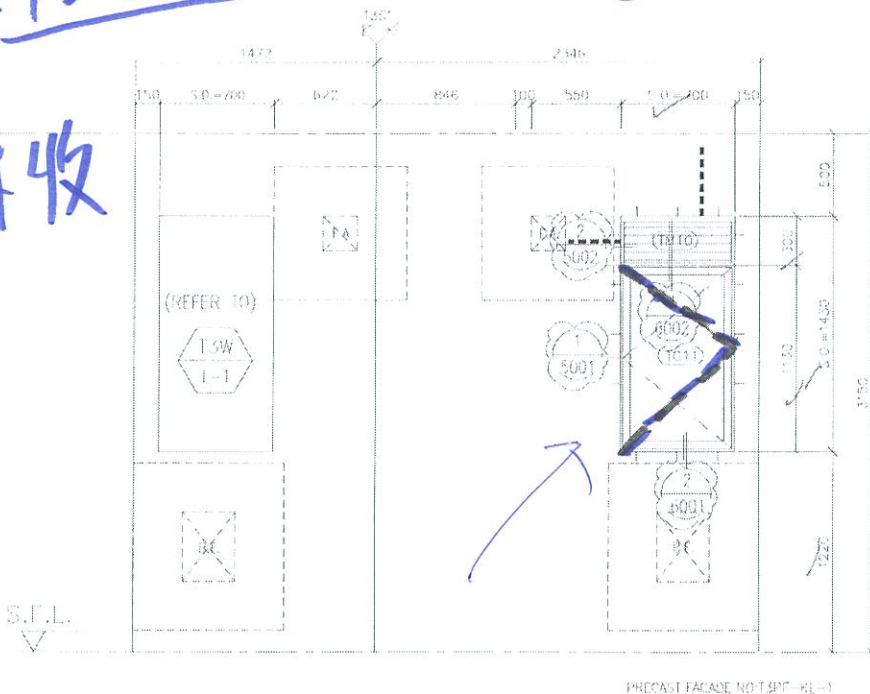

SINO LAND DEVELOPERS LTD.	
PROJECT NO. 1280	
DRAWING NO. J837-PW-2307	
DATE: 17/08/18	
REVISIONS:	
NO.	DESCRIPTION
1	REVISION
APPROVED BY: [Signature]	
CHECKED BY: [Signature]	
DESIGNED BY: [Signature]	
DRAWN BY: [Signature]	
REVIEWED BY: [Signature]	
REVISIONS:	
NO.	DESCRIPTION
1	REVISION
RECEIVED BY: [Signature]	
DATE: 17/08/18	

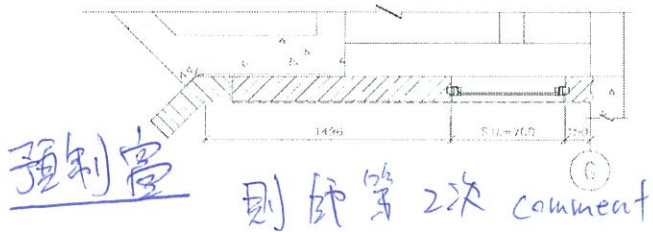

預制窗 則師第2次 comment

開窗方向更改

請修改拆圖

T3W
K-1

WINDOW MARK	T3W K-1
DIRECTION	SOMETIMES SECTION
TYPE	NO. 6115 (PHYSICAL)
LOCATION	T3 6/F - 26A - 28A - 11/F FLAT & KITCHEN
GLAZING	8mm H.K. CLEAR TINTED GLASS
REMARK	

CLIENT: 信和置業有限公司
Sino Land Company Limited

ARCHITECT: WONG TUNG & PARTNERS LIMITED
ARCHITECTS & PLANNERS
WT

MAIN CONTRACTOR: CR Construction Company Limited

STRUCTURAL ENGINEER: AECOM

FAÇADE CONSULTANT:

- SCALE:
1. ALL DIMENSIONS ARE TO FACE
 2. ALL ELEVATIONS ARE VIEWED FROM OUTSIDE
 3. ALL DIMENSIONS TO BE VIEWED IN SIDE VIEW UNLESS STATED
- LEGEND:
- (T) - DETAIL MARK NO.
 - (S) - SECTION SHEET NO.
1. F.F.L. - FINISHED FLOOR LEVEL
 2. S.F.L. - STRUCTURAL FLOOR LEVEL
 3. (S) - STRUCTURE DETAIL

GLAZING AREA	Required = 0.446
	Provided = 0.566
OPENABLE AREA	Required = 0.280
	Provided = 0.691

NO.	REVISED DIMENSION	DATE
1		
JOB NO. J837		
PROJECT: UPA KWUN TONG LOWY CENTRE REDEVELOPMENT (AREA 2 & 3) OF THE 6574 KWUN TONG, KOWLOON		
J837-PW-2307		
DATE: 17/08/18		
SCALE: 1:50		
DRAWN BY: [Signature]		
CHECKED BY: [Signature]		

美特鋁業有限公司
M.T. ALUMINIUM FABRICATOR LTD.
UNIT 101, SUNG SHING INDUSTRIAL BUILDING, 1/F
410 CHEUNG LEE STREET, KOWLOON
HONG KONG
TEL: (852) 2770 7777
FAX: (852) 2770 7777