



工程指示 / 要求簡箋(E.I.)

工程指示編號：EI / 9685 / 18

修改版次：A

工程編號：J - 837

工程名稱：觀塘裕民坊

工程項目：幕牆 鋁料模具生產(暫停 2 個模)

收件人：Maggie

發件人：Eric Liu

日期：30/08/2018

要求提供 / 確認 事項：

- | | | |
|------------------------------------|-------------------------------------|-------------------------------|
| <input type="checkbox"/> 初步鋁料 B.M. | <input type="checkbox"/> 加工拆圖，然後生產 | <input type="checkbox"/> 尺寸表 |
| <input type="checkbox"/> 正式鋁料 B.M. | <input type="checkbox"/> 技術上資料 / 指示 | <input type="checkbox"/> 報價 |
| <input type="checkbox"/> 配件 B.M. | <input type="checkbox"/> 樣辦或貨品說明書 | <input type="checkbox"/> 分判合約 |
| <input type="checkbox"/> 其他：_____ | | |

內容：

A 版暫停 2 個模

(X85558, X85593)

1. 玻璃線勾要改厚度，使勾不會因膠條厚度而移動

扣蓋膠

2. 鋁介子牙尺寸有修改

(兩項修改將會發出新紅改技圖)

謝謝！

請在 2018/09/07 前完成上列要求。

附：2 頁模圖+1 頁

以上項目為：

- 原合約工程包 原合約工程加 / 減賬 新工程報價

原因：-

分發東莞各部門：

- () 生產技術總監 連附件 (/) 技術部 連附件 _{永林} () 生產部 連附件 () 機械設計部 連附件
 () 採購部 連附件 (/) 生產統籌部 連附件 _梅
 (/) 質檢部 連附件 () 會計部 連附件 () 報關組 連附件 () 其他 楊榮輝 連附件

分發其他分判：

- (/) 張 連附件

分發香港各部門：

- () 行政部 連附件 () 會計部 連附件 () 統籌部 連附件 () 工程部地盤科文 連附件
 (/) 採購部 連附件 () QS 部 連附件 () 維修部 連附件 () 其他 _____ 連附件

傳遞編號：

HK 1365/18




發件人簽署：

項目經理簽署：


Page	PART	Grade	榮陽DIE No.	Die No.	0	A	B	C	D
1	M1	6063	T6	LH0089912	X85545				
2	M2	6063	T6	LH0089913	X85546				
3	M3	6063	T6	LH0089914	X85547	1			
4	M4	6063	T6	LH0089915	X85548				
5	M5	6063	T6		X85549				
6	M6	6063	T6	LH0089916	X85550	1			
7	M7	6063	T6	LH0089917	X85551				
8	T1	6063	T6	LH0089918	X85552				
9	T2	6063	T6	LH0089919	X85553	1			
10	T3	6063	T6	LH0089920	X85554	1			
11	T3A	6063	T6	LH0089921	X85555	1			
12	A01	6063	T5	LH0089922	X85556	1			
13	A02	6063	T6	LH0089923	X85557				
14	A03	6063	T6	LH0089924	X85558	1	暫停		
15	A04	6063	T6	LH0089925	X85559				
16	A05	6063	T6	LH0089926	X85560				
17	A06	6063	T6	LH0089927	X85561				
18	A07	6063	T6	LH0089928	X85562				
19	A08	6063	T5	LH0089929	X85563	1			
20	A09	6063	T5	LH0089930	X85564	1			
21	A10	6061	T6	LH0089931	X85565	1			
22	A11	6061	T6	LH0089932	X85566	1			
23	A12	6061	T6	LH0089933	X85567	1			
24	A13	6061	T6		X85568				
25	A14	6061	T6	LH0089934	X85569				
26	S01	6063	T6	LH0089935	X85570				
27	S02	6063	T5		X85571				
28	S03	6063	T6	LH0089936	X85572				
29	S04	6063	T6		X85573				
30	S05	6063	T6		X85574				
31	S06	6063	T6		X85575				
32	S07	6063	T6		X85576				
33	S08	6063	T6		X85577				
34	S09	6063	T5	LH0089937	X85578	1			
35	S10	6063	T6		X85579				
36	S12	6063	T6		X85580				
37	S13	6063	T6		X85581				
38	S15	6063	T6		X85582				
39	S16	6063	T6		X85583				
40	S17	6063	T5		X85584				
41	S18	6063	T6		X85585				
42	S19	6063	T6		X85586				
43	F01	6063	T6		X85587				
44	F02	6063	T6		X85588				
45	F03	6063	T5		X85589				
46	F04	6063	T6		X85590				
47	F05	6063	T6		X85591				
48	AB01	6061	T6	LH0089938	X85592				
49	AB2	6061	T6	LH0089939	X85593	1	暫停		
50	AB4	6061	T6	LH0089940	X85594	1			
51	AB5	6063	T5	LH0089941	X85595				
						15	2暫停		

*欠拉巴模圖



CUSTOMER	HONGKONG CO.	CUSTOMER APPROVAL	CUST PART NO.	X85558
			SECTION NO.	LH0089924

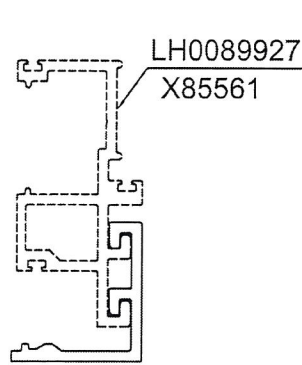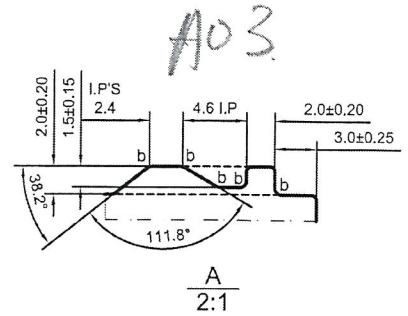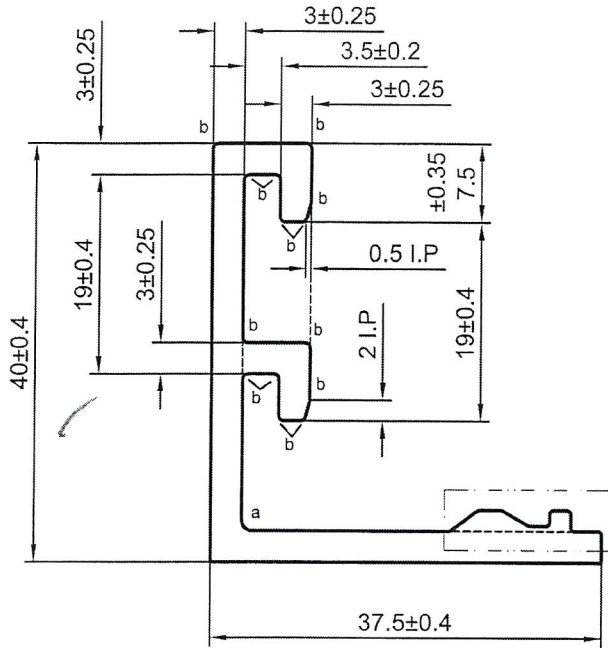


SCALE 1:2

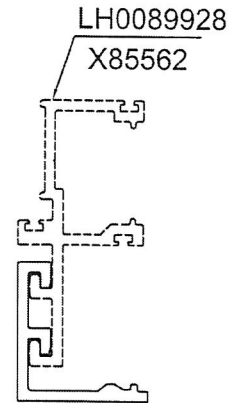


SCALE 1:2

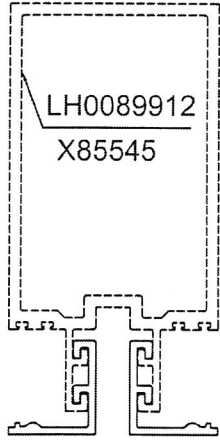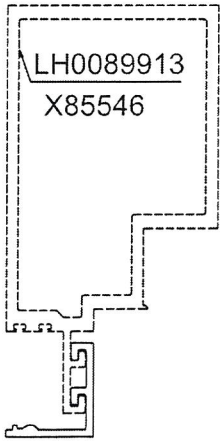

SCALE 1:3

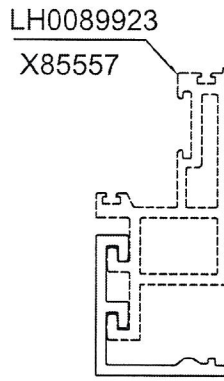


SCALE 1:2

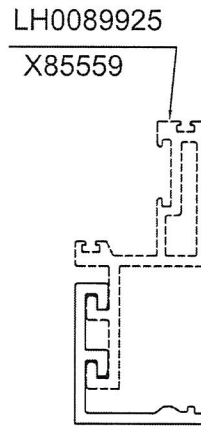

SCALE 1:2

美特鋁質有限公司	
承認圖面	
日期	

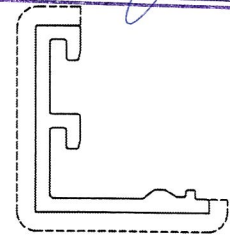

V.F
SCALE 1:1.5

a=R1 b=R0.5




*配合尺寸以实物配合效果为准!

SIGNATURE GRADEING	HIGH SIGNATURE GRADEING	C.C.DIA(MM)	Ø54.5	PERIMETER (MM)	198.8	STANDARD	GB 5237.1	SCALE	1.5:1
AREA (SQ MM)	304.18	UNSPECIFIED THICKNESS	3±0.25	SURFACE AREA	89.98	ALLOY	6063-T6	VERSION	A
MASS (KG/M)	0.824	UNSPECIFIED CORNERS	R 0.3	COMPANY ISSUE	A	DATE	2018-08-24	APPELLATION	-
DRAWN		蔡晓婷		DATE		PAGE		OF	
STANDARDIZATION				DATE					
TO SIGN		陈国提		DATE					
AUDITING				DATE					
MARKER	MODIFY	FILE NO	SIGNATURE	DATE	APPROV	DATE			

PANASIA ALUMINUM (CHINA) LIMITED

CUSTOMER	HONGKONG CO.	CUSTOMER APPROVAL	CUST PART NO.	X85593
			SECTION NO.	LH0089939

AB2.

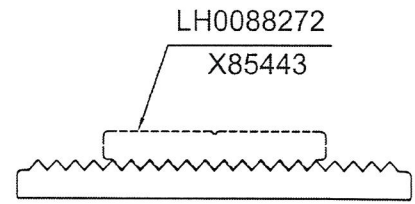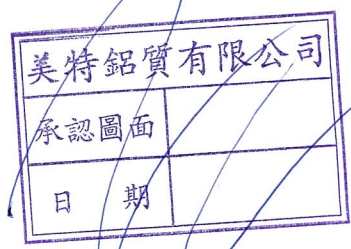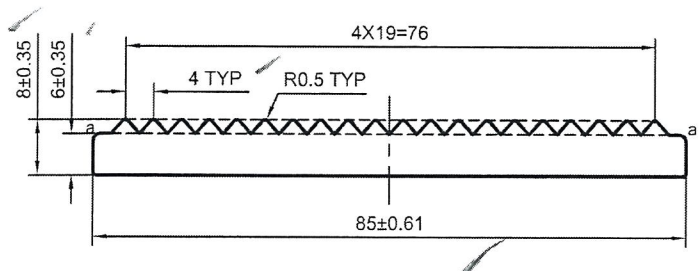

a=R1

*配合尺寸以实物配合效果为准!

NO V.F
SCALE 1:1.5

SIGNATURE GRADEING	HIGH SIGNATURE GRADEING	C.C.DIA(MM)	Ø85.12						
AREA (SQ MM)	598.2	UNSPECIFIED THICKNESS	-	PERIMETER (MM)	215.54	STANDARD	GB 5237.1	SCALE	1:1
MASS (KG/M)	1.621	UNSPECIFIED CORNERS	R 0.5	SURFACE AREA	-	ALLOY	6061-T6	VERSION	A
COMPANY ISSUE		A	DRAWN	蔡晓婷	DATE	2018-08-25	APPELLATION	-	PAGE OF
			STANDARDIZATION		DATE				
			TO SIGN	陈国提	DATE				
			AUDITING		DATE				
MARKER	MODIFY	FILE NO	SIGNATURE	DATE	APPROV	DATE			

