



工程指示 / 要求簡箋(E.I.)

工程指示編號：EI / 9713 / 18

修改版次：-

工程編號：J - 837

工程名稱：觀塘裕民坊

工程項目：現場鋁料+防水樣板 (CW 碰趟門)

收件人：生統

發件人：Eric Liu

日期：31/08/2018

要求提供 / 確認 事項：

- | | | |
|------------------------------------|-------------------------------------|-------------------------------|
| <input type="checkbox"/> 初步鋁料 B.M. | <input type="checkbox"/> 加工拆圖，然後生產 | <input type="checkbox"/> 尺寸表 |
| <input type="checkbox"/> 正式鋁料 B.M. | <input type="checkbox"/> 技術上資料 / 指示 | <input type="checkbox"/> 報價 |
| <input type="checkbox"/> 配件 B.M. | <input type="checkbox"/> 樣辦或貨品說明書 | <input type="checkbox"/> 分判合約 |
| <input type="checkbox"/> 其他：_____ | | |

內容：

請生產鋁料送地盆，做樣板供業主查看。

1. X85418， 2 支，削去。 (J833)

2. X85222， 2 支，削去。 (J831)

3. X85224， 2 支，削去。 (J831)

4. X85459， 16 隻。 (J833)

5. 50x50x5 鋁角，(20 條，L=100mm) (10 條，L=3000mm)

請在 2018 / 09 / 05 送到。

附： 頁

以上項目為：

- 原合約工程包 原合約工程加 / 減賬 新工程報價

原因：-

分發東莞各部門：

- () 生產技術總監 連附件 () 技術部 連附件 () 生產部 連附件 () 機械設計部 連附件
 () 採購部 連附件 () 生產統籌部 連附件
 () 質檢部 連附件 () 會計部 連附件 () 報關組 連附件 () 其他 楊榮輝 連附件

分發其他分判：

- () 王禮秋 連附件

分發香港各部門：


- () 行政部 連附件 () 會計部 連附件 () 統籌部 連附件 () 工程部地盤科文 連附件 楊榮輝
 () 採購部 連附件 () QS 部 連附件 () 維修部 連附件 () 其他 _____ 連附件


傳遞編號：

發件人簽署：Eric Liu

HK 1381 / 18

項目經理簽署：[Signature]

 美特鋁質有限公司 MIDI Aluminium Fabricator Ltd.		工程號:	J-833	計算:	黃漢卿	日期:	2017/02/14	送呈:	Jason	副本:				
		地盤名稱:	白石	核對:	王禮秋	日期:	2017/02/14	A/C Code:						
鋁型材B.M.表		項目類別:	幕牆(屋仔)	批准:		日期:								
BM編號:		修改版次:	EI 6182H	有顏色鋁料(Kg):	105887.3	無電鍍鋁料(Kg):	34910.1	V.F總面積(米 ²):	8068.8					
序號	修改內容	物料編號	鋁料名稱	顏色	合金狀態	長度 (mm)	數量(支)			重量(Kg)		V.F.(米 ²)		備註
							實用	後備	總數	Kg/M	總重量	米 ² /米	Total_V.F.	
1		X85409	公企料(梗窗)	TUC51595XL(RYA)-3(中灰)	6063-T6	3600	143	9	152	5.25	2873.9	0.19	101.8	
2		X85409	公企料(梗窗)	TUC51595XL(RYA)-3(中灰)	6063-T6	4250	19	6	25	5.25	558.0	0.19	19.8	用於GF(3007)和小單元件
3	H(增加數量)	X85410	母企料(梗窗)	TUC51595XL(RYA)-3(中灰)	6063-T6	3600	157	8	165	4.30	2556.6	0.13	79.0	原數量111支
4		X85410	母企料(梗窗)	TUC51595XL(RYA)-3(中灰)	6063-T6	4250	19	6	25	4.30	457.3	0.13	14.1	小單元件
5	H(增加數量)	X85411	公企料(生窗)	TUC51595XL(RYA)-3(中灰)	6063-T6	3600	166	9	175	4.50	2831.9	0.31	197.8	原數量143支
6	H(增加數量)	X85412	母企料(生窗)	TUC51595XL(RYA)-3(中灰)	6063-T6	3600	166	9	175	3.76	2366.9	0.22	139.2	原數量143支
7		X85412	母企料(生窗)	TUC51595XL(RYA)-3(中灰)	6063-T6	4250	1	2	3	3.76	47.9	0.22	2.8	用於GF(3007)
8	H(增加數量)	X85413	公企料(轉角梗窗)	TUC51595XL(RYA)-3(中灰)	6063-T6	3600	153	9	162	7.95	4637.0	0.23	134.1	原數量133支
9		X85413	公企料(轉角梗窗)	TUC51595XL(RYA)-3(中灰)	6063-T6	4250	9	5	14	7.95	473.1	0.23	13.7	用於小單元件
10	H(增加數量)	X85414	母企料(轉角梗窗)	TUC51595XL(RYA)-3(中灰)	6063-T6	3600	157	9	166	6.82	4076.2	0.20	119.5	原數量139支
11		X85414	母企料(轉角梗窗)	TUC51595XL(RYA)-3(中灰)	6063-T6	4250	9	5	14	6.82	405.8	0.20	11.9	用於小單元件
12		X85415	企料(邊位)	TUC51595XL(RYA)-3(中灰)	6063-T6	3600	492	24	516	5.65	10491.7	0.25	457.0	
13		X85415	企料(邊位)	TUC51595XL(RYA)-3(中灰)	6063-T6	4250	54	7	61	5.65	1464.2	0.25	63.8	用於GF(3007)和小單元件
14	H(增加數量)	X85416	公企料(轉角生窗)	TUC51595XL(RYA)-3(中灰)	6063-T6	3600	15	3	18	7.34	475.9	0.44	28.3	原數量6支
14a	H(增加數量)	X85417	母企料(轉角生窗)	TUC51595XL(RYA)-3(中灰)	6063-T6	3600	15	3	18	6.27	406.3	0.37	23.7	原數量6支
15	H(增加數量)	X85418	中企料 x2	TUC51595XL(RYA)-3(中灰)	6063-T6	4500	57	5	62	5.78	1612.3	0.49	136.7	原數量51
16		X85419	底橫(梗窗)	TUC51595XL(RYA)-3(中灰)	6063-T6	5800	181	12	193	7.75	8678.7	0.31	342.5	
17		X85420	頂橫	TUC51595XL(RYA)-3(中灰)	6063-T6	5800	275	20	295	7.55	12914.6	0.26	438.0	
18	H(增加數量)	X85421	中橫梁(梗窗)-弧	TUC51595XL(RYA)-3(中灰)	6063-T6	5800	148	12	160	5.47	5071.5	0.65	598.6	原數量118
19	H(增加數量)	X85422	中橫梁(上生下梗)	TUC51595XL(RYA)-3(中灰)	6063-T6	5800	88	7	95	4.21	2319.2	0.49	268.9	原數量46

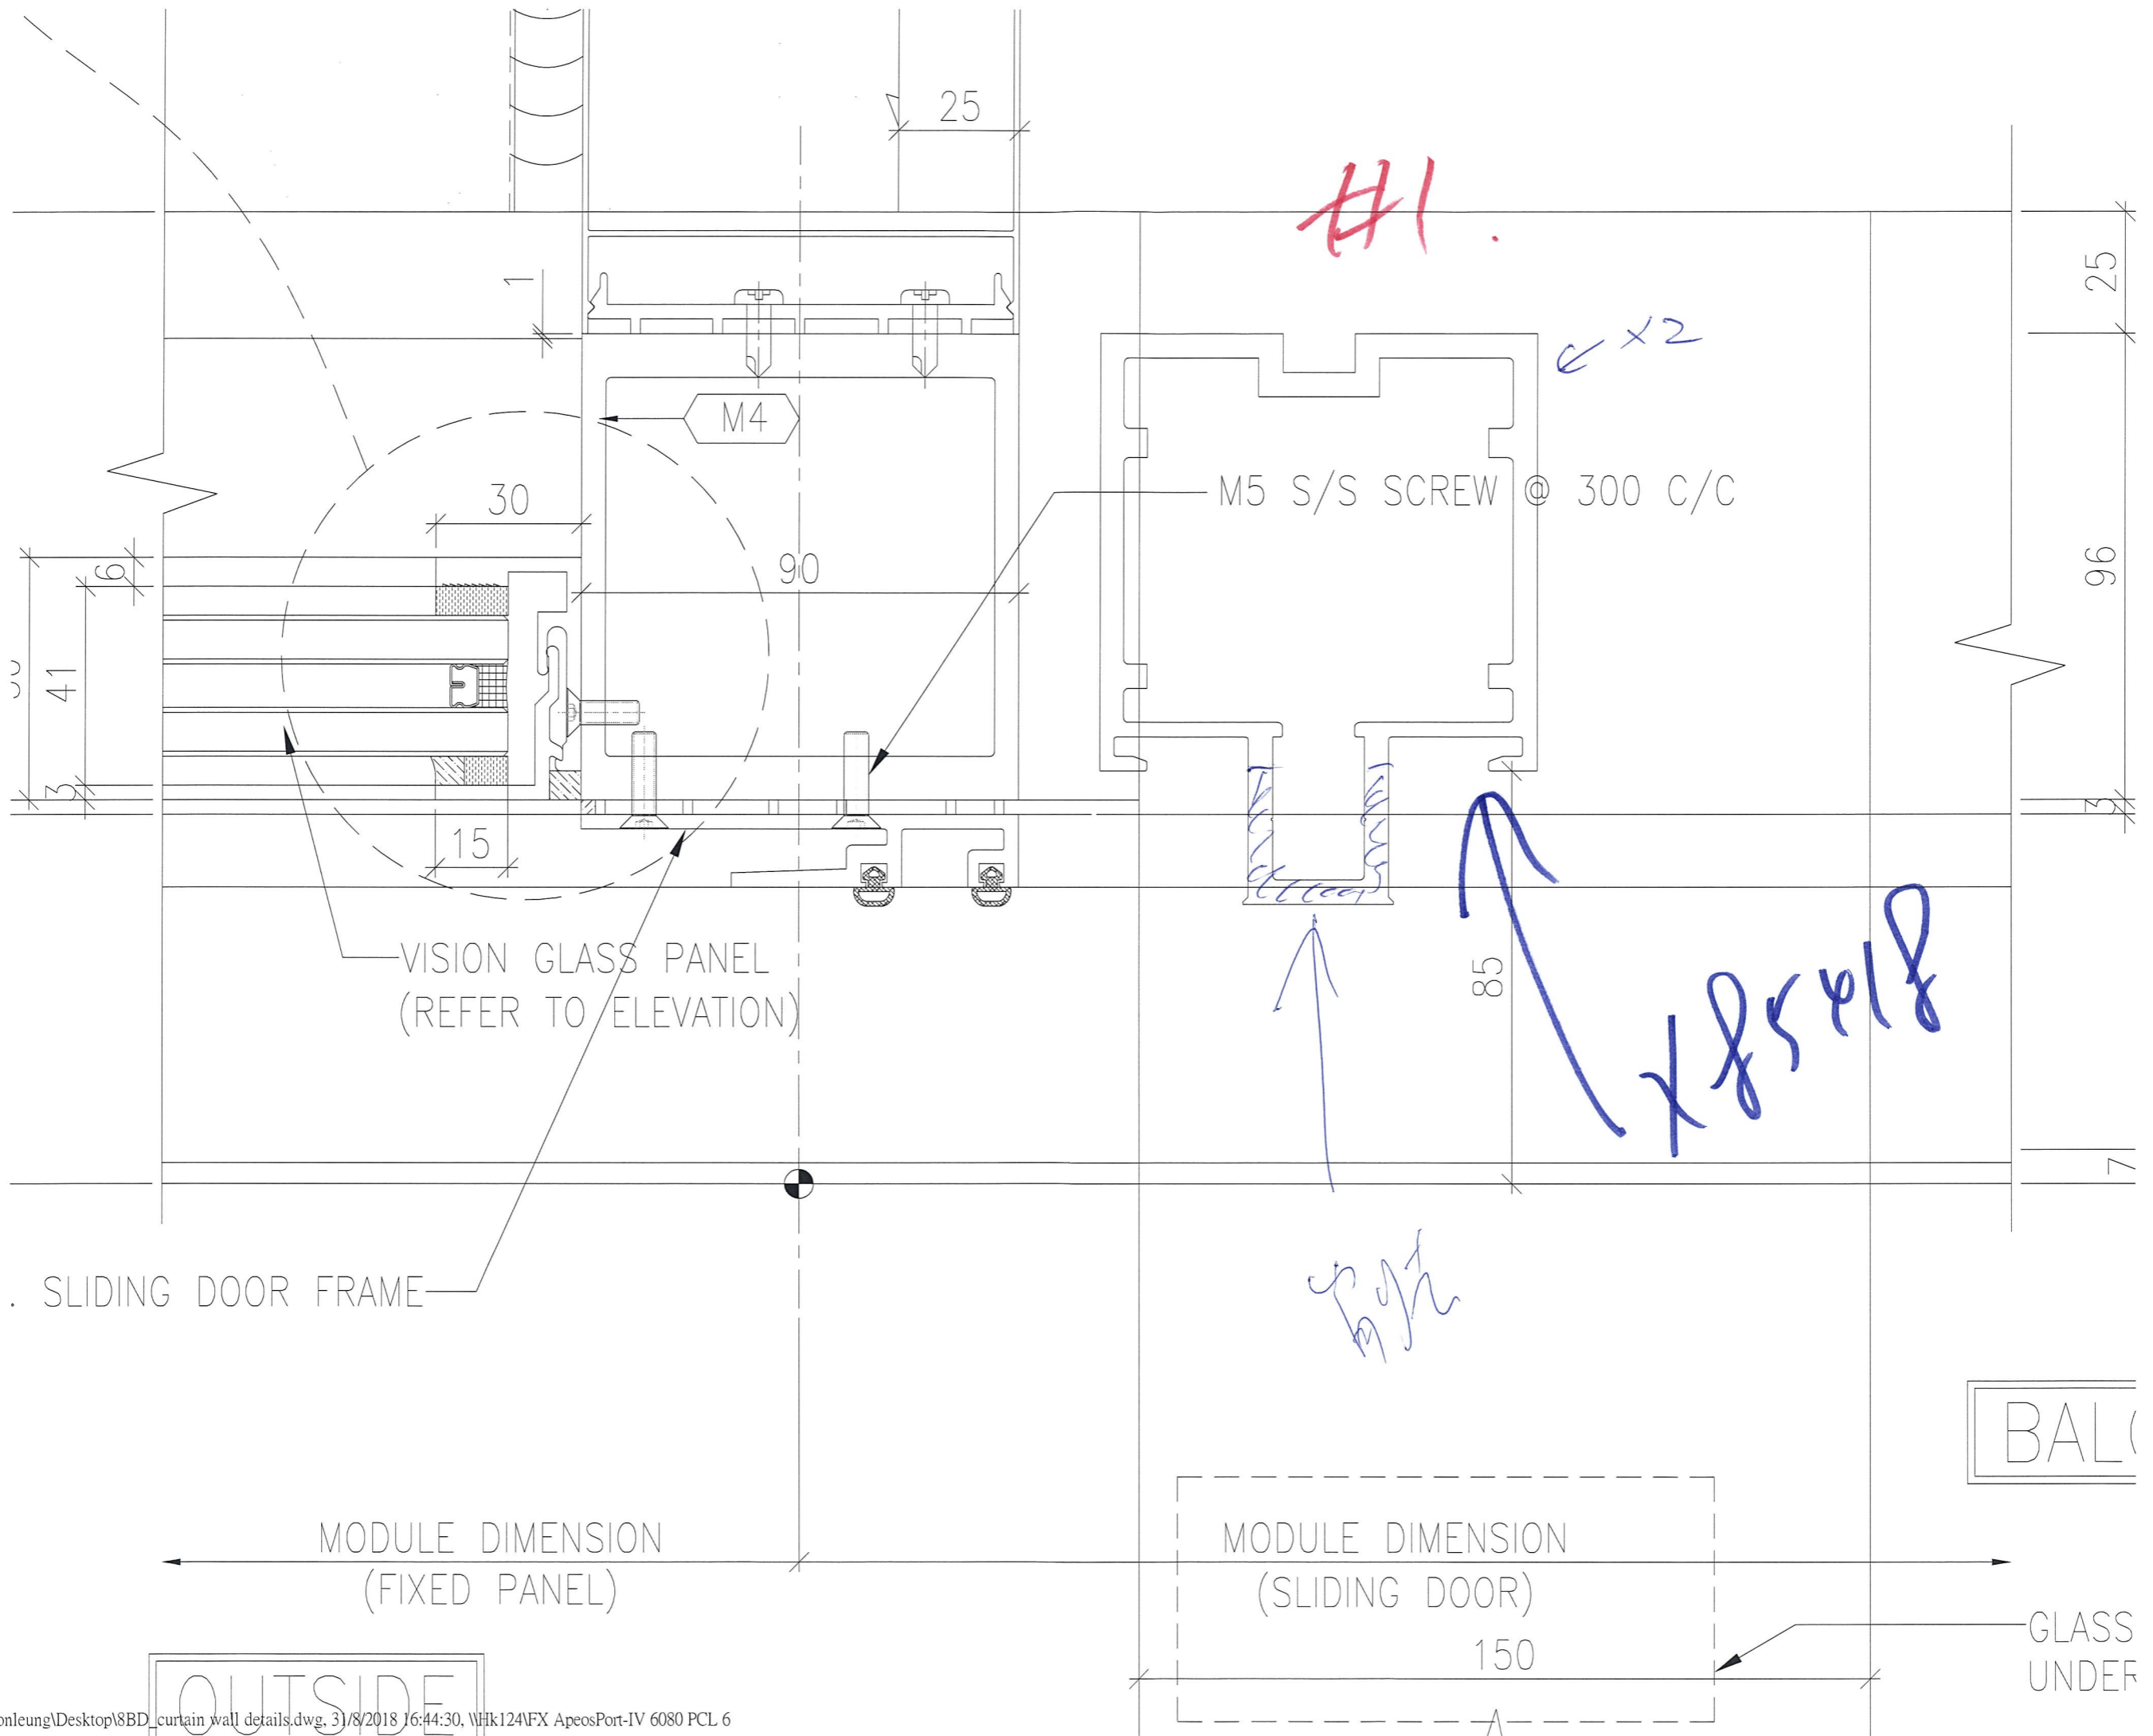

#1.

x2

M5 S/S SCREW @ 300 C/C

VISION GLASS PANEL
(REFER TO ELEVATION)

SLIDING DOOR FRAME

MODULE DIMENSION
(FIXED PANEL)

MODULE DIMENSION
(SLIDING DOOR)

150

GLASS UNDER

OUTSIDE

BAL





85

x 285 x 18


Handwritten note

SECTION NO.

X85222

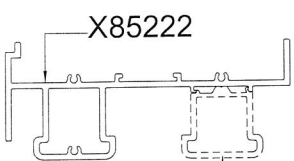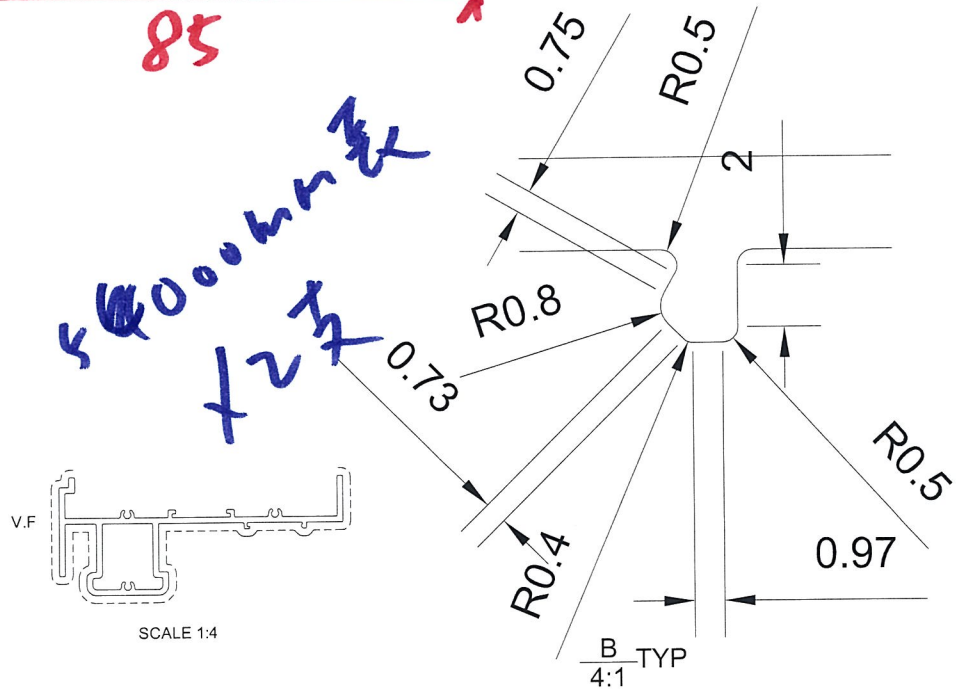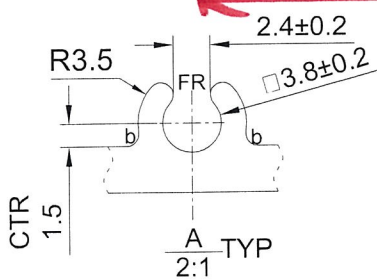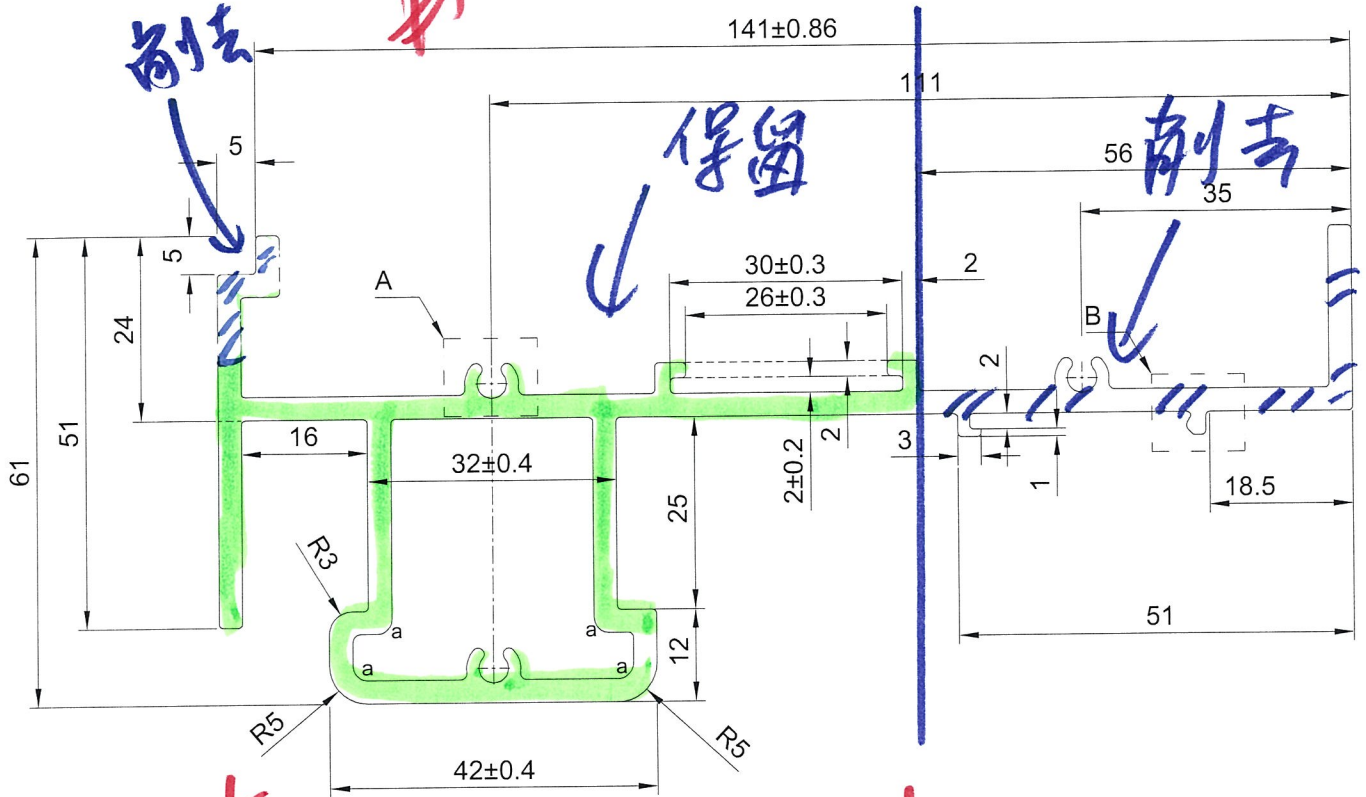

X85223

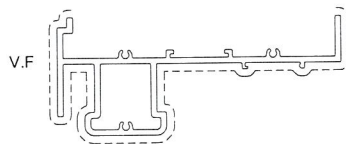

SCALE 1:4

SIGNATURE GRADEING	HIGH SIGNATURE GRADEING	C.C.DIA(MM)	154.65	**a=R2, b=R0.8					
AREA (SQ MM)	1084.33	UNSPECIFIED THICKNESS	3±0.4	PERIMETER (MM)	743.82	STANDARD		SCALE	1:1
MASS (KG/M)	2.928	UNSPECIFIED CORNERS	R=0.5	SURFACE AREA	353.03	ALLOY	6063-T5	VERSION	-
COMPANY ISSUE			DRAWN	KC	DATE	15-11-17	APPELLATION	-	PAGE OF
			STANDARDIZATION		DATE				
			TO SIGN		DATE				
			AUDITING		DATE				
MARKER MODIFY FILE NO SIGNATURE DATE APPROV					DATE				






美特鋁質有限公司
MIDI Aluminium Fabricator Ltd.


SECTION NO.

X85224

Handwritten red mark: 23

146±0.86

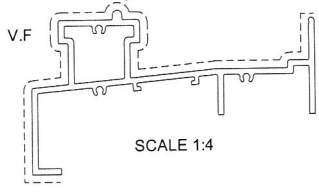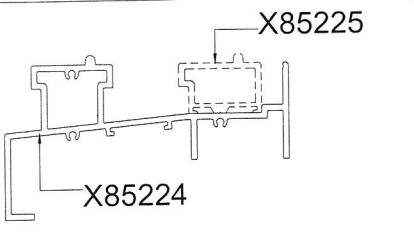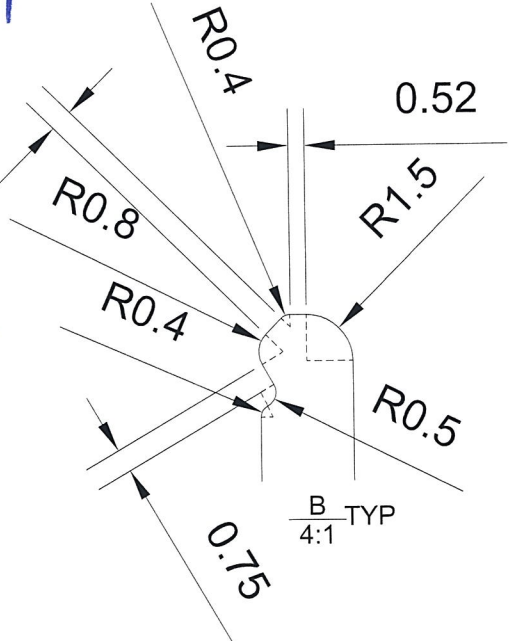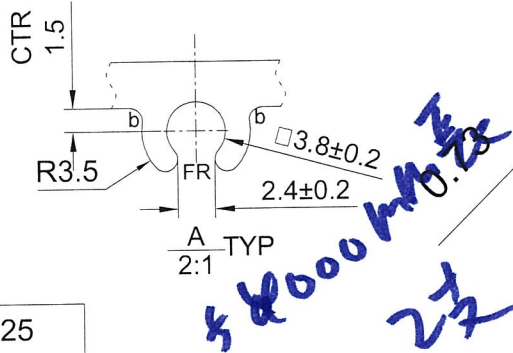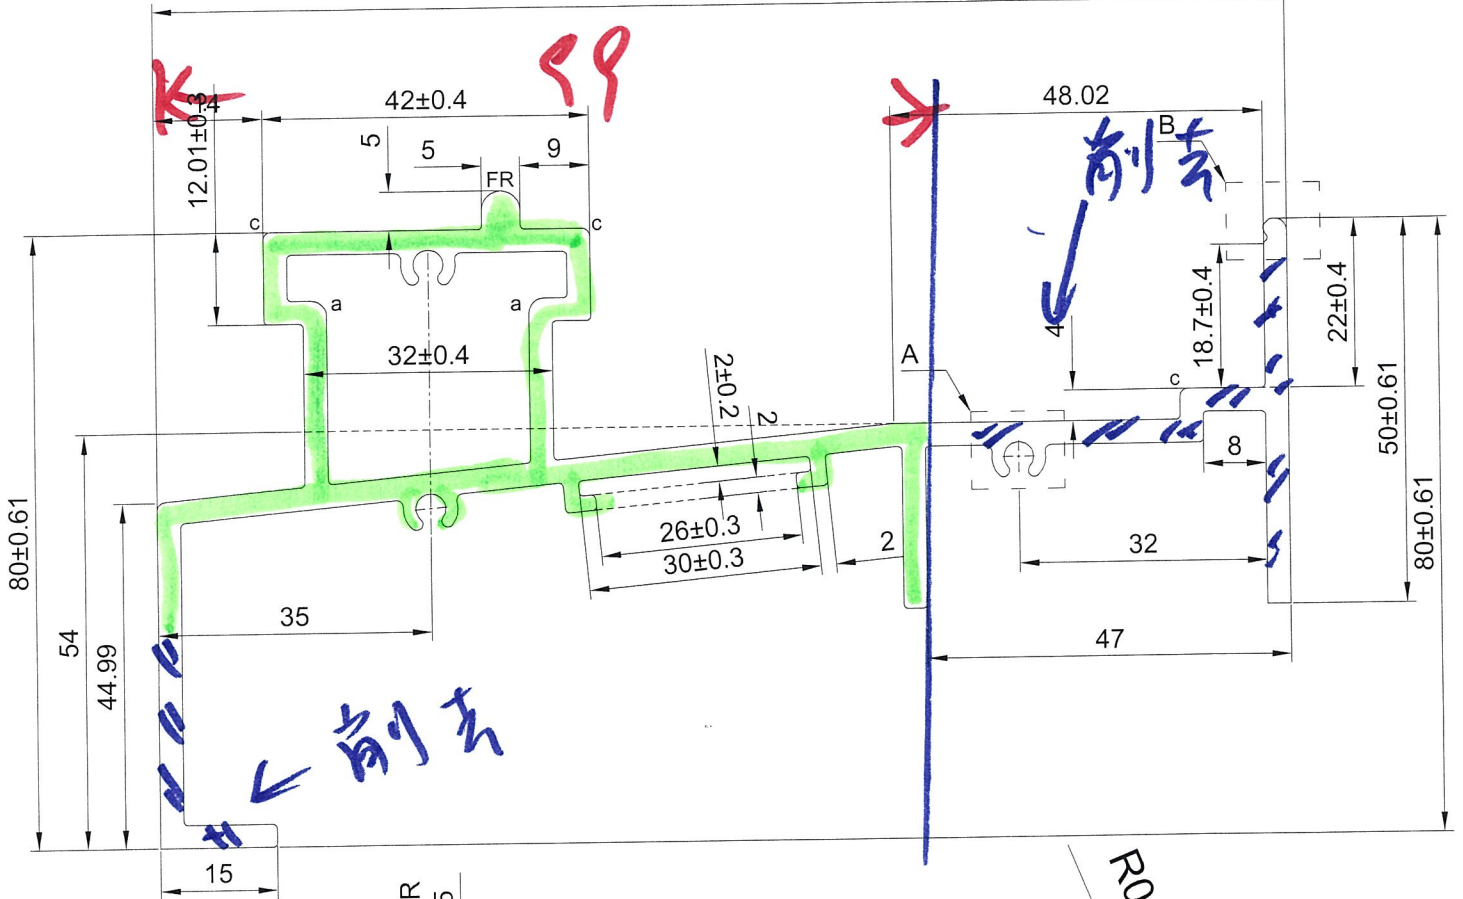


SIGNATURE GRADEING	HIGH SIGNATURE GRADEING	C.C.DIA(MM)	165.88	**a=R2 , c=R1						
AREA (SQ MM)	1229.01	UNSPECIFIED THICKNESS	3±0.4	PERIMETER (MM)	826.31	STANDARD		SCALE	1:1	
MASS (KG/M)	3.318	UNSPECIFIED CORNERS	R=0.5	SURFACE AREA	353.03	ALLOY	6063-T5	VERSION	-	
COMPANY ISSUE				DRAWN	KC	DATE	15-11-14	APELLATION	-	PAGE OF
				STANDARDIZATION		DATE		 美特铝质 有限公司 MIDI Aluminium Fabricator Ltd.		
				TO SIGN		DATE				
				AUDITING		DATE				

V.F. 按此圖為準.


J-831 (教堂里) 提升門鋁料V.F噴圖

Handwritten mark: #2


Handwritten mark: #2

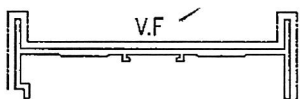


模號: X846340
合金狀態: 6063-T5
名稱: 趟門邊企
重量: 2.1KG/M
V.F.: 268mm

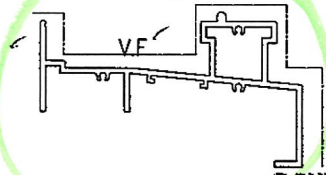


模號: X85224
合金狀態: 6063-T5
名稱: 趟門底橫料
重量: 3.534KG/M
V.F.: 320.46mm

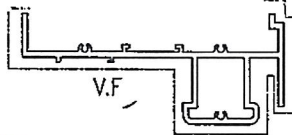

模號: X85222
合金狀態: 6063-T5
名稱: 趟門頂橫料
重量: 3.114KG/M
V.F.: 358.48mm

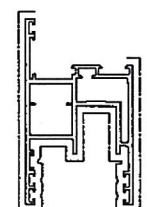


模號: X846310
合金狀態: 6063-T5
名稱: 門玉
重量: 2.55KG/M
V.F.: 444.91mm

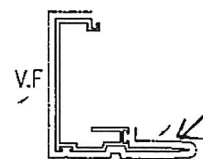


模號: X846280
合金狀態: 6063-T5
名稱: 玉勾企蓋
重量: 1.111KG/M
V.F.: 239mm


要噴

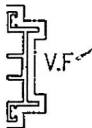


模號: X846270
合金狀態: 6063-T5
名稱: 門企夾邊
重量: 0.725KG/M
V.F.: 129mm

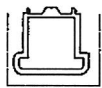


模號: X85223
合金狀態: 6063-T5
名稱: 趟門頂導軌
重量: 1.184KG/M
V.F.: 113.78mm

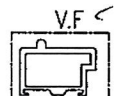


模號: X85225
合金狀態: 6063-T5
名稱: 趟門底導軌
重量: 1.102KG/M
V.F.: 105.71mm

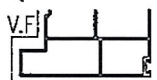

模號: X85226
合金狀態: 6063-T5
名稱: 趟門頂收口
重量: 0.935KG/M
V.F.: 167.42mm

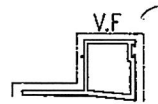


模號: X85227
合金狀態: 6063-T5
名稱: 趟門底收口
重量: 1.124KG/M
V.F.: 141mm

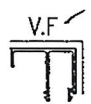


模號: X846290
合金狀態: 6063-T5
名稱: 玻璃線
重量: 0.345KG/M
V.F.: 61mm



模號: ME0000168
名稱: 32*25*3鋁角
合金狀態: 6063-T6
重量: 0.437KG/M
V.F.: 35 mm

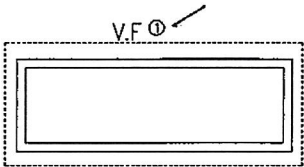

模號: T10000071
合金狀態: 6063-T5
名稱: 50.8X152.4X6.35鋁通
重量: 6.552KG/M
V.F.: 406mm

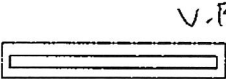

模號: ME0000061
合金狀態: 6063-T5
名稱: 40X2鋁巴
重量: 0.217KG/M
V.F.: 84mm

本來唔使噴，但鑲陽收費問題所以噴埋

Handwritten signature

2/8/17

218/17 d2

		美特鋁制有限公司	工程號:	J-831	計算:	林仁安	日期:	2017/7/7	送呈:	胡哥				
		MIDI Aluminium Fabricator Ltd.	地盤名稱:	香港教堂里	核對:		日期:		副本:					
		廠用鋁型材B.M.表	項目類別:	趟門 29/A ~ 33/A	批准:		日期:		此BM依據 HK2171初步施工圖 計算					
BM編號: 831-XXXX			A/C Code:		有顏色鋁料(Kg):	1882	無顏色鋁料(Kg):	127	V.F總面積(米 ²):	249				
序號	修改標示	物料編號	鋁料名稱	顏色	合金狀態	長度	數量(支)			重量(Kgs)		V.F.(米 ²)		備注
						(mm)	實用	後備	總數	Kg/M	總重量	米 ² /米	Total_V.F.	
以下趟門用料														
1		X846340	趟門邊企料	UCT517910XLA-3 (深灰色)	6063-T5	6000	15		15	2.100	189.0	0.268	24.12	
2	→	X85224	趟門底橫料	UCT517910XLA-3 (深灰色)	6063-T5	5000	8		8	3.534	141.4	0.320	12.82	
3	→	X85222	趟門頂橫料	UCT517910XLA-3 (深灰色)	6063-T5	5000	8		8	3.114	124.6	0.358	14.34	
4		X85225	趟門底導軌	UCT517910XLA-3 (深灰色)	6063-T5	5000	4		4	1.102	22.0	0.106	2.11	
5		X85223	趟門頂導軌	UCT517910XLA-3 (深灰色)	6063-T5	5000	4		4	1.184	23.7	0.114	2.28	
6		X85226	趟門頂收口	UCT517910XLA-3 (深灰色)	6063-T5	5000	4		4	0.935	18.7	0.167	3.35	
7		X85227	趟門底收口	UCT517910XLA-3 (深灰色)	6063-T5	5000	4		4	1.124	22.5	0.141	2.82	
8		X846310	趟門玉料	UCT517910XLA-3 (深灰色)	6063-T5	5500	42	2	44	2.550	617.1	0.445	107.67	
9		X846270	趟門邊夾企	UCT517910XLA-3 (深灰色)	6063-T5	5700	15		15	0.725	62.0	0.129	11.03	
10		X846280	趟門玉企蓋	UCT517910XLA-3 (深灰色)	6063-T5	5700	15		15	1.111	95.0	0.239	20.43	
11		X846290	趟門玻璃線	UCT517910XLA-3 (深灰色)	6063-T5	5500	42	5	47	0.345	89.2	0.061	15.77	
12		ME0000061	40*2鋁巴	UCT517910XLA-3 (深灰色)	6063-T5	5000	8		8	0.217	8.7	0.084	3.36	趟門底用
13		ME0000168	32*25*3鋁角	UCT517910XLA-3 (深灰色)	6063-T5	5000	4		4	0.437	8.7	0.035	0.70	趟門底用
14		TI0000071	50.8*152.4*6.35鋁通	UCT517910XLA-3 (深灰色)	6063-T5	5850	12		12	6.552	460.0	0.406	28.50	趟門邊用
15		TI0000046	76.2*76.2*6.35鋁角	MILL	6063-T5	5700	1		1	2.537	14.5			門玉組裝用
16		PE00E4040	65*5鋁巴	MILL	6063-T5	5700	15		15	0.878	75.1			門玉組裝用
17		LH0082045	18*18*2鋁角	MILL	6063-T5	6000	30		30	0.184	33.1			邊企檔膠
18		ME0003002	25*25*2鋁通	MILL	6063-T5	6000	1		1	0.497	3.0			邊企墊通
19		GY0000009	30*20*1.2鋁通	MILL	6063-T5	5700	1		1	0.310	1.8			梗門玉底墊塊用
										2009.8		249.30		
因初步大圖都未敲定，以上數據僅供參考！														

好
好





美特鋁質 有限公司
MIDI Aluminium Fabricator Ltd.

工程號 J-833 地盤 白石

~~H4~~

不開此孔

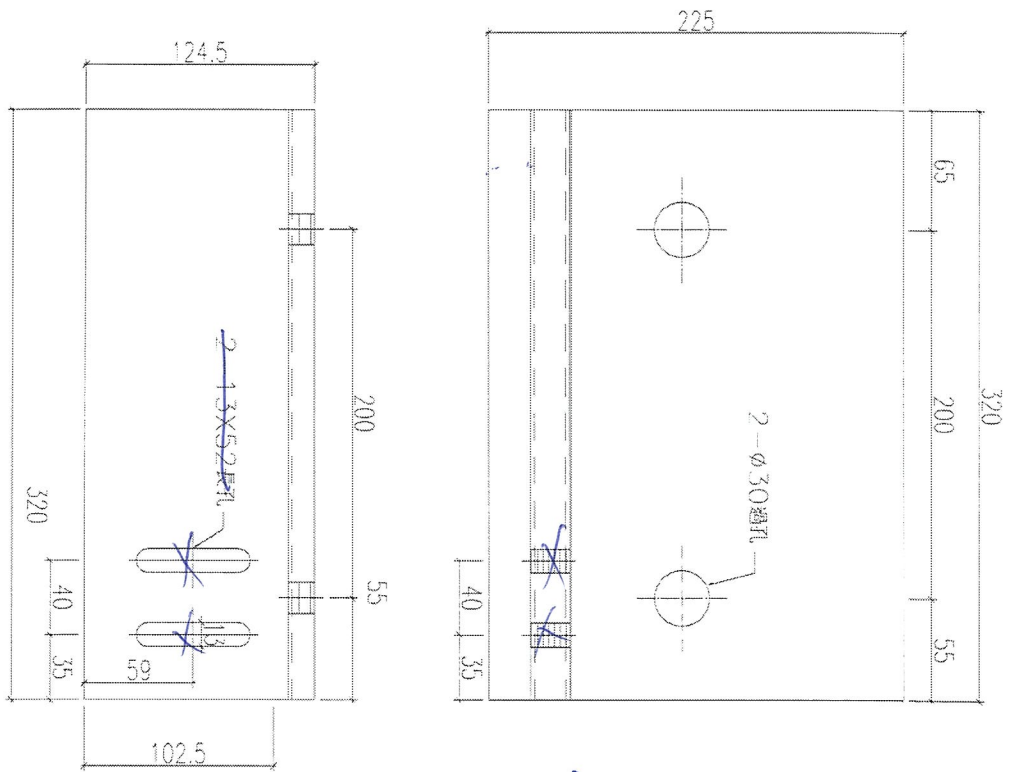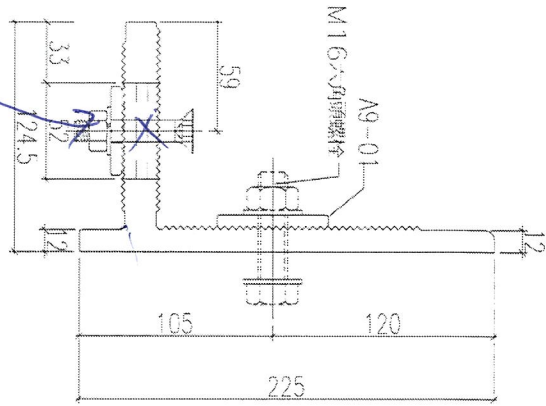


16隻

X85k59

數量	59+8 (預多)
----	-----------

名稱	鐵碼加工圖	制圖	黃漢瑛	2017.6.28	修改	
材料	X85459	復核	王禮秋	2017.6.28	日期	
顏色	MILL	批准			圖號	AB03-02R 34

#5

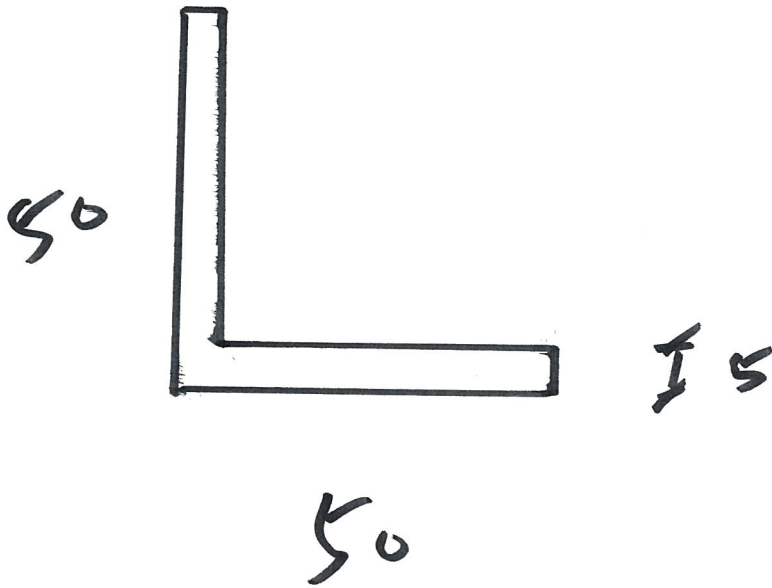

~~20个~~ $50 + 50 + 5$ $L = 100, 20个$
 $L = 3000, 10个$

頁 2 9713

