



工程指示 / 要求簡箋(E.I.)

工程指示編號：EI / 9713 / 18

修改版次：-

工程編號：J - 837

工程名稱：觀塘裕民坊

工程項目：現場鋁料+防水樣板 (CW 碰趟門)

收件人：生統

發件人：Eric Liu

日期：31/08/2018

□要求提供 / □確認 事項：

- | | | |
|------------------------------------|-------------------------------------|-------------------------------|
| <input type="checkbox"/> 初步鋁料 B.M. | <input type="checkbox"/> 加工拆圖，然後生產 | <input type="checkbox"/> 尺寸表 |
| <input type="checkbox"/> 正式鋁料 B.M. | <input type="checkbox"/> 技術上資料 / 指示 | <input type="checkbox"/> 報價 |
| <input type="checkbox"/> 配件 B.M. | <input type="checkbox"/> 樣辦或貨品說明書 | <input type="checkbox"/> 分判合約 |
| <input type="checkbox"/> 其他：_____ | | |

內容：

請生產鋁料送地盆，做樣板供業主查看。

1. X85418， 2 支，削去。(J833)

2. X85222， 2 支，削去。(J831)

3. X85224， 2 支，削去。(J831)

4. X85459， 16 隻。(J833)

5. 50x50x5 鋁角，(20 條，L=100mm) (10 條，L=3000mm)

請在 2018 / 09 / 05 送到。

附： 頁

以上項目為：

- | | | |
|---------------------------------|--------------------------------------|--------------------------------|
| <input type="checkbox"/> 原合約工程包 | <input type="checkbox"/> 原合約工程加 / 減賬 | <input type="checkbox"/> 新工程報價 |
|---------------------------------|--------------------------------------|--------------------------------|

原因：-

分發東莞各部門：

- | | | | |
|--------------------------------------|--|-----------------------------------|---|
| <input type="checkbox"/> 生產技術總監 □連附件 | <input type="checkbox"/> 技術部 □連附件 | <input type="checkbox"/> 生產部 □連附件 | <input type="checkbox"/> 機械設計部 □連附件 |
| <input type="checkbox"/> 採購部 □連附件 | <input checked="" type="checkbox"/> 生產統籌部 □連附件 | | |
| <input type="checkbox"/> 質檢部 □連附件 | <input type="checkbox"/> 會計部 □連附件 | <input type="checkbox"/> 報關組 □連附件 | <input type="checkbox"/> 其他 <u>楊榮輝</u> □連附件 |

分發其他分判：

- | |
|-----------------------------------|
| <input type="checkbox"/> 王禮秋 □連附件 |
|-----------------------------------|

分發香港各部門：

- | | | | | |
|-----------------------------------|------------------------------------|-----------------------------------|--|------------|
| <input type="checkbox"/> 行政部 □連附件 | <input type="checkbox"/> 會計部 □連附件 | <input type="checkbox"/> 統籌部 □連附件 | <input type="checkbox"/> 工程部地盤科文 □連附件 | <u>楊榮輝</u> |
| <input type="checkbox"/> 採購部 □連附件 | <input type="checkbox"/> QS 部 □連附件 | <input type="checkbox"/> 維修部 □連附件 | <input type="checkbox"/> 其他 _____ □連附件 | |


傳遞編號：

發件人簽署：Eric Liu

HK 1381 / 18



項目經理簽署：[Signature]

 美特鋁質有限公司 MIDI Aluminium Fabricator Ltd.		工程號:	J-833	計算:	黃漢卿	日期:	2017/02/14	送呈:	Jason	副本:				
		地盤名稱:	白石	核對:	王禮秋	日期:	2017/02/14	A/C Code:						
鋁型材B.M.表		項目類別:	幕牆(屋仔)	批准:		日期:								
BM編號:		修改版次:	EI 6182H	有顏色鋁料(Kg):	105887.3	無電鍍鋁料(Kg):	34910.1	V.F總面積(米 ²):	8068.8					
序號	修改內容	物料編號	鋁料名稱	顏色	合金狀態	長度 (mm)	數量(支)			重量(Kg)		V.F.(米 ²)		備註
							實用	後備	總數	Kg/M	總重量	米 ² /米	Total_V.F.	
1		X85409	公企料(梗窗)	TUC51595XL(RYA)-3(中灰)	6063-T6	3600	143	9	152	5.25	2873.9	0.19	101.8	
2		X85409	公企料(梗窗)	TUC51595XL(RYA)-3(中灰)	6063-T6	4250	19	6	25	5.25	558.0	0.19	19.8	用於GF(3007)和小單元件
3	H(增加數量)	X85410	母企料(梗窗)	TUC51595XL(RYA)-3(中灰)	6063-T6	3600	157	8	165	4.30	2556.6	0.13	79.0	原數量111支
4		X85410	母企料(梗窗)	TUC51595XL(RYA)-3(中灰)	6063-T6	4250	19	6	25	4.30	457.3	0.13	14.1	小單元件
5	H(增加數量)	X85411	公企料(生窗)	TUC51595XL(RYA)-3(中灰)	6063-T6	3600	166	9	175	4.50	2831.9	0.31	197.8	原數量143支
6	H(增加數量)	X85412	母企料(生窗)	TUC51595XL(RYA)-3(中灰)	6063-T6	3600	166	9	175	3.76	2366.9	0.22	139.2	原數量143支
7		X85412	母企料(生窗)	TUC51595XL(RYA)-3(中灰)	6063-T6	4250	1	2	3	3.76	47.9	0.22	2.8	用於GF(3007)
8	H(增加數量)	X85413	公企料(轉角梗窗)	TUC51595XL(RYA)-3(中灰)	6063-T6	3600	153	9	162	7.95	4637.0	0.23	134.1	原數量133支
9		X85413	公企料(轉角梗窗)	TUC51595XL(RYA)-3(中灰)	6063-T6	4250	9	5	14	7.95	473.1	0.23	13.7	用於小單元件
10	H(增加數量)	X85414	母企料(轉角梗窗)	TUC51595XL(RYA)-3(中灰)	6063-T6	3600	157	9	166	6.82	4076.2	0.20	119.5	原數量139支
11		X85414	母企料(轉角梗窗)	TUC51595XL(RYA)-3(中灰)	6063-T6	4250	9	5	14	6.82	405.8	0.20	11.9	用於小單元件
12		X85415	企料(邊位)	TUC51595XL(RYA)-3(中灰)	6063-T6	3600	492	24	516	5.65	10491.7	0.25	457.0	
13		X85415	企料(邊位)	TUC51595XL(RYA)-3(中灰)	6063-T6	4250	54	7	61	5.65	1464.2	0.25	63.8	用於GF(3007)和小單元件
14	H(增加數量)	X85416	公企料(轉角生窗)	TUC51595XL(RYA)-3(中灰)	6063-T6	3600	15	3	18	7.34	475.9	0.44	28.3	原數量6支
14a	H(增加數量)	X85417	母企料(轉角生窗)	TUC51595XL(RYA)-3(中灰)	6063-T6	3600	15	3	18	6.27	406.3	0.37	23.7	原數量6支
15	H(增加數量)	X85418	中企料 x2	TUC51595XL(RYA)-3(中灰)	6063-T6	4500	57	5	62	5.78	1612.3	0.49	136.7	原數量51
16		X85419	底橫(梗窗)	TUC51595XL(RYA)-3(中灰)	6063-T6	5800	181	12	193	7.75	8678.7	0.31	342.5	
17		X85420	頂橫	TUC51595XL(RYA)-3(中灰)	6063-T6	5800	275	20	295	7.55	12914.6	0.26	438.0	
18	H(增加數量)	X85421	中橫梁(梗窗)-弧	TUC51595XL(RYA)-3(中灰)	6063-T6	5800	148	12	160	5.47	5071.5	0.65	598.6	原數量118
19	H(增加數量)	X85422	中橫梁(上生下梗)	TUC51595XL(RYA)-3(中灰)	6063-T6	5800	88	7	95	4.21	2319.2	0.49	268.9	原數量46


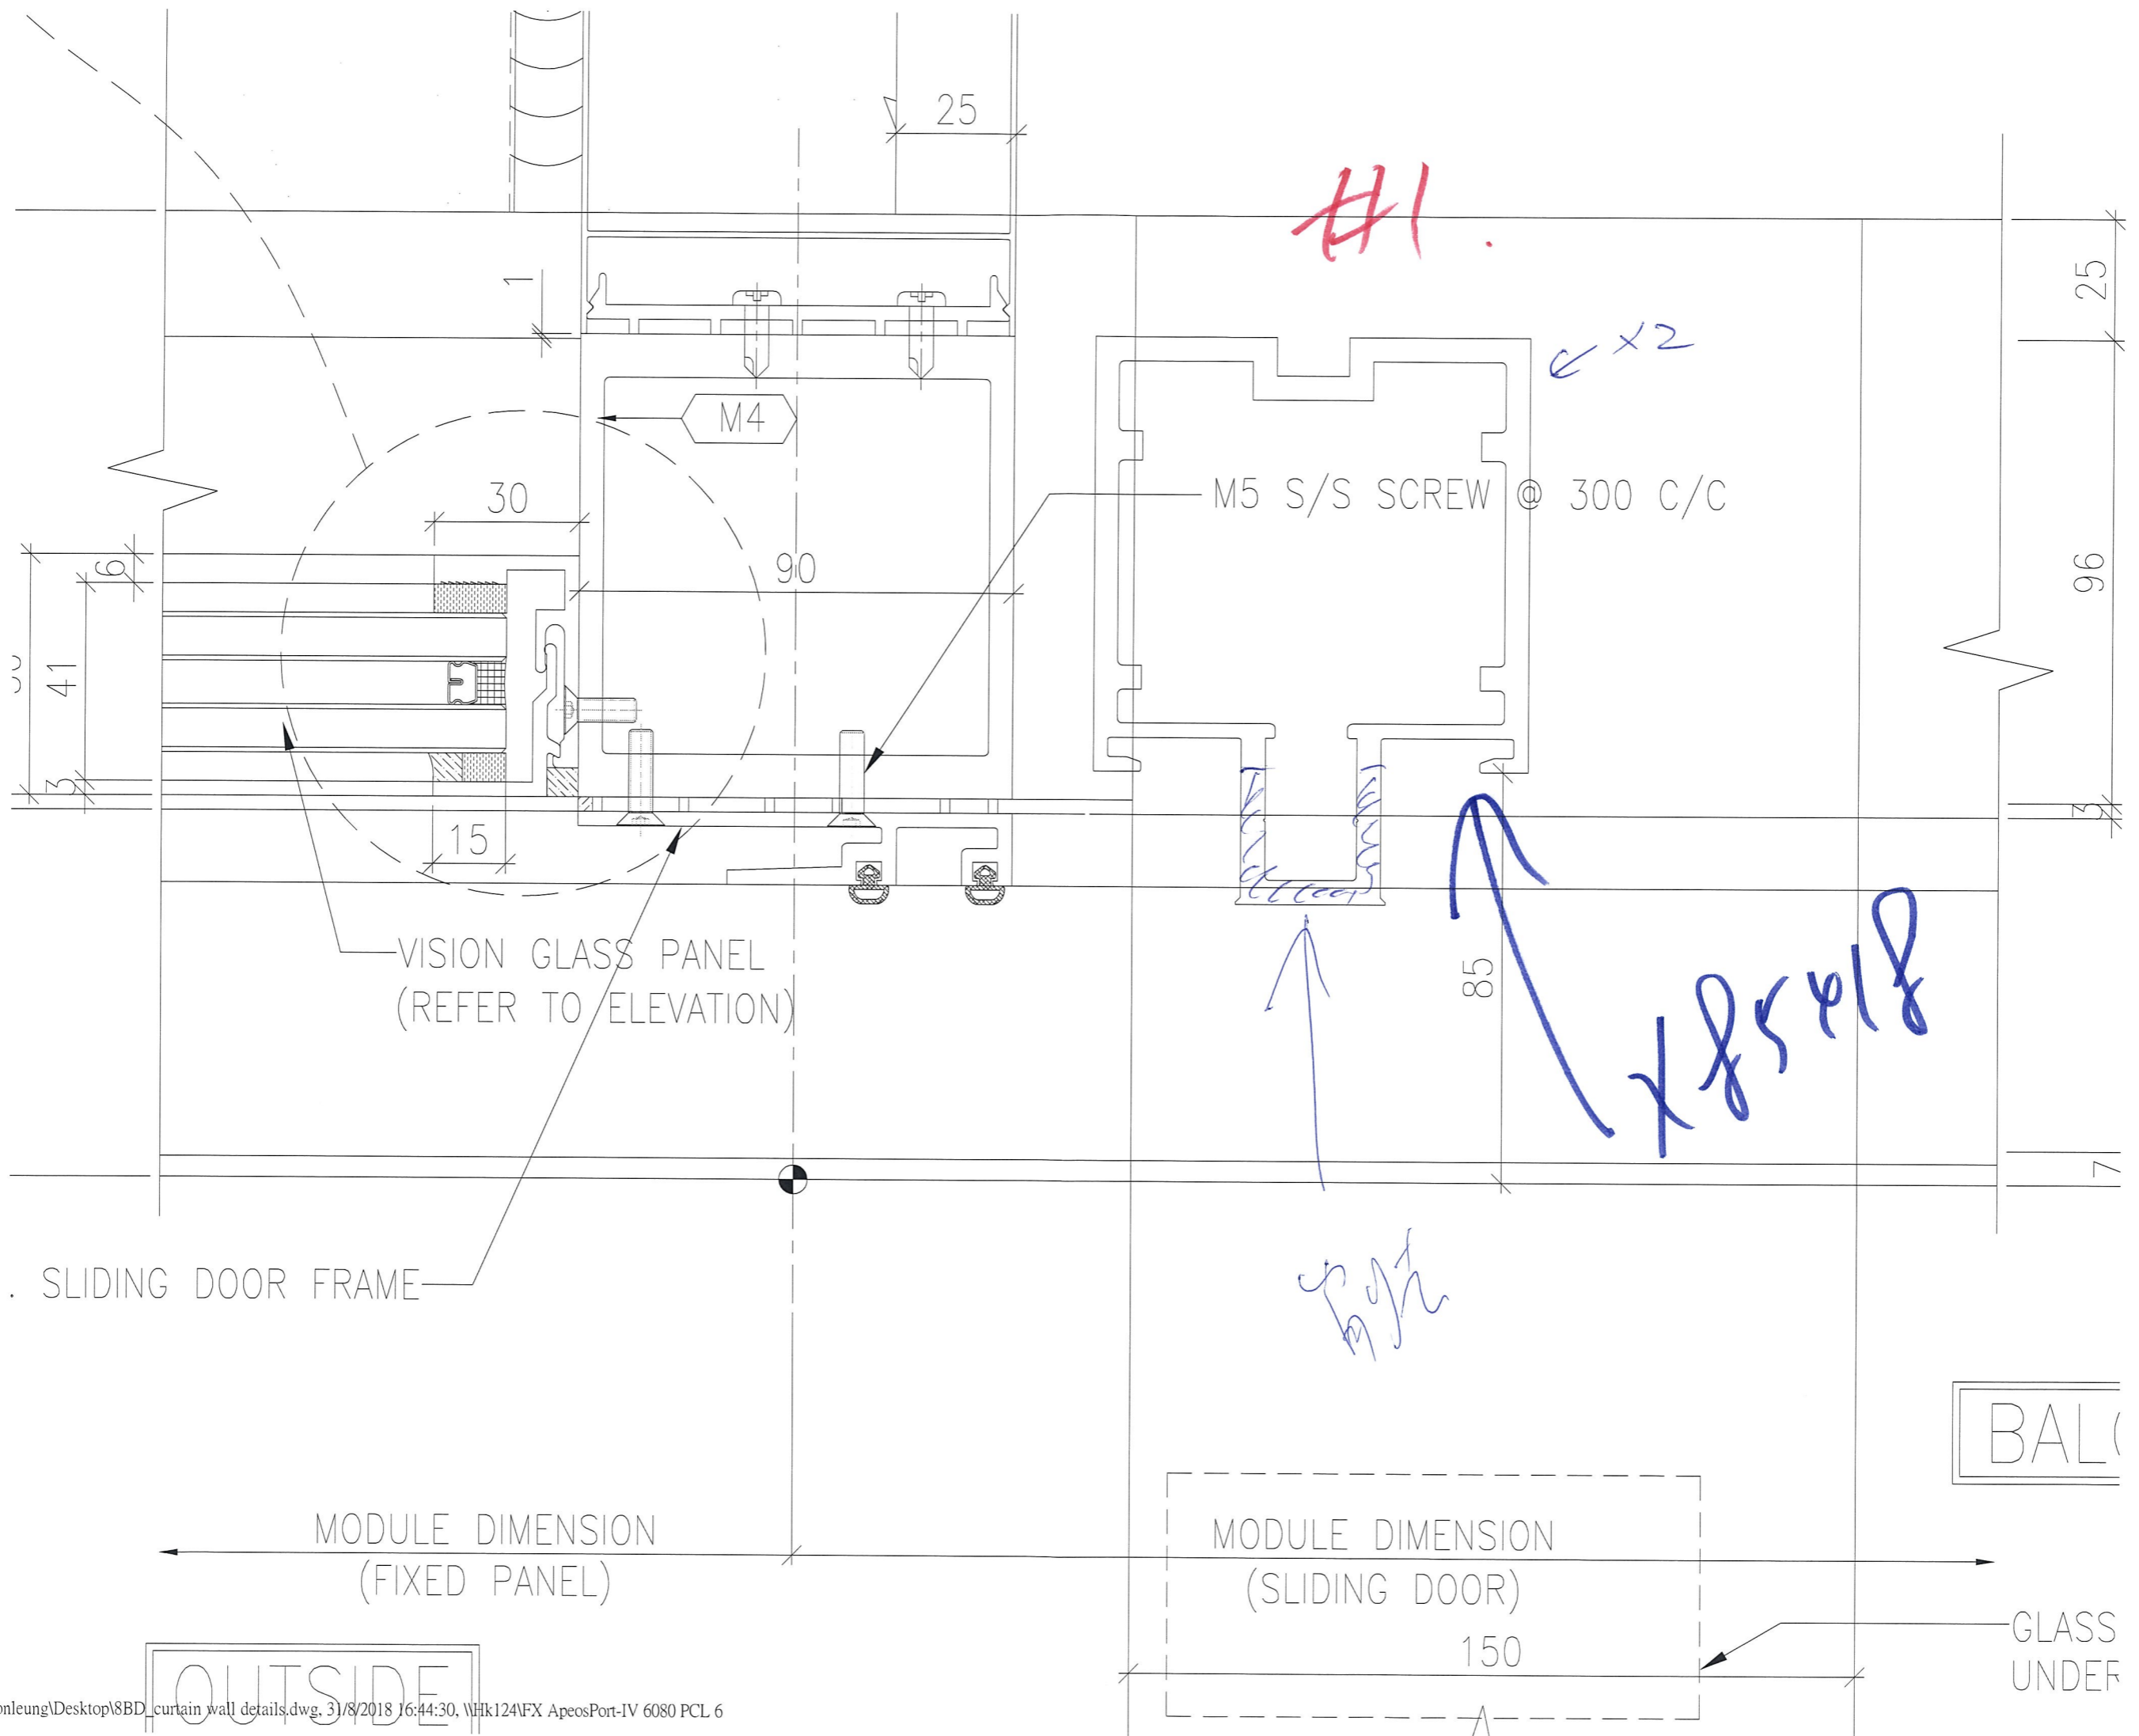


SECTION NO.


X85222

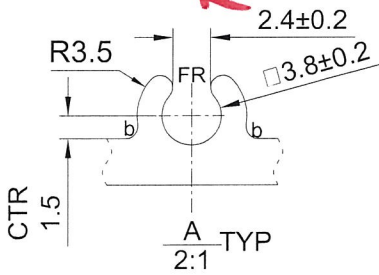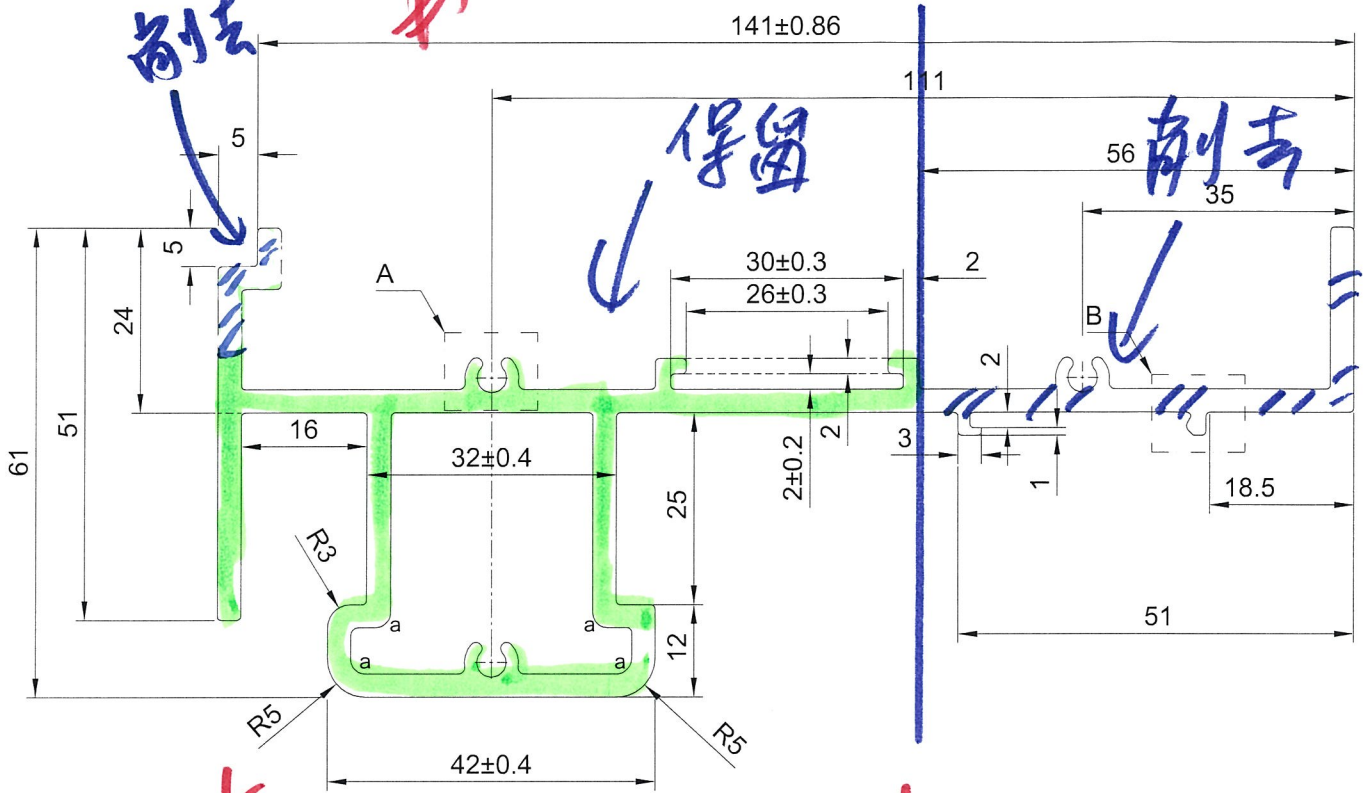

5400mm長
x27

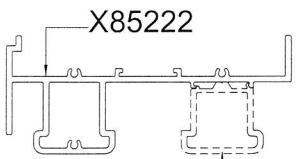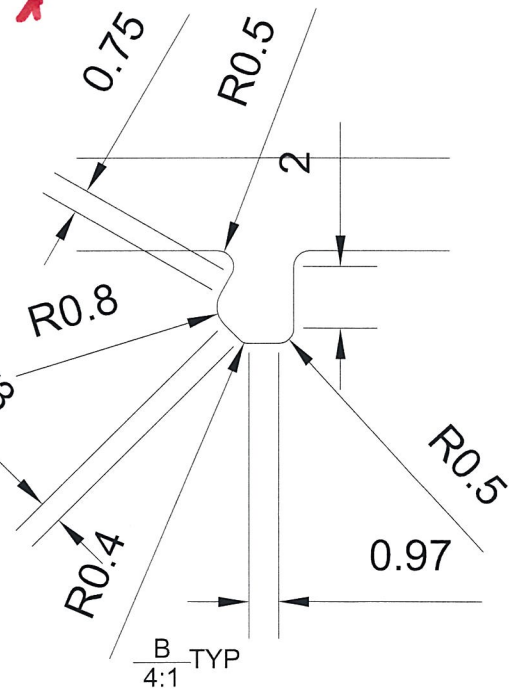

X85223

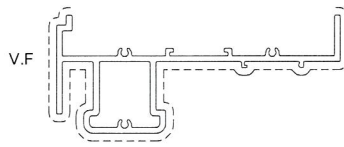

SCALE 1:4






SIGNATURE GRADEING	HIGH SIGNATURE GRADEING	C.C.DIA(MM)	154.65	**a=R2, b=R0.8					
AREA (SQ MM)	1084.33	UNSPECIFIED THICKNESS	3±0.4	PERIMETER (MM)	743.82	STANDARD		SCALE	1:1
MASS (KG/M)	2.928	UNSPECIFIED CORNERS	R=0.5	SURFACE AREA	353.03	ALLOY	6063-T5	VERSION	-
COMPANY ISSUE			DRAWN	KC	DATE	APPELLATION		PAGE OF	
			STANDARDIZATION		15-11-17	-			
			TO SIGN						
			AUDITING						

美特鋁質有限公司
MIDI Aluminium Fabricator Ltd.

SECTION NO.

X85224

Handwritten red mark: 23

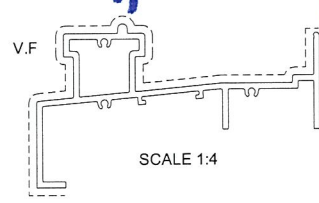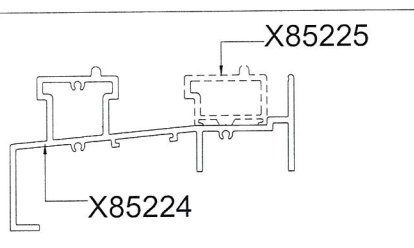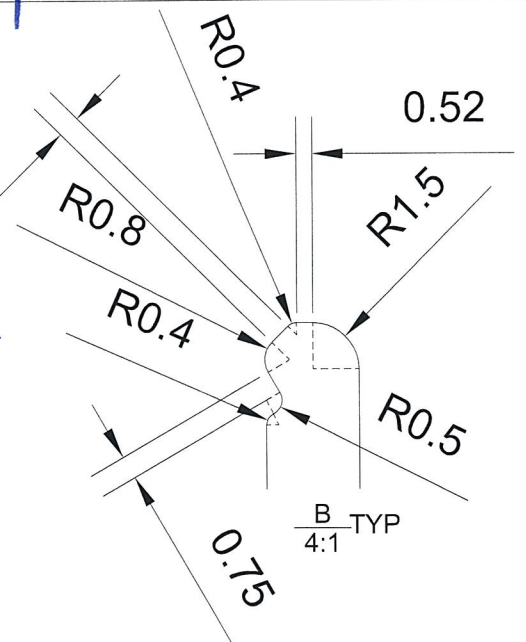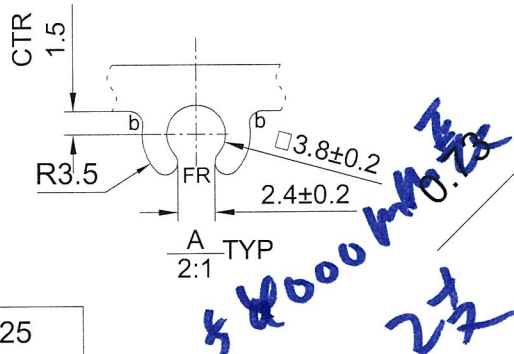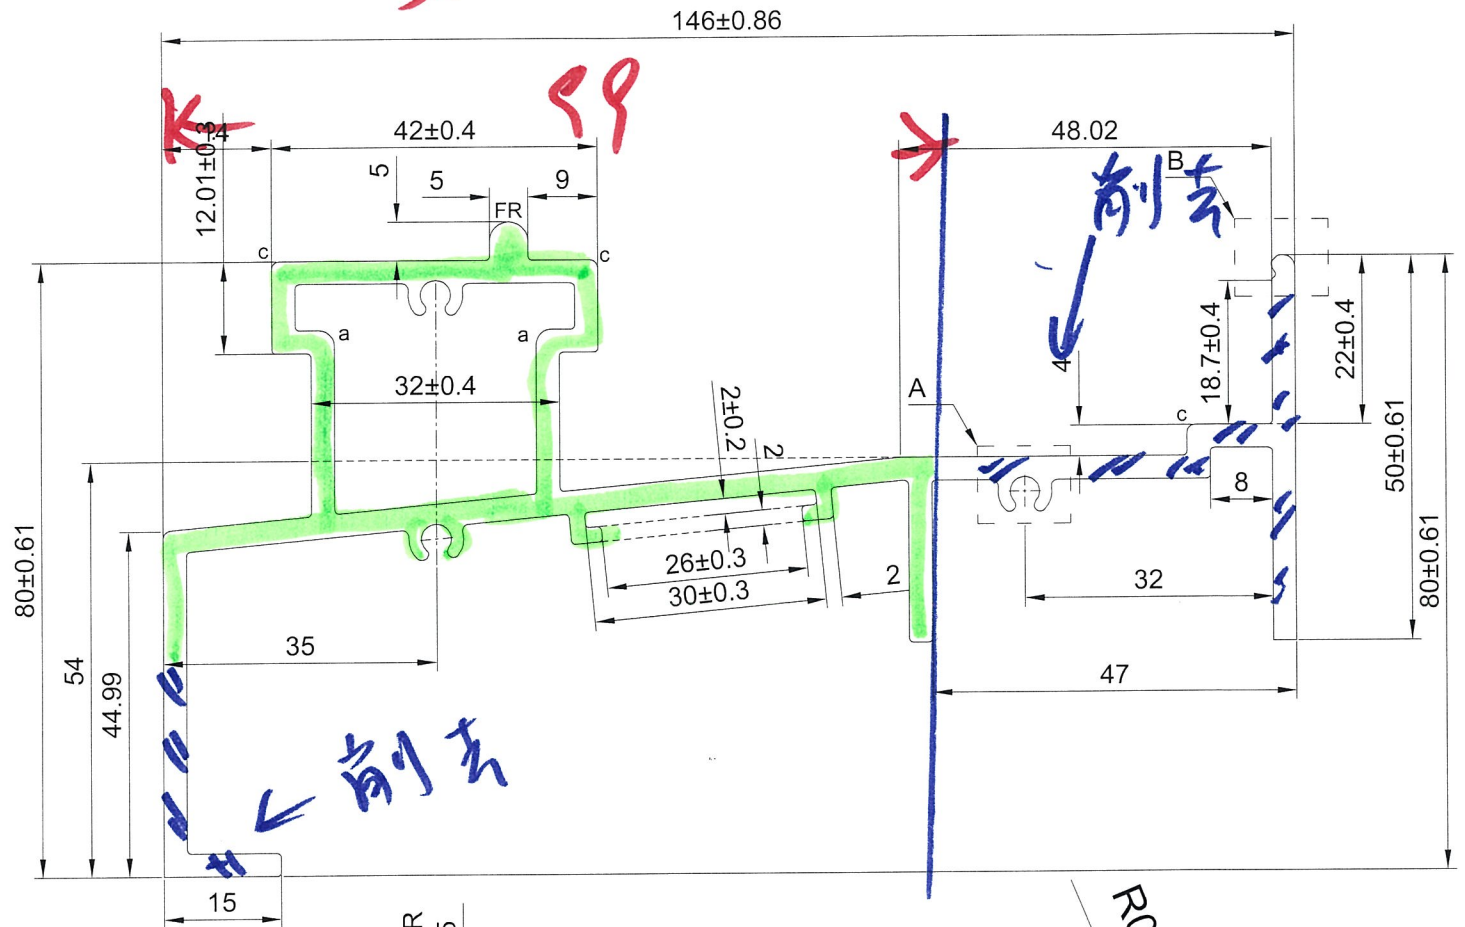

SIGNATURE GRADEING	HIGH SIGNATURE GRADEING	C.C.DIA(MM)	165.88	**a=R2, c=R1					
AREA (SQ MM)	1229.01	UNSPECIFIED THICKNESS	3±0.4	PERIMETER (MM)	826.31	STANDARD		SCALE	1:1
MASS (KG/M)	3.318	UNSPECIFIED CORNERS	R=0.5	SURFACE AREA	353.03	ALLOY	6063-T5	VERSION	-
COMPANY ISSUE			DRAWA	KC	DATE	15-11-14	APELLATION	-	PAGE OF
			STANDA-						
			RDIZATION						
			TO SIGN						
			AUDITING						




V.F. 捲起圖為準


J-831 (教堂里) 提升門鋁料V.F噴圖

Handwritten mark: #2


Handwritten mark: #2

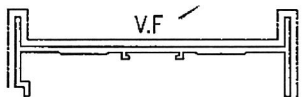


模號: X846340
合金狀態: 6063-T5
名稱: 趟門邊企
重量: 2.1KG/M
V.F.: 268mm

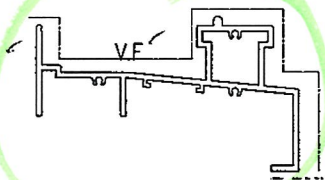


模號: X85224
合金狀態: 6063-T5
名稱: 趟門底橫料
重量: 3.534KG/M
V.F.: 320.46mm

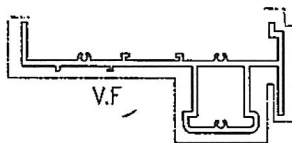

模號: X85222
合金狀態: 6063-T5
名稱: 趟門頂橫料
重量: 3.114KG/M
V.F.: 358.48mm

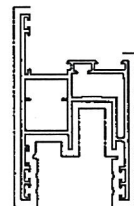


模號: X846310
合金狀態: 6063-T5
名稱: 門玉
重量: 2.55KG/M
V.F.: 444.91mm

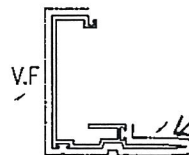

模號: X846280
合金狀態: 6063-T5
名稱: 玉勾企蓋
重量: 1.111KG/M
V.F.: 239mm


要噴

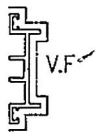


模號: X846270
合金狀態: 6063-T5
名稱: 門企夾邊
重量: 0.725KG/M
V.F.: 129mm




模號: X85223
合金狀態: 6063-T5
名稱: 趟門頂導軌
重量: 1.184KG/M
V.F.: 113.78mm

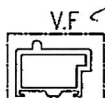

模號: X85225
合金狀態: 6063-T5
名稱: 趟門底導軌
重量: 1.102KG/M
V.F.: 105.71mm

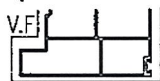


模號: X85226
合金狀態: 6063-T5
名稱: 趟門頂收口
重量: 0.935KG/M
V.F.: 167.42mm

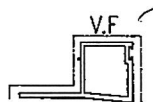


模號: X85227
合金狀態: 6063-T5
名稱: 趟門底收口
重量: 1.124KG/M
V.F.: 141mm




模號: X846290
合金狀態: 6063-T5
名稱: 玻璃線
重量: 0.345KG/M
V.F.: 61mm

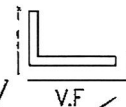

模號: ME0000168
名稱: 32*25*3鋁角
合金狀態: 6063-T5
重量: 0.437KG/M
V.F.: 35 mm

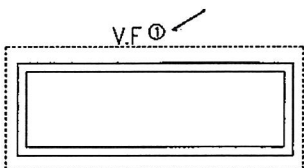

模號: T10000071
合金狀態: 6063-T5
名稱: 50.8X152.4X6.35鋁通
重量: 6.552KG/M
V.F.: 406mm

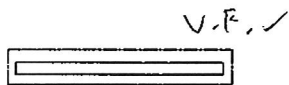

模號: ME0000061
合金狀態: 6063-T5
名稱: 40X2鋁巴
重量: 0.217KG/M
V.F.: 84mm

本來唔係噴，
但學陽收費問題
所以噴埋

Handwritten signature

2/8/17

218/17 07

		美特鋁制有限公司	工程號: J-831	計算: 林仁安	日期: 2017/7/7	送呈: 胡哥								
MIDI Aluminium Fabricator Ltd.		地盤名稱: 香港教堂里	核對:	日期:	副本:									
廠用鋁型材B.M.表		項目類別: 趟門 29/A ~ 33/A	批准:	日期:	此BM依據 HK2171初步施工圖 計算									
BM編號: 831-XXXX		A/C Code:	有顏色鋁料(Kg): 1882	無顏色鋁料(Kg): 127	V.F總面積(米 ²): 249									
序號	修改標示	物料編號	鋁料名稱	顏色	合金狀態	長度	數量(支)			重量(Kgs)		V.F.(米 ²)		備注
						(mm)	實用	後備	總數	Kg/M	總重量	米 ² /米	Total_V.F.	
以下趟門用料														
1		X846340	趟門邊企料	UCT517910XLA-3 (深灰色)	6063-T5	6000	15		15	2.100	189.0	0.268	24.12	
2	→	X85224	趟門底橫料	UCT517910XLA-3 (深灰色)	6063-T5	5000	8		8	3.534	141.4	0.320	12.82	
3	→	X85222	趟門頂橫料	UCT517910XLA-3 (深灰色)	6063-T5	5000	8		8	3.114	124.6	0.358	14.34	
4		X85225	趟門底導軌	UCT517910XLA-3 (深灰色)	6063-T5	5000	4		4	1.102	22.0	0.106	2.11	
5		X85223	趟門頂導軌	UCT517910XLA-3 (深灰色)	6063-T5	5000	4		4	1.184	23.7	0.114	2.28	
6		X85226	趟門頂收口	UCT517910XLA-3 (深灰色)	6063-T5	5000	4		4	0.935	18.7	0.167	3.35	
7		X85227	趟門底收口	UCT517910XLA-3 (深灰色)	6063-T5	5000	4		4	1.124	22.5	0.141	2.82	
8		X846310	趟門玉料	UCT517910XLA-3 (深灰色)	6063-T5	5500	42	2	44	2.550	617.1	0.445	107.67	
9		X846270	趟門邊夾企	UCT517910XLA-3 (深灰色)	6063-T5	5700	15		15	0.725	62.0	0.129	11.03	
10		X846280	趟門玉企蓋	UCT517910XLA-3 (深灰色)	6063-T5	5700	15		15	1.111	95.0	0.239	20.43	
11		X846290	趟門玻璃線	UCT517910XLA-3 (深灰色)	6063-T5	5500	42	5	47	0.345	89.2	0.061	15.77	
12		ME0000061	40*2鋁巴	UCT517910XLA-3 (深灰色)	6063-T5	5000	8		8	0.217	8.7	0.084	3.36	趟門底用
13		ME0000168	32*25*3鋁角	UCT517910XLA-3 (深灰色)	6063-T5	5000	4		4	0.437	8.7	0.035	0.70	趟門底用
14		TI0000071	50.8*152.4*6.35鋁通	UCT517910XLA-3 (深灰色)	6063-T5	5850	12		12	6.552	460.0	0.406	28.50	趟門邊用
15		TI0000046	76.2*76.2*6.35鋁角	MILL	6063-T5	5700	1		1	2.537	14.5			門玉組裝用
16		PE00E4040	65*5鋁巴	MILL	6063-T5	5700	15		15	0.878	75.1			門玉組裝用
17		LH0082045	18*18*2鋁角	MILL	6063-T5	6000	30		30	0.184	33.1			邊企檔膠
18		ME0003002	25*25*2鋁通	MILL	6063-T5	6000	1		1	0.497	3.0			邊企墊通
19		GY0000009	30*20*1.2鋁通	MILL	6063-T5	5700	1		1	0.310	1.8			梗門玉底墊塊用
											2009.8	249.30		
因初步大圖都未敲定，以上數據僅供參考！														

好
好



EG-DWG3

美特鋁質有限公司
MIDI Aluminium Fabricator Ltd.

工程號 J-833 地盤 白石

#4

不在此孔

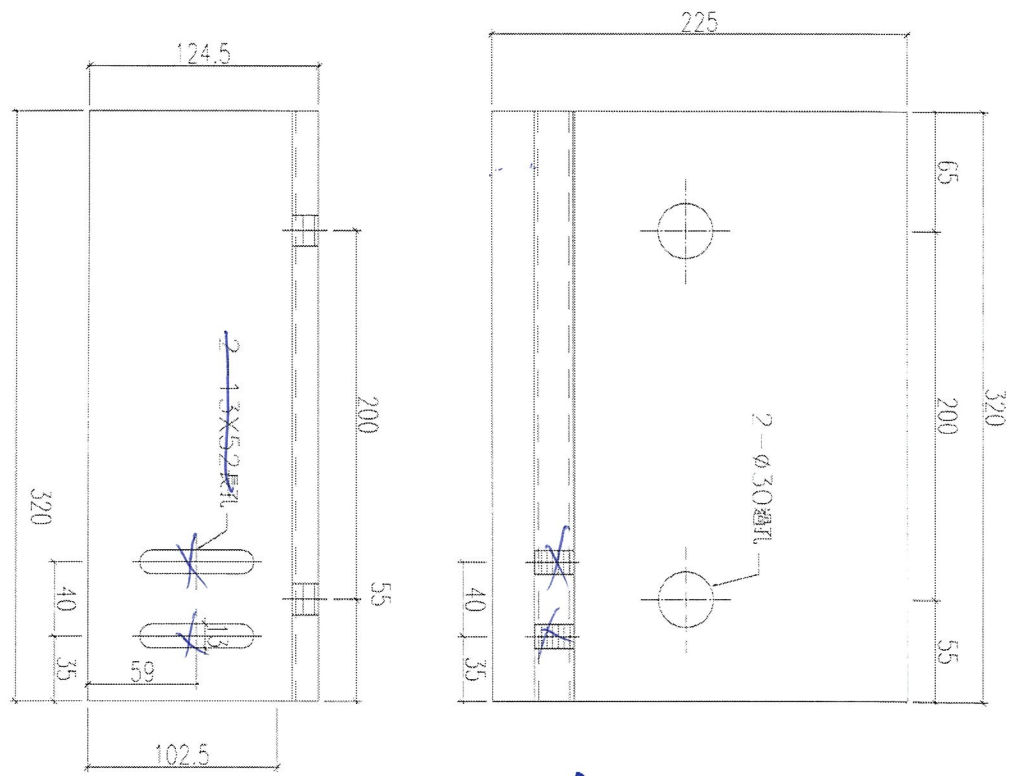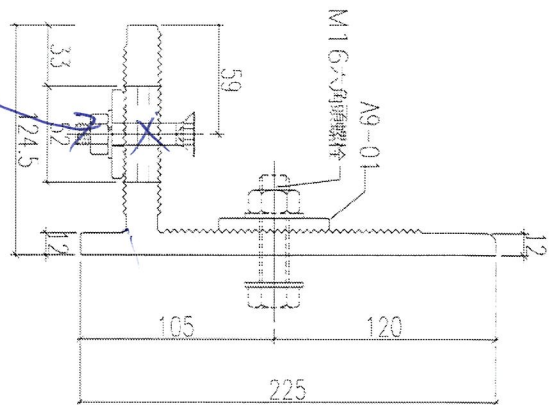


16隻

X85K59

數量	59+8 (預多)
----	-----------

名稱	鐵邊加工圖	制圖	黃漢卿	2017.6.26	修改
材料	X85459	復核	王禮秋	2017.6.28	日期
顏色	MILL	批准			圖號 AB03-02R 34

#5

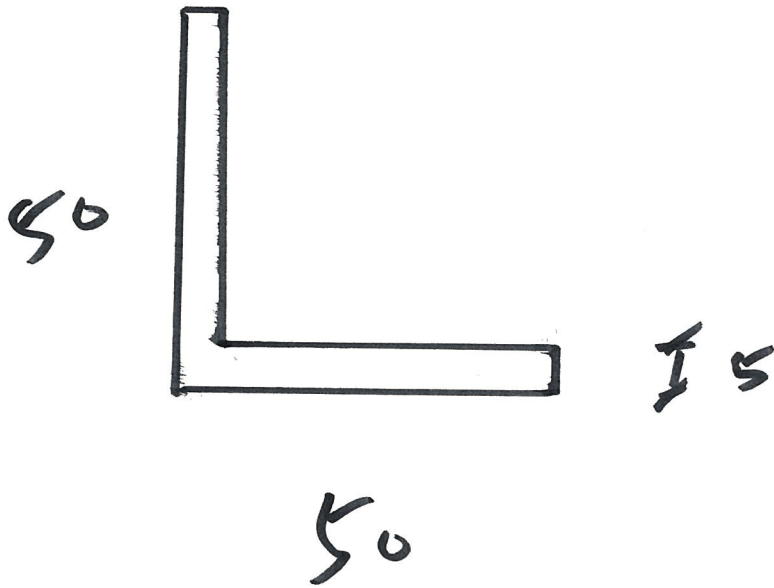

~~Area~~ $50 + 50 + 5$ $L = 100, 20 \text{ 个}$
 $L = 3000, 10 \text{ 个}$

