



工程指示 / 要求簡箋(E.I.)

工程指示編號：EI / 9853 / 19

修改版次：C

工程編號：J - 837

工程名稱：觀塘裕民坊

工程項目：佛沙窗轉後裝窗 新增 access panel

收件人：生統 / 永林

發件人：Bessie

日期：07/01/2019

要求提供 /  確認 事項：

- |                                    |                                     |                               |
|------------------------------------|-------------------------------------|-------------------------------|
| <input type="checkbox"/> 初步鋁料 B.M. | <input type="checkbox"/> 加工拆圖，然後生產  | <input type="checkbox"/> 尺寸表  |
| <input type="checkbox"/> 正式鋁料 B.M. | <input type="checkbox"/> 技術上資料 / 指示 | <input type="checkbox"/> 報價   |
| <input type="checkbox"/> 配件 B.M.   | <input type="checkbox"/> 樣辦或貨品說明書   | <input type="checkbox"/> 分判合約 |
| <input type="checkbox"/> 其他：_____  |                                     |                               |

內容：

現新增附件之 access panel, 煩請提供鋁料 bm 及拆圖, 煩請幫忙優先拆圖, 特急!

\*\*\*access panel 的樓層及數量請按附件 PDF 為準

附 CAD 檔, 文件夾名稱: J-837 佛沙窗改後裝窗施工圖 (第二次) (2019-1-7)

請在 8/1/19 前完成上列要求。

特急!

附： 頁

以上項目為：

- |                                 |                                      |                                |
|---------------------------------|--------------------------------------|--------------------------------|
| <input type="checkbox"/> 原合約工程包 | <input type="checkbox"/> 原合約工程加 / 減賬 | <input type="checkbox"/> 新工程報價 |
|---------------------------------|--------------------------------------|--------------------------------|

原因：-

分發東莞各部門：

- |  |   |    |   |  |
|--|---|----|---|--|
| <input type="checkbox"/> 生產技術總監 <input type="checkbox"/> 連附件 | <input checked="" type="checkbox"/> 技術部 <input checked="" type="checkbox"/> 連附件   | 永林 | <input type="checkbox"/> 生產部 <input type="checkbox"/> 連附件 | <input type="checkbox"/> 機械設計部 <input type="checkbox"/> 連附件    |
| <input type="checkbox"/> 採購部 <input type="checkbox"/> 連附件    | <input checked="" type="checkbox"/> 生產統籌部 <input checked="" type="checkbox"/> 連附件 | 梅姐 |   |  |
| <input type="checkbox"/> 質檢部 <input type="checkbox"/> 連附件    | <input type="checkbox"/> 會計部 <input type="checkbox"/> 連附件                         |    | <input type="checkbox"/> 報關組 <input type="checkbox"/> 連附件 | <input type="checkbox"/> 其他 _____ <input type="checkbox"/> 連附件 |

分發香港各部門：

- |   |  |   |  |    |
|---|--|---|--|----|
| <input type="checkbox"/> 行政部 <input type="checkbox"/> 連附件 | <input type="checkbox"/> 會計部 <input type="checkbox"/> 連附件  | <input type="checkbox"/> 統籌部 <input type="checkbox"/> 連附件 | <input type="checkbox"/> 工程部地盤科文 <input type="checkbox"/> 連附件  | 炳哥 |
| <input type="checkbox"/> 採購部 <input type="checkbox"/> 連附件 | <input type="checkbox"/> QS 部 <input type="checkbox"/> 連附件 | <input type="checkbox"/> 維修部 <input type="checkbox"/> 連附件 | <input type="checkbox"/> 其他 _____ <input type="checkbox"/> 連附件 |    |

傳遞編號：HK 0059 / 19

發件人簽署：

項目經理簽署：

PROJECT :

URA KWUN TONG TOWN CENTRE  
REDEVELOPMENT (AREA 2 & 3) AT NKIL 6514, KWUN TONG, KOWLOON

2

7/1/19 2019

TITLE : SHOP DRAWING FOR PRECAST WINDOW CHANGES TO IN SITU  
FOR TOWER 1&3(FROM 6/F TO 11/F) AND TOWER 2&5( (FROM 6/F TO 17/F)

DATE: 13-DEC - 2018

# DRAWING SUBMISSION REGISTER

PROJECT: URA KWUN TONG TOWN CENTRE REDEVELOPMENT (AREA 2 & 3) AT NKIL 6514, KWUN TONG, KOWLOON	DATE OF ISSUE										SUBMISSION STATE (FOR B.D / A.S.D)			SUBMISSION STATE (FOR CLIENT / CONSULTANT)			SUBMISSION STATE (FOR ARCHITECT)			FABRICATION / CONSTRUCTION STATE						
	ISSUE	01	02									AP - APPROVED			AP - APPROVED			AP - APPROVED			ISSUE TO CHINA OFFICE		ISSUE TO SITE		ISSUE TO SUB-CONTRACTOR	
	DAY	15	7								AC - APPROVED SUB. TO CONDITION			AC - APPROVED SUB. TO CONDITION			AC - APPROVED SUB. TO CONDITION									
	MONTH	10	1								NA - NOT APPROVED			NA - NOT APPROVED			NA - NOT APPROVED									
	YEAR	18	19																							
DRAWING TITLE	DWG. NO.	REVISIONS								COMMENT DATE	REV.	STATE	COMMENT DATE	REV.	STATE	COMMENT DATE	REV.	STATE	REV.	DATE	REV.	DATE	REV.	DATE		
COVERPAGE	J-837-PIW-0000	-	A																							
DRAWING SUBMISSION REGISTER	J-837-PIW-0001	-	A																							
DRAWING SUBMISSION REGISTER	J-837-PIW-0002	-	A																							
GENERAL NOTE OF ALUM. WINDOW	J-837-PIW-0003	-	-																							
SECTION PROFILE FOR ALUM. WINDOW	J-837-PIW-0004	-	-																							
TYPICAL ALUM. WINDOW SCHEDULE	J-837-PIW-2101	-	-																							
TYPICAL ALUM. WINDOW SCHEDULE	J-837-PIW-2102	-	-																							
TYPICAL ALUM. WINDOW SCHEDULE	J-837-PIW-2103	-	-																							
TYPICAL ALUM. WINDOW SCHEDULE	J-837-PIW-2104	-	-																							
TYPICAL ALUM. WINDOW SCHEDULE	J-837-PIW-2105	-	-																							
TYPICAL ALUM. WINDOW SCHEDULE	J-837-PIW-2106	-	-																							
TYPICAL ALUM. WINDOW SCHEDULE	J-837-PIW-2107	-	-																							
TYPICAL ALUM. WINDOW SCHEDULE	J-837-PIW-2108	-	-																							
TYPICAL ALUM. WINDOW SCHEDULE	J-837-PIW-2109	-	-																							
TYPICAL ALUM. WINDOW SCHEDULE	J-837-PIW-2110	-	-																							
TYPICAL ALUM. WINDOW SCHEDULE	J-837-PIW-2111	-	-																							
TYPICAL ALUM. WINDOW SCHEDULE	J-837-PIW-2112	-	A																							
TYPICAL ALUM. WINDOW SCHEDULE	J-837-PIW-2113	-	-																							
TYPICAL ALUM. WINDOW SCHEDULE	J-837-PIW-2114	-	-																							
TYPICAL ALUM. WINDOW SCHEDULE	J-837-PIW-2115	-	-																							
TYPICAL ALUM. WINDOW SCHEDULE	J-837-PIW-2301	-	-																							

IN-HOUSE DESIGN CHECKER


  
**MIDI ALUMINIUM FABRICATOR LTD.**  
 Units 6-8, Sunray Industrial Centre, 1/F  
 610 Cho Kwo Ling Road, Kowloon  
 Tel: 23469211-4 Fax: (852) 27727666


# DRAWING SUBMISSION REGISTER

PROJECT: URA KWUN TONG TOWN CENTRE REDEVELOPMENT (AREA 2 & 3) AT NKIL 6514, KWUN TONG, KOWLOON	DATE OF ISSUE							SUBMISSION STATE (FOR B.D / A.S.D)			SUBMISSION STATE (FOR CLIENT / CONSULTANT)			SUBMISSION STATE (FOR ARCHITECT)			FABRICATION / CONSTRUCTION STATE					
	ISSUE	01	02					AP - APPROVED			AP - APPROVED			AP - APPROVED			ISSUE TO CHINA OFFICE	ISSUE TO SITE	ISSUE TO SUB-CONTRACTOR			
	DAY	30	13					AC - APPROVED SUB. TO CONDITION			AC - APPROVED SUB. TO CONDITION			AC - APPROVED SUB. TO CONDITION								
	MONTH	10	12					NA - NOT APPROVED			NA - NOT APPROVED			NA - NOT APPROVED								
	YEAR	18	18																			
DRAWING TITLE	DWG. NO.	REVISIONS					COMMENT DATE	REV.	STATE	COMMENT DATE	REV.	STATE	COMMENT DATE	REV.	STATE	REV.	DATE	REV.	DATE	REV.	DATE	
TYPICAL ALUM. WINDOW SCHEDULE	J-837-PIW-2502	-	-																			
TYPICAL ALUM. WINDOW SCHEDULE	J-837-PIW-2503	-	-																			
TYPICAL ALUM. WINDOW SCHEDULE	J-837-PIW-2504	-	-																			
TYPICAL ALUM. WINDOW SCHEDULE	J-837-PIW-2505	-	-																			
TYPICAL ALUM. WINDOW SCHEDULE	J-837-PIW-2506	-	-																			
TYPICAL ALUM. WINDOW SCHEDULE	J-837-PIW-2507	-	-																			
TYPICAL ALUM. WINDOW SCHEDULE	J-837-PIW-2508	-	-																			
TYPICAL ALUM. WINDOW SCHEDULE	J-837-PIW-2509	-	-																			
FULL PLAN LAYOUT (FOR T1 6/F FLOOR PLAN)	J-837-PIW-3101	-	A																			
FULL PLAN LAYOUT (FOR T1 TYPICAL FLOOR PLAN)	J-837-PIW-3102	-	A																			
FULL PLAN LAYOUT (FOR T2 6/F FLOOR PLAN)	J-837-PIW-3201	-	A																			
FULL PLAN LAYOUT (FOR T2 TYPICAL FLOOR PLAN)	J-837-PIW-3202	-	A																			
FULL PLAN LAYOUT (FOR T3 6/F FLOOR PLAN)	J-837-PIW-3301	-	A																			
FULL PLAN LAYOUT (FOR T3 TYPICAL FLOOR PLAN)	J-837-PIW-3302	-	A																			
FULL PLAN LAYOUT (FOR T5 6/F FLOOR PLAN)	J-837-PIW-3501	-	A																			
LOW ZONE LAYOUT (FOR T5 7/F-21/F FLOOR PLAN)	J-837-PIW-3502	-	A																			
TYPICAL DETAIL FOR ALUM. WINDOW	J-837-PIW-5001	-	-																			
TYPICAL DETAIL FOR ALUM. WINDOW	J-837-PIW-5002	-	-																			
TYPICAL DETAIL FOR ALUM. WINDOW	J-837-PIW-6001	-	-																			
TYPICAL DETAIL FOR ALUM. WINDOW	J-837-PIW-6002	-	-																			
TYPICAL DETAIL FOR ALUM. WINDOW	J-837-PIW-6003	-	-																			
TYPICAL DETAIL FOR ALUM. WINDOW	J-837-PIW-6004	-	-																			
ALUM. WINDOW SECTION FIXING DETAIL	J-837-PIW-8001	-	-																			
ALUM. SIDE HUNG WINDOW TYPICAL LOCK & HINGES DETAIL	J-837-PIW-8002	-	-																			
G.M.S. FIXING LUG TYPICAL DETAIL	J-837-PIW-8003	-	-																			
TYPICAL EARTHING BONDING DETAILS OF PRECAST	J-837-PIW-8004	-	-																			

IN-HOUSE DESIGN CHECKER

**英特鋁質有限公司**  
**MIDI ALUMINIUM FABRICATOR LTD.**  
 Units 6-8, Sunray Industrial Centre, 1/F  
 610 Cha Kwo Ling Road, Kowloon  
 Tel: 23489211-4 Fax: (852) 27276666

ELEVATION

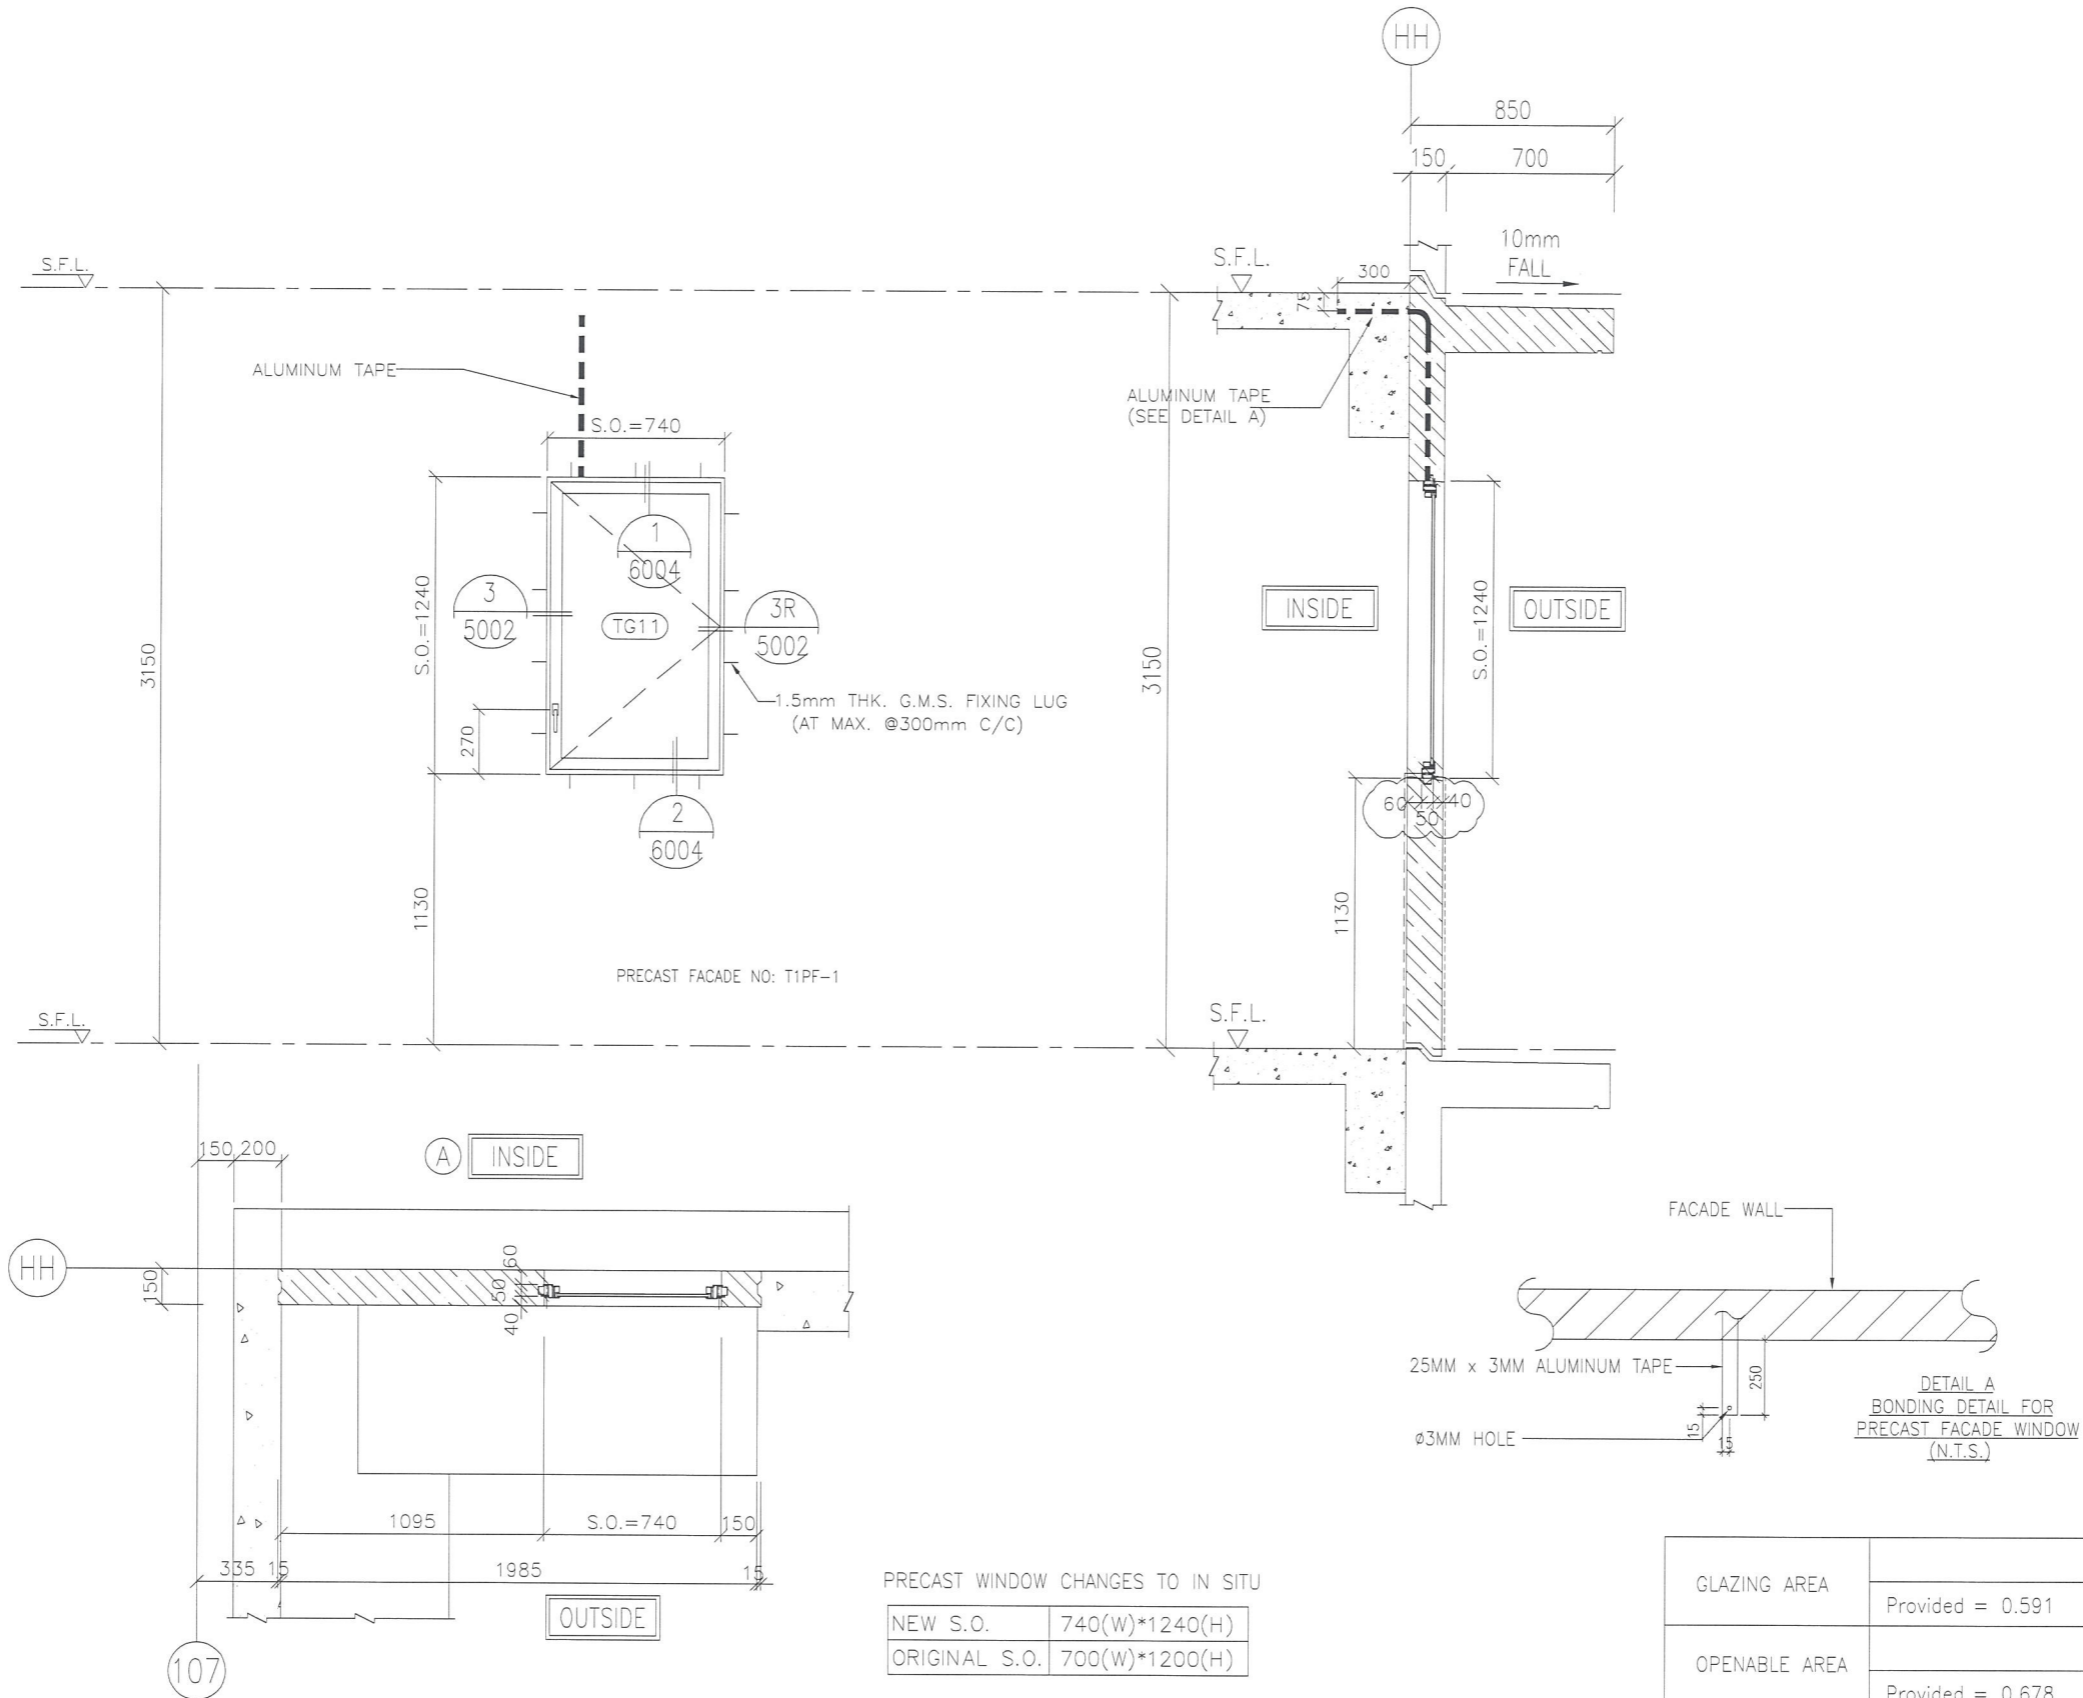

B.D. REF :

CLIENT :  
 信和置業有限公司  
 Sino Land Company Limited



ARCHITECT :  
 WONG TUNG & PARTNERS LIMITED  
 ARCHITECTS & PLANNERS

MAIN CONTRACTOR :  
 CR Construction Company Limited

STRUCTURAL ENGINEER :  
 AECOM

FAÇADE CONSULTANT :

NOTE :  
 1. ALL DIMENSIONS ARE IN mm.  
 2. ALL ELEVATIONS ARE VIEWED FROM OUTSIDE.  
 3. ALL DIMENSIONS TO BE VERIFIED ON SITE BEFORE FABRICATION.

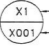
LEGEND :  
 X1 --- DETAIL MARK NO.  
 X001 --- REFER SHEET NO.  
 1. F.F.L. --- FINISHED FLOOR LEVEL  
 2. S.F.L. --- STRUCTURAL FLOOR LEVEL  
 3. (R) --- REVERSED DETAIL

NO.	DATE	REVISED	BY

JOB NO. : J-837  
 PROJECT :  
 URA KWUN TONG TOWN CENTRE  
 REDEVELOPMENT (AREA 2 & 3) AT  
 NKIL 6514, KWUN TONG, KOWLOON

TITLE :  
 ALUM. WINDOW SCHEDULE  
 (FOR T1)

DATE : 30-AUG-18 SCALE : 1:30  
 DRAWN BY : Zeng CHECKED BY : DW

 英特鋁質有限公司  
 MIDI ALUMINIUM FABRICATOR LTD.  
 Units 6-8, Sunray Industrial Centre, 1/F  
 610 Cha Kwo Ling Road, Kowloon  
 Tel: 23489211-4 Fax: (852) 2727666

DWG NO. : J837-PIW-2117 REV. : -

WINDOW MARK



SECTION :

50mm ALUM. SECTION

QTY.

23 NOS. (TYPICAL)(TO BE CONFIRMED)

LOCATION :

6/F-26/F, 28/F-32/F COMMON CORRIDOR(TO BE CONFIRMED)


GLAZING

8mm THK CLEAR TEMPERED GLASS

REMARK :

ACCESS PANEL

ELEVATION

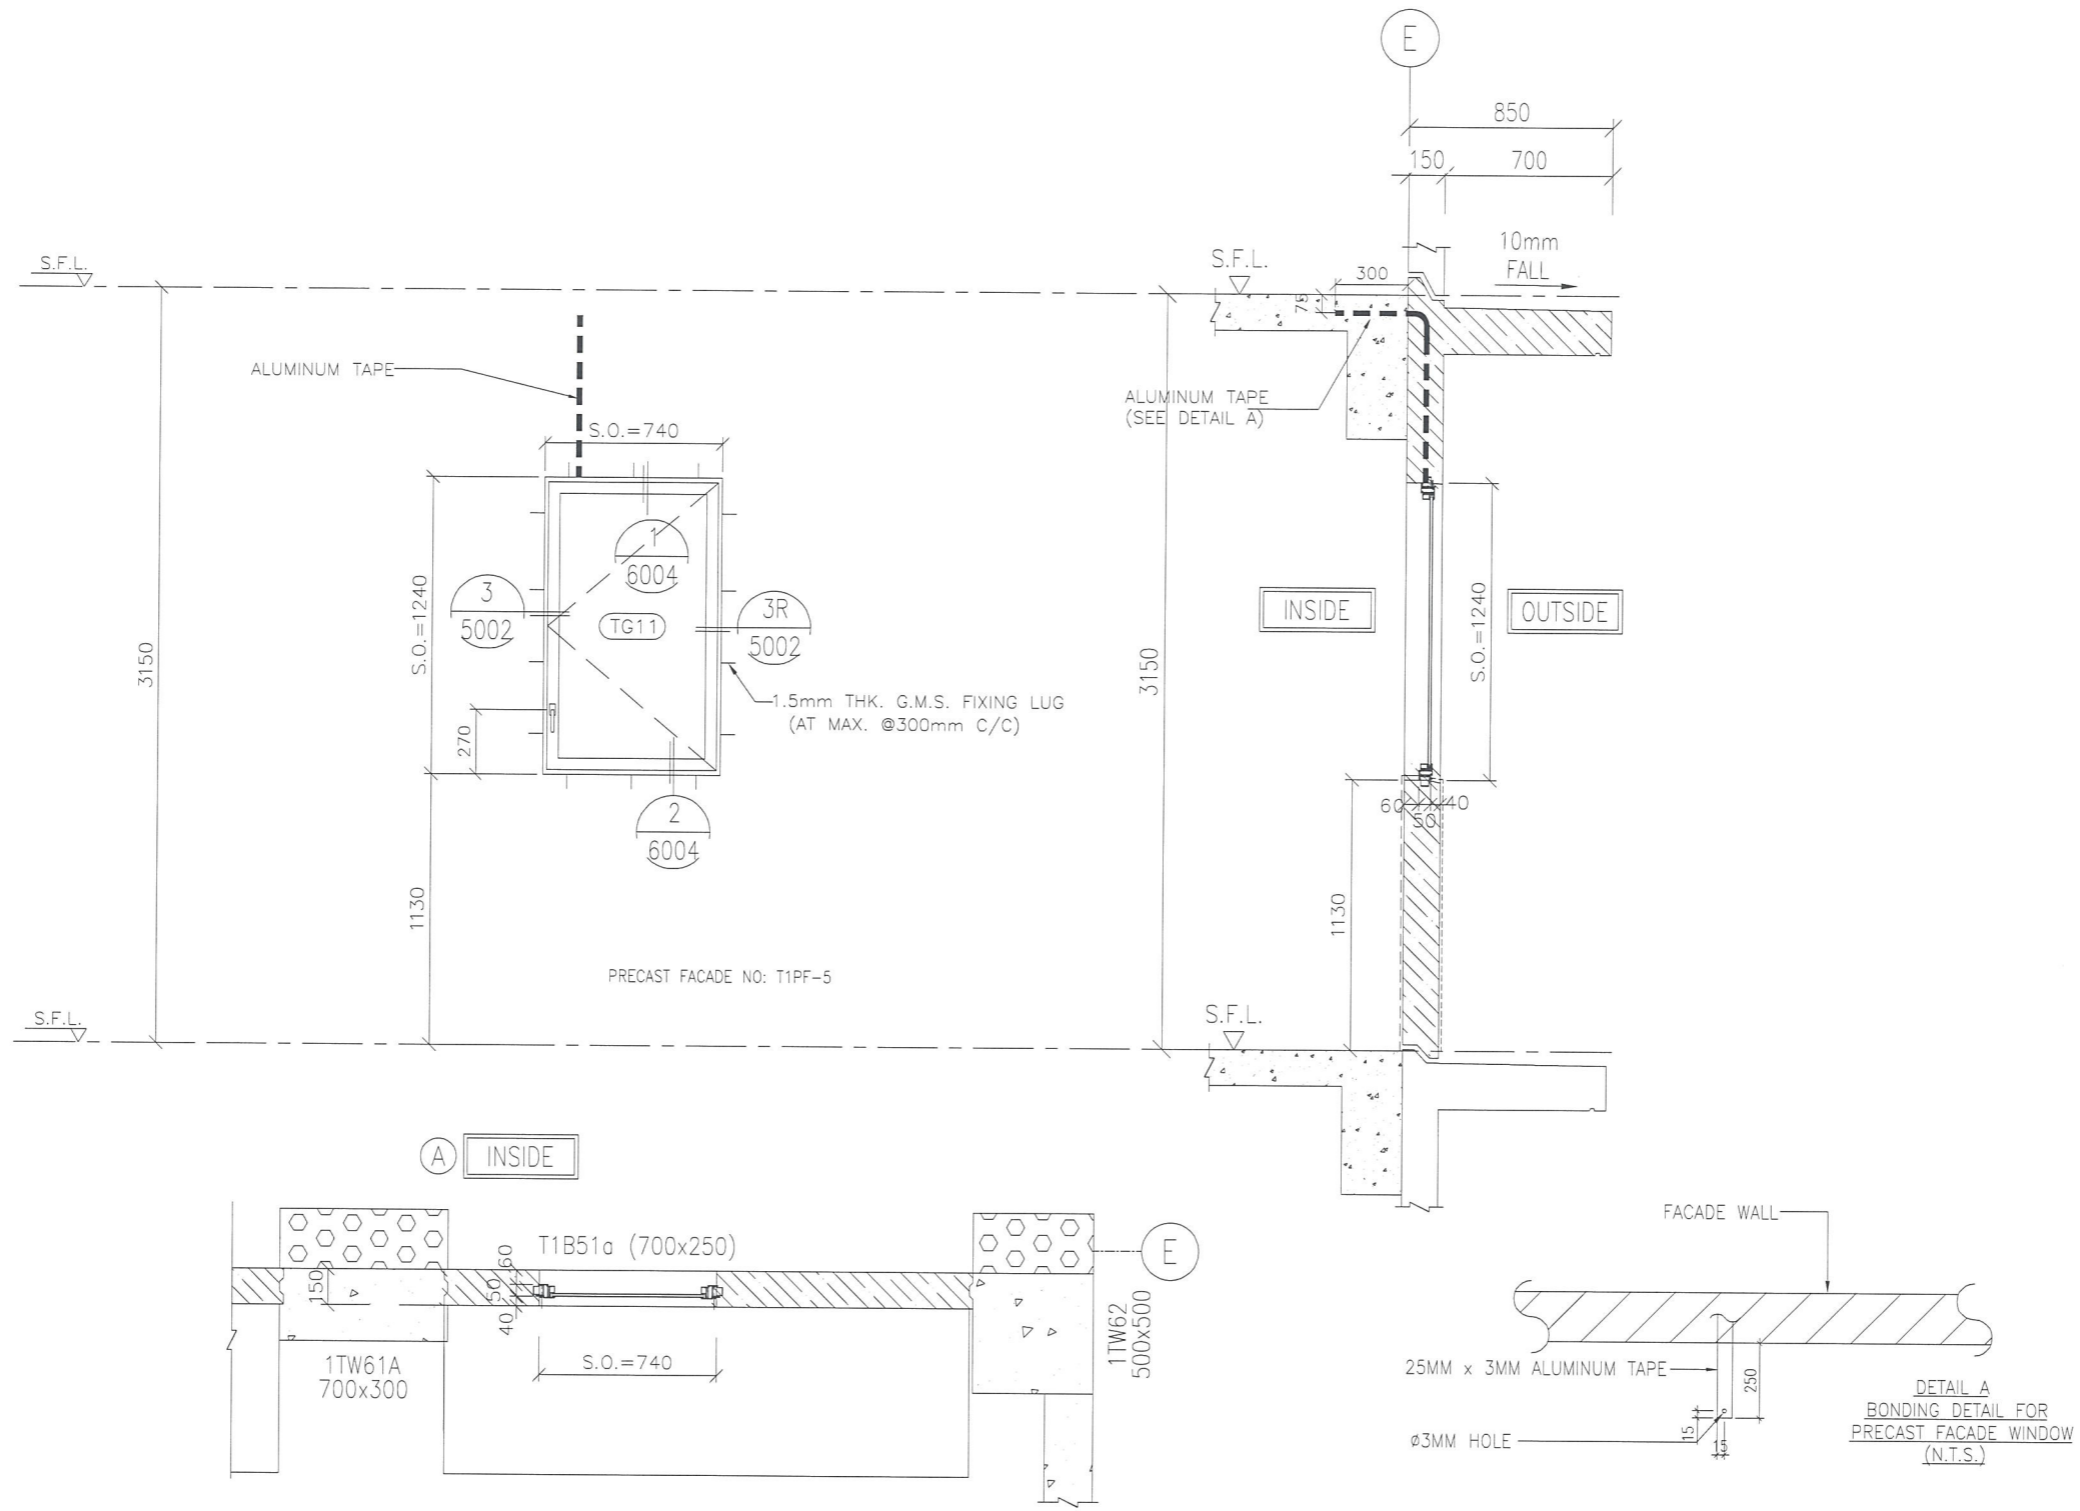

PRECAST WINDOW CHANGES TO IN SITU

NEW S.O.	740(W)*1240(H)
ORIGINAL S.O.	700(W)*1200(H)

GLAZING AREA	Provided = 0.591
OPENABLE AREA	Provided = 0.678

WINDOW MARK	
SECTION :	50mm ALUM. SECTION
QTY.	23 NOS. (TYPICAL)(TO BE CONFIRMED)
LOCATION :	6/F-26/F, 28/F-32/F COMMON CORRIDOR(TO BE CONFIRMED)
GLAZING	8mm THK CLEAR TEMPERED GLASS
REMARK :	ACCESS PANEL

B.D. REF :

CLIENT :  
 信和置業有限公司  
 Sino Land Company Limited

ARCHITECT :  
 WONG TUNG & PARTNERS LIMITED  
 ARCHITECTS & PLANNERS

MAIN CONTRACTOR :  
 CR Construction Company Limited

STRUCTURAL ENGINEER :  
 AECOM


FACADE CONSULTANT:

NOTE :  
 1. ALL DIMENSIONS ARE IN mm.  
 2. ALL ELEVATIONS ARE VIEWED FROM OUTSIDE.  
 3. ALL DIMENSIONS TO BE VERIFIED ON SITE BEFORE FABRICATION.

LEGEND :  
 X1 --- DETAIL MARK NO.  
 X001 --- REFER SHEET NO.  
 1. F.F.L. --- FINISHED FLOOR LEVEL  
 2. S.F.L. --- STRUCTURAL FLOOR LEVEL  
 3. (R) --- REVERSED DETAIL

NO.	DATE	REVISED	BY
JOB NO. :		J-837	
PROJECT : URA KWUN TONG TOWN CENTRE REDEVELOPMENT (AREA 2 & 3) AT NKIL 6514, KWUN TONG, KOWLOON			
TITLE : ALUM. WINDOW SCHEDULE (FOR T1)			
DATE : 30-AUG-18		SCALE : 1:30	
DRAWN BY : Zeng		CHECKED BY : DW	
美特鋁質有限公司 MIDI ALUMINIUM FABRICATOR LTD. Units 6-8, Sunray Industrial Centre, 1/F 610 Cho Kwo Ling Road, Kowloon Tel:23489211-4 Fax:(852)27727666			
DWG NO. : J837-PIW-2118			REV. : -

ELEVATION

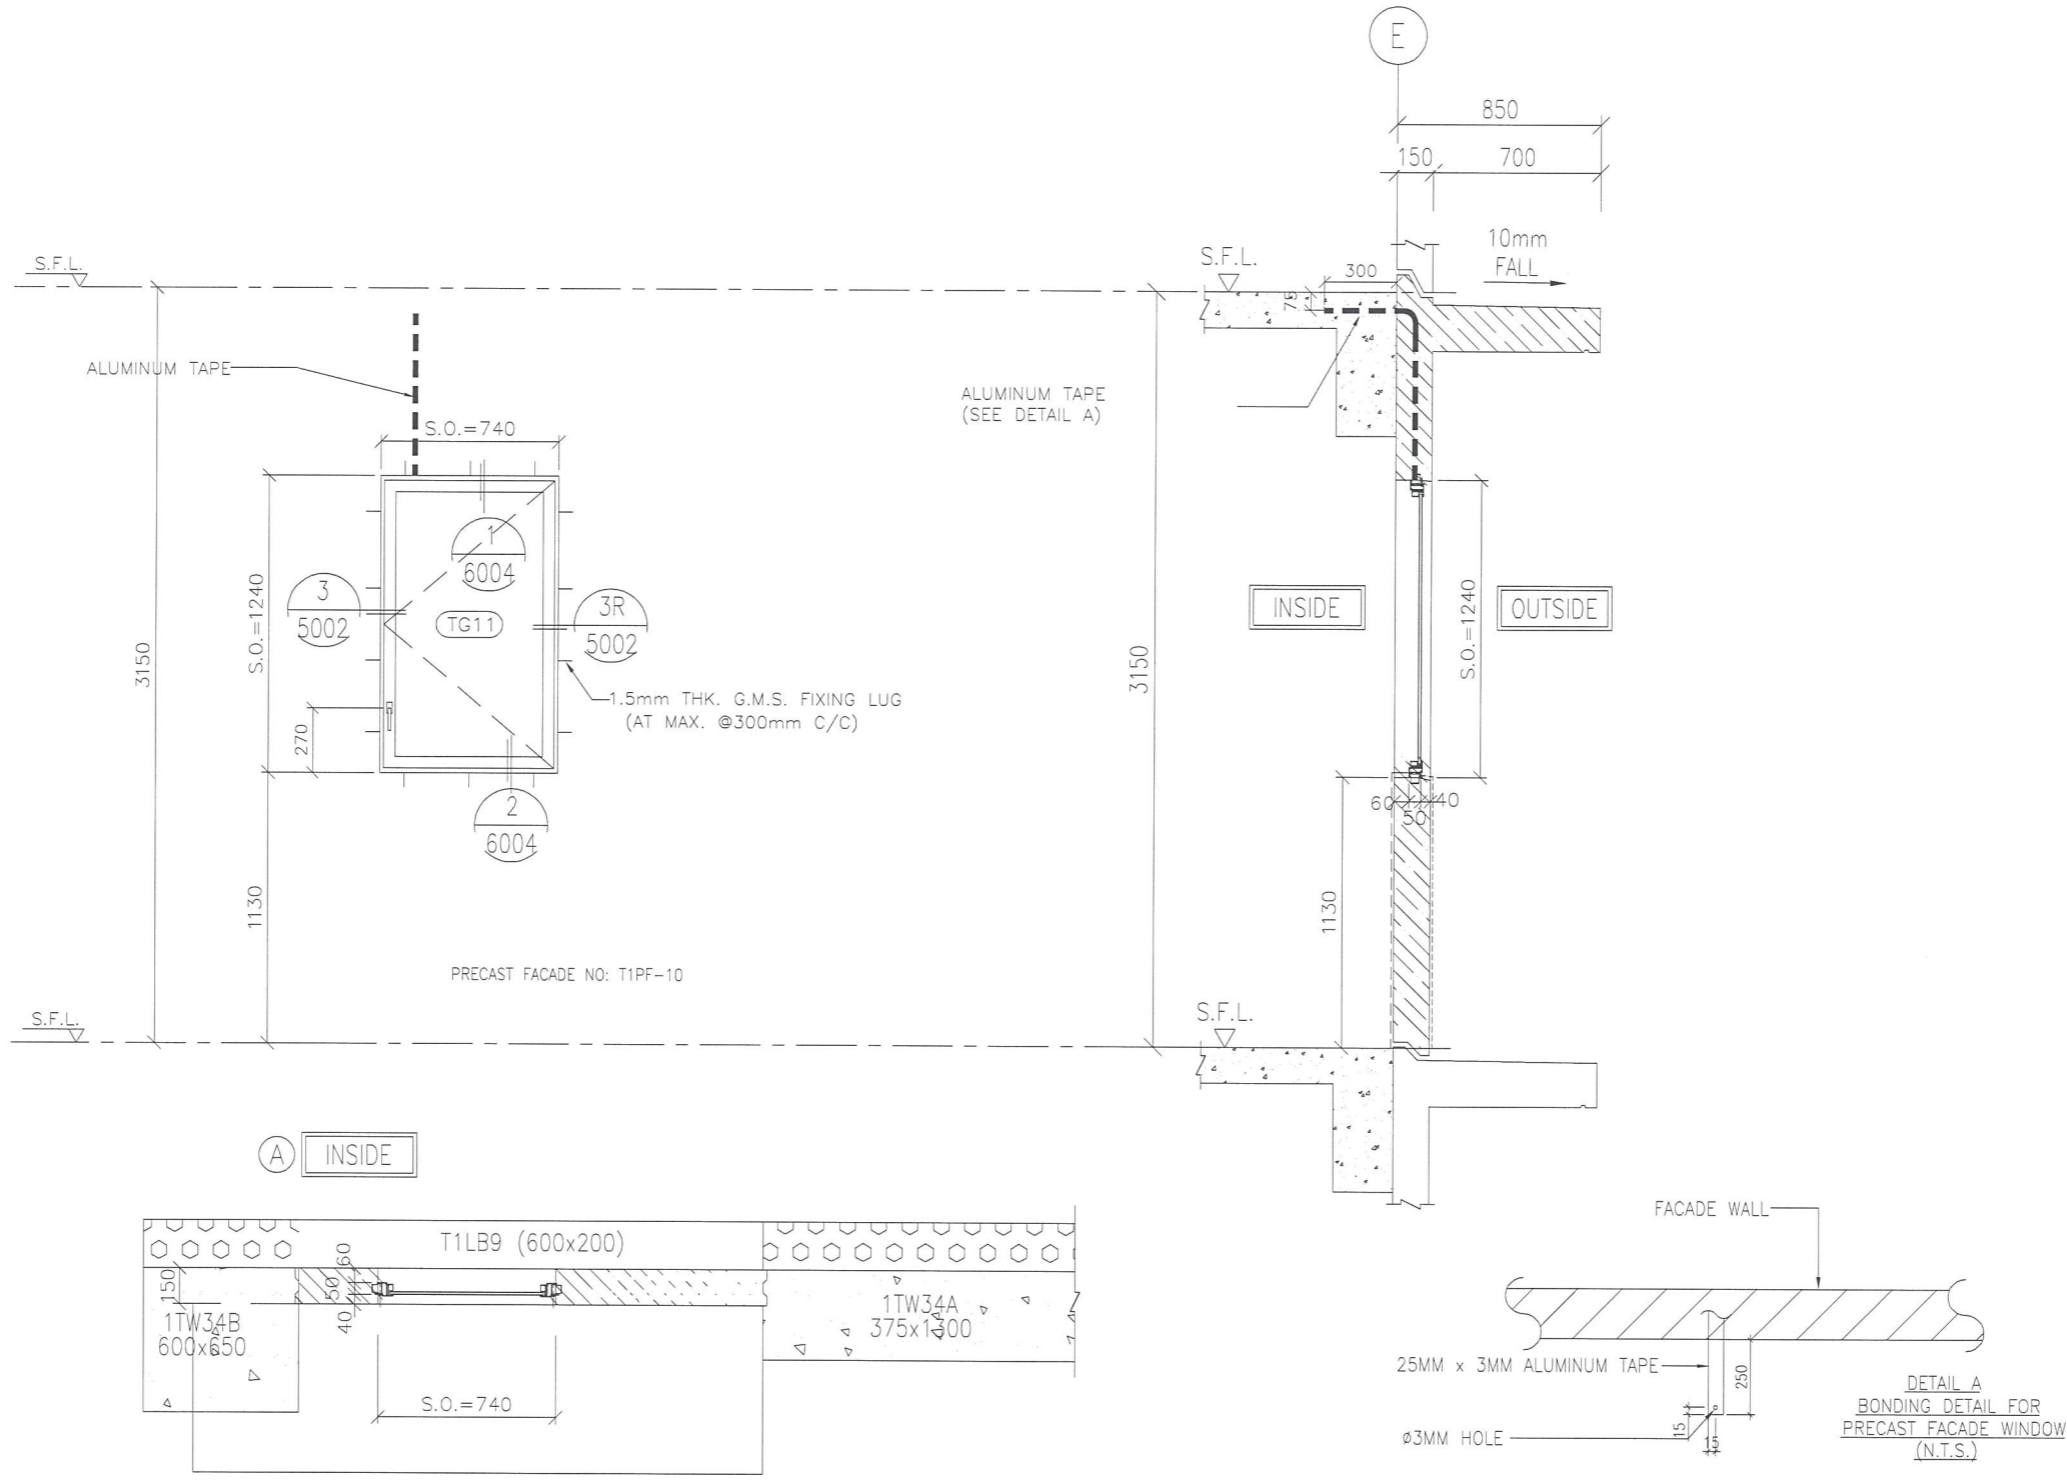

PRECAST WINDOW CHANGES TO IN SITU

NEW S.O.	740(W)*1240(H)
ORIGINAL S.O.	700(W)*1200(H)

GLAZING AREA	Provided = 0.591
OPENABLE AREA	Provided = 0.678

WINDOW MARK	
SECTION :	50mm ALUM. SECTION
QTY.	23 NOS. (TYPICAL)(TO BE CONFIRMED)
LOCATION :	6/F-26/F, 28/F-32/F COMMON CORRIDOR(TO BE CONFIRMED)
GLAZING	8mm THK CLEAR TEMPERED GLASS
REMARK :	ACCESS PANEL

B.D. REF :

CLIENT :  
 信和置業有限公司  
 Sino Land Company Limited

ARCHITECT :  
 WONG TUNG & PARTNERS LIMITED  
 ARCHITECTS & PLANNERS

MAIN CONTRACTOR :  
 CR Construction Company Limited

STRUCTURAL ENGINEER :

FAÇADE CONSULTANT:

NOTE :  
 1. ALL DIMENSIONS ARE IN mm.  
 2. ALL ELEVATIONS ARE VIEWED FROM OUTSIDE.  
 3. ALL DIMENSIONS TO BE VERIFIED ON SITE BEFORE FABRICATION.

LEGEND :  
 — DETAIL MARK NO.  
 — REFER SHEET NO.

1. F.F.L. -- FINISHED FLOOR LEVEL  
 2. S.F.L. -- STRUCTURAL FLOOR LEVEL  
 3. (R) -- REVERSED DETAIL

NO.	DATE	REVISED	BY

JOB NO. : J-837

PROJECT :  
 URA KWUN TONG TOWN CENTRE  
 REDEVELOPMENT (AREA 2 & 3) AT  
 NKIL 6514, KWUN TONG, KOWLOON

TITLE :  
 ALUM. WINDOW SCHEDULE  
 (FOR T1)


DATE : 30-AUG-18      SCALE : 1:30

DRAWN BY : Zeng      CHECKED BY : DW

美特鋁質有限公司  
 MIDI ALUMINIUM FABRICATOR LTD.  
 Units 6-8, Sunray Industrial Centre, 1/F  
 610 Cha Kwo Ling Road, Kowloon  
 Tel:23489211-4 Fax:(852)2727666

DWG NO. : JB37-PIW-2119      REV. : -

ELEVATION

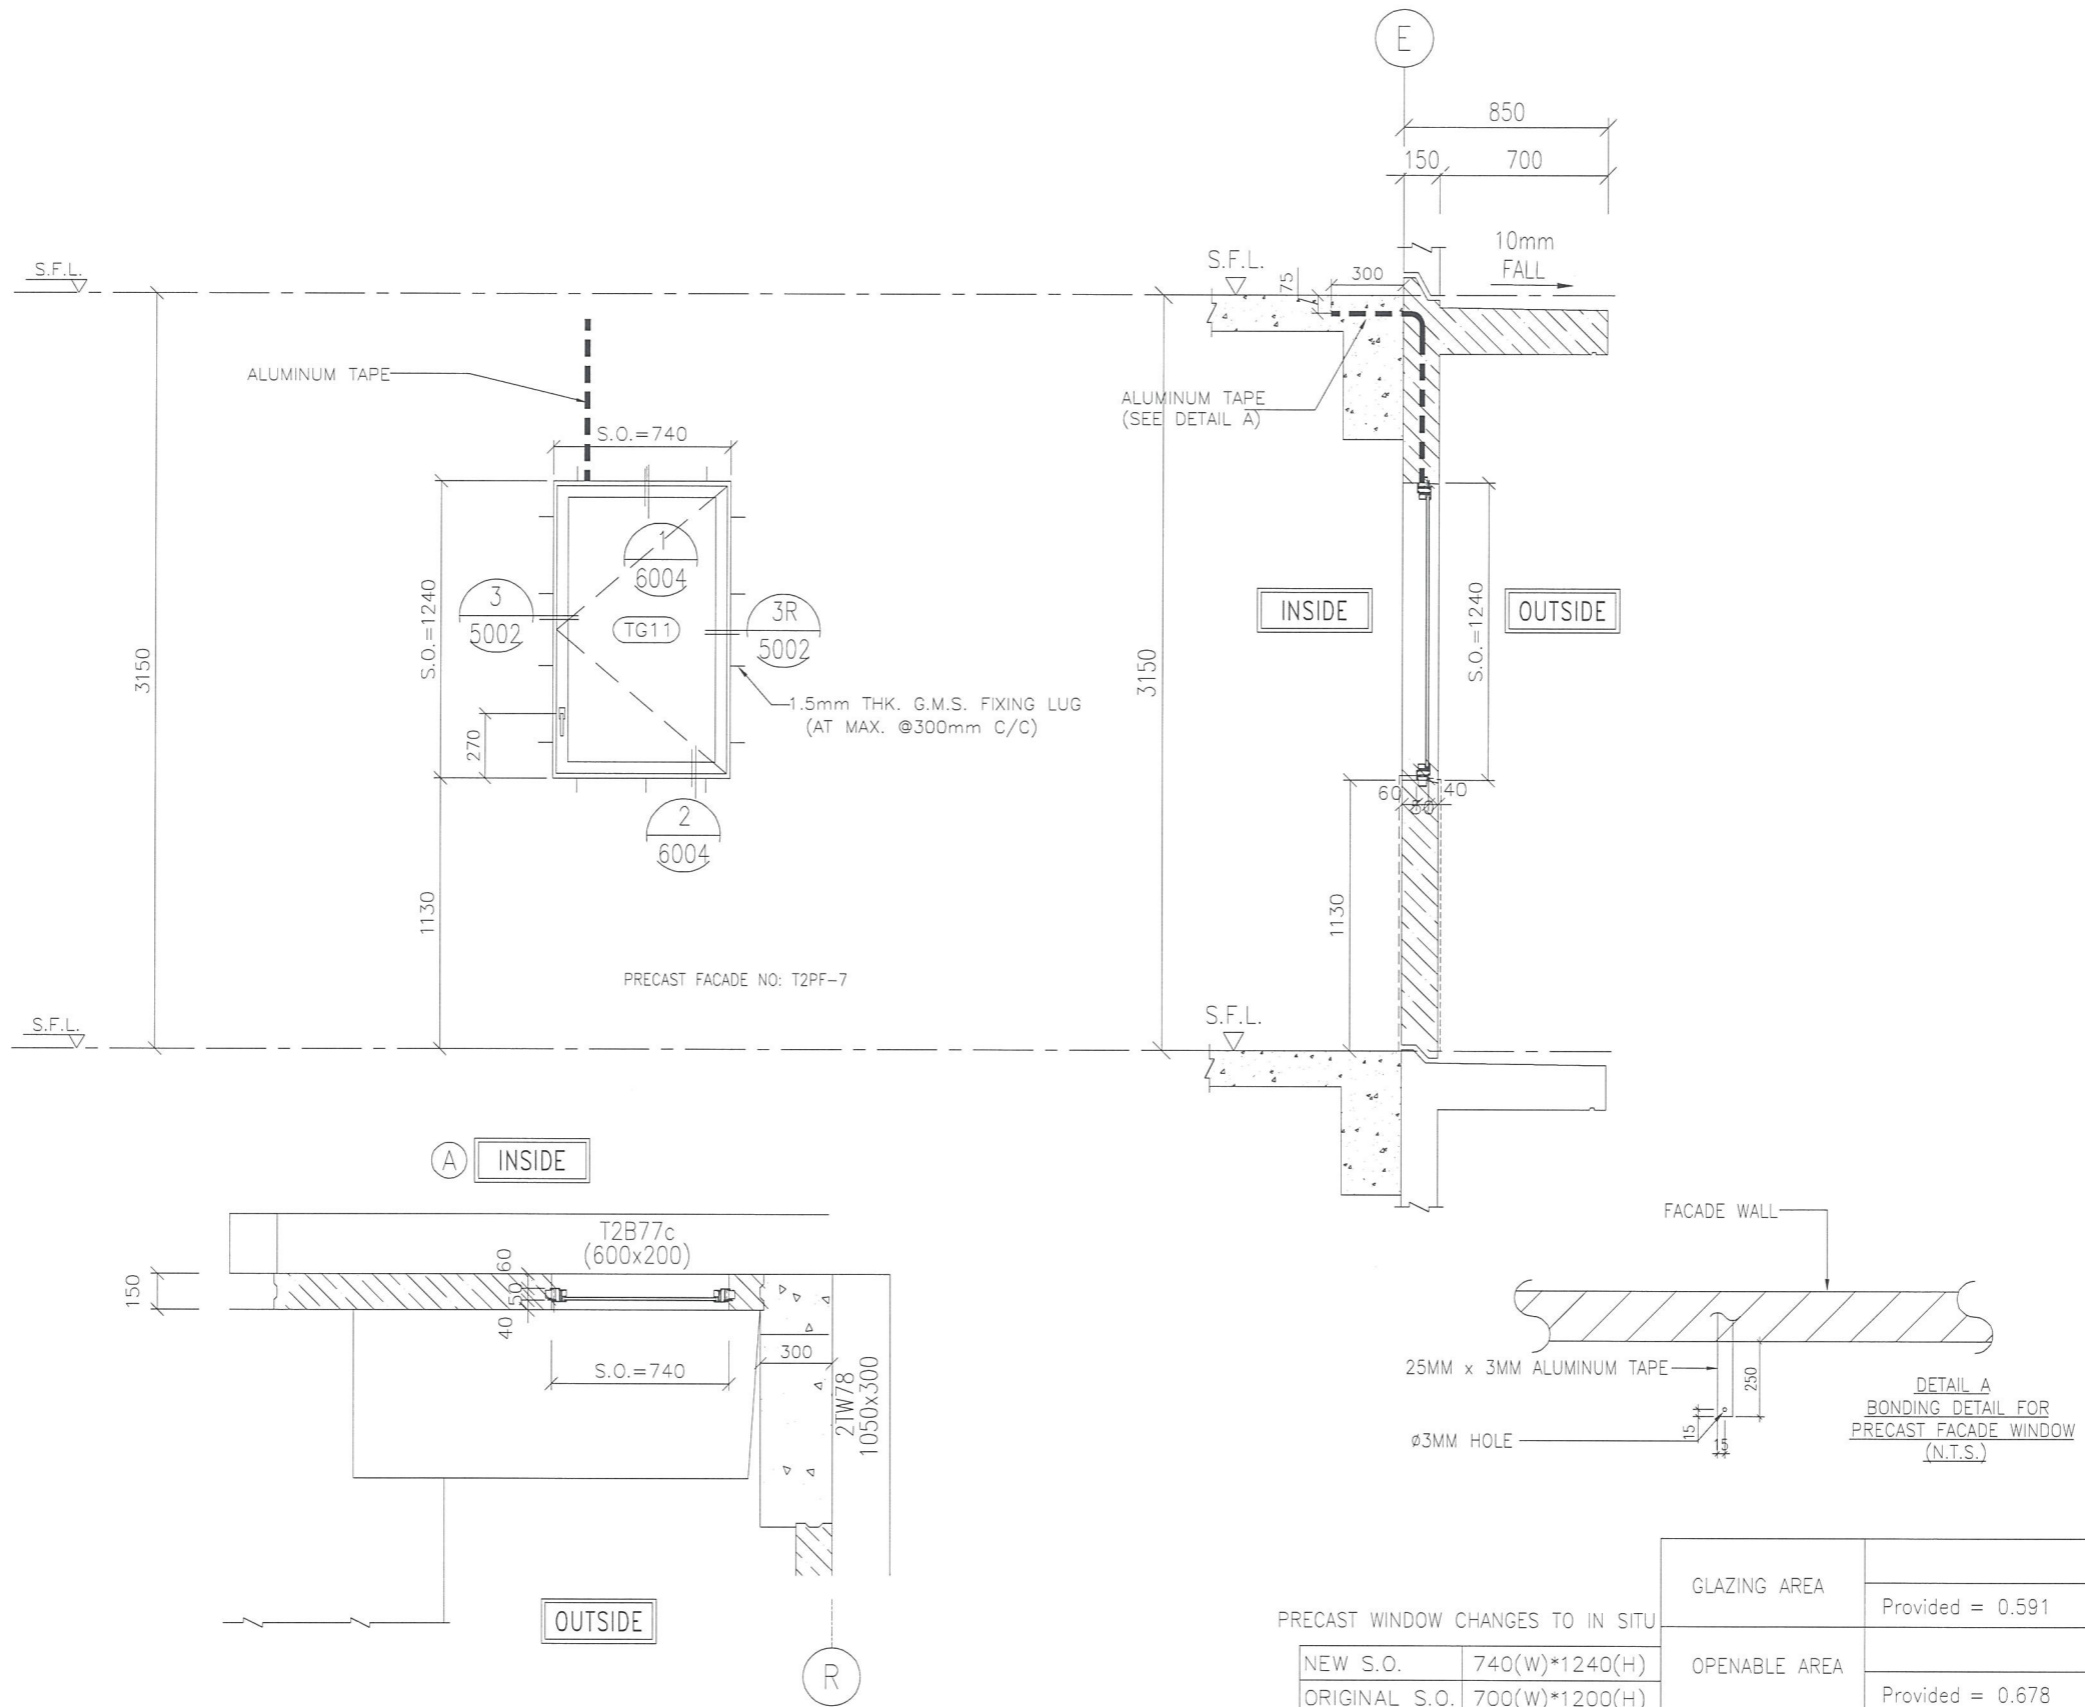

B.D. REF :

CLIENT :  
 信和置業有限公司  
 Sino Land Company Limited

ARCHITECT :  
 WONG TUNG & PARTNERS LIMITED  
 ARCHITECTS & PLANNERS

MAIN CONTRACTOR :  
 CR Construction Company Limited

STRUCTURAL ENGINEER :  
 AECOM

FACADE CONSULTANT:

NOTE :  
 1. ALL DIMENSIONS ARE IN mm.  
 2. ALL ELEVATIONS ARE VIEWED FROM OUTSIDE.  
 3. ALL DIMENSIONS TO BE VERIFIED ON SITE BEFORE FABRICATION.

LEGEND :  
 X1 --- DETAIL MARK NO.  
 X001 --- REFER SHEET NO.  
 1. F.F.L. --- FINISHED FLOOR LEVEL  
 2. S.F.L. --- STRUCTURAL FLOOR LEVEL  
 3. (R) --- REVERSED DETAIL

NO.	DATE	REVISED	BY
-----	------	---------	----

JOB NO. : J-837  
 PROJECT : URA KWUN TONG TOWN CENTRE REDEVELOPMENT (AREA 2 & 3) AT NKIL 6514, KWUN TONG, KOWLOON

TITLE : ALUM. WINDOW SCHEDULE (FOR T2)

DATE : 30-AUG-18 SCALE : 1:30  
 DRAWN BY : Zeng CHECKED BY : DW


英特鋁質有限公司  
 MIDI ALUMINIUM FABRICATOR LTD.  
 Units 6-8, Sunray Industrial Centre, 1/F  
 610 Cha Kwo Ling Road, Kowloon  
 Tel:23489211-4 Fax:(852)27727666

DWG NO. : J837-PIW-2209 REV. : -

WINDOW MARK	
SECTION :	50mm ALUM. SECTION
QTY.	28 NOS. (TYPICAL)(TO BE CONFIRMED)
LOCATION :	6/F-26/F, 28/F-37/F COMMON CORRIDOR(TO BE CONFIRMED)
GLAZING	8mm THK CLEAR TEMPERED GLASS
REMARK :	ACCESS PANEL

PRECAST WINDOW CHANGES TO IN SITU		GLAZING AREA	
NEW S.O.	740(W)*1240(H)	OPENABLE AREA	Provided = 0.591
ORIGINAL S.O.	700(W)*1200(H)		Provided = 0.678

ELEVATION

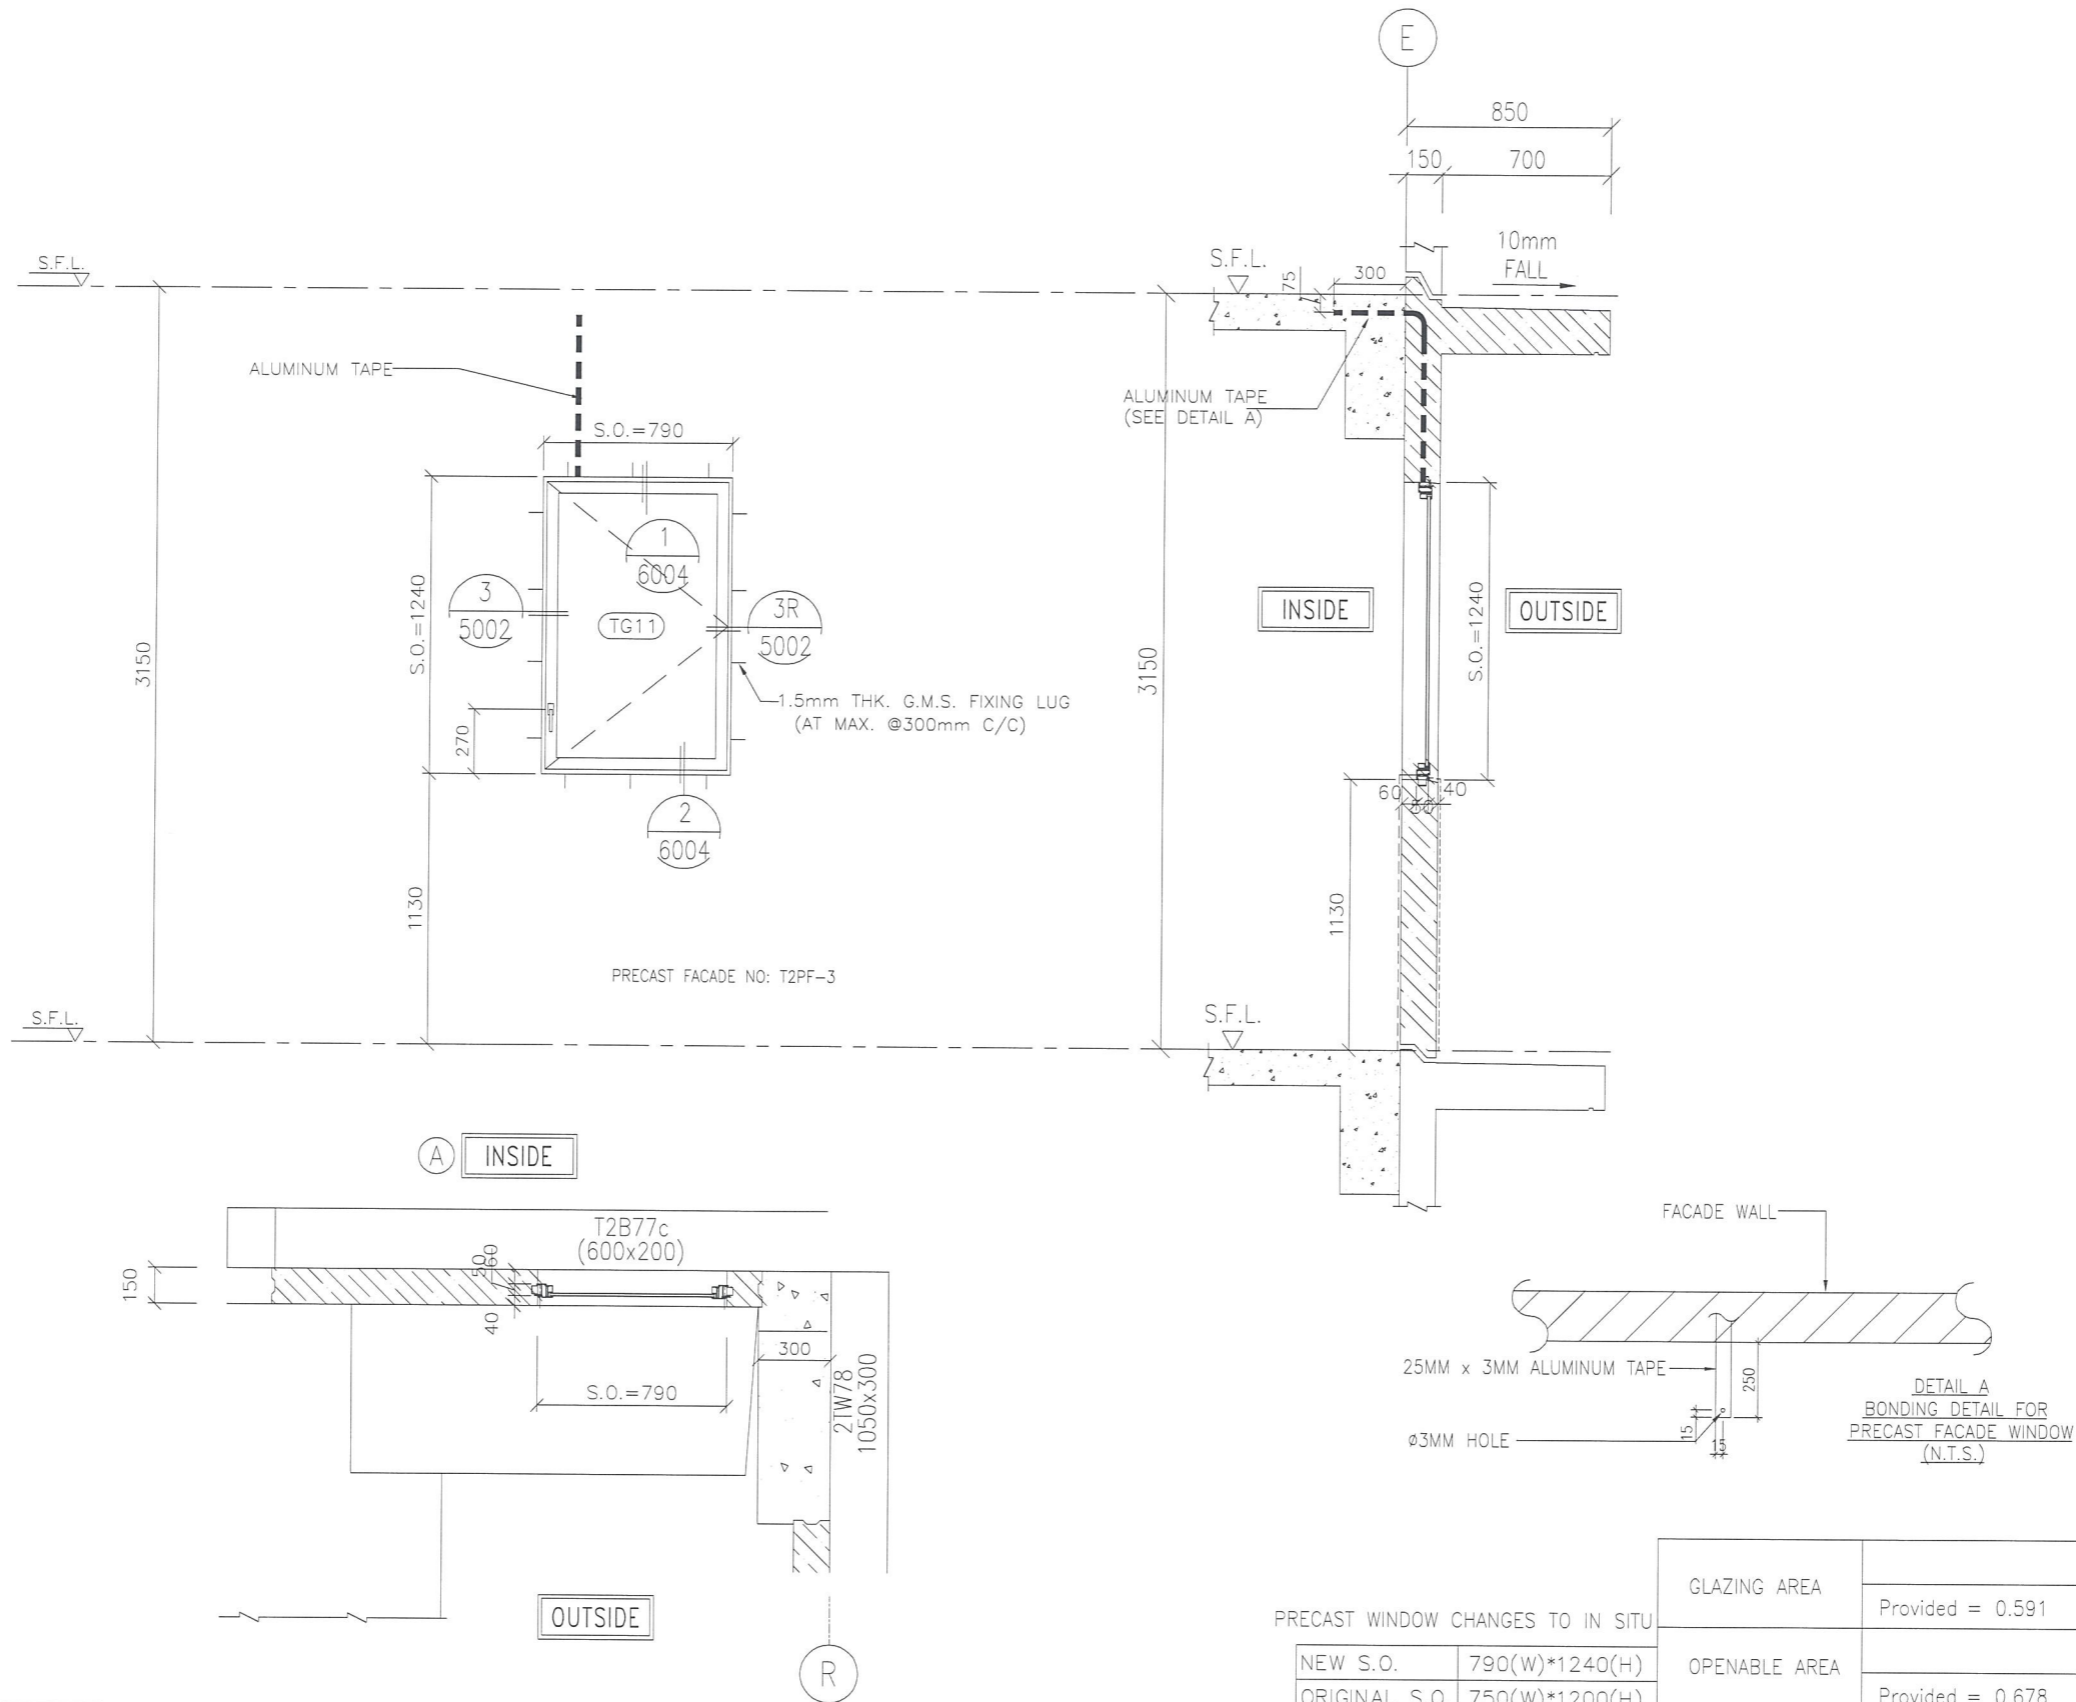

B.D. REF :

CLIENT :  
 信和置業有限公司  
 Sino Land Company Limited

ARCHITECT :  
 WONG TUNG & PARTNERS LIMITED  
 ARCHITECTS & PLANNERS

MAIN CONTRACTOR :  
 CR Construction Company Limited

STRUCTURAL ENGINEER :  
 AECOM

FACADE CONSULTANT:


NOTE :  
 1. ALL DIMENSIONS ARE IN mm.  
 2. ALL ELEVATIONS ARE VIEWED FROM OUTSIDE.  
 3. ALL DIMENSIONS TO BE VERIFIED ON SITE BEFORE FABRICATION.

LEGEND :  
 X1 --- DETAIL MARK NO.  
 X001 --- REFER SHEET NO.  
 1. F.F.L. --- FINISHED FLOOR LEVEL  
 2. S.F.L. --- STRUCTURAL FLOOR LEVEL  
 3. (R) --- REVERSED DETAIL

WINDOW MARK	
SECTION :	50mm ALUM. SECTION
QTY.	27 NOS. (TYPICAL)(TO BE CONFIRMED)
LOCATION :	7/F-26/F, 28/F-37/F COMMON CORRIDOR(TO BE CONFIRMED)
GLAZING	8mm THK CLEAR TEMPERED GLASS
REMARK :	ACCESS PANEL

NO.	DATE	REVISED	BY
JOB NO. :		J-837	
PROJECT : URA KWUN TONG TOWN CENTRE REDEVELOPMENT (AREA 2 & 3) AT NKIL 6514, KWUN TONG, KOWLOON			
TITLE : ALUM. WINDOW SCHEDULE (FOR T2)			
DATE : 30-AUG-18		SCALE : 1:30	
DRAWN BY : Zeng		CHECKED BY : DW	
美特鋁質有限公司 MIDI ALUMINIUM FABRICATOR LTD. Units 6-8, Sunray Industrial Centre, 1/F 610 Cho Kwo Ling Road, Kowloon Tel:23489211-4 Fax:(852)27727666			
DWG NO. : JB37-PIW-2210		REV. : -	

ELEVATION

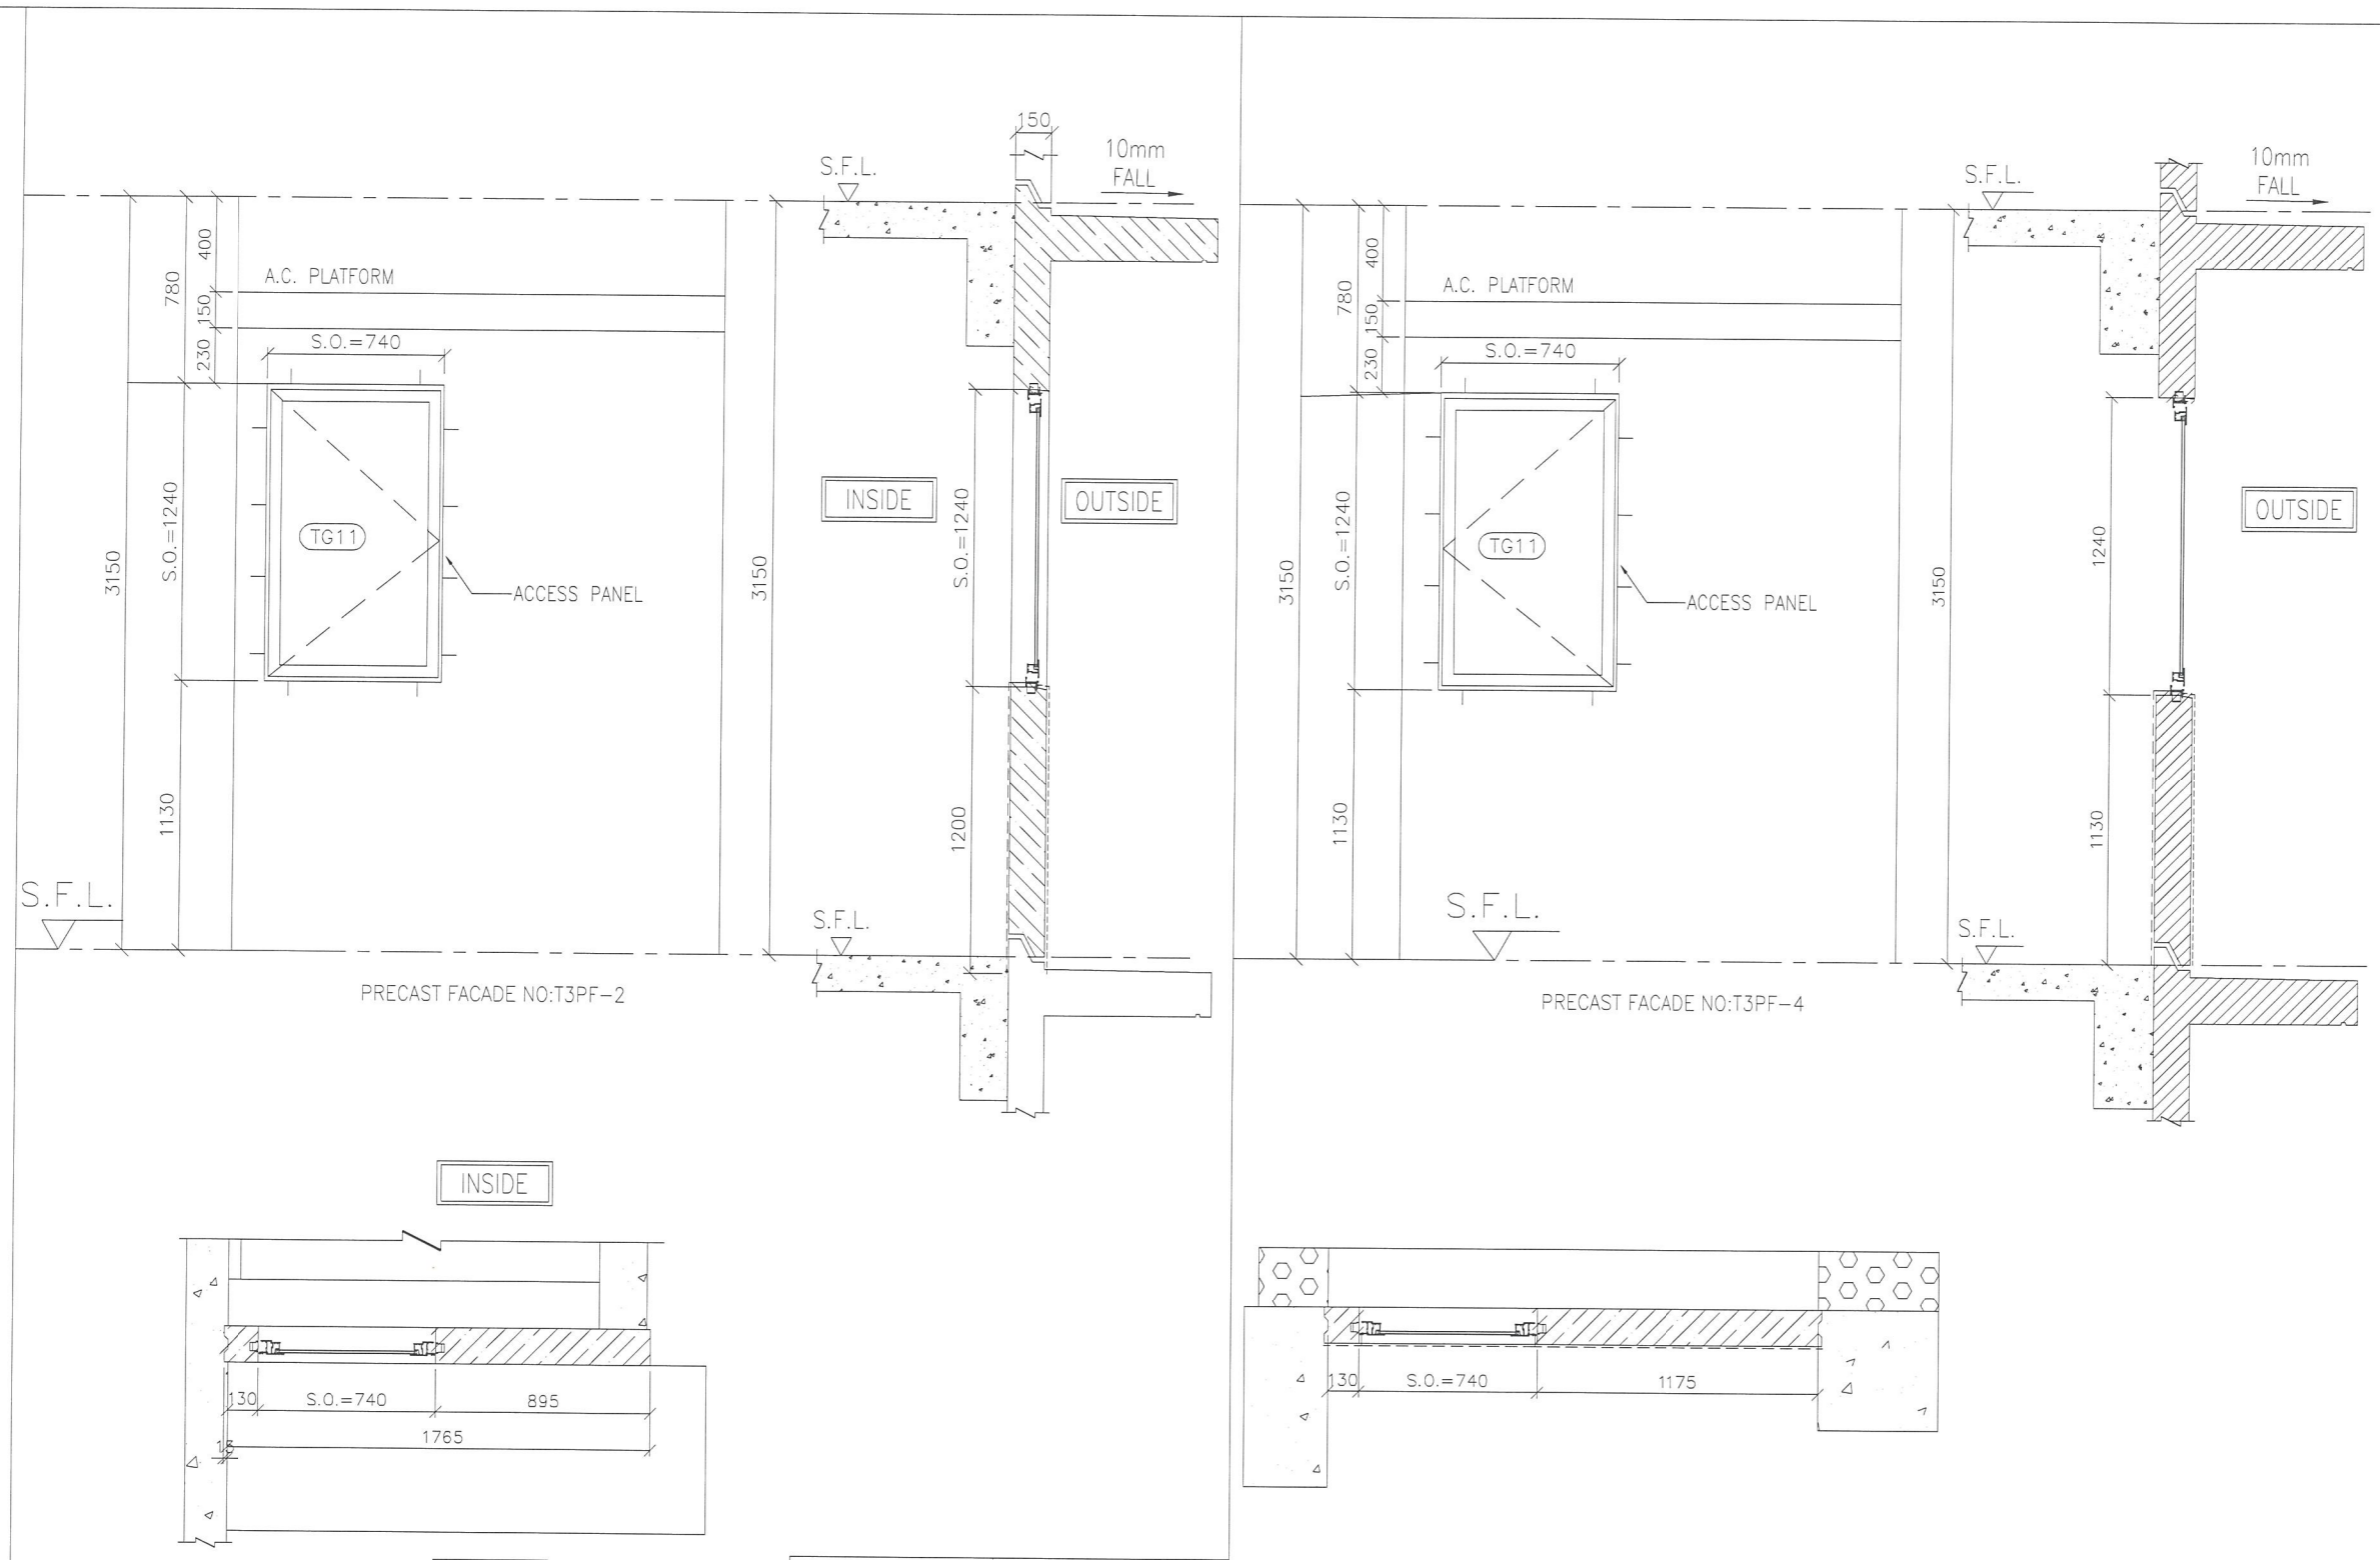

PRECAST WINDOW CHANGES TO IN SITU

NEW S.O.	740(W)*1240(H)
ORIGINAL S.O.	700(W)*1200(H)

GLAZING AREA	Provided = 0.591
OPENABLE AREA	Provided = 0.678

PRECAST WINDOW CHANGES TO IN SITU

NEW S.O.	740(W)*1240(H)
ORIGINAL S.O.	700(W)*1200(H)

GLAZING AREA	Provided = 0.591
OPENABLE AREA	Provided = 0.678

WINDOW MARK		WINDOW MARK	
SECTION :	50mm ALUM. SECTION	SECTION :	50mm ALUM. SECTION
QTY.	<del>23 NOS.</del> (TYPICAL)(TO BE CONFIRMED) <i>24 nos.</i>	QTY.	23 NOS. (TYPICAL)(TO BE CONFIRMED) ✓
LOCATION :	T3 6/F-26/F, 28/F <del>REFUSE STORAGE</del> (TO BE CONFIRMED) <i>~32/F</i>	LOCATION :	T3 6/F-26/F, 28/F <del>COMMON CORRIDOR</del> (TO BE CONFIRMED) <i>~32/F</i>
GLAZING	8mm THK. CLEAR TEMPERED GLASS	GLAZING	8mm THK. CLEAR TEMPERED GLASS
REMARK :	ACCESS PANEL	REMARK :	ACCESS PANEL

WINDOW MARK		WINDOW MARK	
SECTION :	50mm ALUM. SECTION	SECTION :	50mm ALUM. SECTION
QTY.	23 NOS. (TYPICAL)(TO BE CONFIRMED) ✓	QTY.	23 NOS. (TYPICAL)(TO BE CONFIRMED) ✓
LOCATION :	T3 6/F-26/F, 28/F <del>COMMON CORRIDOR</del> (TO BE CONFIRMED) <i>~32/F</i>	LOCATION :	T3 6/F-26/F, 28/F <del>COMMON CORRIDOR</del> (TO BE CONFIRMED) <i>~32/F</i>
GLAZING	8mm THK. CLEAR TEMPERED GLASS	GLAZING	8mm THK. CLEAR TEMPERED GLASS
REMARK :	ACCESS PANEL	REMARK :	ACCESS PANEL

B.D. REF :

CLIENT :  
 信和置業有限公司  
 Sino Land Company Limited

ARCHITECT :  
 WONG TUNG & PARTNERS LIMITED  
 ARCHITECTS & PLANNERS

MAIN CONTRACTOR :  
 CR Construction Company Limited

STRUCTURAL ENGINEER :  
 AECOM

FACADE CONSULTANT :

NOTE :  
 1. ALL DIMENSIONS ARE IN mm.  
 2. ALL ELEVATIONS ARE VIEWED FROM OUTSIDE.  
 3. ALL DIMENSIONS TO BE VERIFIED ON SITE BEFORE FABRICATION.

LEGEND :  
 X1 --- DETAIL MARK NO.  
 X001 --- REFER SHEET NO.

1. F.F.L. --- FINISHED FLOOR LEVEL  
 2. S.F.L. --- STRUCTURAL FLOOR LEVEL  
 3. (R) --- REVERSED DETAIL

NO.	DATE	REVISED	BY
-----	------	---------	----

JOB NO. : J-837

PROJECT :  
 URA KWUN TONG TOWN CENTRE  
 REDEVELOPMENT (AREA 2 & 3) AT  
 NKIL 6514, KWUN TONG, KOWLOON

TITLE :  
 ALUM. WINDOW SCHEDULE  
 (FOR T3)



DATE : 30-AUG-18      SCALE : 1:##

DRAWN BY : Zeng      CHECKED BY : DW

美特鋁質有限公司  
 MIDI ALUMINIUM FABRICATOR LTD.  
 Units 6-8, Sunray Industrial Centre, 1/F  
 610 Cha Kwo Ling Road, Kowloon  
 Tel:23489211-4 Fax:(852)2727666

DWG NO. : J837-PIW-2311      REV. : A

ELEVATION

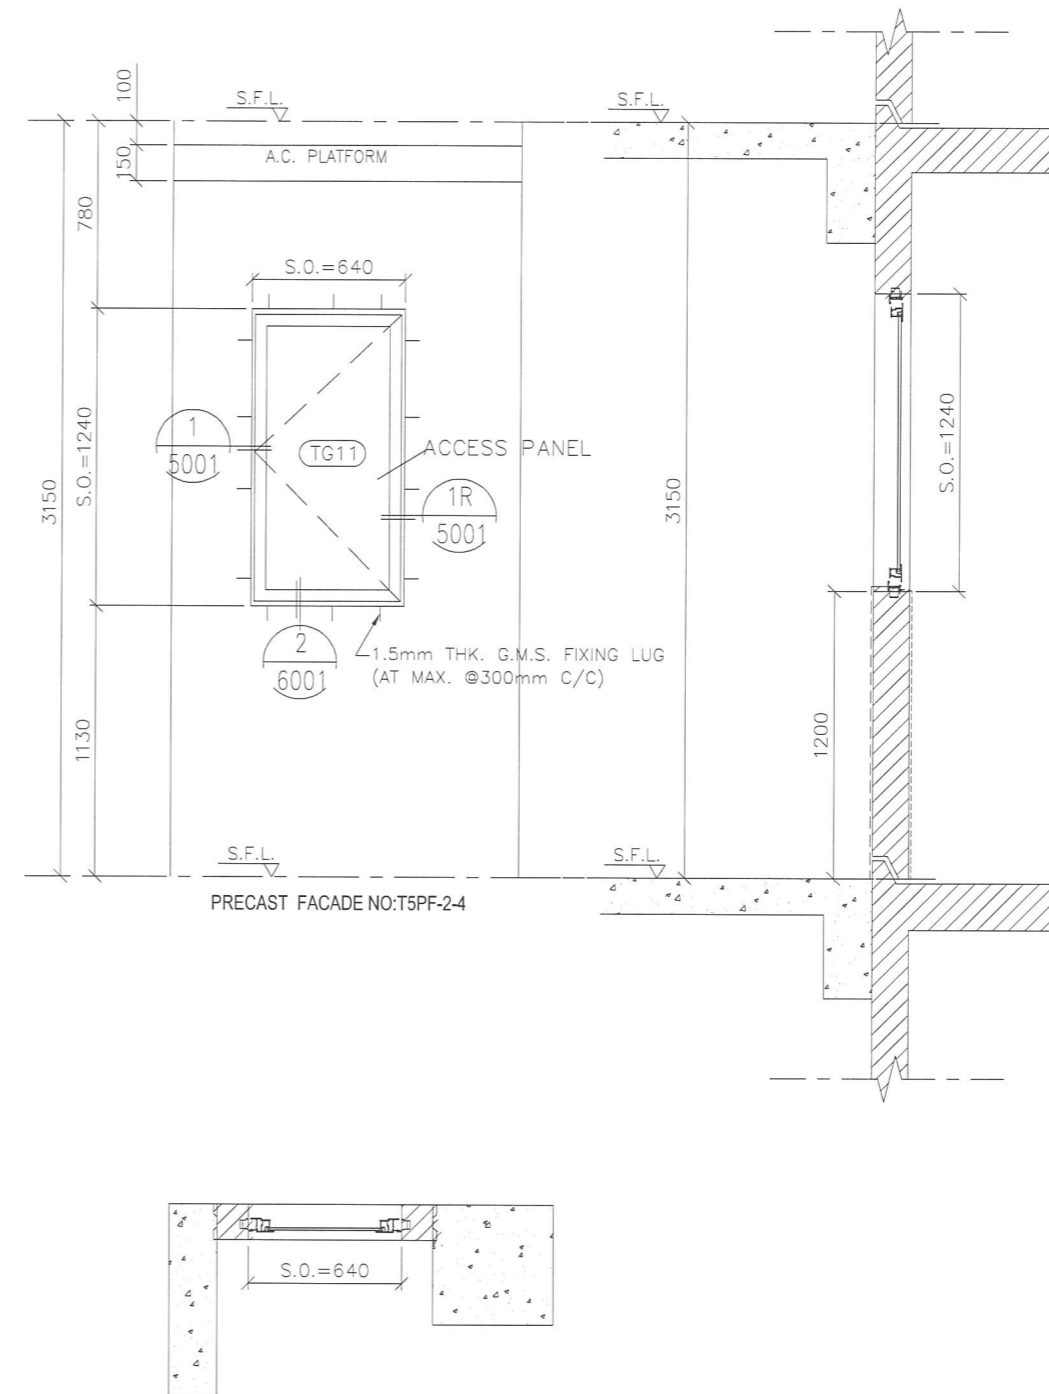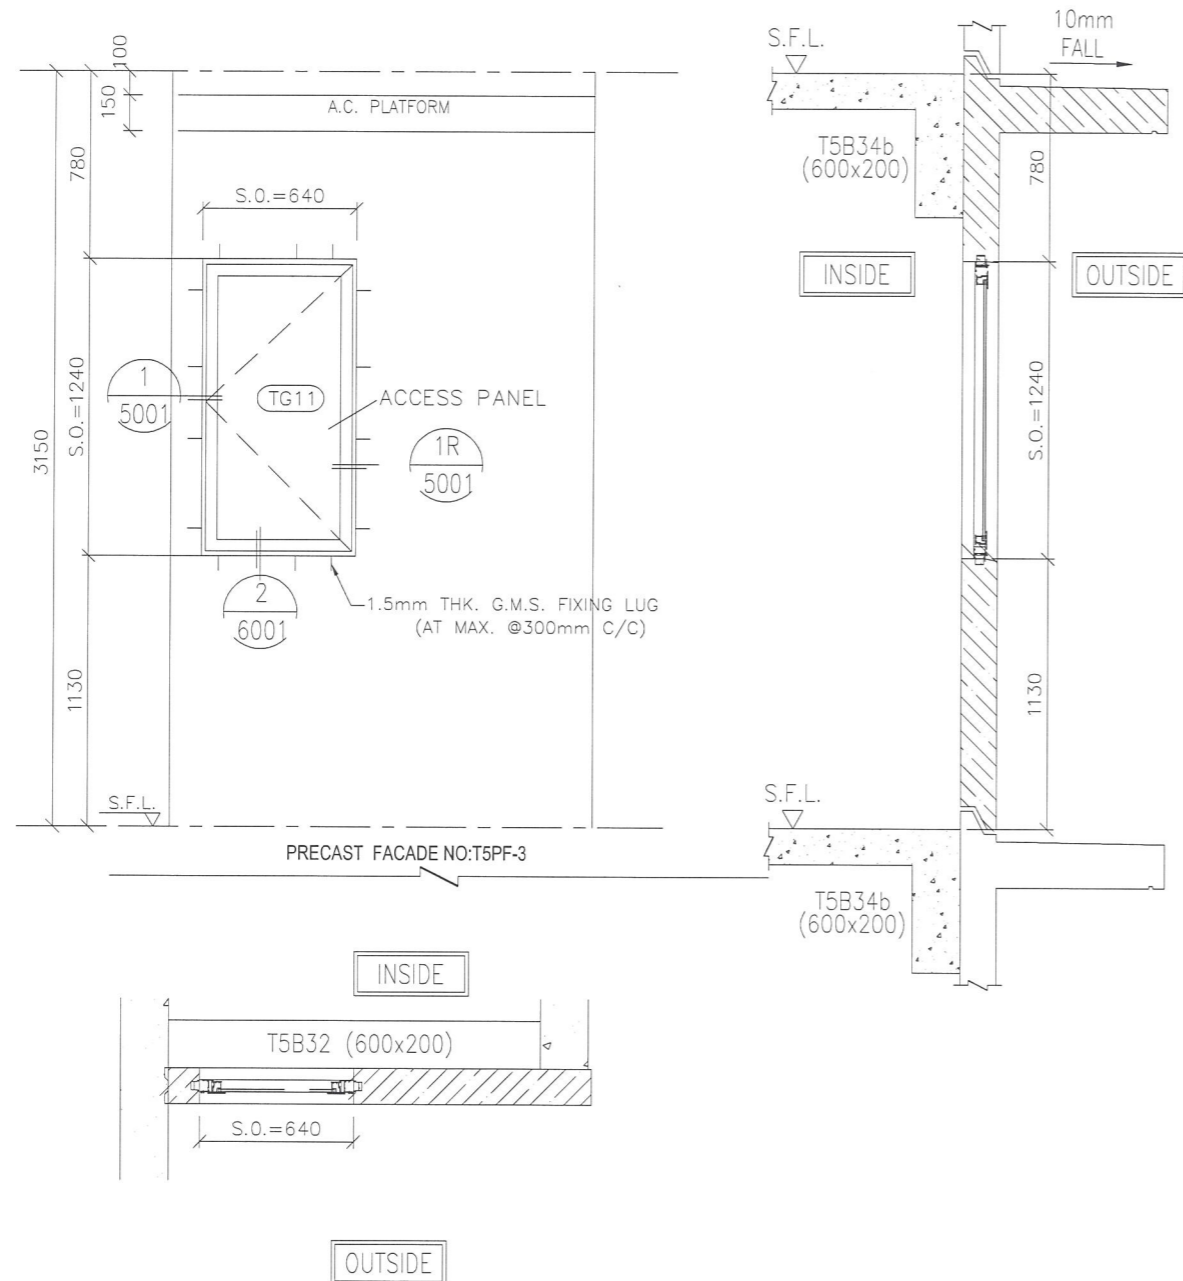

PRECAST WINDOW CHANGES TO IN SITU

NEW S.O.	640(W)*1240(H)
ORIGINAL S.O.	600(W)*1200(H)

GLAZING AREA	Required = 0.336
	Provided = 0.711
OPENABLE AREA	Required = 0.336
	Provided = 0.818

PRECAST WINDOW CHANGES TO IN SITU

NEW S.O.	640(W)*1240(H)
ORIGINAL S.O.	600(W)*1200(H)

GLAZING AREA	Required = 0.336
	Provided = 0.711
OPENABLE AREA	Required = 0.336
	Provided = 0.818

WINDOW MARK	
SECTION :	50mm ALUM. SECTION
QTY.	28 NOS. (TYPICAL)(TO BE CONFIRMED)
LOCATION :	6/F-26/F, 28/F-37/F COMMON CORRIDOR(TO BE CONFIRMED) ✓
GLAZING	8mm THK CLEAR TEMPERED GLASS
REMARK :	ACCESS PANEL

WINDOW MARK	
SECTION :	50mm ALUM. SECTION
QTY.	28 NOS. (TYPICAL)(TO BE CONFIRMED)
LOCATION :	6/F-26/F, 28/F-37/F COMMON CORRIDOR(TO BE CONFIRMED) ✓
GLAZING	8mm THK CLEAR TEMPERED GLASS
REMARK :	ACCESS PANEL

B.D. REF :

CLIENT : 信和置業有限公司 Sino Land Company Limited

ARCHITECT : WONG TUNG & PARTNERS LIMITED ARCHITECTS & PLANNERS

MAIN CONTRACTOR : CR Construction Company Limited

STRUCTURAL ENGINEER : AECOM

FACADE CONSULTANT :

NOTE :

- ALL DIMENSIONS ARE IN mm.
- ALL ELEVATIONS ARE VIEWED FROM OUTSIDE.
- ALL DIMENSIONS TO BE VERIFIED ON SITE BEFORE FABRICATION.

LEGEND :

X1 --- DETAIL MARK NO.  
X001 --- REFER SHEET NO.

1. F.F.L. --- FINISHED FLOOR LEVEL  
2. S.F.L. --- STRUCTURAL FLOOR LEVEL  
3. (R) --- REVERSED DETAIL

NO.	DATE	REVISED	BY

JOB NO. : J-837

PROJECT : URA KWUN TONG TOWN CENTRE REDEVELOPMENT (AREA 2 & 3) AT NKIL 6514, KWUN TONG, KOWLOON

TITLE : ALUM. WINDOW SCHEDULE (FOR T5)

DATE : 30-AUG-18 SCALE : 1:30

DRAWN BY : Zeng CHECKED BY : DW

美特鋁質有限公司  
MIDI ALUMINUM FABRICATOR LTD.  
Units 6-8, Sunray Industrial Centre, 1/F  
610 Cha Kwo Ling Road, Kowloon  
Tel: 23489211-4 Fax: (852) 2727666

DWG NO. : J837-PIW-2509 REV. : -