

工程指示 / 要求簡箋(E.I.)

工程指示編號：EI / 9853 / 19

修改版次：D

工程編號：J - 837

工程名稱：觀塘裕民坊

工程項目：佛沙窗轉後裝窗 新增 access panel T1W/4

收件人：生統 / 永林

發件人：Bessie

日期：25/02/2019

要求提供 / 確認 事項：

- () 初步鋁料 B.M. () 加工拆圖，然後生產 () 尺寸表
- () 正式鋁料 B.M. () 技術上資料 / 指示 () 報價
- () 配件 B.M. () 樣辦或貨品說明書 () 分判合約
- () 其他：_____

內容：

T1W/4 (格則師 comment 新增)

現新增附件之 access panel, 煩請提供拆圖

附 CAD 檔: PIW-2101~2120(2019-02-13).dwg

請在 _____ 前完成上列要求。

開窗方向以附件為準，
不要以 cad 檔為準。

附： 頁

以上項目為：

- 原合約工程包 原合約工程加 / 減賬 新工程報價

原因：-

分發東莞各部門：

- () 生產技術總監 連附件 () 技術部 連附件 永林 () 生產部 連附件 () 機械設計部 連附件
- () 採購部 連附件 () 生產統籌部 連附件 梅姐
- () 質檢部 連附件 () 會計部 連附件 () 報關組 連附件 () 其他 _____ 連附件

分發香港各部門：


- () 行政部 連附件 () 會計部 連附件 () 統籌部 連附件 () 工程部地盤科文 連附件 炳哥
- () 採購部 連附件 () QS 部 連附件 () 維修部 連附件 () 其他 _____ 連附件

傳遞編號：HK0466 / 19

發件人簽署：

項目經理簽署：

ELEVATION

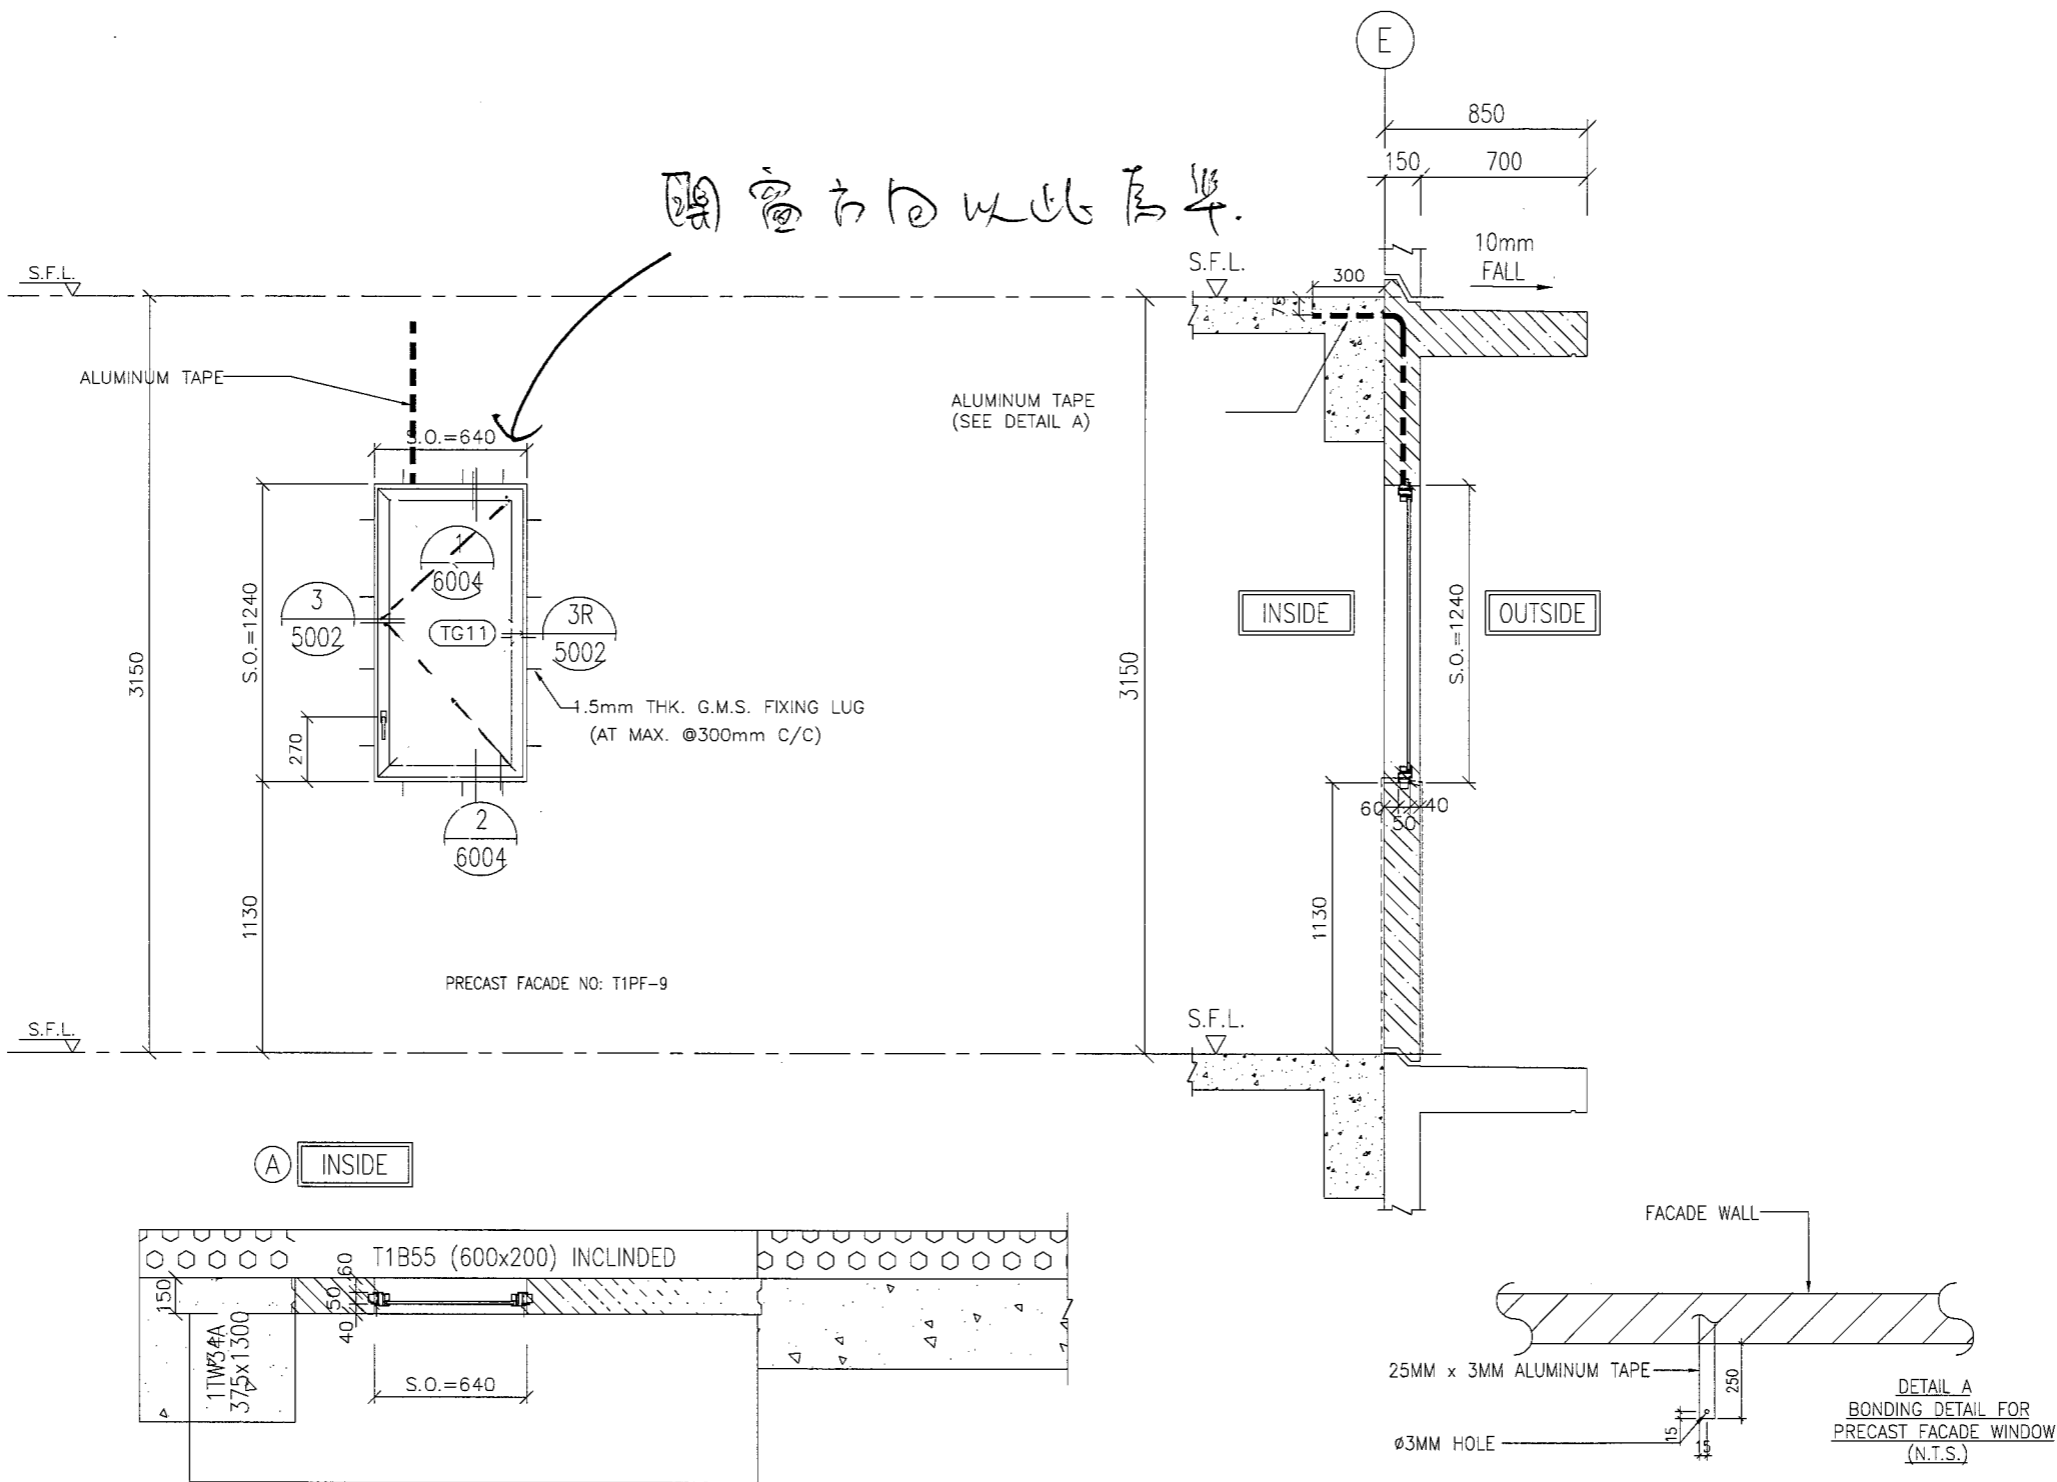

B.D. REF :

CLIENT :
 信和置業有限公司
 Sino Land Company Limited

ARCHITECT :
 WONG TUNG & PARTNERS LIMITED
 ARCHITECTS & PLANNERS

MAIN CONTRACTOR :
 CR Construction Company Limited

STRUCTURAL ENGINEER :
 AECOM

FACADE CONSULTANT:

NOTE :
 1. ALL DIMENSIONS ARE IN mm.
 2. ALL ELEVATIONS ARE VIEWED FROM OUTSIDE.
 3. ALL DIMENSIONS TO BE VERIFIED ON SITE BEFORE FABRICATION.

LEGEND :

 1. F.F.L. -- FINISHED FLOOR LEVEL
 2. S.F.L. -- STRUCTURAL FLOOR LEVEL
 3. (R) -- REVERSED DETAIL

NO.	DATE	REVISED	BY
-----	------	---------	----

JOB NO. : J-837

PROJECT :
 URA KWUN TONG TOWN CENTRE
 REDEVELOPMENT (AREA 2 & 3) AT
 NKIL 6514, KWUN TONG, KOWLOON

TITLE :
 ALUM. WINDOW SCHEDULE
 (FOR T1)

DATE : 30-AUG-18 SCALE : 1:30

DRAWN BY : Zeng CHECKED BY : DW

美特鋁質有限公司
 MIDI ALUMINIUM FABRICATOR LTD.
 Units 6-8, Sunray Industrial Centre, 1/F
 610 Cha Kwo Ling Road, Kowloon
 Tel:23489211-4 Fax:(852)2772666

DWG NO. : JB37-PIW-2120 REV. : -

Precast changes to insitu

New S.O.	640(W) x 1240(H)
Original S.O.	600(W) x 1200(H)

OUTSIDE

GLAZING AREA	Provided = 0.567
OPENABLE AREA	Provided = 0.654

WINDOW MARK	
SECTION :	50mm ALUM. SECTION
QTY.	23 NOS. (TYPICAL)(TO BE CONFIRMED)
LOCATION :	6/F-26/F,28F~32F COMMON CORRIDOR(TO BE CONFIRMED) ✓
GLAZING	8mm THK ACID ETCHED FROSTED TEMPERED GLASS
REMARK :	OPENABLE WINDOW