

工程指示 / 要求簡箋(E.I.)

工程指示編號：EI / P133 / 18

修改版次：-

工程編號：J - 837

工程名稱：觀塘裕民坊

工程項目：後裝窗大貨(T1-T5)

收件人：生統

發件人：Bessie

日期：13/11/2018

要求提供 / 確認 事項：

- () 初步鋁料 B.M. () 加工拆圖，然後生產 () 尺寸表
- () 正式鋁料 B.M. () 技術上資料 / 指示 () 報價
- () 配件 B.M. () 樣辦或貨品說明書 () 分判合約
- () 其他：_____

內容：

請按加工圖生產後裝窗，送地盤安裝

優先生產 8 樓辦房，預算 11 月底出貨到地盤

其餘樓層之後裝窗按 EI/9867/18 排期生產，每次出貨 8 層後裝窗，按地盤指示才安排出貨。
(T1W/G2 及 T3W/A3 待定，因則師要求更改窗號 T1W/G2 及 T3W/A3 的 SO，
此兩幅窗待修改大圖後再更新拆圖)

謝謝！

請在 _____ 前完成上列要求。

附：2 頁圖登，36 頁加工圖

位置圖共 13 頁

以上項目為：

- 原合約工程包 原合約工程加 / 減賬 新工程報價

原因：-

分發東莞各部門：

- () 生產技術總監 連附件 技術部 連附件 () 生產部 連附件 () 機械設計部 連附件
- () 採購部 連附件 生產統籌部 連附件
- () 質檢部 連附件 () 會計部 連附件 () 報關組 連附件 () 其他 楊榮輝 連附件

分發其他分判：
() 王禮秋 連附件

分發香港各部門：

- () 行政部 連附件 () 會計部 連附件 () 統籌部 連附件 () 工程部地盤科文 連附件
- () 採購部 連附件 () QS 部 連附件 () 維修部 連附件 () 其他 _____ 連附件

傳遞編號：

發件人簽署：

HK P133 / 18

項目經理簽署：

圖則登記表
DRAWING REGISTER

接收日期 Receiving Date (適用於客戶圖則)

工程名稱 Project Title: **觀塘裕民坊**
50後裝窗

工程編號 Project No: **J-837**

年									
月									
日									

分發予 Distributed To

年	18								
月	11								
日	9								

圖則編號 Drg. No.	圖則名稱 Drawing Title
T2W-N-1	50後裝窗組裝圖
T5W-L-5	50後裝窗組裝圖
T1W-E3	50後裝窗組裝圖
T3W-5	50後裝窗組裝圖
T5W-2	50後裝窗組裝圖
T1W-G-1	50後裝窗組裝圖
T5W-A-4	50後裝窗組裝圖
T1W-A-2	50後裝窗組裝圖
T5W-M-BATH2	50後裝窗組裝圖
T1W-G2	50後裝窗組裝圖
T1W-H-1	50後裝窗組裝圖
T1W-H-2	50後裝窗組裝圖
T5W-L-4	50後裝窗組裝圖
T2W-N-3	50後裝窗組裝圖
T2W-C-1	50後裝窗組裝圖
T2W-D-1	50後裝窗組裝圖
T2W-M-2	50後裝窗組裝圖
T2W-B-2	50後裝窗組裝圖
T1W-A-1	50後裝窗組裝圖

	修訂編號 Revision No.
1	-
2	-
圖則登記表
DRAWING REGISTER

接收日期 Receiving Date (適用於客戶圖則)

工程名稱 Project Title: 觀塘裕民坊
50後裝窗

工程編號 Project No: J-837

年									
月									
日									


分發予 Distributed To

年	18								
月	11								
日	9								

圖則編號 Drg. No.	圖則名稱 Drawing Title
T5W-A-1	50後裝窗組裝圖
T2W-M-1	50後裝窗組裝圖
T2W-G-4	50後裝窗組裝圖
837-FYA1	多點鎖放樣圖
837-FYA2	多點鎖放樣圖
837-FYA3	多點鎖放樣圖
837-FYA4	多點鎖放樣圖
837-FYA5	多點鎖放樣圖
837-FYA6	多點鎖放樣圖
837-FYA7	多點鎖放樣圖
837-FYA8	多點鎖放樣圖
837-FYA9	多點鎖放樣圖
837-WB1	50窗節點示意圖
837-WB2	50窗節點示意圖
837-WB3	50窗節點示意圖
837-WB4	50窗節點示意圖
YB-LJ1	鉛角拆圖

修訂編號 Revision No.									
20	-								
21	-								
22	-								
 美特鋁質 有限公司 MIDI Aluminium Fabricator Ltd.	工程號	J837	拆圖	鞠章芳	2018.11.08
	地盤	觀塘裕民坊	復核	謝永林	2018.11.10
名稱	50後裝窗	顏色	EC-DG-S332054 (3塗)	批准	

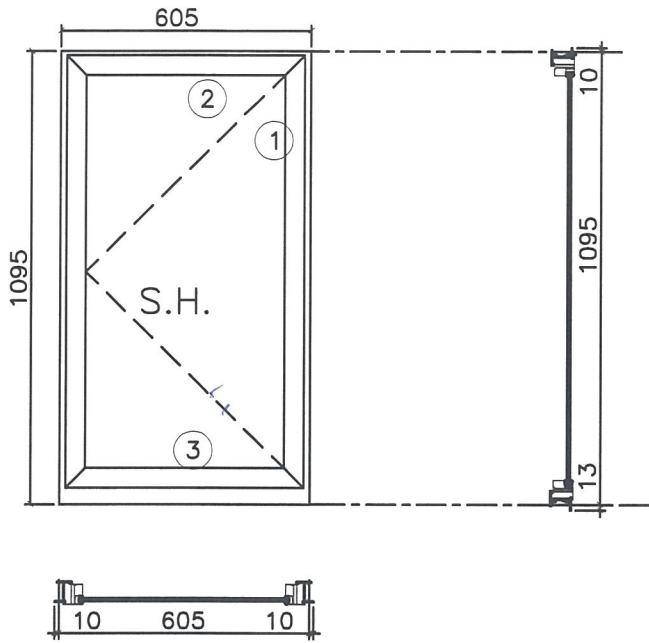


OUTSIDE

- 注：
- (1) 玻璃線橫碰企。
 - (2) 生窗底料需開長方形去水孔。
 - (3) 窗玉搭位6mm
 - (4) 滴水線比窗玉每頭長1mm。
 - (5) S.H 窗採用東城多點鎖
S.H 窗需裝窗掛1隻/玉
 - (6) SH 窗需裝3組扣碼。
 - (7) SH 窗用東城產2021A 扇撐定
窗玉裝不銹鋼加力巴特制款
 - (8) 框橫料兩端需切 X2mm 切口打膠

序號	料號	名稱	出苟	長度 (mm)	支/幅	加工說明	加工細則				
1	X846370	邊企料		1118.0	2		頂留	10	mm		
2	X846390	生頂橫(獨立生窗)	避位	587	1		底留	13	mm		
3	X846400	生底橫	避位	579	1		企料底部開避位		mm		
							底橫料防水巴鋸去		mm		
							水線孔在企料-----	頂	底		
							安裝扣碼	TC903			
							多點鎖芯型號:	東城2035B 鎖盒			
							手柄型號:	2017-MD			
							限位撐型號:				
							T窗最大的開度:				
							窗玉搭位數:	6mm			
							窗玉	寬度	高度	隻/幅	撐長
							SHL	585.0	1073.0	2	16"
							大圖版次	本圖版			
								日期			
							窗玉用料				
							窗號	寬度 (W)	高度 (H)	幅數	樓層數
序號	料號	名稱	出苟	長度 (mm)	支/幅	加工說明	T5W-L-5	605	1095.0	39	6-26 28-50F
1	X846540	窗玉企	45°斜口	1073.0	2						
2	X846540	窗玉橫	45°斜口	585.0	2						
3	X846550	窗玉玻璃線企	直口	1009.0	2						
4	X846550	窗玉玻璃線橫	直口	489.0	2						
							圖號	T5W-L-5			

 美特鋁質 有限公司 MIDI Aluminium Fabricator Ltd.		工程號 J837 地 盤 觀塘裕民坊	拆圖 韓章芳 復核 謝永林	2018.11.08 2018.11.10
名稱 50後裝窗	顏色 EC-DG-S332054 (3塗)	批准		

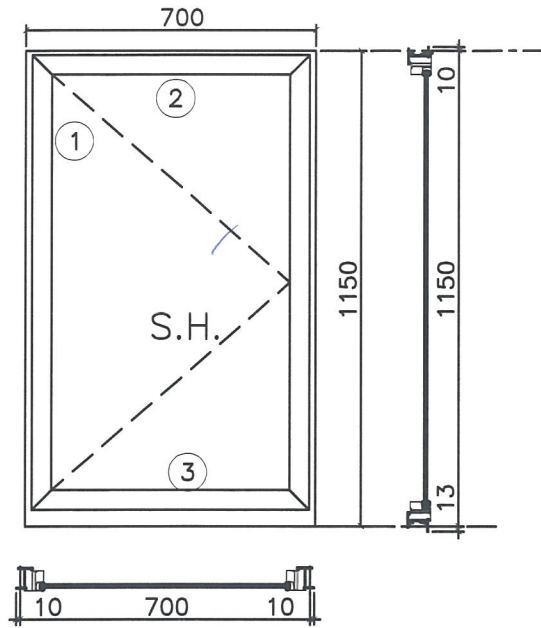


OUTSIDE

注：

- (1) 玻璃線橫碰企。
- (2) 生窗底料需開長方形去水孔。
- (3) 窗玉搭位6mm
- (4) 滴水線比窗玉每頭長1mm。
- (5) S.H.窗採用東城多點鎖
S.H.窗需裝窗掛1隻/玉
- (6) SH窗需裝3組扣碼。
- (7) SH窗用東城產2021A扇撐定
窗玉裝不銹鋼加力巴特制款
- (8) 框橫料兩端需切X2mm切口打膠

序號	料號	名稱	出苟	長度 (mm)	支/幅	加工說明	加工細則					
1	X846370	邊企料		1173.0	2		頂留	10	mm			
2	X846390	生頂橫(獨立生窗)	避位	682	1		底留	13	mm			
3	X846400	生底橫	避位	674	1		企料底部開避位		mm			
							底橫料防水巴鋸去		mm			
							水線孔在企料-----	頂	底			
							安裝扣碼	TC903				
							多點鎖芯型號:	東城2035B 鎖盒				
							手柄型號:	2017-MD				
							限位撐型號:					
							T窗最大的開度:					
							窗玉搭位數:	6mm				
							窗款	寬度	高度	隻/幅	撐長	
							SHR	680.0	1128.0	2	18"	
							大圖版次	本圖版				
								日期				
							窗玉用料	窗号	寬度 (W)	高度 (H)	幅数	樓層數
1	X846540	窗玉企	45°斜口	1128.0	2		T3W-5	700	1150.0	41	6-26 28-52F	
2	X846540	窗玉橫	45°斜口	680.0	2		T3W-1	700	1150.0	40	6-26 28-51F	
3	X846550	窗玉玻璃線企	直口	1064.0	2							
4	X846550	窗玉玻璃線橫	直口	584.0	2							
							圖號	T3W-5				

 美特鋁質 有限公司 MIDI Aluminium Fabricator Ltd.	工程號	J837	拆圖	鞠章芳	2018.11.08
	地盤	觀塘裕民坊	復核	謝永林	2018.11.10
名稱	50後裝窗	顏色	EC-DG-S332054 (3塗)	批准	

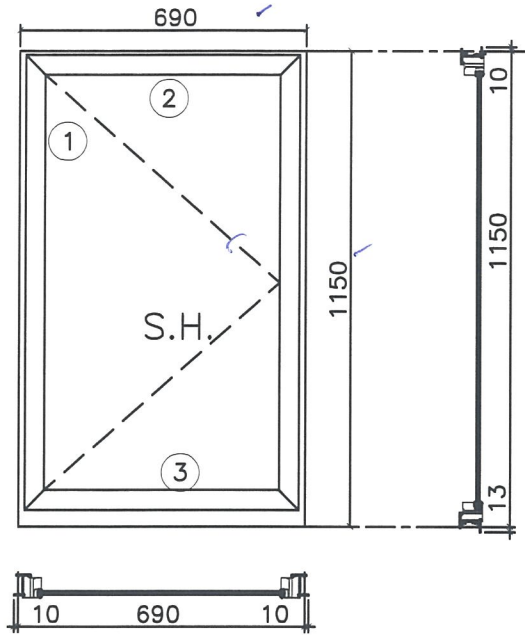


OUTSIDE

- 注：
- (1) 玻璃線橫碰企。
 - (2) 生窗底料需開長方形去水孔。
 - (3) 窗玉搭位6mm
 - (4) 滴水線比窗玉每頭長1mm。
 - (5) S.H 窗採用東城多點鎖
S.H 窗需裝窗掛1隻/玉
 - (6) SH 窗需裝3組扣碼。
 - (7) SH 窗用東城產2021A 扇撐定
窗玉裝不銹鋼加力巴特制款
 - (8) 框橫料兩端需切 X2mm 切口打膠

序號	料號	名稱	出苟	長度 (mm)	支/幅	加工說明	加工細則				
1	X846370	邊企料		1173.0	2		頂留	10	mm		
2	X846390	生頂橫(獨立生窗)	避位	672	1		底留	13	mm		
3	X846400	生底橫	避位	664	1		企料底部開避位		mm		
							底橫料防水巴鋸去		mm		
							水線孔在企料-----	頂	底		
							安裝扣碼	TC903			
							多點鎖芯型號:	東城2035B 鎖盒			
							手柄型號:	2017-MD			
							限位撐型號:				
							T窗最大的開度:				
							窗玉搭位數:	6mm			
							窗款	寬度	高度	隻/幅	撐長
							SHR	670.0	1128.0	2	18"
							大圖版次	本圖版			
								日期			
							窗号	寬度 (W)	高度 (H)	幅数	樓層數
							T5W-2	690	1150.0	39	6-26 28-50F
							圖號	T5W-2			
							窗玉用料				
序號	料號	名稱	出苟	長度 (mm)	支/幅	加工說明					
1	X846540	窗玉企	45°斜口	1128.0	2						
2	X846540	窗玉橫	45°斜口	670.0	2						
3	X846550	窗玉玻璃線企	直口	1064.0	2						
4	X846550	窗玉玻璃線橫	直口	574.0	2						


 美特鋁質 有限公司 MIDI Aluminium Fabricator Ltd.	工程號	J837	拆圖	鞠章芳	2018.11.08
	地盤	觀塘裕民坊	復核	謝永林	2018.11.10
名稱	50後裝窗	顏色	EC-DG-S332054 (3塗)	批准	

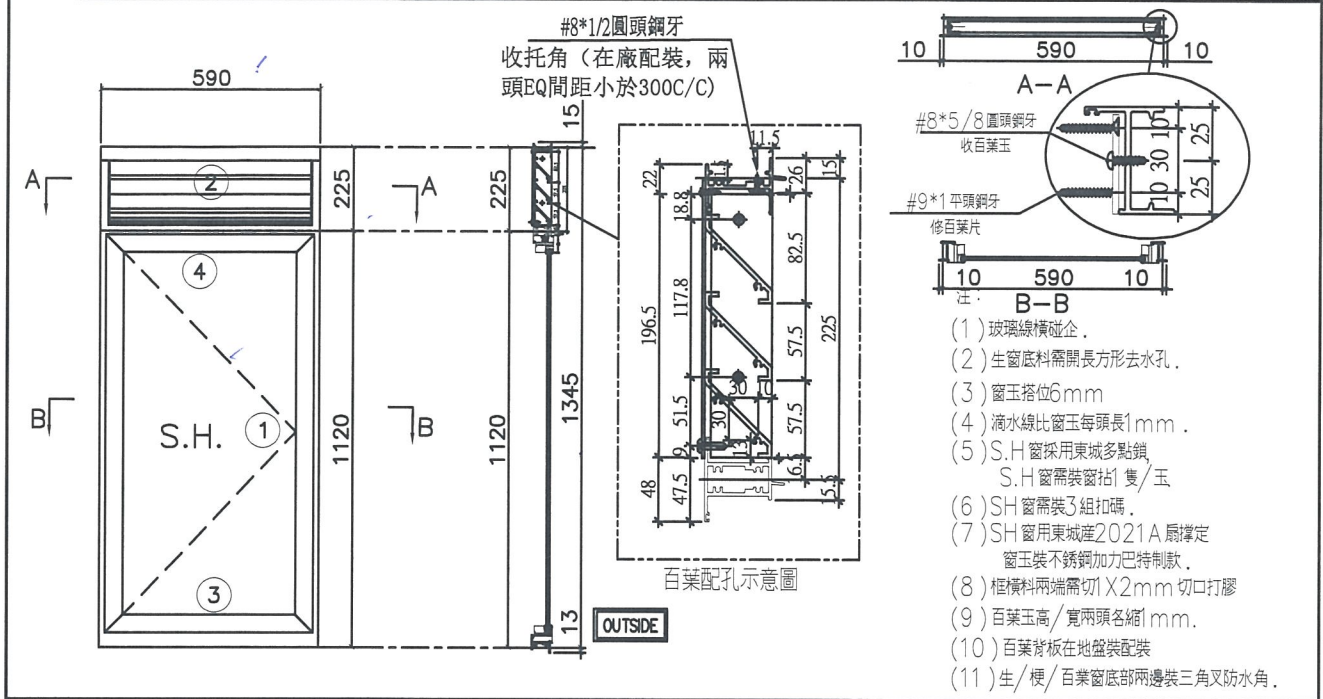

序號	料號	名稱	出苟	長度 (mm)	支/幅	加工說明	加工細則					
							頂	底	寬度	高度		
1	X846370	邊企料		1373.0	2		頂留	15	mm			
2	X846390	生頂橫	避位	572	1		底留	13	mm			
3	X846400	生底橫	避位	564	1		企料底部開避位					
4	X846080	上生下生中橫	避位	572	1		底橫料防水巴鋸去					
							水線孔在企料-----	頂	底			
							安裝扣碼	TC903				
							多點鎖芯型號:	東城2035B 鎖盒				
							手柄型號:	2017-MD				
							限位撐型號:					
							T窗最大的開度:					
							窗玉搭位數:	6mm				
							窗款	寬度	高度	隻/幅	撐長	
							SHR	570.0	1098.5	2	14"	
							大圖版次	本圖版				
							日期					
							窗號	寬度 (W)	高度 (H)	幅數	樓層數	
							T1W-A-2	590	1345.0	38	6-26 28-49F	
							圖號	T1W-A-2				

百葉玉用料						
序號	料號	名稱	出苟	長度 (mm)	支/幅	加工說明
1	ME0002318	百葉玉鋁巴	避位	196.5	2	
2	X843331	百葉片	避位	550.0	3	
3	X844890	百葉頂托角	直口	550.0	1	
窗玉用料						
序號	料號	名稱	出苟	長度 (mm)	支/幅	加工說明
1	X846540	窗玉企	45°斜口	1098.5	2	
2	X846540	窗玉橫	45°斜口	570.0	2	
3	X846550	窗玉玻璃線企	直口	1034.5	2	
4	X846550	窗玉玻璃線橫	直口	474.0	2	


 美特鋁質 有限公司 MIDI Aluminium Fabricator Ltd.	工程號	J837	拆圖	韓章芳	2018.11.08
	地盤	觀塘裕民坊	復核	謝永林	2018.11.10
名稱	50後裝窗	顏色	EC-DG-S332054 (3塗)	批准	

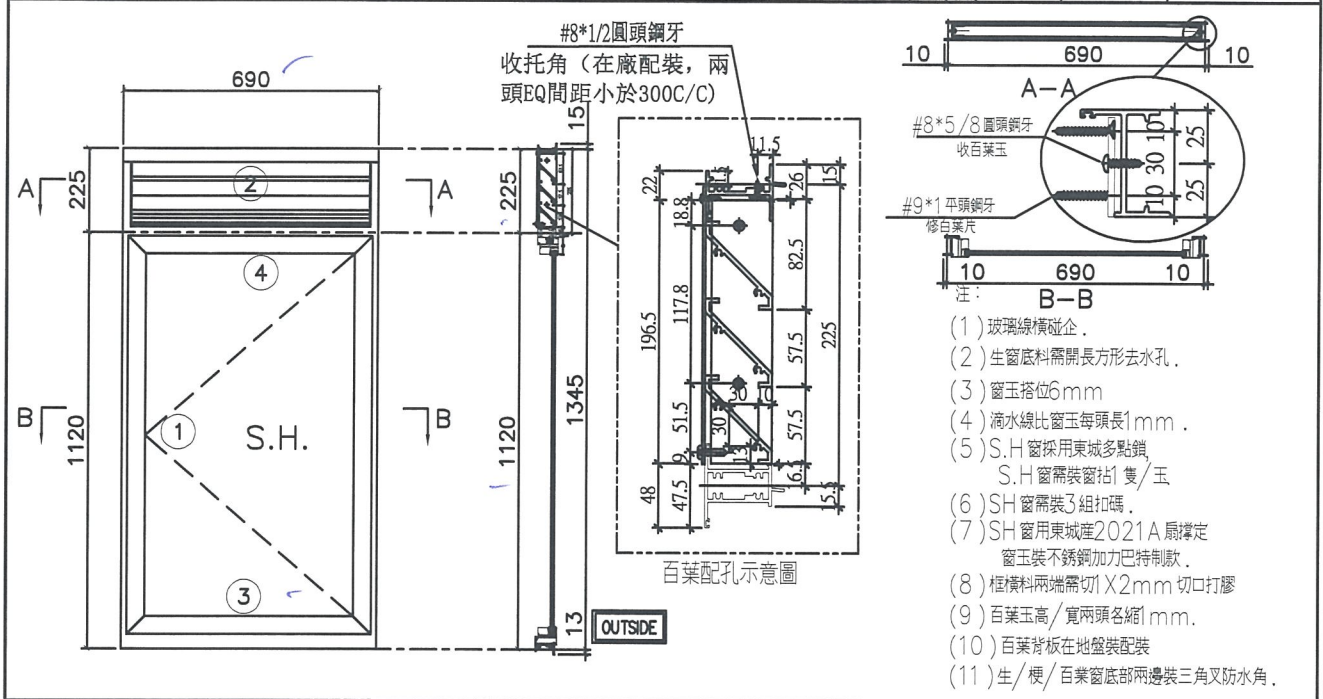


序號	料號	名稱	出荷	長度 (mm)	支/幅	加工說明	加工細則					
1	X846370	邊企料		1373.0	2		頂留	15	mm			
2	X846390	生頂橫	避位	672	1		底留	13	mm			
3	X846400	生底橫	避位	664	1		企料底部開避位					
4	X846080	上生下生中橫	避位	672	1		底橫料防水巴鋸去					
							水線孔在企料-----	頂	底			
							安裝扣碼	TC903				
							多點鎖芯型號:	東城2035B 鎖盒				
							手柄型號:	2017-MD				
							限位撐型號:					
							T窗最大的開度:					
							窗玉搭位數:	6mm				
							窗款	寬度	高度	隻/幅	撐長	
							SHL	670.0	1098.5	2	18"	
							大圖版次	本圖版				
							日期					
							窗号	寬度 (W)	高度 (H)	幅数	樓層數	
							T5W-M-BATH2	690	1345.0	1	51F	
							圖號	T5W-M-BATH2				

百葉玉用料						
序號	料號	名稱	出荷	長度 (mm)	支/幅	加工說明
1	ME0002318	百葉玉鋁巴	避位	196.5	2	
2	X843331	百葉片	避位	650.0	3	
3	X844890	百葉頂托角	直口	650.0	1	

窗玉用料						
序號	料號	名稱	出荷	長度 (mm)	支/幅	加工說明
1	X846540	窗玉企	45°斜口	1098.5	2	
2	X846540	窗玉橫	45°斜口	670.0	2	
3	X846550	窗玉玻璃線企	直口	1034.5	2	
4	X846550	窗玉玻璃線橫	直口	574.0	2	

 美特鋁質 有限公司 MIDI Aluminium Fabricator Ltd.	工程號	J837	拆圖	鞠章芳	2018.11.08
	地盤	觀塘裕民坊	復核	謝永林	2018.11.10
名稱	50後裝窗	顏色	EC-DG-S332054 (3塗)	批准	

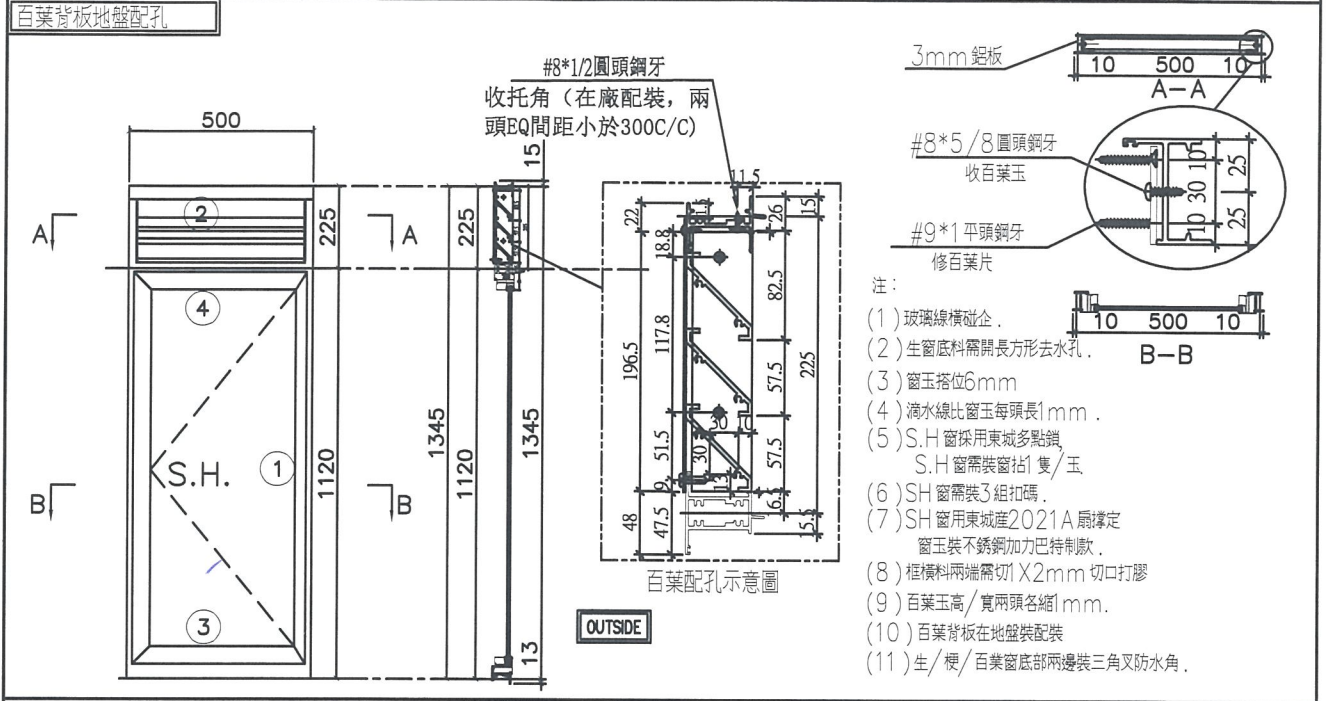


序號	料號	名稱	出苟	長度 (mm)	支/幅	加工說明	加工細則					
1	X846370	邊企料		1373.0	2		頂留	15	mm			
2	X846390	生頂橫	避位	482	1		底留	13	mm			
3	X846400	生底橫	避位	474	1		企料底部開避位		mm			
4	X846080	上生下生中橫	避位	482	1		底橫料防水巴鋸去		mm			
							水線孔在企料-----	頂	底			
							安裝扣碼	TC903				
							多點鎖芯型號:	東城2035B 鎖盒				
							手柄型號:	2017-MD				
							限位撐型號:					
							T窗最大的開度:					
							窗玉搭位數:	6mm				
							窗款	寬度	高度	隻/幅	撐長	
							SHL	480.0	1098.5	2	14"	
							大圓版次	本圖版				
								日期				
							窗號	寬度 (W)	高度 (H)	幅數	樓層數	
							T1W-H-2	500	1345.0	39	6-26 28-50F	
							T1W-C-3	500	1345.0	39	6-26 28-50F	
							圖號	T1W-H-2				

百葉玉用料						
序號	料號	名稱	出苟	長度 (mm)	支/幅	加工說明
1	ME0002318	百葉玉鋁巴	避位	196.5	2	
2	X843331	百葉片	避位	460.0	3	
3	X841890	百葉頂托角	直口	460.0	1	

窗玉用料						
序號	料號	名稱	出苟	長度 (mm)	支/幅	加工說明
1	X846540	窗玉企	45°斜口	1098.5	2	
2	X846540	窗玉橫	45°斜口	480.0	2	
3	X846550	窗玉玻璃線企	直口	1034.5	2	
4	X846550	窗玉玻璃線橫	直口	384.0	2	

 美特鋁質 有限公司 MIDI Aluminium Fabricator Ltd.	工程號	J837	拆圖	鞠章芳	2018.11.08
	地盤	觀塘裕民坊	復核	謝永林	2018.11.10
名稱	50後裝窗	顏色	EC-DG-S332054 (3塗)	批准	

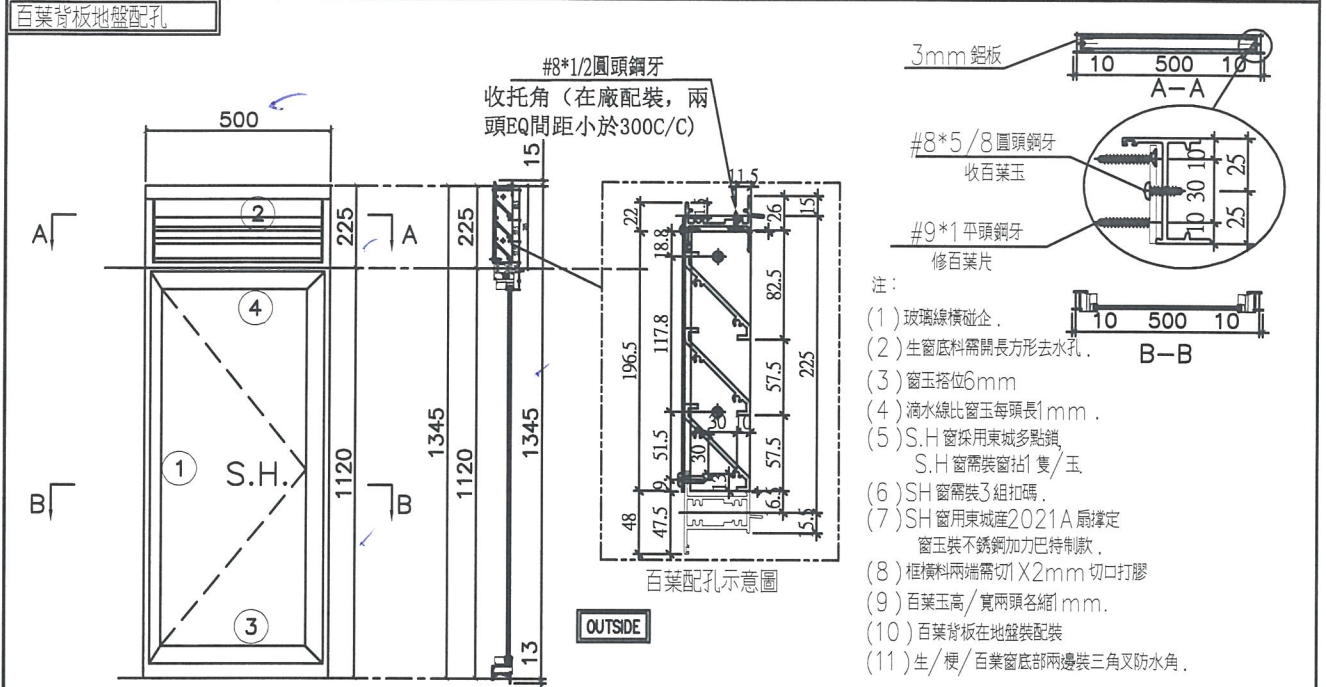


序號	料號	名稱	出荷	長度 (mm)	支/幅	加工說明	加工細則					
1	X846370	邊企料		1373.0	2		頂留	15	mm			
2	X846390	生頂橫	避位	482	1		底留	13	mm			
3	X846400	生底橫	避位	474	1		企料底部開避位		mm			
4	X846080	上生下生中橫	避位	482	1		底橫料防水巴鋸去		mm			
							水線孔在企料-----	頂	底			
							安裝扣碼	TC903				
							多點鎖芯型號:	東城2035B 鎖盒				
							手柄型號:	2017-MD				
							限位撐型號:					
							T窗最大的開度:					
							窗玉搭位數:	6mm				
							窗款	寬度	高度	隻/幅	撐長	
							SHR	480.0	1098.5	2	14"	
							大圓版次	本圖版				
								日期				
							窗號	寬度 (W)	高度 (H)	幅數	樓層數	
							T5W-L-4	500 ✓	1345.0 ✓	39 ✓	6-26 28-50F ✓	
							圖號	T5W-L-4				

百葉玉用料						
序號	料號	名稱	出荷	長度 (mm)	支/幅	加工說明
1	ME0002318	百葉玉鋁巴	避位	196.5	2	
2	X843331	百葉片	避位	460.0	3	
3	X844890	百葉頂托角	直口	460.0	1	


窗玉用料						
序號	料號	名稱	出荷	長度 (mm)	支/幅	加工說明
1	X846540	窗玉企	45°斜口	1098.5	2	
2	X846540	窗玉橫	45°斜口	480.0	2	
3	X846550	窗玉玻璃線企	直口	1034.5	2	
4	X846550	窗玉玻璃線橫	直口	384.0	2	

 美特鋁質 有限公司 MIDI Aluminium Fabricator Ltd.	工程號	J837	拆圖	韓章芳	2018.11.08
	地盤	觀塘裕民坊	復核	謝永林	2018.11.10
名稱	50後裝窗	顏色	EC-DG-S332054 (3塗)	批准	

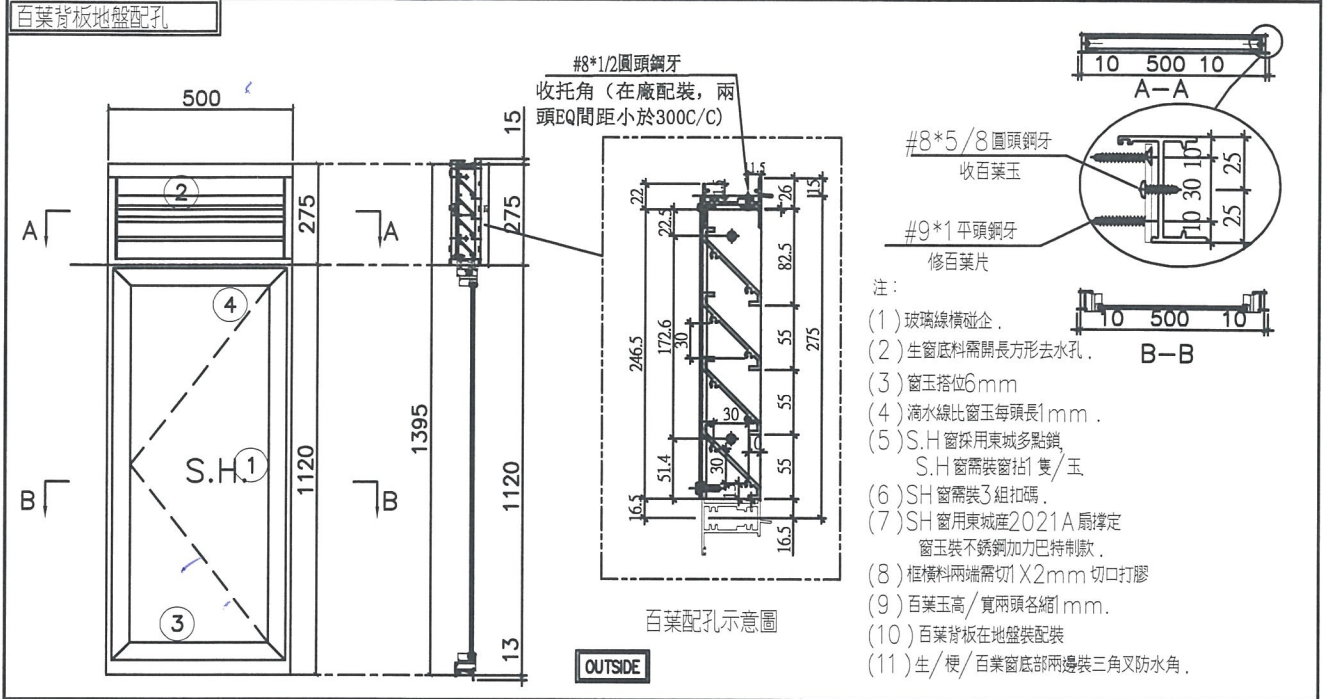

序號	料號	名稱	出荷	長度 (mm)	支/幅	加工說明	加工細則						
1	X846370	邊企料		1423.0	2		頂留	15	mm				
2	X846390	生頂橫	避位	482	1		底留	13	mm				
3	X846400	生底橫	避位	474	1		企料底部開避位		mm				
4	X846080	上生下生中橫	避位	482	1		底橫料防水巴鋸去		mm				
							水線孔在企料-----	頂	底				
							安裝扣碼	TC903					
							多點鎖芯型號:	東城2035B 鎖盒					
							手柄型號:	2017-MD					
							限位撐型號:						
							T窗最大的開度:						
							窗玉搭位數:	6mm					
							窗款	寬度	高度	隻/幅	撐長		
							SHL	480.0	1098.5	2	14"		
							百葉玉用料						
							大圖版次	本圖版					
								日期					
							窗號	寬度 (W)	高度 (H)	幅數	樓層數		
							T2W-N-3	500	1395.0	43	6-26 28-55F		
							窗玉用料						
							序號	料號	名稱	出荷	長度 (mm)	支/幅	加工說明
							1	X846540	窗玉企	45°斜口	1098.5	2	
							2	X846540	窗玉橫	45°斜口	480.0	2	
							3	X846550	窗玉玻璃線企	直口	1034.5	2	
							4	X846550	窗玉玻璃線橫	直口	384.0	2	
							圖號	T2W-N-3					

美特鋁質有限公司 MIDI Aluminium Fabricator Ltd.		工程號 J837 地盤 觀塘裕民坊	拆圖 鞠章芳 復核 謝永林	2018.11.08 2018.11.10
名稱 50後裝窗 百葉背板地盤配孔	顏色 EC-DG-S332054 (3塗)	批准		

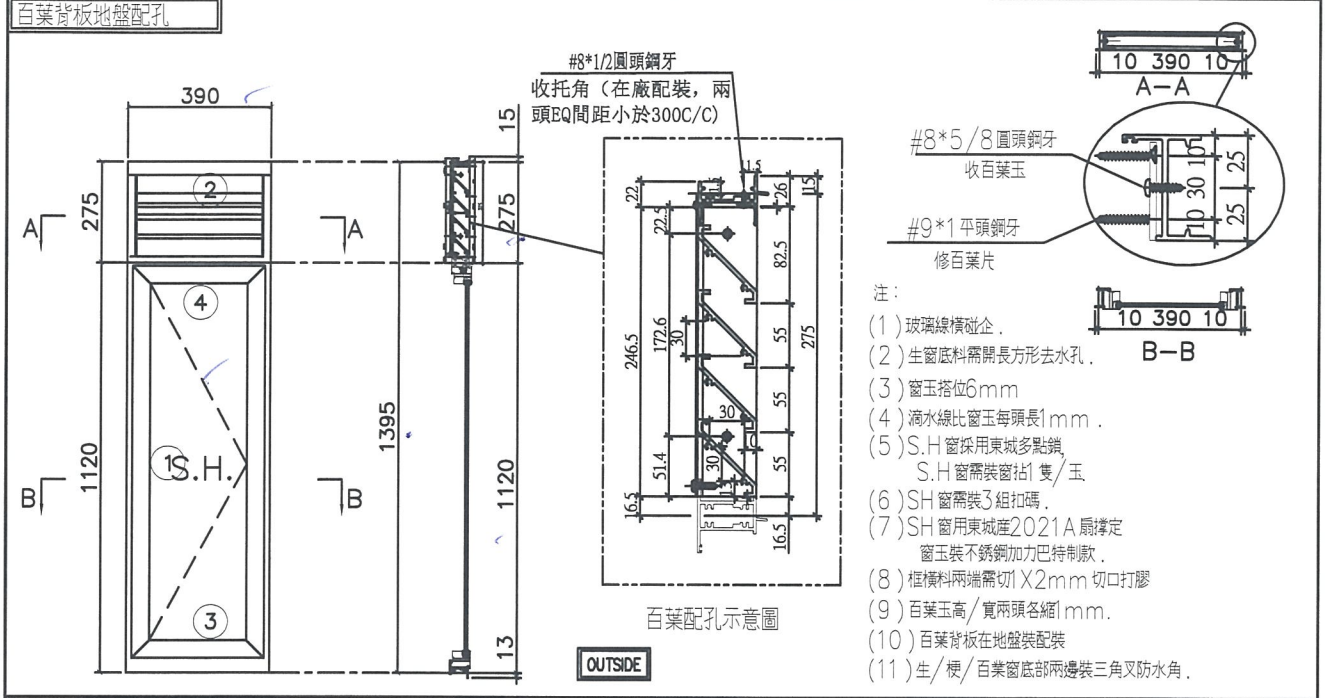


序號	料號	名稱	出荷	長度 (mm)	支/幅	加工說明	加工細則					
1	X846370	邊企料		1423.0	2		頂留	15	mm			
2	X846390	生頂橫	避位	372	1		底留	13	mm			
3	X846400	生底橫	避位	364	1		企料底部開避位		mm			
4	X846080	上生下生中橫	避位	372	1		底橫料防水巴鋸去		mm			
							水線孔在企料-----	頂		底		
							安裝扣碼	TC903				
							多點鎖芯型號:	東城2035B 鎖盒				
							手柄型號:	2017-MD				
							限位撐型號:					
							T窗最大的開度:					
							窗玉搭位數:	6mm				
							窗款	寬度	高度	隻/幅	撐長	
							SHR	370.0	1098.5	2	12"	
							大圖版次	本圖版				
								日期				
							窗号	寬度 (W)	高度 (H)	幅数	樓層數	
							T2W-C-1	390	1395.0	43	6-26 28-55F	
							圖號	T2W-C-1				

百葉玉用料						
序號	料號	名稱	出荷	長度 (mm)	支/幅	加工說明
1	ME0002318	百葉玉鋁巴	避位	246.5	2	
2	X843331	百葉片	避位	350.0	4	
3	X844890	百葉頂托角	直口	350.0	1	

窗玉用料						
序號	料號	名稱	出荷	長度 (mm)	支/幅	加工說明
1	X846540	窗玉企	45°斜口	1098.5	2	
2	X846540	窗玉橫	45°斜口	370.0	2	
3	X846550	窗玉玻璃線企	直口	1034.5	2	
4	X846550	窗玉玻璃線橫	直口	274.0	2	

 美特鋁質 有限公司 MIDI Aluminium Fabricator Ltd.	工程號	J837	拆圖	鞠章芳	2018.11.08
	地盤	觀塘裕民坊	復核	謝永林	2018.11.10
名稱	50後裝窗	顏色	EC-DG-S332054 (3塗)	批准	

百葉背板地盤配孔

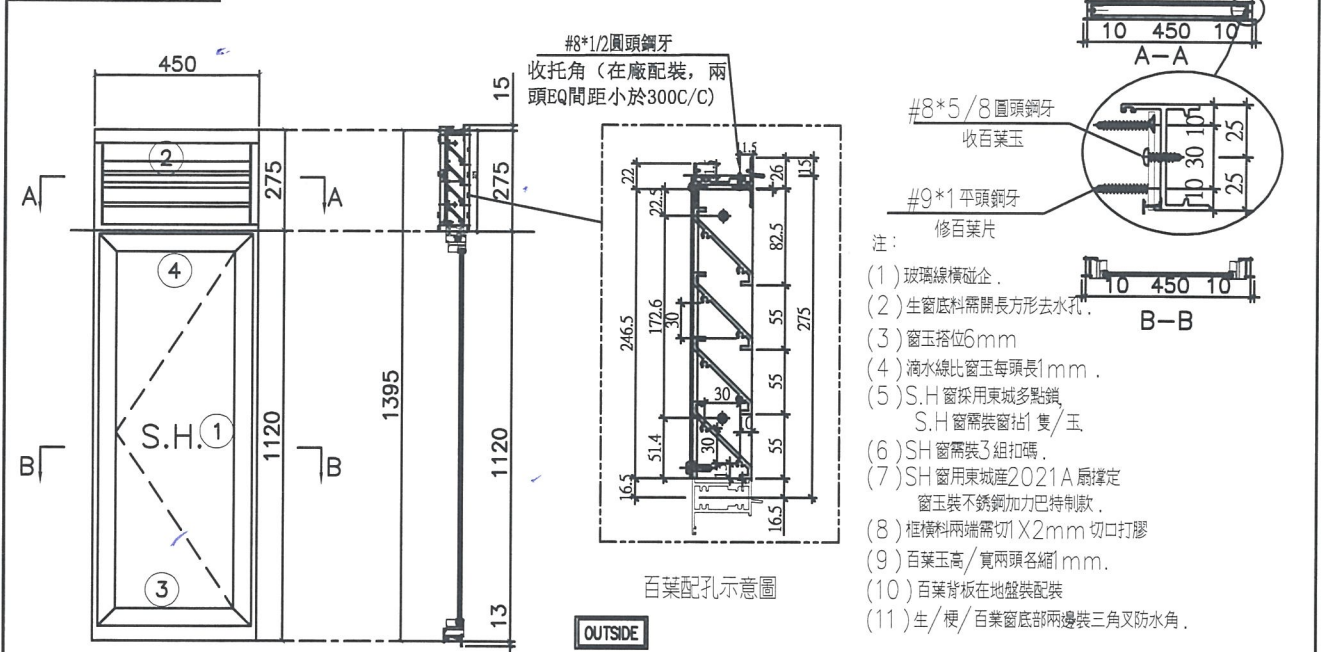


序號	料號	名稱	出苟	長度 (mm)	支/幅	加工說明	加工細則					
1	X846370	邊企料		1423.0	2		頂留	15	mm			
2	X846390	生頂橫	避位	432	1		底留	13	mm			
3	X846400	生底橫	避位	424	1		企料底部開避位		mm			
4	X846080	上生下生中橫	避位	432	1		底橫料防水巴鋸去		mm			
							水線孔在企料----	頂	底			
							安裝扣碼	TC903				
							多點鎖芯型號:	東城2035B 鎖盒				
							手柄型號:	2017-MD				
							限位撐型號:					
							T窗最大的開度:					
							窗玉搭位數:	6mm				
							窗款	寬度	高度	隻/幅	撐長	
							SHL	430.0	1098.5	2	12"	
							大圖版次	本圖版				
							日期					
							窗号	寬度 (W)	高度 (H)	幅数	樓層數	
							T2W-D-1	450	1395.0	43	6-26 28-55F	
							圖號	T2W-D-1				

百葉玉用料						
序號	料號	名稱	出苟	長度 (mm)	支/幅	加工說明
1	ME0002318	百葉玉鋁巴	避位	246.5	2	
2	X843331	百葉片	避位	410.0	4	
3	X844890	百葉頂托角	直口	410.0	1	

窗玉用料						
序號	料號	名稱	出苟	長度 (mm)	支/幅	加工說明
1	X846540	窗玉企	45°斜口	1098.5	2	
2	X846540	窗玉橫	45°斜口	430.0	2	
3	X846550	窗玉玻璃線企	直口	1034.5	2	
4	X846550	窗玉玻璃線橫	直口	334.0	2	

美特鋁質有限公司 MIDI Aluminium Fabricator Ltd.		工程號 J837 地盤 觀塘裕民坊	拆圖 韓章芳 復核 謝永林	2018.11.08 2018.11.10
名稱 50後裝窗 百葉基板地盤配孔	顏色 EC-DG-S332054 (3塗)	批准		

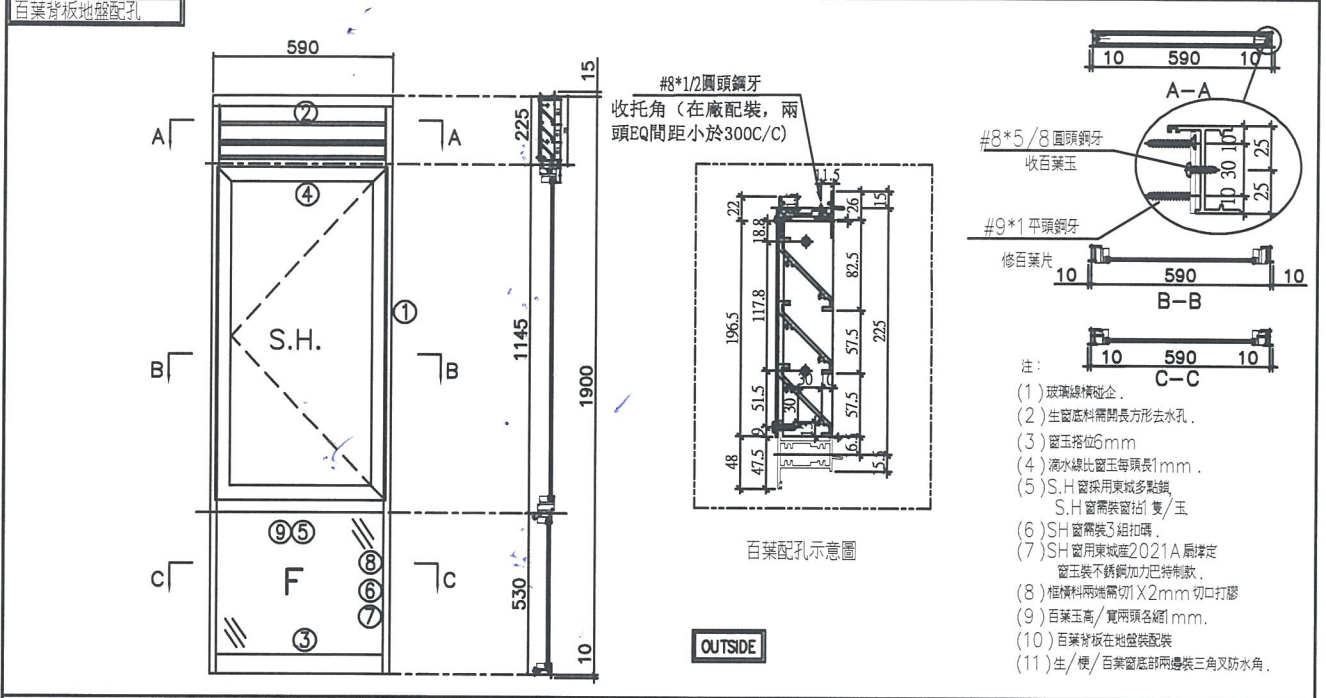


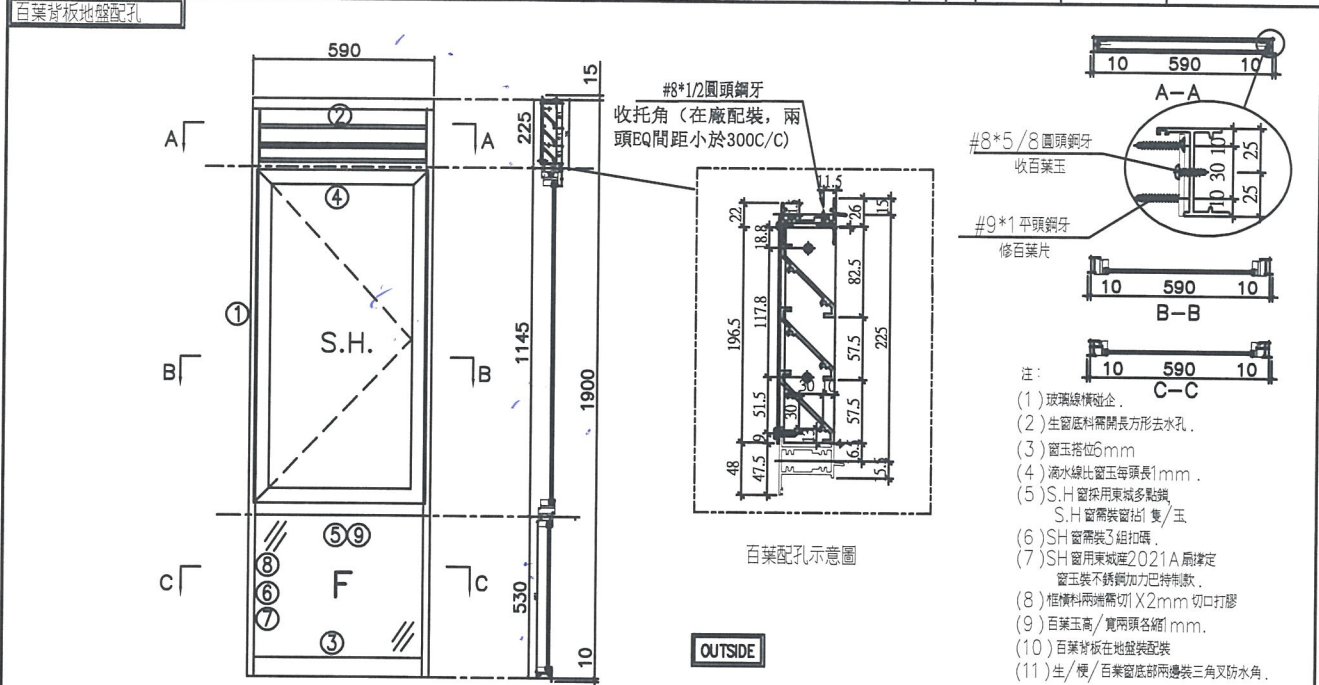
- 注:
- (1) 玻璃線橫企。
 - (2) 生窗底料需開長方形去水孔。
 - (3) 窗玉搭位6mm
 - (4) 滴水線比窗玉每頭長1mm。
 - (5) S.H.窗採用東城多點鎖
S.H.窗需裝窗插1隻/玉
 - (6) SH窗需裝3組扣碼。
 - (7) SH窗用東城運2021A扇撐定
窗玉裝不銹鋼加力巴特制款。
 - (8) 框橫料兩端需切1X2mm切口打膠
 - (9) 百葉玉寬/寬兩頭各縮1mm。
 - (10) 百葉基板在地盤裝配
 - (11) 生/便/百葉窗底部兩邊裝三角叉防水角。

序號	料號	名稱	出苟	長度 (mm)	支/幅	加工說明	加工細則					
1	X846370	邊企料		1925.0	2		頂留	15	mm			
2	X846390	生頂橫	避位	572	1		底留	10	mm			
3	X84642	梗底橫	避位	564	1		企料底部開避位		mm			
4	X846080	上生下生中橫	避位	572	1		底橫料防水巴鋸去		mm			
5	X846100	上生下梗中橫	避位	564	1		水線孔在企料-----	頂	底			
6	X846070	反拍線	避位	493.5	2		安裝扣碼	TC903				
7	X845451	反拍線擋膠鋁角	直口	493.5	2		多點鎖芯型號:	東城2035B 鎖盒				
8	X846550	梗窗玻璃線企	直口	493.5	2		手柄型號:	2017-MD				
9	X846550	梗窗玻璃線橫	直口	474.0	2		限位撐型號:					
							T窗最大的開度:					
							窗玉搭位數:	6mm				
							窗玉	寬度	高度	隻/幅	撐長	
							SHL	570.0	1126.0	2	14"	
							大圖版次	本圖版				
								日期				
							窗号	寬度 (W)	高度 (H)	幅数	樓層數	
							T2W-M-2	590	1900.0	43	6-26	28-55F
							T2W-N-2	590	1900.0	43	6-26	28-55F
							T2W-A-5	590	1900.0	43	6-26	28-55F
							T2W-A-4	590	1900.0	43	6-26	28-55F
							T3W-A2	590	1900.0	41	6-26	28-52F
							T5W-A-3	590	1900.0	39	6-26	28-50F
							T5W-M-2	590	1900.0	39	6-26	28-50F
							T2W-H-1	590	1900.0	42	6-26	28-53F
							T1W-G3	590	1900.0	39	6-26	28-50F
							圖號	T2W-M-2				


百葉玉用料						
序號	料號	名稱	出苟	長度 (mm)	支/幅	加工說明
1	ME0002318	百葉玉鋁巴	避位	196.5	2	
2	X843331	百葉片	避位	550.0	3	
3	X844890	百葉頂托角	直口	550.0	1	


窗玉用料						
序號	料號	名稱	出苟	長度 (mm)	支/幅	加工說明
1	X846540	窗玉企	45°斜口	1126.0	2	
2	X846540	窗玉橫	45°斜口	570.0	2	
3	X846550	窗玉玻璃線企	直口	1062.0	2	
4	X846550	窗玉玻璃線橫	直口	474.0	2	

 美特鋁質 有限公司 MIDI Aluminium Fabricator Ltd.		工程號 J837 地盤 觀塘裕民坊	拆圖 鞠章芳 復核 謝永林	2018.11.08 2018.11.10
名稱 50後裝窗	顏色 EC-DG-S332054 (3塗)	批准		



序號	料號	名稱	出荷	長度 (mm)	支/幅	加工說明	加工細則				
1	X846370	邊企料		1925.0	2		頂留	15	mm		
2	X846390	生頂橫	避位	572	1		底留	10	mm		
3	X84642	梗底橫	避位	564	1		企料底部開避位				
4	X846080	上生下生中橫	避位	572	1		底橫料防水巴鋸去				
5	X846100	上生下梗中橫	避位	564	1		水線孔在企料-----	頂	底		
6	X846070	反拍線	避位	493.5	2		安裝扣碼	TC903			
7	X845451	反拍線擋膠鋁角	直口	493.5	2		多點鎖芯型號:	東城2035B 鎖盒			
8	X846550	梗窗玻璃線企	直口	493.5	2		手柄型號:	2017-MD			
9	X846550	梗窗玻璃線橫	直口	474.0	2		限位撐型號:				
							T窗最大的開度:				
							窗玉搭位數:	6mm			
							窗玉	寬度	高度	隻/幅	撐長
							SHR	570.0	1126.0	2	14"
百葉玉用料											
序號	料號	名稱	出荷	長度 (mm)	支/幅	加工說明	大圖版次	本圖版			
1	ME0002318	百葉玉鋁巴	避位	196.5	2			日期			
2	X843331	百葉片	避位	550.0	3		窗號	寬度 (W)	高度 (H)	幅數	樓層數
3	X844890	百葉頂托角	直口	550.0	1		T2W-B-2	590	1900.0	43	6-26 28-55F
							T2W-B-1	590	1900.0	43	6-26 28-55F
							T3W-B-2	590	1900.0	41	6-26 28-52F
							T3W-E-1	590	1900.0	40	6-26 28-51F
							T5W-G-2	590	1900.0	39	6-26 28-50F
							T3W-B-1	590	1900.0	41	6-26 28-52F
							圖號	T2W-B-2			

 美特鋁質 有限公司 MIDI Aluminium Fabricator Ltd.	工程號	J837	拆圖	鞠章芳	2018.11.08
	地盤	觀塘裕民坊	復核	謝永林	2018.11.10
名稱	50後裝窗	顏色	EC-DG-S332054 (3塗)	批准	

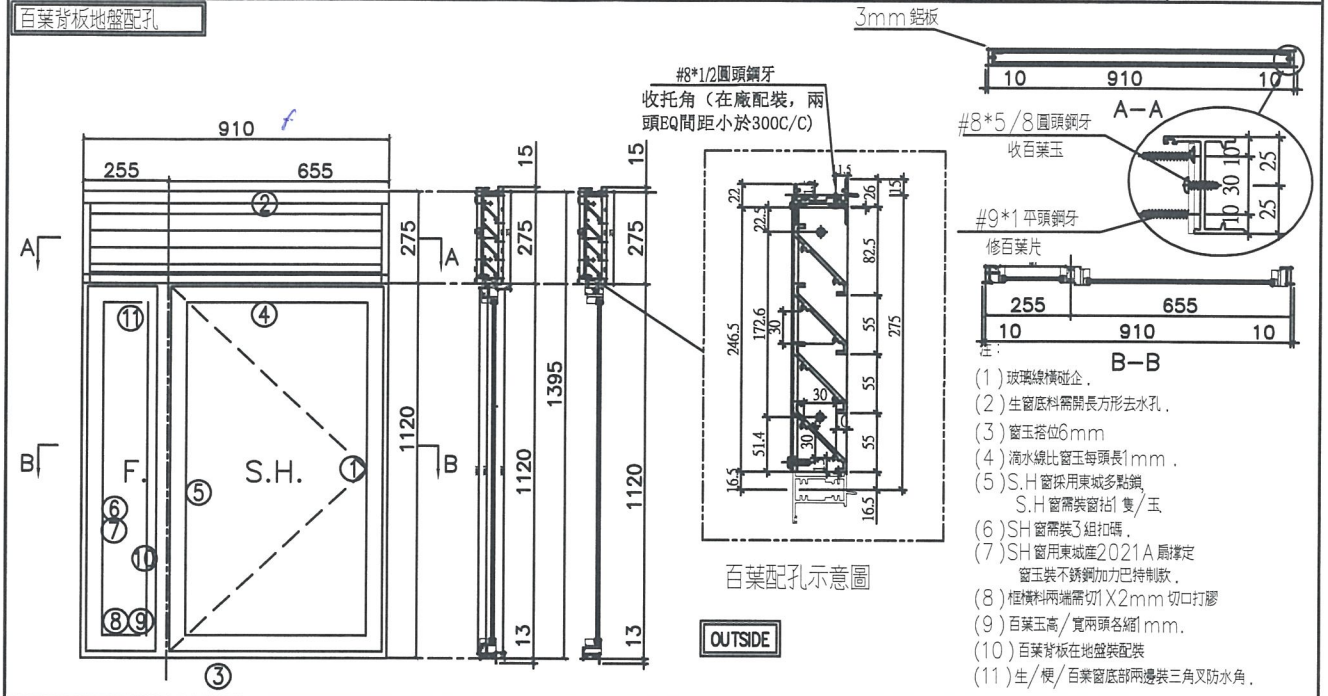

序號	料號	名稱	出苟	長度 (mm)	支/幅	加工說明	加工細則		
1	X846370	邊企料		1423.0	2		頂留	15	mm
2	X846390	梗頂橫	避位	892	1		底留	13	mm
3	X846400	生底橫	避位	884	1		企料底部開避位		mm
4	X846080	上生下生中橫	避位	892	1		底橫料防水巴鋸去		mm
5	X846100	左梗右生中企	避位	1092.5	1		水線孔在企料	頂	底
6	X846070	反拍線企	避位	1086.5	1		安裝扣碼	TC903	
7	X845451	反拍線擋膠鋁角	直口	1086.5	1		多點鎖芯型號:	東城2035B 鎖盒	
8	X846070	反拍線橫	避位	197.5	2		手柄型號:	2017-MD	
9	X845451	反拍線擋膠鋁角	直口	197.5	2		限位撐型號:		
10	X846550	梗窗玻璃線企	直口	1034.5	2		T窗最大的開度:		
11	X846550	梗窗玻璃線橫	直口	165.5	2		窗玉搭位數:		

窗玉	寬度	高度	隻/幅	撐長
SHR	635.5	1098.5	2	16"

百葉玉用料


序號	料號	名稱	出苟	長度 (mm)	支/幅	加工說明
1	ME0002318	百葉玉鋁巴	避位	246.5	2	
2	X843331	百葉片	避位	870	4	
3	X844890	百葉頂托角	直口	870	1	


窗玉用料

序號	料號	名稱	出苟	長度 (mm)	支/幅	加工說明
1	X846540	窗玉企	45°斜口	1098.5	2	
2	X846540	窗玉橫	45°斜口	635.5	2	
3	X846550	窗玉玻璃線企	直口	1034.5	2	
4	X846550	窗玉玻璃線橫	直口	539.5	2	

大圖版次	本圖版			
日期				
窗号	寬度 (W)	高度 (H)	幅数	樓層數
T1W-A-1	910	1395.0	38	6-26 28-49F
圖號	T1W-A-1			

EG-DWG1


 美特鋁質 有限公司 MIDI Aluminium Fabricator Ltd.	工程號	J837	拆圖	韓章芳	2018.11.08
	地盤	觀塘裕民坊	復核	謝永林	2018.11.10
名稱	50後裝窗	顏色	EC-DG-S332054 (3塗)	批准	

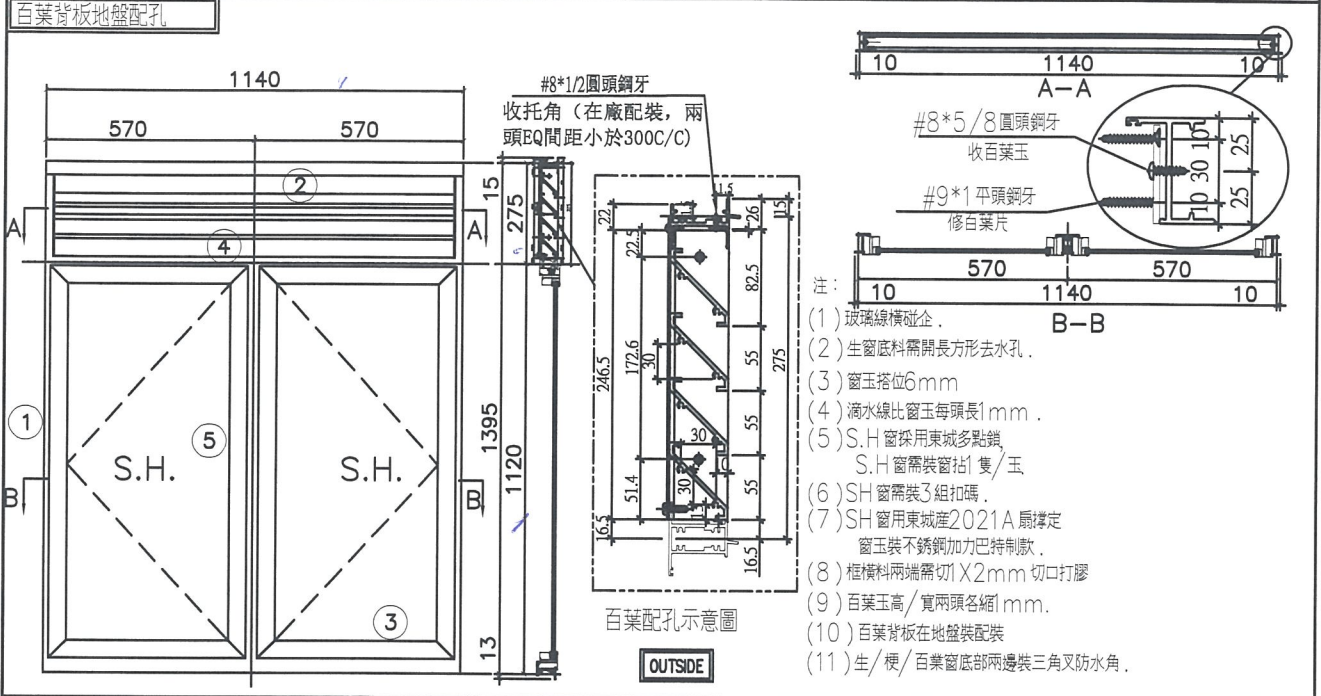


序號	料號	名稱	出荷	長度 (mm)	支/幅	加工說明	加工細則				
1	X846370	邊企料		1423.0	2		頂留	15	mm		
2	X846390	生頂橫	避位	1122	1		底留	13	mm		
3	X846400	生底橫	避位	1114	1		企料底部開避位				
4	X846080	上生下生中橫	避位	1122	1		底橫料防水巴鋸去				
5	X846090	企工	避位	1092.5	1		水線孔在企料-----	頂	底		
							安裝扣碼			TC903	
							多點鎖芯型號:			東城2035B 鎖盒	
							手柄型號:			2017-MD	
							限位撐型號:				
							T窗最大的開度:				
							窗玉搭位數:			6mm	
							窗款	寬度	高度	隻/幅	撐長
							SHL	550.5	1098.5	2	14"
							SHR	550.5	1098.5	2	14"
							大圖版次		本圖版		
									日期		
							窗号	寬度 (W)	高度 (H)	幅数	樓層數
							T5W-A-1	1140	1395.0	39	6-26 28-50F
							圖號	T5W-A-1			

百葉玉用料

序號	料號	名稱	出荷	長度 (mm)	支/幅	加工說明
1	ME0002318	百葉玉鋁巴	避位	246.5	2	
2	X843331	百葉片	避位	1100.0	4	
3	X844890	百葉頂托角	直口	1100.0	1	
						窗玉用料
序號	料號	名稱	出荷	長度 (mm)	支/幅	加工說明
1	X846540	窗玉企	45°斜口	1098.5	4	
2	X846540	窗玉橫	45°斜口	550.5	4	
3	X846550	窗玉玻璃線企	直口	1034.5	4	
4	X846550	窗玉玻璃線橫	直口	454.5	4	

 美特鋁質 有限公司 MIDI Aluminium Fabricator Ltd.	工程號	J837	拆圖	韓章芳	2018.11.08
	地盤	觀塘裕民坊	復核	謝永林	2018.11.10
名稱	50後裝窗	顏色	EC-DG-S332054 (3塗)	批准	

百葉背板地盤配孔

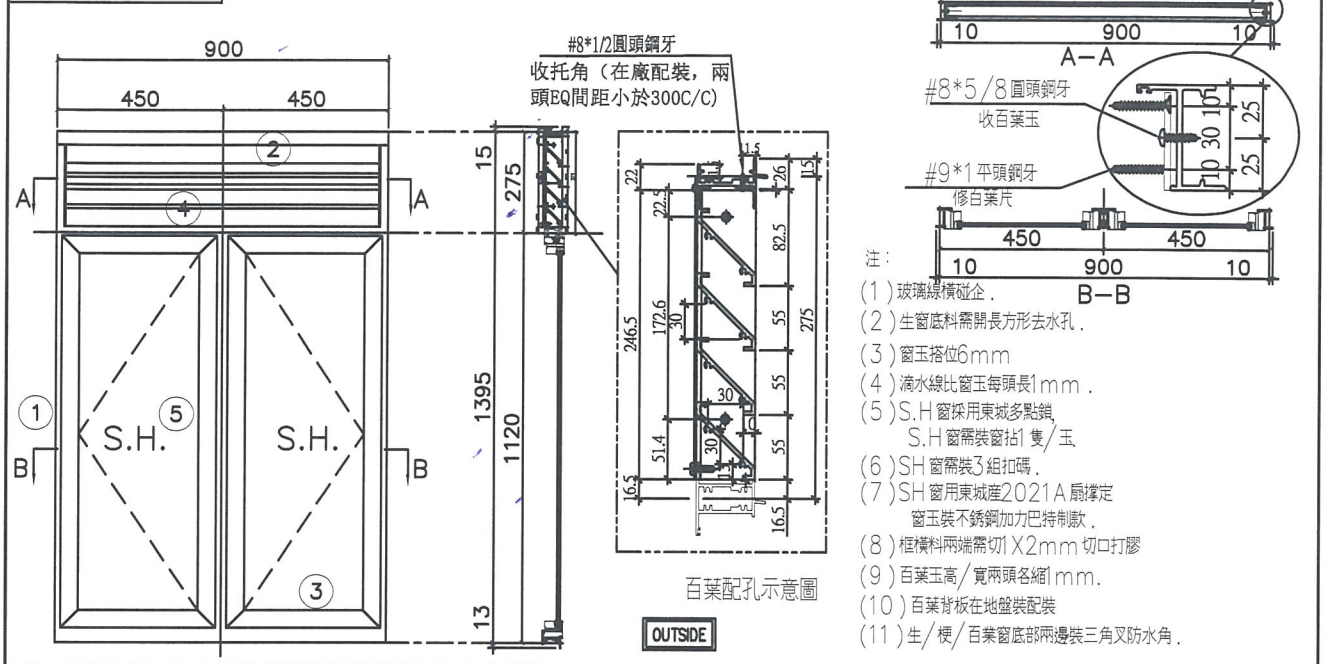

序號	料號	名稱	出苟	長度 (mm)	支/幅	加工說明	加工細則					
1	X846370	邊企料		1423.0	2		頂留	15	mm			
2	X846390	生頂橫	避位	882	1		底留	13	mm			
3	X846400	生底橫	避位	874	1		企料底部開避位		mm			
4	X846080	上生下生中橫	避位	882	1		底橫料防水巴鋸去		mm			
5	X846090	企工	避位	1092.5	1		水線孔在企料-----	頂		底		
							安裝扣碼	TC903				
							多點鎖芯型號:	東城2035B 鎖盒				
							手柄型號:	2017-MD				
							限位撐型號:					
							T窗最大的開度:					
							窗玉搭位數:	6mm				
							窗款	寬度	高度	隻/幅	撐長	
							SHL	430.5	1098.5	2	12"	
							SHR	430.5	1098.5	2	12"	
百葉玉用料							大圖版次		本圖版			
序號	料號	名稱	出苟	長度 (mm)	支/幅	加工說明	窗号	寬度 (W)	高度 (H)	幅数	樓層數	
1	ME0002318	百葉玉鋁巴	避位	246.5	2		T2W-M-1	900	1395.0	43	6-26 28-55F	
2	X843331	百葉片	避位	860.0	4							
3	X844890	百葉頂托角	直口	860.0	1							
窗玉用料							圖號	T2W-M-1				
序號	料號	名稱	出苟	長度 (mm)	支/幅	加工說明						
1	X846540	窗玉企	45°斜口	1098.5	4							
2	X846540	窗玉橫	45°斜口	430.5	4							
3	X846550	窗玉玻璃線企	直口	1034.5	4							
4	X846550	窗玉玻璃線橫	直口	334.5	4							


23

EG-DWG3




美特鋁質 有限公司
MIDI Aluminium Fabricator Ltd.

工程號 J837 地盤 觀塘裕民坊

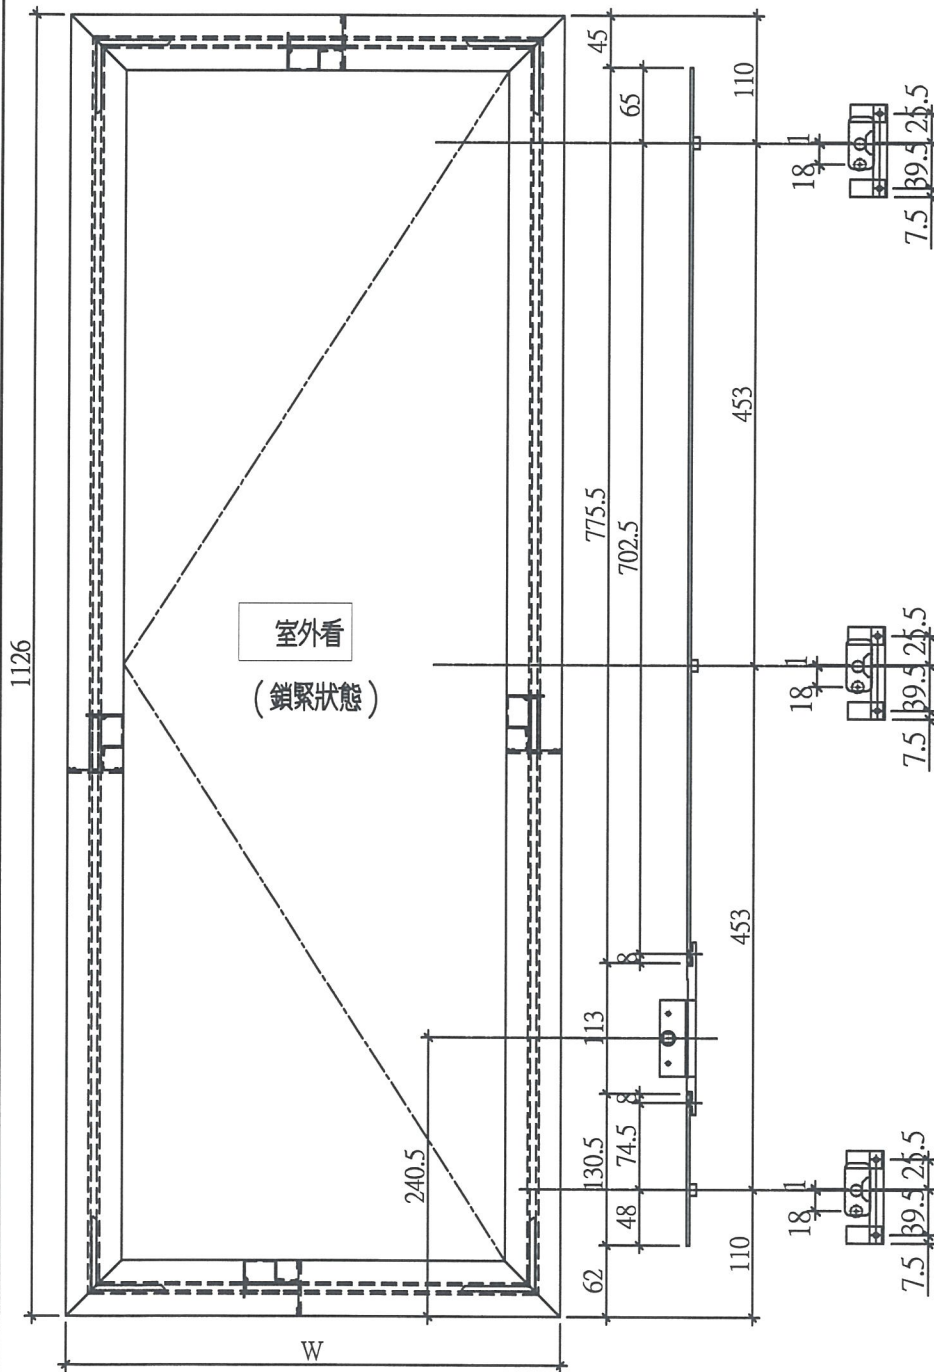

室外看
(鎖緊狀態)

W	數量	使用位置
570	39	T1W-G3
570	43	T2W-M-2
570	43	T2W-N-2
570	43	T2W-A-4
570	43	T2W-A-5
570	41	T3W-A-2
570	42	T2W-H-1
570	39	T5W-A-3
570	39	T5W-M-2
合計	共372幅	

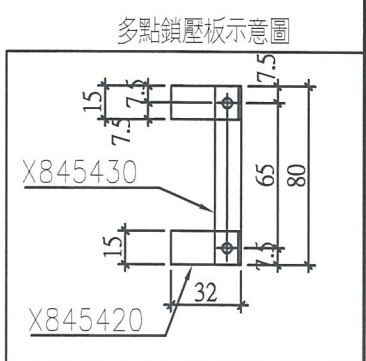



名稱	多點鎖放樣圖	制圖	鞠章芳	2018.11.08	修改		
材料	14*3鋁/X845420/X845430	復核	謝永林	2018.11.10	日期		
顏色	EC-DG-S332054 (3塗)	批准			圖號	837-FYA1	



美特鋁質 有限公司
MIDI Aluminium Fabricator Ltd.

工程號 J837 地盤 觀塘裕民坊

W	數量	使用位置
515	39	T5W-L-3
515	41	T3W-A-3
515	40	T5W-F-2
480	39	T1W-C-3
515	39	T1W-G2
480	39	T1W-H-2
670	1	T5W-M-BATH2
480	43	T2W-N-3
430	43	T2W-D-1
550.5	39	T5W-A-1
430.5	43	T2W-M-1
555.5	1	T2W-G-4
555.5	1	T3W-H-3
合計	共408幅	

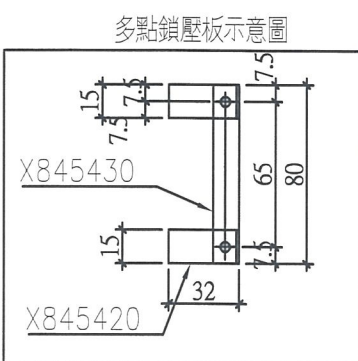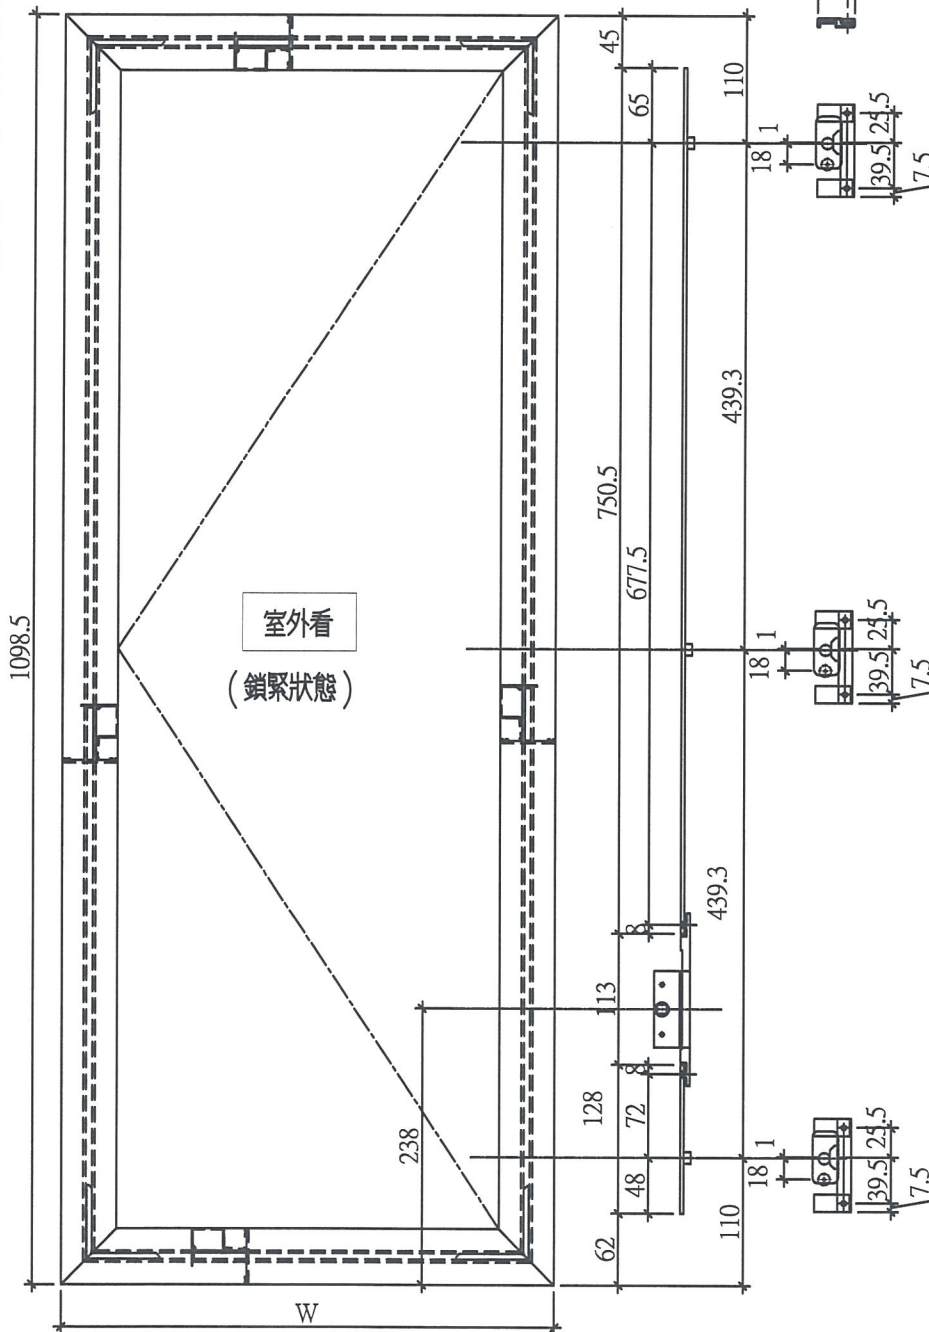

名稱	多點鎖放樣圖	制圖	鞠章芳	2018.11.08	修改	
材料	14*3鋁/X845420/X845430	復核	謝永林	2018.11.10	日期	
顏色	EC-DG-S332054 (3塗)	批准			圖號	837-FYA2

25


EG-DWG3




美特鋁質 有限公司
MIDI Aluminium Fabricator Ltd.

工程號 J837 地盤 觀塘裕民坊

W	數量	使用位置
570	43	T2W-N-1
585	39	T5W-L-5
合計	共82幅	

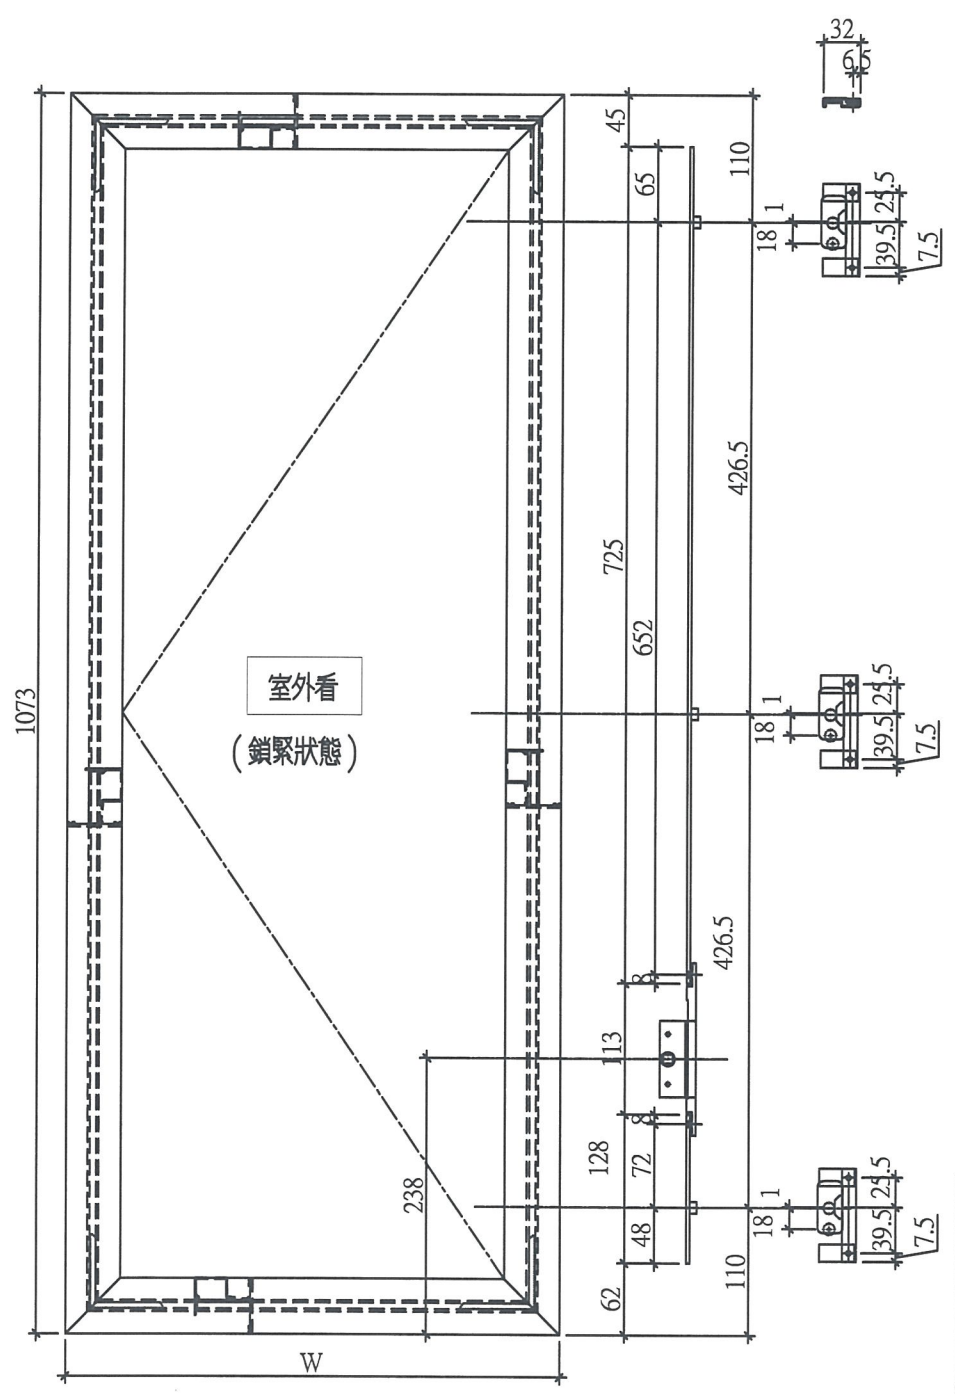

室外看
(鎖緊狀態)

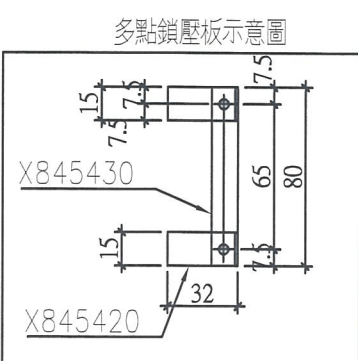

名稱	多點鎖放樣圖	制圖	鞠章芳	2018.11.08	修改		
材料	14*3鋁/X845420/X845430	復核	謝永林	2018.11.10	日期		
顏色	EC-DG-S332054 (3塗)	批准			圖號	837-FYA3	

26


EG-DWG3




美特鋁質 有限公司
MIDI Aluminium Fabricator Ltd.

工程號 J837 地盤 觀塘裕民坊

W	數量	使用位置
570	43	T2W-B-1
570	43	T2W-B-2
570	41	T3W-B-1
570	41	T3W-B-2
570	40	T3W-E-1
570	39	T5W-G-2
合計	共247幅	

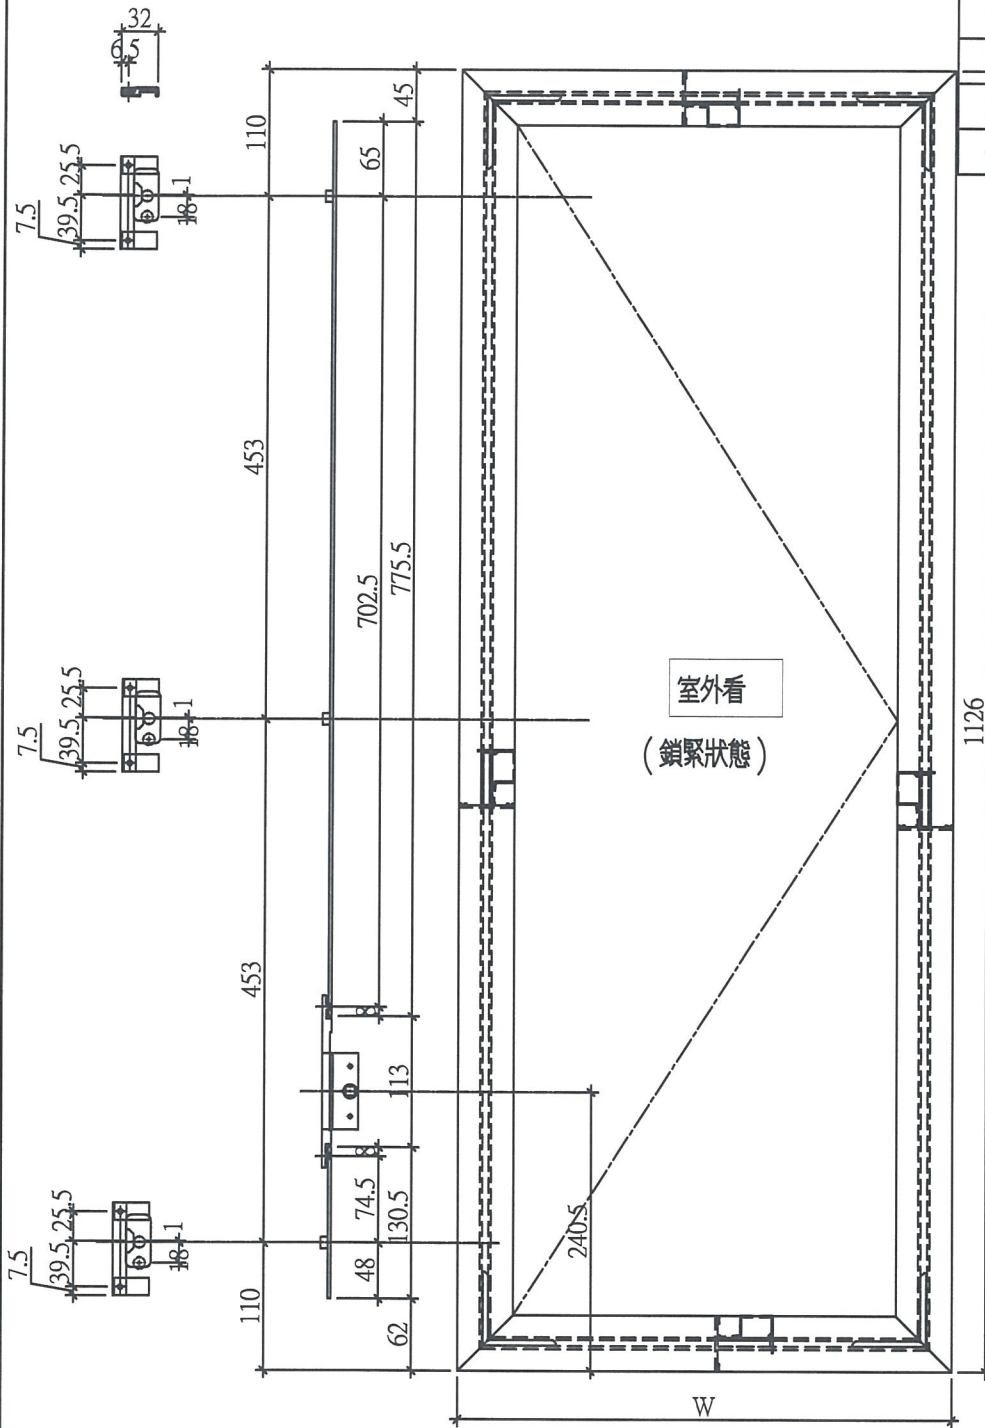

室外看
(鎖緊狀態)

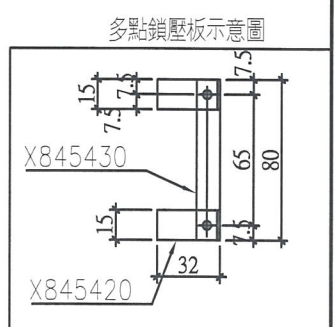


名稱	多點鎖放樣圖	制圖	鞠章芳	2018.11.08	修改		
材料	14*3鋁/X845420/X845430	復核	謝永林	2018.11.10	日期		
顏色	EC-DG-S332054 (3塗)	批准			圖號	837-FYA4	




美特鋁質 有限公司
MIDI Aluminium Fabricator Ltd.

工程號 J837 地盤 觀塘裕民坊

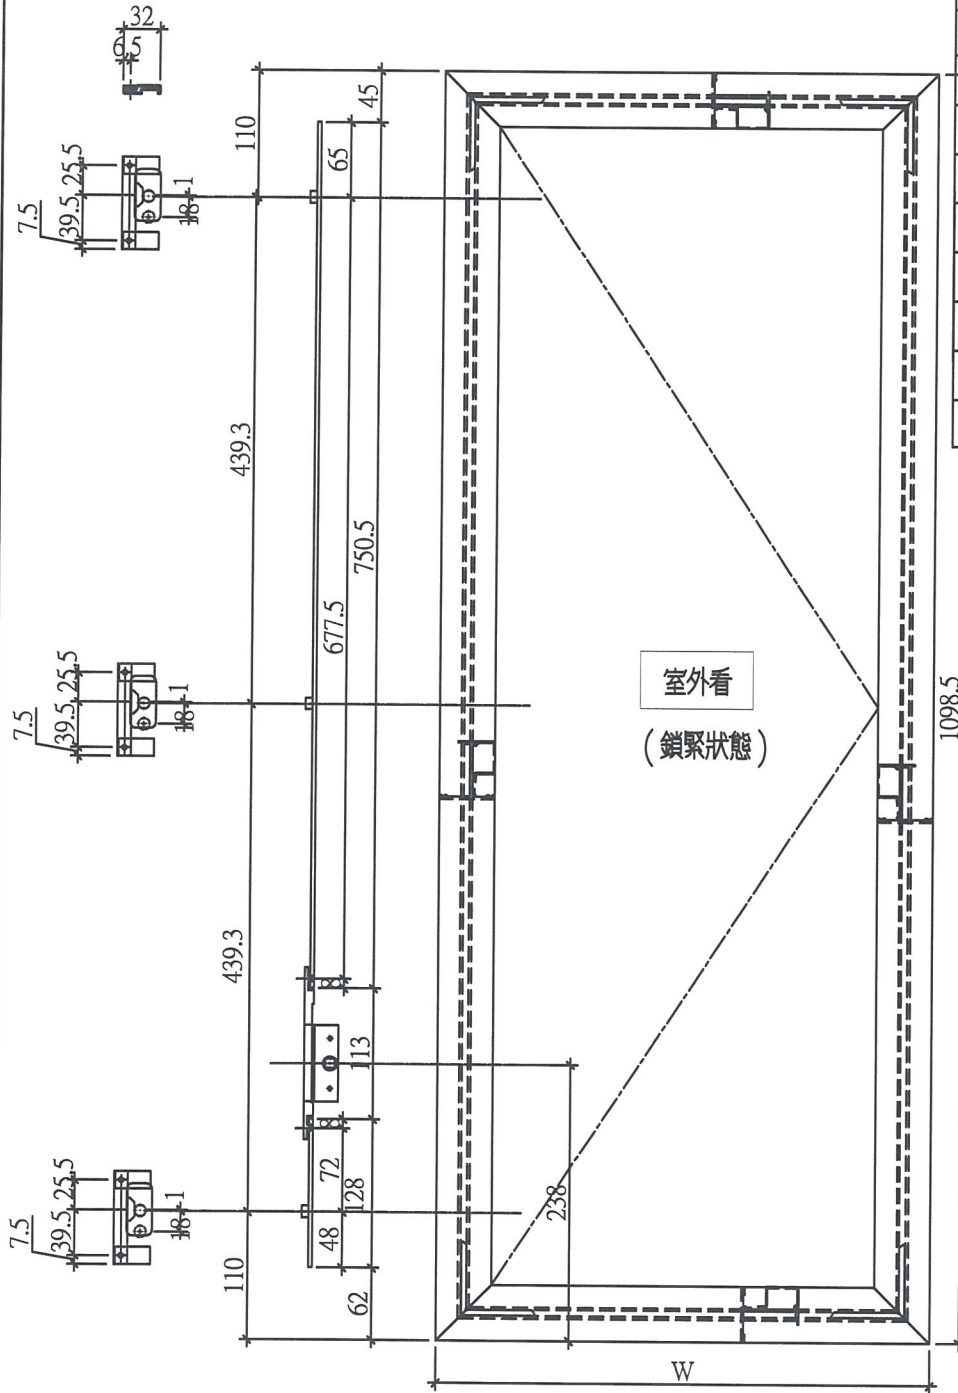

W	數量	使用位置
515	39	T1W-C-2
515	39	T1W-H-1
515	40	T3W-E-2
515	1	T5W-M-BATH1
515	39	T5W-N-1
370	43	T2W-C-1
635.5	38	T1W-A-1
550.5	39	T5W-A-1
430.5	43	T2W-M-1
555.5	1	T2W-G-4
555.5	1	T3W-H-3
570	38	T1W-A-2
480	39	T5W-L-4
合計	共400幅	

多點鎖壓板示意圖

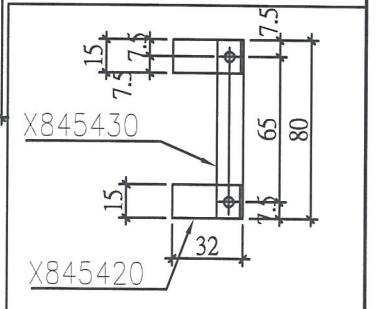


名稱	多點鎖放樣圖	制圖	鞠章芳	2018.11.08	修改	
材料	14*3鋁/X845420/X845430	復核	謝永林	2018.11.10	日期	
顏色	EC-DG-S332054 (3塗)	批准			圖號	837-FYA5




美特鋁質 有限公司
MIDI Aluminium Fabricator Ltd.

工程號 J837 地盤 觀塘裕民坊

W	數量	使用位置
630	39	T5W-A-2
630	39	T1W-E3

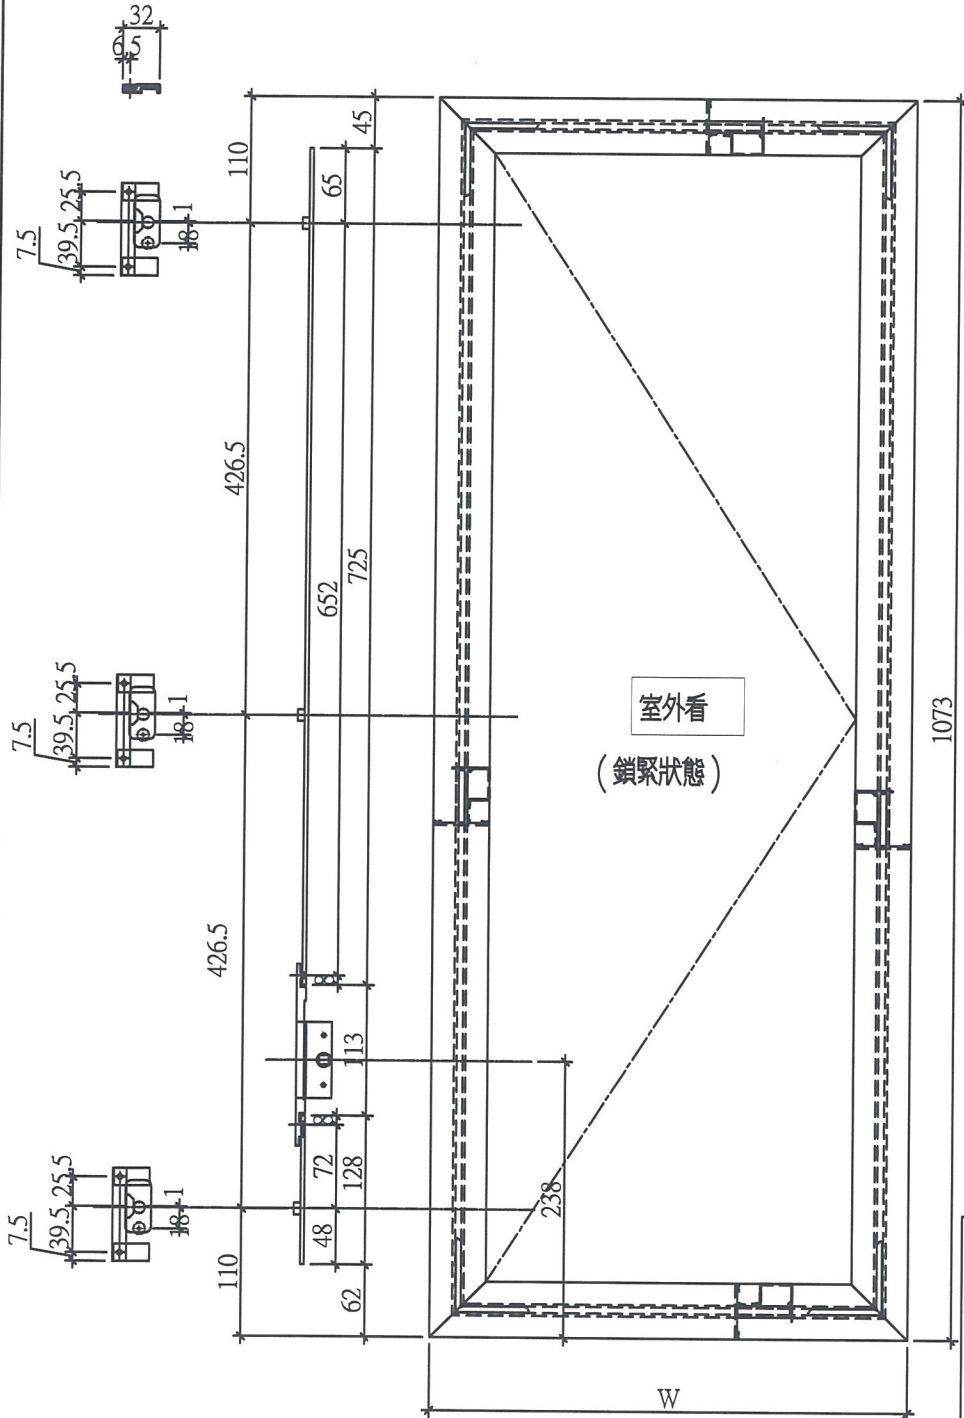

多點鎖壓板示意圖

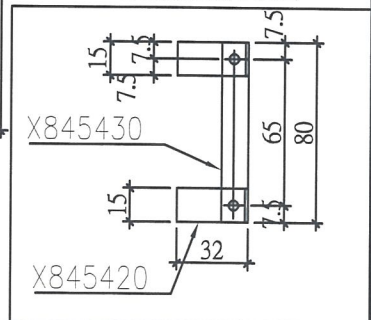


名稱	多點鎖放機圖	制圖	鞠章芳	2018.11.08	修改		
材料	14*3鋁/X845420/X845430	復核	謝永林	2018.11.10	日期		
顏色	EC-DG-S332054 (3塗)	批准			圖號	837-FYA6	




美特鋁質 有限公司
MIDI Aluminium Fabricator Ltd.

W	數量	使用位置
570	38	T5W-A-4

工程號	J837	地盤	觀塘裕民坊
-----	------	----	-------

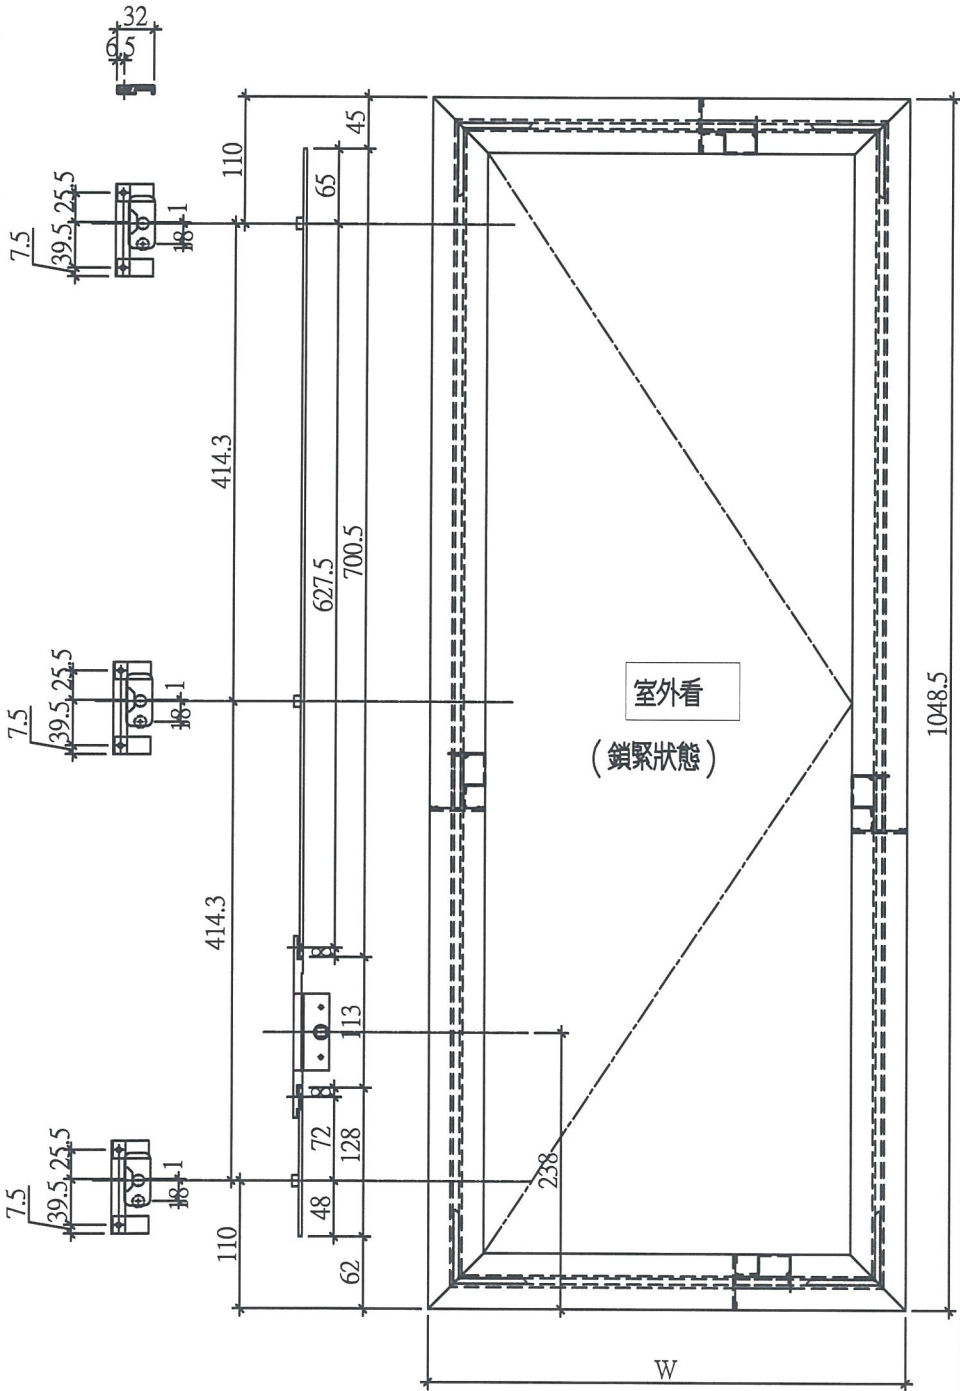

多點鎖壓板示意圖

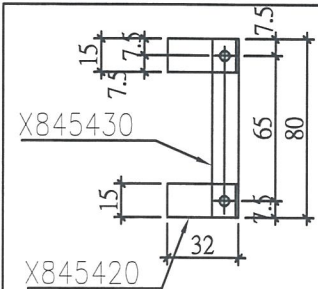


名稱	多點鎖放樣圖	制圖	鞠章芳	2018.11.08	修改		
材料	14*3鋁/X845420/X845430	復核	謝永林	2018.11.10	日期		
顏色	EC-DG-S332054 (3塗)	批准			圖號	837-FYA7	



美特鋁質 有限公司
MIDI Aluminium Fabricator Ltd.


工程號 J837 地盤 觀塘裕民坊

W	數量	使用位置
680	40	T3W-1
680	41	T3W-5
670	39	T5W-2
合計	共120幅	

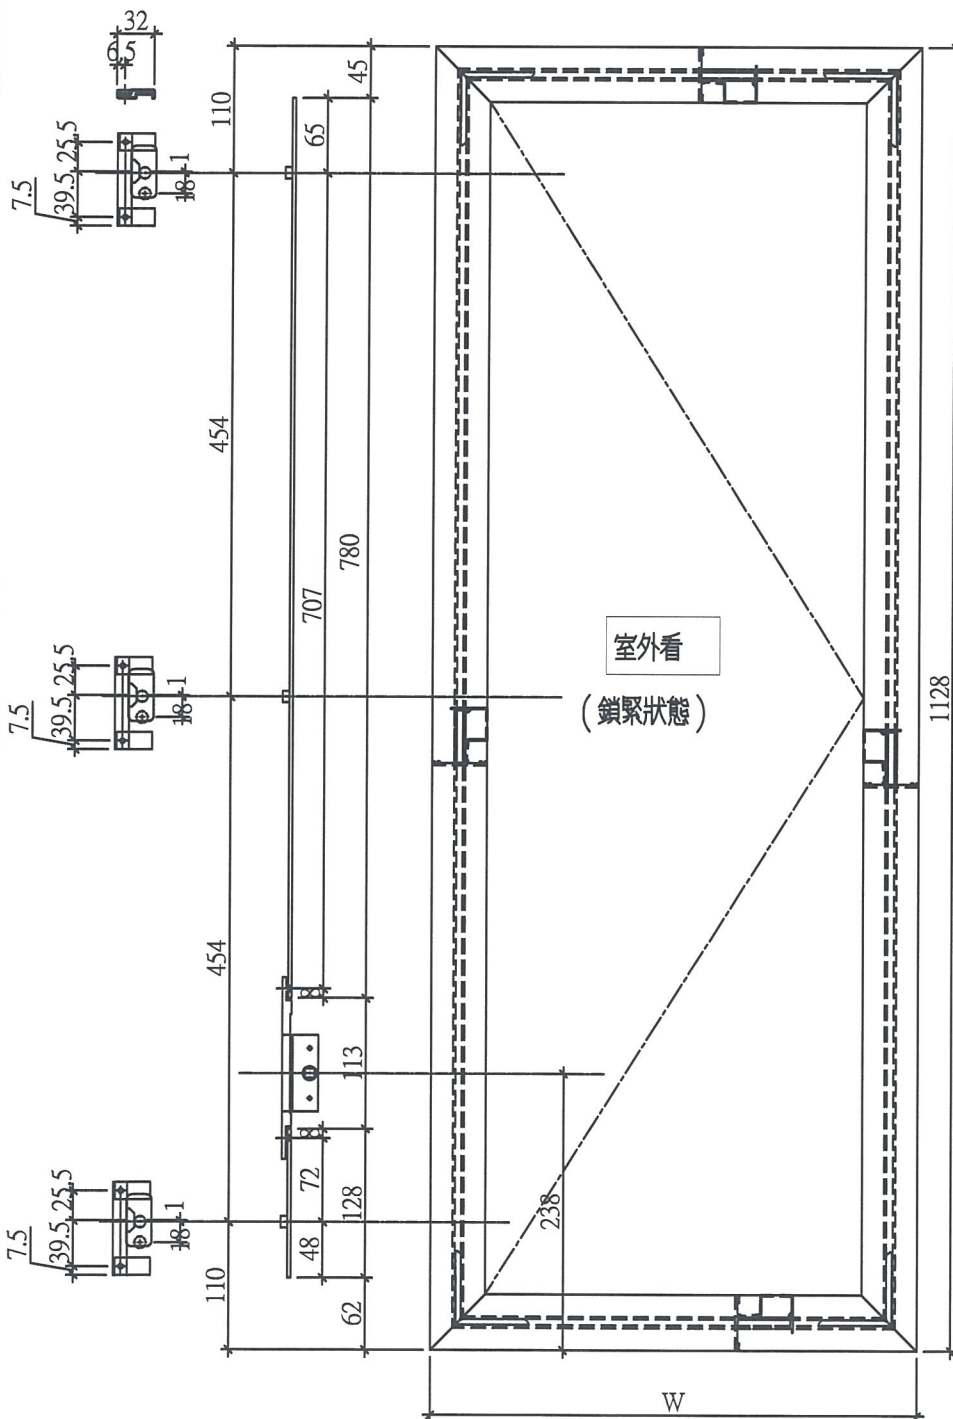

室外看
(鎖緊狀態)

多點鎖壓板示意圖






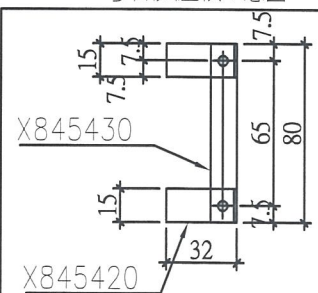


名稱	多點鎖放樣圖	制圖	鞠章芳	2018.11.08	修改		
材料	14*3鋁/X845420/X845430	復核	謝永林	2018.11.10	日期		
顏色	EC-DG-S332054 (3塗)	批准			圖號	837-FYA8	



美特鋁質 有限公司
MIDI Aluminium Fabricator Ltd.

工程號 J837 地盤 觀塘裕民坊

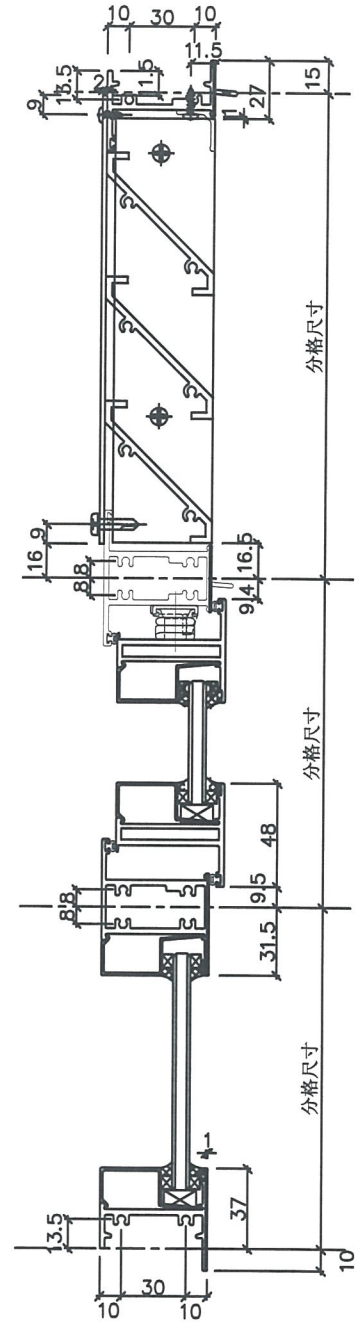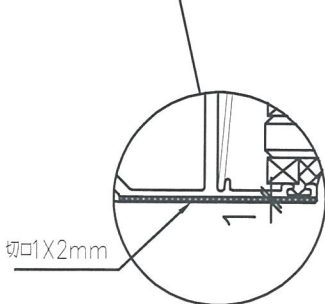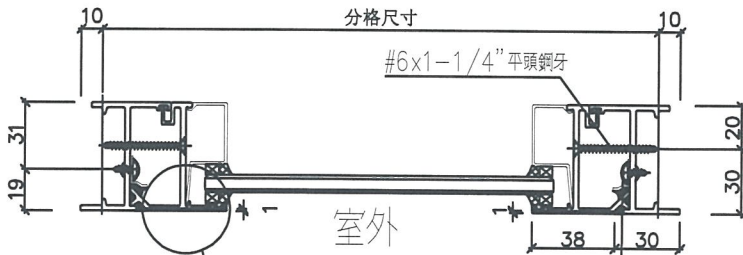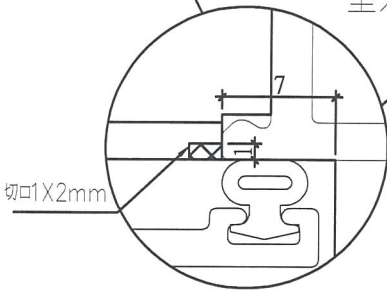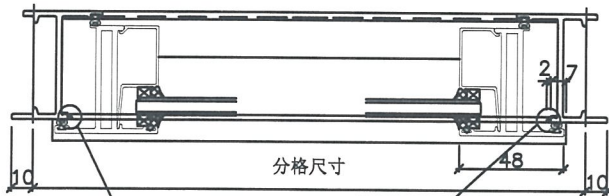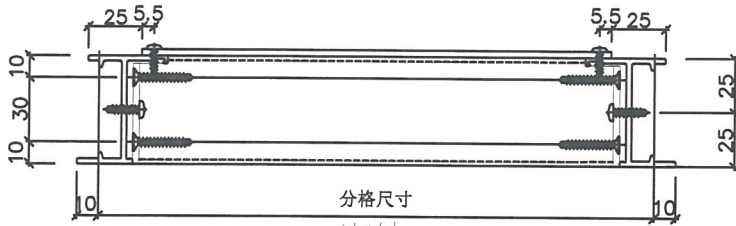


上生下梗窗用節點

名稱	50窗節點示意圖	制圖	鞠章芳	2018.11.08	修改		
材料	—	復核	謝永林	2018.11.10	日期		
顏色	EC-DG-S332054 (3塗)	批准			圖號	837-WB1	



美特鋁質 有限公司
MIDI Aluminium Fabricator Ltd.

工程號 J837 地盤 觀塘裕民坊

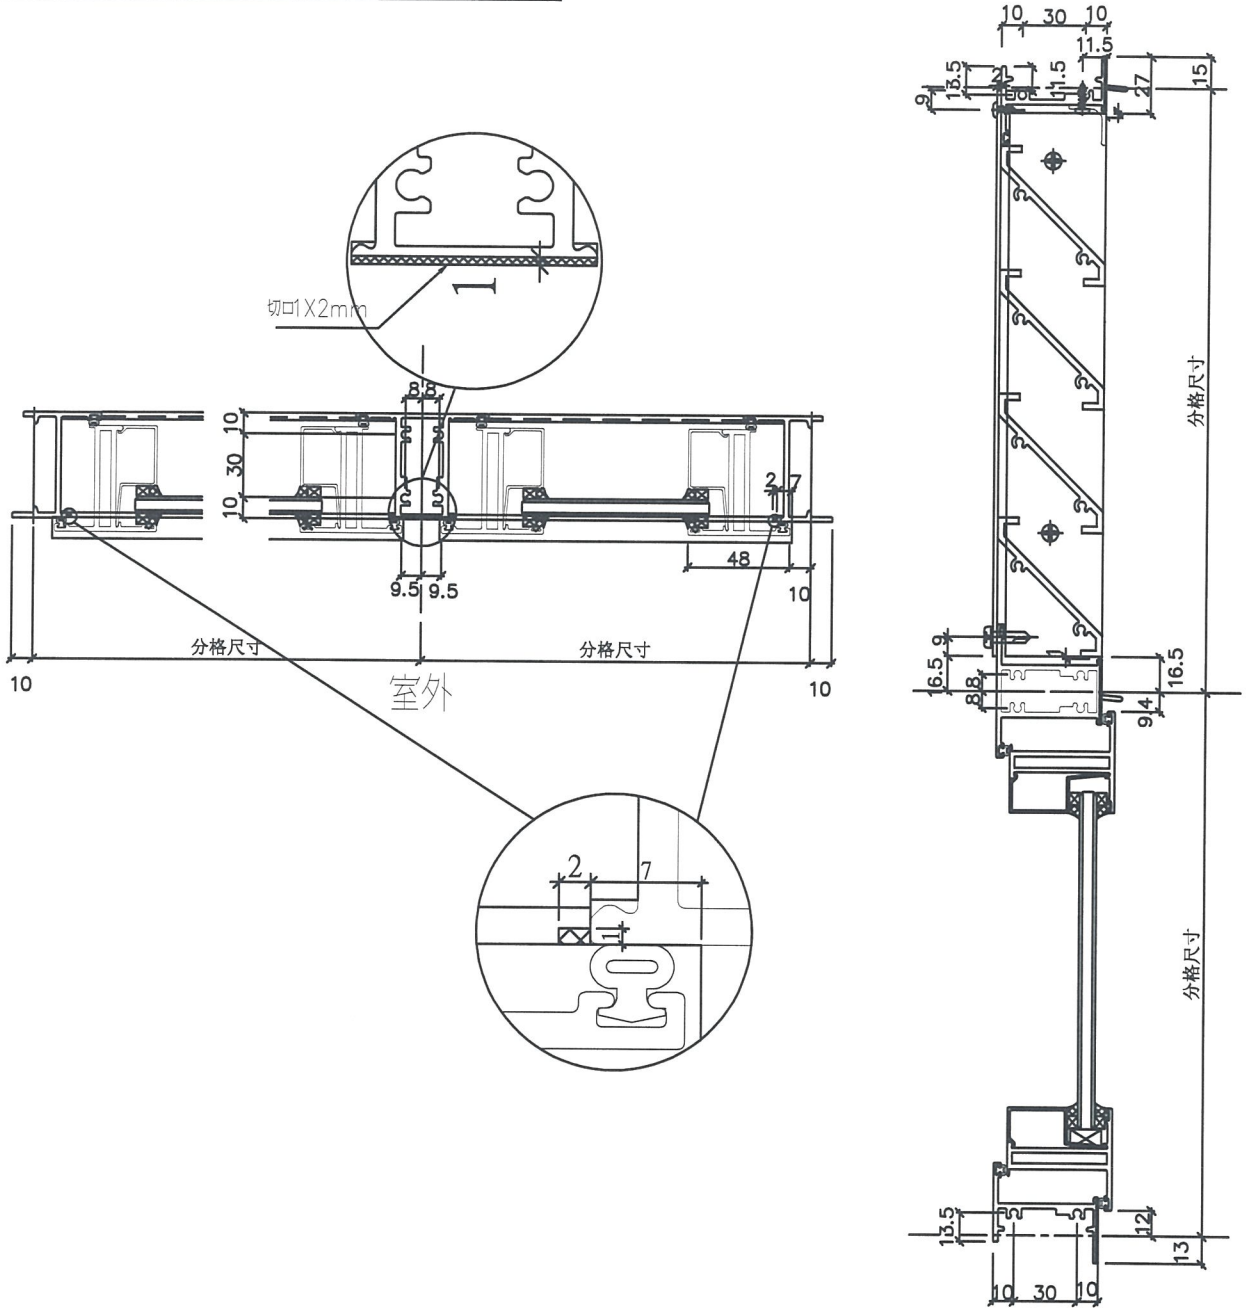


雙開生窗用節點

名稱	50窗節點示意圖	制圖	鞠章芳	2018.11.08	修改		
材料	—	復核	謝永林	2018.11.10	日期		
顏色	EC-DG-S332054 (3塗)	批准			圖號	837-WB3	



美特鋁質 有限公司
MIDI Aluminium Fabricator Ltd.

工程號	J837	地盤	觀塘裕民坊
-----	------	----	-------

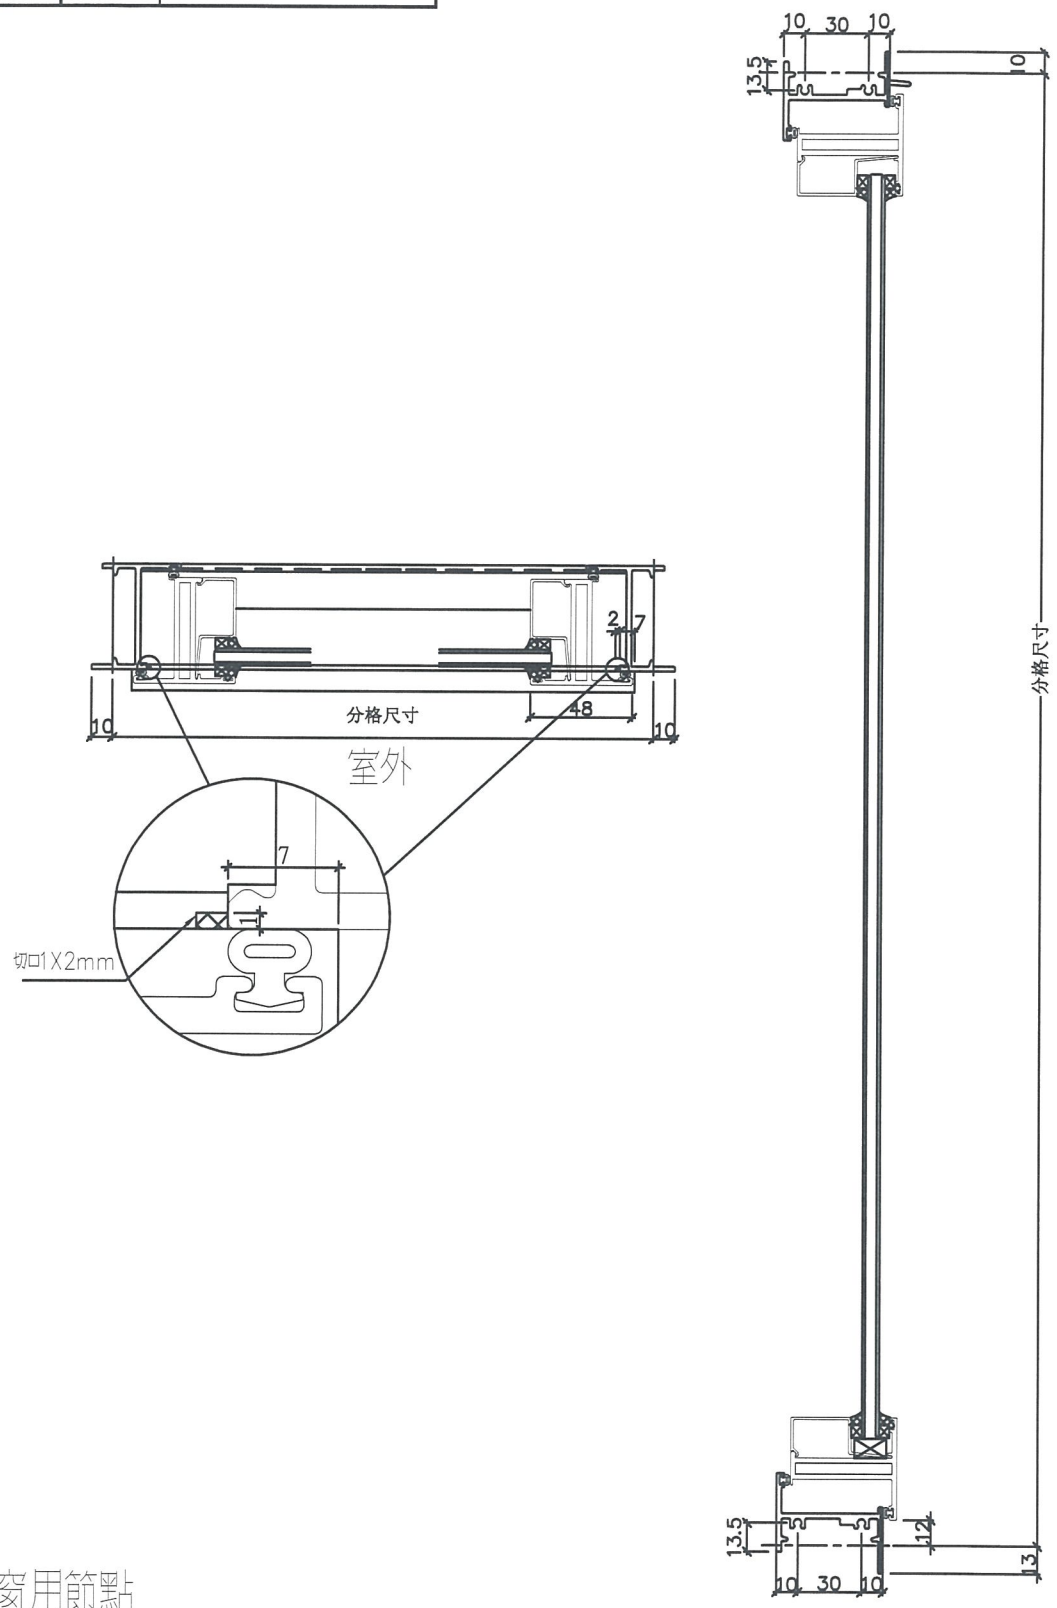



獨立生窗用節點

名稱	50窗節點示意圖	制圖	鞠章芳	2018.11.08	修改		
材料	—	復核	謝永林	2018.11.10	日期		
顏色	EC-DG-S332054 (3塗)	批准			圖號	837-WB4	




美特鋁質 有限公司
MIDI Aluminium Fabricator Ltd.

工程號	J837	地盤	觀塘裕民坊
-----	------	----	-------

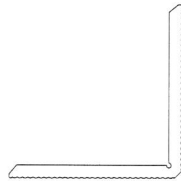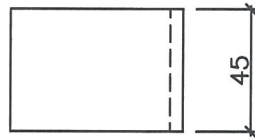

物料編號: YB-LJ1
數量: 7136+14(後備)=7150

名稱	鋁角拆圖	制圖	鞠章芳	2018.11.08	修改			
材料	X84236	復核	謝永林	2018.11.10	日期			
顏色	EC-DG-S332054 (3塗)	批准			圖號	YB-LJ1		

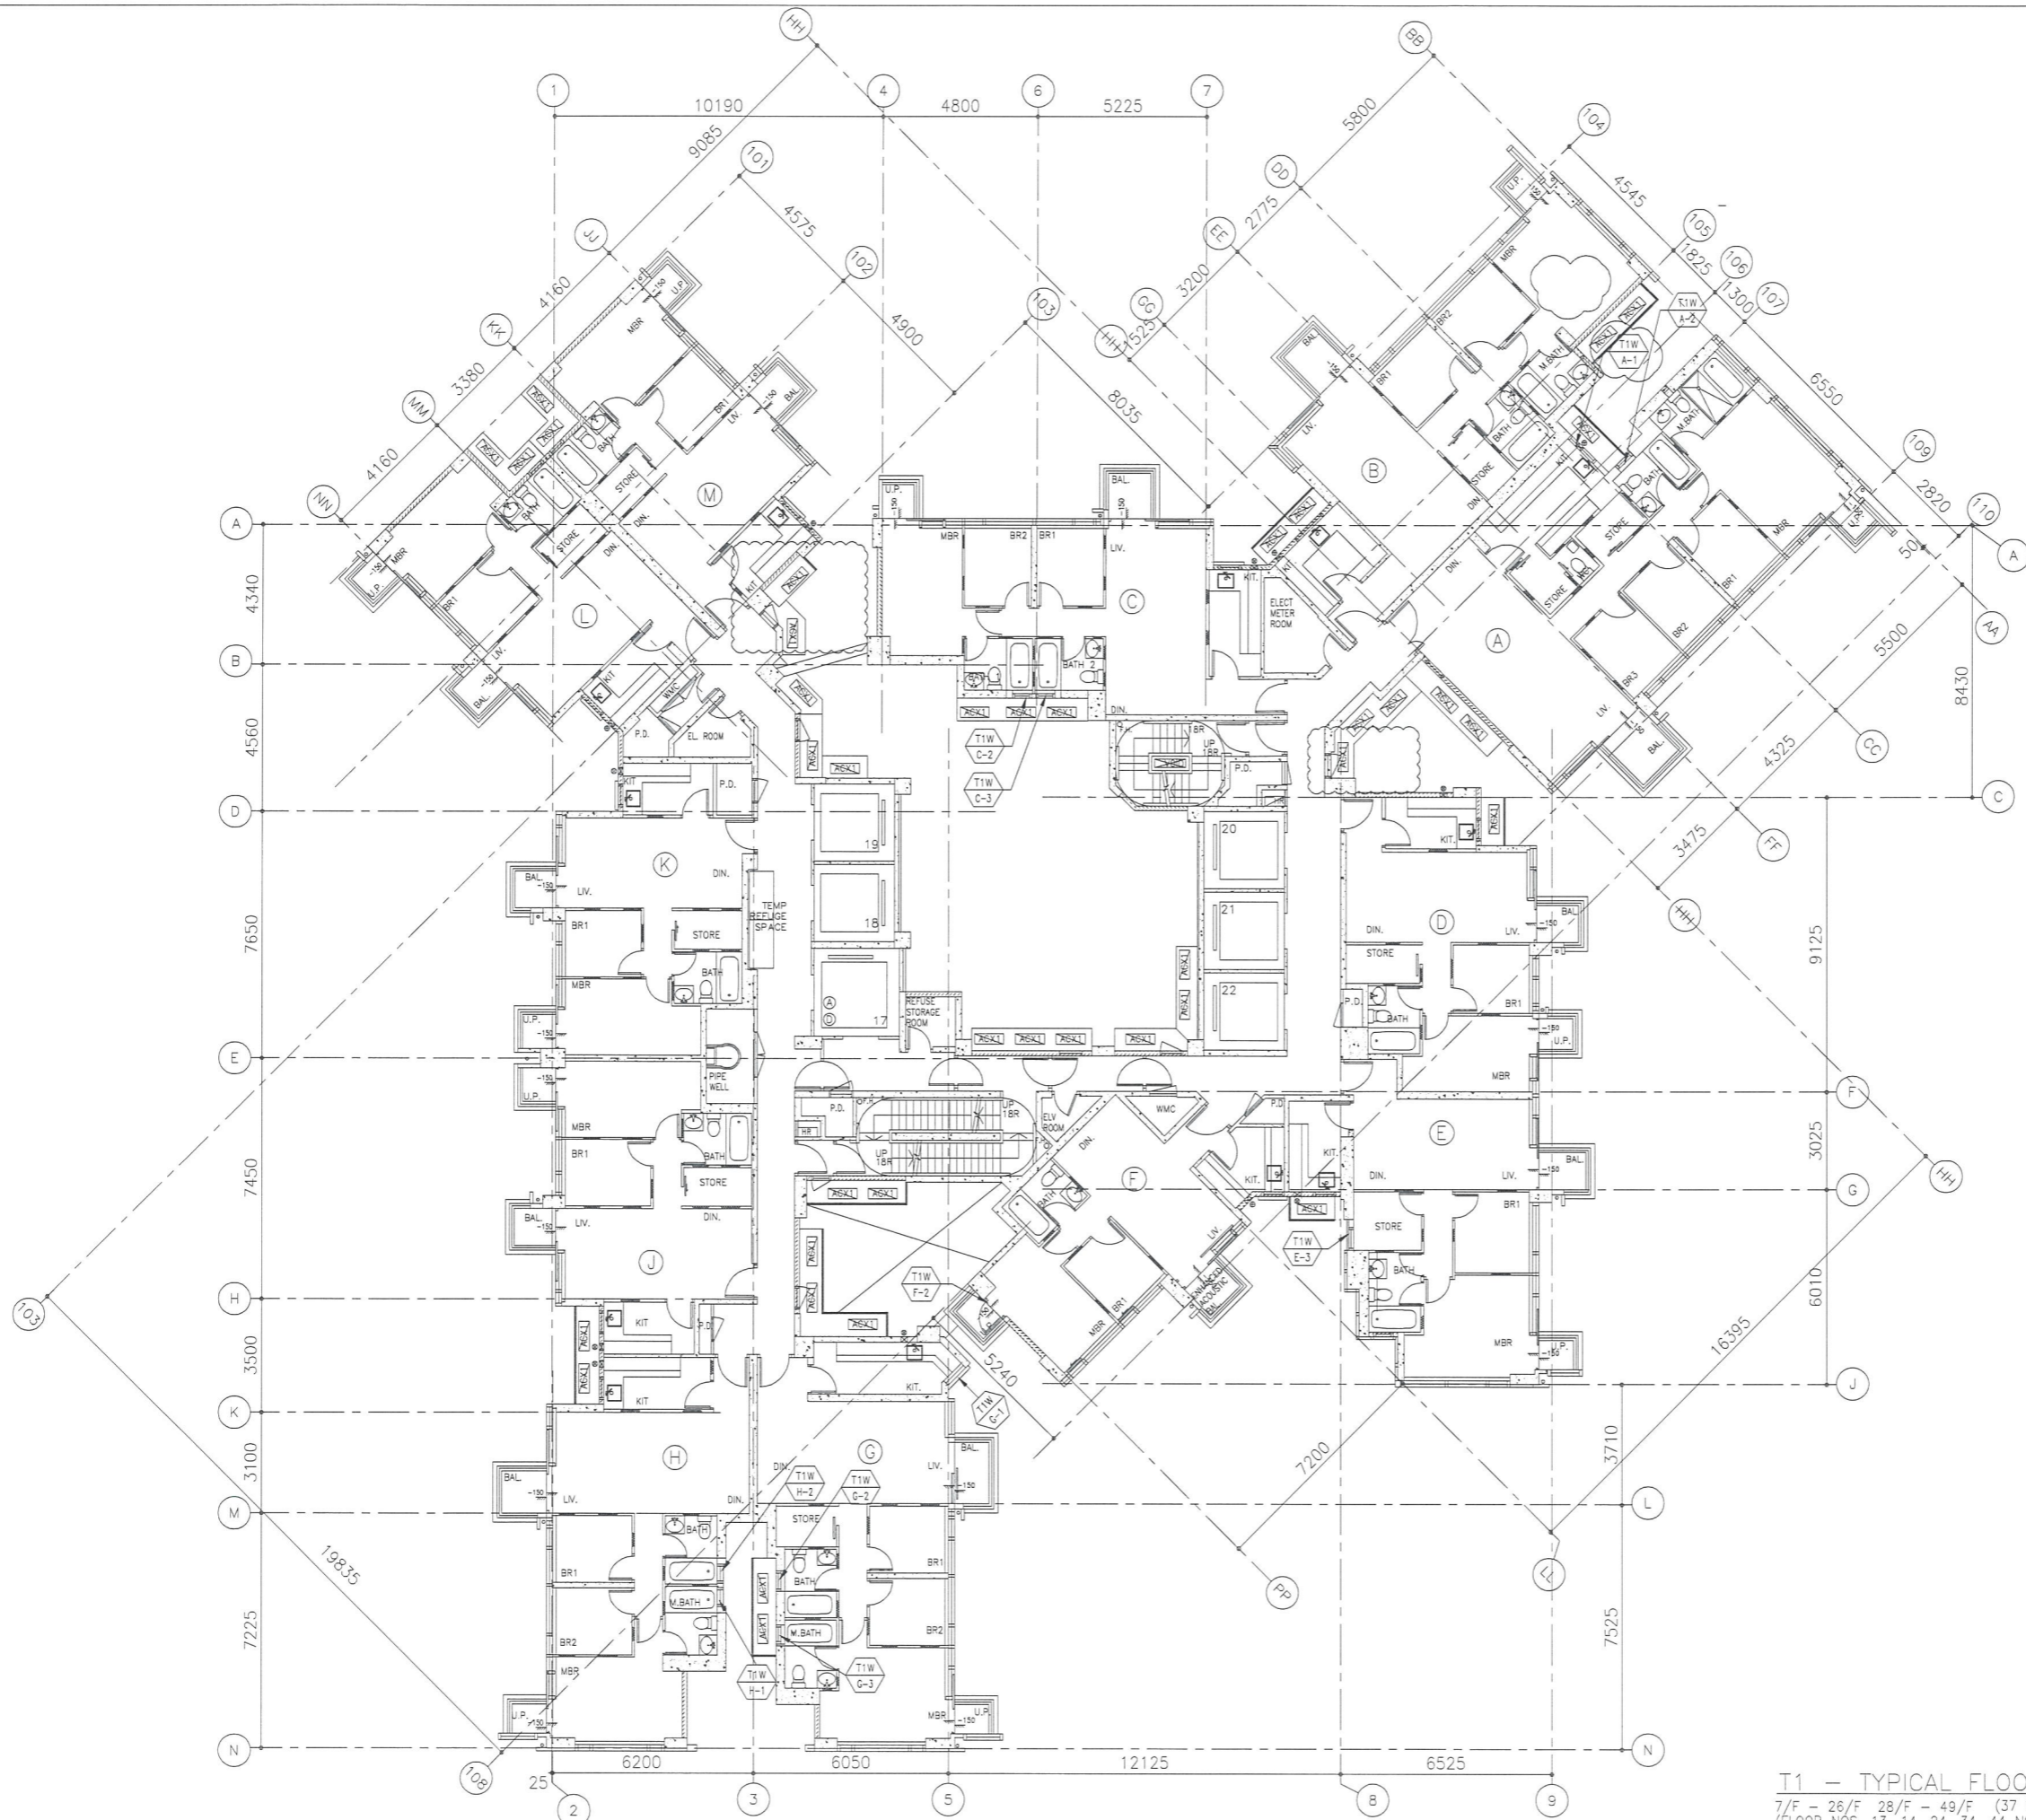

B.D. REF :

CLIENT :
 信和置業有限公司
 Sino Land Company Limited

ARCHITECT :
 WONG TUNG & PARTNERS LIMITED
 ARCHITECTS & PLANNERS

MAIN CONTRACTOR :
 CR Construction Company Limited

STRUCTURAL ENGINEER :
 AECOM

FACADE CONSULTANT :

NOTE :
 1. ALL DIMENSIONS ARE IN mm.
 2. ALL ELEVATIONS ARE VIEWED FROM OUTSIDE.
 3. ALL DIMENSIONS TO BE VERIFIED ON SITE BEFORE FABRICATION.

LEGEND :
 X1 --- DETAIL MARK NO.
 X001 --- REFER SHEET NO.
 1. F.F.L. --- FINISHED FLOOR LEVEL
 2. S.F.L. --- STRUCTURAL FLOOR LEVEL
 3. /R --- REVERSED DETAIL

A	2016/09/1	BY ARCHITECT COMMENT	Zeng
NO.	DATE	REVISED	BY


JOB NO. : J-837
 PROJECT :
 URA KWUN TONG TOWN CENTRE
 REDEVELOPMENT (AREA 2 & 3) AT
 NKIL 6514, KWUN TONG, KOWLOON

TITLE :
 FULL PLAN LAYOUT
 (FOR T1 TYPICAL FLOOR PLAN)

DATE : 09-JUL-18 SCALE : 1:200
 DRAWN BY : Zeng CHECKED BY : DW

美特鋁質有限公司
 MIDI ALUMINUM FABRICATOR LTD.
 Units 6-8, Sunray Industrial Centre, 1/F
 610 Cha Kwo Ling Road, Kowloon
 Tel:23489211-4 Fax:(852)27727666
 DWG NO. : JB37-IW-3102 REV. : A


T1 - TYPICAL FLOOR PLAN
 7/F - 26/F 28/F - 49/F (37 STOREYS)
 (FLOOR NOS. 13, 14, 24, 34, 44 NOT USED.)

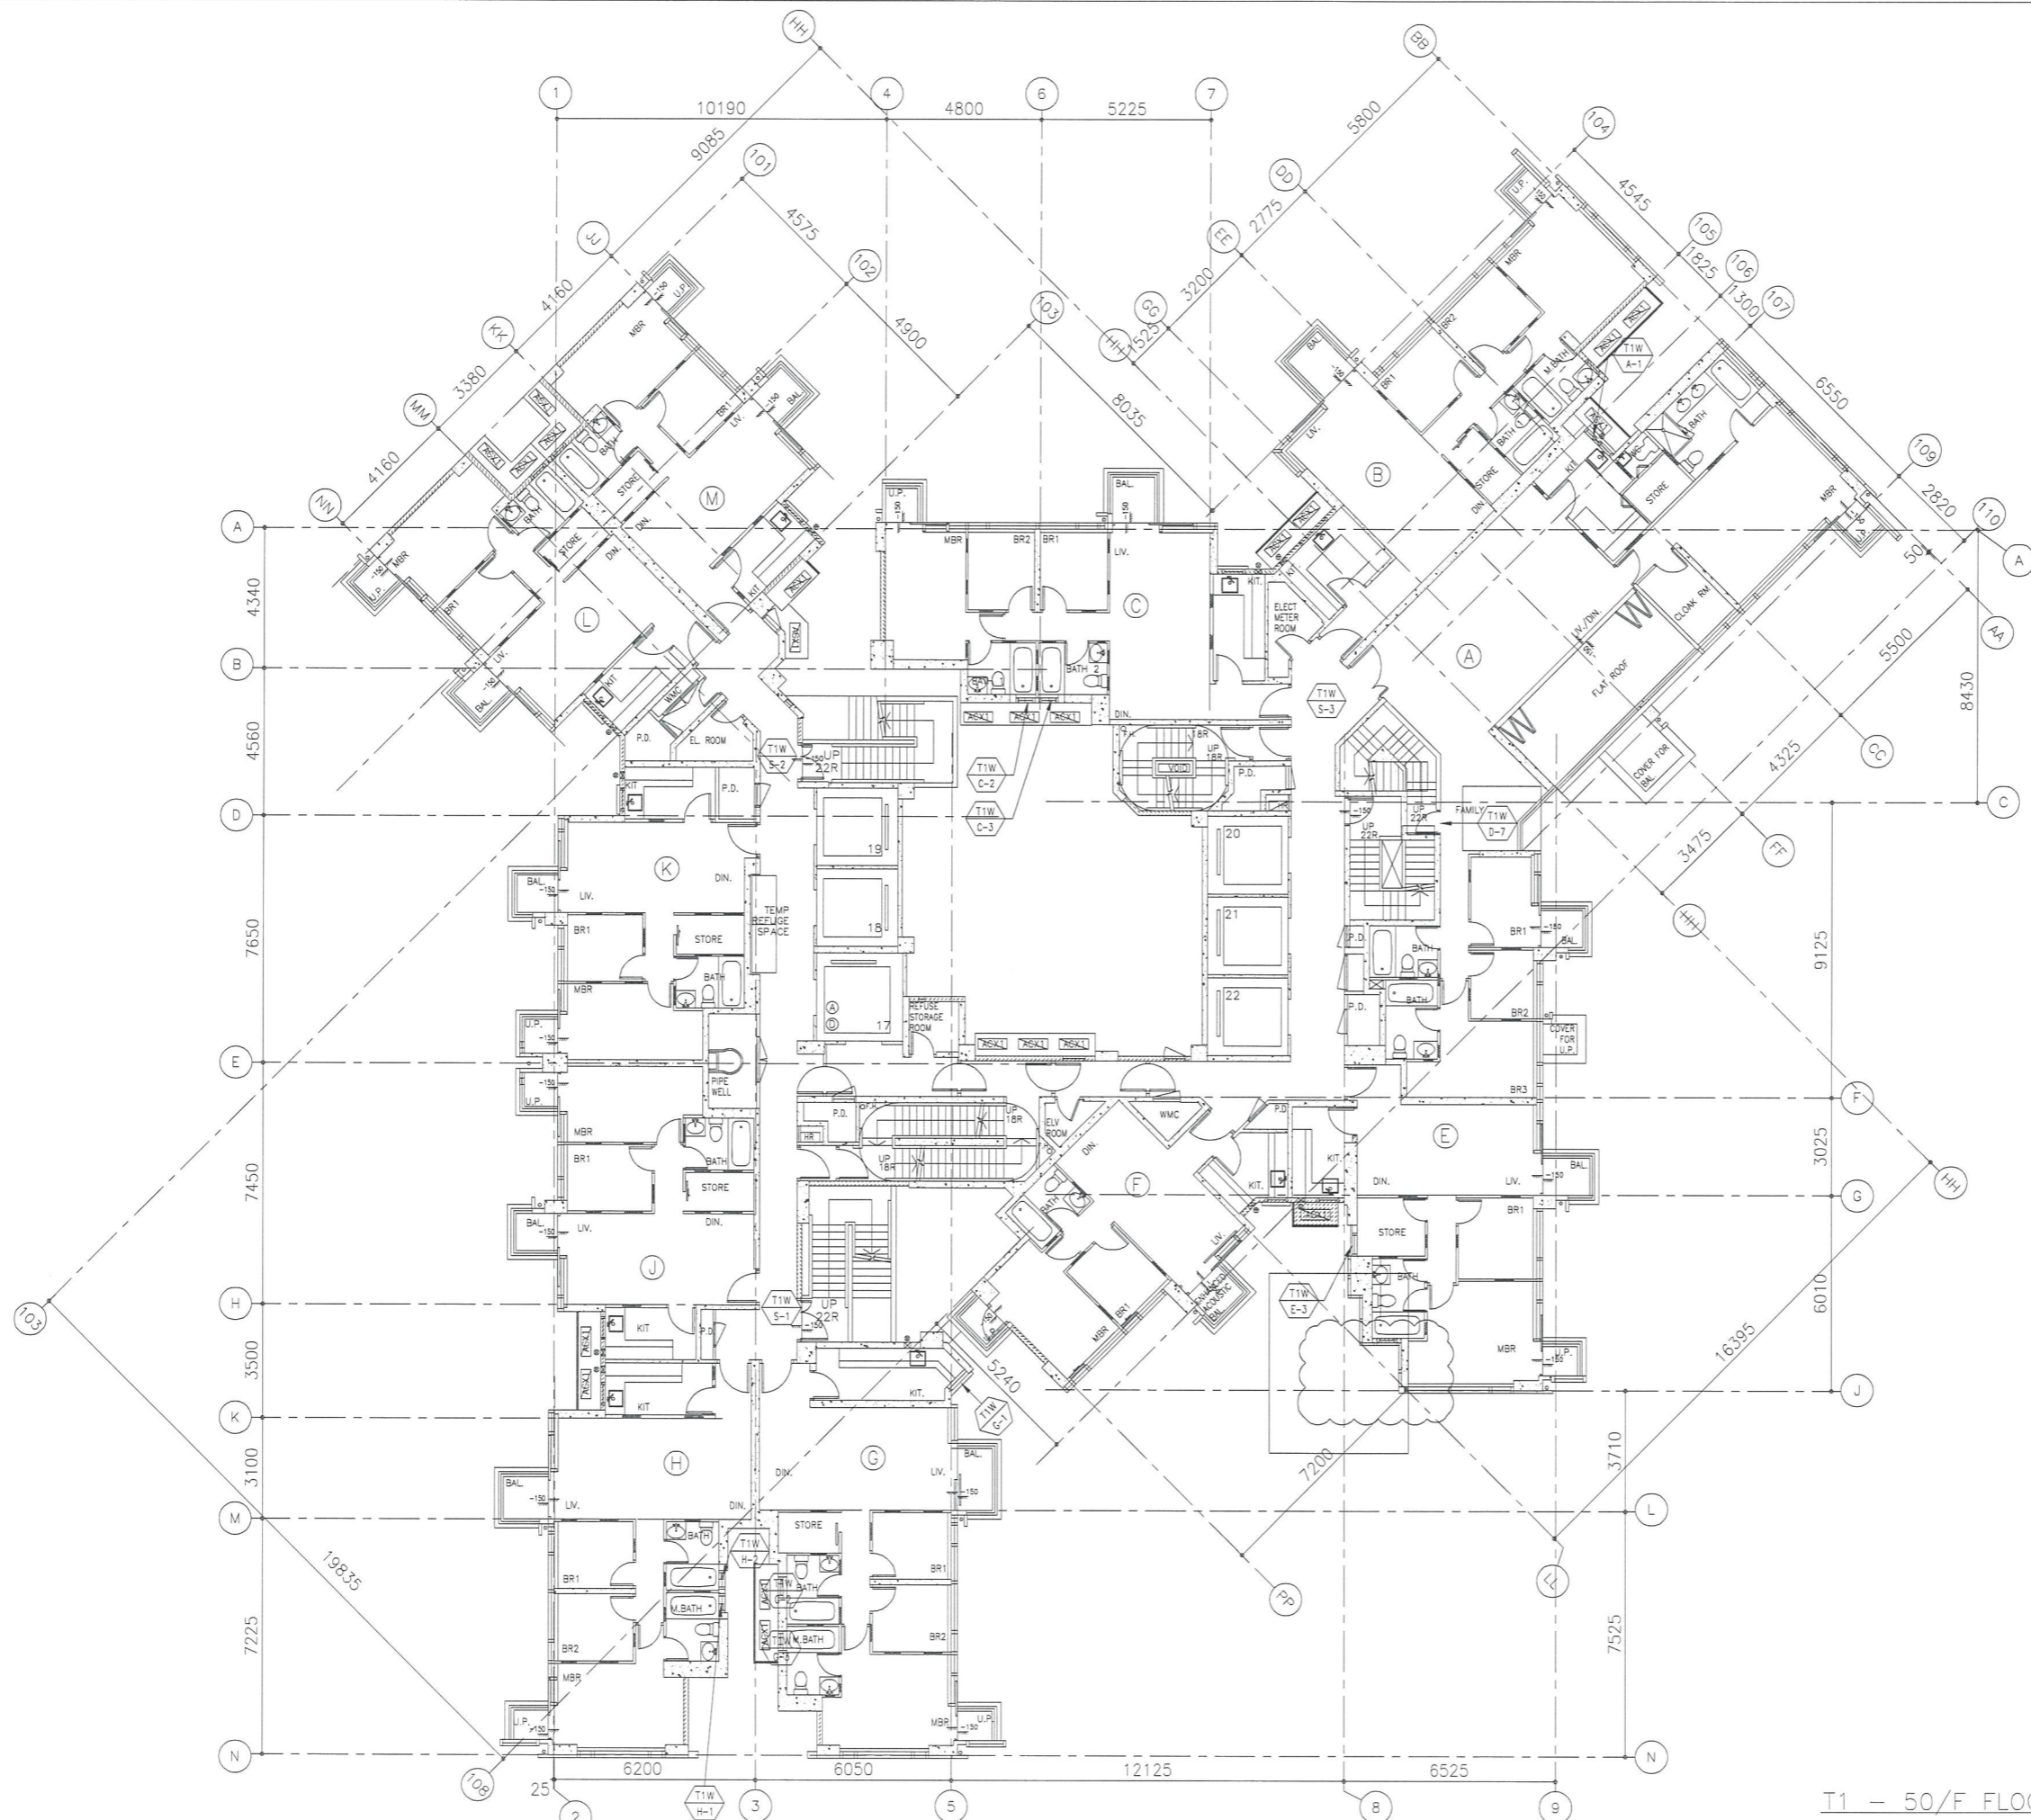

B.D. REF :

CLIENT :
 信和置業有限公司
 Sino Land Company Limited



ARCHITECT :
 WONG TUNG & PARTNERS LIMITED
 ARCHITECTS & PLANNERS


MAIN CONTRACTOR :
 CR Construction Company Limited

STRUCTURAL ENGINEER :


FACADE CONSULTANT :

NOTE :
 1. ALL DIMENSIONS ARE IN mm.
 2. ALL ELEVATIONS ARE VIEWED FROM OUTSIDE.
 3. ALL DIMENSIONS TO BE VERIFIED ON SITE BEFORE FABRICATION.

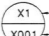LEGEND :
 X1 --- DETAIL MARK NO.
 X001 --- REFER SHEET NO.
 1. F.F.L. --- FINISHED FLOOR LEVEL
 2. S.F.L. --- STRUCTURAL FLOOR LEVEL
 3. (R) --- REVERSED DETAIL

NO.	DATE	REVISED	BY

JOB NO. : J-837
 PROJECT :
 URA KWUN TONG TOWN CENTRE
 REDEVELOPMENT (AREA 2 & 3) AT
 NKIL 6514, KWUN TONG, KOWLOON


TITLE :
 FULL PLAN LAYOUT
 (FOR T1 50/F FLOOR PLAN)

DATE : 09-JUL-18 SCALE : 1:200
 DRAWN BY : Zeng CHECKED BY : DW

 英特鋁質有限公司
 MIDI ALUMINUM FABRICATOR LTD.
 Units 6-8, Sunray Industrial Centre, 1/F
 610 Cha Kwo Ling Road, Kowloon
 Tel: 23489211-4 Fax: (852) 2727666

DWG NO. : JB37-IW-3103 REV. : -

T1 - 50/F FLOOR PLAN

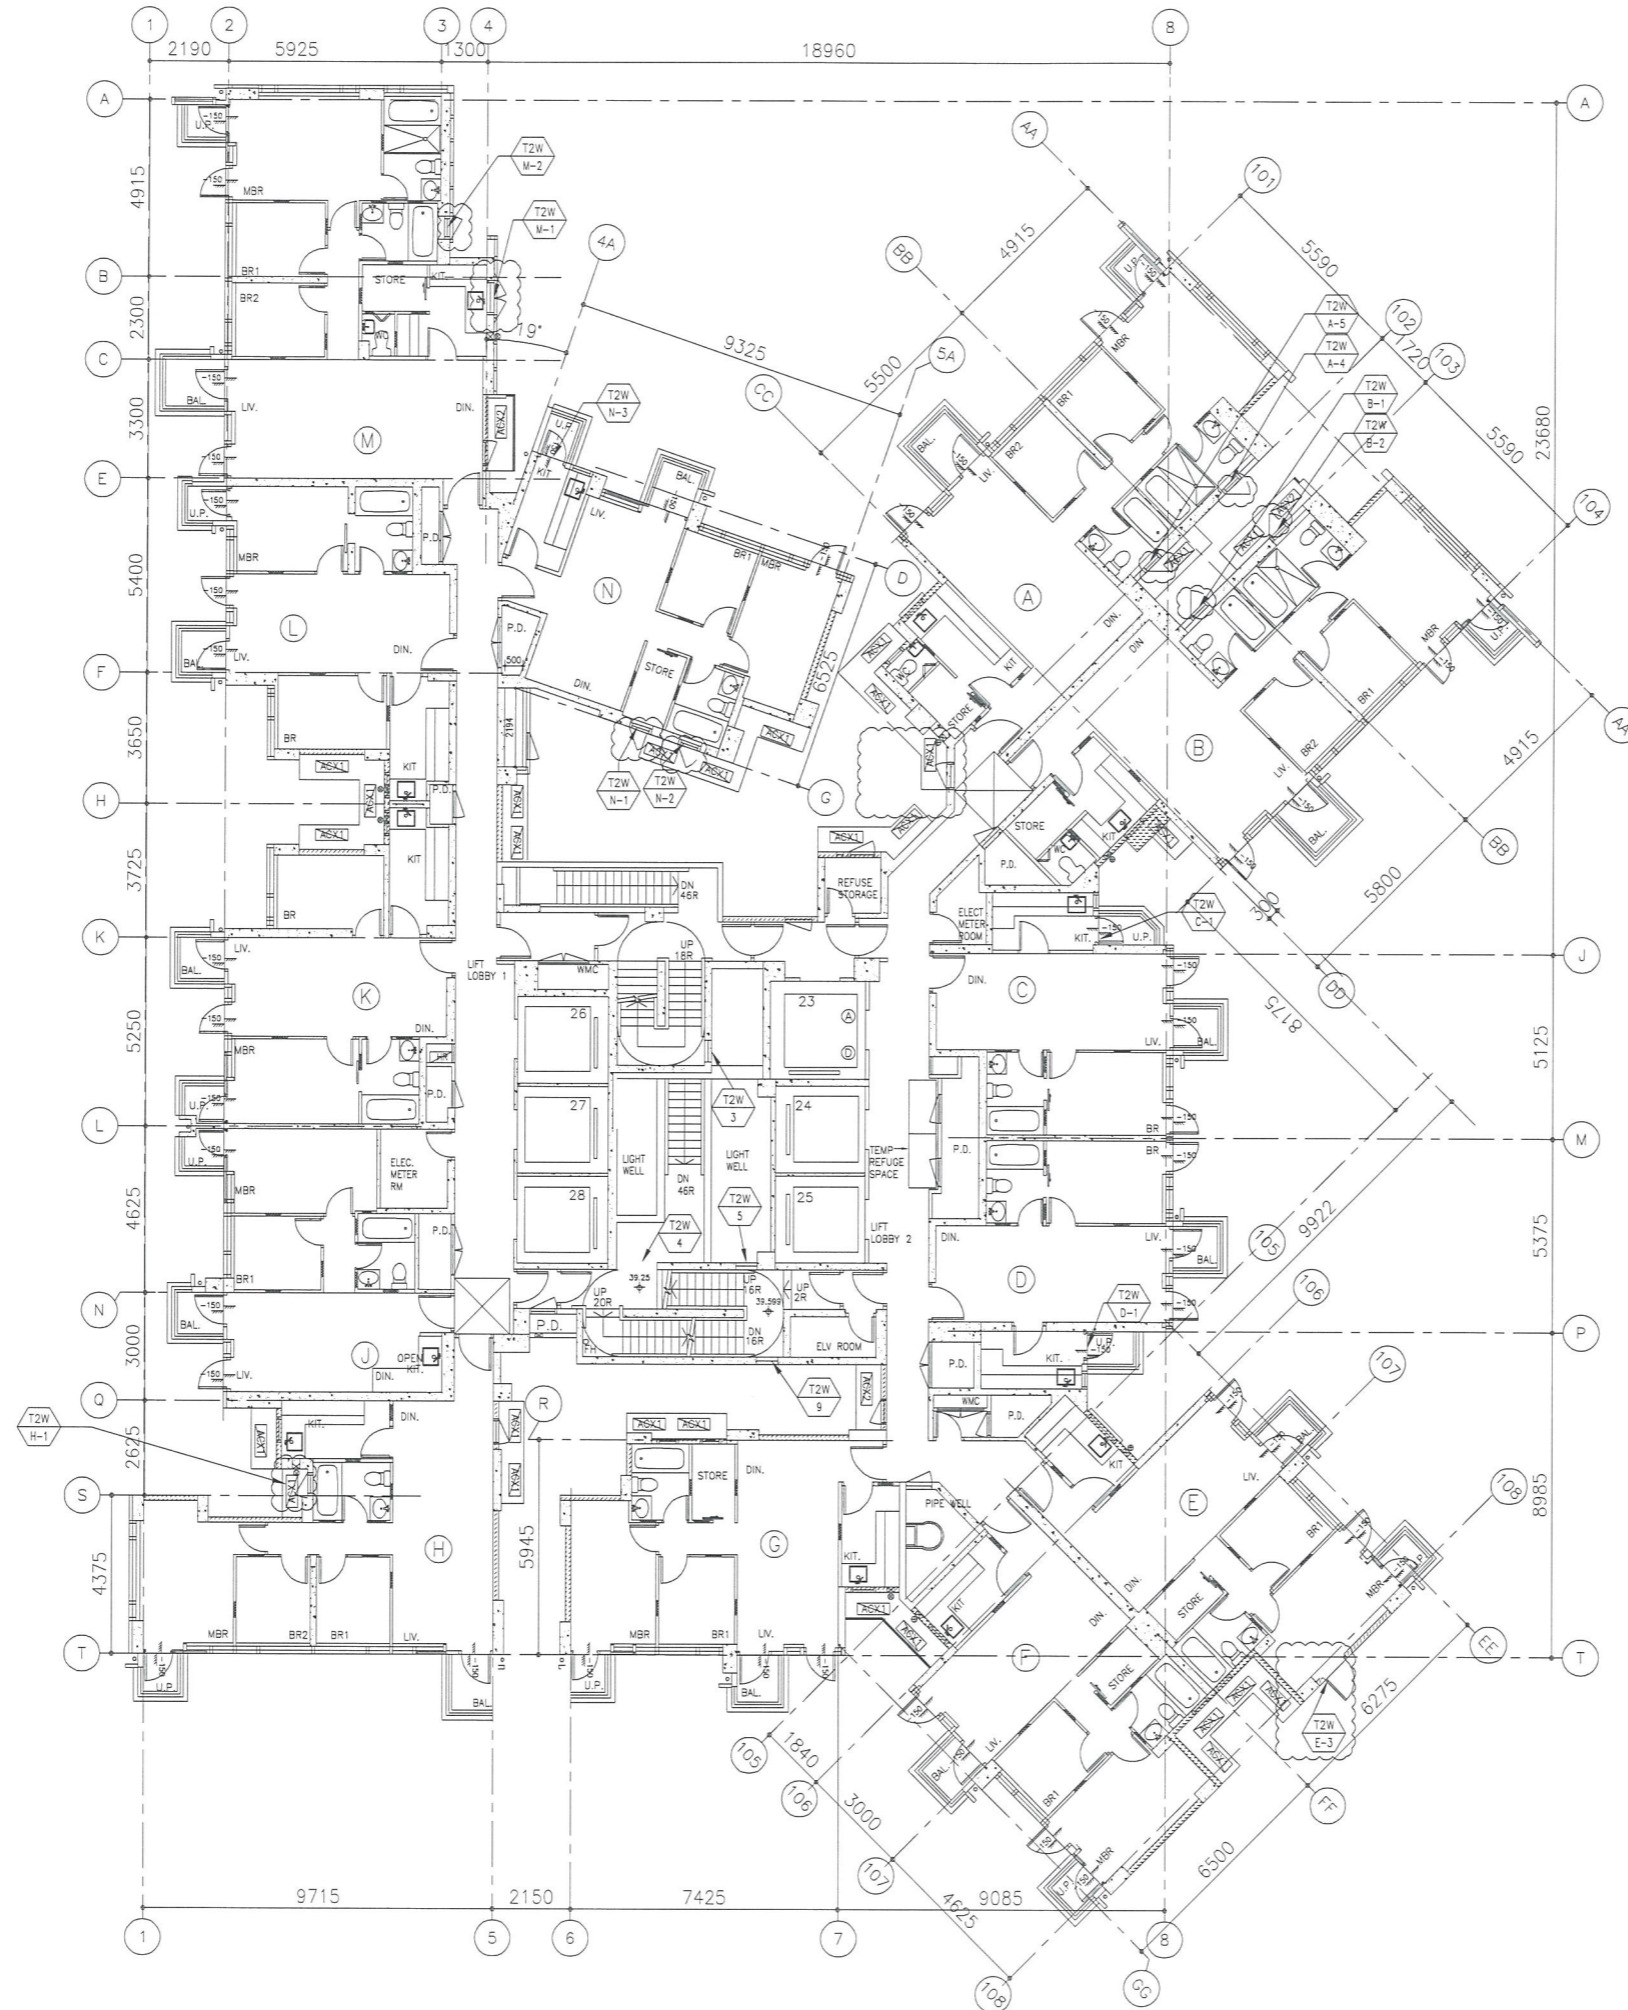

T2 - 6/F FLOOR PLAN

B.D. REF :

CLIENT :
 信和置業有限公司
 Sino Land Company Limited



ARCHITECT :
 WONG TUNG & PARTNERS LIMITED
 ARCHITECTS & PLANNERS


MAIN CONTRACTOR :
 CR Construction Company Limited

STRUCTURAL ENGINEER :


FAÇADE CONSULTANT :

NOTE :
 1. ALL DIMENSIONS ARE IN mm.
 2. ALL ELEVATIONS ARE VIEWED FROM OUTSIDE.
 3. ALL DIMENSIONS TO BE VERIFIED ON SITE BEFORE FABRICATION.

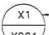LEGEND :
 --- DETAIL MARK NO.
 --- REFER SHEET NO.
 1. F.F.L. --- FINISHED FLOOR LEVEL
 2. S.F.L. --- STRUCTURAL FLOOR LEVEL
 3. (R) --- REVERSED DETAIL

A	2016/08/27	BY ARCHITECT COMMENT	Zeng
NO.	DATE	REVISED	BY

JOB NO. : J-837
 PROJECT :
 URA KWUN TONG TOWN CENTRE
 REDEVELOPMENT (AREA 2 & 3) AT
 NKIL 6514, KWUN TONG, KOWLOON

TITLE :
 FULL PLAN LAYOUT
 (FOR T2 6/F FLOOR PLAN)


DATE : 09-JUL-18 SCALE : 1:200

DRAWN BY : Zeng CHECKED BY : DW

 美特鋁質有限公司
 MIDI ALUMINIUM FABRICATOR LTD.
 Units 6-8, Sunray Industrial Centre, 1/F
 610 Cha Kwo Ling Road, Kowloon
 Tel:23489211-4 Fax:(852)27727666

DWG NO. : JB37-IW-3201 REV. : A

Leo

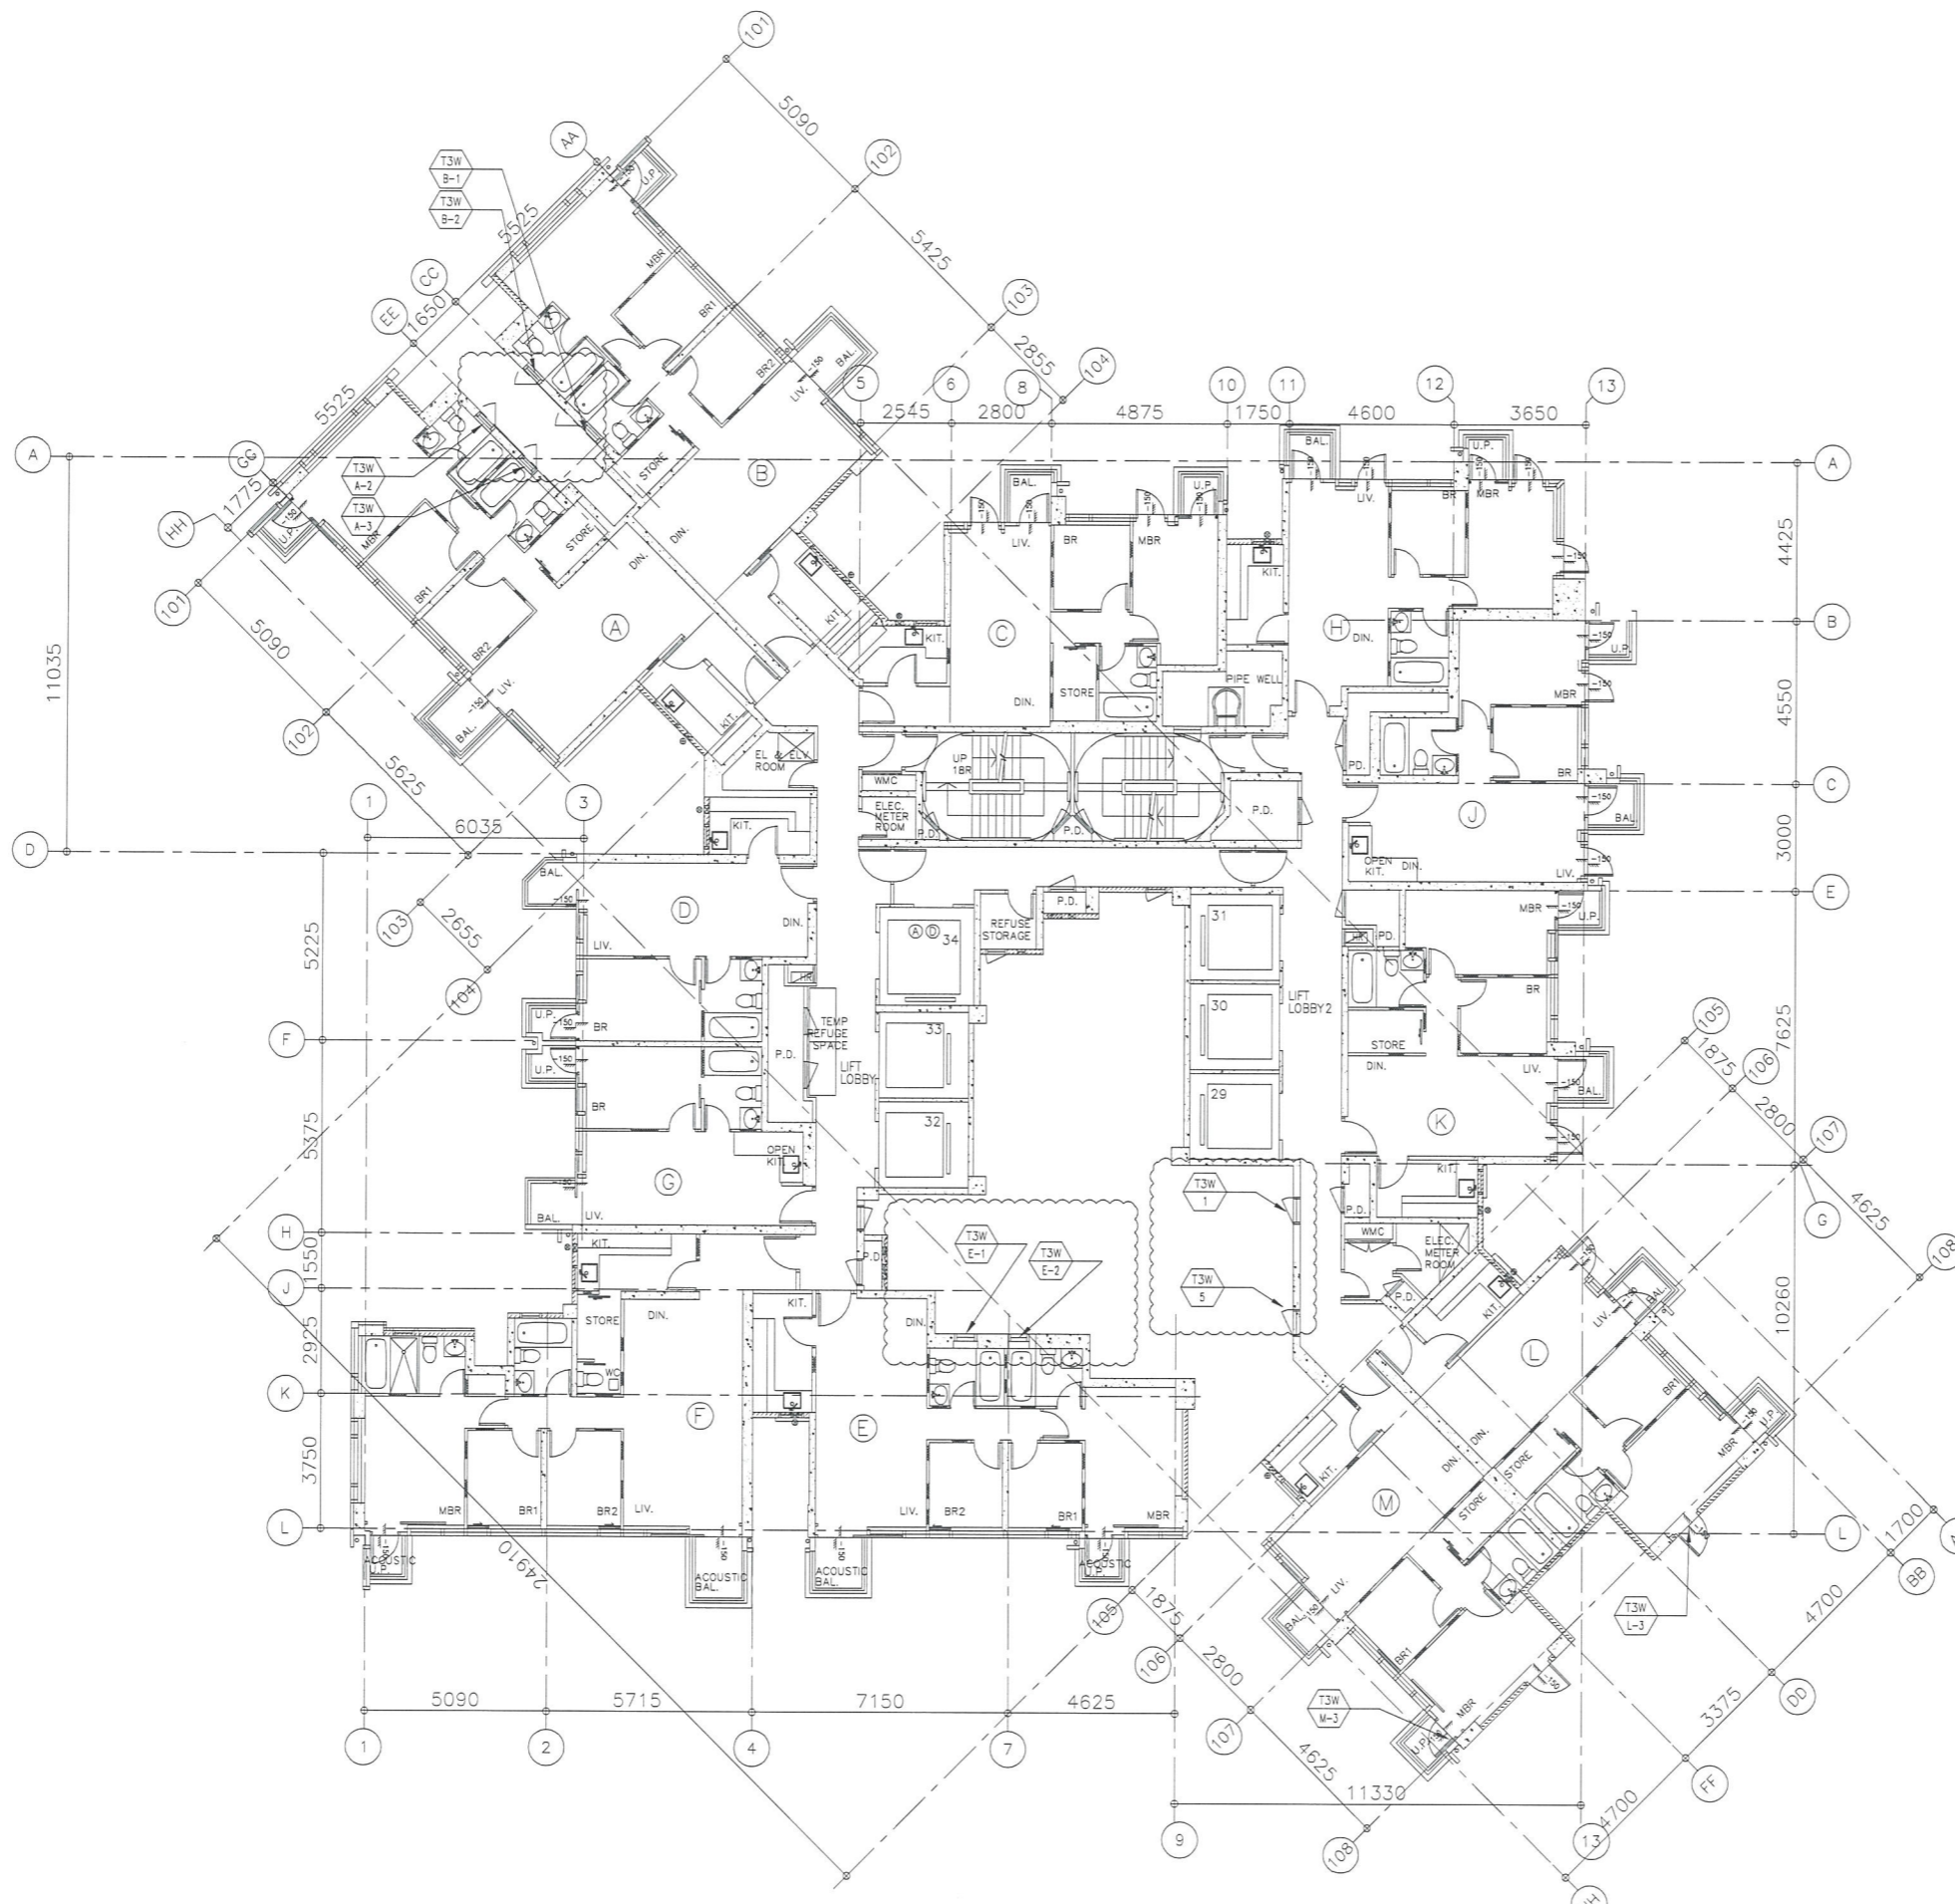

T3 - 6/F FLOOR PLAN

B.D. REF :

CLIENT :
 信和置業有限公司
 Sino Land Company Limited



ARCHITECT :
 WONG TUNG & PARTNERS LIMITED
 ARCHITECTS & PLANNERS

MAIN CONTRACTOR :
 CR Construction Company Limited

STRUCTURAL ENGINEER :
 AECOM

FACADE CONSULTANT :

NOTE :
 1. ALL DIMENSIONS ARE IN mm.
 2. ALL ELEVATIONS ARE VIEWED FROM OUTSIDE.
 3. ALL DIMENSIONS TO BE VERIFIED ON SITE BEFORE FABRICATION.

LEGEND :
 --- DETAIL MARK NO.
 --- REFER SHEET NO.
 1. F.F.L. --- FINISHED FLOOR LEVEL
 2. S.F.L. --- STRUCTURAL FLOOR LEVEL
 3. (R) --- REVERSED DETAIL

A	2018/09-27	BY ARCHITECT COMMENT	Zeng
NO.	DATE	REVISED	BY


JOB NO. : J-837
 PROJECT :
 URA KWUN TONG TOWN CENTRE
 REDEVELOPMENT (AREA 2 & 3) AT
 NKIL 6514, KWUN TONG, KOWLOON

TITLE :
 FULL PLAN LAYOUT
 (FOR T3 6/F FLOOR PLAN)

DATE : 09-JUL-18 SCALE : 1:200
 DRAWN BY : Zeng CHECKED BY : DW

 美特鋁質有限公司
 MIDI ALUMINIUM FABRICATOR LTD.
 Units 6-8, Sunray Industrial Centre, 1/F
 610 Cha Kwo Ling Road, Kowloon
 Tel:23489211-4 Fax:(852)2772666

DWG NO. : JB37-IW-3301 REV. : A

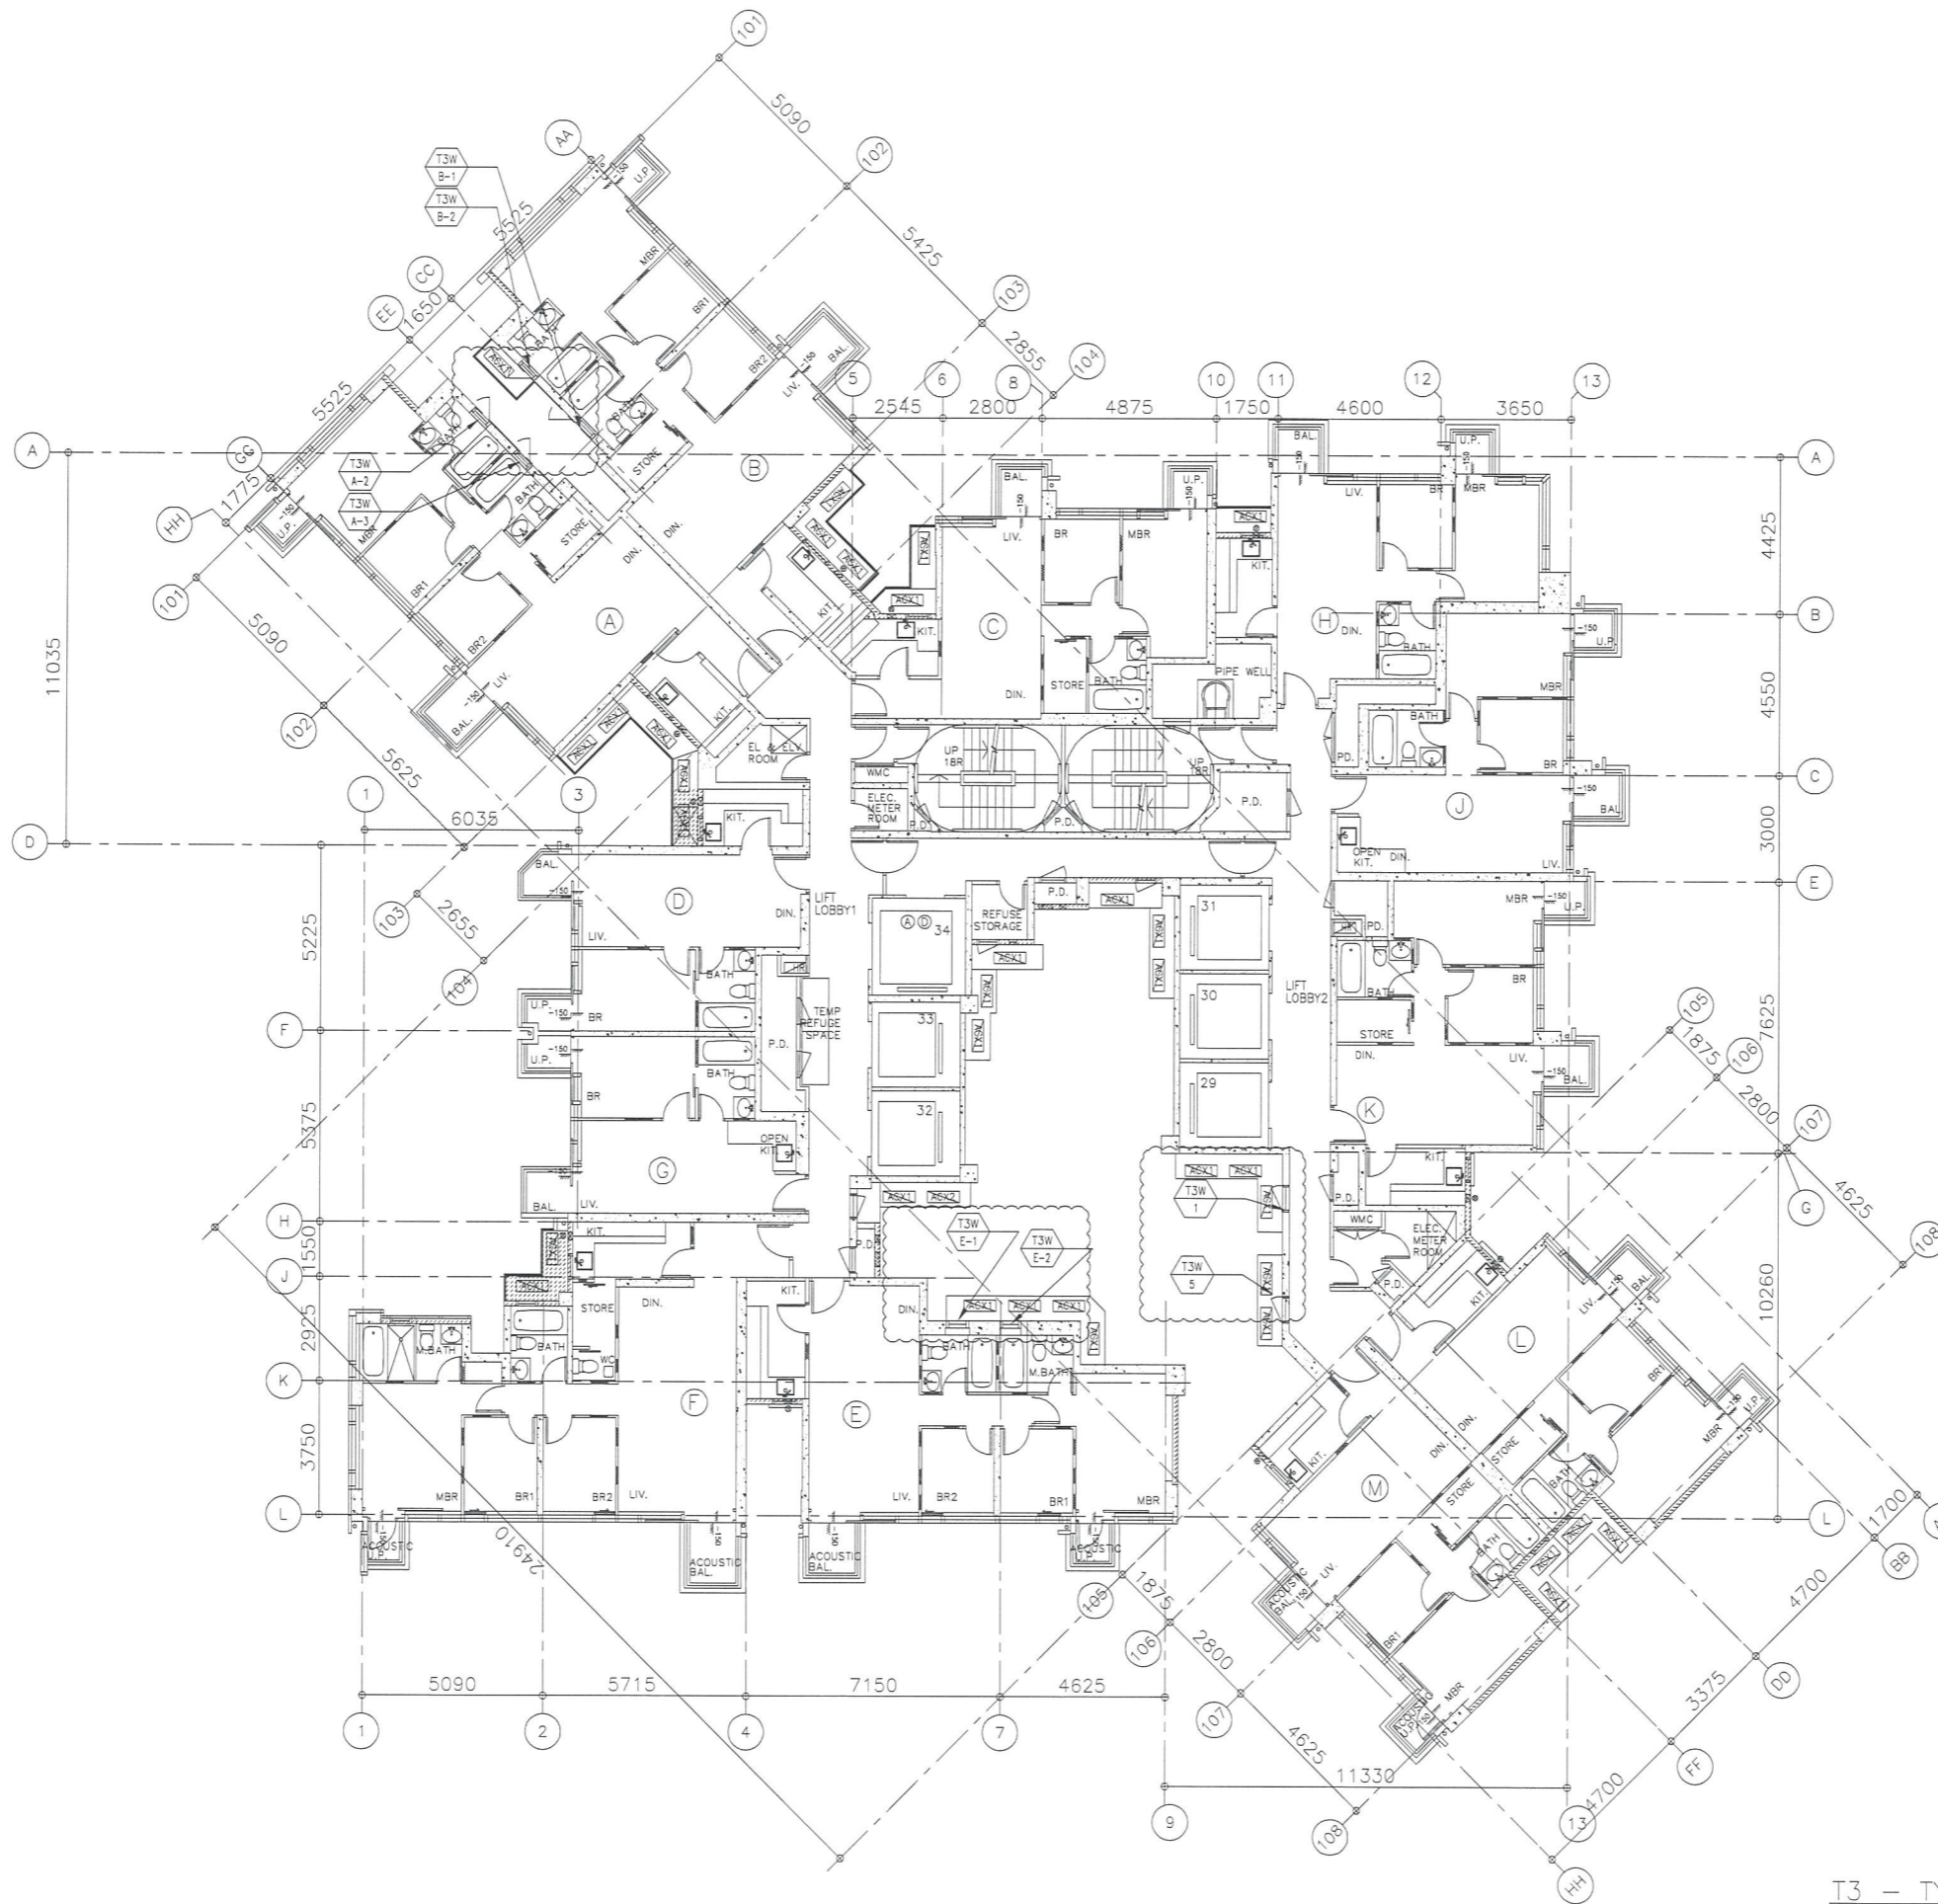

T3 - TYPICAL FLOOR PLAN
 7/F - 26/F 28/F - 51/F (39 STOREYS)
 (FLOOR NOS. 13, 14, 24, 34, 44 NOT USED.)

B.D. REF :

CLIENT :
 信和置業有限公司
 Sino Land Company Limited

ARCHITECT :
 WONG TUNG & PARTNERS LIMITED
 ARCHITECTS & PLANNERS

MAIN CONTRACTOR :
 CR Construction Company Limited

STRUCTURAL ENGINEER :
 AECOM

FACADE CONSULTANT:

NOTE :
 1. ALL DIMENSIONS ARE IN mm.
 2. ALL ELEVATIONS ARE VIEWED FROM OUTSIDE.
 3. ALL DIMENSIONS TO BE VERIFIED ON SITE BEFORE FABRICATION.

LEGEND :
 X1 --- DETAIL MARK NO.
 X001 --- REFER SHEET NO.
 1. F.F.L. --- FINISHED FLOOR LEVEL
 2. S.F.L. --- STRUCTURAL FLOOR LEVEL
 3. (R) --- REVERSED DETAIL

A	2016/09-27	BY ARCHITECT COMMENT	Zeng
NO.	DATE	REVISED	BY


JOB NO. : J-837
 PROJECT :
 URA KWUN TONG TOWN CENTRE
 REDEVELOPMENT (AREA 2 & 3) AT
 NKIL 6514, KWUN TONG, KOWLOON

TITLE :
 FULL PLAN LAYOUT
 (FOR T3 TYPICAL FLOOR PLAN)

DATE : 09-JUL-18 SCALE : 1:200
 DRAWN BY : Zeng CHECKED BY : DW

美特鋁質有限公司
 MIDI ALUMINIUM FABRICATOR LTD.
 Units 6-8, Sunray Industrial Centre, 1/F
 610 Cha Kwo Ling Road, Kowloon
 Tel:23489211-4 Fax:(852)2727666
 DWG NO. : JB37-IW-3302 REV. : A

LF6

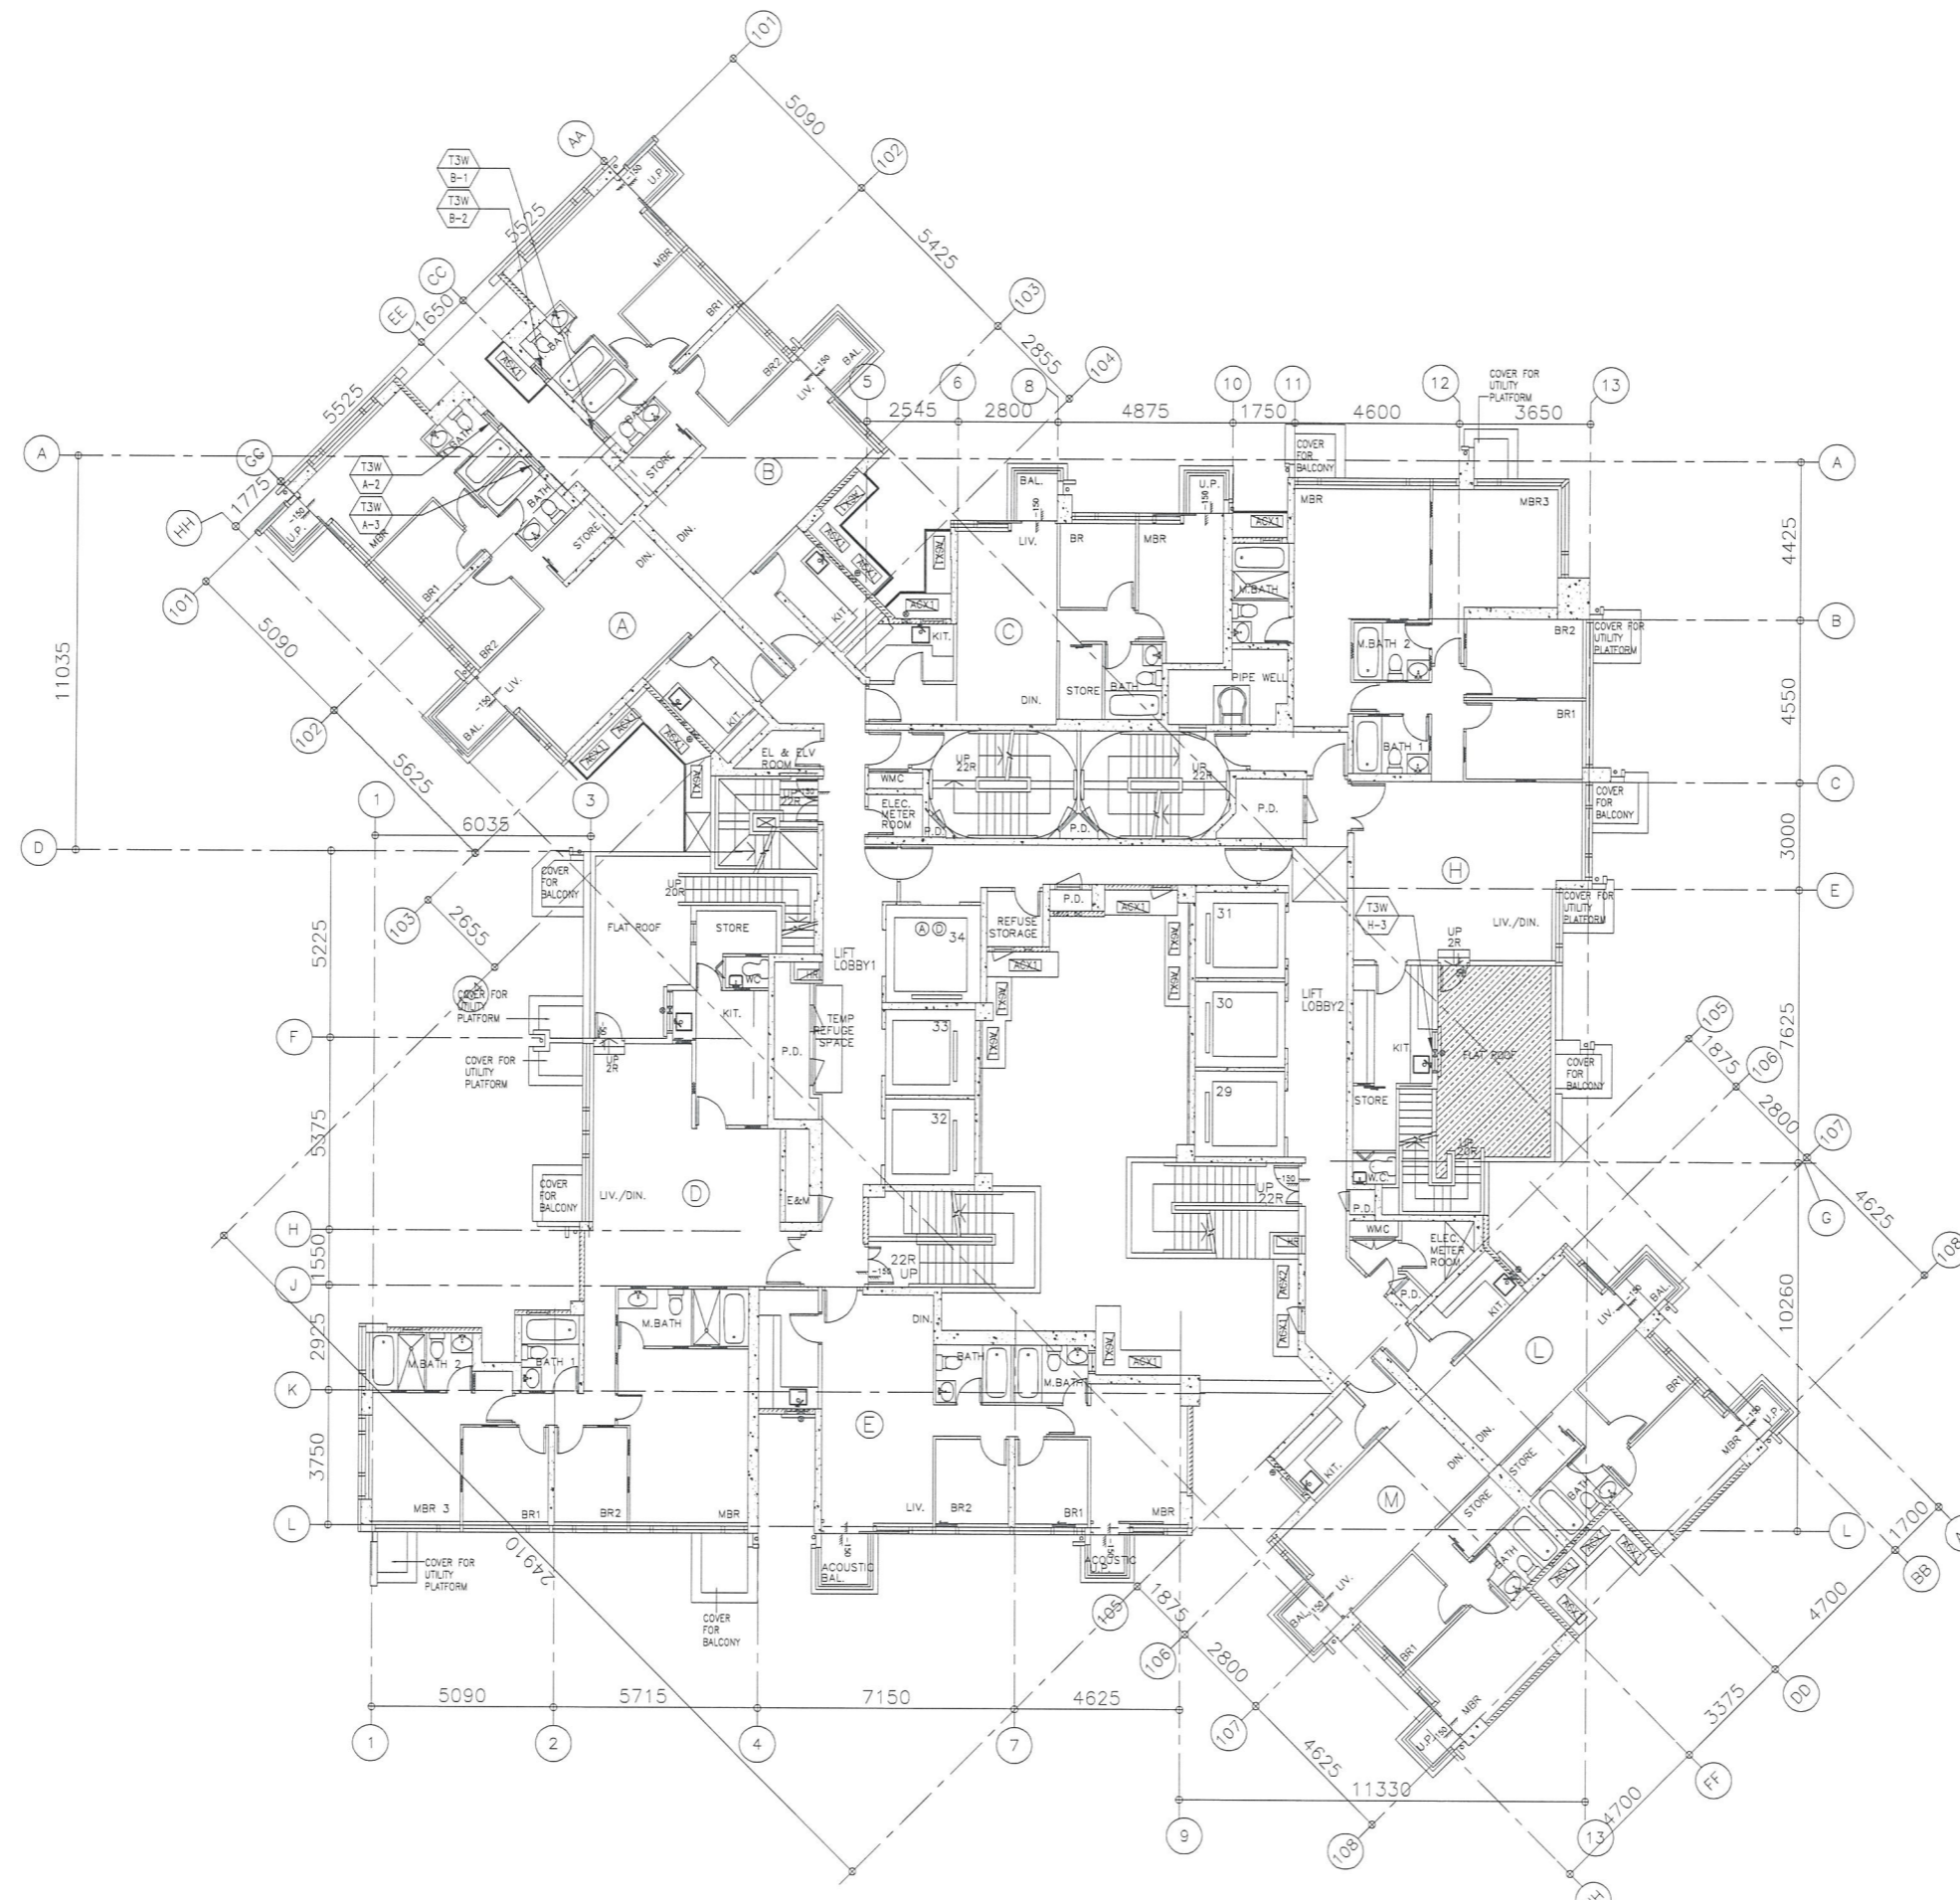

T3 - 52/F FLOOR PLAN

B.D. REF :

CLIENT :
 信和置業有限公司
 Sino Land Company Limited



ARCHITECT :
 WONG TUNG & PARTNERS LIMITED
 ARCHITECTS & PLANNERS


MAIN CONTRACTOR :
 CR Construction Company Limited

STRUCTURAL ENGINEER :


FACADE CONSULTANT :

NOTE :
 1. ALL DIMENSIONS ARE IN mm.
 2. ALL ELEVATIONS ARE VIEWED FROM OUTSIDE.
 3. ALL DIMENSIONS TO BE VERIFIED ON SITE BEFORE FABRICATION.

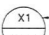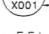LEGEND :
 --- DETAIL MARK NO.
 --- REFER SHEET NO.
 1. F.F.L. --- FINISHED FLOOR LEVEL
 2. S.F.L. --- STRUCTURAL FLOOR LEVEL
 3. (R) --- REVERSED DETAIL

NO.	DATE	REVISED	BY
-----	------	---------	----

JOB NO. : J-837
 PROJECT :
 URA KWUN TONG TOWN CENTRE
 REDEVELOPMENT (AREA 2 & 3) AT
 NKIL 6514, KWUN TONG, KOWLOON


TITLE :
 FULL PLAN LAYOUT
 (FOR T3 52/F FLOOR PLAN)

DATE : 09-JUL-18 SCALE : 1:200

DRAWN BY : Zeng CHECKED BY : DW

 美特鋁質有限公司
 MIDI ALUMINIUM FABRICATOR LTD.
 Units 6-8, Sunray Industrial Centre, 1/F
 610 Cha Kwo Ling Road, Kowloon
 Tel: 23489211-4 Fax: (852) 27727666

DWG NO. : J837-IW-3303 REV. : -

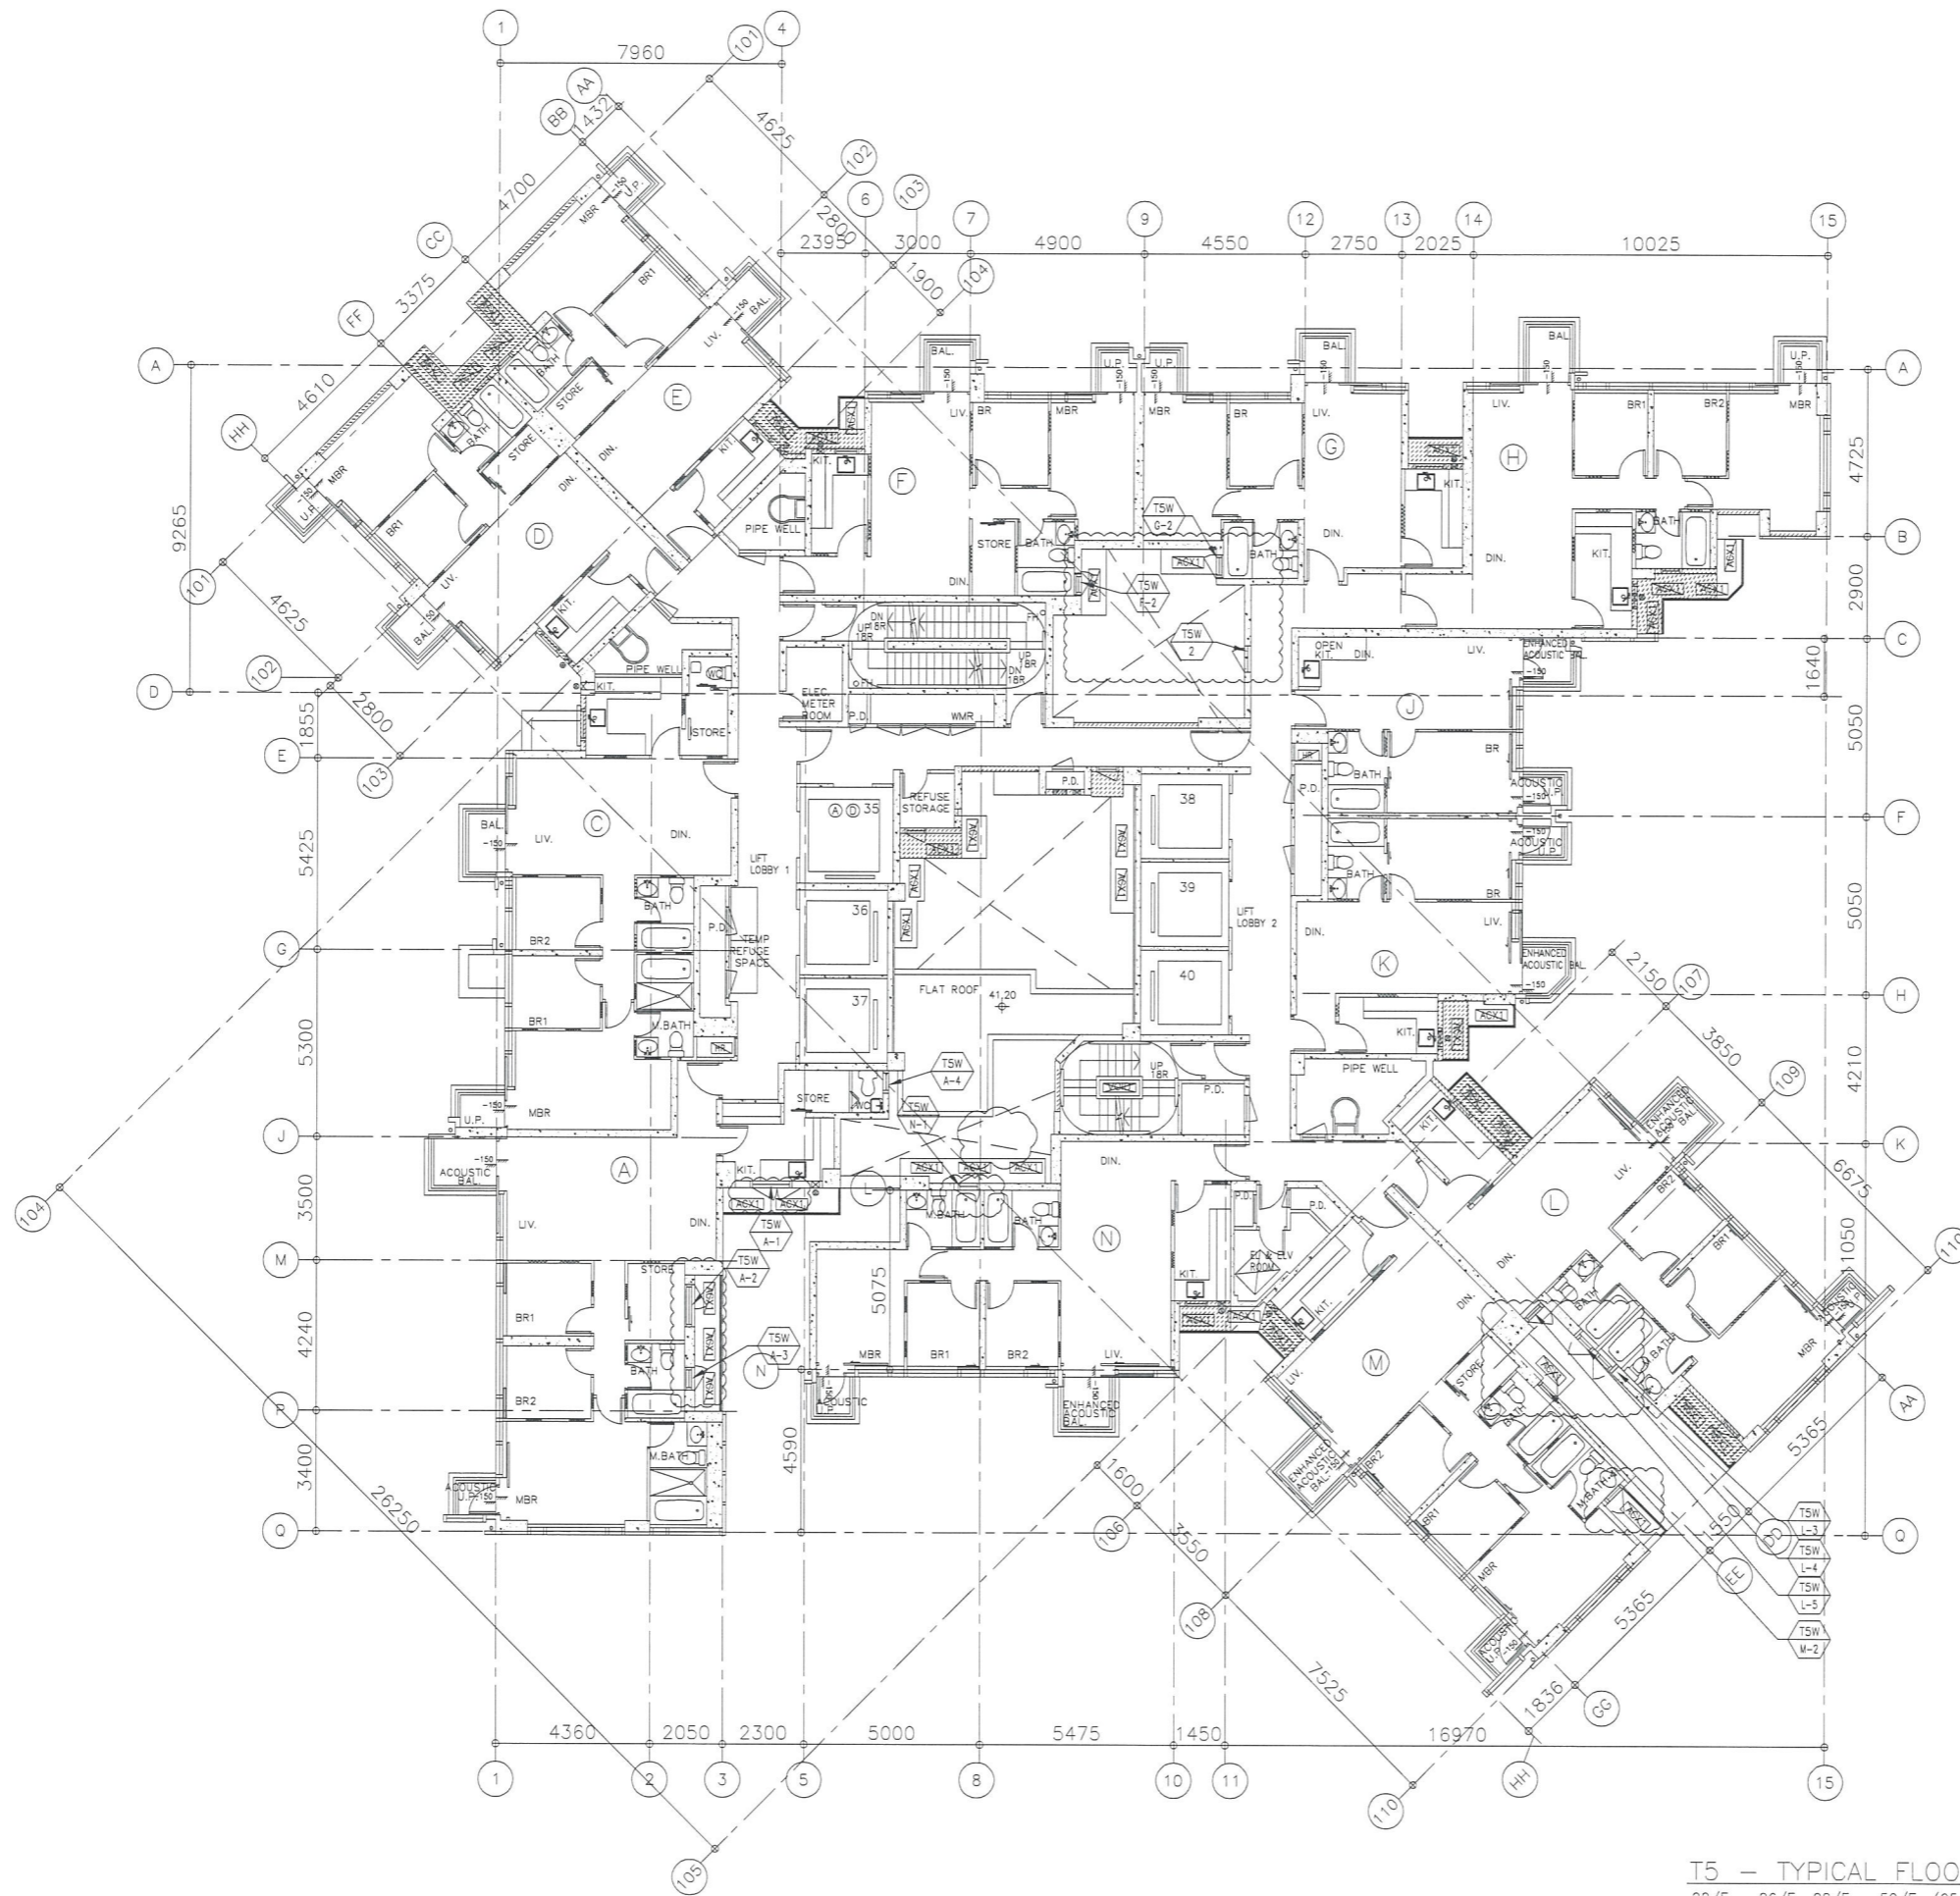

T5 - TYPICAL FLOOR PLAN (HIGH ZONE)
 22/F - 26/F 28/F - 50/F (25 STOREYS)
 (FLOOR NOS. 24, 34, 44 NOT USED.)

B.D. REF :

CLIENT :
 信和置業有限公司
 Sino Land Company Limited

ARCHITECT :
 WONG TUNG & PARTNERS LIMITED
 ARCHITECTS & PLANNERS

MAIN CONTRACTOR :
 CR Construction Company Limited

STRUCTURAL ENGINEER :
 AECOM

FACADE CONSULTANT :

NOTE :
 1. ALL DIMENSIONS ARE IN mm.
 2. ALL ELEVATIONS ARE VIEWED FROM OUTSIDE.
 3. ALL DIMENSIONS TO BE VERIFIED ON SITE BEFORE FABRICATION.

LEGEND :
 (X1) --- DETAIL MARK NO.
 (X001) --- REFER SHEET NO.

1. F.F.L. --- FINISHED FLOOR LEVEL
 2. S.F.L. --- STRUCTURAL FLOOR LEVEL
 3. (R) --- REVERSED DETAIL

A	2018/09-1	BY ARCHITECT COMMENT	Zeng
NO.	DATE	REVISED	BY

JOB NO. : J-837

PROJECT :
 URA KWUN TONG TOWN CENTRE
 REDEVELOPMENT (AREA 2 & 3) AT
 NKIL 6514, KWUN TONG, KOWLOON

TITLE :
 FULL PLAN LAYOUT
 (FOR T5 50/F FLOOR PLAN (HIGH ZONE))

DATE : 09-JUL-18 SCALE : 1:200

DRAWN BY : Zeng CHECKED BY : DW

美特鋁質有限公司
 MIDI ALUMINUM FABRICATOR LTD.
 Units 6-8, Sunray Industrial Centre, 1/F
 610 Cha Kwo Ling Road, Kowloon
 Tel: 23489211-4 Fax: (852) 27727666

DWG NO. : JB37-IW-3503 REV. : A

49