



工程指示 / 要求簡箋(E.I.)

工程指示編號：EI / 9933 / 18

修改版次：E

工程編號：J - 837

工程名稱：觀塘裕民坊

工程項目：後裝窗大貨(T1-T5) 增訂 52/F

收件人：生統 / 永林

發件人：Bessie

日期：09/04/2019

要求提供 / 確認 事項：

- ( ) 初步鋁料 B.M.
- ( ) 加工拆圖，然後生產
- ( ) 尺寸表
- ( ) 正式鋁料 B.M.
- ( ) 技術上資料 / 指示
- ( ) 報價
- ( ) 配件 B.M.
- ( ) 樣辦或貨品說明書
- ( ) 分判合約
- ( ) 其他：\_\_\_\_\_

內容：

現按則師 20190114 之 COMMENT 增訂 52/F 後裝窗共兩幅，謝謝！  
(T3W-E-1 & T3W-E-2 增加至 52/F)

請在 N/A 前完成上列要求。

附：

附則師comment

以上項目為：

- 原合約工程包
- 原合約工程加 / 減賬
- 新工程報價

原因：-

分發東莞各部門：

- ( ) 生產技術總監  連附件
- ( ) 技術部  連附件
- ( ) 生產部  連附件
- ( ) 機械設計部  連附件
- ( ) 採購部  連附件
- ( ) 生產統籌部  連附件
- ( ) 質檢部  連附件
- ( ) 會計部  連附件
- ( ) 報關組  連附件
- ( ) 其他 楊榮輝  連附件

分發其他分判：

分發香港各部門：

- ( ) 行政部  連附件
- ( ) 會計部  連附件
- ( ) 統籌部  連附件
- ( ) 工程部地盤科文  連附件
- ( ) 採購部  連附件
- ( ) QS 部  連附件
- ( ) 維修部  連附件
- ( ) 其他 \_\_\_\_\_  連附件

傳遞編號：

HK 082/19

發件人簽署：

項目經理簽署：

E 9933 C  
 2版 窗 訂 T1W/7


圖則登記表  
 DRAWING REGISTER

工程名稱 Project Title: 觀塘裕民坊		接收日期 Receiving Date (適用於客戶圖則)	
50後裝窗 (原EI9933)		年	
工程編號 Project No: J-837		月	
分發予 Distributed To		日	
		年	18 18 19 19
		月	11 11 1 4
		日	9 14 26 9
圖則編號 Drg. No.	圖則名稱 Drawing Title	修訂編號 Revision No.	
T2W-N-1	50後裝窗組裝圖	1	- -
T5W-L-5	50後裝窗組裝圖	2	- -
T1W-E3	50後裝窗組裝圖	3	- -
T3W-5	50後裝窗組裝圖	4	- -
T5W-2	50後裝窗組裝圖	5	- -
T1W-G-1	50後裝窗組裝圖	6	- -
T5W-A-4	50後裝窗組裝圖	7	- -
T1W-A-2	50後裝窗組裝圖	8	- -
T5W-M-BATH2	50後裝窗組裝圖	9	- -
T1W-G2	50後裝窗組裝圖	10	- -
T1W-H-1	50後裝窗組裝圖	11	- - E
T1W-H-2	50後裝窗組裝圖	12	- -
T5W-L-4	50後裝窗組裝圖	13	- -
T2W-N-3	50後裝窗組裝圖	14	- -
T2W-C-1	50後裝窗組裝圖	15	- -
T2W-D-1	50後裝窗組裝圖	16	- -
T2W-M-2	50後裝窗組裝圖	17	- -
T2W-B-2	50後裝窗組裝圖	18	- - E
T1W-A-1	50後裝窗組裝圖	19	- -



 <b>美特鋁質</b> 有限公司 MIDI Aluminium Fabricator Ltd.	工程號	J837	拆圖	鞠章芳	2018.11.08
	地盤	觀塘裕民坊	復核	謝永林	2018.11.10
名稱	50後裝窗	顏色	EC-DG-S332054 (3塗)	批准	

百葉背板地盤配孔

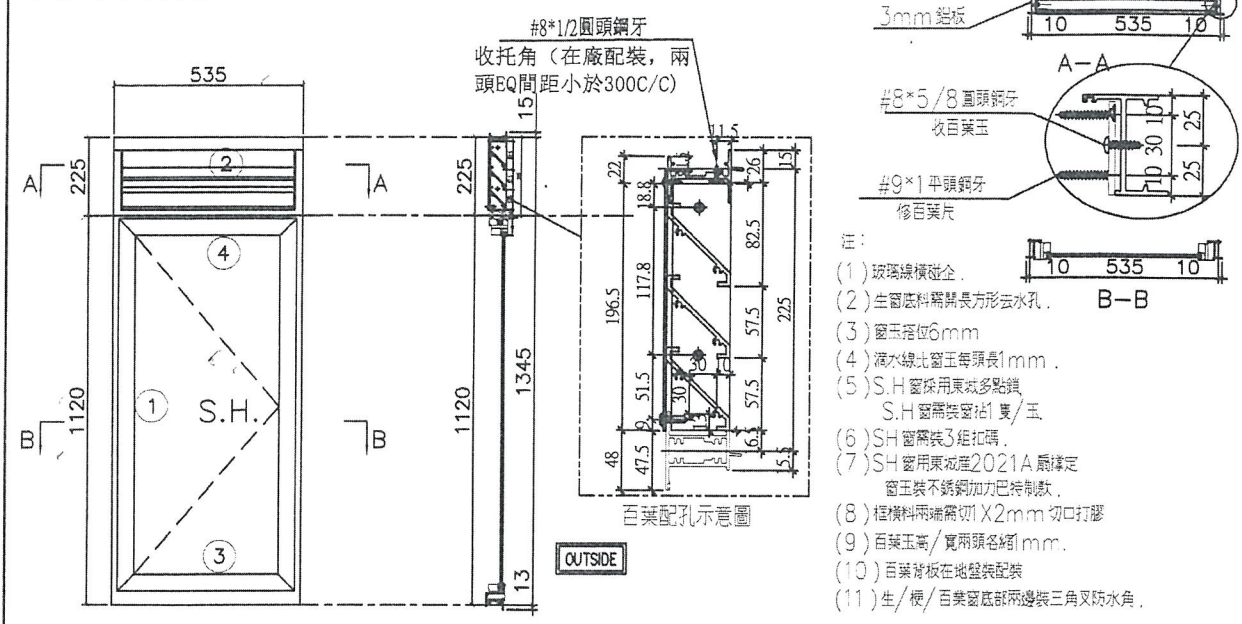


序號	料號	名稱	出荷	長度 (mm)	支/幅	加工說明
1	X846370	邊企料		1373.0	2	
2	X846390	生頂橫	避位	517	1	
3	X846400	生底橫	避位	509	1	
4	X846080	上生下生中橫	避位	517	1	


加工細則			
頂留	15	mm	
底留	13	mm	
企料底部開避位		mm	
底橫料防水巴鋸去		mm	
水線孔在企料	頂	底	
安裝扣碼	TC903		
多點鎖心型號:	東城2035B 鎖盒		
手柄型號:	2017-MD		
限位撐型號:			
T窗最大的開度:			
窗玉搭位數:	6mm		
窗款	寬度	高度	隻/幅 撐長
SHR	515.0	1098.5	2 14"

百葉玉用料

序號	料號	名稱	出荷	長度 (mm)	支/幅	加工說明
1	ME0002318	百葉玉鋁巴	避位	196.5	2	
2	X843331	百葉片	避位	495.0	3	
3	X844890	百葉頂托角	直口	495.0	1	
窗玉用料						
序號	料號	名稱	出荷	長度 (mm)	支/幅	加工說明
1	X846540	窗玉企	45°斜口	1098.5	2	
2	X846540	窗玉橫	45°斜口	515.0	2	
3	X846550	窗玉玻璃線企	直口	1034.5	2	
4	X846550	窗玉玻璃線橫	直口	419.0	2	

大圖版次	本圖版	7		
	日期	9/11/19		
窗号	寬度 (W)	高度 (H)	幅数	樓層數
T1W-H-1	535	1345.0	39	6-26 28-50F
T1W-C-2	535	1345.0	39	6-26 28-50F
T3W-E-2	535	1345.0	40	6-26 28-50F
T5W-M-BATH1	535	1345.0	1	51F
T5W-N-1	535	1345.0	39	6-26 28-50F
圖號	T1W-H-1			

 <b>美特鋁質</b> 有限公司 MIDI Aluminium Fabricator Ltd.	工程號	J837	拆圖	謝永林	2018.11.08
	地盤	觀塘裕民坊	復核	謝永林	2018.11.10
名稱	50後裝窗	顏色	EC-DG-S332054 (3塗)	批准	

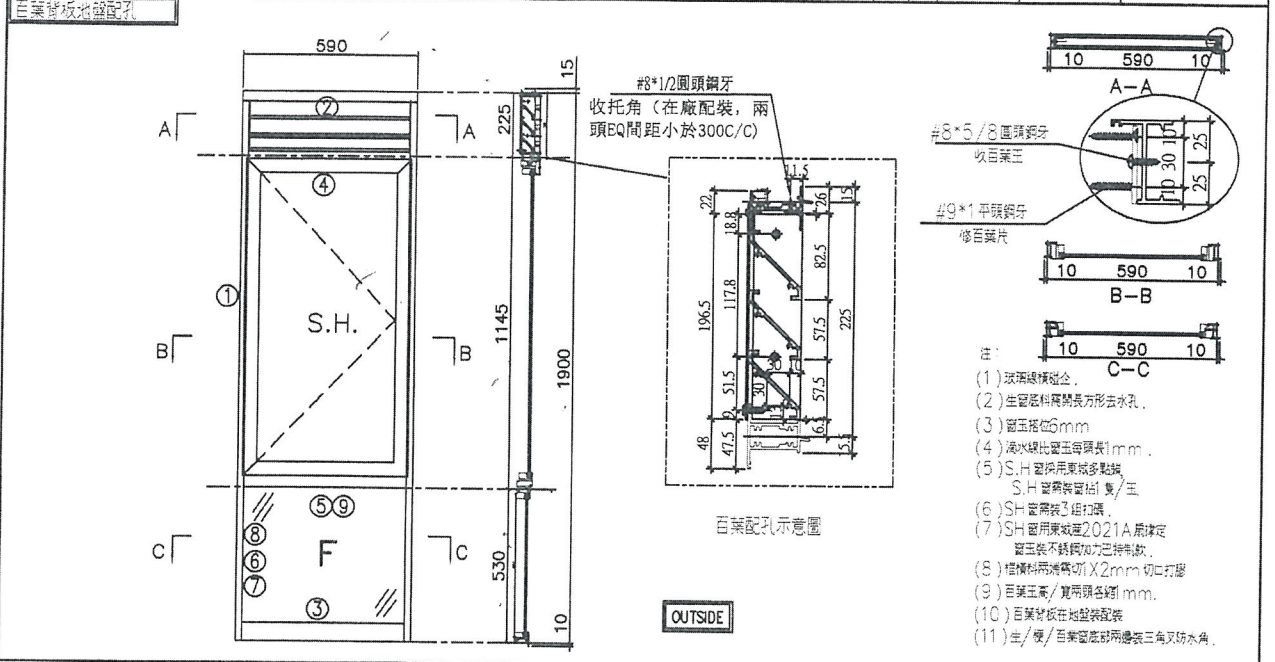

序號	料號	名稱	出荷	長度 (mm)	支/幅	加工說明
1	X846370	邊企料		1925.0	2	
2	X846390	生頂橫	避位	572	1	
3	X84642	梗底橫	避位	564	1	
4	X846080	上生下生中橫	避位	572	1	
5	X846100	上生下梗中橫	避位	564	1	
6	X846070	反拍線	避位	493.5	2	
7	X845451	反拍線擋膠鋁角	直口	493.5	2	
8	X846550	梗窗玻璃線企	直口	493.5	2	
9	X846550	梗窗玻璃線橫	直口	474.0	2	

加工細則			
頂留	15	mm	
底留	10	mm	
企料底部開避位		mm	
底橫料防水巴鋸去		mm	
水線孔在企料-----	頂	底	
安裝扣碼	TC903		
多點鎖芯型號:	東城2035B 鎖盒		
手柄型號:	2017-MD		
限位撐型號:			
T窗最大的開度:			
窗玉搭位數:	6mm		

序號	料號	名稱	出荷	長度 (mm)	支/幅	加工說明
百葉玉用料						
1	ME0002318	百葉玉鋁巴	避位	196.5	2	
2	X843331	百葉片	避位	550.0	3	
3	X844890	百葉頂托角	直口	550.0	1	

序號	料號	名稱	出荷	長度 (mm)	支/幅	加工說明
窗玉用料						
1	X846540	窗玉企	45°斜口	1126.0	2	
2	X846540	窗玉橫	45°斜口	570.0	2	
3	X846550	窗玉玻璃線企	直口	1062.0	2	
4	X846550	窗玉玻璃線橫	直口	474.0	2	

大圖版次	本圖版	日期	窗號	
		9/4/14	寬度 (W)	高度 (H)
			幅數	樓層數
			T2W-B-2	590 ✓ 1900.0 43 ✓ 6-26 28-55F
			T2W-B-1	590 ✓ 1900.0 43 ✓ 6-26 28-55F
			T3W-B-2	590 ✓ 1900.0 41 ✓ 6-26 28-52F
			T3W-E-1	590 ✓ 1900.0 41 ✓ 6-26 28-51F
			T5W-G-2	590 ✓ 1900.0 39 ✓ 6-26 28-50F
			T3W-B-1	590 ✓ 1900.0 41 ✓ 6-26 28-52F
圖號	T2W-B-2			

52/F

CLIENT: **信和置業有限公司**  
Sino Land Company Limited

ARCHITECT: **WORKING PARTNERS LIMITED**  
ARCHITECTS & PLANNERS


WORK CONSULTANT: **WT**

STRUCTURAL ENGINEER: **CR Construction Company Limited**


FRAME CONSULTANT: **AECOM**

NOTE:  
1. ALL DIMENSIONS ARE IN mm.  
2. ALL ELEVATIONS ARE VIEWED FROM OUTSIDE.  
3. ALL DIMENSIONS TO BE VERIFIED ON SITE BEFORE FABRICATION.

LEGEND:  
 DETAIL MARK NO.  
 REEL SHEET NO.  
 1. F.F.L. -- FINISHED FLOOR LEVEL  
 2. S.F.L. -- STRUCTURAL FLOOR LEVEL  
 3. (A) -- REQUESTED DETAIL

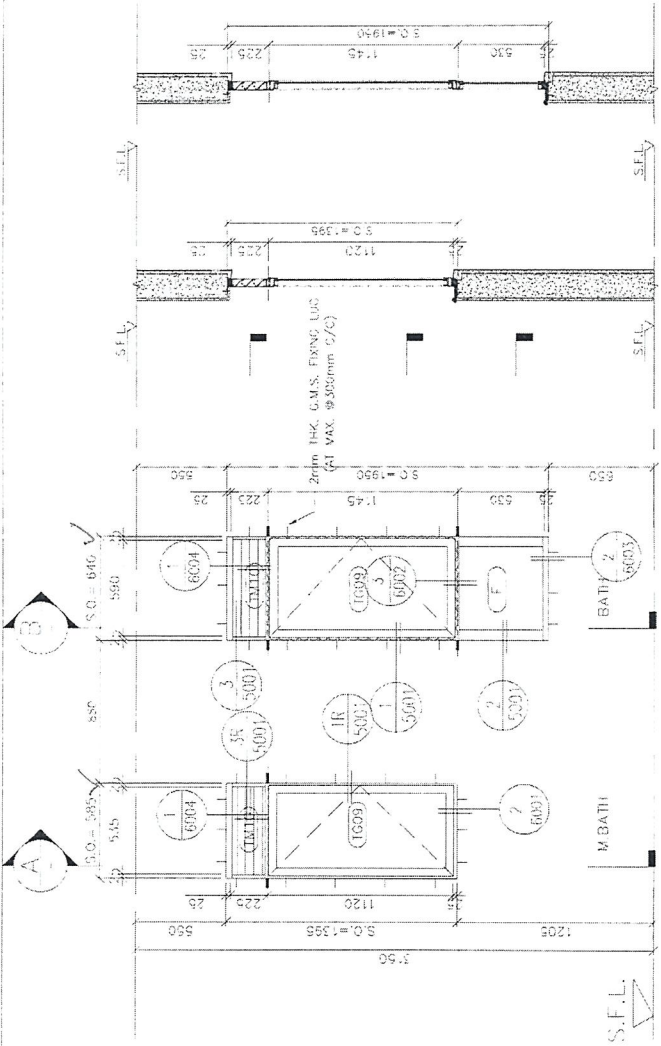

A-A  
B-B

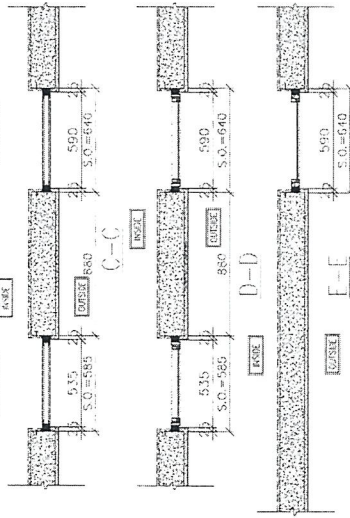

GLAZING AREA	Required = 0.336 Provided = 0.71
OPENABLE AREA	Required = 0.336 Provided = 0.57

GLAZING AREA	Required = 0.336 Provided = 0.42
OPENABLE AREA	Required = 0.336 Provided = 0.50

WINDOW MARK	T3W E-7	50mm ALUM. SECTION	50mm ALUM. SECTION
SECTION	T3 6/F-26/F	FLATE M-BATH	FLATE BATH
QTY.	2	42 NOS. (TYPICAL)	52/F
LOCATION	3mm THK ACID ETCHED FROSTED TEMPERED GLASS	3mm THK ACID ETCHED FROSTED TEMPERED GLASS	3mm THK ACID ETCHED FROSTED TEMPERED GLASS
REMARK			

PROJECT: **URA KW IN TONG TOWN CENTRE**  
REDEVELOPMENT (AREA 2 & 3) AT  
PKL 85/3, PAUK TONG, KUALALUMPUR

DATE: 04-04-18  
SCALE: 1:20  
DRAWN BY: Zeng  
CHECKED BY: JOW

ALUM. WINDOW SCHEDULE (FOR I3)

DATE: 04-04-18  
SCALE: 1:20  
DRAWN BY: Zeng  
CHECKED BY: JOW

CLIENT: **信和置業有限公司**  
Sino Land Company Limited

ARCHITECT: **WORKING PARTNERS LIMITED**  
ARCHITECTS & PLANNERS

WORK CONSULTANT: **WT**

STRUCTURAL ENGINEER: **CR Construction Company Limited**

FRAME CONSULTANT: **AECOM**

PROJECT: **URA KW IN TONG TOWN CENTRE**  
REDEVELOPMENT (AREA 2 & 3) AT  
PKL 85/3, PAUK TONG, KUALALUMPUR

DATE: 04-04-18  
SCALE: 1:20  
DRAWN BY: Zeng  
CHECKED BY: JOW

ALUM. WINDOW SCHEDULE (FOR I3)

DATE: 04-04-18  
SCALE: 1:20  
DRAWN BY: Zeng  
CHECKED BY: JOW