



工程指示 / 要求簡箋(E.I.)

工程指示編號：EI / 9987 / 18

修改版次：F

工程編號：J - 837

工程名稱：觀塘裕民坊

工程項目：幕牆 鋁料模圖繪畫 (1 個)

收件人：Maggie

發件人：Eric Liu

日期：17/01/2019

 要求提供 / 確認 事項：

- | | | |
|------------------------------------|-------------------------------------|-------------------------------|
| <input type="checkbox"/> 初步鋁料 B.M. | <input type="checkbox"/> 加工拆圖，然後生產 | <input type="checkbox"/> 尺寸表 |
| <input type="checkbox"/> 正式鋁料 B.M. | <input type="checkbox"/> 技術上資料 / 指示 | <input type="checkbox"/> 報價 |
| <input type="checkbox"/> 配件 B.M. | <input type="checkbox"/> 樣辦或貨品說明書 | <input type="checkbox"/> 分判合約 |
| <input type="checkbox"/> 其他：_____ | | |

內容：

請留意，因 EI9660 已到 J 版，無法再登記，EI9987 為 EI9660 修改版F 版: 1. 新增趟門用拉巴(X85657)

謝謝！

永材：請盡快提供此款拉巴鋁料BM

請在 2019/ 01 / 19 前完成上列要求。

附：1 頁模圖+1 頁

以上項目為：

 原合約工程包
 原合約工程加 / 減賬
 新工程報價

原因：-

分發東莞各部門：

- | | | | |
|--|---|---|---|
| <input type="checkbox"/> 生產技術總監 <input type="checkbox"/> 連附件 | <input checked="" type="checkbox"/> 技術部 <input checked="" type="checkbox"/> 連附件 | <input type="checkbox"/> 生產部 <input type="checkbox"/> 連附件 | <input type="checkbox"/> 機械設計部 <input type="checkbox"/> 連附件 |
| <input type="checkbox"/> 採購部 <input type="checkbox"/> 連附件 | <input type="checkbox"/> 生產統籌部 <input type="checkbox"/> 連附件 | | |
| <input type="checkbox"/> 質檢部 <input type="checkbox"/> 連附件 | <input type="checkbox"/> 會計部 <input type="checkbox"/> 連附件 | <input type="checkbox"/> 報關組 <input type="checkbox"/> 連附件 | <input type="checkbox"/> 其他 <u>楊榮輝</u> <input type="checkbox"/> 連附件 |

分發其他分判：

 王禮秋 連附件

分發香港各部門：

- | | | | |
|---|--|---|--|
| <input type="checkbox"/> 行政部 <input type="checkbox"/> 連附件 | <input type="checkbox"/> 會計部 <input type="checkbox"/> 連附件 | <input type="checkbox"/> 統籌部 <input type="checkbox"/> 連附件 | <input type="checkbox"/> 工程部地盤科文 <input type="checkbox"/> 連附件 |
| <input checked="" type="checkbox"/> 採購部 <input checked="" type="checkbox"/> 連附件 | <input type="checkbox"/> QS 部 <input type="checkbox"/> 連附件 | <input type="checkbox"/> 維修部 <input type="checkbox"/> 連附件 | <input type="checkbox"/> 其他 _____ <input type="checkbox"/> 連附件 |

傳遞編號：




HK 0165/19

發件人簽署：

項目經理簽署：

| 類別 | 名稱 | Page | PART | Grade | 榮陽DIE No. | Die No. | 0 | A | B | C | D | E | F |
|-----|------------|------|------|-------|-----------|-----------|--------|---|---|---|---|---|---|
| 企橫 | 雙梗企 | 1 | M1 | 6063 | T6 | LH0089912 | X85545 | | | | | | |
| 企橫 | 生梗企 | 2 | M2 | 6063 | T6 | LH0089913 | X85546 | | | | | | |
| 企橫 | 雙生企 | 3 | M3 | 6063 | T6 | LH0089914 | X85547 | | | | | | |
| 企橫 | SD中企(90) | 4 | M4 | 6063 | T6 | LH0089915 | X85548 | | | | | | |
| 企橫 | 轉角企 | 5 | M5 | 6063 | T6 | LH0090004 | X85549 | | | | | | |
| 企橫 | 邊企 | 6 | M6 | 6063 | T6 | LH0089916 | X85550 | | | | | | |
| 企橫 | 雙生托 | 7 | M7 | 6063 | T6 | LH0089917 | X85551 | | | | | | |
| 企橫 | 雙梗橫料 | 8 | T1 | 6063 | T6 | LH0089918 | X85552 | | | | | | |
| 企橫 | 生梗橫料 | 9 | T2 | 6063 | T6 | LH0089919 | X85553 | | | | | | |
| 取消 | SD窗頂橫(單玻) | 10 | T3 | 6063 | T6 | LH0089920 | X85554 | | | | | | |
| 企橫 | SD窗頂橫(雙玻) | 11 | T3A | 6063 | T6 | LH0089921 | X85555 | | | | | | |
| 窗玉 | 框橫料扣蓋 | 12 | A01 | 6063 | T5 | LH0089922 | X85556 | | | | | | |
| 取消 | 生玉料(單玻) | 13 | A02 | 6063 | T6 | LH0089923 | X85557 | | | | | | |
| 窗玉 | 玻璃扣蓋 | 14 | A03 | 6063 | T6 | LH0089924 | X85558 | | | | | | |
| 窗玉 | 生玉料(雙玻) | 15 | A04 | 6063 | T6 | LH0089925 | X85559 | | | | | | |
| 窗玉 | 單玻插線 | 16 | A05 | 6063 | T6 | LH0089926 | X85560 | | | | | | |
| 窗玉 | 生梗企單玻 | 17 | A06 | 6063 | T6 | LH0089927 | X85561 | | | | | | |
| 窗玉 | 生梗企雙玻 | 18 | A07 | 6063 | T6 | LH0089928 | X85562 | | | | | | |
| 窗玉 | 生梗企單玻扣蓋 | 19 | A08 | 6063 | T5 | LH0089929 | X85563 | | | | | | |
| 窗玉 | 生梗企雙玻扣蓋 | 20 | A09 | 6063 | T5 | LH0089930 | X85564 | | | | | | |
| 套心 | 雙梗企套心 | 21 | A10 | 6061 | T6 | LH0089931 | X85565 | | | | | | |
| 套心 | 生梗企套心 | 22 | A11 | 6061 | T6 | LH0089932 | X85566 | | | | | | |
| 套心 | 雙生企套心 | 23 | A12 | 6061 | T6 | LH0089933 | X85567 | | | | | | |
| 套心 | 轉角企套心 | 24 | A13 | 6061 | T6 | LH0090005 | X85568 | | | | | | |
| 企橫 | 轉角外蓋 | 25 | A14 | 6063 | T6 | LH0089934 | X85569 | | | | | | |
| 取消 | SD平台橫料(單玻) | 26 | S01 | 6063 | T6 | LH0089935 | X85570 | | | | | | |
| 趟門 | SD梗框企收邊 | 27 | S02 | 6063 | T6 | LH0090014 | X85571 | 1 | | | | | |
| 趟門 | SD平台橫料(雙玻) | 28 | S03 | 6063 | T6 | LH0089936 | X85572 | 1 | | | | | |
| 取消 | SD梗框底(單玻) | 29 | S04 | 6063 | T6 | | X85573 | | | | | | |
| 趟門 | SD梗框底(雙玻) | 30 | S05 | 6063 | T6 | LH0090103 | X85574 | 1 | | | | | |
| 取消 | SD梗企扣料(單玻) | 31 | S06 | 6063 | T6 | | X85575 | | | | | | |
| 趟門 | SD梗企扣角線 | 32 | S07 | 6063 | T6 | LH0090104 | X85576 | 1 | 廢 | | | | |
| 趟門 | SD梗企扣料(雙玻) | 33 | S08 | 6063 | T6 | LH0090105 | X85577 | 1 | 廢 | | | | |
| 趟門 | SD平台橫扣蓋 | 34 | S09 | 6063 | T5 | LH0089937 | X85578 | | | | | | |
| 趟門 | SD中柱底座 | 35 | S10 | 6063 | T6 | LH0090106 | X85579 | | | | | | |
| 趟門 | SD中柱勾企 | 36 | S12 | 6063 | T6 | LH0090107 | X85580 | 1 | | | | 廢 | |
| 趟門 | SD框頂橫 | 37 | S13 | 6063 | T6 | LH0090118 | X85581 | 1 | | | | | |
| 趟門 | SD勾企料 | 38 | S15 | 6063 | T6 | LH0090119 | X85582 | 1 | | | | 1 | |
| 趟門 | SD玉底橫 | 39 | S16 | 6063 | T6 | LH0090120 | X85583 | 1 | | | | | |
| 趟門 | SD框底橫 | 40 | S17 | 6063 | T5 | LH0090108 | X85584 | 1 | | | | | |
| 趟門 | SD玉頂橫 | 41 | S18 | 6063 | T6 | LH0090121 | X85585 | 1 | | | | | |
| 趟門 | SD中柱扣蓋 | 42 | S19 | 6063 | T6 | LH0090109 | X85586 | | | | | | |
| FD門 | FD門框底 | 43 | F01 | 6063 | T6 | | X85587 | | | | | | |
| FD門 | FD門框頂 | 44 | F02 | 6063 | T6 | | X85588 | | | | | | |
| FD門 | FD框企料 | 45 | F03 | 6063 | T5 | | X85589 | | | | | | |
| FD門 | FD門玉料 | 46 | F04 | 6063 | T6 | | X85590 | | | | | | |
| FD門 | FD門 | 47 | F05 | 6063 | T6 | | X85591 | | | | | | |
| 鋁碼 | 固定鋁碼 | 48 | AB01 | 6061 | T6 | LH0089938 | X85592 | | | | | | |
| 介子 | 85介子 | 49 | AB2 | 6061 | T6 | LH0089939 | X85593 | | | | | | |
| 企橫 | 30*30*6鋁角 | 50 | AB4 | 6061 | T6 | LH0089940 | X85594 | | | | | | |
| 取消 | 室外收口壓巴 | 51 | AB5 | 6063 | T5 | LH0089941 | X85595 | | | | | | |
| 企橫 | 轉角企內企 | 52 | A15 | 6063 | T6 | LH0090006 | X85596 | | | | | | |
| 企橫 | 轉角企室內蓋 | 53 | A16 | 6063 | T5 | LH0090007 | X85597 | | | | | | |
| 窗玉 | 拉巴 | 54 | A17 | 6063 | T6 | LH0090013 | X85598 | | | | | | |
| 取消 | 6+6玻璃用窗玉 | 55 | A18 | 6063 | T6 | LH0090015 | X85599 | | | | | | |
| 介子 | 48介子 | 56 | AB6 | 6061 | T6 | LH0090080 | X85600 | | | | | | |
| 趟門 | 中柱扣蓋(短) | 57 | S20 | 6063 | T6 | LH0090110 | X85603 | | | | | | |
| 趟門 | 趟門玉加拉手 | 58 | S21 | 6063 | T6 | LH0090122 | X85608 | 1 | | | | | |
| 趟門 | 趟門企框摩耳 | 59 | S22 | 6063 | T6 | LH0090111 | X85604 | 1 | | | | | |
| 取消 | 雙梗橫料 | 60 | T1A | 6063 | T6 | | X85605 | | | | | | |
| 趟門 | 玻璃拍線 | 61 | S23 | 6063 | T6 | LH0090170 | X85621 | 1 | | | | | |
| 趟門 | 底路軌飾線 | 62 | S24 | 6063 | T6 | LH0090171 | X85622 | 1 | | | | | |
| 趟門 | 底路軌(泥水用) | 63 | S25 | 6063 | T6 | LH0090172 | X85623 | 1 | | | | | |
| 趟門 | 頂橫(泥水用) | 64 | S26 | 6063 | T6 | LH0090173 | X85624 | 1 | | | | | |
| 背板 | 修背板位用 | 65 | AB7 | 6063 | T5 | LH0090174 | X85625 | 1 | | | | | |
| 趟門 | SD梗企扣角線 | 66 | S07 | 6063 | T6 | LH0090176 | X85626 | | 1 | | | | |
| 趟門 | SD梗企扣料(雙玻) | 67 | S08 | 6063 | T6 | LH0090177 | X85627 | | 1 | | | | |
| 窗玉 | 8+8窗玉 | 68 | S07 | 6063 | T6 | LH0090212 | X85638 | | | 1 | | 1 | |
| 攝芯 | 橫碰企攝芯 | 69 | S08 | 6063 | T6 | LH0090213 | X85639 | | | 1 | | | |
| 窗玉 | 蝴蝶窗窗玉 | 70 | A19 | 6063 | T6 | LH0090228 | X85650 | | | | 1 | 1 | |
| 窗玉 | 蝴蝶窗玻璃線 | 71 | A20 | 6063 | T6 | LH0090229 | X85651 | | | | 1 | | |
| 趟門 | SD中柱勾企 | 72 | S12 | 6063 | T6 | LH0090230 | X85652 | | | | | 1 | |
| FD門 | 加長腳門框 | 73 | F06 | 6063 | T6 | LH0090234 | X85653 | | | | | | 1 |
| 趟門 | 趟門用拉巴 | 74 | S27 | 6061 | T6 | | X85657 | | | | | | 1 |
| | | | | | | 總數 | 18 | 2 | 2 | 2 | 4 | 1 | 1 |

| | | | | |
|----------|--|-------------------|---------------|--------|
| CUSTOMER | | CUSTOMER APPROVAL | CUST PART NO. | S27 |
| | | | SECTION NO. | Y85657 |

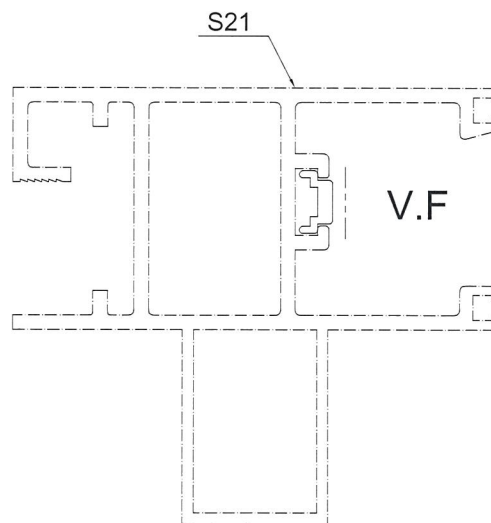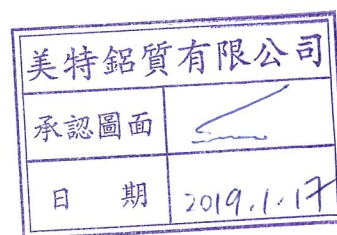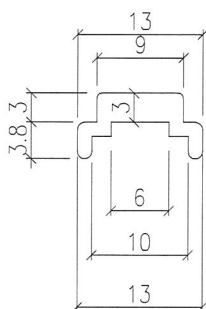

SCALE 1:1

| | | | | | | | | | |
|--------------------|-------------------------|-----------------------|------------------|----------------|-------------|----------|---------|---------|-----|
| SIGNATURE GRADEING | HIGH SIGNATURE GRADEING | C.C.DIA(MM) | | | | | | | |
| AREA (SQ MM) | 43.57 | UNSPECIFIED THICKNESS | - | PERIMETER (MM) | - | STANDARD | | SCALE | 2:1 |
| MASS (KG/M) | - | UNSPECIFIED CORNERS | - | SURFACE AREA | - | ALLOY | 6061 T6 | VERSION | |
| COMPANY ISSUE | | | DRAWA | DATE | APPELLATION | - | PAGE OF | | |
| | | | STANDA-RDIZATION | DATE | | | | | |
| | | | TO SIGN | DATE | | | | | |
| | | | AUDITING | DATE | | | | | |
| MARKER | MODIFY | FILE NO | SIGNATURE | DATE | APPROV | | | | |



美特鋁質有限公司
MIDI Aluminium Fabricator Ltd.