

工程指示 / 要求簡箋(E.I.)

工程指示編號：EI / 9987 / 18

修改版次：G

工程編號：J - 837

工程名稱：觀塘裕民坊

工程項目：幕牆 鋁料模圖繪畫 (1 個)

收件人：Maggie

發件人：Eric Liu

日期：18/01/2019

要求提供 / 確認 事項：

- |                                    |                                     |                               |
|------------------------------------|-------------------------------------|-------------------------------|
| <input type="checkbox"/> 初步鋁料 B.M. | <input type="checkbox"/> 加工拆圖，然後生產  | <input type="checkbox"/> 尺寸表  |
| <input type="checkbox"/> 正式鋁料 B.M. | <input type="checkbox"/> 技術上資料 / 指示 | <input type="checkbox"/> 報價   |
| <input type="checkbox"/> 配件 B.M.   | <input type="checkbox"/> 樣辦或貨品說明書   | <input type="checkbox"/> 分判合約 |
| <input type="checkbox"/> 其他：_____  |                                     |                               |

內容：

請留意，因 EI9660 已到 J 版，無法再登記，EI9987 為 EI9660 修改版

G 版: 1. 趟門用拉巴(X85657)，改為 6063-T6

謝謝！

請在 2019/ 01 / 21 前完成上列要求。

附：1 頁模圖+1 頁

以上項目為：

- 原合約工程包                       原合約工程加 / 減賬                       新工程報價

原因：-

分發東莞各部門：

- ( ) 生產技術總監  連附件    ( / ) 技術部  連附件 *林*    ( ) 生產部  連附件    ( ) 機械設計部  連附件  
 ( ) 採購部  連附件    ( / ) 生產統籌部  連附件 *梅*  
 ( ) 質檢部  連附件    ( ) 會計部  連附件    ( ) 報關組  連附件    ( ) 其他 楊榮輝  連附件

分發其他分判：

- ( ) 王禮秋  連附件

分發香港各部門：

- ( ) 行政部  連附件    ( ) 會計部  連附件    ( ) 統籌部  連附件    ( ) 工程部地盤科文  連附件  
 ( / ) 採購部  連附件    ( ) QS 部  連附件    ( ) 維修部  連附件    ( ) 其他 \_\_\_\_\_  連附件

傳遞編號：

HK 0172/19

發件人簽署：


*Eric Liu*

項目經理簽署：


*pp*

類別	名稱	Page	PART	Grade	榮陽DIE No.	Die No.	0	A	B	C	D	E	F	G	
企橫	雙梗企	1	M1	6063	T6	LH0089912	X85545								
企橫	生梗企	2	M2	6063	T6	LH0089913	X85546								
企橫	雙生企	3	M3	6063	T6	LH0089914	X85547								
企橫	SD中企(90)	4	M4	6063	T6	LH0089915	X85548								
企橫	轉角企	5	M5	6063	T6	LH0090004	X85549								
企橫	邊企	6	M6	6063	T6	LH0089916	X85550								
企橫	雙生托	7	M7	6063	T6	LH0089917	X85551								
企橫	雙梗橫料	8	T1	6063	T6	LH0089918	X85552								
企橫	生梗橫料	9	T2	6063	T6	LH0089919	X85553								
取消	SD窗頂橫(單玻)	10	T3	6063	T6	LH0089920	X85554								
企橫	SD窗頂橫(雙玻)	11	T3A	6063	T6	LH0089921	X85555								
窗玉	框橫料扣蓋	12	A01	6063	T5	LH0089922	X85556								
取消	生玉料(單玻)	13	A02	6063	T6	LH0089923	X85557								
窗玉	玻璃扣蓋	14	A03	6063	T6	LH0089924	X85558								
窗玉	生玉料(雙玻)	15	A04	6063	T6	LH0089925	X85559								
窗玉	單玻插線	16	A05	6063	T6	LH0089926	X85560								
窗玉	生梗企單玻	17	A06	6063	T6	LH0089927	X85561								
窗玉	生梗企雙玻	18	A07	6063	T6	LH0089928	X85562								
窗玉	生梗企單玻扣蓋	19	A08	6063	T5	LH0089929	X85563								
窗玉	生梗企雙玻扣蓋	20	A09	6063	T5	LH0089930	X85564								
套心	雙梗企套心	21	A10	6061	T6	LH0089931	X85565								
套心	生梗企套心	22	A11	6061	T6	LH0089932	X85566								
套心	雙生企套心	23	A12	6061	T6	LH0089933	X85567								
套心	轉角企套心	24	A13	6061	T6	LH0090005	X85568								
企橫	轉角外蓋	25	A14	6063	T6	LH0089934	X85569								
取消	SD平台橫料(單玻)	26	S01	6063	T6	LH0089935	X85570								
趟門	SD梗框企收邊	27	S02	6063	T6	LH0090014	X85571	1							
趟門	SD平台橫料(雙玻)	28	S03	6063	T6	LH0089936	X85572	1							
取消	SD梗框底(單玻)	29	S04	6063	T6		X85573								
趟門	SD梗框底(雙玻)	30	S05	6063	T6	LH0090103	X85574	1							
取消	SD梗企扣料(單玻)	31	S06	6063	T6		X85575								
趟門	SD梗企扣角線	32	S07	6063	T6	LH0090104	X85576	1	廢						
趟門	SD梗企扣料(雙玻)	33	S08	6063	T6	LH0090105	X85577	1	廢						
趟門	SD平台橫扣蓋	34	S09	6063	T5	LH0089937	X85578								
趟門	SD中柱底座	35	S10	6063	T6	LH0090106	X85579								
趟門	SD中柱勾企	36	S12	6063	T6	LH0090107	X85580	1				廢			
趟門	SD框頂橫	37	S13	6063	T6	LH0090118	X85581	1							
趟門	SD勾企料	38	S15	6063	T6	LH0090119	X85582	1				1			
趟門	SD玉底橫	39	S16	6063	T6	LH0090120	X85583	1							
趟門	SD框底橫	40	S17	6063	T5	LH0090108	X85584	1							
趟門	SD玉頂橫	41	S18	6063	T6	LH0090121	X85585	1							
趟門	SD中柱扣蓋	42	S19	6063	T6	LH0090109	X85586								
FD門	FD門框底	43	F01	6063	T6		X85587								
FD門	FD門框頂	44	F02	6063	T6		X85588								
FD門	FD框企料	45	F03	6063	T5		X85589								
FD門	FD門玉料	46	F04	6063	T6		X85590								
FD門	FD門	47	F05	6063	T6		X85591								
鋁碼	固定鋁碼	48	AB01	6061	T6	LH0089938	X85592								
介子	85介子	49	AB2	6061	T6	LH0089939	X85593								
企橫	30*30*6鋁角	50	AB4	6061	T6	LH0089940	X85594								
取消	室外收口膠巴	51	AB5	6063	T5	LH0089941	X85595								
企橫	轉角企內企	52	A15	6063	T6	LH0090006	X85596								
企橫	轉角企室內蓋	53	A16	6063	T5	LH0090007	X85597								
窗玉	拉巴	54	A17	6063	T6	LH0090013	X85598								
取消	6+6玻璃用窗玉	55	A18	6063	T6	LH0090015	X85599								
介子	48介子	56	AB6	6061	T6	LH0090080	X85600								
趟門	中柱扣蓋(短)	57	S20	6063	T6	LH0090110	X85603								
趟門	趟門玉加拉手	58	S21	6063	T6	LH0090122	X85608	1							
趟門	趟門企框摩耳	59	S22	6063	T6	LH0090111	X85604	1							
取消	雙梗橫料	60	T1A	6063	T6		X85605								
趟門	玻璃拍線	61	S23	6063	T6	LH0090170	X85621	1							
趟門	底路軌飾線	62	S24	6063	T6	LH0090171	X85622	1							
趟門	底路軌(泥水用)	63	S25	6063	T6	LH0090172	X85623	1							
趟門	頂橫(泥水用)	64	S26	6063	T6	LH0090173	X85624	1							
背板	修背板位用	65	AB7	6063	T5	LH0090174	X85625	1							
趟門	SD梗企扣角線	66	S07	6063	T6	LH0090176	X85626		1						
趟門	SD梗企扣料(雙玻)	67	S08	6063	T6	LH0090177	X85627		1						
窗玉	8+8窗玉	68	S07	6063	T6	LH0090212	X85638			1		1			
攝芯	攝芯企攝芯	69	S08	6063	T6	LH0090213	X85639			1					
窗玉	蝴蝶窗窗玉	70	A19	6063	T6	LH0090228	X85650				1	1			
窗玉	蝴蝶窗玻璃線	71	A20	6063	T6	LH0090229	X85651				1				
趟門	SD中柱勾企	72	S12	6063	T6	LH0090230	X85652					1			
FD門	加長腳門框	73	F06	6063	T6	LH0090234	X85653						1		
趟門	趟門用拉巴	74	S27	6063	T6		X85657						1	1	
						總數		18	2	2	2	4	1	1	1

CUSTOMER	CUSTOMER APPROVAL	CUST PART NO.	S27
		SECTION NO.	Y85657

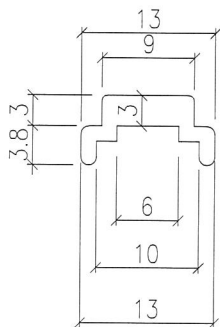

美特鋁質有限公司  
承認圖面 印乙  
日期 2019.1.18

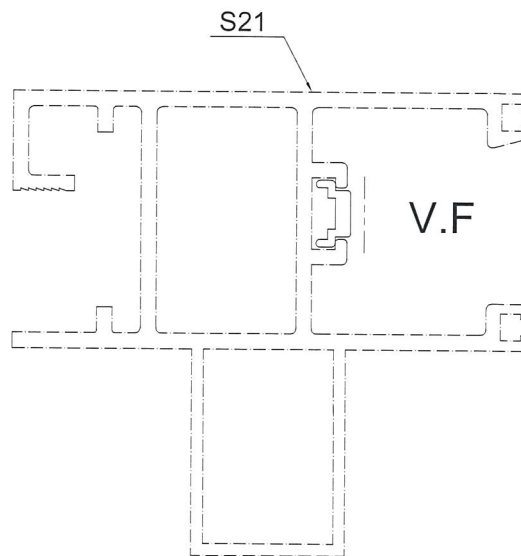

SCALE 1:1

SIGNATURE GRADEING	HIGH SIGNATURE GRADEING	C.C.DIA(MM)							
AREA (SQ MM)	43.57	UNSPECIFIED THICKNESS	-	PERIMETER (MM)	-	STANDARD		SCALE	2:1
MASS (KG/M)	-	UNSPECIFIED CORNERS	-	SURFACE AREA	-	ALLOY	6063 T6	VERSION	A
COMPANY ISSUE			DRAWA	DATE	APPELLATION	-	PAGE OF		
			STANDAR- RDIZATION	DATE					
			TO SIGN	DATE					
			AUDITING	DATE					
MARKER MODIFY	FILE NO	SIGNATURE	DATE	APPROV	DATE				

美特鋁質有限公司  
MIDI Aluminium Fabricator Ltd.