

## 工程指示 / 要求簡箋(E.I.)

工程指示編號：EI / 9987 / 18

修改版次：I

工程編號：J - 837

工程名稱：觀塘裕民坊

工程項目：幕牆 鋁料模圖繪畫 (1 個)

收件人：Maggie

發件人：Eric Liu

日期：27/02/2019

□要求提供 / □確認 事項：

- |                                    |                                     |                               |
|------------------------------------|-------------------------------------|-------------------------------|
| <input type="checkbox"/> 初步鋁料 B.M. | <input type="checkbox"/> 加工拆圖，然後生產  | <input type="checkbox"/> 尺寸表  |
| <input type="checkbox"/> 正式鋁料 B.M. | <input type="checkbox"/> 技術上資料 / 指示 | <input type="checkbox"/> 報價   |
| <input type="checkbox"/> 配件 B.M.   | <input type="checkbox"/> 樣辦或貨品說明書   | <input type="checkbox"/> 分判合約 |
| <input type="checkbox"/> 其他：_____  |                                     |                               |

內容：

請留意，因 EI9660 已到 J 版，無法再登記，EI9987 為 EI9660 修改版I 版: 1.修改 X85662，(EI9894I 已批，原 1mm 厚，簽批 1.5mm 厚，要修改內壁尺寸)謝謝！請在 2019/ 02 / 22 前完成上列要求。

附：1 頁模圖+1 頁

以上項目為：

- |                                 |                                      |                                |
|---------------------------------|--------------------------------------|--------------------------------|
| <input type="checkbox"/> 原合約工程包 | <input type="checkbox"/> 原合約工程加 / 減賬 | <input type="checkbox"/> 新工程報價 |
|---------------------------------|--------------------------------------|--------------------------------|

原因：-

分發東莞各部門：

- |   |                              |   |                              |                              |                              |                                |   |
|---|------------------------------|---|------------------------------|------------------------------|------------------------------|--------------------------------|---|
| <input type="checkbox"/> 生產技術總監         | <input type="checkbox"/> 連附件 | <input checked="" type="checkbox"/> 技術部   | <input type="checkbox"/> 連附件 | <input type="checkbox"/> 生產部 | <input type="checkbox"/> 連附件 | <input type="checkbox"/> 機械設計部 | <input type="checkbox"/> 連附件            |
| <input type="checkbox"/> 採購部            | <input type="checkbox"/> 連附件 | <input checked="" type="checkbox"/> 生產統籌部 | <input type="checkbox"/> 連附件 |                              |                              |                                |   |
| <input checked="" type="checkbox"/> 質檢部 | <input type="checkbox"/> 連附件 | <input type="checkbox"/> 會計部              | <input type="checkbox"/> 連附件 | <input type="checkbox"/> 報關組 | <input type="checkbox"/> 連附件 | <input type="checkbox"/> 其他    | <u>楊榮輝</u> <input type="checkbox"/> 連附件 |

分發其他分判：

- |                              |                              |
|------------------------------|------------------------------|
| <input type="checkbox"/> 王禮秋 | <input type="checkbox"/> 連附件 |
|------------------------------|------------------------------|

分發香港各部門：

- |   |                              |                               |                              |                              |                              |                                 |                                    |
|---|------------------------------|-------------------------------|------------------------------|------------------------------|------------------------------|---------------------------------|------------------------------------|
| <input type="checkbox"/> 行政部            | <input type="checkbox"/> 連附件 | <input type="checkbox"/> 會計部  | <input type="checkbox"/> 連附件 | <input type="checkbox"/> 統籌部 | <input type="checkbox"/> 連附件 | <input type="checkbox"/> 工程部地盤科 | <input type="checkbox"/> 連附件       |
| <input checked="" type="checkbox"/> 採購部 | <input type="checkbox"/> 連附件 | <input type="checkbox"/> QS 部 | <input type="checkbox"/> 連附件 | <input type="checkbox"/> 維修部 | <input type="checkbox"/> 連附件 | <input type="checkbox"/> 其他     | _____ <input type="checkbox"/> 連附件 |

傳遞編號：

HK0487 /19

發件人簽署：


項目經理簽署：

類別	名稱	Page	PART	Grade	禁陽DIE No.	Die No.	0	A	B	C	D	E	F	G	H	I
企橫	雙標企	1	M1	6063	T6	LH0089912	X85545									
企橫	生標企	2	M2	6063	T6	LH0089913	X85546									
企橫	雙生企	3	M3	6063	T6	LH0089914	X85547									
企橫	SD中企(90)	4	M4	6063	T6	LH0089915	X85548									
企橫	轉角企	5	M5	6063	T6	LH0090004	X85549									
企橫	邊企	6	M6	6063	T6	LH0089916	X85550									
企橫	雙生托	7	M7	6063	T6	LH0089917	X85551									
企橫	雙標橫料	8	T1	6063	T6	LH0089918	X85552									
企橫	生標橫料	9	T2	6063	T6	LH0089919	X85553									
取消	SD窗頂橫(單玻)	10	T3	6063	T6	LH0089920	X85554									
企橫	SD窗頂橫(雙玻)	11	T3A	6063	T6	LH0089921	X85555									
窗玉	框橫料扣蓋	12	A01	6063	T5	LH0089922	X85556									
取消	生玉料(單玻)	13	A02	6063	T6	LH0089923	X85557									
窗玉	玻璃扣蓋	14	A03	6063	T6	LH0089924	X85558									
窗玉	生玉料(雙玻)	15	A04	6063	T6	LH0089925	X85559									
窗玉	單玻插線	16	A05	6063	T6	LH0089926	X85560									
窗玉	生標企單玻	17	A06	6063	T6	LH0089927	X85561									
窗玉	生標企雙玻	18	A07	6063	T6	LH0089928	X85562									
窗玉	生標企單玻扣蓋	19	A08	6063	T5	LH0089929	X85563									
窗玉	生標企雙玻扣蓋	20	A09	6063	T5	LH0089930	X85564									
套心	雙標企套心	21	A10	6061	T6	LH0089931	X85565									
套心	生標企套心	22	A11	6061	T6	LH0089932	X85566									
套心	雙生企套心	23	A12	6061	T6	LH0089933	X85567									
套心	轉角企套心	24	A13	6061	T6	LH0090005	X85568									
企橫	轉角外蓋	25	A14	6063	T6	LH0089934	X85569									
取消	SD平台橫料(單玻)	26	S01	6063	T6	LH0089935	X85570									
趟門	SD標框企收邊	27	S02	6063	T6	LH0090014	X85571	1								
趟門	SD平台橫料(雙玻)	28	S03	6063	T6	LH0089936	X85572	1								
取消	SD標框底(單玻)	29	S04	6063	T6		X85573									
趟門	SD標框底(雙玻)	30	S05	6063	T6	LH0090103	X85574	1								
取消	SD標企扣料(單玻)	31	S06	6063	T6		X85575									
趟門	SD標企扣角線	32	S07	6063	T6	LH0090104	X85576	1	腐							
趟門	SD標企扣料(雙玻)	33	S08	6063	T6	LH0090105	X85577	1	腐							
趟門	SD平台橫扣蓋	34	S09	6063	T5	LH0089937	X85578									
趟門	SD中柱底座	35	S10	6063	T6	LH0090106	X85579									
趟門	SD中柱勾企	36	S12	6063	T6	LH0090107	X85580	1								
趟門	SD框頂橫	37	S13	6063	T6	LH0090118	X85581	1								
趟門	SD勾企料	38	S15	6063	T6	LH0090119	X85582	1								
趟門	SD玉底橫	39	S16	6063	T6	LH0090120	X85583	1								
趟門	SD框底橫	40	S17	6063	T5	LH0090108	X85584	1								
趟門	SD玉頂橫	41	S18	6063	T6	LH0090121	X85585	1								
趟門	SD中柱扣蓋	42	S19	6063	T6	LH0090109	X85586									
FD門	FD門框底	43	F01	6063	T6		X85587									
FD門	FD門框頂	44	F02	6063	T6		X85588									
FD門	FD框企料	45	F03	6063	T5		X85589									
FD門	FD門玉料	46	F04	6063	T6		X85590									
FD門	FD門	47	F05	6063	T6		X85591									
鉛碼	固定鉛碼	48	AB01	6061	T6	LH0089938	X85592									
介子	85介子	49	AB2	6061	T6	LH0089939	X85593									
企橫	30*30*6鋁角	50	AB4	6061	T6	LH0089940	X85594									
取消	室外收口膠巴	51	AB5	6063	T5	LH0089941	X85595									
企橫	轉角企內企	52	A15	6063	T6	LH0090006	X85596									
企橫	轉角企室內蓋	53	A16	6063	T5	LH0090007	X85597									
窗玉	拉巴	54	A17	6063	T6	LH0090013	X85598									
取消	6+6玻璃用窗玉	55	A18	6063	T6	LH0090015	X85599									
介子	48介子	56	AB6	6061	T6	LH0090080	X85600									
趟門	中柱扣蓋(短)	57	S20	6063	T6	LH0090110	X85603									
趟門	趟門玉加拉手	58	S21	6063	T6	LH0090122	X85608	1								
趟門	趟門企框厚耳	59	S22	6063	T6	LH0090111	X85604	1								
取消	雙標橫料	60	T1A	6063	T6		X85605									
趟門	玻璃拍線	61	S23	6063	T6	LH0090170	X85621	1								
趟門	底路軌飾線	62	S24	6063	T6	LH0090171	X85622	1								
趟門	底路軌(泥水用)	63	S25	6063	T6	LH0090172	X85623	1								
趟門	頂橫(泥水用)	64	S26	6063	T6	LH0090173	X85624	1								
背板	修背板位用	65	AB7	6063	T5	LH0090174	X85625	1								
趟門	SD標企扣角線	66	S07	6063	T6	LH0090176	X85626		1							
趟門	SD標企扣料(雙玻)	67	S08	6063	T6	LH0090177	X85627		1							
窗玉	8+8窗玉	68	S07	6063	T6	LH0090212	X85638			1						
攝芯	橫碰企攝芯	69	S08	6063	T6	LH0090213	X85639			1						
窗玉	蝴蝶窗窗玉	70	A19	6063	T6	LH0090228	X85650				1					
窗玉	蝴蝶窗玻璃線	71	A20	6063	T6	LH0090229	X85651				1					
趟門	SD中柱勾企	72	S12	6063	T6	LH0090230	X85652					1				
FD門	加長腳門框	73	F06	6063	T6	LH0090234	X85653						1			
趟門	趟門用拉巴	74	S27	6063	T6	LH0090297	X85657							1		
企橫	死牆二合一遮醜片	75	A21	6063	T6	LH0090326	X85662							1	1	
							總數	18	2	2	2	4	1	1	1	1





CUSTOMER	CUSTOMER APPROVAL	CUST PART NO.	A21
		SECTION NO.	X85662

LH0090326

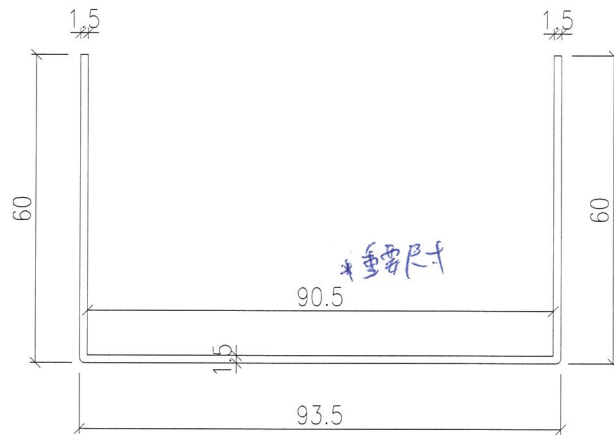

美特鋁質有限公司  
承認圖面  
日期 2019-2-27

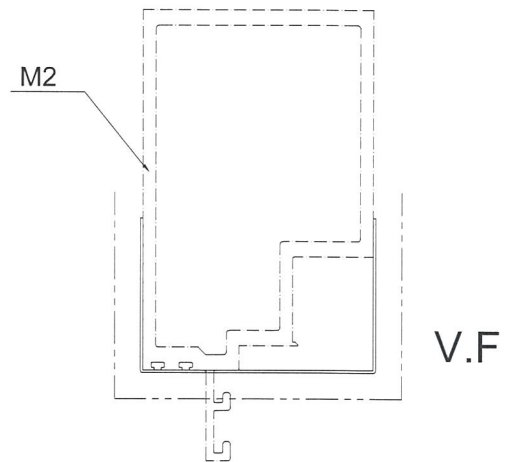

SIGNATURE GRADEING	HIGH SIGNATURE GRADEING	C.C.DIA(MM)							
AREA (SQ MM)	210	UNSPECIFIED THICKNESS	-	PERIMETER (MM)	-	STANDARD		SCALE	1:1
MASS (KG/M)	-	UNSPECIFIED CORNERS	-	SURFACE AREA	-	ALLOY	6063 T6	VERSION	A
COMPANY ISSUE			DRAWN	DATE	APPELLATION		-	PAGE OF	
			STANDARDIZATION	DATE	 <b>美特鋁質有限公司</b> MIDI Aluminium Fabricator Ltd.				
			TO SIGN	DATE					
			AUDITING	DATE					
MARKER	MODIFY	FILE NO	SIGNATURE	DATE					