

工程指示 / 要求簡箋(E.I.)

工程指示編號：EI/1245/19

修改版次：C

工程編號：J851

工程名稱：青衣明翹匯住宅

工程項目：樣板

收件人：生統

發件人：Leung Hin Wai

日期：29/11/2019

要求提供 / 確認 事項：

- | | | |
|------------------------------------|-------------------------------------|-------------------------------|
| <input type="checkbox"/> 初步鋁料 B.M. | <input type="checkbox"/> 加工拆圖，然後生產 | <input type="checkbox"/> 尺寸表 |
| <input type="checkbox"/> 正式鋁料 B.M. | <input type="checkbox"/> 技術上資料 / 指示 | <input type="checkbox"/> 報價 |
| <input type="checkbox"/> 配件 B.M. | <input type="checkbox"/> 樣辦或貨品說明書 | <input type="checkbox"/> 分判合約 |
| <input type="checkbox"/> 其他：_____ | | |

施工圖更新

內容：

請看附頁施工圖，要在 12 月 14 日送趨門、鋁窗、欄河、柵格、鋁板和鋁飾線。

在 12 月 16 日開始安裝。

地址是東莞鴻輝建築材料製品有限公司 東莞市沙田鎮福祿沙管理區

聯絡人:李志鵬 電話:150 1709 1031

請安排適合人手在以上地址安裝

請在_____前完成上列要求。

附： -

以上項目為：

- 原合約工程包 原合約工程加 / 減賬 新工程報價

原因：-

分發東莞各部門：

- ()生產技術總監 連附件 ()技術部 連附件 ()生產部 連附件 ()機械設計部 連附件
 ()採購部 連附件 ()生產統籌部 連附件
 ()質檢部 連附件 ()會計部 連附件 ()報關組 連附件 ()其他 _____ 連附件

分發香港各部門：

- ()行政部 連附件 ()會計部 連附件 ()統籌部 連附件 ()工程部地盤科文(柄) 連附件
 ()採購部 連附件 ()QS 部 連附件 ()維修部 連附件 ()其他 _____ 連附件

傳遞編號：

H/A 2450

發件人簽署：

仲

項目經理簽署：

林pp


PROJECT :**RESIDENTIAL DEVELOPMENT AT
TSING YI TOWN LOT 190
SAI SHAN ROAD**

**DRAWING FOR MOCK UP
ALUM. WINDOW, ALUM. GRILLE,
GLASS BALUSTRADE AND ALUM. FEATURE
(TOWER 1)**


DATE : 29 - November - 2019




Units 6-8, Sunray Industrial Centre, 1/F
610 Cha Kwo Ling Road, Kowloon
Tel:23489211-4 Fax:(852)27727666

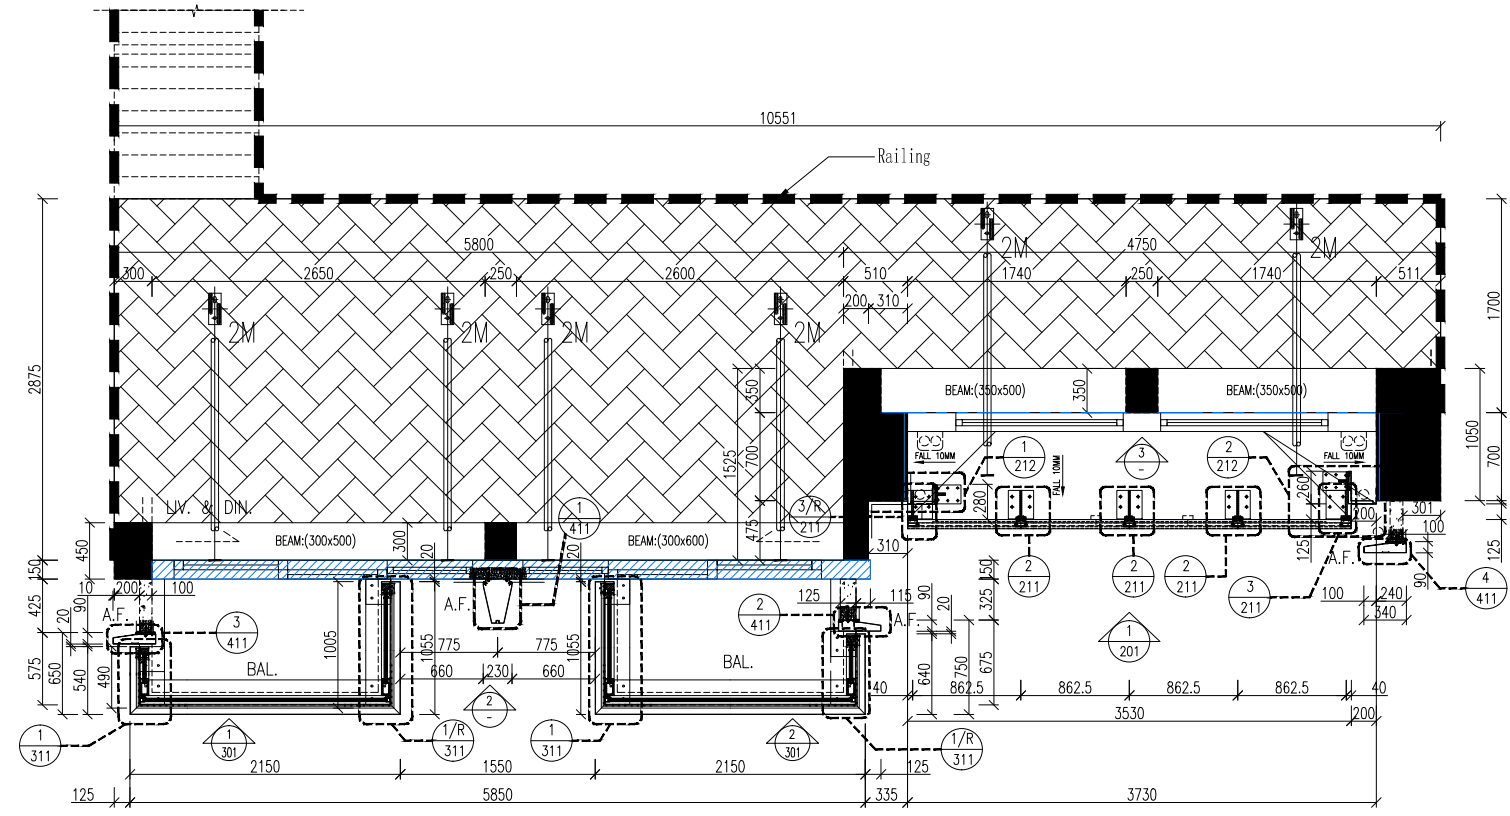

1 LAYOUT PLAN OF PRECAST FACADE

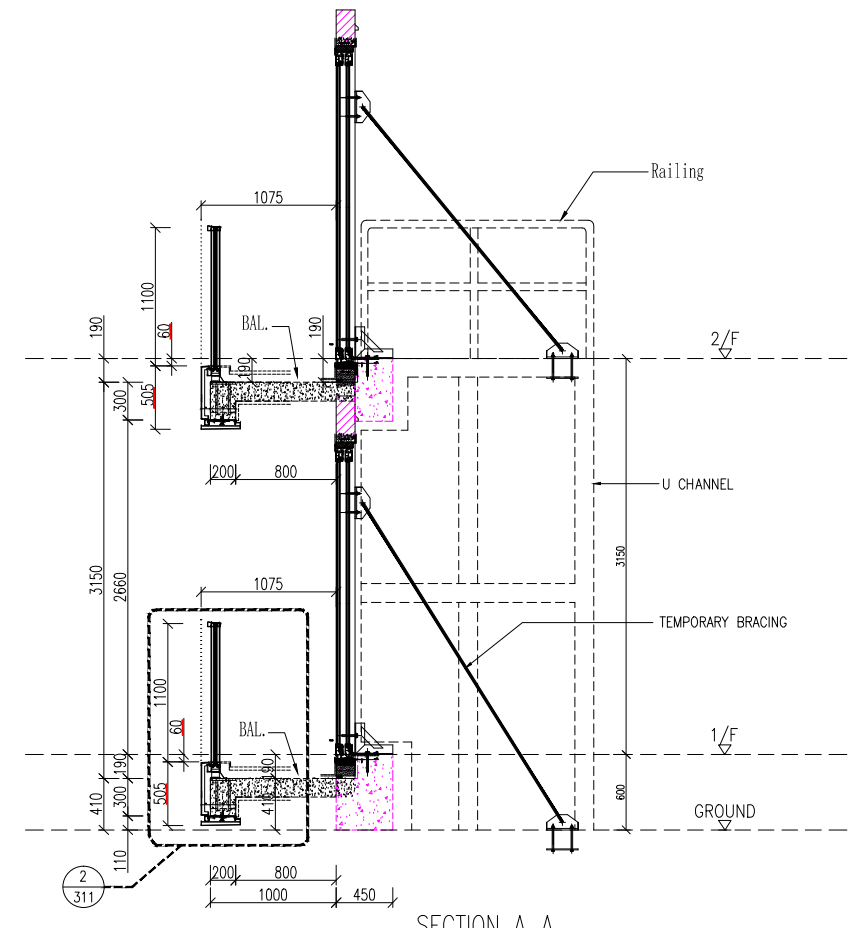


SECTION A-A

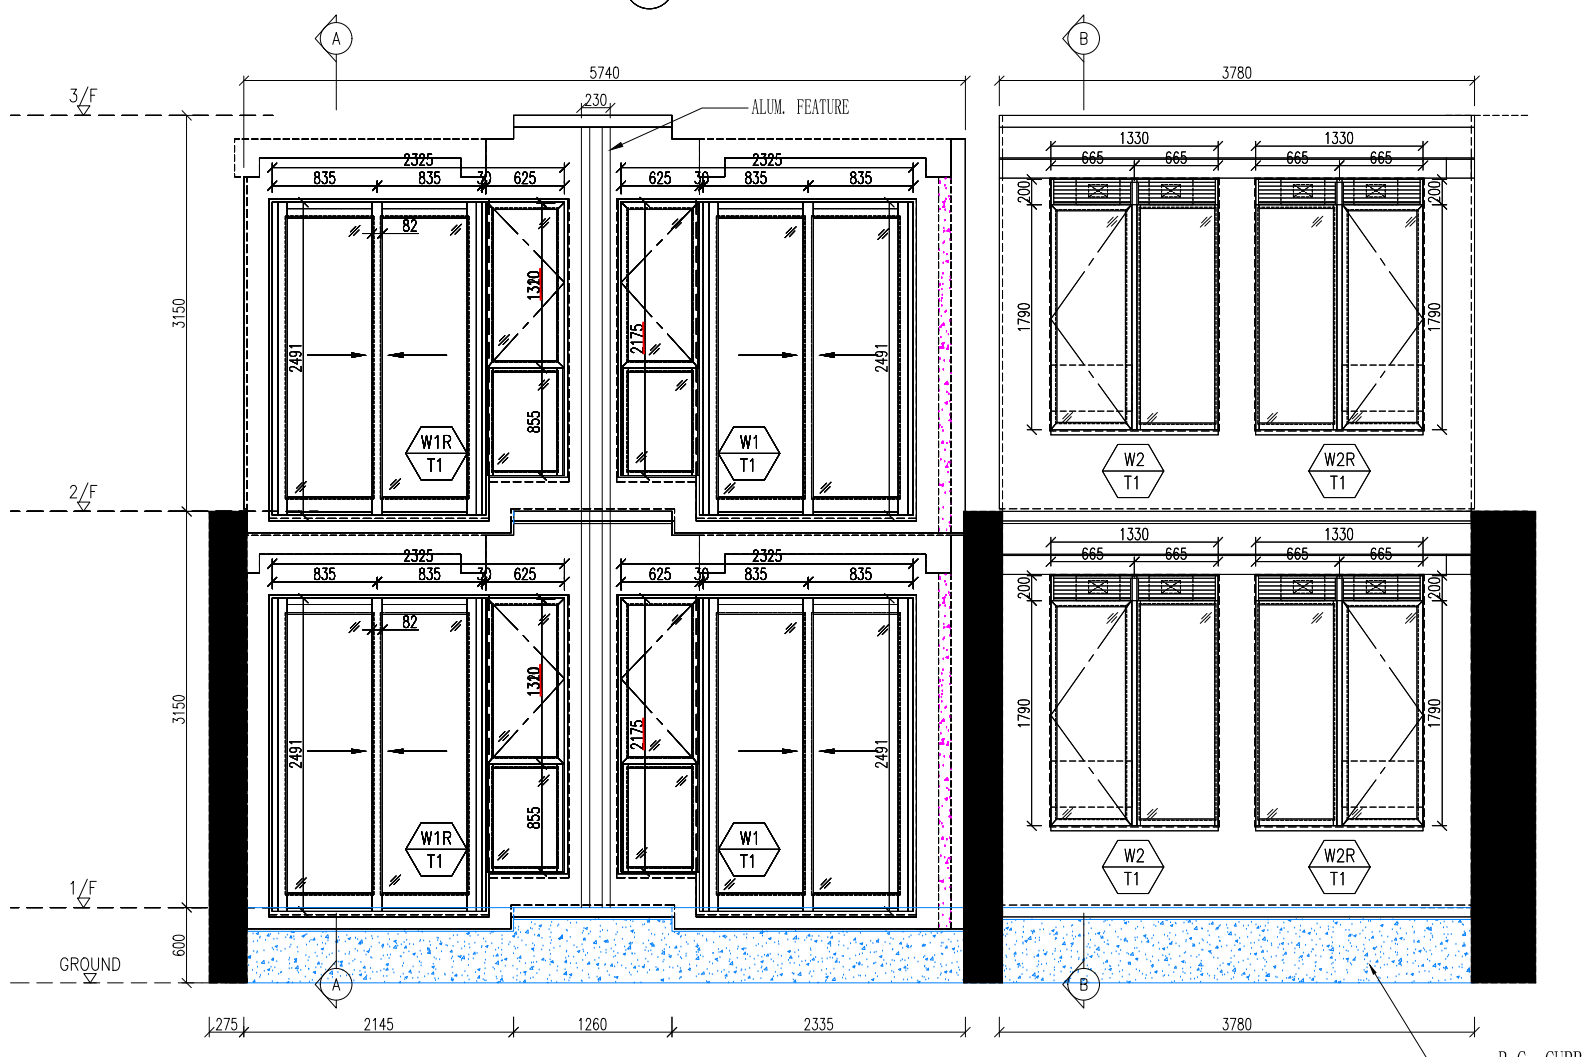

2 ELEVATION OF PRECAST FACADE

3 ELEVATION OF PRECAST FACADE

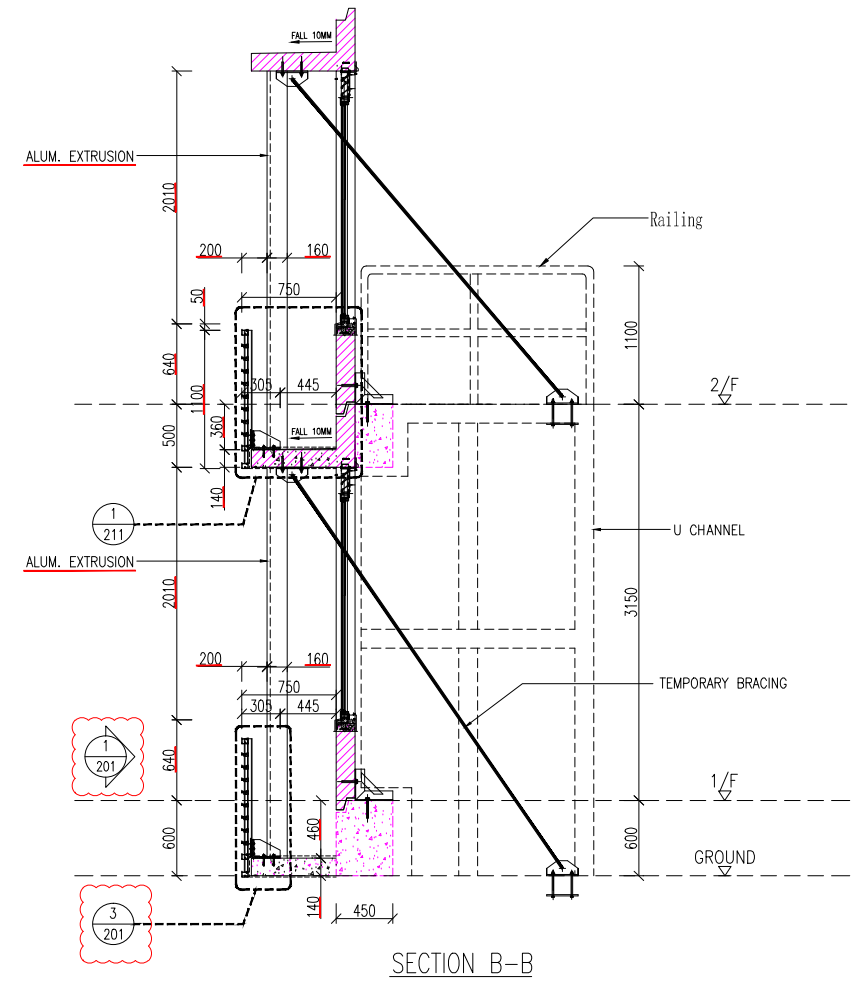

SECTION B-B

B.D. REF :
 F.S.D. REF :
 Note :
 1. All dimensions are in mm.
 2. All elevations are viewed from outside.
 3. All dimensions to be verified on site before fabrication.

GENERAL NOTES

Legend :
 1. F.F.L.-- Finished Floor Level
 2. S.F.L.-- Structural Floor Level
 3. (R) -- Reversed Detail

X1 -- DETAIL MARK NO.
 X001 -- REFER SHEET NO.

NO.	DATE	REVISED	BY
B	2019.11.29	General Revision	
A	2019.11.19	General Revision	

CLIENT :
佳明集團控股有限公司
 GRAND MING GROUP HOLDINGS LIMITED

ARCHITECT :
WONG TUNG & PARTNERS LIMITED
 ARCHITECTS & PLANNERS

STRUCTURAL ENGINEER :
C M WONG & ASSOCIATES LTD



MAIN CONTRACTOR :
 GRAND TECH CONSTRUCTION CO. LTD.

美特鋁質有限公司
MIDI ALUMINIUM FABRICATOR LTD.
 Units 6-8, Sunray Industrial Centre, 1/F
 610 Cha Kwo Ling Road, Kowloon
 Tel:23489211-4 Fax:(852)27727666

PROJECT :
 RESIDENTIAL DEVELOPMENT AT
 TSING YI TOWN LOT 190 SAI SHAN ROAD

TITLE :
 MOCK UP - LAYOUT PLAN,
 ELEVATION AND SECTION
 FOR PRECAST FACADE


JOB NO. :	J-851
DRAWN BY :	C.H.P.
DATE :	31-10-2019
CHKD BY :	
SCALE :	A1: A3: 1:60
DWG. NO. :	J851-MU-010
REV. :	B

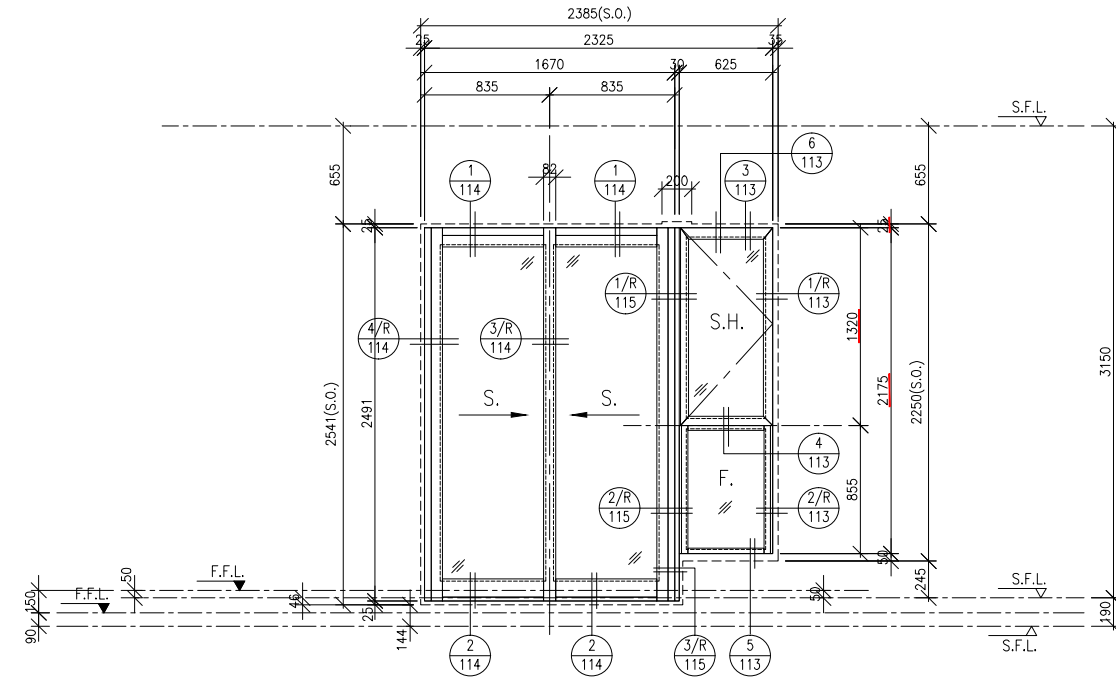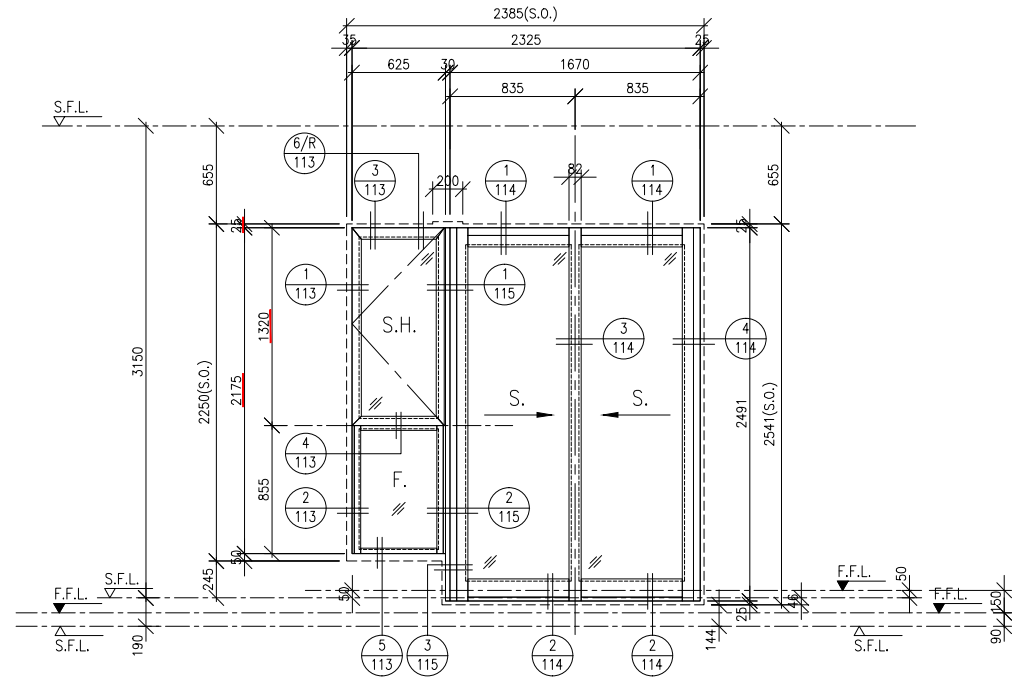

TYPE W1
T1 2 nos.

GLAZING GLO2 FRAME AL11


REMARK

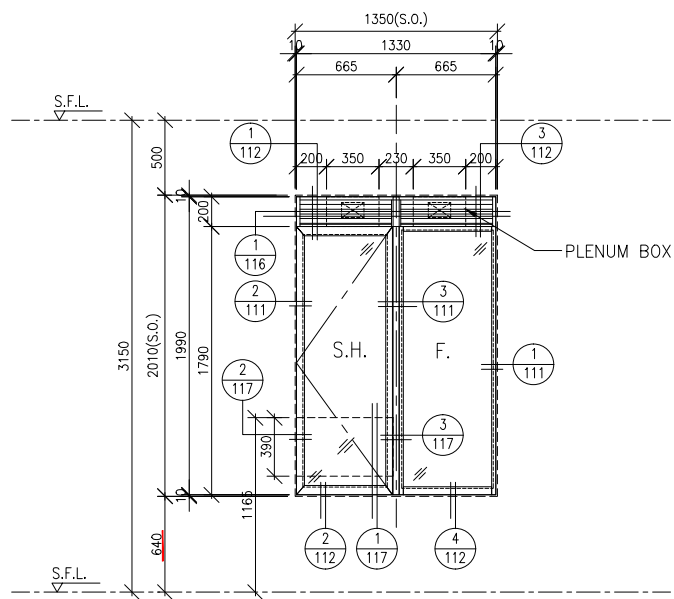

TYPE W2
T1 2 nos.

GLAZING GLO2 FRAME AL11

REMARK

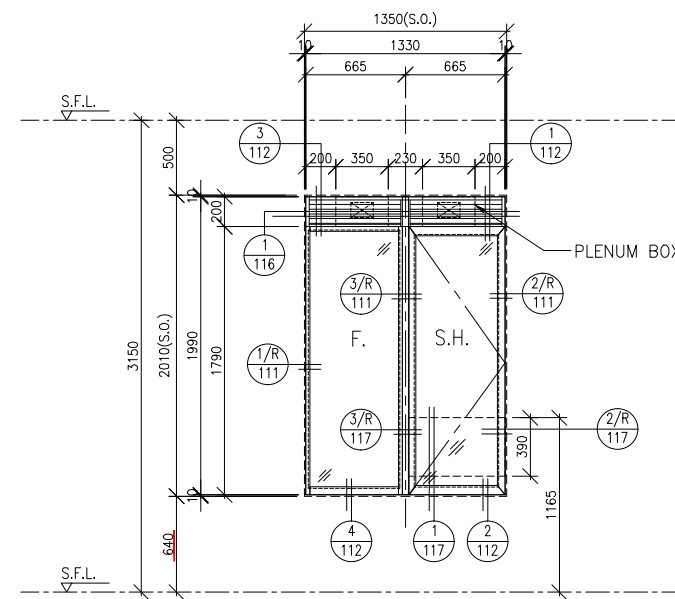

TYPE W2R
T1 2 nos.

GLAZING GLO2 FRAME AL11

REMARK

B.D. REF :
F.S.D. REF :
Note :
1. All dimensions are in mm.
2. All elevations are viewed from outside.
3. All dimensions to be verified on site before fabrication.

GENERAL NOTES
Legend :
1. F.F.L. -- Finished Floor Level
2. S.F.L. -- Structural Floor Level
3. (R) -- Reversed Detail

X1 -- DETAIL MARK NO.
X001 -- REFER SHEET NO.

B	2019.11.29	General Revision	
A	2019.11.19	General Revision	
NO.	DATE	REVISED	BY

CLIENT :
佳明集團控股有限公司
GRAND MING GROUP HOLDINGS LIMITED

ARCHITECT :
WONG TUNG & PARTNERS LIMITED
ARCHITECTS & PLANNERS

STRUCTURAL ENGINEER :
C M WONG & ASSOCIATES LTD


MAIN CONTRACTOR :
GRAND TECH CONSTRUCTION CO. LTD.

美特鋁質有限公司
MIDI ALUMINIUM FABRICATOR LTD.
Units 6-8, Sunray Industrial Centre, 1/F
610 Cha Kwo Ling Road, Kowloon
Tel: 23489211-4 Fax: (852) 27727666


PROJECT :
RESIDENTIAL DEVELOPMENT AT
TSING YI TOWN LOT 190 SAI SHAN ROAD

TITLE :
MOCK UP - WINDOW SCHEDULE
FOR PRECAST FACADE IN-SITU


JOB NO. :	J-851
DRAWN BY :	C.H.P.
DATE :	31-10-2019
CHKD BY :	SCALE A1: 1:30 A3: 1:30
DWG. NO. :	J851-MU-101
REV. :	B

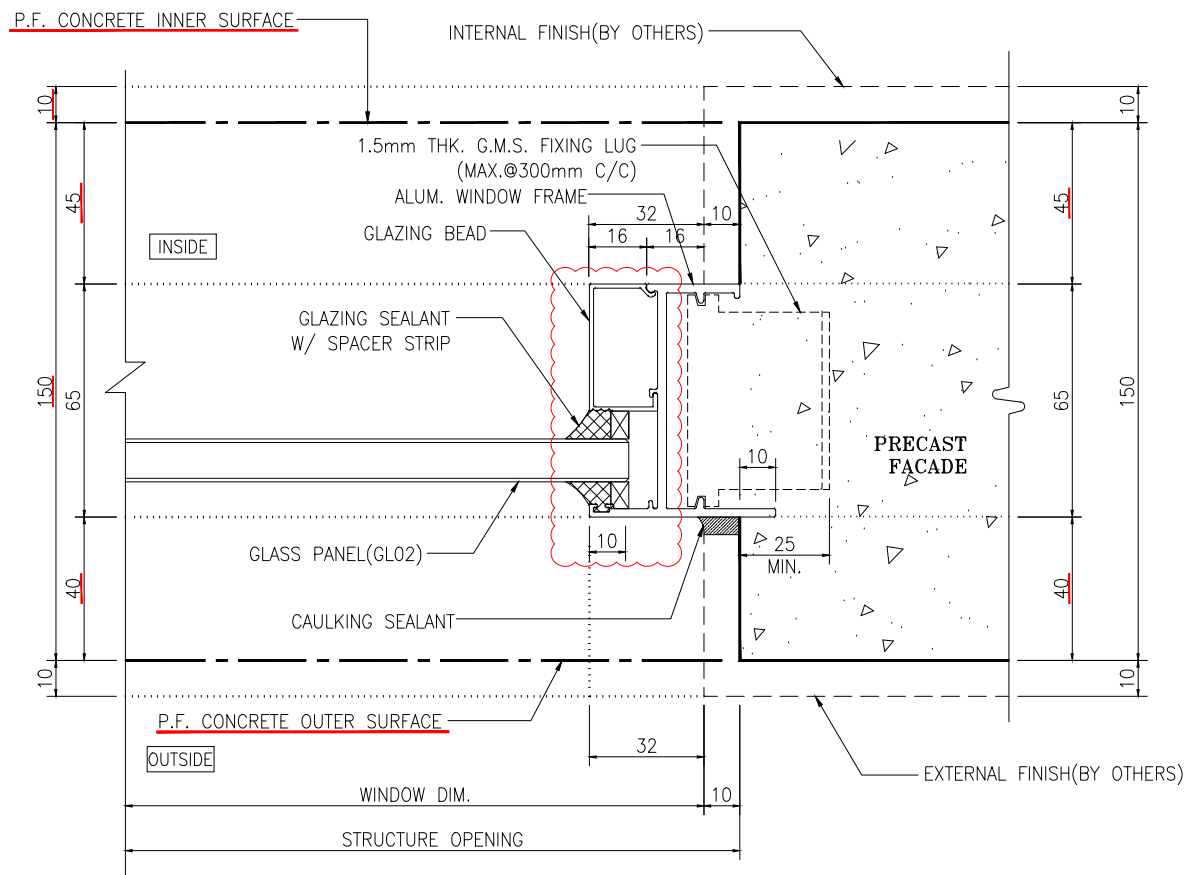

1 HORIZONTAL DETAIL
111 Fixed Window

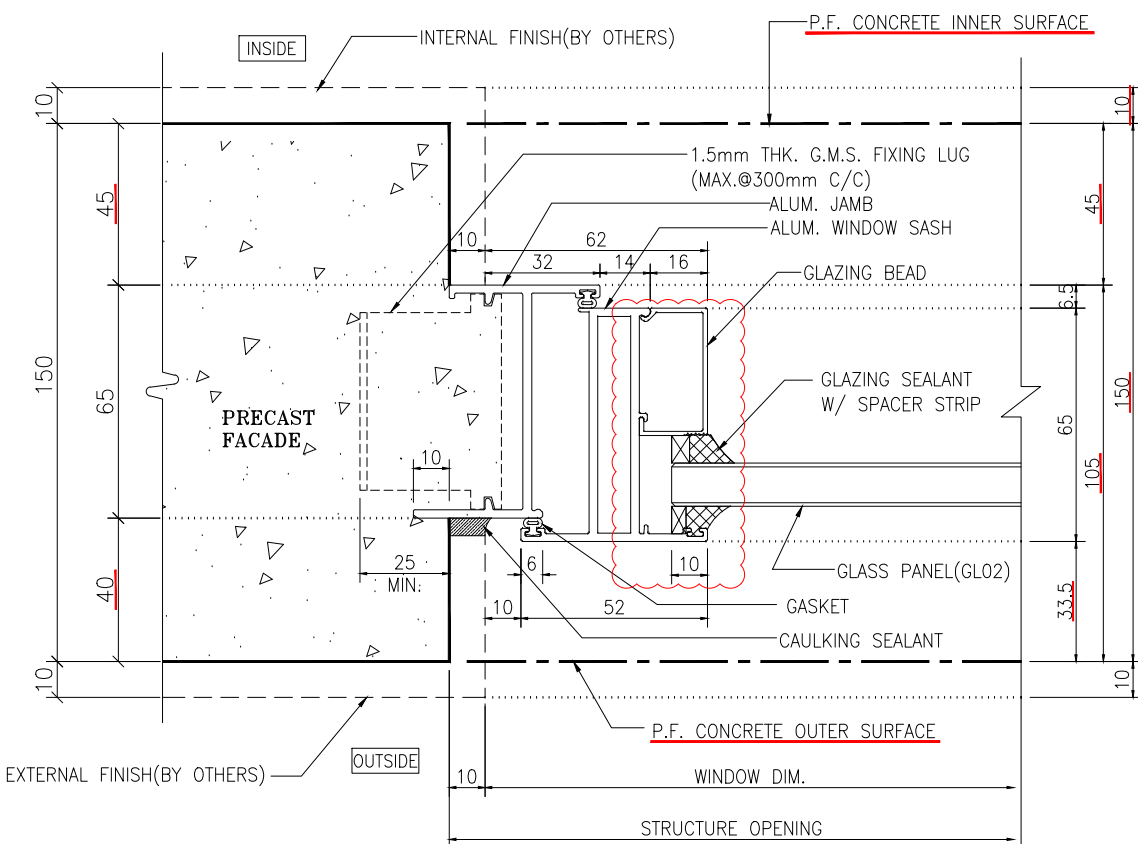

2 HORIZONTAL DETAIL
111 Operable Window

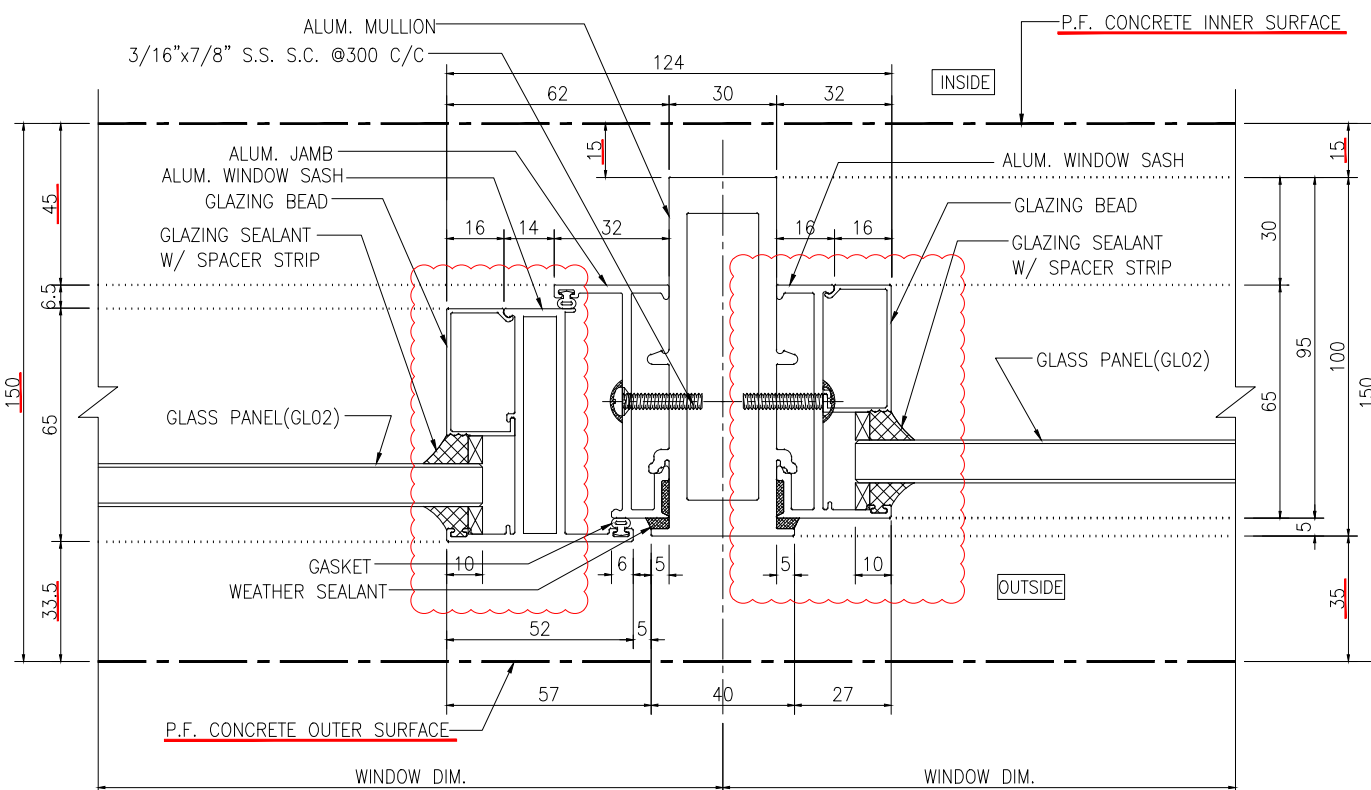

3 HORIZONTAL DETAIL
111 Mullion Of Fixed Window
And Operable Window

B.D. REF :
F.S.D. REF :
Note :
1.All dimensions are in mm.
2.All elevations are viewed from outside.
3.All dimensions to be verified on site before fabrication.

GENERAL NOTES

Legend :
1. F.F.L-- Finished Floor Level
2. S.F.L-- Structural Floor Level
3. (R) -- Reversed Detail

X1 -- DETAIL MARK NO.
X001 -- REFER SHEET NO.

NO.	DATE	REVISED	BY
B	2019.11.29	General Revision	
A	2019.11.19	General Revision	

CLIENT :
佳明集團控股有限公司
GRAND MING GROUP HOLDINGS LIMITED

ARCHITECT :
WONG TUNG & PARTNERS LIMITED
ARCHITECTS & PLANNERS
WT

STRUCTURAL ENGINEER :
C M WONG & ASSOCIATES LTD

MAIN CONTRACTOR :
GRAND TECH CONSTRUCTION CO. LTD.

美特鋁質有限公司
MIDI ALUMINIUM FABRICATOR LTD.
Units 6-8, Sunray Industrial Centre, 1/F
610 Cha Kwo Ling Road, Kowloon
Tel:23489211-4 Fax:(852)2772666

PROJECT :
RESIDENTIAL DEVELOPMENT AT
TSING YI TOWN LOT 190 SAI SHAN ROAD

TITLE :
MOCK UP - TYPICAL DETAIL FOR
ALUM. WINDOW

JOB NO. :	J-851
DRAWN BY :	C.H.P.
DATE :	31-10-2019
CHKD BY :	SCALE A1: A3: 1:2
DWG. NO. :	J851-MU-111
REV. :	B

B.D. REF :
 F.S.D. REF :
 Note :
 1. All dimensions are in mm.
 2. All elevations are viewed from outside.
 3. All dimensions to be verified on site before fabrication.

GENERAL NOTES

Legend :
 1. F.F.L.-- Finished Floor Level
 2. S.F.L.-- Structural Floor Level
 3. (R) -- Reversed Detail

X1 -- DETAIL MARK NO.
 X001 -- REFER SHEET NO.

B	2019.11.29	General Revision	
A	2019.11.19	General Revision	
NO.	DATE	REVISED	BY

CLIENT :
佳明集團控股有限公司
 GRAND MING GROUP HOLDINGS LIMITED

ARCHITECT :
WONG TUNG & PARTNERS LIMITED
 ARCHITECTS & PLANNERS

STRUCTURAL ENGINEER :
C M WONG & ASSOCIATES LTD





MAIN CONTRACTOR :
GRAND TECH CONSTRUCTION CO. LTD.


美特鋁質有限公司
MIDI ALUMINIUM FABRICATOR LTD.
 Units 6-8, Sunray Industrial Centre, 1/F
 610 Cha Kwo Ling Road, Kowloon
 Tel:23489211-4 Fax:(852)2727666

PROJECT :
 RESIDENTIAL DEVELOPMENT AT
 TSING YI TOWN LOT 190 SAI SHAN ROAD


TITLE :
 MOCK UP - TYPICAL DETAIL FOR
 SLIDING DOOR

JOB NO. :	J-851
DRAWN BY :	C.H.P.
DATE :	31-10-2019
CHKD BY :	SCALE A1: A3: 1:3
DWG. NO. :	J851-MU-114
REV. :	B

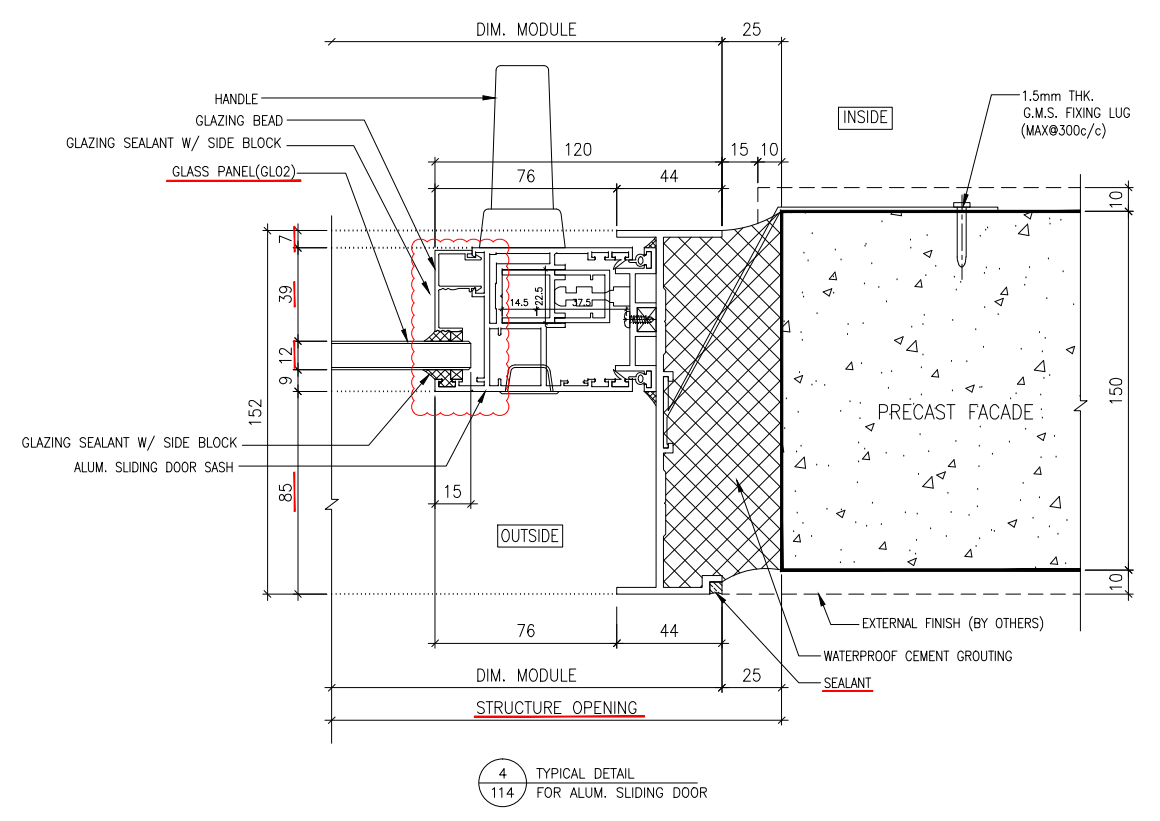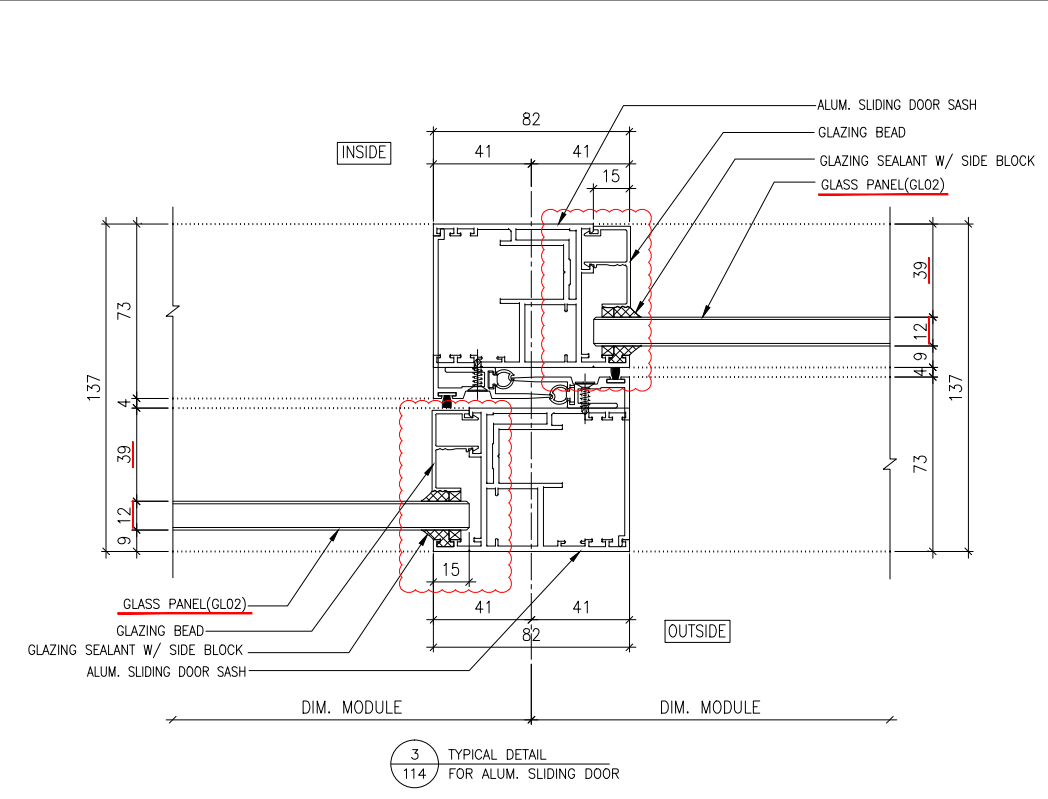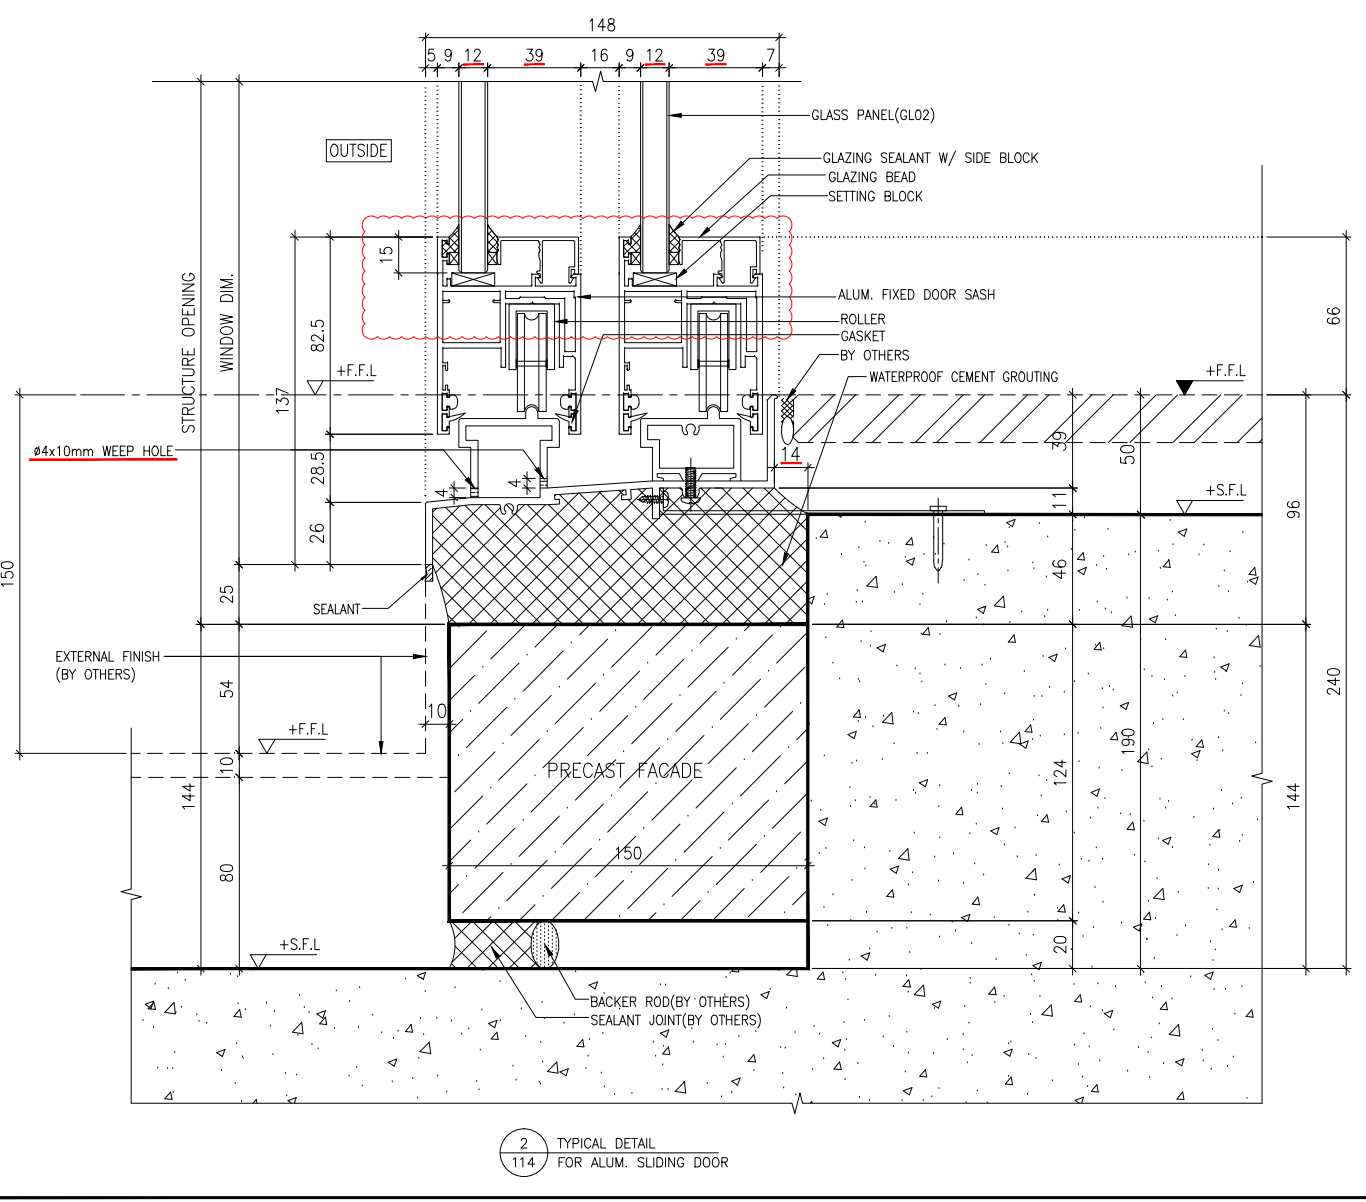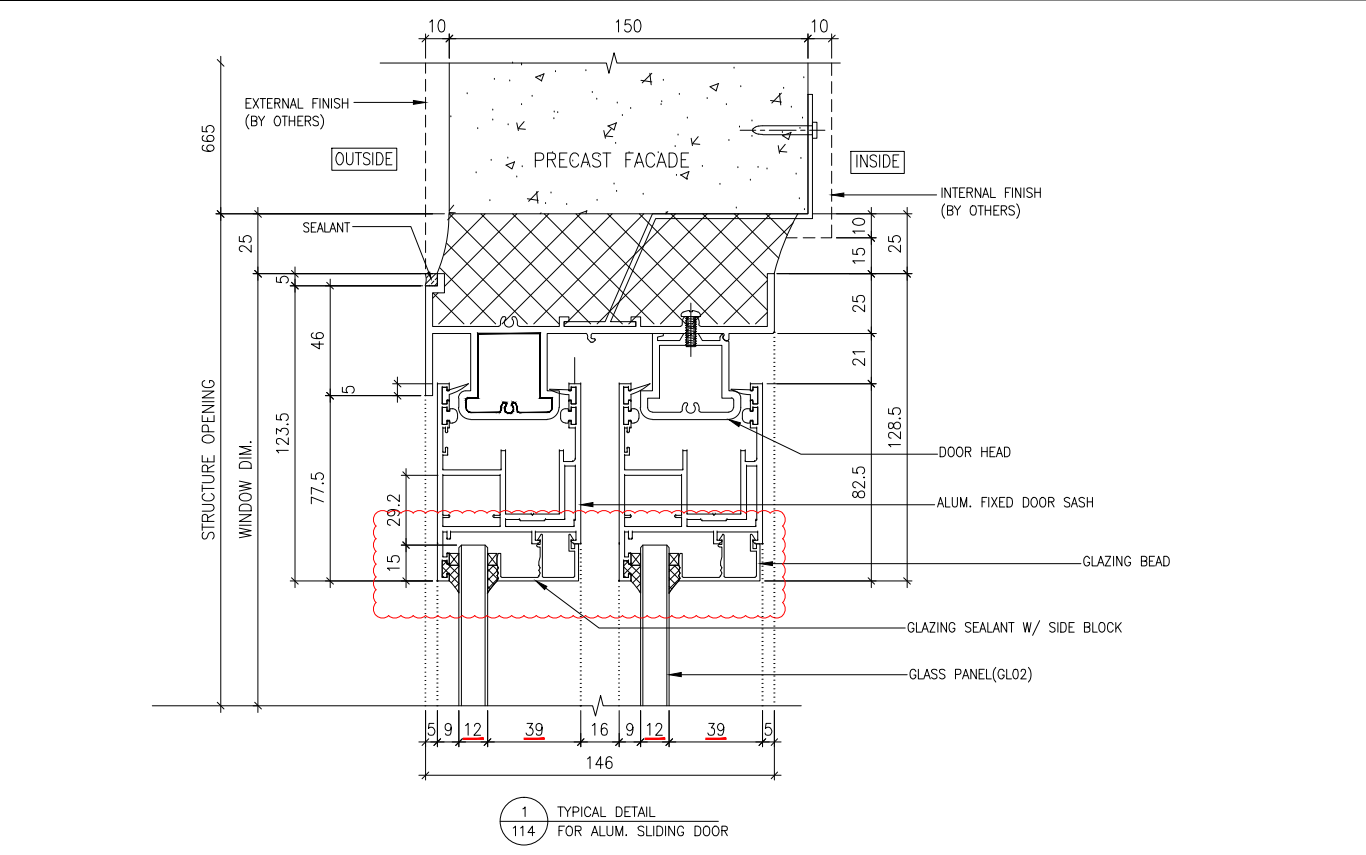


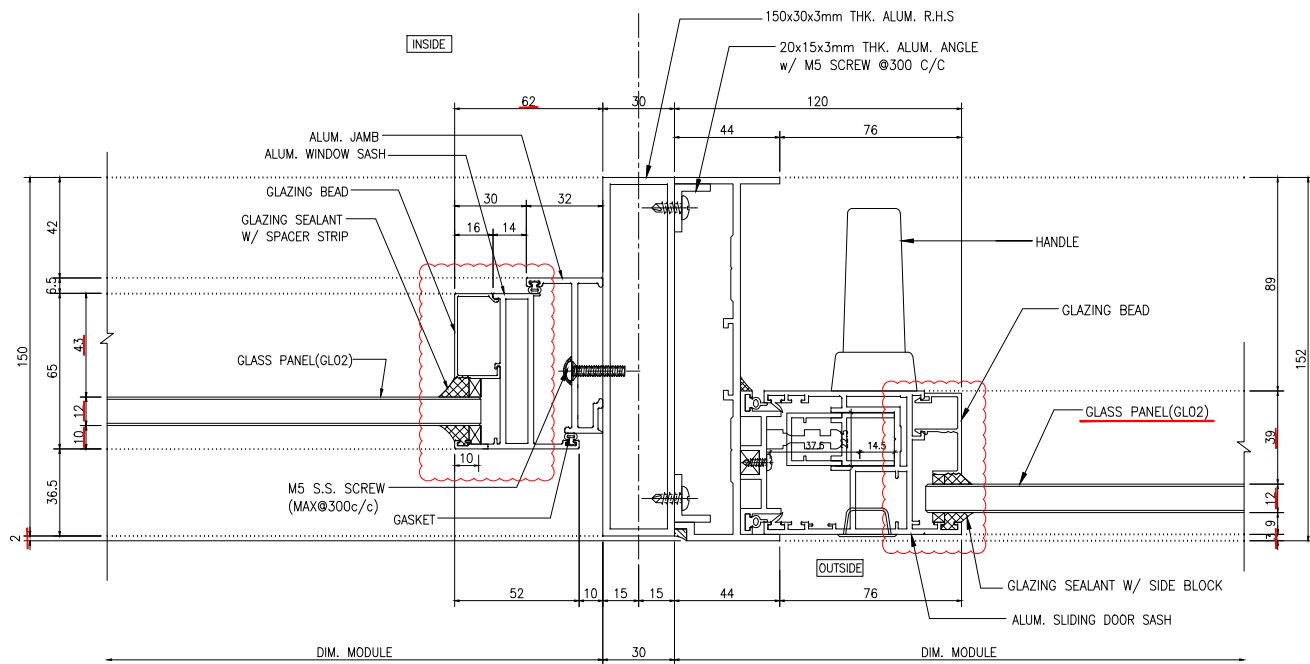

1 TYPICAL DETAIL
115 FOR ALUM. SLIDING DOOR
AND OPENABLE WINDOW

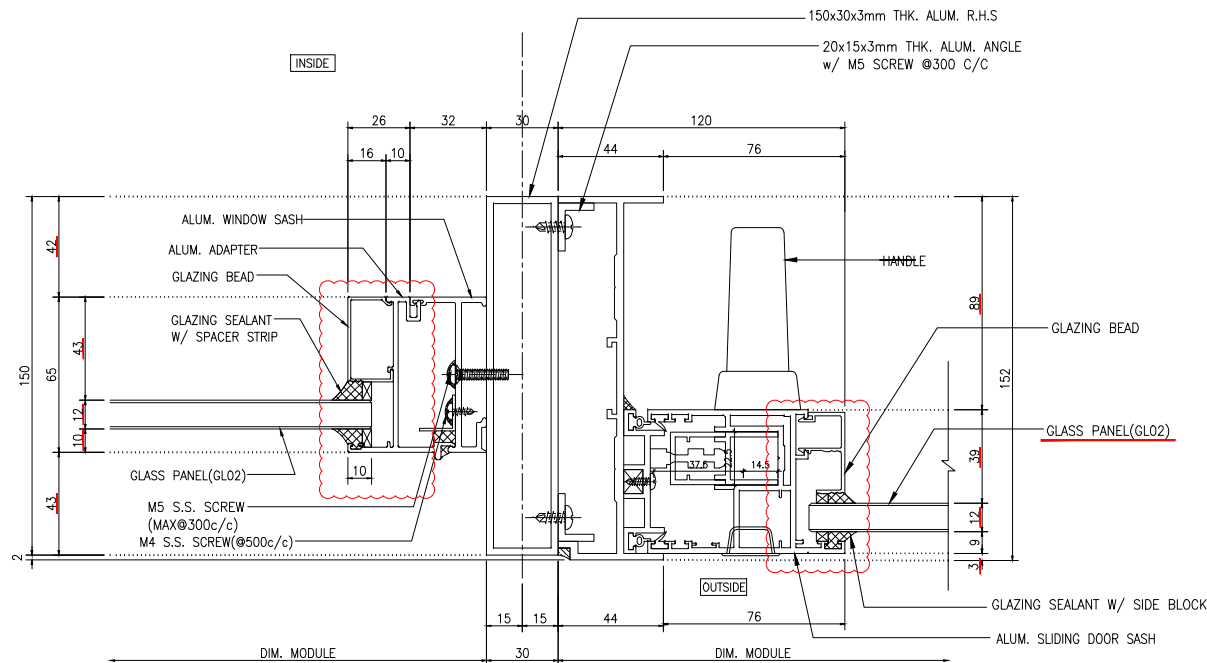

2 TYPICAL DETAIL
115 FOR ALUM. SLIDING DOOR
AND FIXED WINDOW

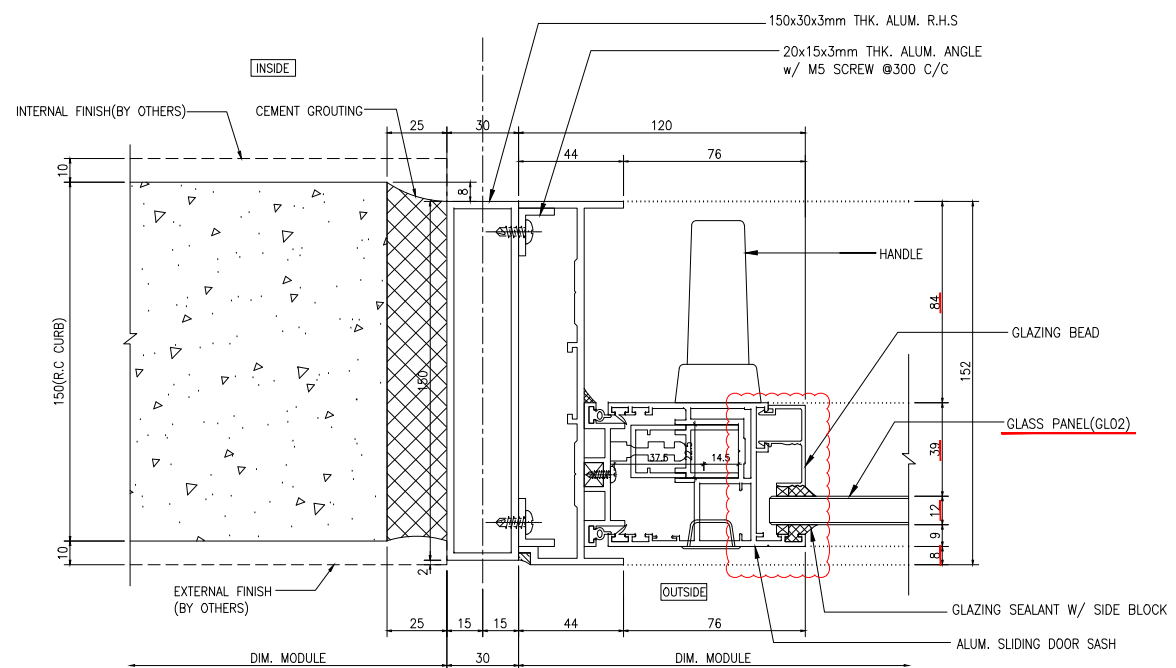

3 TYPICAL DETAIL
115 FOR ALUM. SLIDING DOOR

B.D. REF :
F.S.D. REF :
Note :
1. All dimensions are in mm.
2. All elevations are viewed from outside.
3. All dimensions to be verified on site before fabrication.

GENERAL NOTES

Legend :

1. F.F.L-- Finished Floor Level
2. S.F.L-- Structural Floor Level
3. (R) -- Reversed Detail

X1 -- DETAIL MARK NO.
X001 -- REFER SHEET NO.

NO.	DATE	REVISED	BY
B	2019.11.29	General Revision	
A	2019.11.19	General Revision	

CLIENT :
佳明集團控股有限公司
GRAND MING GROUP HOLDINGS LIMITED

ARCHITECT :
WONG TUNG & PARTNERS LIMITED
ARCHITECTS & PLANNERS

STRUCTURAL ENGINEER :

C M WONG & ASSOCIATES LTD


MAIN CONTRACTOR :
GRAND TECH CONSTRUCTION CO. LTD.

MIDI ALUMINIUM FABRICATOR LTD.
Units 6-8, Sunray Industrial Centre, 1/F
610 Cha Kwo Ling Road, Kowloon
Tel:23489211-4 Fax:(852)27727666

PROJECT :
RESIDENTIAL DEVELOPMENT AT
TSING YI TOWN LOT 190 SAI SHAN ROAD

TITLE :
MOCK UP - TYPICAL DETAIL FOR
SLIDING DOOR

JOB NO. : J-851
DRAWN BY : C.H.P. DATE : 31-10-2019
CHKD BY : SCALE A1: A3: 1:3
DWG. NO. : J851-MU-115 REV. : B

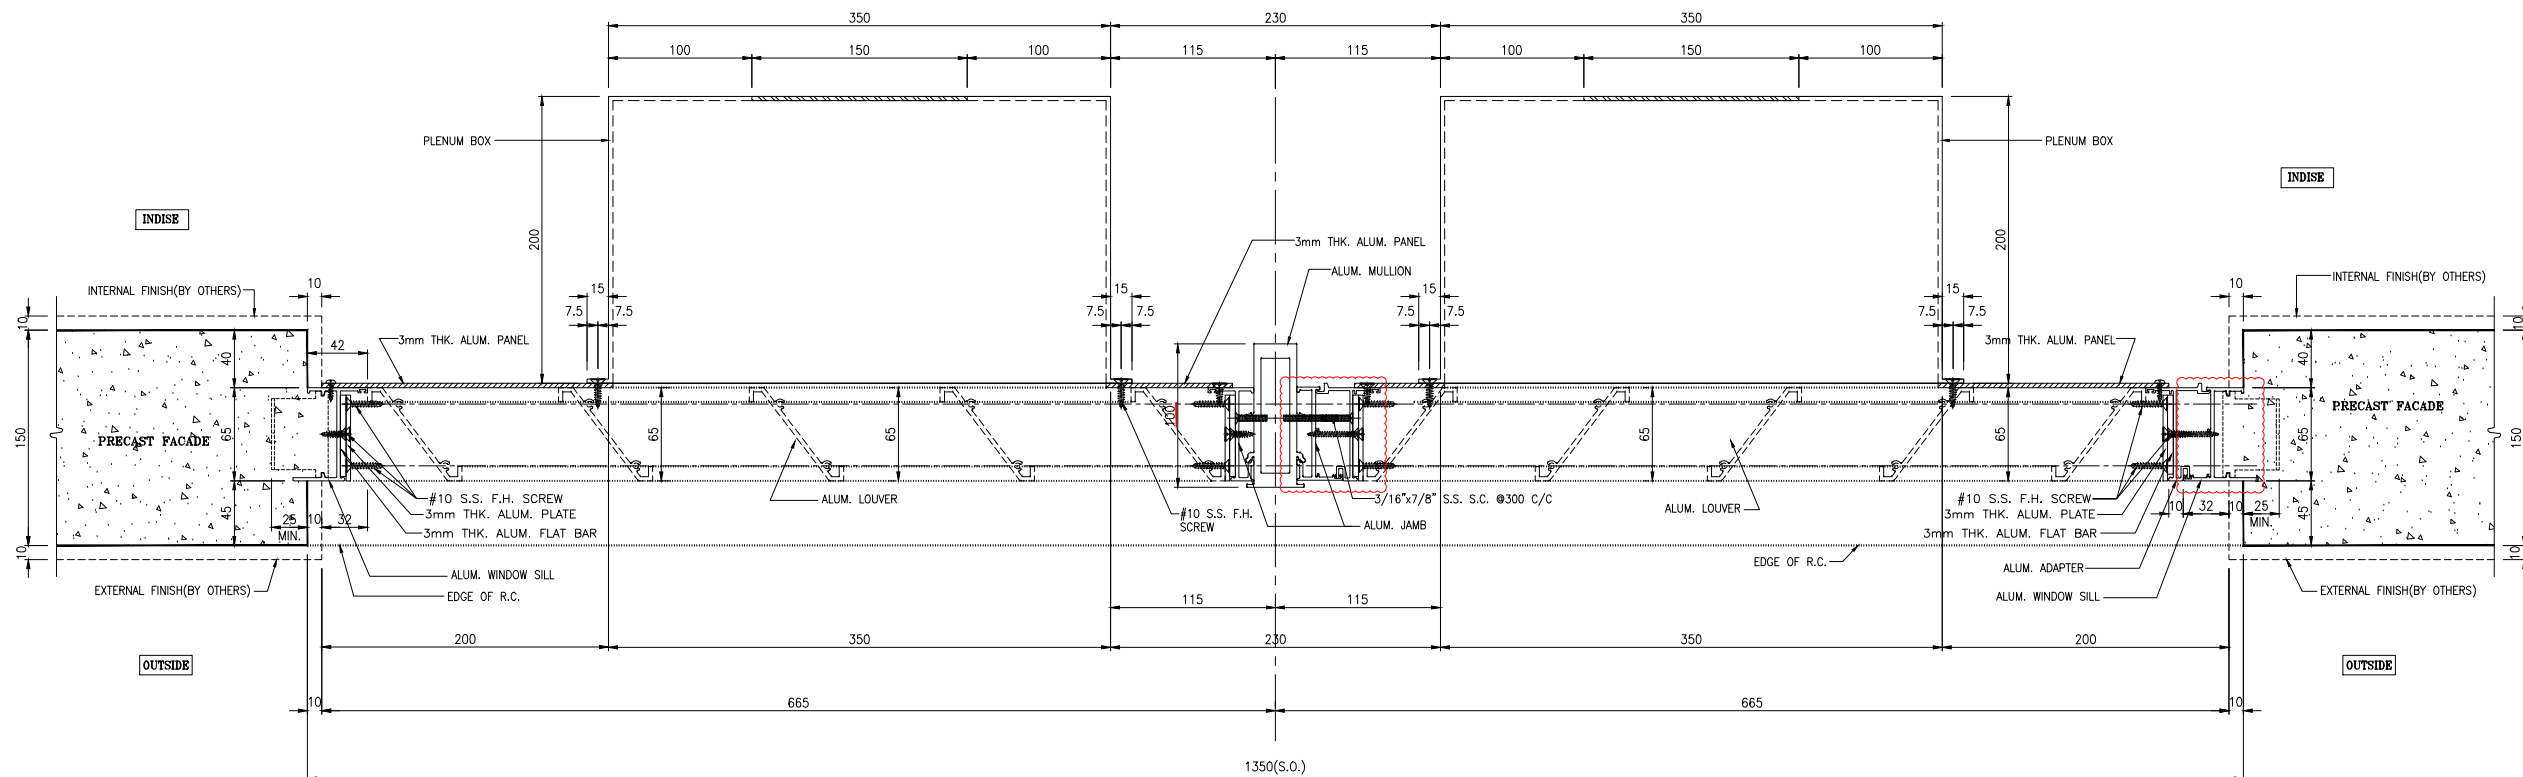


1 TYPICAL DETAIL
116 FOR ALUM. LOUVER

B.D. REF :
F.S.D. REF :
Note :
1.All dimensions are in mm.
2.All elevations are viewed from outside.
3.All dimensions to be verified on site before fabrication.

GENERAL NOTES

- Legend :
- 1. F.F.L.-- Finished Floor Level
 - 2. S.F.L.-- Structural Floor Level
 - 3. (R) -- Reversed Detail

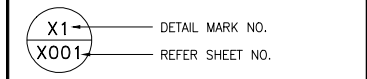

B	2019.11.29	General Revision	
A	2019.11.19	General Revision	
NO.	DATE	REVISED	BY

CLIENT :
佳明集團控股有限公司
GRAND MING GROUP HOLDINGS LIMITED

ARCHITECT :
WONG TUNG & PARTNERS LIMITED
ARCHITECTS & PLANNERS

STRUCTURAL ENGINEER :

C M WONG & ASSOCIATES LTD

MAIN CONTRACTOR :
GRAND TECH CONSTRUCTION CO. LTD.


MIDI ALUMINIUM FABRICATOR LTD.
Units 6-8, Sunray Industrial Centre, 1/F
610 Cha Kwo Ling Road, Kowloon
Tel:23489211-4 Fax:(852)27727666

PROJECT :
RESIDENTIAL DEVELOPMENT AT
TSING YI TOWN LOT 190 SAI SHAN ROAD

TITLE :
MOCK UP - TYPICAL DETAIL FOR
ALUM. LOUVER

JOB NO. :	J-851
DRAWN BY :	C.H.P.
DATE :	31-10-2019
CHKD BY :	SCALE A1: A3: 1:5
DWG. NO. :	J851-MU-116
REV. :	B

REMARKS:
- WHITE COLOR FOR TOWER 1 - 18/F ALUM. GRILLE

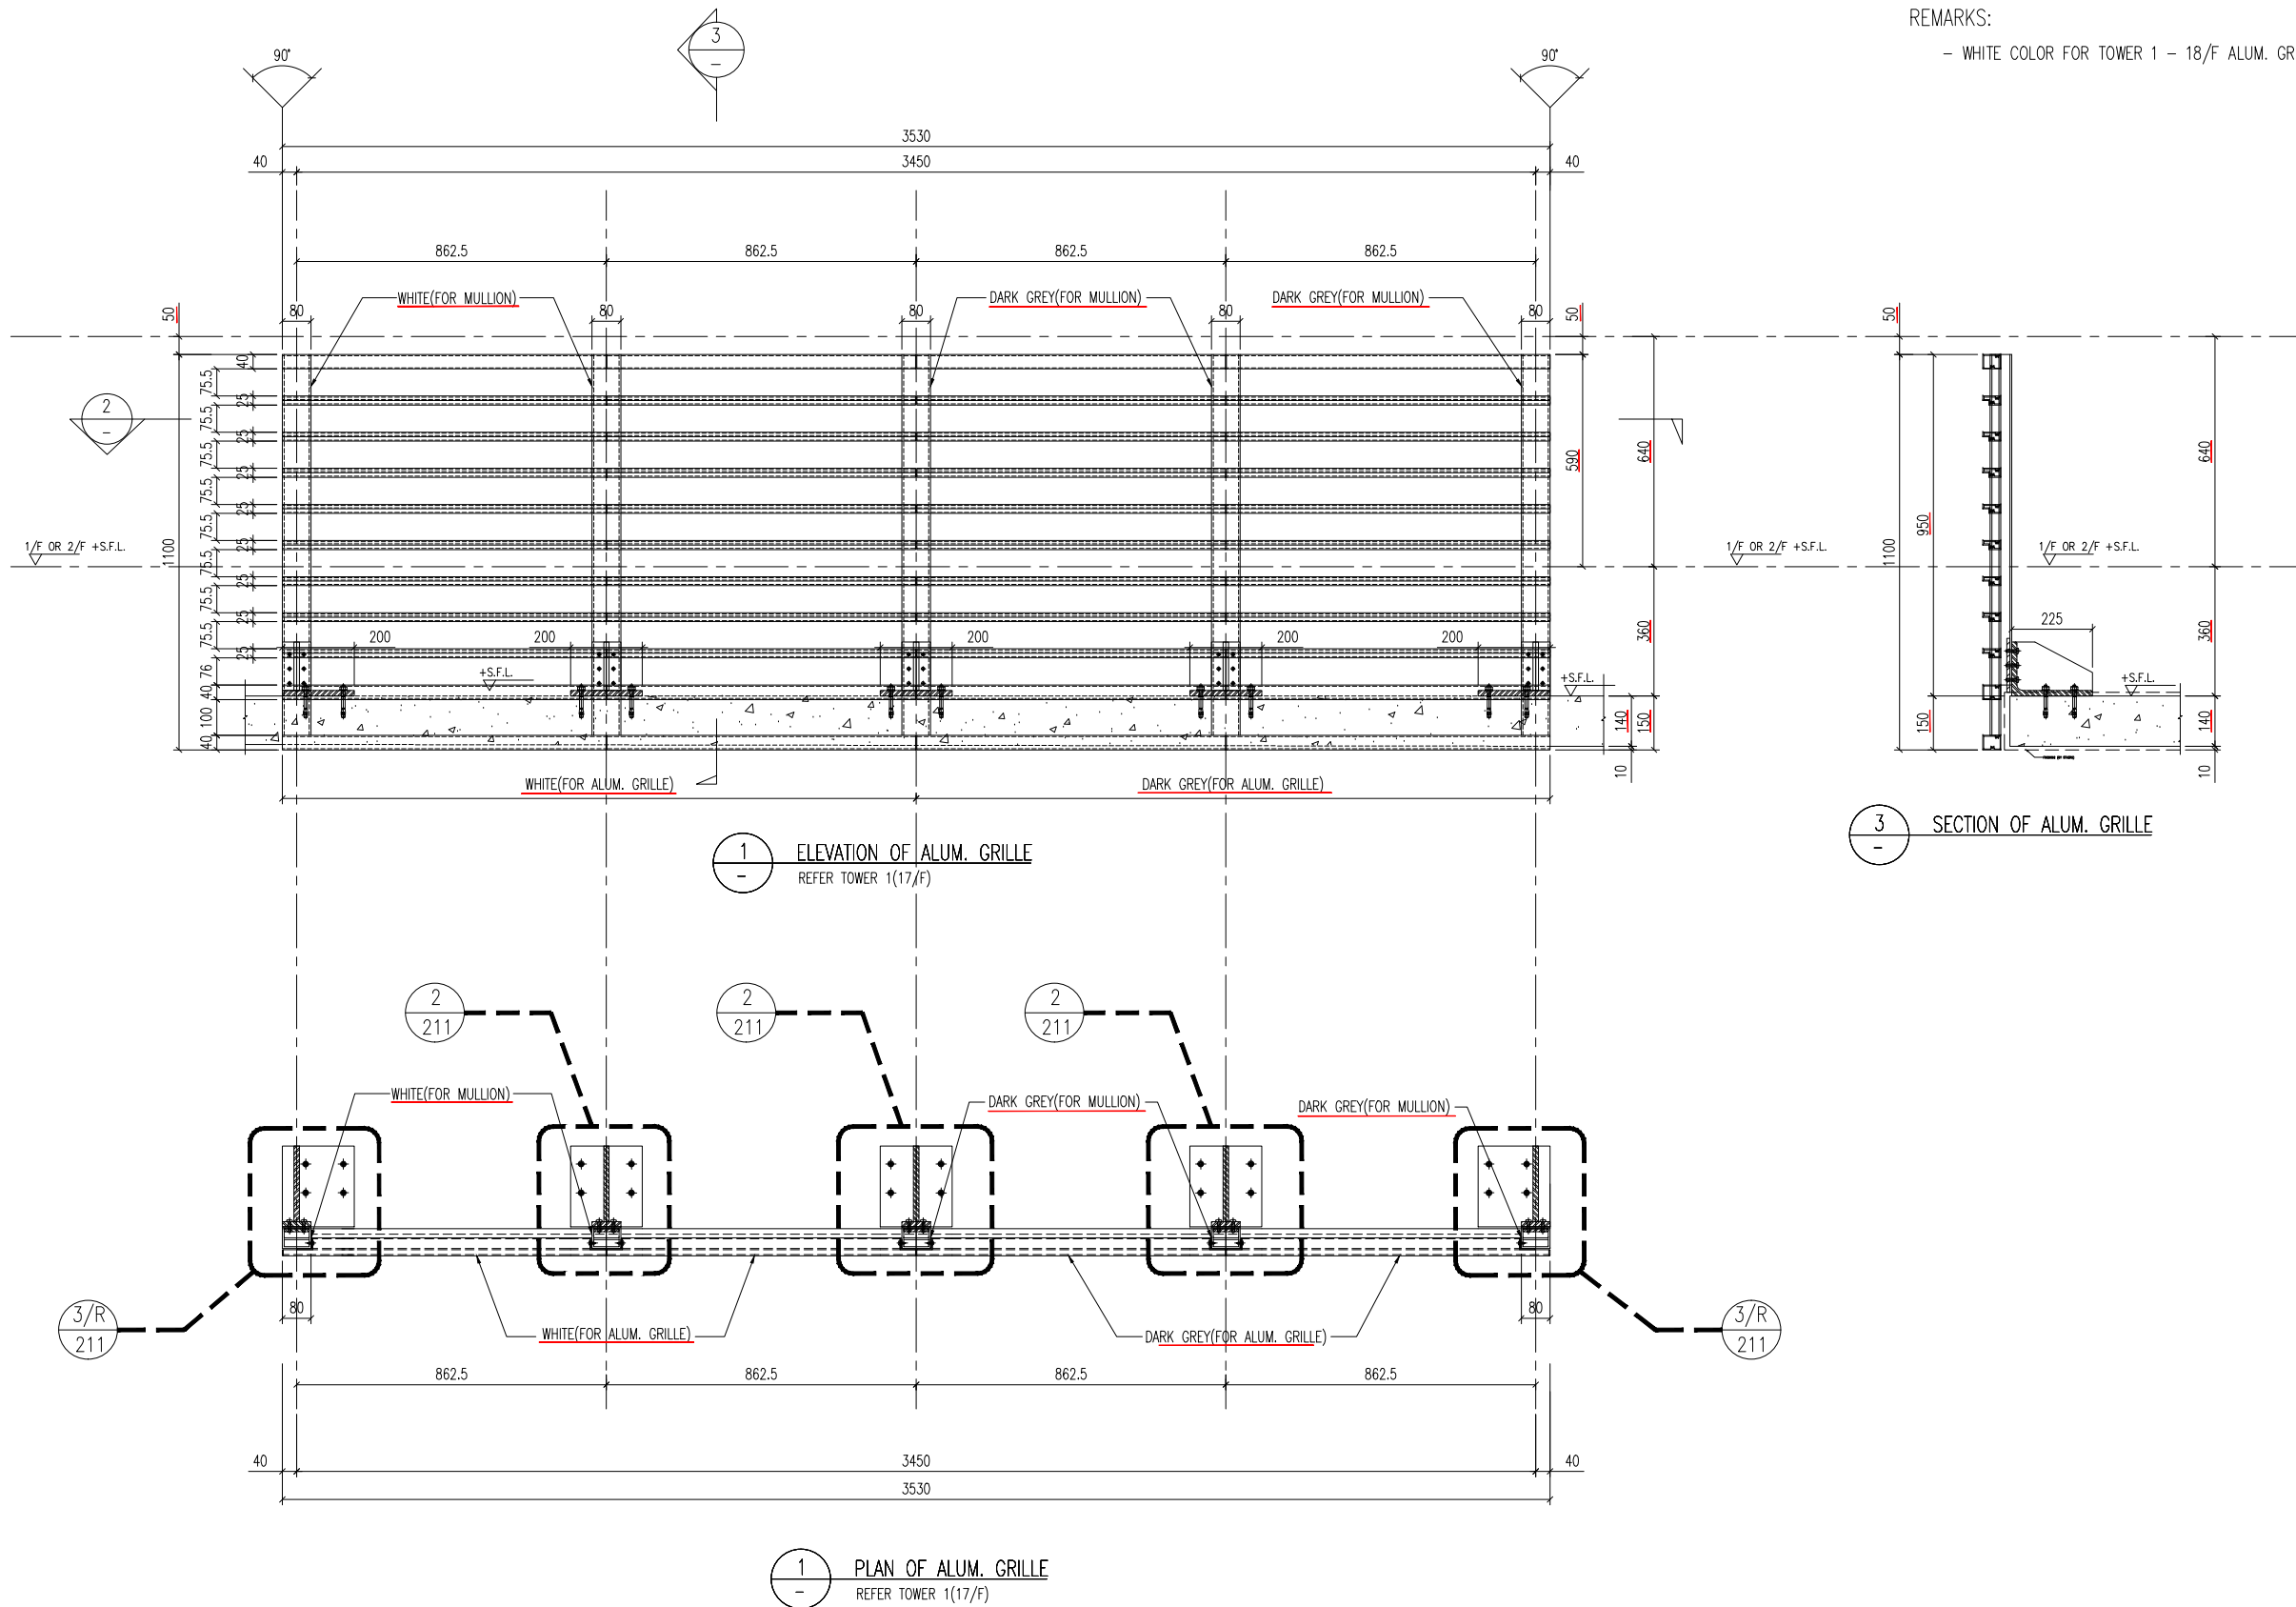

B.D. REF :
F.S.D. REF :
Note :
1. All dimensions are in mm.
2. All elevations are viewed from outside.
3. All dimensions to be verified on site before fabrication.

GENERAL NOTES
Legend :
1. F.F.L.-- Finished Floor Level
2. S.F.L.-- Structural Floor Level
3. (R) -- Reversed Detail

X1 -- DETAIL MARK NO.
X001 -- REFER SHEET NO.

NO.	DATE	REVISED	BY
B	2019.11.29	General Revision	
A	2019.11.19	General Revision	

CLIENT :
佳明集團控股有限公司
GRAND MING GROUP HOLDINGS LIMITED

ARCHITECT :
WONG TUNG & PARTNERS LIMITED
ARCHITECTS & PLANNERS
WT

STRUCTURAL ENGINEER :
C M WONG & ASSOCIATES LTD




MAIN CONTRACTOR :
GRAND TECH CONSTRUCTION CO. LTD.

美特鋁質有限公司
MIDI ALUMINIUM FABRICATOR LTD.
Units 6-8, Sunray Industrial Centre, 1/F
610 Cha Kwo Ling Road, Kowloon
Tel:23489211-4 Fax:(852)27727666

PROJECT :
RESIDENTIAL DEVELOPMENT AT
TSING YI TOWN LOT 190 SAI SHAN ROAD

TITLE :
MOCK UP - ELEVATION FOR
ALUM. GRILLE

JOB NO. :	J-851
DRAWN BY :	C.H.P.
DATE :	31-10-2019
CHKD BY :	SCALE A1: A3: 1:20
DWG. NO. :	J851-MU-201
REV. :	B

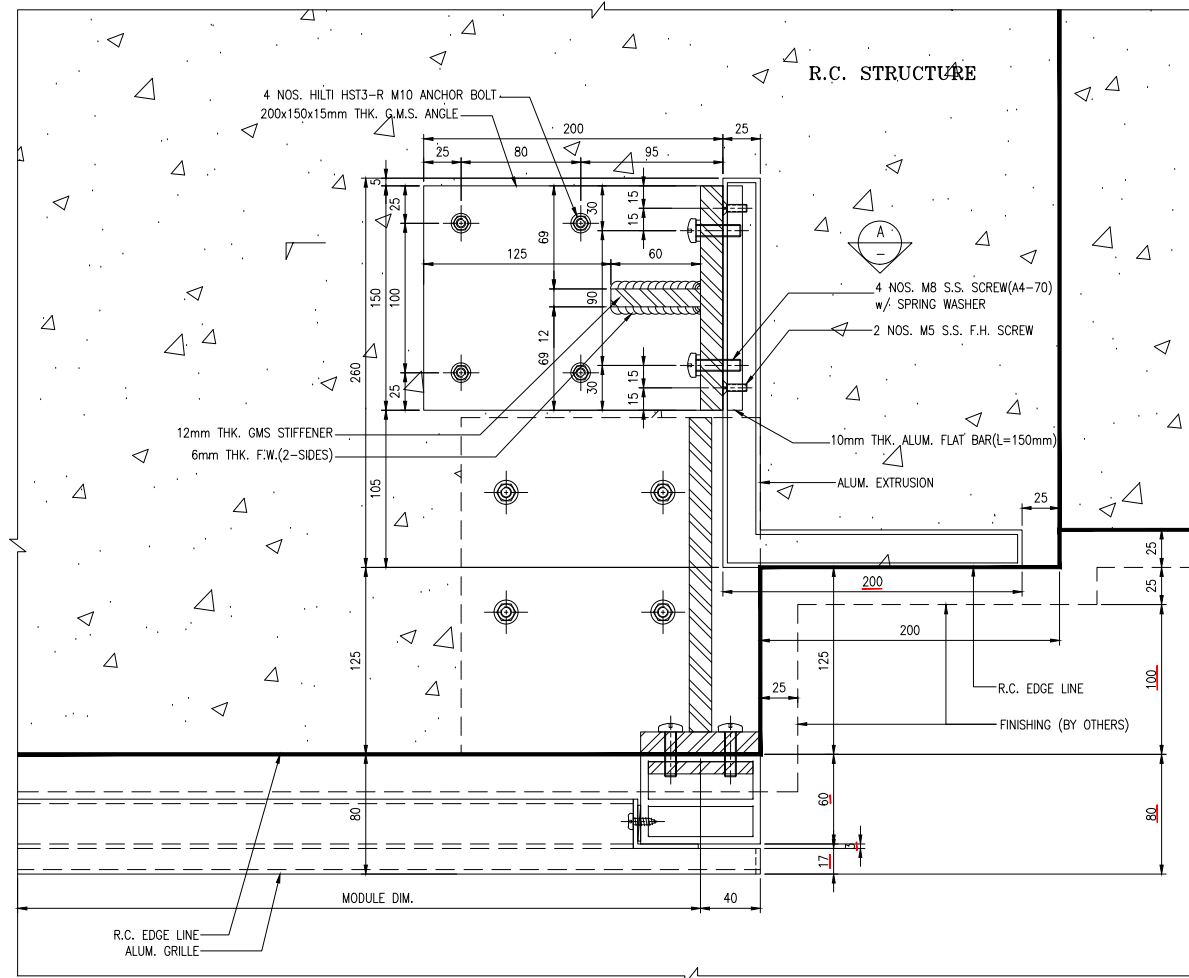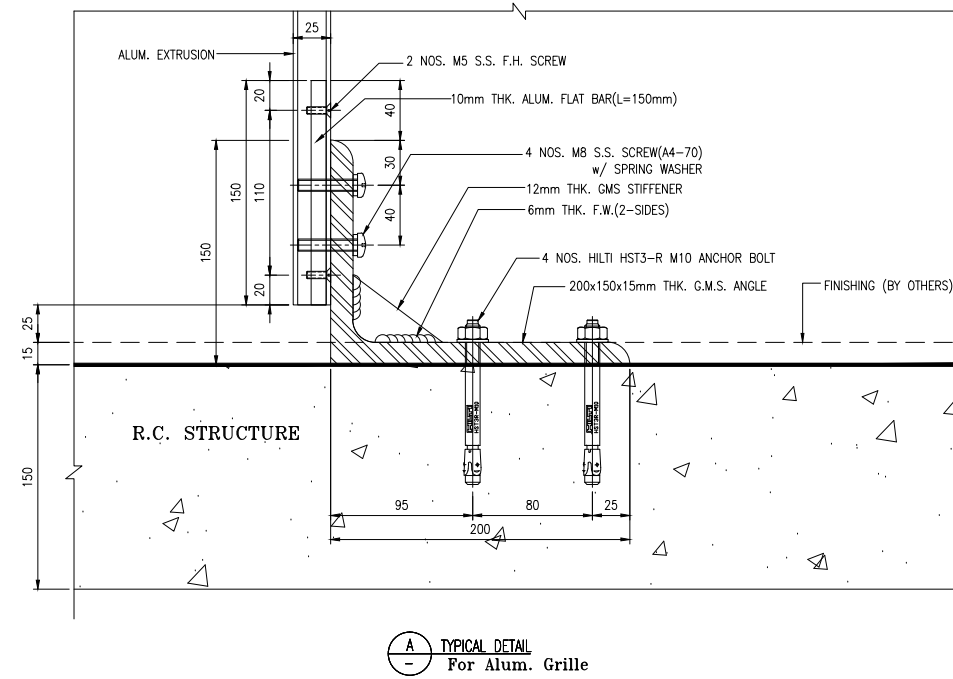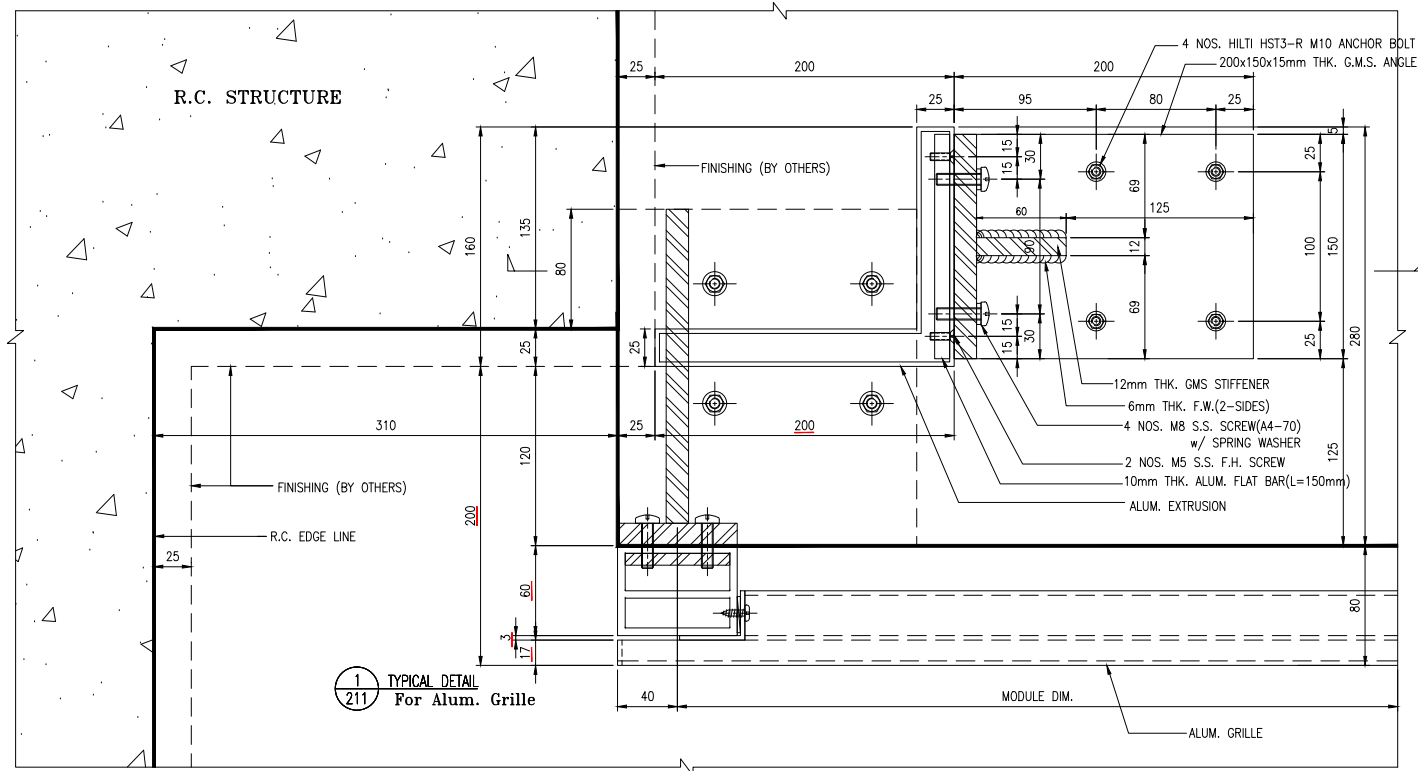

B.D. REF :
 F.S.D. REF :
 Note :
 1.All dimensions are in mm.
 2.All elevations are viewed from outside.
 3.All dimensions to be verified on site before fabrication.

GENERAL NOTES

Legend :
 1. F.F.L.-- Finished Floor Level
 2. S.F.L.-- Structural Floor Level
 3. (R) -- Reversed Detail

X1 -- DETAIL MARK NO.
 X001 -- REFER SHEET NO.

NO.	DATE	REVISION	BY
A	2019.11.29	General Revision	

CLIENT :
佳明集團控股有限公司
 GRAND MING GROUP HOLDINGS LIMITED

ARCHITECT :
WONG TUNG & PARTNERS LIMITED
 ARCHITECTS & PLANNERS

STRUCTURAL ENGINEER :
C M WONG & ASSOCIATES LTD


MAIN CONTRACTOR :
 GRAND TECH CONSTRUCTION CO. LTD.

美特鋁質有限公司
 MIDI ALUMINIUM FABRICATOR LTD.
 Units 6-8, Sunray Industrial Centre, 1/F
 610 Cha Kwo Ling Road, Kowloon
 Tel:23489211-4 Fax:(852)27727666


PROJECT :
 RESIDENTIAL DEVELOPMENT AT
 TSING YI TOWN LOT 190 SAI SHAN ROAD

TITLE :
 MOCK UP - TYPICAL DETAIL FOR
 ALUM. GRILLE


JOB NO. :	J-851
DRAWN BY :	C.H.P.
DATE :	31-10-2019
CHKD BY :	SCALE A1: A3: 1:5
DWG. NO. :	J851-MU-212
REV. :	A

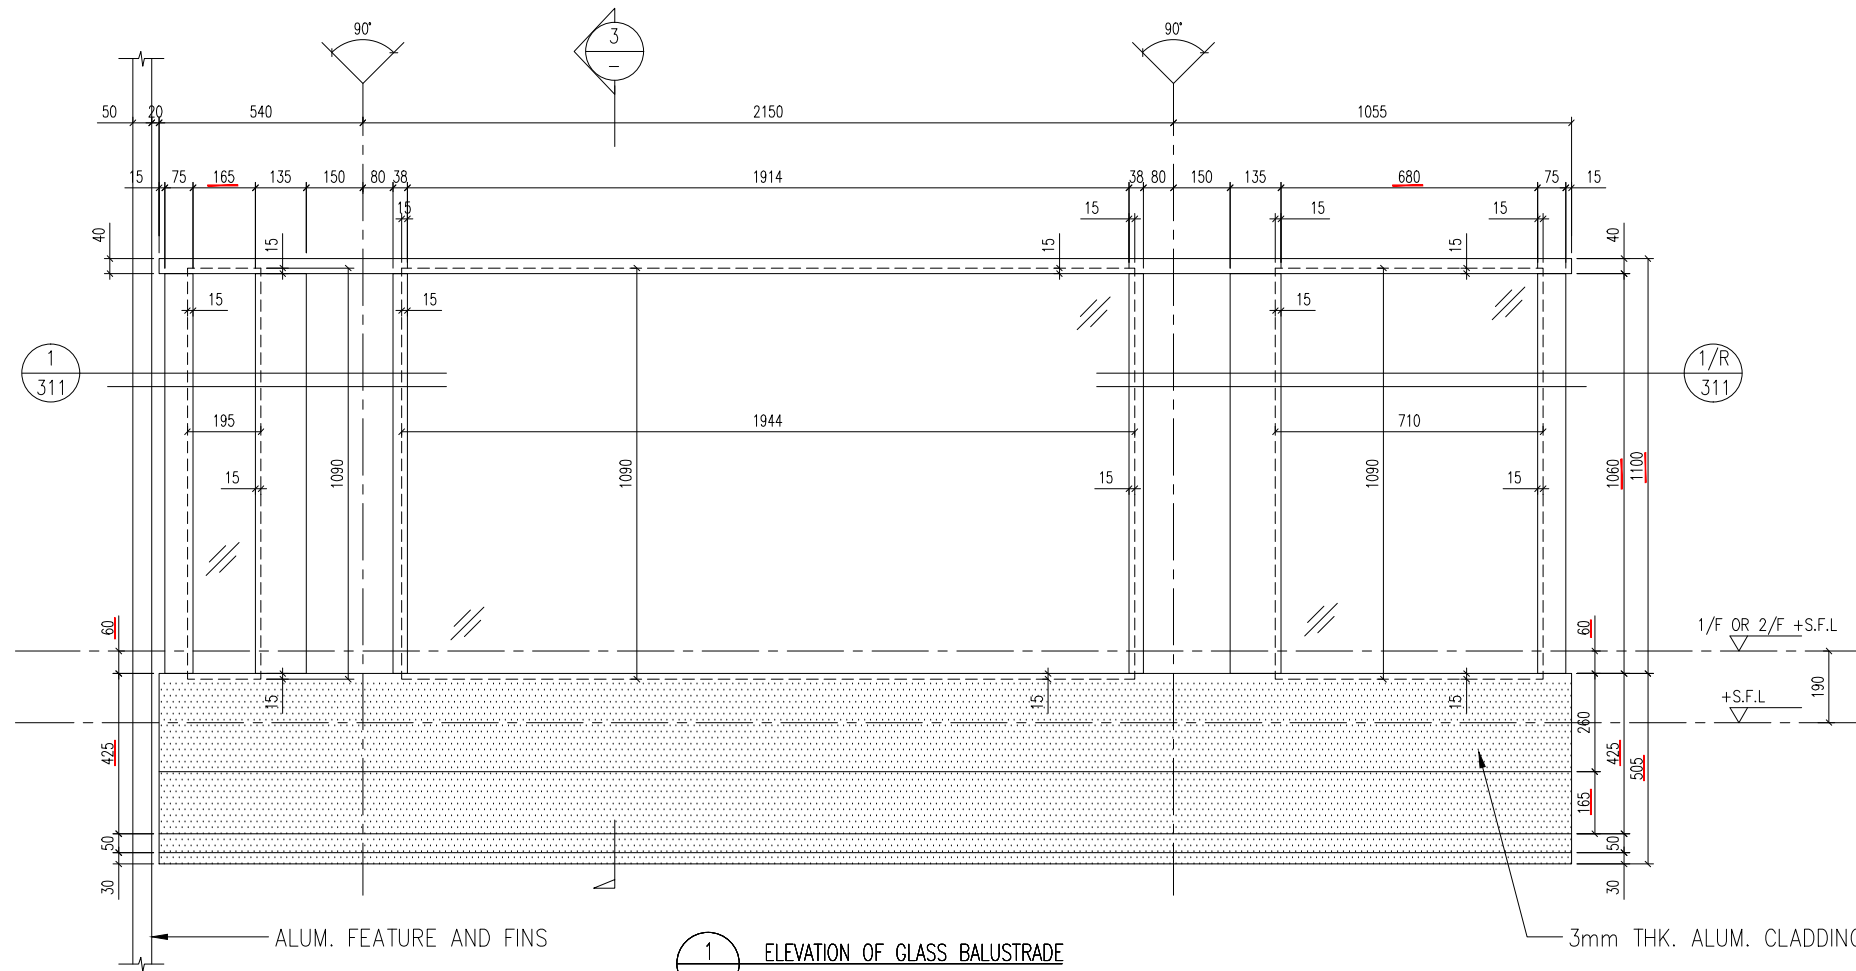

1 ELEVATION OF GLASS BALUSTRADE

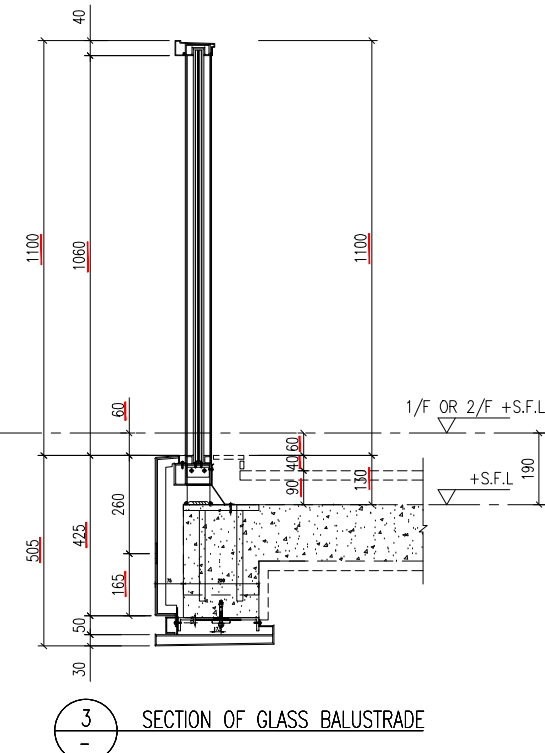

3 SECTION OF GLASS BALUSTRADE

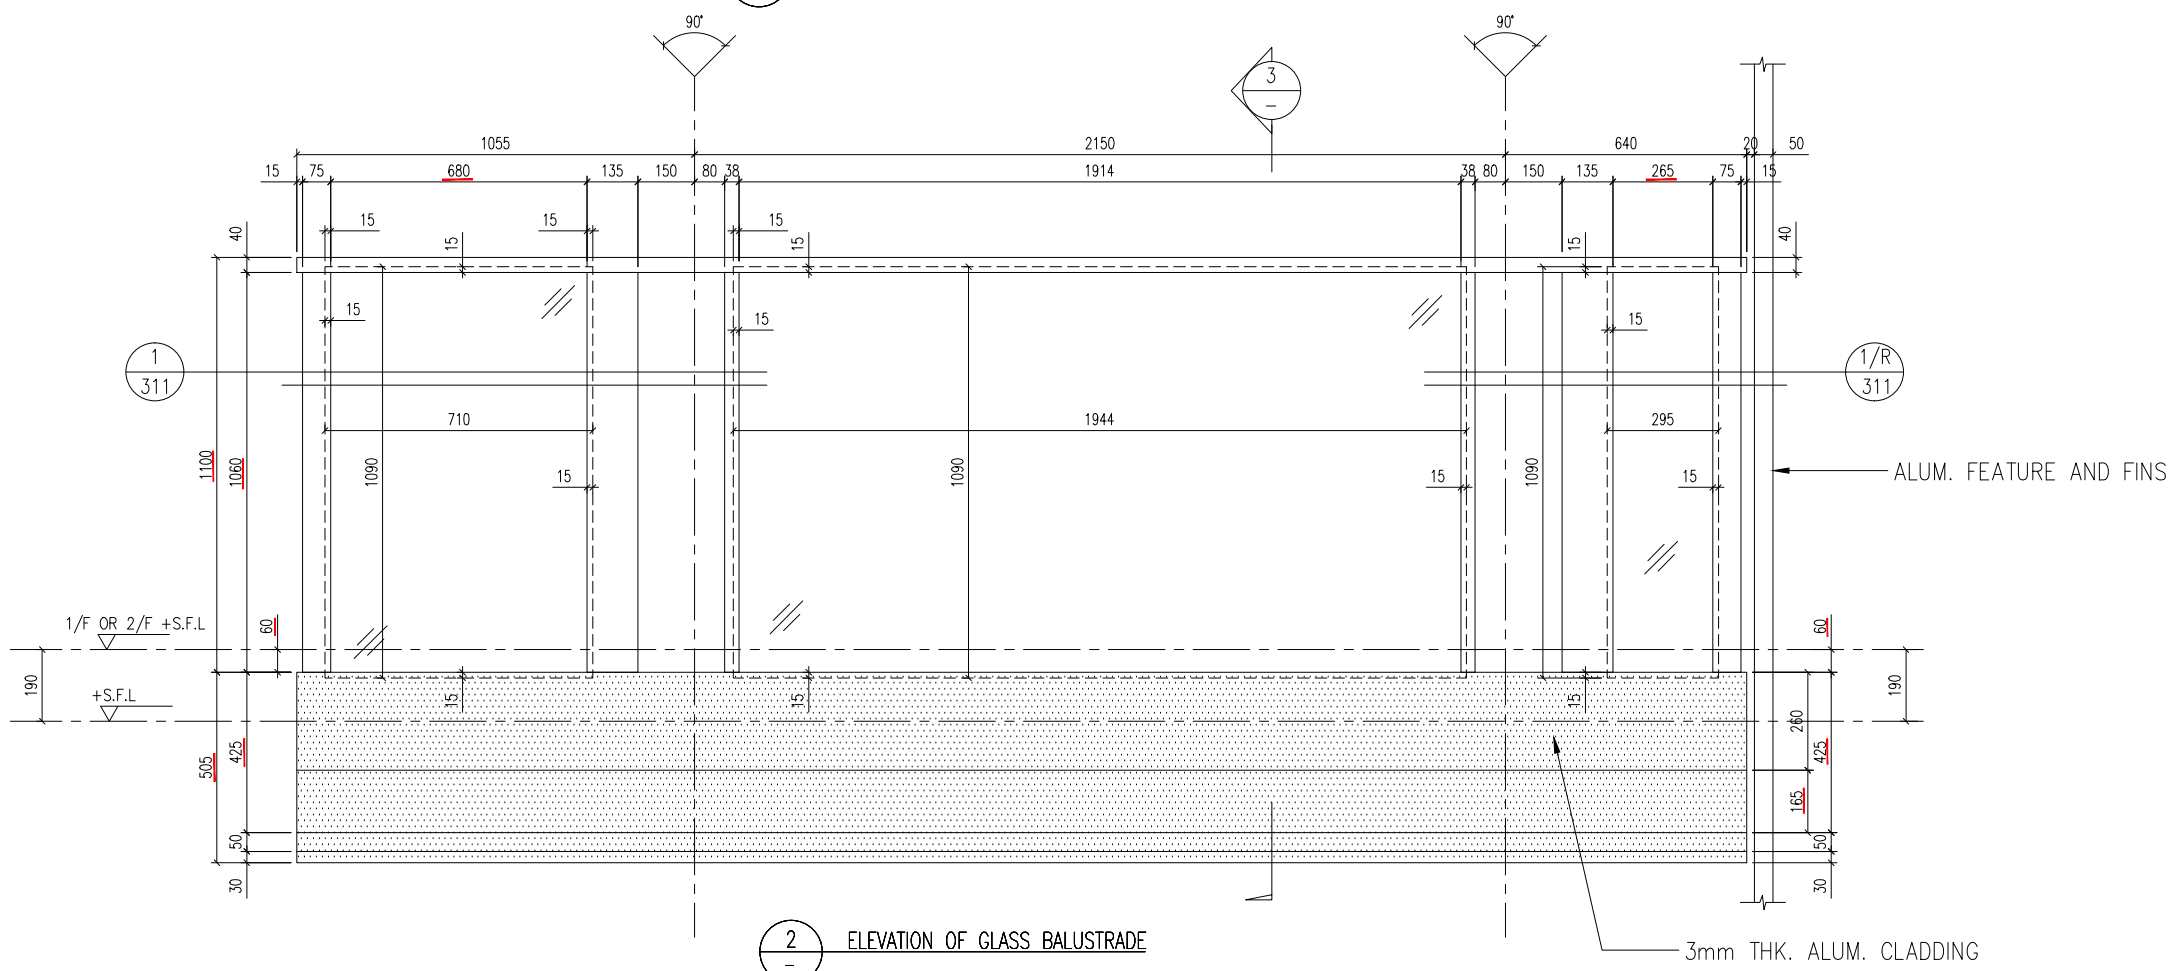

2 ELEVATION OF GLASS BALUSTRADE

B.D. REF :
 F.S.D. REF :
 Note :
 1.All dimensions are in mm.
 2.All elevations are viewed from outside.
 3.All dimensions to be verified on site before fabrication.

GENERAL NOTES

- Legend :**
 1. F.F.L.-- Finished Floor Level
 2. S.F.L.-- Structural Floor Level
 3. (R) -- Reversed Detail
- X1 -- DETAIL MARK NO.
 X001 -- REFER SHEET NO.

NO.	DATE	REVISION	BY
A	2019.11.29	General Revision	

CLIENT :
 佳明集團控股有限公司
 GRAND MING GROUP HOLDINGS LIMITED

ARCHITECT :
 WONG TUNG & PARTNERS LIMITED
 ARCHITECTS & PLANNERS

STRUCTURAL ENGINEER :

 C M WONG & ASSOCIATES LTD


MAIN CONTRACTOR :
 GRAND TECH CONSTRUCTION CO. LTD.

MIDI ALUMINIUM FABRICATOR LTD.
 Units 6-8, Sunray Industrial Centre, 1/F
 610 Cha Kwo Ling Road, Kowloon
 Tel:23489211-4 Fax:(852)27727666


PROJECT :
 RESIDENTIAL DEVELOPMENT AT
 TSING YI TOWN LOT 190 SAI SHAN ROAD

TITLE :
 MOCK UP - ELEVATION FOR
 GLASS BALUSTRADE


JOB NO. :	J-851
DRAWN BY :	C.H.P.
DATE :	31-10-2019
CHKD BY :	
SCALE :	A1: A3: 1:20
DWG. NO. :	J851-MU-301
REV. :	A

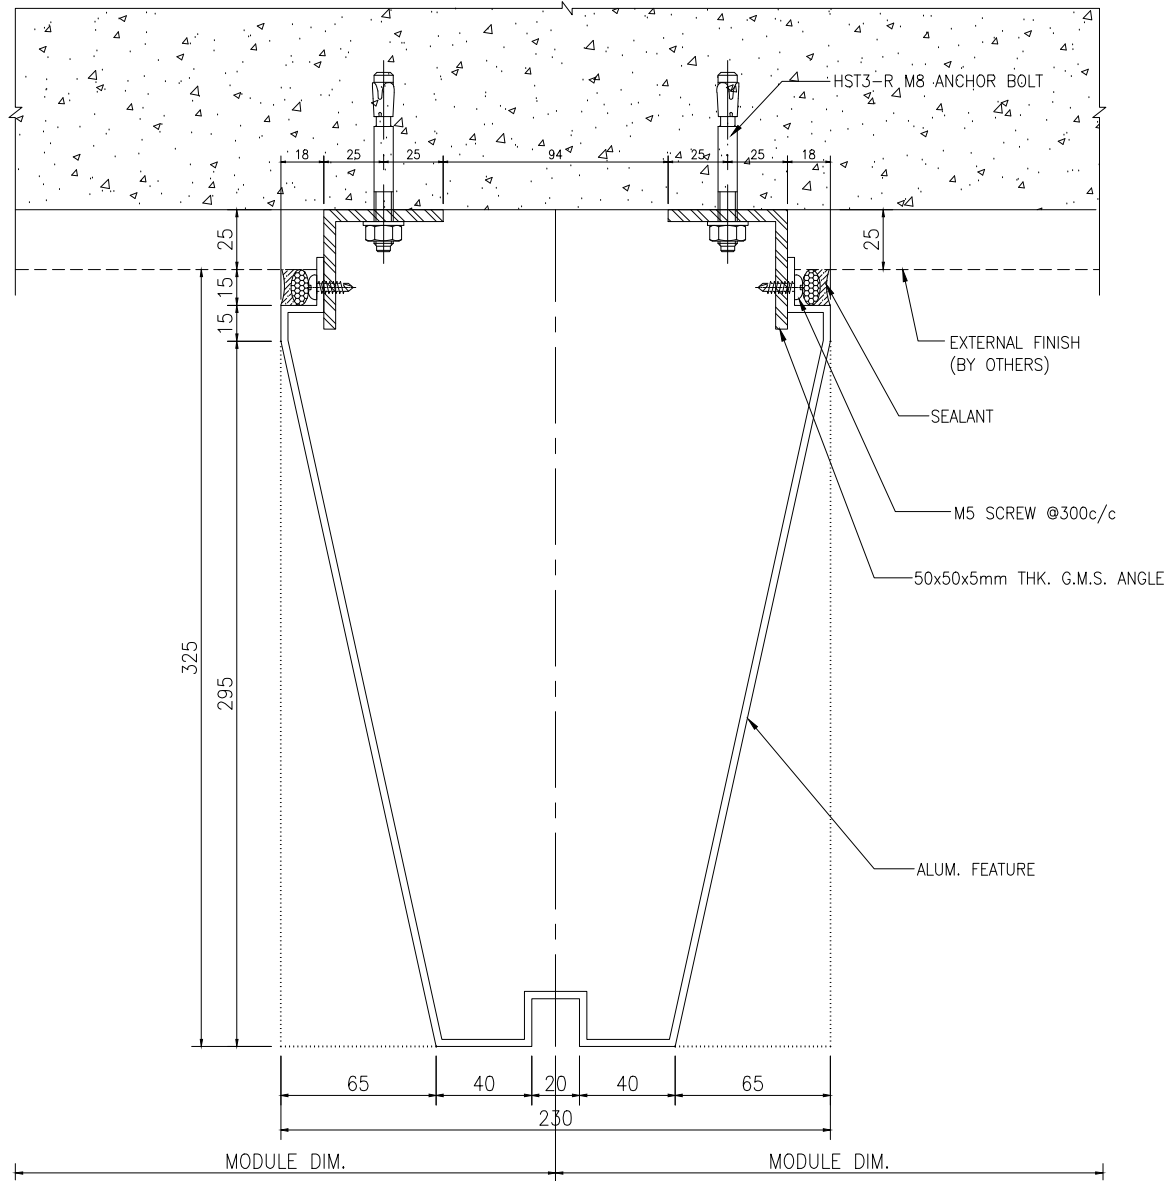


1 HORIZONTAL DETAIL
411 For Alum. Feature

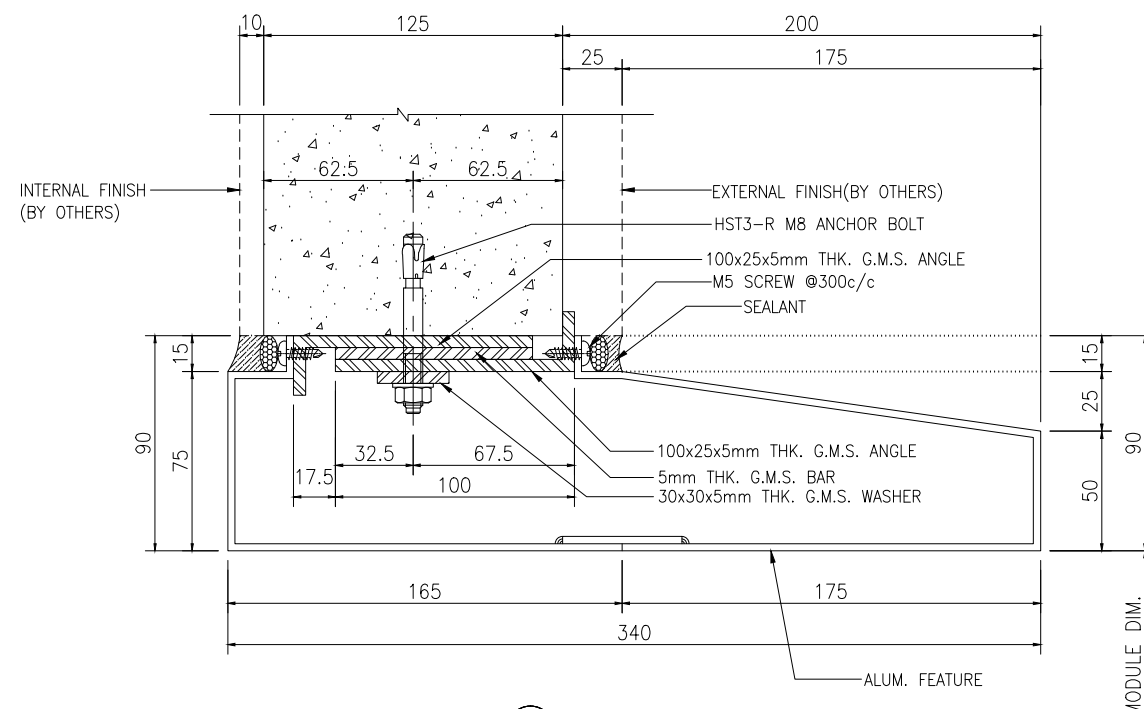

2 HORIZONTAL DETAIL
411 For Alum. Feature

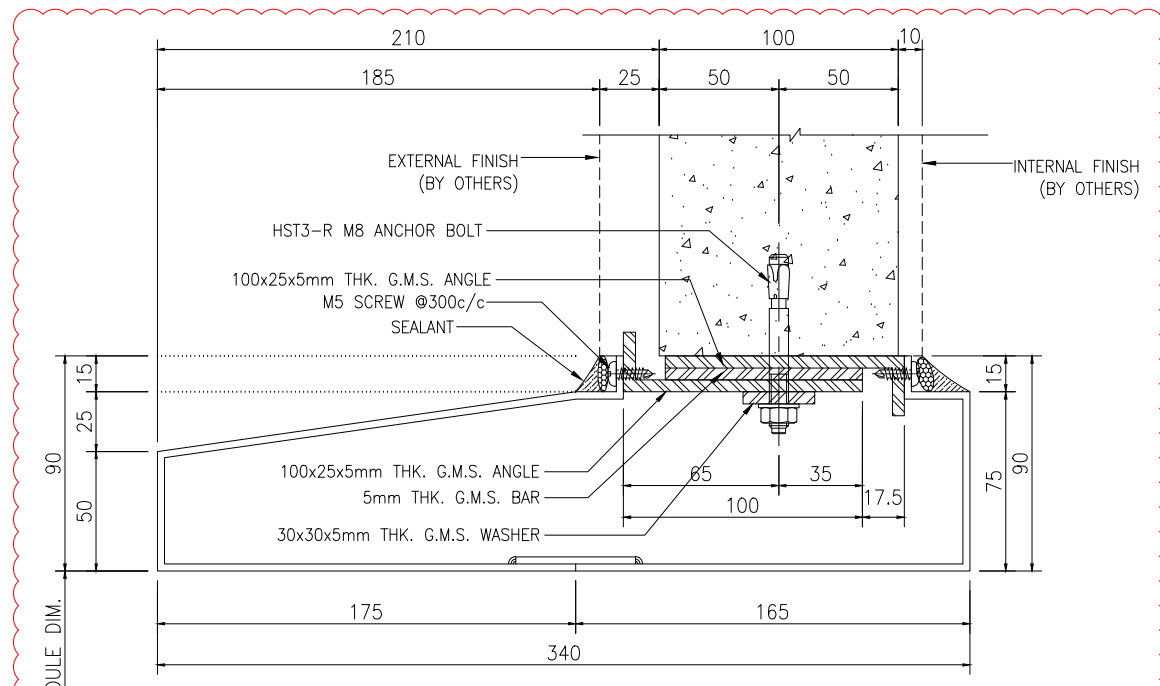

3 HORIZONTAL DETAIL
411 For Alum. Feature

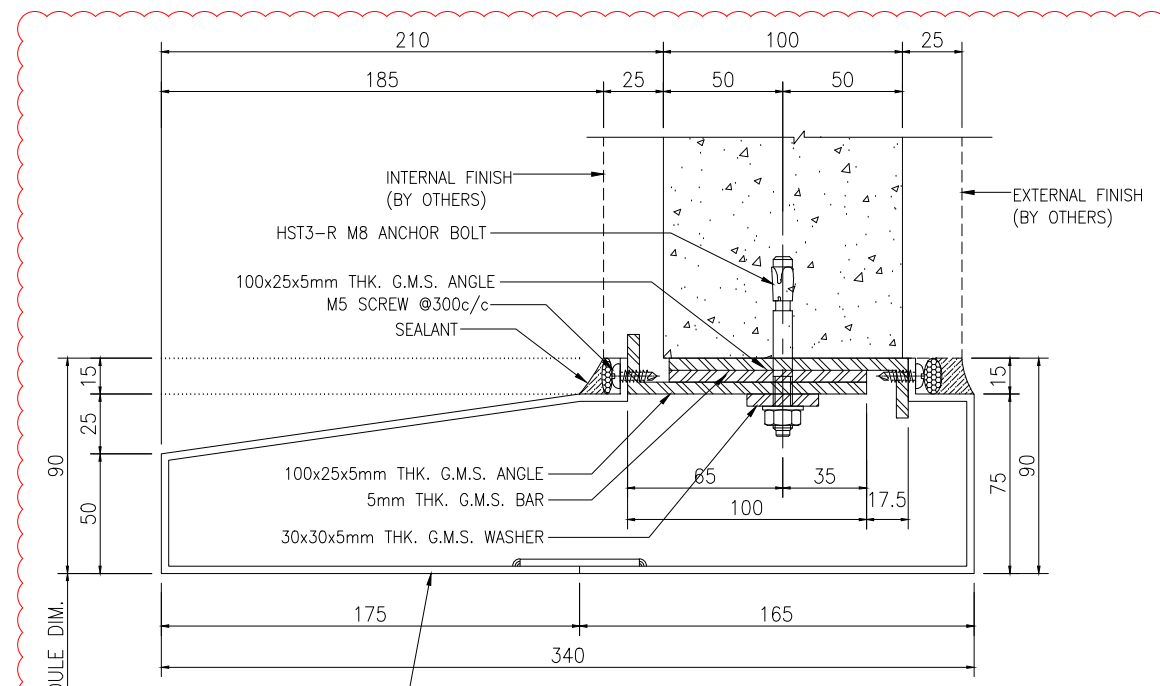

4 HORIZONTAL DETAIL
411 For Alum. Feature

B.D. REF :
F.S.D. REF :
Note :
1. All dimensions are in mm.
2. All elevations are viewed from outside.
3. All dimensions to be verified on site before fabrication.

GENERAL NOTES
Legend :
1. F.F.L.-- Finished Floor Level
2. S.F.L.-- Structural Floor Level
3. (R) -- Reversed Detail
X1 -- DETAIL MARK NO.
X001 -- REFER SHEET NO.

NO.	DATE	REVISED	BY
A	2019.11.19	General Revision	

CLIENT :
佳明集團控股有限公司
GRAND MING GROUP HOLDINGS LIMITED

ARCHITECT :
WONG TUNG & PARTNERS LIMITED
ARCHITECTS & PLANNERS
WT

STRUCTURAL ENGINEER :
CMWONG & ASSOCIATES LTD

MAIN CONTRACTOR :
GRAND TECH CONSTRUCTION CO. LTD.

美特鋁質有限公司
MIDI ALUMINIUM FABRICATOR LTD.
Units 6-8, Sunray Industrial Centre, 1/F
610 Cha Kwo Ling Road, Kowloon
Tel:23489211-4 Fax:(852)27727666

PROJECT :
RESIDENTIAL DEVELOPMENT AT
TSING YI TOWN LOT 190 SAI SHAN ROAD

TITLE :
MOCK UP - TYPICAL DETAIL FOR
ALUM. FEATURE AND FINS

JOB NO. :	J-851
DRAWN BY :	C.H.P.
DATE :	31-10-2019
CHKD BY :	SCALE A1: A3: 1:3
DWG. NO. :	J851-MU-411
REV. :	A