



工程指示 / 要求簡箋(E.I.)

工程指示編號：EI / 1472 / 20 修改版次：E
 工程編號：J851 工程名稱：青衣明翹匯住宅
 工程項目：大貨試模窗
 收件人：生統 發件人：Leung Hin Wai 日期：21/02/2020

要求提供 / 確認 事項：

- | | | |
|------------------------------------|-------------------------------------|-------------------------------|
| <input type="checkbox"/> 初步鋁料 B.M. | <input type="checkbox"/> 加工拆圖，然後生產 | <input type="checkbox"/> 尺寸表 |
| <input type="checkbox"/> 正式鋁料 B.M. | <input type="checkbox"/> 技術上資料 / 指示 | <input type="checkbox"/> 報價 |
| <input type="checkbox"/> 配件 B.M. | <input type="checkbox"/> 樣辦或貨品說明書 | <input type="checkbox"/> 分判合約 |
| <input type="checkbox"/> 其他：_____ | | |

內容：

現附上更新預制窗施工圖。
 要按此新圖更新試模窗。
 另外也要更新 EI1473 內的表格。

請在 28/2 前完成上列要求。

附： -

以上項目為：

- 原合約工程包 原合約工程加 / 減賬 新工程報價

原因：-

分發東莞各部門：

- () 生產技術總監 連附件 () 技術部 連附件 () 生產部 連附件 () 機械設計部 連附件
 () 採購部 連附件 () 生產統籌部 連附件
 () 質檢部 連附件 () 會計部 連附件 () 報關組 連附件 () 其他 _____ 連附件

分發香港各部門：

- () 行政部 連附件 () 會計部 連附件 () 統籌部 連附件 () 工程部地盤科文(柄) 連附件
 () 採購部 連附件 () QS 部 連附件 () 維修部 連附件 () 其他 _____ 連附件

傳遞編號：

HK 0195

發件人簽署：

項目經理簽署：

PROJECT :

**RESIDENTIAL DEVELOPMENT AT
TSING YI TOWN LOT 190
SAI SHAN ROAD**

**SHOPDRAWING FOR
PRE-CAST ALUM. WINDOW & LOUVRE
(TOWER 1/1A, TOWER 2/2A)
DATE : XX - February - 2019**


 **美特鋁質有限公司**
MIDI ALUMINIUM FABRICATOR LTD.
Units 6-8, Sunray Industrial Centre, 1/F
610 Cha Kwo Ling Road, Kowloon
Tel:23489211-4 Fax:(852)27727666



DRAWING SUBMISSION REGISTER

PROJECT : RESIDENTIAL DEVELOPMENT AT TSING YI TOWN LOT 190 SAI SHAN ROAD WORK TYPE: SHOPDRAWING FOR PRE-CAST ALUM. WINDOW & LOUVRE (TOWER 1/1A, TOWER 2/2A)	DATE OF ISSUE				SUBMISSION STATE (FOR B.D./A.S.D)			SUBMISSION STATE (FOR CLIENT/CONSULTANT)			SUBMISSION STATE (FOR ARCHITECT)			FABRICATION/CONSTRUCTION STATE					
	COVER	01	02	03	AP - APPROVED			AP - APPROVED			AP - APPROVED			ISSUE TO CHINA OFFICE		ISSUE TO SITE		ISSUE TO SUB-CONTRACTOR	
	DAY	10	05	XX	AC - APPROVED SUB. TO CONDITION			AC - APPROVED SUB. TO CONDITION			AC - APPROVED SUB. TO CONDITION			REV.	DATE	REV.	DATE	REV.	DATE
	MONTH	12	02	02	NA - NOT APPROVED			NA - NOT APPROVED			NA - NOT APPROVED								
YEAR	19	20	20	COMMENT DATE	REV.	STATE	COMMENT DATE	REV.	STATE	COMMENT DATE	REV.	STATE	REV.	DATE	REV.	DATE	REV.	DATE	
DRAWING TITLE	DRG. NO.	REVISIONS																	
WINDOW SCHEDULE FOR PRECAST FACADE OF T1/T1A	J851-SCH-101a	-																	
WINDOW SCHEDULE FOR PRECAST FACADE OF T2/T2A	J851-SCH-201a	-																	
TYPICAL DETAIL FOR PRECAST ALUM. WINDOW	J851-PW-501	-	A	B															
TYPICAL DETAIL FOR PRECAST ALUM. WINDOW	J851-PW-601	-	A	B															
TYPICAL DETAIL FOR PRECAST ALUM. WINDOW	J851-PW-602	-	A	B															
TYPICAL DETAIL FOR PRECAST ALUM. WINDOW	J851-PW-603	-	A	B															
TYPICAL DETAIL FOR PRECAST ALUM. LOUVRE	J851-PW-604	-	DELETE																

IN-HOUSE DESIGN CHECKER

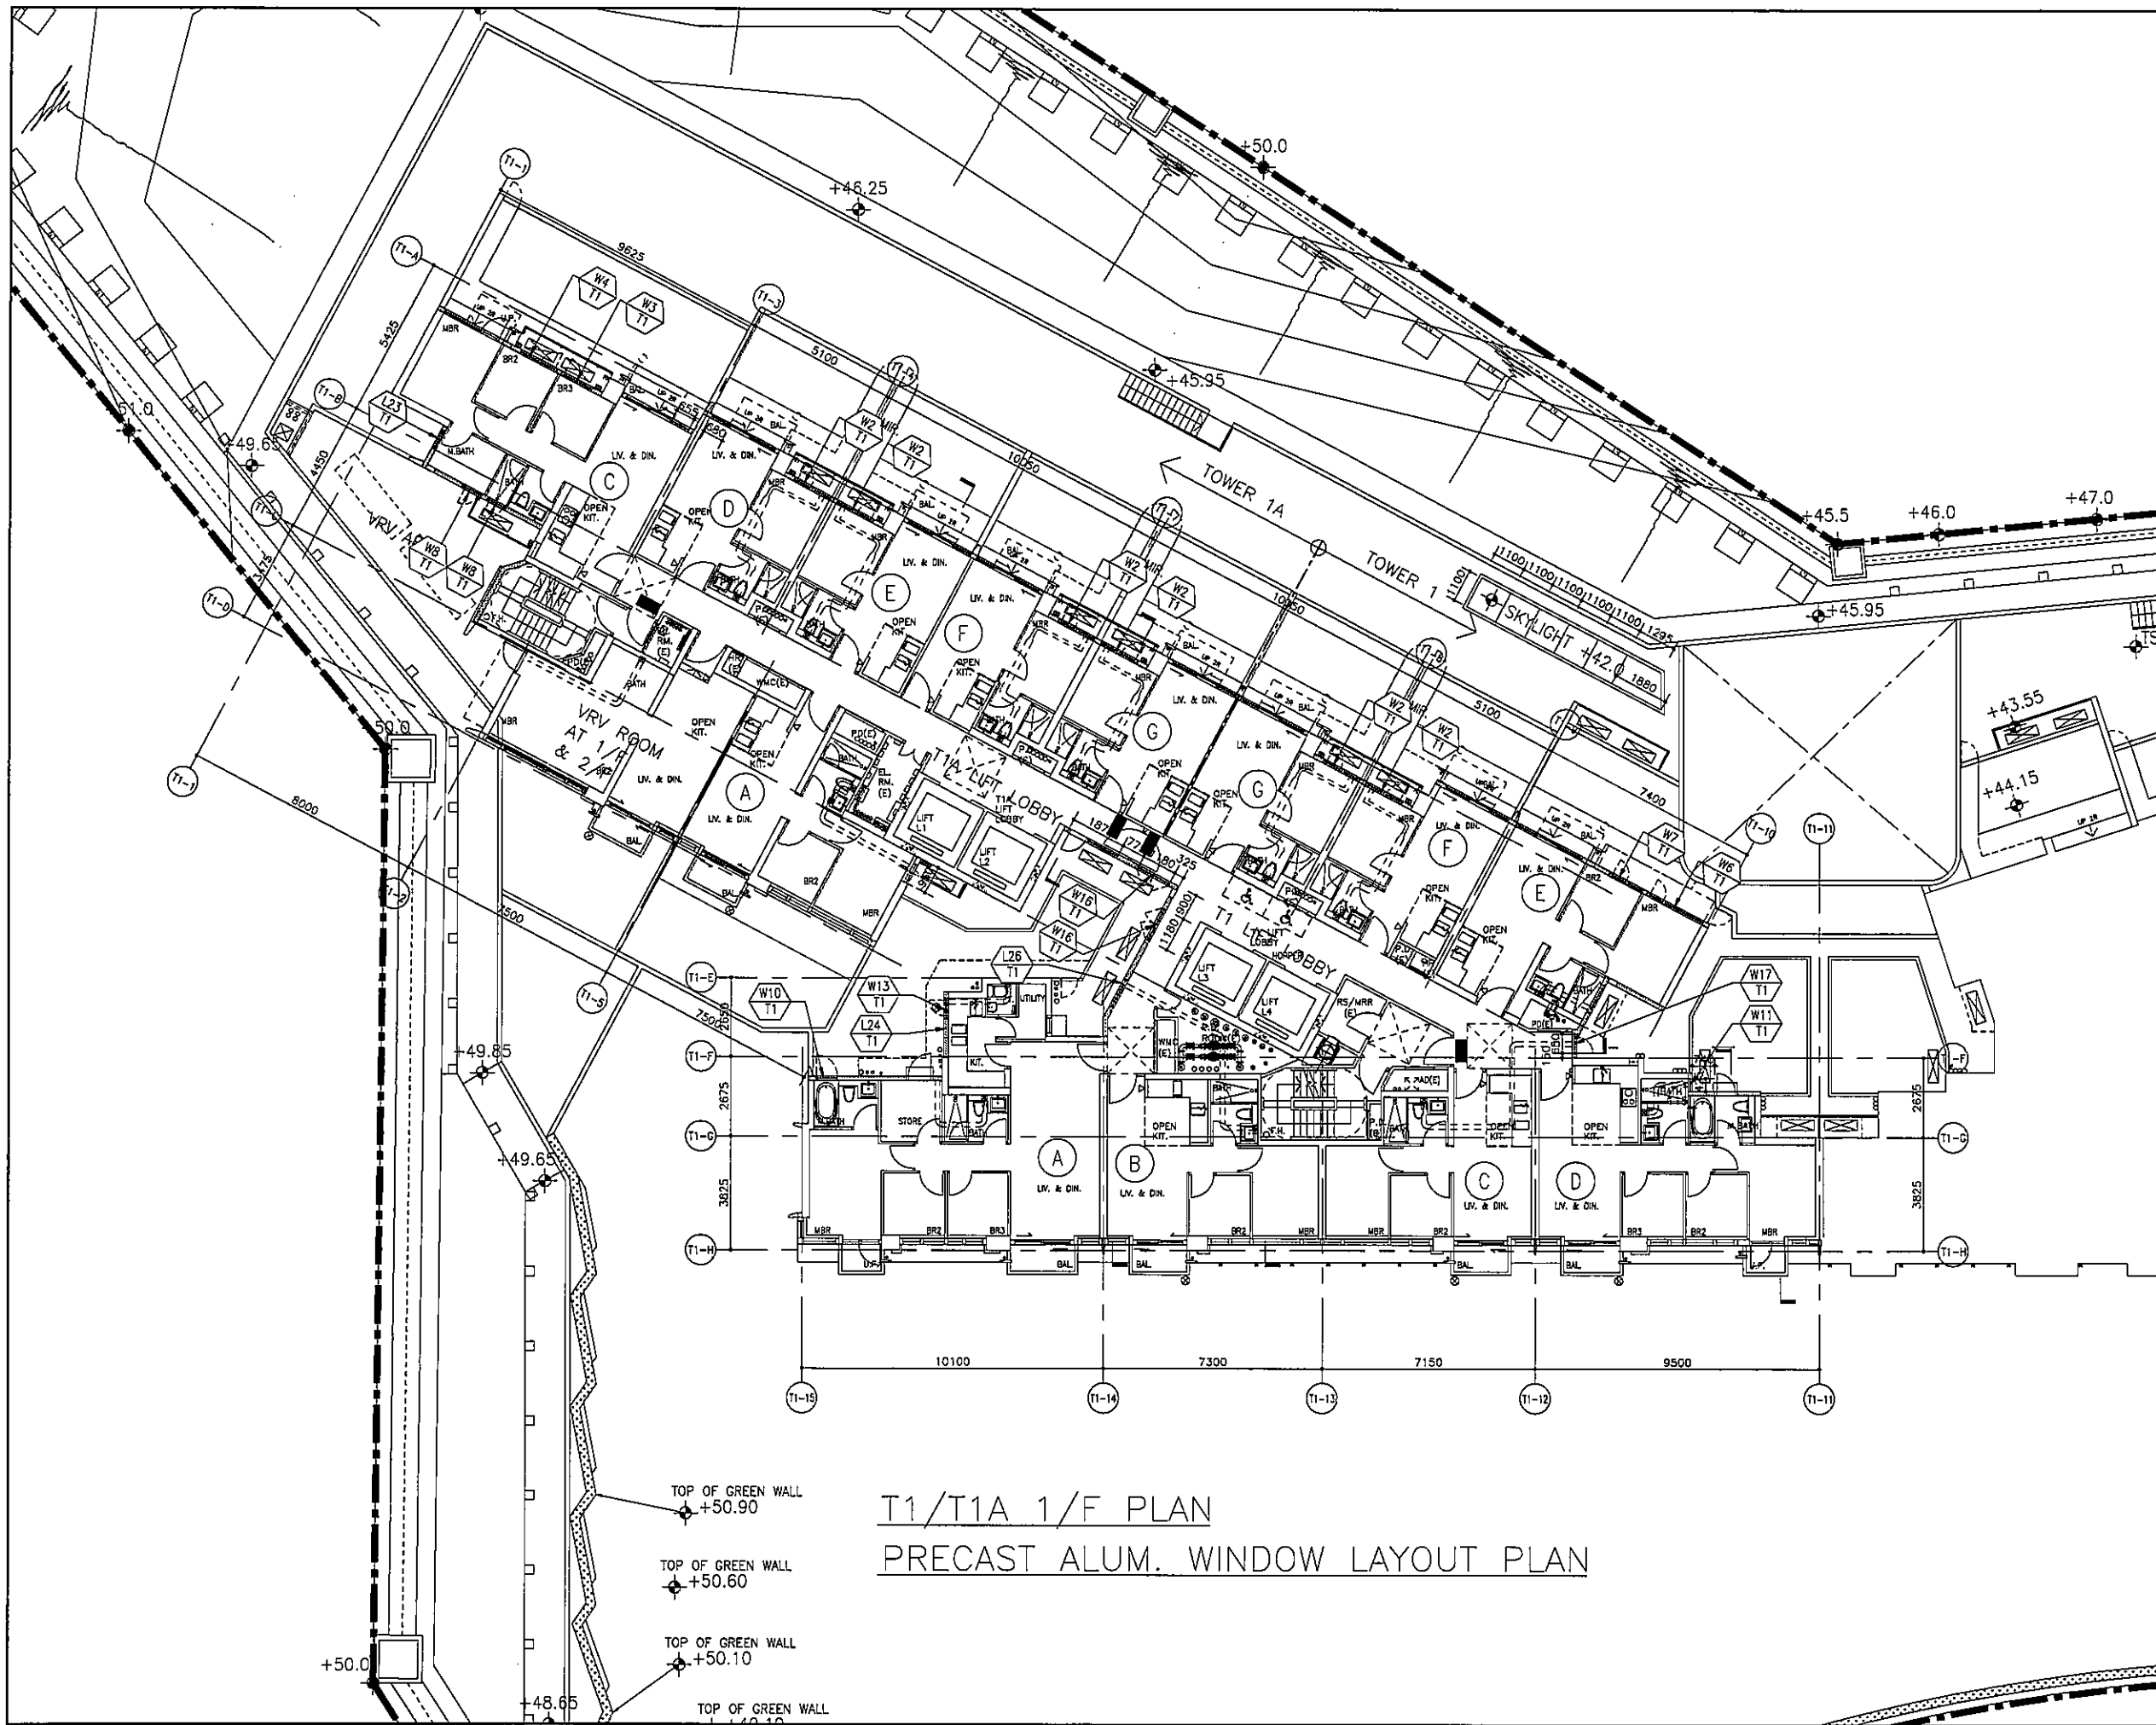

T1/T1A 1/F PLAN
 PRECAST ALUM. WINDOW LAYOUT PLAN

B.D. REF :
 F.S.D. REF :
 Note :
 1. All dimensions are in mm.
 2. All elevations are viewed from outside.
 3. All dimensions to be verified on site before fabrication.

GENERAL NOTES
 Legend :
 1. F.F.L.-- Finished Floor Level
 2. S.F.L.-- Structural Floor Level
 3. (R) -- Reversed Detail
 X1 -- DETAIL MARK NO.
 X001 -- REFER SHEET NO.

NO.	DATE	REVISED	BY

CLIENT :
佳明集團控股有限公司
 GRAND MING GROUP HOLDINGS LIMITED

MAIN CONTRACTOR :
GRAND TECH CONSTRUCTION CO. LTD.

ARCHITECT :
WONG TUNG & PARTNERS LIMITED
 ARCHITECTS & PLANNERS


STRUCTURAL ENGINEER :
C M WONG & ASSOCIATES LTD

美特鋁質有限公司
 MIDI ALUMINUM FABRICATOR LTD.
 Units 6-8, Sunray Industrial Centre, 1/F
 610 Cha Kwo Ling Road, Kowloon
 Tel: 23489211-4 Fax: (852) 27727666

PROJECT :
 RESIDENTIAL DEVELOPMENT AT
 TSING YI TOWN LOT 190 SAI SHAN ROAD




TITLE :
 TOWER 1/1A WINDOW LOCATION PLAN
 1/F

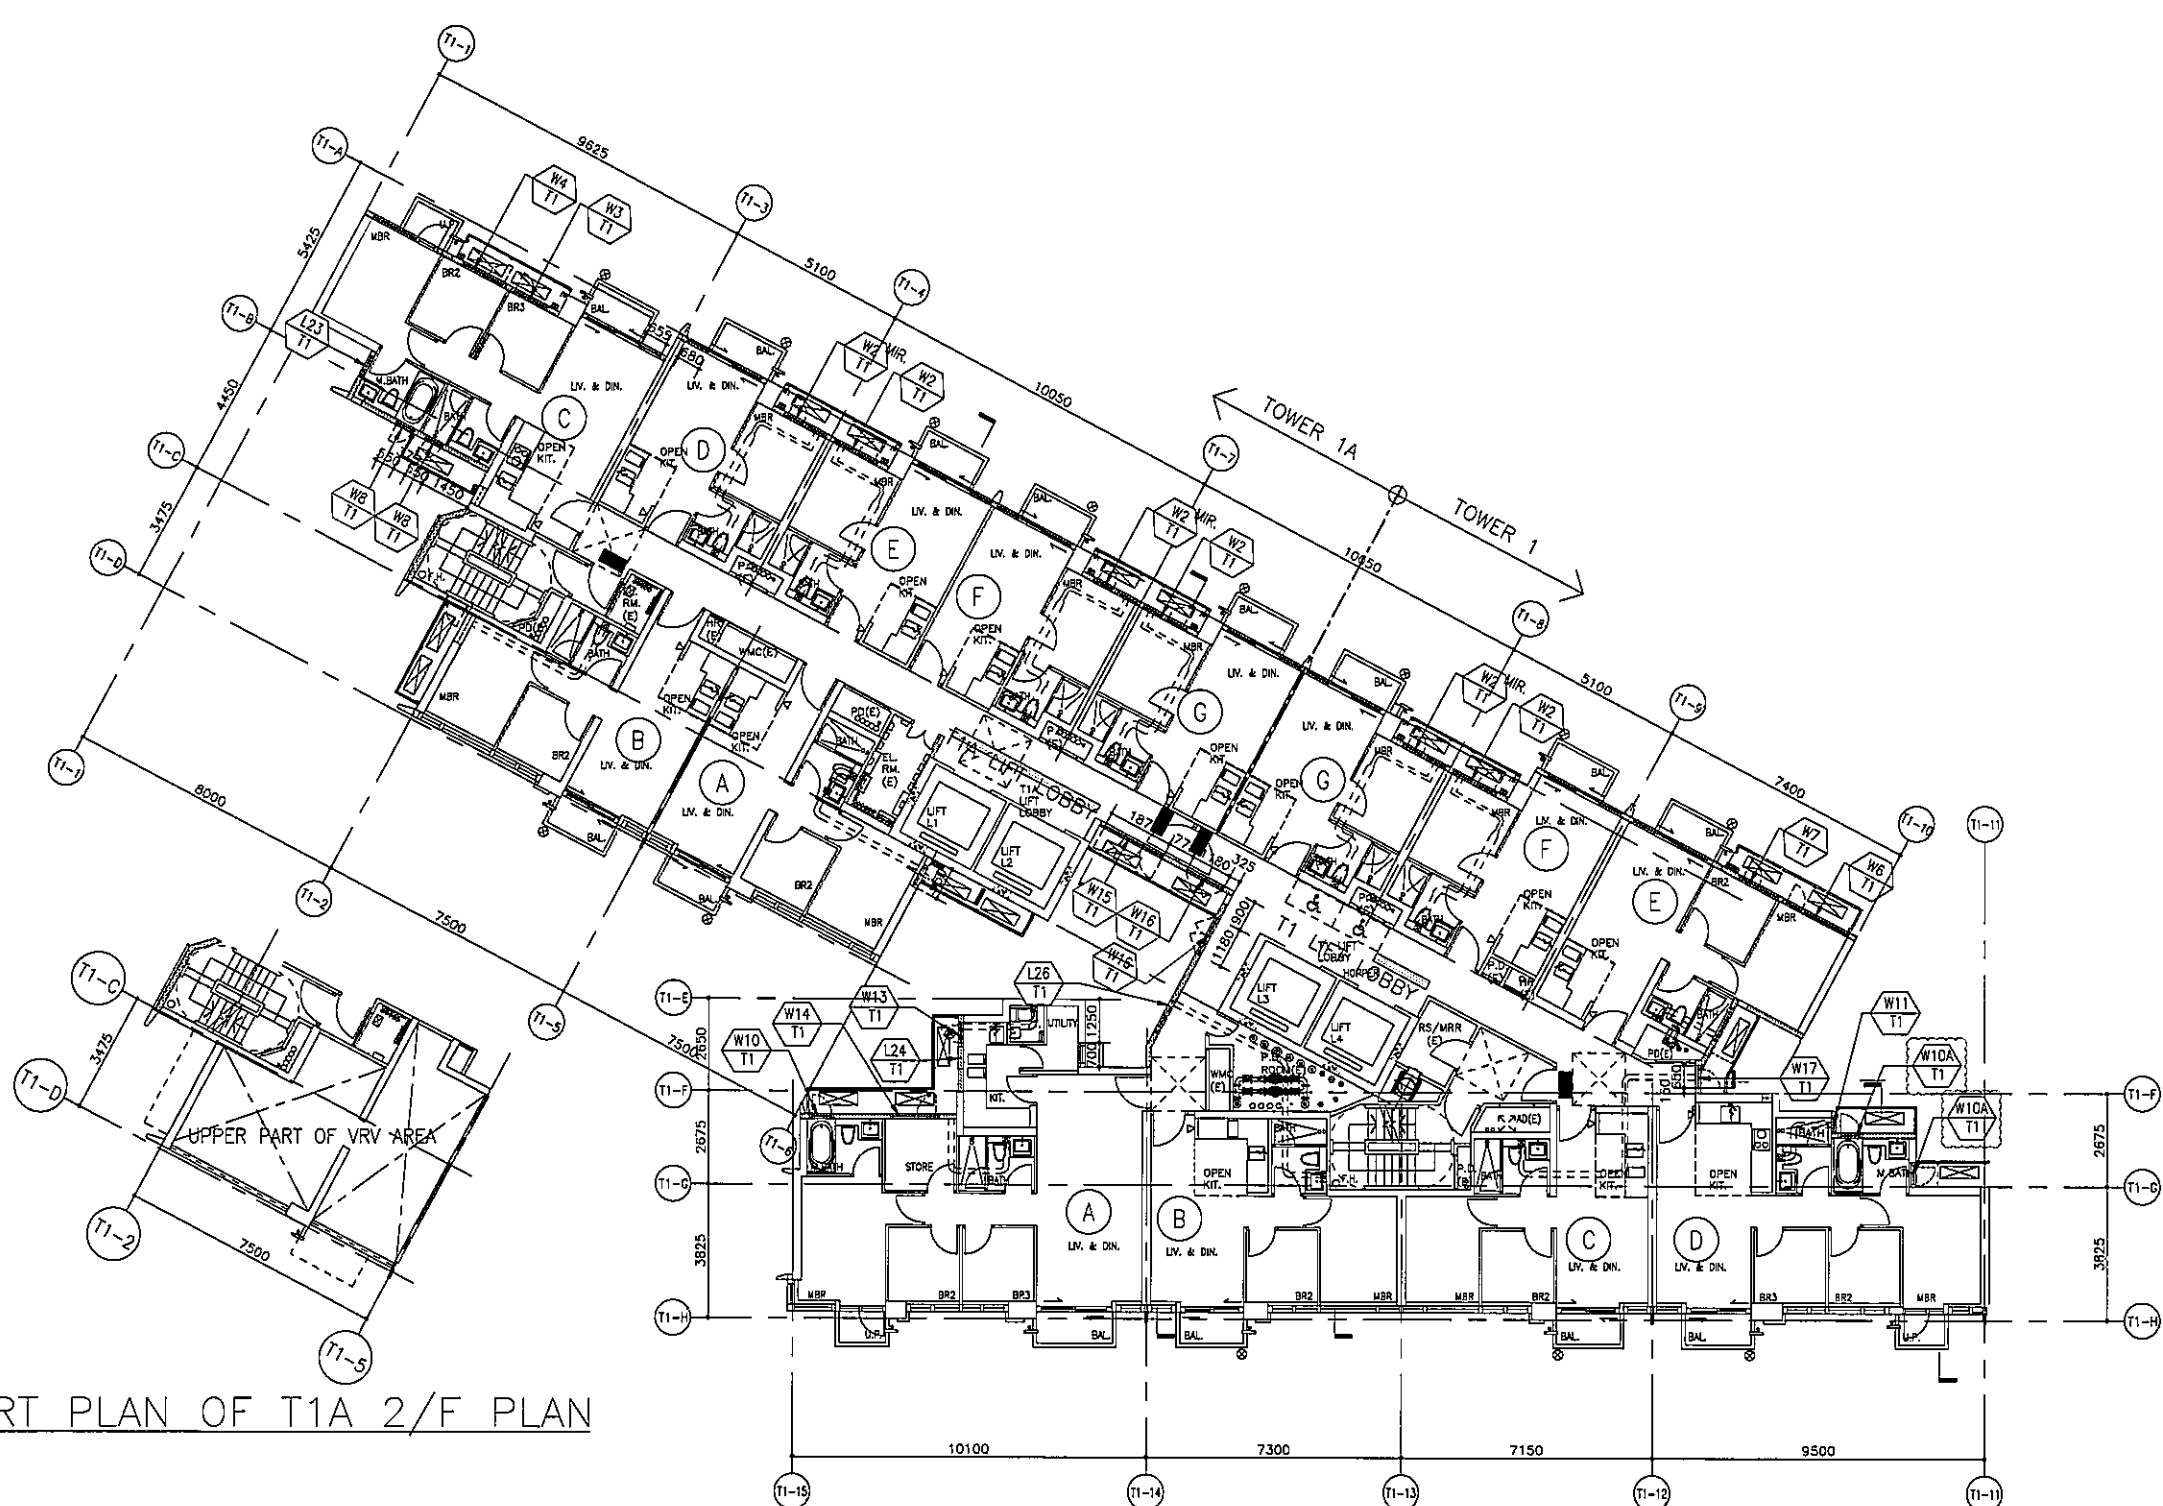
JOB NO. : J-851
 DRAWN BY : C.H.P. DATE : 30-11-2019
 CHKD BY : SCALE A1: A3: 1:30
 DWG. NO. : JB51-PL-101 REV. : -



PART PLAN OF T1A 2/F PLAN

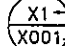T1/T1A 2/F - 31/F(TYPICAL)
 PRECAST ALUM. WINDOW LAYOUT PLAN

B.D. REF :														
F.S.D. REF :														
Note : 1. All dimensions are in mm. 2. All elevations are viewed from outside. 3. All dimensions to be verified on site before fabrication.														
GENERAL NOTES														
Legend : 1. F.F.L--- Finished Floor Level 2. S.F.L--- Structural Floor Level 3. (R) --- Reversed Detail														
 X1  X001	DETAIL MARK NO. REFER SHEET NO.													
<table border="1" style="width: 100%; border-collapse: collapse;"> <thead> <tr> <th style="width: 5%;">NO.</th> <th style="width: 15%;">DATE</th> <th style="width: 40%;">GENERAL REVISION</th> <th style="width: 40%;">REVISED BY</th> </tr> </thead> <tbody> <tr> <td> </td> <td> </td> <td> </td> <td> </td> </tr> <tr> <td> </td> <td> </td> <td> </td> <td> </td> </tr> </tbody> </table>			NO.	DATE	GENERAL REVISION	REVISED BY								
NO.	DATE	GENERAL REVISION	REVISED BY											
CLIENT : 佳明集團控股有限公司 GRAND MING GROUP HOLDINGS LIMITED														
MAIN CONTRACTOR : GRAND TECH CONSTRUCTION CO. LTD.														
ARCHITECT : WONG TUNG & PARTNERS LIMITED ARCHITECTS & PLANNERS 														
STRUCTURAL ENGINEER :  C M WONG & ASSOCIATES LTD														
 美特鋁質有限公司 MIDI ALUMINIUM FABRICATOR LTD. Units 6-8, Sunray Industrial Centre, 1/F 610 Cha Kwo Ling Road, Kowloon Tel: 23489211-4 Fax: (852) 27727666														
PROJECT : RESIDENTIAL DEVELOPMENT AT TSING YI TOWN LOT 180 SAI SHAN ROAD														
TITLE : TOWER 1/1A WINDOW LOCATION PLAN 2/F-31/F (TYPICAL)														
JOB NO. : J-851														
DRAWN BY : C.H.P.		DATE : 30-11-2019												
CHKD BY :		SCALE A1: A3: 1:30												
DWG. NO. : J851-PL-102		REV. : A												

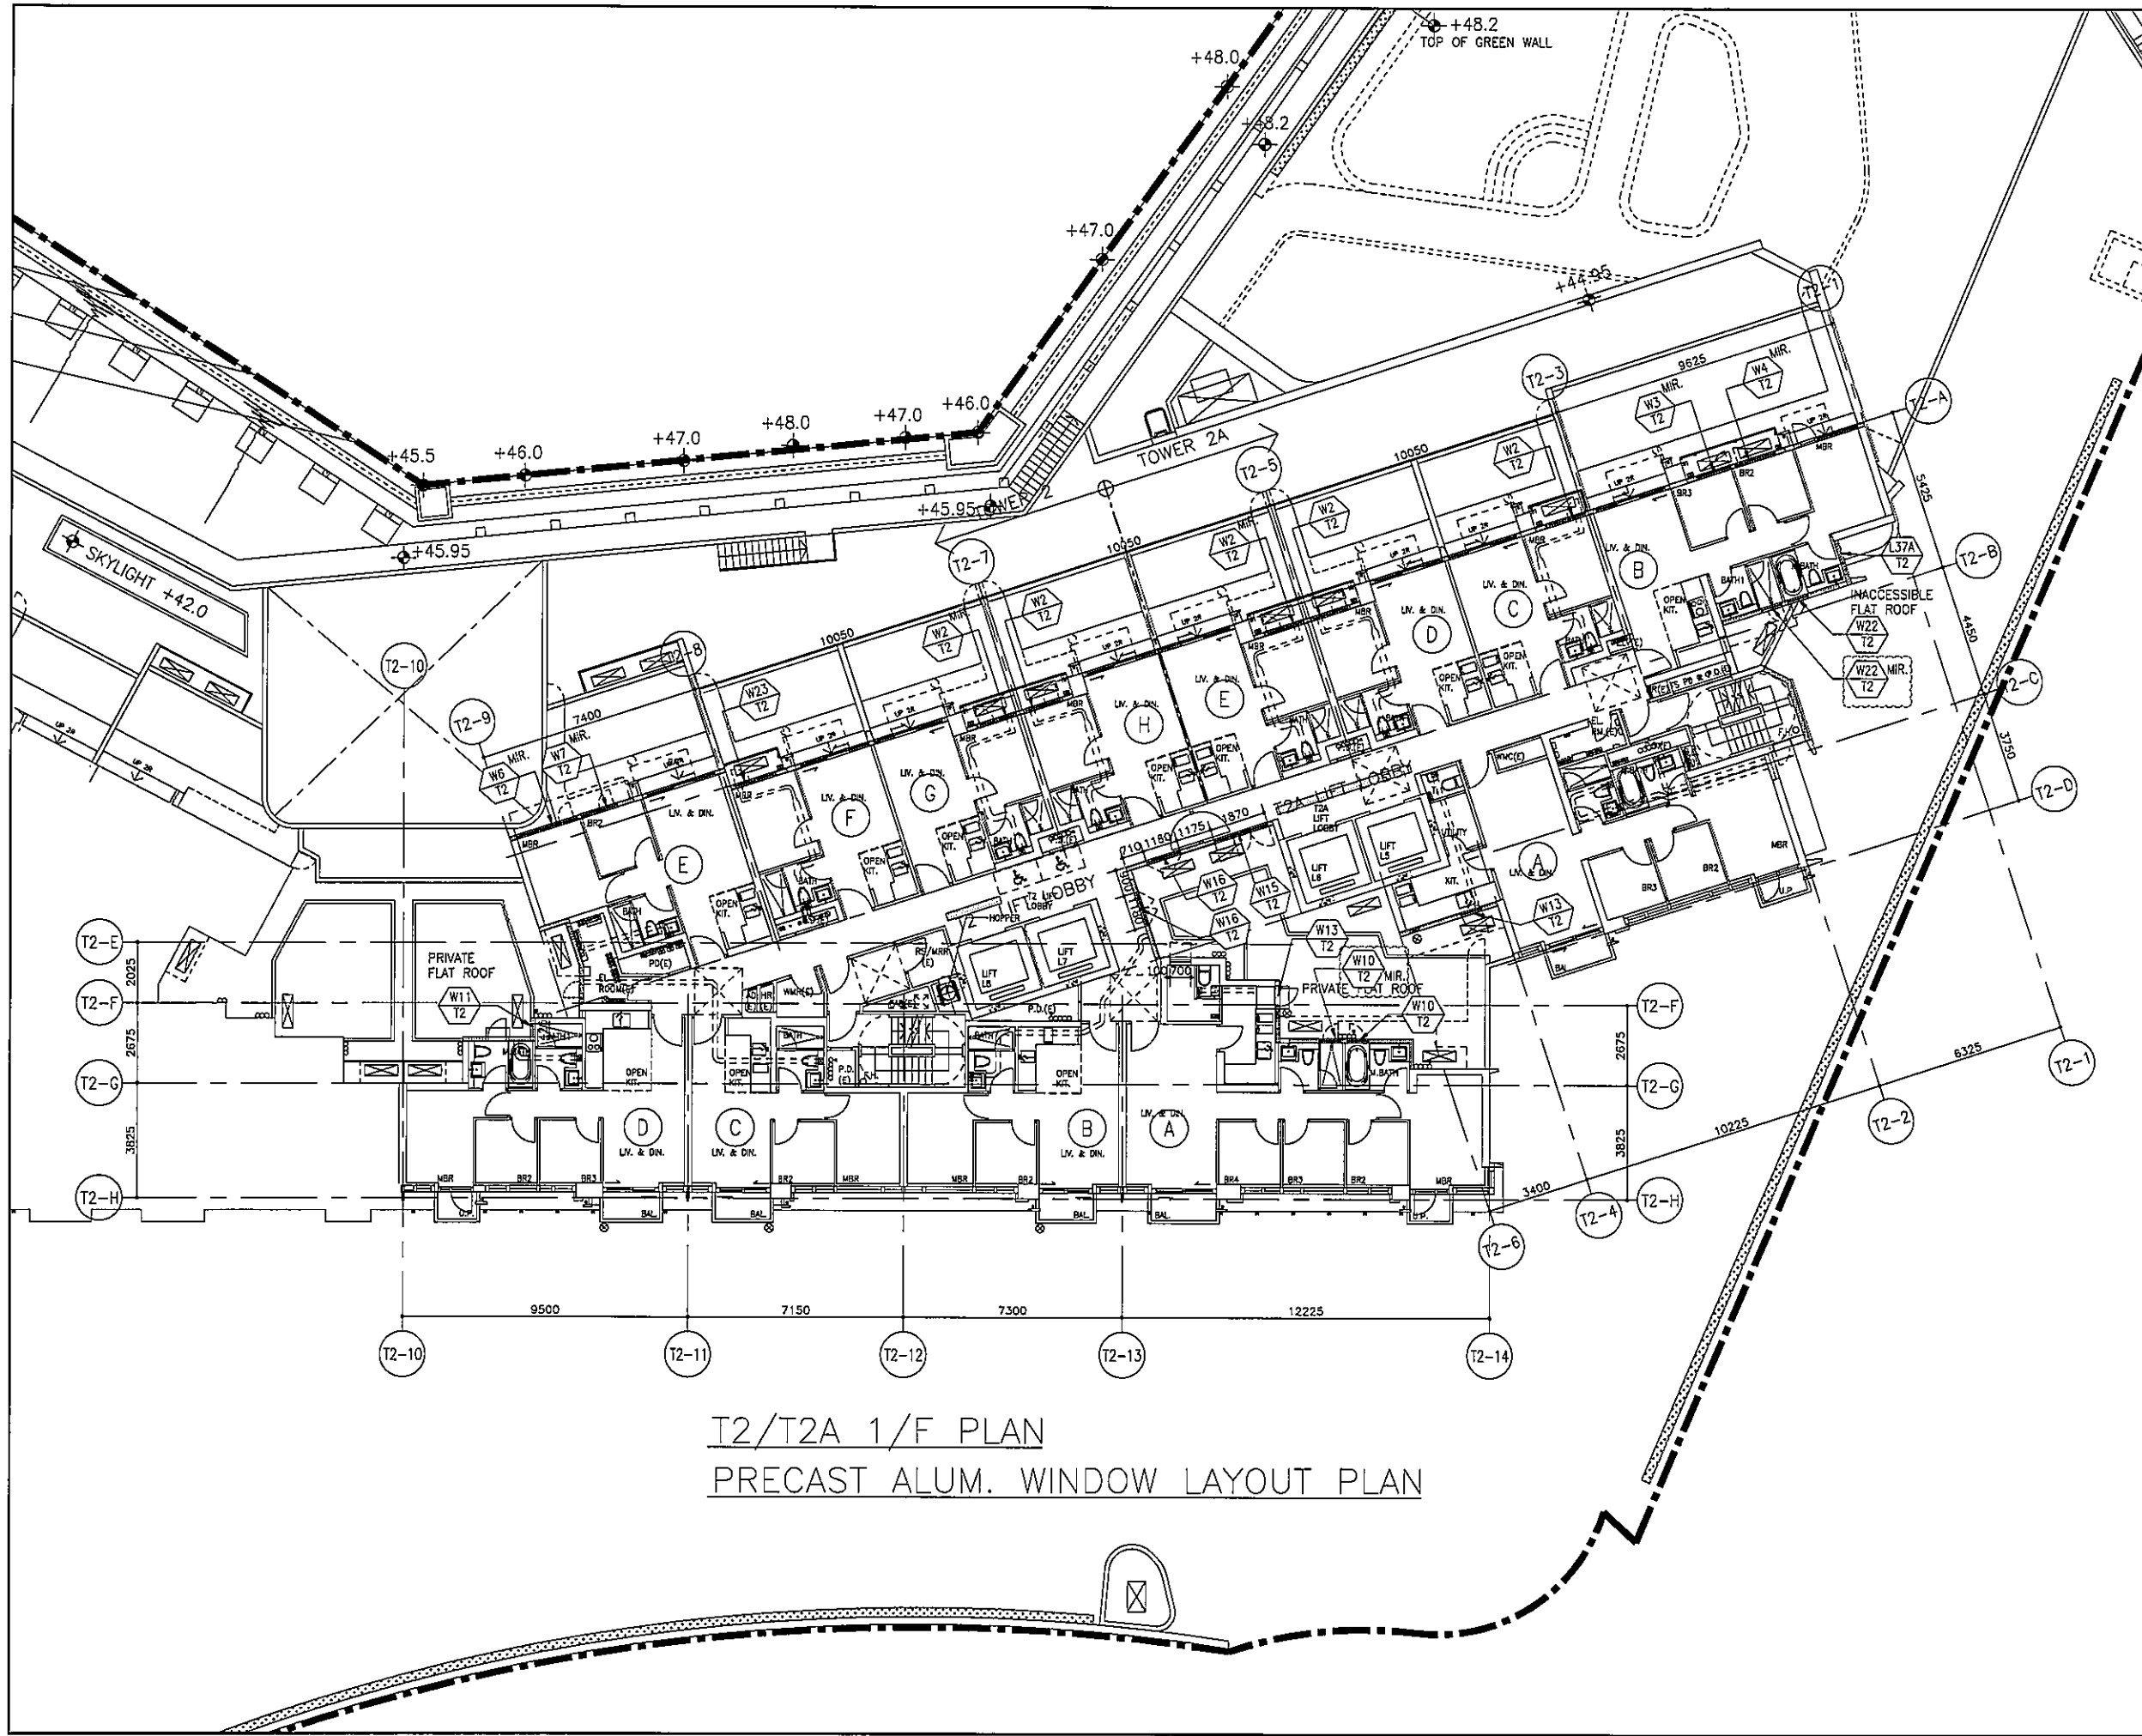

T2/T2A 1/F PLAN
 PRECAST ALUM. WINDOW LOCATION PLAN

B.D. REF :
 F.S.D. REF :

Note:
 1. All dimensions are in mm.
 2. All elevations are viewed from outside.
 3. All dimensions to be verified on site before fabrication.

GENERAL NOTES

Legend:
 1. F.F.L. -- Finished Floor Level
 2. S.F.L. -- Structural Floor Level
 3. (R) -- Reversed Detail

X1 -- DETAIL MARK NO.
 X001 -- REFER SHEET NO.

NO.	DATE	REVISED	BY
B	XX.02.2020	GENERAL REVISION	
A	06.02.2020	GENERAL REVISION	

CLIENT :
佳明集團控股有限公司
 GRAND MING GROUP HOLDINGS LIMITED

MAIN CONTRACTOR :
GRAND TECH CONSTRUCTION CO. LTD.

ARCHITECT :
WONG TUNG & PARTNERS LIMITED
 ARCHITECTS & PLANNERS



STRUCTURAL ENGINEER :
C M WONG & ASSOCIATES LTD



美特鋁質有限公司
 MIDI ALUMINIUM FABRICATOR LTD.

Units 6-8, Sunray Industrial Centre, 1/F
 610 Cha Kwo Ling Road, Kowloon
 Tel: 23489211-4 Fax: (852) 2727666

PROJECT :
 RESIDENTIAL DEVELOPMENT AT
 TSING YI TOWN LOT 190 SAI SHAN ROAD


TITLE :
 TOWER 2/2A WINDOW LOCATION PLAN
 1/F

JOB NO. : J-851

DRAWN BY : C.H.P. DATE : 30-11-2019







CHKD BY : SCALE A1: A3: 1:30

DWG. NO. : J851-PL-201 REV. : B

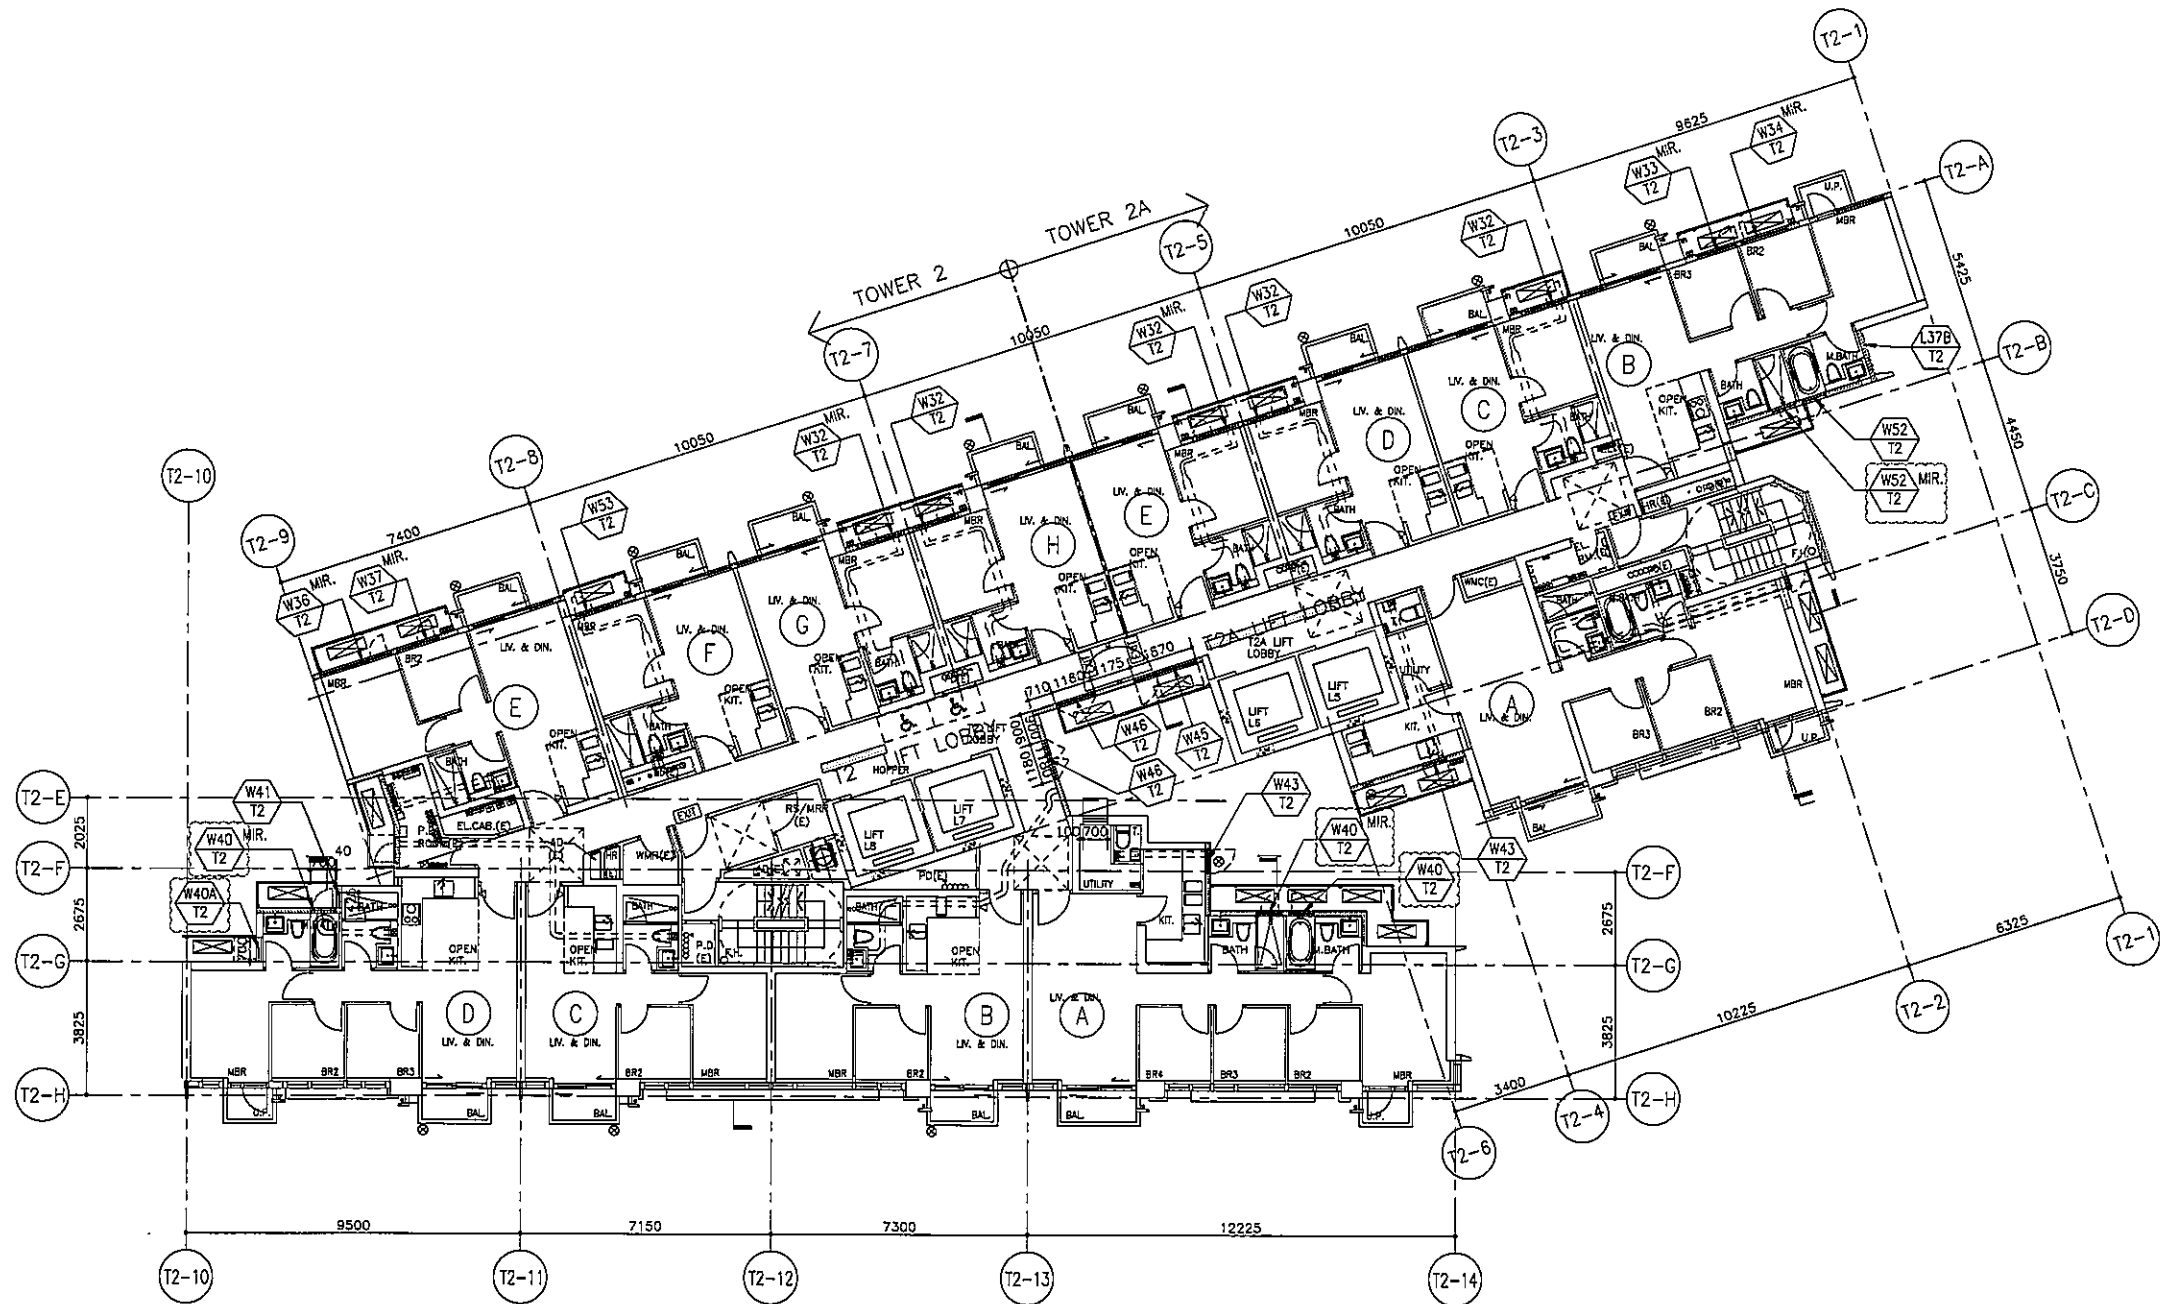

T2/T2A 32/F PLAN
 PRECAST ALUM. WINDOW LAYOUT PLAN


B.D. REF :													
F.S.D. REF :													
Note : 1. All dimensions are in mm. 2. All elevations are viewed from outside. 3. All dimensions to be verified on site before fabrication.													
GENERAL NOTES													
Legend : 1. F.F.L--- Finished Floor Level 2. S.F.L--- Structural Floor Level 3. (R) --- Reversed Detail													
(X1) --- DETAIL MARK NO. (X001) --- REFER SHEET NO.													
<table border="1"> <tr> <td>NO.</td> <td>DATE</td> <td>REVISED</td> <td>BY</td> </tr> <tr> <td>B</td> <td>06.02.2020</td> <td>GENERAL REVISION</td> <td></td> </tr> <tr> <td>A</td> <td>06.02.2020</td> <td>GENERAL REVISION</td> <td></td> </tr> </table>		NO.	DATE	REVISED	BY	B	06.02.2020	GENERAL REVISION		A	06.02.2020	GENERAL REVISION	
NO.	DATE	REVISED	BY										
B	06.02.2020	GENERAL REVISION											
A	06.02.2020	GENERAL REVISION											
CLIENT : 佳明集團控股有限公司 GRAND MING GROUP HOLDINGS LIMITED													
MAIN CONTRACTOR : GRAND TECH CONSTRUCTION CO. LTD.													
ARCHITECT : WONG TUNG & PARTNERS LIMITED ARCHITECTS & PLANNERS 													
STRUCTURAL ENGINEER :  C M WONG & ASSOCIATES LTD													
 美特鋁質有限公司 MIDI ALUMINIUM FABRICATOR LTD. Units 6-8, Sunray Industrial Centre, 1/F 610 Cha Kwo Ling Road, Kowloon Tel: 23489211-4 Fax: (852) 27727666													
PROJECT : RESIDENTIAL DEVELOPMENT AT TSING YI TOWN LOT 190 SAI SHAN ROAD													
TITLE : TOWER 2/2A WINDOW LOCATION PLAN 32/F													
JOB NO. : J-851													
DRAWN BY : C.H.P.	DATE : 30-11-2019												
CHKD BY :	SCALE : A1: A3: 1:30												
DWG. NO. : J851-PL-203	REV. : B												

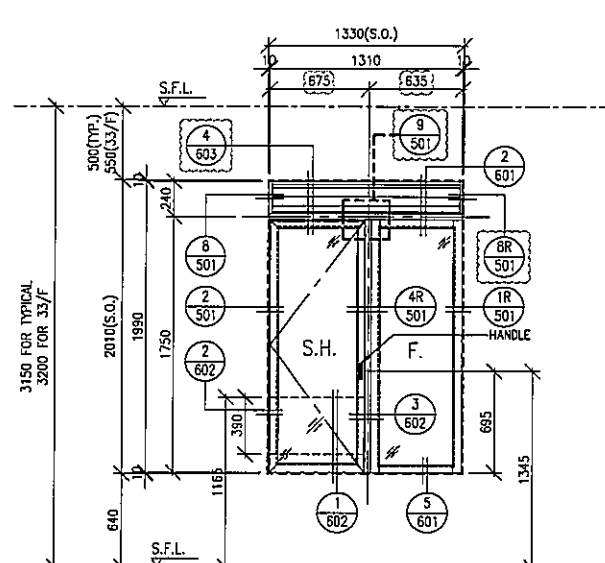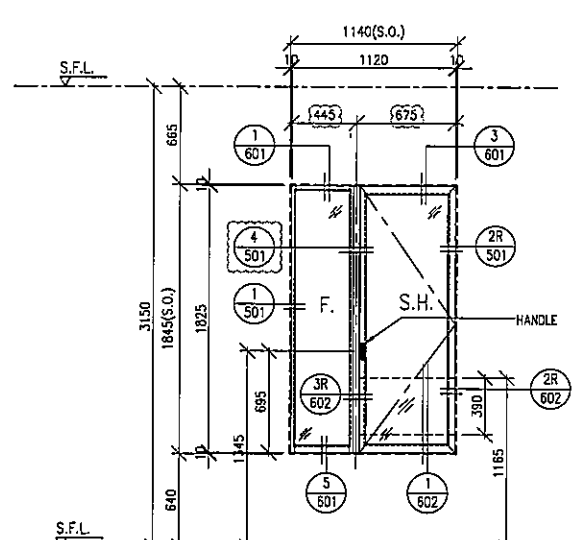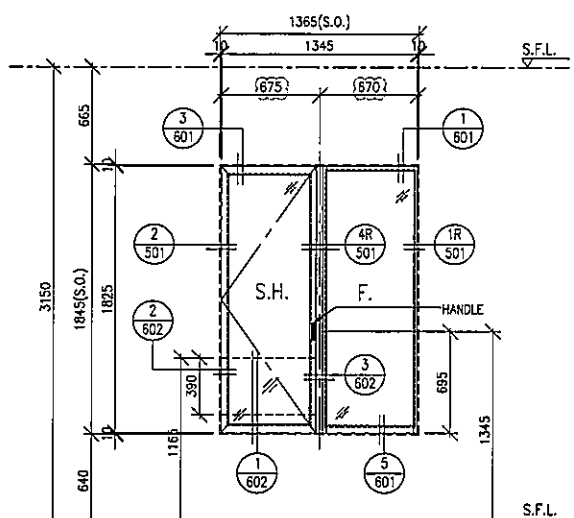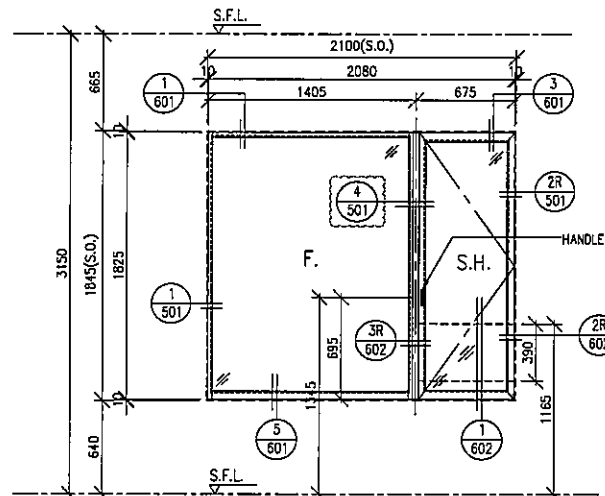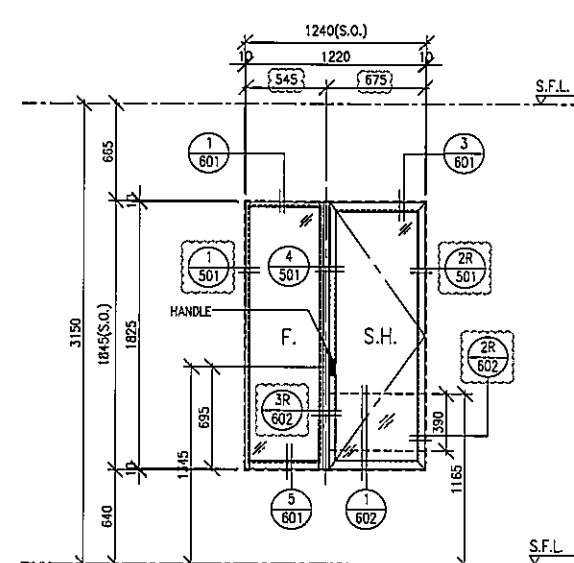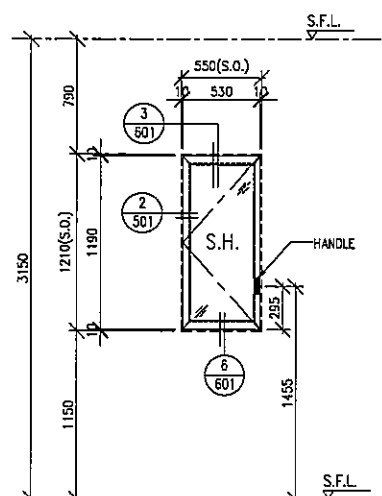
FREE AREA(%)	OPENABLE AREA	GLAZING AREA	OPENABLE AREA	GLAZING AREA	OPENABLE AREA	GLAZING AREA	B.D. REF :		
57%							F.S.D. REF :		
									Note : 1.All dimensions are in mm. 2.All elevations are viewed from outside. 3.All dimensions to be verified on site before fabrication.
WINDOW MARK	W2 T1 84 nos.		WINDOW MARK	W3 T1 27 nos.		WINDOW MARK	W4 T1 27 nos.		GENERAL NOTES Legend : 1. F.F.L-- Finished Floor Level 2. S.F.L-- Structural Floor Level 3. (R) -- Reversed Detail X1 -- DETAIL MARK NO. X001 -- REFER SHEET NO.
LOCATION	T1A FLAT E,G MBR. (1-31/F & 33/F ; 4,13,14,24/F OMITTED) T1 FLAT F MBR. (1-31/F & 33/F ; 4,13,14,24/F OMITTED)		LOCATION	T1A FLAT C BR3. (1-31/F; 4,13,14,24/F OMITTED)		LOCATION	T1A FLAT C BR2. (1-31/F; 4,13,14,24/F OMITTED)		
GLAZING	GL02	FRAME AL11	GLAZING	GL02	FRAME AL11	GLAZING	GL02	FRAME AL11	
REMARK	65mm ALUM. WINDOW SECTION		REMARK	65mm ALUM. WINDOW SECTION		REMARK	65mm ALUM. WINDOW SECTION		
OPENABLE AREA	GLAZING AREA		OPENABLE AREA	GLAZING AREA		OPENABLE AREA	GLAZING AREA		
									
WINDOW MARK	W6 T1 27 nos.		WINDOW MARK	W7 T1 27 nos.		WINDOW MARK	W8 T1 54 nos.		
LOCATION	T1 FLAT E MBR. (1-31/F; 4,13,14,24/F OMITTED)		LOCATION	T1 FLAT E BR2. (1-31/F; 4,13,14,24/F OMITTED)		LOCATION	T1A FLAT C M.BATH. (1-31/F; 4,13,14,24/F OMITTED) T1A FLAT C BATH1. (1-31/F; 4,13,14,24/F OMITTED)		
GLAZING	GL02	FRAME AL11	GLAZING	GL02	FRAME AL11	GLAZING	GL06	FRAME AL11	
REMARK	65mm ALUM. WINDOW SECTION		REMARK	65mm ALUM. WINDOW SECTION		REMARK	65mm ALUM. WINDOW SECTION		

B	XX.02.2020	GENERAL REVISION	
A	06.02.2020	GENERAL REVISION	
NO.	DATE	REVISED	BY

CLIENT :
佳明集團控股有限公司
 GRAND MING GROUP HOLDINGS LIMITED

MAIN CONTRACTOR :
GRAND TECH CONSTRUCTION CO. LTD.

ARCHITECT :
WONG TUNG & PARTNERS LIMITED
 ARCHITECTS & PLANNERS


STRUCTURAL ENGINEER :
 **C M WONG & ASSOCIATES LTD**

 **美特鋁質有限公司**
 MIDI ALUMINIUM FABRICATOR LTD.
 Units 6-8, Sunray Industrial Centre, 1/F
 610 Cha Kwo Ling Road, Kowloon
 Tel:23489211-4 Fax:(852)27727666

PROJECT :
 RESIDENTIAL DEVELOPMENT AT
 TSING YI TOWN LOT 190 SAI SHAN ROAD

TITLE :
 WINDOW SCHEDULE
 FOR PRECAST FACADE
 OF T1/T1A (1 OF 6)

JOB NO. : J-851
 DRAWN BY : C.H.P. DATE : 30-11-2019
 CHKD BY : SCALE A1: A3: 1:30
 DWG. NO. : J851-SCH-101 REV. : B

FREE AREA(%)	OPENABLE AREA	GLAZING AREA	WINDOW MARK	LOCATION	GLAZING	FRAME	AL11	REMARK
57%			W10 T1 27 nos.	T1 FLAT A M.BATH. (1-31/F; 4,13,14,24/F OMITTED)	GL06			65mm ALUM. WINDOW SECTION
			W11 T1 27 nos.	T1 FLAT D BATH1. (1-31/F; 4,13,14,24/F OMITTED)	GL06			65mm ALUM. WINDOW SECTION
			W13 T1 27 nos.	T1 FLAT A KIT. (1-32/F; 4,13,14,24/F OMITTED)	GL02			65mm ALUM. WINDOW SECTION
FREE AREA(%)	OPENABLE AREA	GLAZING AREA	WINDOW MARK	LOCATION	GLAZING	FRAME	AL11	REMARK
57%			W14 T1 26 nos.	T1 FLAT A STORE (2-31/F; 4,13,14,24/F OMITTED)	GL02			65mm ALUM. WINDOW SECTION
			W15 T1 26 nos.	T1A LOBBY CORRIDOR (2-31/F; 4,13,14,24/F OMITTED)	GL08			65mm ALUM. WINDOW SECTION
			W16 T1 54 nos.	T1 LOBBY CORRIDOR (1-31/F; 4,13,14,24/F OMITTED)	GL08			65mm ALUM. WINDOW SECTION

B.D. REF :
F.S.D. REF :
Note :
1. All dimensions are in mm.
2. All elevations are viewed from outside.
3. All dimensions to be verified on site before fabrication.

GENERAL NOTES

Legend :
1. F.F.L.-- Finished Floor Level
2. S.F.L.-- Structural Floor Level
3. (R) -- Reversed Detail

X1 -- DETAIL MARK NO.
X001 -- REFER SHEET NO.

B	XX.02.2020	GENERAL REVISION	
A	06.02.2020	GENERAL REVISION	
NO.	DATE	REVISED	BY

CLIENT :
佳明集團控股有限公司
GRAND WING GROUP HOLDINGS LIMITED

MAIN CONTRACTOR :
GRAND TECH CONSTRUCTION CO. LTD.

ARCHITECT :
WONG TUNG & PARTNERS LIMITED
ARCHITECTS & PLANNERS

STRUCTURAL ENGINEER :
C M WONG & ASSOCIATES LTD

英特鋁質有限公司
MIDI ALUMINIUM FABRICATOR LTD.
Units 6-8, Sunray Industrial Centre, 1/F
610 Cha Kwo Ling Road, Kowloon
Tel:23489211-4 Fax:(852)27727666

PROJECT :
RESIDENTIAL DEVELOPMENT AT
TSING YI TOWN LOT 190 SAI SHAN ROAD







TITLE :
WINDOW SCHEDULE
FOR PRECAST FACADE
OF T1/T1A (2 OF 6)

JOB NO. : J-851


DRAWN BY : C.H.P. DATE : 30-11-2019

CHKD BY : SCALE A1: 1:30

DWG. NO. : J851-SCH-102 REV. : B

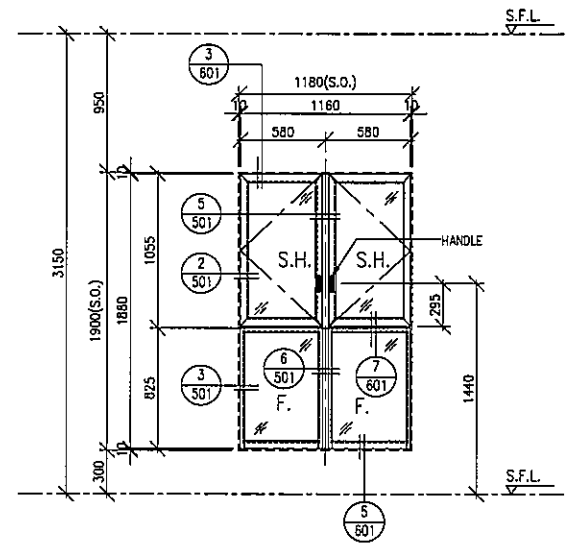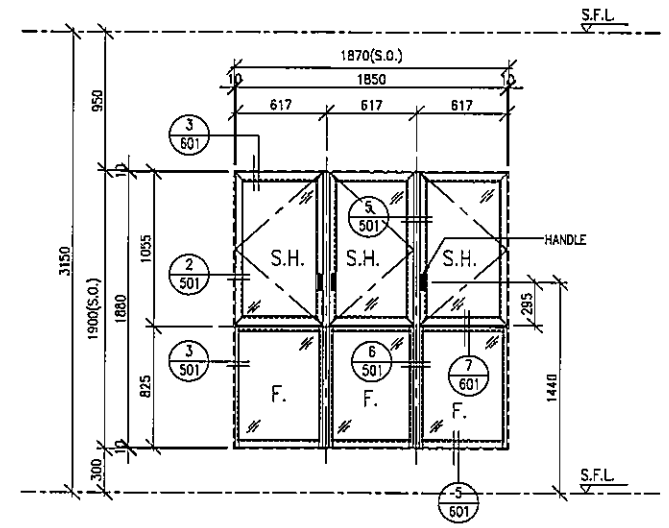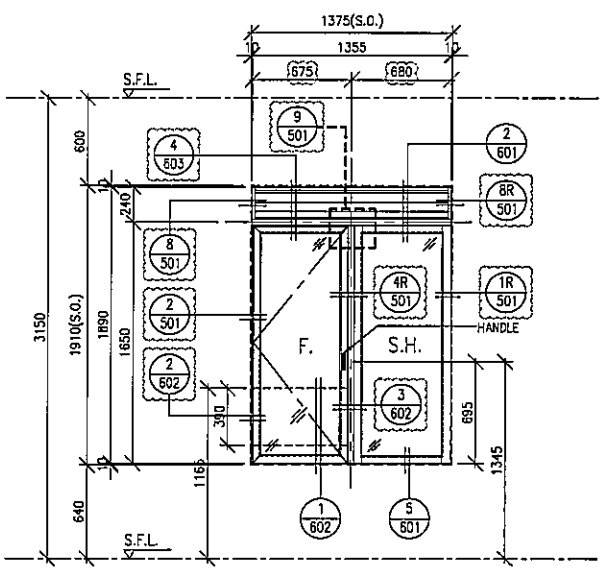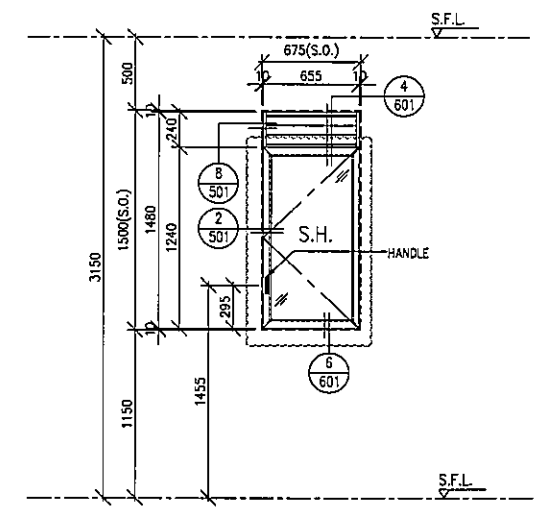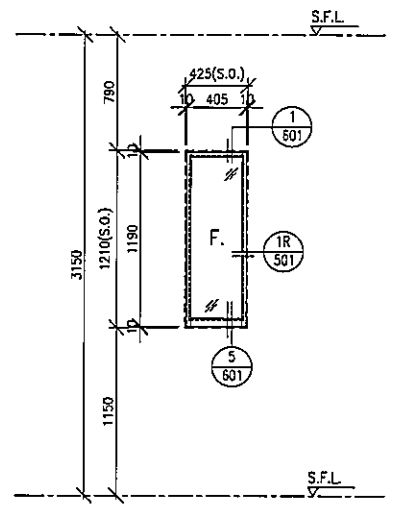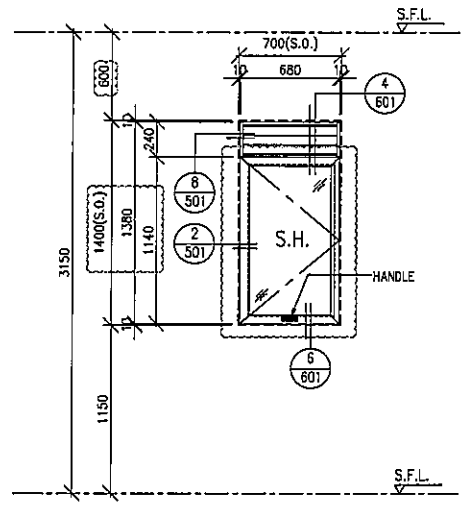

OPENABLE AREA	GLAZING AREA
---------------	--------------

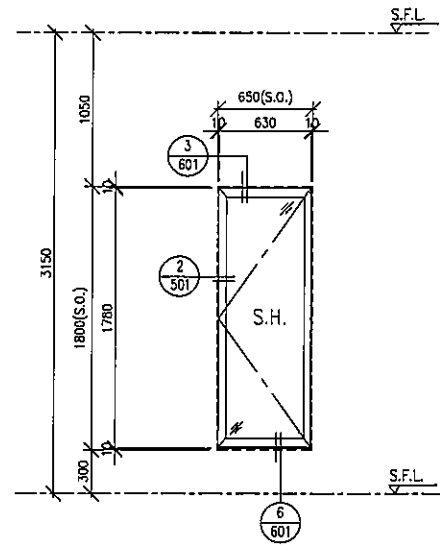


WINDOW MARK	W17 T1 27 nos.
-------------	-------------------

LOCATION	T1 LOBBY CORRIDOR (1-31/F; 4,13,14,24/F OMITTED)
----------	--

GLAZING	GL08	FRAME	AL11
---------	------	-------	------

REMARK	65mm ALUM. WINDOW SECTION
--------	---------------------------

FREE AREA(%)	OPENABLE AREA	GLAZING AREA
{57%}		

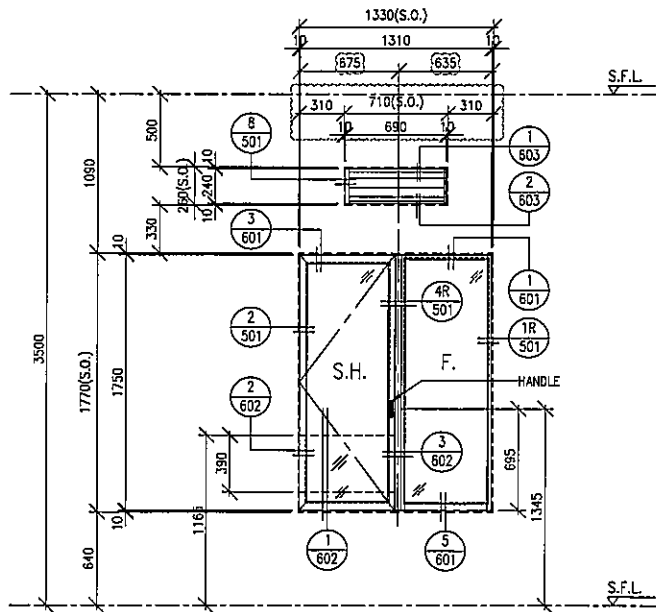

WINDOW MARK	W32 T1 3 nos.
-------------	------------------

LOCATION	T1A FLAT E.G MBR.(32/F) T1 FLAT F MBR.(32/F)
----------	---

GLAZING	GL02	FRAME	AL11
---------	------	-------	------

REMARK	65mm ALUM. WINDOW SECTION
--------	---------------------------


WINDOW MARK	
-------------	--

LOCATION	
----------	--

GLAZING		FRAME	
---------	--	-------	--

REMARK	
--------	--

OPENABLE AREA	GLAZING AREA
---------------	--------------

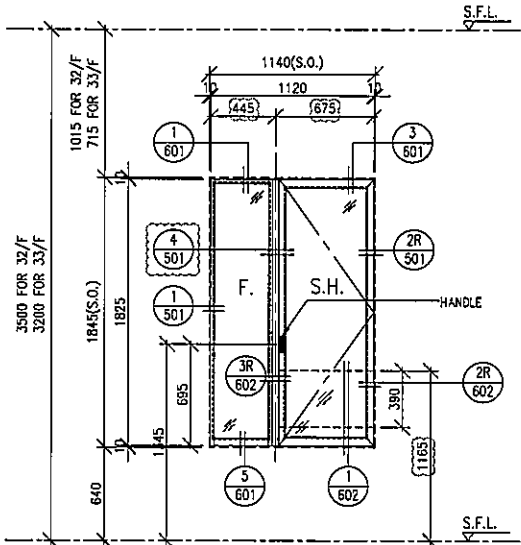

WINDOW MARK	W33 T1 2 nos.
-------------	------------------

LOCATION	T1A FLAT C BR3. (32-33/F)
----------	---------------------------

GLAZING	GL02	FRAME	AL11
---------	------	-------	------

REMARK	65mm ALUM. WINDOW SECTION
--------	---------------------------


WINDOW MARK	
-------------	--

LOCATION	
----------	--

GLAZING		FRAME	
---------	--	-------	--

REMARK	
--------	--

OPENABLE AREA	GLAZING AREA
---------------	--------------

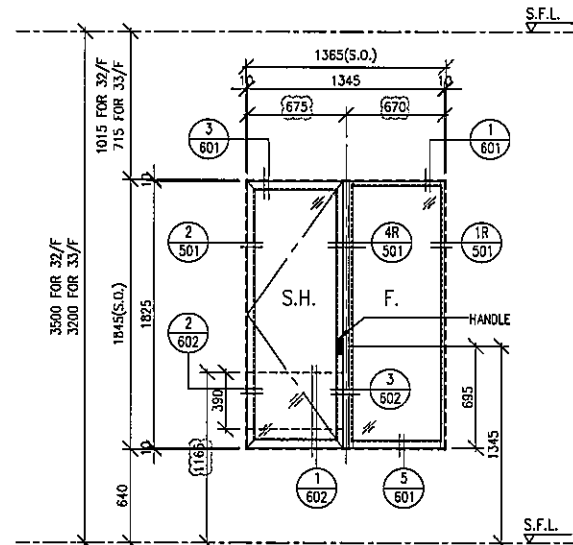

WINDOW MARK	W34 T1 2 nos.
-------------	------------------

LOCATION	T1A FLAT C BR2. (32-33/F)
----------	---------------------------

GLAZING	GL02	FRAME	AL11
---------	------	-------	------

REMARK	65mm ALUM. WINDOW SECTION
--------	---------------------------

B.D. REF :
F.S.D. REF :
Note :
1. All dimensions are in mm.
2. All elevations are viewed from outside.
3. All dimensions to be verified on site before fabrication.

GENERAL NOTES

Legend :
1. F.F.L--- Finished Floor Level
2. S.F.L--- Structural Floor Level
3. (R) --- Reversed Detail

X1 --- DETAIL MARK NO.
X001 --- REFER SHEET NO.

B	XX.02.2020	GENERAL REVISION
A	08.02.2020	GENERAL REVISION
NO.	DATE	REVISED BY

CLIENT :
佳明集團控股有限公司
GRAND MING GROUP HOLDINGS LIMITED

MAIN CONTRACTOR :
GRAND TECH CONSTRUCTION CO. LTD.

ARCHITECT :
WONG TUNG & PARTNERS LIMITED
ARCHITECTS & PLANNERS

STRUCTURAL ENGINEER :
C M WONG & ASSOCIATES LTD

美特鋁質有限公司
MIDI ALUMINUM FABRICATOR LTD.
Units 6-8, Sunray Industrial Centre, 1/F
610 Cha Kwo Ling Road, Kowloon
Tel:23489211-4 Fax:(852)27727666

PROJECT :
RESIDENTIAL DEVELOPMENT AT
TSING YI TOWN LOT 190 SAI SHAN ROAD

TITLE :
WINDOW SCHEDULE
FOR PRECAST FACADE
OF T1/T1A (3 OF 5)










JOB NO. : J-851

DRAWN BY : C.H.P. DATE : 30-11-2019

CHKD BY : SCALE A1: 1:30

DWG. NO. : J851-SCH-103 REV. : B

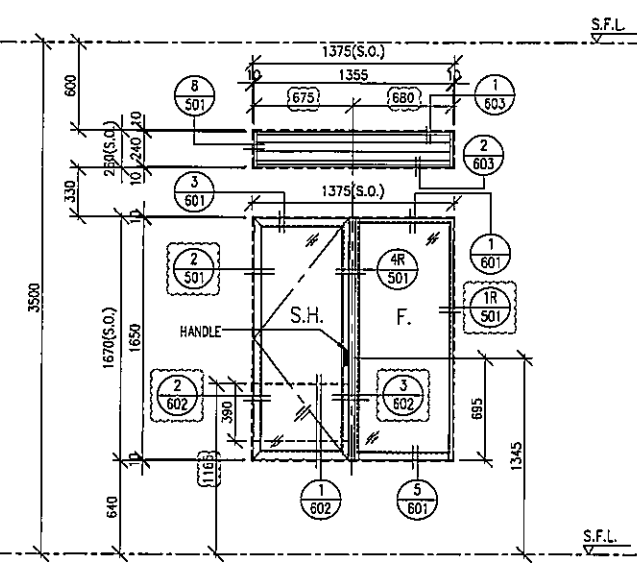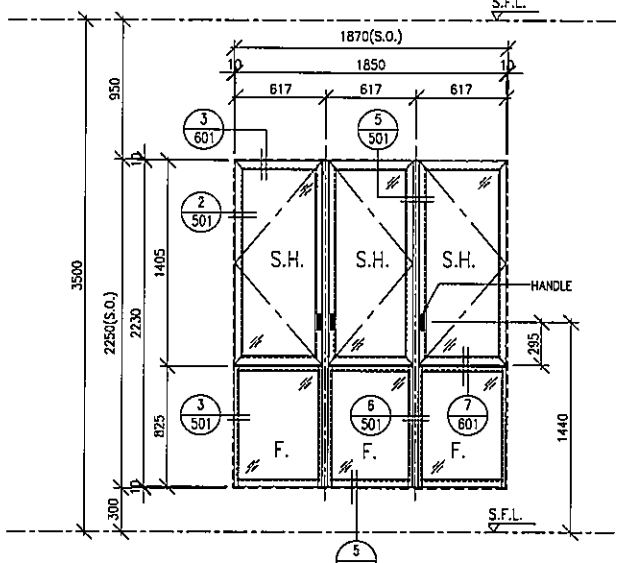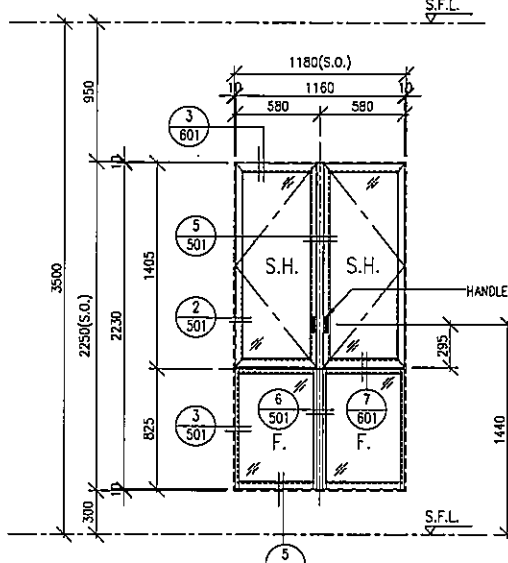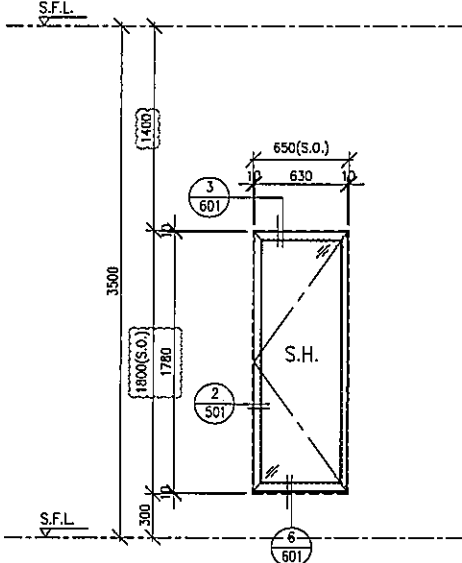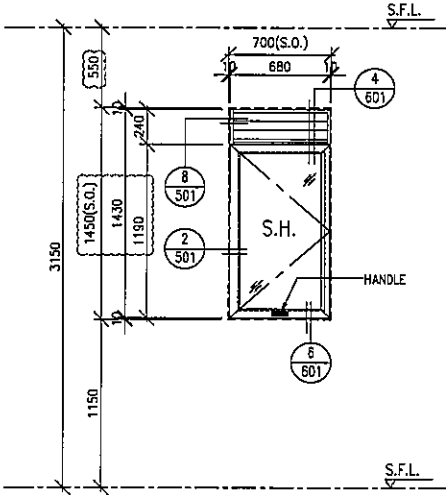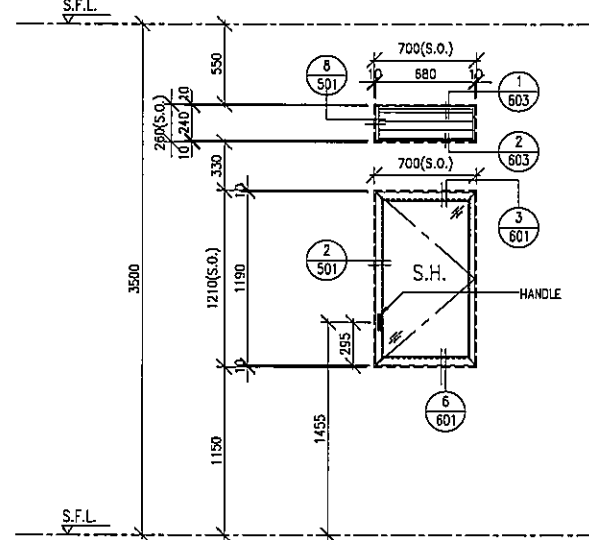OPENABLE AREA	GLAZING AREA	OPENABLE AREA	GLAZING AREA	OPENABLE AREA	GLAZING AREA	B.D. REF :
						F.S.D. REF :
WINDOW MARK	W36 T1 2 nos.		WINDOW MARK	W37 T1 2 nos.		Note :
LOCATION	T1 FLAT E MBR. (32-33/F)		LOCATION	T1 FLAT E BR2. (32-33/F)		1. All dimensions are in mm.
GLAZING	GL02	FRAME AL11	GLAZING	GL02	FRAME AL11	2. All elevations are viewed from outside.
REMARK	65mm ALUM. WINDOW SECTION		REMARK	65mm ALUM. WINDOW SECTION		3. All dimensions to be verified on site before fabrication.
FREE AREA(%)	OPENABLE AREA	GLAZING AREA	GLAZING AREA	FREE AREA(%)	OPENABLE AREA	GENERAL NOTES
{57%}				{57%}		Legend :
						1. F.F.L.-- Finished Floor Level
WINDOW MARK	W40 T1 1 no.		WINDOW MARK	W41 T1 1 no.		2. S.F.L.-- Structural Floor Level
LOCATION	T1 FLAT A M.BATH. (32/F)		LOCATION	T1 FLAT D BATH1. (32/F)		3. (R) -- Reversed Detail
GLAZING	GL06	FRAME AL11	GLAZING	GL06	FRAME AL11	X1 -- DETAIL MARK NO.
REMARK	65mm ALUM. WINDOW SECTION		REMARK	65mm ALUM. WINDOW SECTION		X001 -- REFER SHEET NO.
						CLIENT :
						佳明集團控股有限公司 GRAND MING GROUP HOLDINGS LIMITED
						MAIN CONTRACTOR :
						GRAND TECH CONSTRUCTION CO.LTD.
						ARCHITECT :
						WONG TUNG & PARTNERS LIMITED ARCHITECTS & PLANNERS
						STRUCTURAL ENGINEER :
						C M WONG & ASSOCIATES LTD
						美特鋁質有限公司 MIDI ALUMINIUM FABRICATOR LTD.
						Units 5-8, Sunray Industrial Centre, 1/F 610 Cha Kwo Ling Road, Kowloon Tel:23489211-4 Fax:(852)27727656
						PROJECT :
						RESIDENTIAL DEVELOPMENT AT TSING YI TOWN LOT 190 SAI SHAN ROAD
						TITLE :
						WINDOW SCHEDULE FOR PRECAST FACADE OF T1/T1A (4 OF 6)
						JOB NO. : J-851
						DRAWN BY : C.H.P. DATE : 30-11-2019
						CHKD BY : SCALE A1: A3: 1:30
						DWG. NO. : J851-SCH-104 REV. : B

FREE AREA(%)	OPENABLE AREA	GLAZING AREA	OPENABLE AREA	GLAZING AREA	OPENABLE AREA	GLAZING AREA	B.D. REF :		
{57%}							F.S.D. REF :		
									Note : 1. All dimensions are in mm. 2. All elevations are viewed from outside. 3. All dimensions to be verified on site before fabrication.
WINDOW MARK	W44 T1 1 nos.		WINDOW MARK	W45 T1 2 nos.		WINDOW MARK	W46 T1 4 nos.		GENERAL NOTES Legend : 1. F.F.L. --- Finished Floor Level 2. S.F.L. --- Structural Floor Level 3. (R) --- Reversed Detail X1 --- DETAIL MARK NO. X001 --- REFER SHEET NO.
LOCATION	T1 FLAT A STORE (32/F)		LOCATION	T1A LOBBY CORRIDOR (32-33/F)		LOCATION	T1 LOBBY CORRIDOR (32-33/F)		
GLAZING	GLO2	FRAME AL11	GLAZING	GLO8	FRAME AL11	GLAZING	GLO8	FRAME AL11	
REMARK	65mm ALUM. WINDOW SECTION		REMARK	65mm ALUM. WINDOW SECTION		REMARK	65mm ALUM. WINDOW SECTION		
OPENABLE AREA	GLAZING AREA	FREE AREA(%)	OPENABLE AREA	GLAZING AREA	FREE AREA(%)	OPENABLE AREA	GLAZING AREA	CLIENT :	
		{57%}			{57%}			佳明集團控股有限公司 GRAND WING GROUP HOLDINGS LIMITED	
									MAIN CONTRACTOR : GRAND TECH CONSTRUCTION CO. LTD.
WINDOW MARK	W47 T1 2 nos.		WINDOW MARK	W10A T1 52 nos.		WINDOW MARK	W40A T1 2 nos.		ARCHITECT : WONG TUNG & PARTNERS LIMITED ARCHITECTS & PLANNERS 
LOCATION	T1 LOBBY CORRIDOR (32-33/F)		LOCATION	T1 FLAT D M.BATH. (2-31/F; 4,13,14,24/F OMITTED)		LOCATION	T1 FLAT D M.BATH. (32/F)		STRUCTURAL ENGINEER :  C M WONG & ASSOCIATES LTD
GLAZING	GLO6	FRAME AL11	GLAZING	GLO6	FRAME AL11	GLAZING	GLO6	FRAME AL11	 美特鋁質有限公司 MIDI ALUMINIUM FABRICATOR LTD. Units 6-8, Sunray Industrial Centre, 1/F 610 Cha Kwo Ling Road, Kowloon Tel:23489211-4 Fax:(852)27727666
REMARK	65mm ALUM. WINDOW SECTION		REMARK	65mm ALUM. WINDOW SECTION		REMARK	65mm ALUM. WINDOW SECTION		PROJECT : RESIDENTIAL DEVELOPMENT AT TSING YI TOWN LOT 190 SAI SHAN ROAD
						TITLE : WINDOW SCHEDULE FOR PRECAST FACADE OF T1/T1A (5 OF 6)			
						JOB NO. : J-851			
						DRAWN BY : C.H.P. DATE : 30-11-2019			
						CHKD BY : SCALE A1: A3: 1:30			
						DWG. NO. : J851-SCH-105 REV. : B			

FREE AREA(%)	OPENABLE AREA	FREE AREA(%)	OPENABLE AREA	FREE AREA(%)	OPENABLE AREA	GLAZING AREA	B.D. REF :
{57%}		{57%}					F.S.D. REF :
GLAZING AREA		GLAZING AREA					Note :
							1. All dimensions are in mm. 2. All elevations are viewed from outside. 3. All dimensions to be verified on site before fabrication.
WINDOW MARK	W60 T1 2 nos.	MIR. W60A T1 1 nos.		WINDOW MARK	W60 T1 1 nos.		GENERAL NOTES
LOCATION	T1 FLAT A UTILITY RM (35/F)	T1 FLAT A POWDER ROOM (35/F)		LOCATION	T1 FLAT B UTILITY RM (35/F)		Legend :
GLAZING	GL06	FRAME	AL11	GLAZING	GL06	FRAME	1. F.F.L.-- Finished Floor Level 2. S.F.L.-- Structural Floor Level 3. (R) -- Reversed Detail
REMARK	65mm ALUM. WINDOW SECTION			REMARK	65mm ALUM. WINDOW SECTION		X1 -- DETAIL MARK NO. X001 -- REFER SHEET NO.
GLAZING AREA				GLAZING AREA			
WINDOW MARK	W66 T1 1 nos.			WINDOW MARK	W72 T1 1 nos.		CLIENT :
LOCATION	T1 FLAT B UTILITY RM (35/F)			LOCATION	T1 FLAT B LV. & DIN. (35/F)		佳明集團控股有限公司 GRAND WING GROUP HOLDINGS LIMITED
GLAZING	GL06	FRAME	AL11	GLAZING	GL02	FRAME	MAIN CONTRACTOR :
REMARK	65mm ALUM. WINDOW SECTION			REMARK	65mm ALUM. WINDOW SECTION		GRAND TECH CONSTRUCTION CO. LTD.
GLAZING AREA				GLAZING AREA			ARCHITECT :
							WONG TUNG & PARTNERS LIMITED ARCHITECTS & PLANNERS
WINDOW MARK	W66 T1 1 nos.			WINDOW MARK	W72 T1 1 nos.		STRUCTURAL ENGINEER :
LOCATION	T1 FLAT B UTILITY RM (35/F)			LOCATION	T1 FLAT A M.BATH1. (33/F)		C M WONG & ASSOCIATES LTD
GLAZING	GL06	FRAME	AL11	GLAZING	GL06	FRAME	美特鋁質有限公司 MIDI ALUMINIUM FABRICATOR LTD.
REMARK	65mm ALUM. WINDOW SECTION			REMARK	65mm ALUM. WINDOW SECTION		Units 6-8, Sunray Industrial Centre, 1/F 810 Cha Kwo Ling Road, Kowloon Tel:23489211-4 Fax:(852)2727666
GLAZING AREA				GLAZING AREA			PROJECT :
							RESIDENTIAL DEVELOPMENT AT TSING YI TOWN LOT 190 SAI SHAN ROAD
WINDOW MARK	W66 T1 1 nos.			WINDOW MARK	W72 T1 1 nos.		TITLE :
LOCATION	T1 FLAT B UTILITY RM (35/F)			LOCATION	T1 FLAT B LV. & DIN. (35/F)		WINDOW SCHEDULE FOR PRECAST FACADE OF T1/T1A (6 OF 6)
GLAZING	GL06	FRAME	AL11	GLAZING	GL02	FRAME	JOB NO. : J-851
REMARK	65mm ALUM. WINDOW SECTION			REMARK	65mm ALUM. WINDOW SECTION		DRAWN BY : C.H.P. DATE : 30-11-2019
GLAZING AREA				GLAZING AREA			CHKD BY : SCALE A1: A3: 1:30
							DWG. NO. : JB51-SCH-106 REV. : B

FREE AREA(%) {57%}		FREE AREA(%) {57%}		FREE AREA(%) {57%}		B.D. REF :	
						B.S.D. REF :	
WINDOW MARK L23 T1 29 nos.		WINDOW MARK L24 T1 28 nos.		WINDOW MARK L26 T1 28 nos.		F.S.D. REF :	
LOCATION T1A FLAT C M.BATH. (1-33/F; 4,13,14,24/F OMITTED)		LOCATION T1 FLAT A KIT. (1-32/F; 4,13,14,24/F OMITTED)		LOCATION T1 LOBBY CORRIDOR (1-32/F; 4,13,14,24/F OMITTED)		Note :	
GLAZING FRAME AL11		GLAZING FRAME AL11		GLAZING FRAME AL11		1. All dimensions are in mm. 2. All elevations are viewed from outside. 3. All dimensions to be verified on site before fabrication.	
REMARK 65mm ALUM. WINDOW SECTION		REMARK 65mm ALUM. WINDOW SECTION		REMARK 65mm ALUM. WINDOW SECTION		GENERAL NOTES	
FREE AREA(%) 52.6%						Legend :	
						1. F.F.L.-- Finished Floor Level 2. S.F.L.-- Structural Floor Level 3. (R) --- Reversed Detail	
WINDOW MARK L27 T1 29 nos.		WINDOW MARK		WINDOW MARK		X1 --- DETAIL MARK NO. X001 --- REFER SHEET NO.	
LOCATION T1 FLAT E BATH. (1-33/F; 4,13,14,24/F OMITTED)		LOCATION		LOCATION		B XX.02.2020 GENERAL REVISION A 05.02.2020 GENERAL REVISION NO. DATE REVISED BY	
GLAZING FRAME AL11		GLAZING FRAME		GLAZING FRAME		CLIENT :	
REMARK 65mm ALUM. WINDOW SECTION		REMARK		REMARK		佳明集團控股有限公司 GRAND MING GROUP HOLDINGS LIMITED	
						MAIN CONTRACTOR :	
						GRAND TECH CONSTRUCTION CO. LTD.	
						ARCHITECT :	
						WONG TUNG & PARTNERS LIMITED ARCHITECTS & PLANNERS 	
						STRUCTURAL ENGINEER :	
						C M WONG & ASSOCIATES LTD	
						美特鋁質有限公司 MIDI ALUMINIUM FABRICATOR LTD. Units 6-8, Sunray Industrial Centre, 1/F 510 Cha Kwo Ling Road, Kowloon Tel:23489211-4 Fax:(852)27727656	
						PROJECT :	
						RESIDENTIAL DEVELOPMENT AT TSING YI TOWN LOT 190 SAI SHAN ROAD	
						TITLE :	
						LOUVRE SCHEDULE FOR PRECAST FACADE OF T1/T1A	
						JOB NO. : J-851	
						DRAWN BY : C.H.P. DATE : 30-11-2019	
						CHKD BY : SCALE A1: A3: 1:30	
						DWG. NO. : J851-SCH-107 REV. : B	

FREE AREA(%)	OPENABLE AREA	GLAZING AREA
57%		

WINDOW MARK	W2 T1 MIR. 84 nos.
LOCATION	T1A FLAT D.F. MBR. (1-31/F & 33/F ; 4,13,14,24/F OMITTED) T1 FLAT G MBR. (1-31/F & 33/F ; 4,13,14,24/F OMITTED)
GLAZING	GL02 FRAME AL11
REMARK	65mm ALUM. WINDOW SECTION

FREE AREA(%)	OPENABLE AREA	GLAZING AREA
57%		

WINDOW MARK	W32 T1 MIR. 3 nos.
LOCATION	T1A FLAT D.F. MBR.(32/F) T1 FLAT G MBR.(32/F)
GLAZING	GL02 FRAME AL11
REMARK	65mm ALUM. WINDOW SECTION

B.D. REF :
F.S.D. REF :
Note :
1. All dimensions are in mm.
2. All elevations are viewed from outside.
3. All dimensions to be verified on site before fabrication.

GENERAL NOTES
Legend :
1. F.F.L. --- Finished Floor Level
2. S.F.L. --- Structural Floor Level
3. (R) --- Reversed Detail
X1 --- DETAIL MARK NO.
X001 --- REFER SHEET NO.

NO.	DATE	REVISED	BY

CLIENT :
佳明集團控股有限公司
GRAND MING GROUP HOLDINGS LIMITED

MAIN CONTRACTOR :
GRAND TECH CONSTRUCTION CO. LTD.

ARCHITECT :
WONG TUNG & PARTNERS LIMITED
ARCHITECTS & PLANNERS

STRUCTURAL ENGINEER :
C M WONG & ASSOCIATES LTD

美特鋁質有限公司
MIDI ALUMINIUM FABRICATOR LTD.
Units 6-8, Sunray Industrial Centre, 1/F
610 Cha Kwo Ling Road, Kowloon
Tel:23489211-4 Fax:(852)27727666

PROJECT :
RESIDENTIAL DEVELOPMENT AT
TSING YI TOWN LOT 190 SAI SHAN ROAD






TITLE :
WINDOW SCHEDULE
FOR PRECAST FACADE
OF T1/T1A

JOB NO. : J-851

DRAWN BY : C.H.P. DATE : 30-11-2019

CHKD BY : SCALE A1:
A3: 1:30

DWG. NO. : JB51-SCH-101a REV. : --

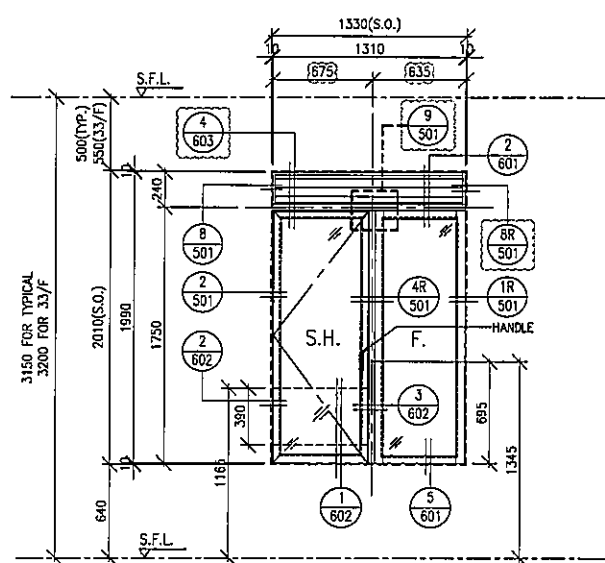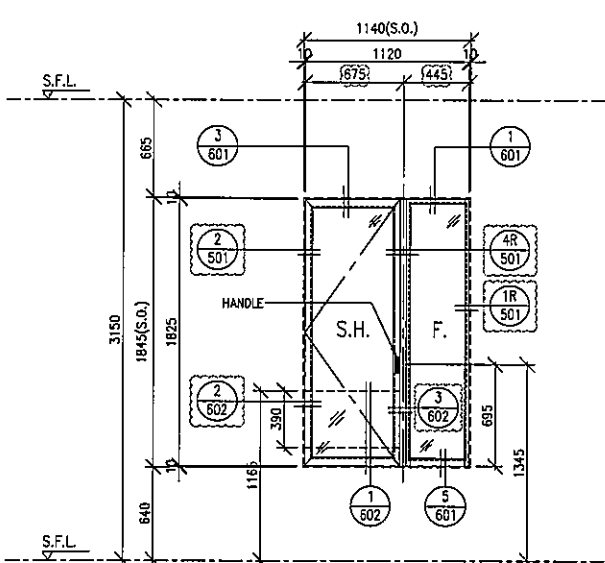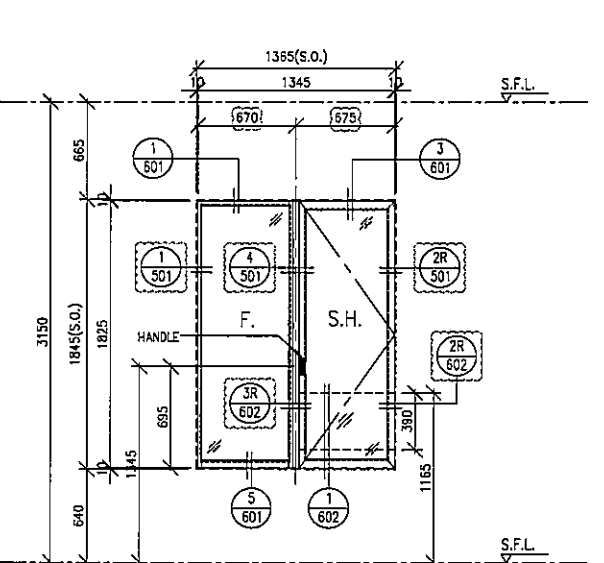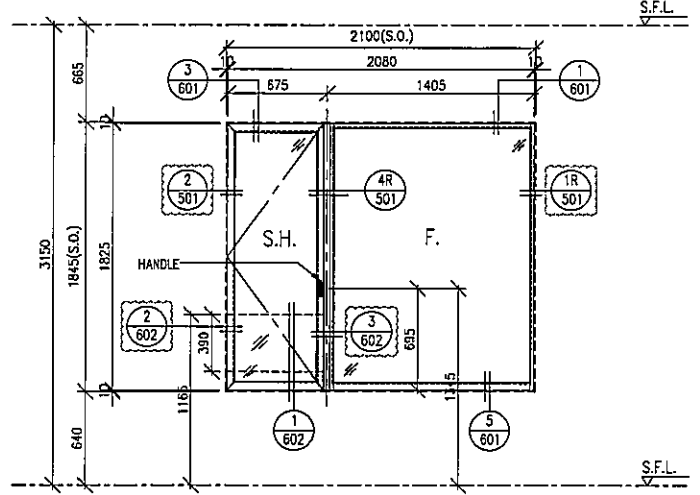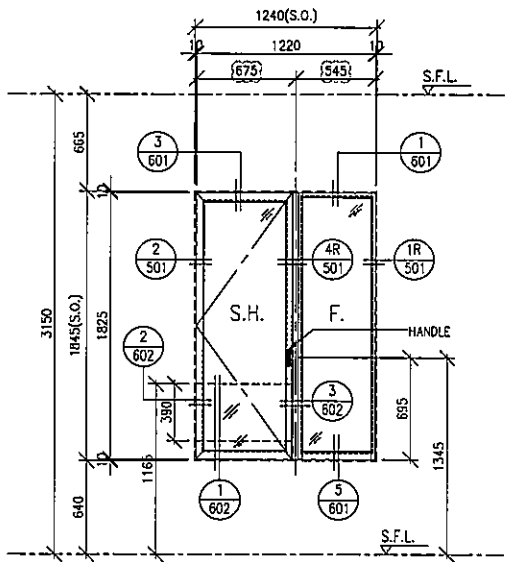FREE AREA(%)	OPENABLE AREA	GLAZING AREA	OPENABLE AREA	GLAZING AREA	OPENABLE AREA	GLAZING AREA		
{57%}								
								
WINDOW MARK	W2 T2 81 nos.		WINDOW MARK	W3 T2 26 nos.		WINDOW MARK	W4 T2 26 nos.	
LOCATION	T2A FLAT C,D MBR. (2-31/F & 33/F ; 4,13,14,24/F OMITTED) T2 FLAT H MBR. (2-31/F & 33/F ; 4,13,14,24/F OMITTED)		LOCATION	T2A FLAT B BR3.(2-31/F; 4,13,14,24/F OMITTED)		LOCATION	T2A FLAT B BR2.(2-31/F; 4,13,14,24/F OMITTED)	
GLAZING	GLO2	FRAME AL11	GLAZING	GLO2	FRAME AL11	GLAZING	GLO2	FRAME AL11
REMARK	65mm ALUM. WINDOW SECTION		REMARK	65mm ALUM. WINDOW SECTION		REMARK	65mm ALUM. WINDOW SECTION	
OPENABLE AREA	GLAZING AREA		OPENABLE AREA	GLAZING AREA		OPENABLE AREA	GLAZING AREA	
								
WINDOW MARK	W6 T2 26 nos.		WINDOW MARK	W7 T2 26 nos.		WINDOW MARK		
LOCATION	T2 FLAT E MBR.(2-31/F; 4,13,14,24/F OMITTED)		LOCATION	T2 FLAT E BR2.(2-31/F; 4,13,14,24/F OMITTED)		LOCATION		
GLAZING	GLO2	FRAME AL11	GLAZING	GLO2	FRAME AL11	GLAZING		FRAME
REMARK	65mm ALUM. WINDOW SECTION		REMARK	65mm ALUM. WINDOW SECTION		REMARK		

B.D. REF :
F.S.D. REF :
Note :
1.All dimensions are in mm.
2.All elevations are viewed from outside.
3.All dimensions to be verified on site before fabrication.


GENERAL NOTES
Legend :
1. F.F.L--- Finished Floor Level
2. S.F.L--- Structural Floor Level
3. (R) --- Reversed Detail
X1 --- DETAIL MARK NO.
X001 --- REFER SHEET NO.

NO.	DATE	REVISION	BY
B	20.02.2020	GENERAL REVISION	
A	08.02.2020	GENERAL REVISION	

CLIENT :
佳明集團控股有限公司
GRAND MING GROUP HOLDINGS LIMITED

MAIN CONTRACTOR :
GRAND TECH CONSTRUCTION CO. LTD.

ARCHITECT :
WONG TUNG & PARTNERS LIMITED
ARCHITECTS & PLANNERS


STRUCTURAL ENGINEER :
 C M WONG & ASSOCIATES LTD

 美特鋁質有限公司
MIDI ALUMINUM FABRICATOR LTD.
Units 6-8, Sunray Industrial Centre, 1/F
610 Cha Kwo Ling Road, Kowloon
Tel:23489211-4 Fax:(852)2772666

PROJECT :
RESIDENTIAL DEVELOPMENT AT
TSING YI TOWN LOT 190 SAI SHAN ROAD

TITLE :
WINDOW SCHEDULE
FOR PRECAST FACADE
OF T2/T2A (1 OF 6)

JOB NO. : J-851
DRAWN BY : C.H.P. DATE : 30-11-2019
CHKD BY : SCALE A1: 1:30
A3: 1:30
DWG. NO. : J851-SCH-201 REV. : B

FREE AREA(%)	GLAZING AREA	OPENABLE AREA	GLAZING AREA	FREE AREA(%)	GLAZING AREA	OPENABLE AREA		
{57%}				{57%}				
WINDOW MARK	W10 T2 53 nos.		WINDOW MARK	W11 T2 26 nos.		WINDOW MARK	W13 T2 52 nos.	
LOCATION	T2 FLAT A M.BATH.(1-31/F; 4,13,14,24/F OMITTED) T2 FLAT D M.BATH.(2-31/F; 4,13,14,24/F OMITTED)		LOCATION	T2 FLAT D BATH1.(2-31/F; 4,13,14,24/F OMITTED)		LOCATION	T2 FLAT A KIT.(2-31/F; 4,13,14,24/F OMITTED) T2A FLAT A KIT.(2-31/F; 4,13,14,24/F OMITTED)	
GLAZING	GLO6	FRAME AL11	GLAZING	GLO6	FRAME AL11	GLAZING	GLO2	FRAME AL11
REMARK	65mm ALUM. WINDOW SECTION		REMARK	65mm ALUM. WINDOW SECTION		REMARK	65mm ALUM. WINDOW SECTION	
			OPENABLE AREA	GLAZING AREA				
WINDOW MARK	W15 T2 27 nos.		WINDOW MARK	W16 T2 52 nos.				
LOCATION	T2A LOBBY CORRIDOR(1-31/F; 4,13,14,24/F OMITTED)		LOCATION	T2 LOBBY CORRIDOR(2-31/F; 4,13,14,24/F OMITTED)				
GLAZING		FRAME	GLAZING	GLO8	FRAME AL11	GLAZING	GLO8	FRAME AL11
REMARK			REMARK	65mm ALUM. WINDOW SECTION		REMARK	65mm ALUM. WINDOW SECTION	

B.D. REF :
F.S.D. REF :
Note :
1. All dimensions are in mm.
2. All elevations are viewed from outside.
3. All dimensions to be verified on site before fabrication.

GENERAL NOTES
Legend :
1. F.F.L.-- Finished Floor Level
2. S.F.L.-- Structural Floor Level
3. (R) -- Reversed Detail
X1 -- DETAIL MARK NO.
X001 -- REFER SHEET NO.

B	XX.02.2020	GENERAL REVISION	
A	08.02.2020	GENERAL REVISION	
NO.	DATE	REVISED	BY

CLIENT :
佳明集團控股有限公司
GRAND NING GROUP HOLDINGS LIMITED

MAIN CONTRACTOR :
GRAND TECH CONSTRUCTION CO. LTD.

ARCHITECT :
WONG TUNG & PARTNERS LIMITED
ARCHITECTS & PLANNERS






STRUCTURAL ENGINEER :
C M WONG & ASSOCIATES LTD

美特鋁質有限公司
MIDI ALUMINIUM FABRICATOR LTD.
Units 6-8, Sunray Industrial Centre, 1/F
610 Cha Kwo Ling Road, Kowloon
Tel:23489211-4 Fax:(852)27727666

PROJECT :
RESIDENTIAL DEVELOPMENT AT
TSING YI TOWN LOT 190 SAI SHAN ROAD

TITLE :
WINDOW SCHEDULE
FOR PRECAST FACADE
OF T2/T2A (2 OF 6)

JOB NO. : J-851
DRAWN BY : C.H.P. DATE : 30-11-2019
CHKD BY : SCALE A1: A3: 1:30
DWG. NO. : J851-SCH-202 REV. : B

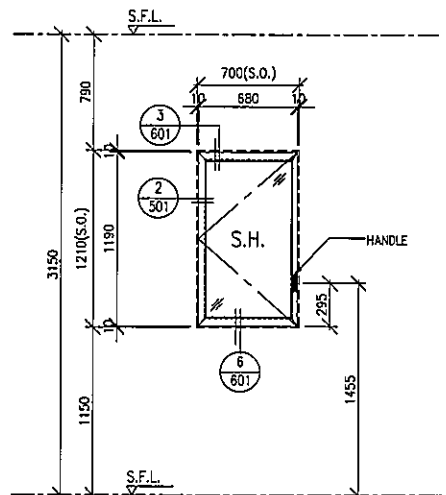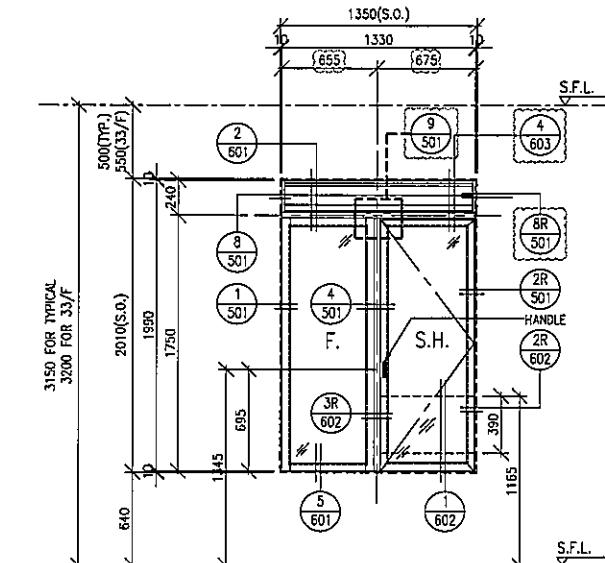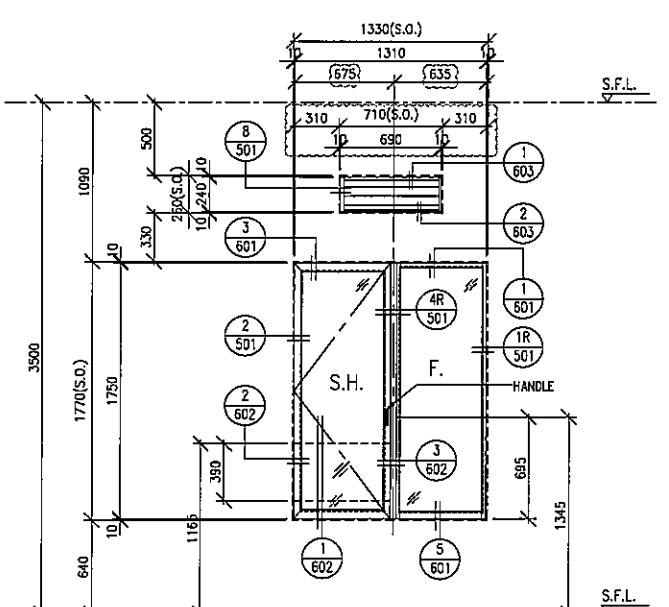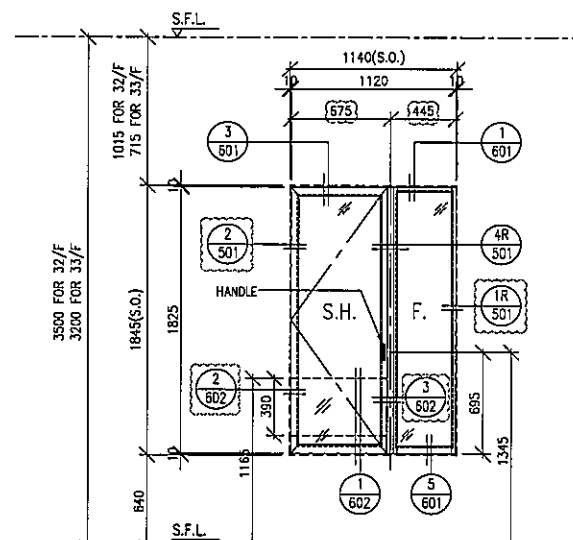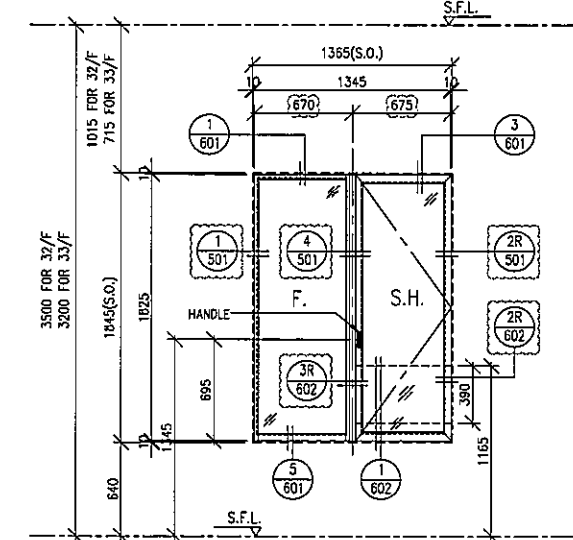FREE AREA(%)				OPENABLE AREA				GLAZING AREA			
57%											
											
WINDOW MARK				WINDOW MARK				WINDOW MARK			
W22 T2				W23 T2				W32 T2			
26 nos.				28 nos.				3 nos.			
LOCATION				LOCATION				LOCATION			
T2A FLAT B M.BATH.(2-31/F; 4,13,14,24/F OMITTED)				T2 FLAT F MBR.(1-31/F & 33/F ; 4,13,14,24/F OMITTED)				T2A FLAT C.D MBR.(32/F) T2 FLAT H MBR.(32/F)			
GLAZING				GLAZING				GLAZING			
GLO6				GLO2				GLO2			
FRAME				FRAME				FRAME			
AL11				AL11				AL11			
REMARK				REMARK				REMARK			
65mm ALUM. WINDOW SECTION				65mm ALUM. WINDOW SECTION				65mm ALUM. WINDOW SECTION			
FREE AREA(%)				OPENABLE AREA				GLAZING AREA			
57%											
											
WINDOW MARK				WINDOW MARK				WINDOW MARK			
W33 T2				W34 T2							
2 nos.				2 nos.							
LOCATION				LOCATION				LOCATION			
T2A FLAT B BR3. (32-33/F)				T2A FLAT B BR2. (32-33/F)							
GLAZING				GLAZING				GLAZING			
GLO2				GLO2				GLO2			
FRAME				FRAME				FRAME			
AL11				AL11				AL11			
REMARK				REMARK				REMARK			
65mm ALUM. WINDOW SECTION				65mm ALUM. WINDOW SECTION				65mm ALUM. WINDOW SECTION			

B.D. REF :
F.S.D. REF :
Note:
1.All dimensions are in mm.
2.All elevations are viewed from outside.
3.All dimensions to be verified on site before fabrication.

GENERAL NOTES
Legend:
1. F.F.L-- Finished Floor Level
2. S.F.L-- Structural Floor Level
3. (R) -- Reversed Detail
X1 -- DETAIL MARK NO.
X001 -- REFER SHEET NO.

B	06.02.2020	GENERAL REVISION	
A	06.02.2020	GENERAL REVISION	
NO.	DATE	REVISED	BY

CLIENT :
佳明集團控股有限公司
GRAND MING GROUP HOLDINGS LIMITED

MAIN CONTRACTOR :
GRAND TECH CONSTRUCTION CO. LTD.

ARCHITECT :
WONG TUNG & PARTNERS LIMITED
ARCHITECTS & PLANNERS

STRUCTURAL ENGINEER :
C M WONG & ASSOCIATES LTD

美特鋁質有限公司
MIDI ALUMINIUM FABRICATOR LTD.
Units 6-8, Sunray Industrial Centre, 1/F
510 Cha Kwo Ling Road, Kowloon
Tel:23469211-4 Fax:(852)27727666

PROJECT :
RESIDENTIAL DEVELOPMENT AT
TSING YI TOWN LOT 190 SAI SHAN ROAD

TITLE :
WINDOW SCHEDULE
FOR PRECAST FACADE
OF T2/T2A (3 OF 6)

JOB NO. : J-851
DRAWN BY : C.H.P. DATE : 30-11-2019
CHKD BY : SCALE A1: A3: 1:30
DWC NO. : J851-SCH-203 REV. : B

OPENABLE AREA	GLAZING AREA	OPENABLE AREA	GLAZING AREA	FREE AREA(%)	OPENABLE AREA	GLAZING AREA			
				{57%}					
WINDOW MARK	W36 T2 2 nos.		WINDOW MARK	W37 T2 2 nos.		WINDOW MARK	W38 T2 1 nos.		
LOCATION	T2 FLAT E MBR. (32-33/F)		LOCATION	T2 FLAT E BR2. (32-33/F)		LOCATION	T2 FLAT B M.BATH. (33/F)		
GLAZING	GLO2	FRAME AL11	GLAZING	GLO2	FRAME AL11	GLAZING	GLO6	FRAME AL11	
REMARK	65mm ALUM. WINDOW SECTION		REMARK	65mm ALUM. WINDOW SECTION		REMARK	65mm ALUM. WINDOW SECTION		
FREE AREA(%)	OPENABLE AREA	GLAZING AREA	GLAZING AREA	FREE AREA(%)	OPENABLE AREA	GLAZING AREA	FREE AREA(%)	OPENABLE AREA	GLAZING AREA
{57%}				{57%}			{57%}		
WINDOW MARK	W40 T2 1 no.		WINDOW MARK	W41 T2 1 no.		WINDOW MARK	W43 T2 2 nos.		
LOCATION	T2 FLAT A M.BATH. (32/F)		LOCATION	T2 FLAT D BATH. (32/F) T2 FLAT B M.BATH. (33/F)		LOCATION	T2A FLAT A KIT. (32/F) T2 FLAT A KIT. (32/F) T2 FLAT A BATH. (33/F)		
GLAZING	GLO6	FRAME AL11	GLAZING	GLO6	FRAME AL11	GLAZING	GLO2	FRAME AL11	
REMARK	65mm ALUM. WINDOW SECTION		REMARK	65mm ALUM. WINDOW SECTION		REMARK	65mm ALUM. WINDOW SECTION		

B.D. REF :
F.S.D. REF :
Note :
1.All dimensions are in mm.
2.All elevations are viewed from outside.
3.All dimensions to be verified on site before fabrication.

GENERAL NOTES
Legend :
1. F.F.L-- Finished Floor Level
2. S.F.L-- Structural Floor Level
3. (R) -- Reversed Detail
X1 -- DETAIL MARK NO.
X001 -- REFER SHEET NO.

B	08.02.2020	GENERAL REVISION
A	08.02.2020	GENERAL REVISION
NO.	DATE	REVISED

CLIENT :
佳明集團控股有限公司
GRAND MING GROUP HOLDINGS LIMITED

MAIN CONTRACTOR :
GRAND TECH CONSTRUCTION CO. LTD.

ARCHITECT :
WONG TUNG & PARTNERS LIMITED
ARCHITECTS & PLANNERS

STRUCTURAL ENGINEER :
C M WONG & ASSOCIATES LTD

美特鋁質有限公司
MIDI ALUMINIUM FABRICATOR LTD.
Units 6-8, Sunray Industrial Centre, 1/F
610 Cha Kwo Ling Road, Kowloon
Tel:23489211-4 Fax:(852)27727666

PROJECT :
RESIDENTIAL DEVELOPMENT AT
TSING YI TOWN LOT 190 SAI SHAN ROAD

TITLE :
WINDOW SCHEDULE
FOR PRECAST FACADE
OF T2/T2A (4 OF 6)

JOB NO. : J-851
DRAWN BY : C.H.P. DATE : 30-11-2019
CHKD BY : SCALE A1: 1:30
A3: 1:30
DWG. NO. : J851-SCH-204 REV. : B

OPENABLE AREA		GLAZING AREA		OPENABLE AREA		GLAZING AREA	
WINDOW MARK	W45 T2 2 nos.			WINDOW MARK	W46 T2 4 nos.		
LOCATION	T2A LOBBY CORRIDOR (32-33/F)			LOCATION	T2 LOBBY CORRIDOR (32-33/F)		
GLAZING	GL08	FRAME	AL11	GLAZING	GL08	FRAME	AL11
REMARK	65mm ALUM. WINDOW SECTION			REMARK	65mm ALUM. WINDOW SECTION		
FREE AREA(%)	GLAZING AREA	OPENABLE AREA		FREE AREA(%)	GLAZING AREA	OPENABLE AREA	
57%							
WINDOW MARK	W40A T2 2 nos.			WINDOW MARK			
LOCATION	T2 FLAT D N.BATH. (32-33/F)			LOCATION			
GLAZING	GL06	FRAME	AL11	GLAZING		FRAME	
REMARK	65mm ALUM. WINDOW SECTION			REMARK			

B.D. REF :
F.S.D. REF :
Note :
1.All dimensions are in mm.
2.All elevations are viewed from outside.
3.All dimensions to be verified on site before fabrication.

GENERAL NOTES
Legend :
1. F.F.L.-- Finished Floor Level
2. S.F.L.-- Structural Floor Level
3. (R) -- Reversed Detail
X1 -- DETAIL MARK NO.
X001 -- REFER SHEET NO.

B	22.02.2020	GENERAL REVISION	
A	08.02.2020	GENERAL REVISION	
NO.	DATE	REVISED	BY

CLIENT :
佳明集團控股有限公司
GRAND MING GROUP HOLDINGS LIMITED

MAIN CONTRACTOR :
GRAND TECH CONSTRUCTION CO. LTD.

ARCHITECT :
WONG TUNG & PARTNERS LIMITED
ARCHITECTS & PLANNERS

STRUCTURAL ENGINEER :
 C M WONG & ASSOCIATES LTD

美特鋁質有限公司
MIDI ALUMINUM FABRICATOR LTD.
Units 6-8, Sunray Industrial Centre, 1/F
510 Cha Kwo Ling Road, Kowloon
Tel:23489211-4 Fax:(852)27727666

PROJECT :
RESIDENTIAL DEVELOPMENT AT
TSING YI TOWN LOT 190 SAI SHAN ROAD

TITLE :
WINDOW SCHEDULE
FOR PRECAST FACADE
OF T2/T2A (5 OF 6)

JOB NO. : J-851
DRAWN BY : C.H.P. DATE : 30-11-2019
CHKD BY : SCALE A1: A3: 1:30
DWG. NO. : J851-SCH-205 REV. : B

OPENABLE AREA	GLAZING AREA	FREE AREA(%)	GLAZING AREA	OPENABLE AREA							
		{57%}									
WINDOW MARK	W52 T2 2 nos.	WINDOW MARK	W53 T2 1 no.	WINDOW MARK	W63 T2 1 no.						
LOCATION	T2A FLAT B M.BATH. (32-33/F)	LOCATION	T2 FLAT F MBR.(32/F)	LOCATION	T2 FLAT A UTILITY RM (35/F)						
GLAZING	GL06	FRAME	AL11	GLAZING	GL02	FRAME	AL11	GLAZING	GL06	FRAME	AL11
REMARK	65mm ALUM. WINDOW SECTION		REMARK	65mm ALUM. WINDOW SECTION		REMARK	65mm ALUM. WINDOW SECTION				
FREE AREA(%)	OPENABLE AREA	FREE AREA(%)	OPENABLE AREA	GLAZING AREA							
{57%}		{57%}									
GLAZING AREA		GLAZING AREA									
WINDOW MARK	W64 T2 1 no.	WINDOW MARK	W64A T2 1 no.	WINDOW MARK	W73 T2 1 no.	WINDOW MARK		WINDOW MARK			
LOCATION	T2 FLAT B UTILITY RM (35/F)	LOCATION	T2 FLAT A POWDER RM (35/F)	LOCATION	T2 FLAT B LIV. & DIN. (35/F)	LOCATION		LOCATION			
GLAZING	GL06	FRAME	AL11	GLAZING	GL06	FRAME	AL11	GLAZING		FRAME	
REMARK	65mm ALUM. WINDOW SECTION		REMARK	65mm ALUM. WINDOW SECTION		REMARK		REMARK			

B.D. REF :
F.S.D. REF :
Note :
1.All dimensions are in mm.
2.All elevations are viewed from outside.
3.All dimensions to be verified on site before fabrication.

GENERAL NOTES
Legend :
1. F.F.L--- Finished Floor Level
2. S.F.L--- Structural Floor Level
3. (R) --- Reversed Detail
X1 --- DETAIL MARK NO.
X001 --- REFER SHEET NO.

B	06.02.2020	GENERAL REVISION	
A	06.02.2020	GENERAL REVISION	
NO.	DATE	REVISED	BY

CLIENT :
佳明集團控股有限公司
GRAND MING GROUP HOLDINGS LIMITED

MAIN CONTRACTOR :
GRAND TECH CONSTRUCTION CO. LTD.

ARCHITECT :
WONG TUNG & PARTNERS LIMITED
ARCHITECTS & PLANNERS

STRUCTURAL ENGINEER :
C M WONG & ASSOCIATES LTD

美特鋁質有限公司
MIDI ALUMINIUM FABRICATOR LTD.
Units 6-8, Sunray Industrial Centre, 1/F
610 Cha Kwo Ling Road, Kowloon
Tel:23489211-4 Fax:(852)27727666

PROJECT :
RESIDENTIAL DEVELOPMENT AT
TSING YI TOWN LOT 190 SAI SHAN ROAD


TITLE :
WINDOW SCHEDULE
FOR PRECAST FACADE
OF T2/T2A (6 OF 6)

JOB NO. : J-851


DRAWN BY : C.H.P. DATE : 30-11-2019

CHKD BY : SCALE A1: A3: 1:30


DWG. NO. : J851-SCH-206 REV. : B

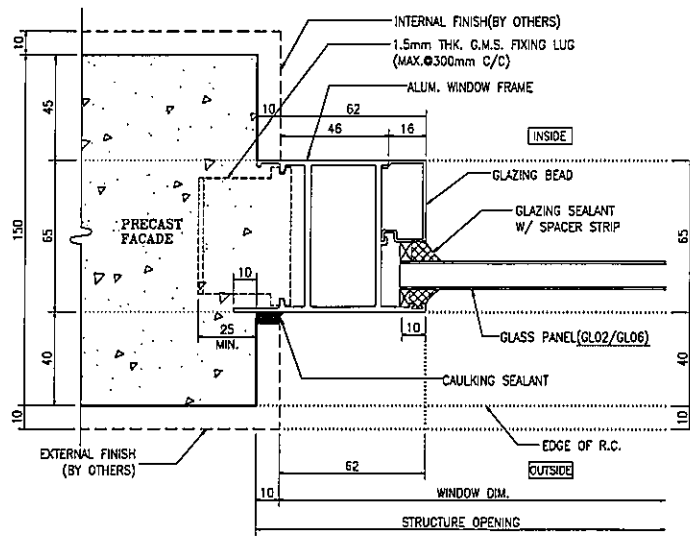


1 HORIZONTAL DETAIL
501 Fixed Window

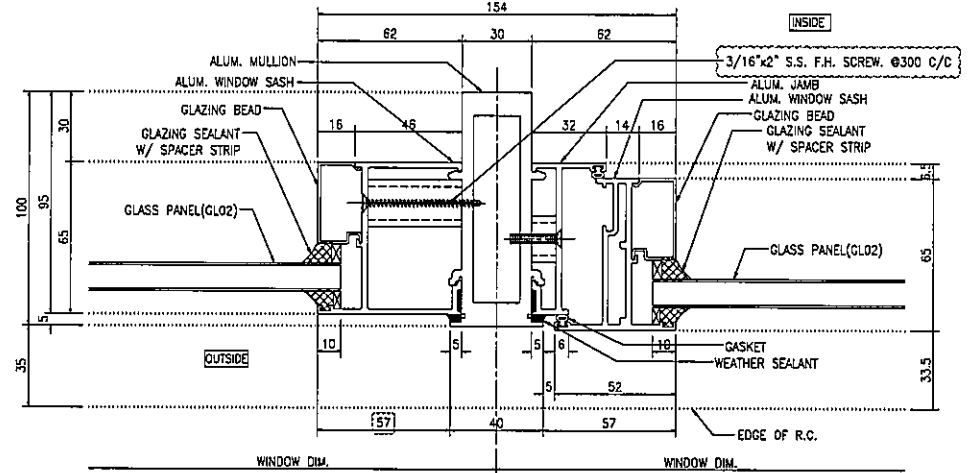


4 HORIZONTAL DETAIL
501 Mullion Of Fixed Window
And Openable Window

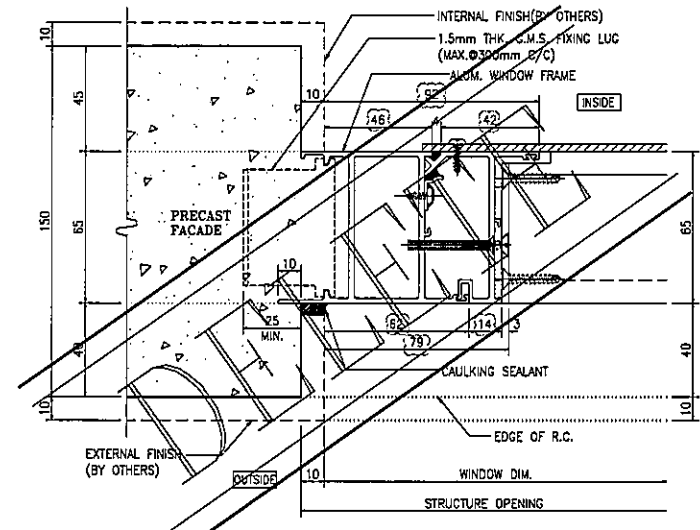


7 HORIZONTAL DETAIL
501 Louvre

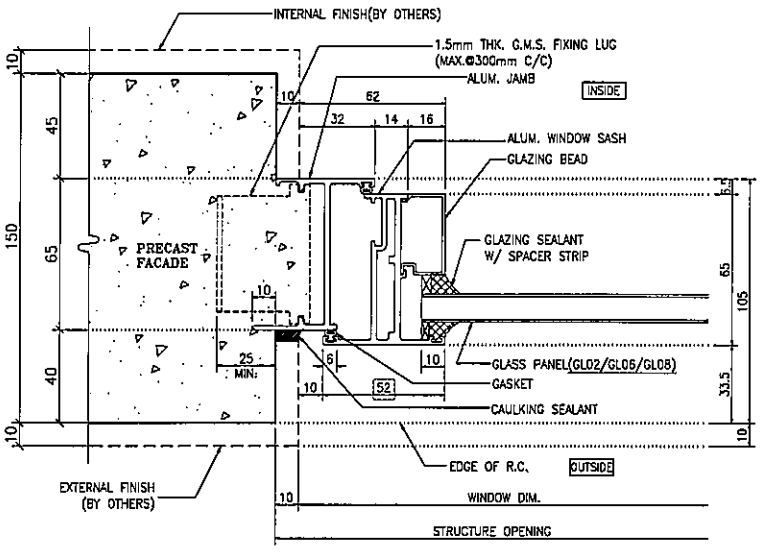


2 HORIZONTAL DETAIL
501 Openable Window

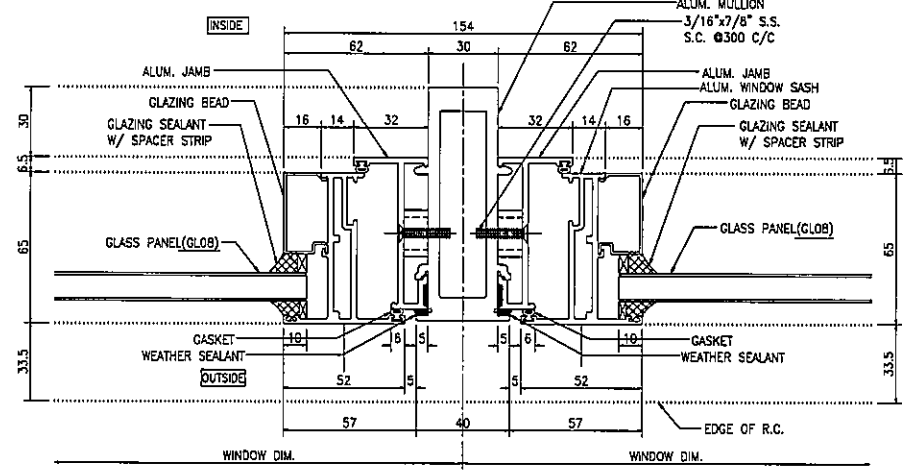


5 HORIZONTAL DETAIL
501 Mullion Of Openable Window

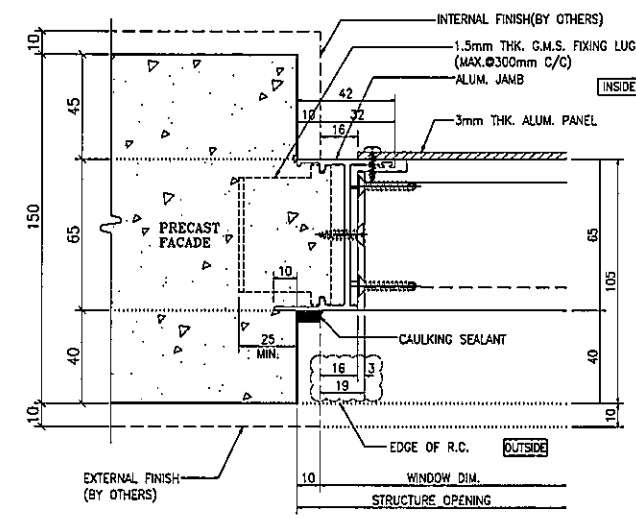


8 HORIZONTAL DETAIL
501 Louvre

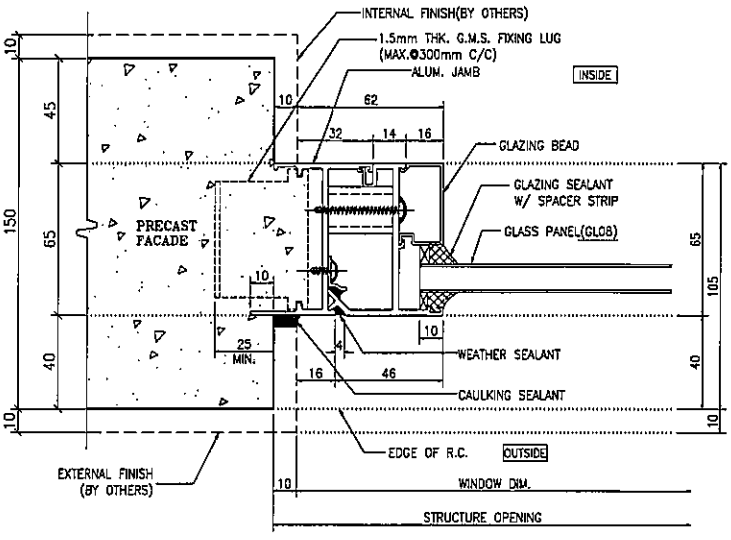

3 HORIZONTAL DETAIL
501 Fixed Window
w/ Adapter

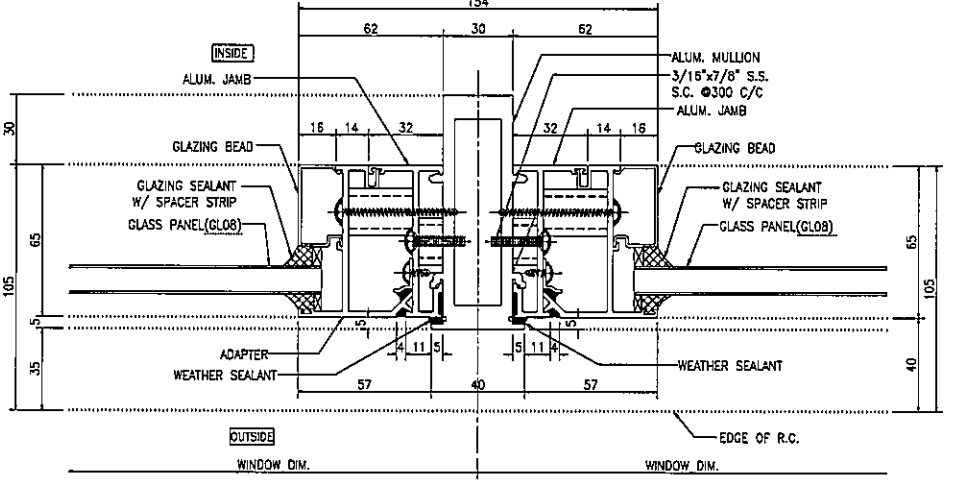


6 HORIZONTAL DETAIL
501 Mullion Of Fixed Window
w/ Adapter

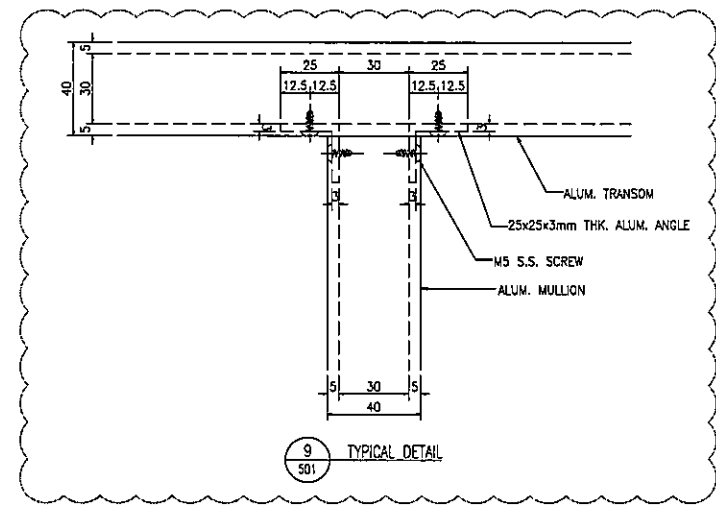


9 TYPICAL DETAIL
501


B.D. REF :													
F.S.D. REF :													
Note :													
1. All dimensions are in mm.													
2. All elevations are viewed from outside.													
3. All dimensions to be verified on site before fabrication.													
GENERAL NOTES													
Legend :													
1. F.F.L. --- Finished Floor Level													
2. S.F.L. --- Structural Floor Level													
3. (R) --- Reversed Detail													
(X1)	DETAIL MARK NO.												
(X001)	REFER SHEET NO.												
<table border="1"> <thead> <tr> <th>NO.</th> <th>DATE</th> <th>REVISED</th> <th>BY</th> </tr> </thead> <tbody> <tr> <td>B</td> <td>06.02.2020</td> <td>GENERAL REVISION</td> <td></td> </tr> <tr> <td>A</td> <td>06.02.2020</td> <td>GENERAL REVISION</td> <td></td> </tr> </tbody> </table>		NO.	DATE	REVISED	BY	B	06.02.2020	GENERAL REVISION		A	06.02.2020	GENERAL REVISION	
NO.	DATE	REVISED	BY										
B	06.02.2020	GENERAL REVISION											
A	06.02.2020	GENERAL REVISION											
CLIENT :													
佳明集團控股有限公司 GRAND MING GROUP HOLDINGS LIMITED													
MAIN CONTRACTOR :													
GRAND TECH CONSTRUCTION CO. LTD.													
ARCHITECT :													
WONG TUNG & PARTNERS LIMITED ARCHITECTS & PLANNERS													
STRUCTURAL ENGINEER :													
C M WONG & ASSOCIATES LTD													
美特鋁質有限公司 MIDI ALUMINUM FABRICATOR LTD.													
Units 6-8, Sunray Industrial Centre, 1/F 610 Cha Kwo Ling Road, Kowloon Tel: 23489211-4 Fax: (852) 27727666													
PROJECT :													
RESIDENTIAL DEVELOPMENT AT TSING YI TOWN LOT 190 SAI SHAN ROAD													
TITLE :													
TYPICAL DETAIL FOR PRECAST ALUM. WINDOW													
JOB NO. :	J-851												
DRAWN BY :	C.H.P.												
DATE :	30-11-2019												
CHKD BY :	SCALE A1: A3: 1:3												
DWG. NO. :	J851-PW-501												
REV. :	B												

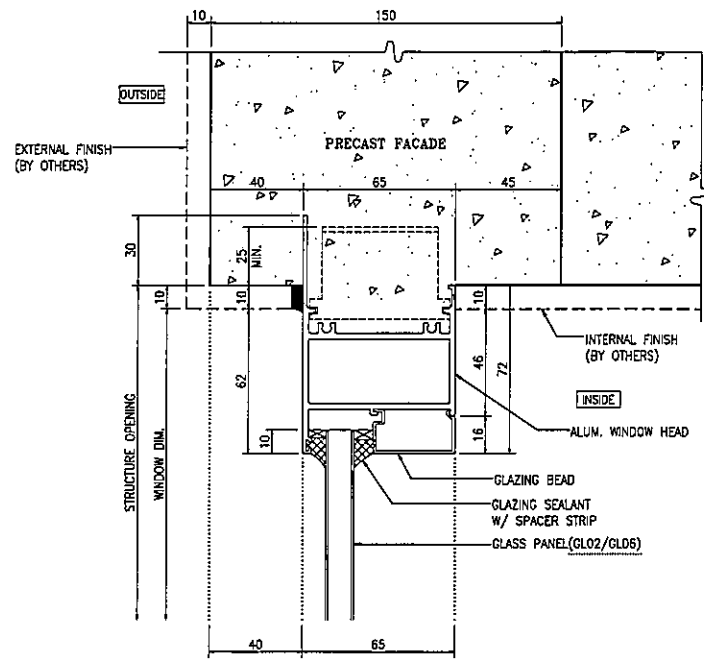


1 VERTICAL DETAIL
601 Fixed Window

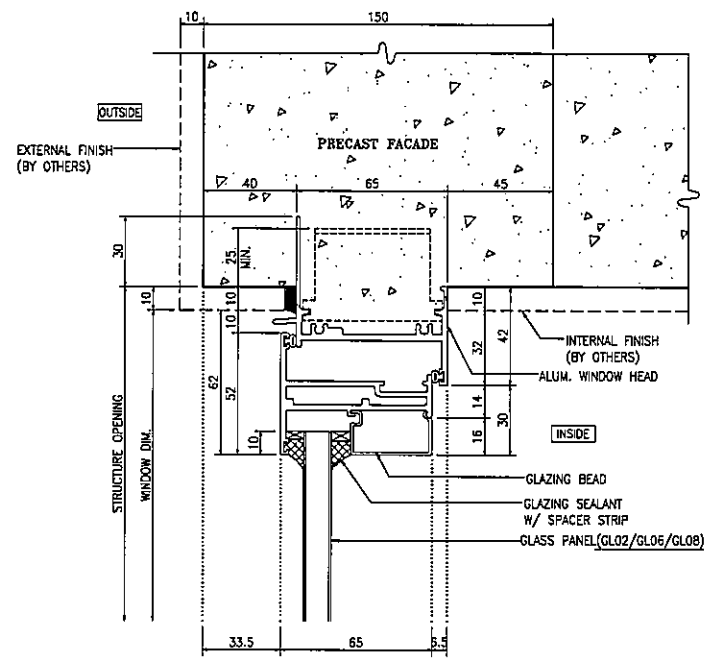


3 VERTICAL DETAIL
601 Operable Window

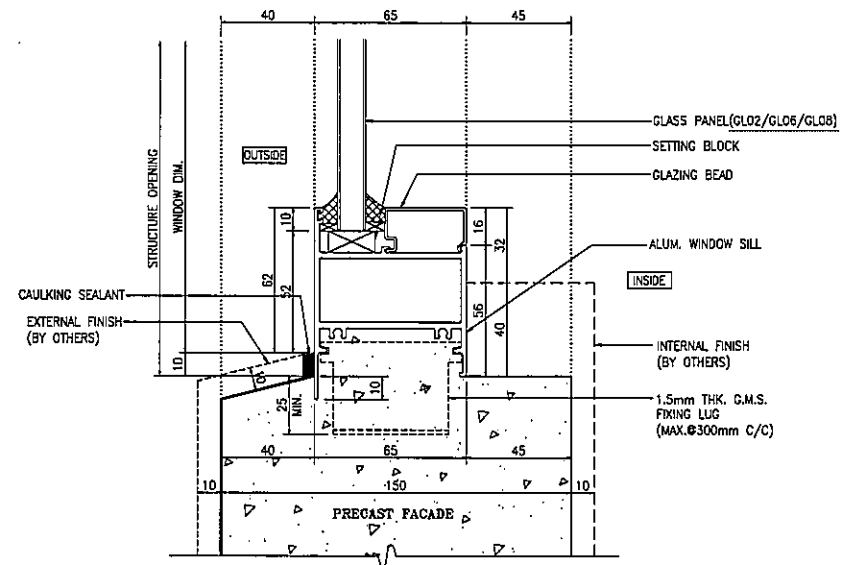


5 VERTICAL DETAIL
601 Fixed Window

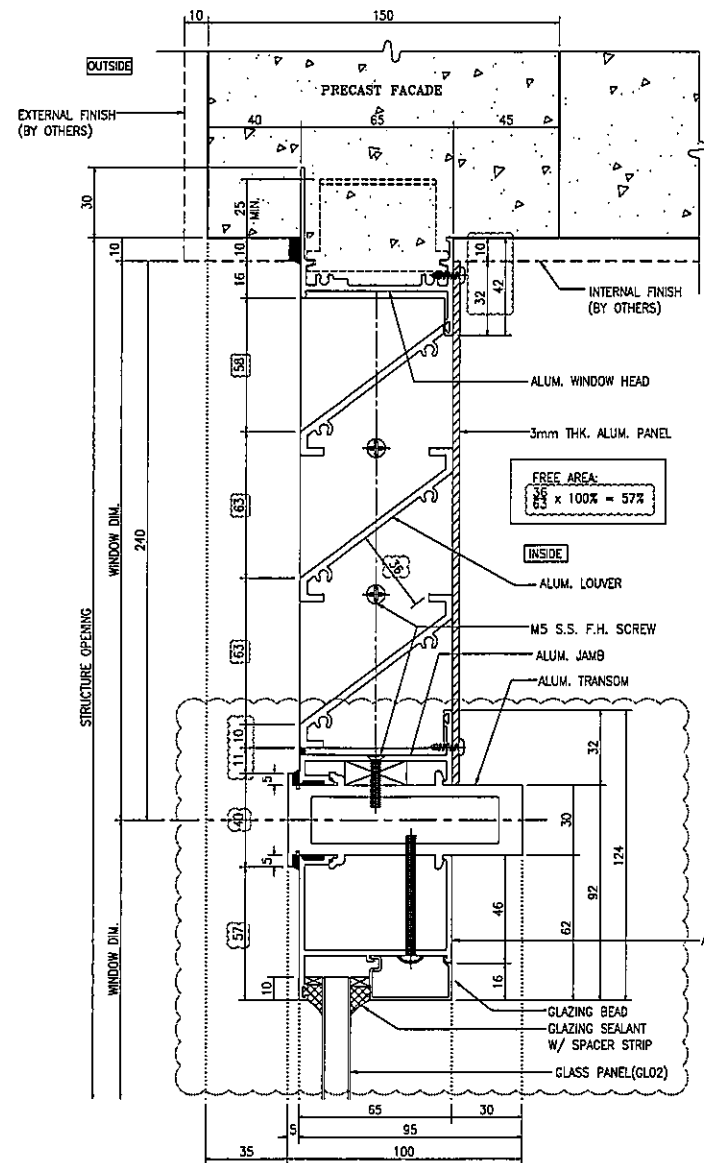


2 VERTICAL DETAIL
601 For Transom Of Fixed Window

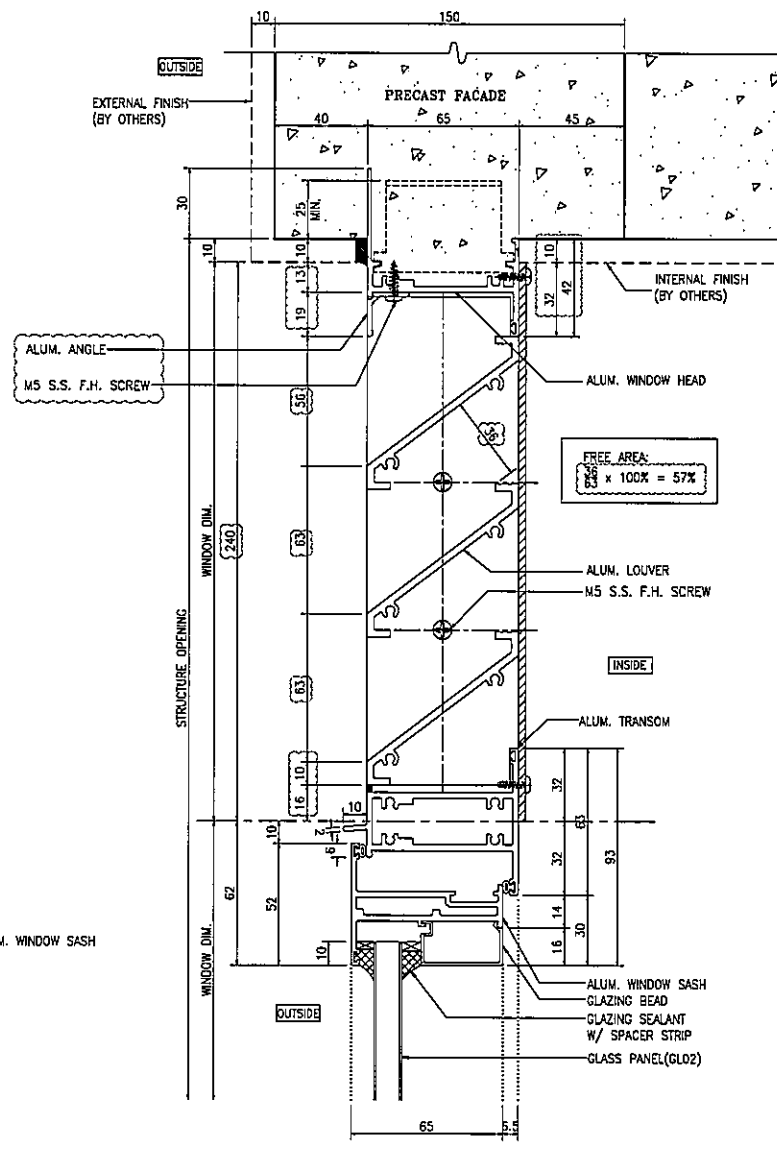

4 VERTICAL DETAIL
601 For Transom Of Operable Window

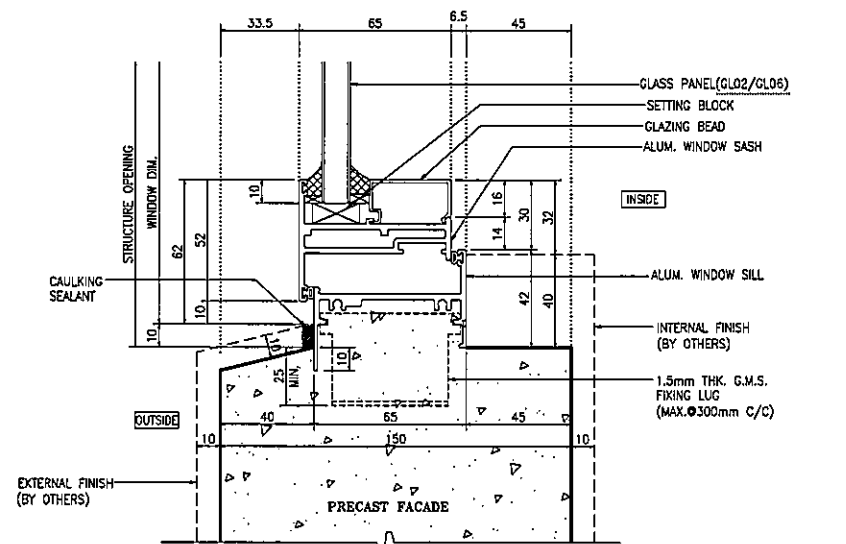

6 VERTICAL DETAIL
601 Operable Window

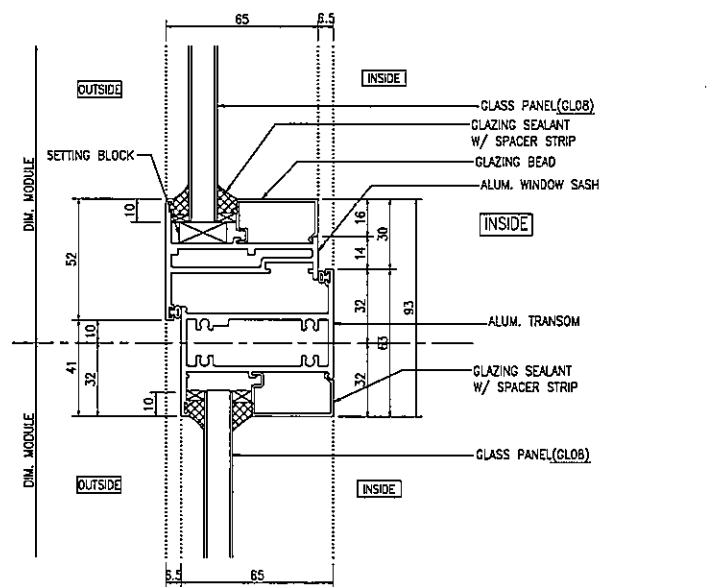

7 VERTICAL DETAIL
601 Fixed Window and Operable Window

B.D. REF :
F.S.D. REF :
Note :
1. All dimensions are in mm.
2. All elevations are viewed from outside.
3. All dimensions to be verified on site before fabrication.

GENERAL NOTES

Legend :
1. F.F.L. -- Finished Floor Level
2. S.F.L. -- Structural Floor Level
3. (R) -- Reversed Detail

(X1) -- DETAIL MARK NO.
(X001) -- REFER SHEET NO.

B	20.02.2020	GENERAL REVISION	
A	06.02.2020	GENERAL REVISION	
NO.	DATE	REVISED	BY

CLIENT :
佳明集團控股有限公司
GRAND MING GROUP HOLDINGS LIMITED

MAIN CONTRACTOR :
GRAND TECH CONSTRUCTION CO. LTD.

ARCHITECT :
WONG TUNG & PARTNERS LIMITED
ARCHITECTS & PLANNERS

STRUCTURAL ENGINEER :
C M WONG & ASSOCIATES LTD

美特鋁質有限公司
MIDI ALUMINIUM FABRICATOR LTD.
Units 6-8, Sunray Industrial Centre, 1/F
610 Cha Kwo Ling Road, Kowloon
Tel: 23489211-4 Fax: (852) 27727666

PROJECT :
RESIDENTIAL DEVELOPMENT AT
TSING YI TOWN LOT 190 SAI SHAN ROAD


TITLE :
TYPICAL DETAIL FOR
PRECAST ALUM. WINDOW

JOB NO. : J-851


DRAWN BY : C.H.P. DATE : 30-11-2019

CHKD BY : SCALE A1:
A3: 1:3


DWG. NO. : J851-PW-601 REV. : B

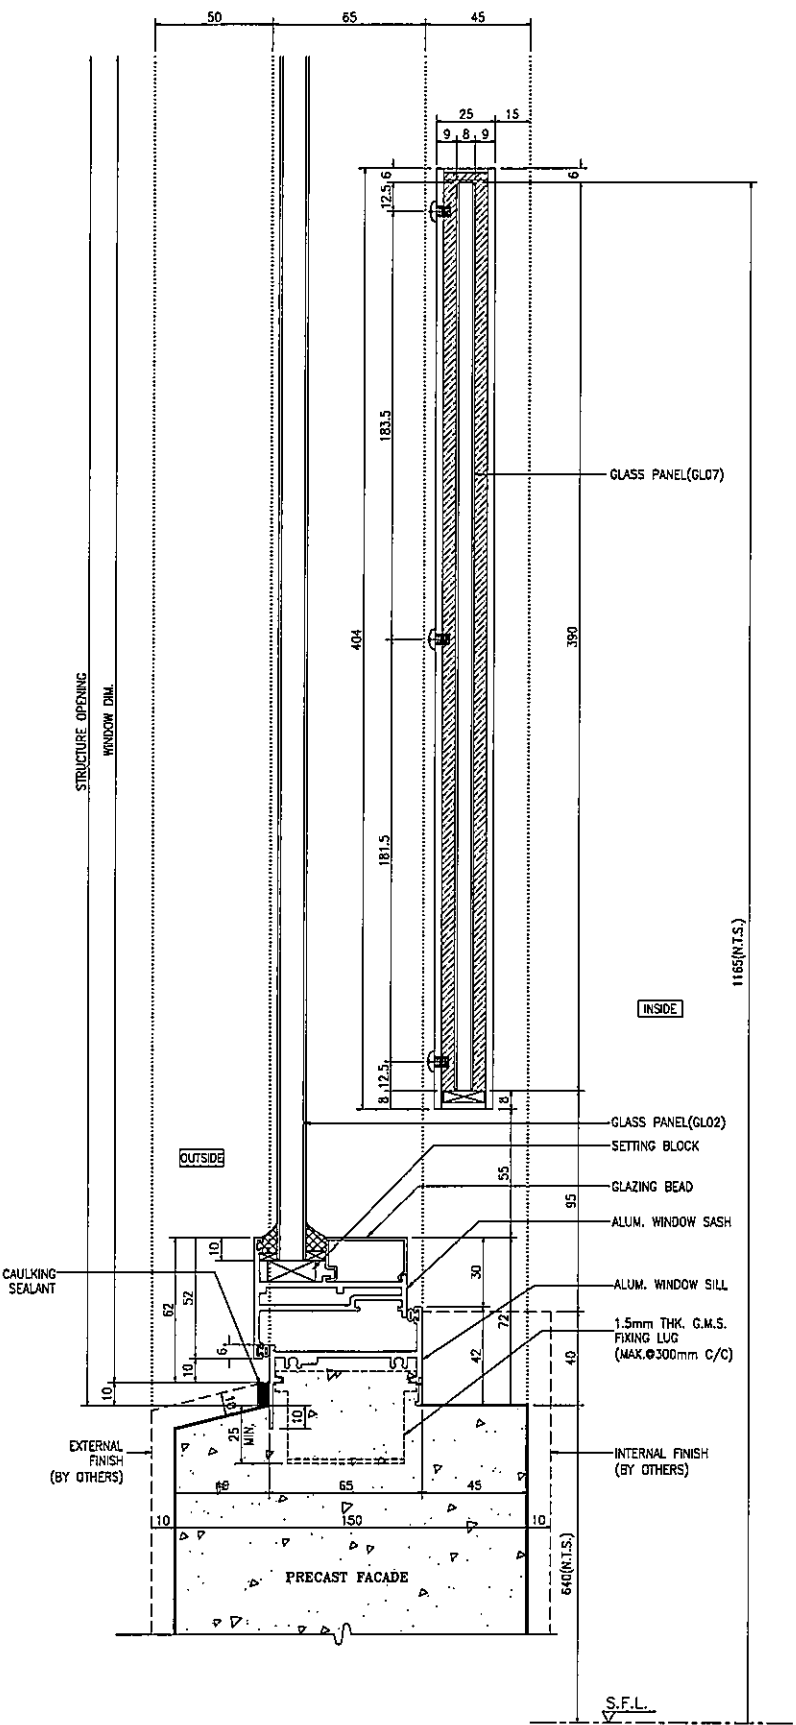


1 VERTICAL DETAIL
Openable Window
For Glass Barrier

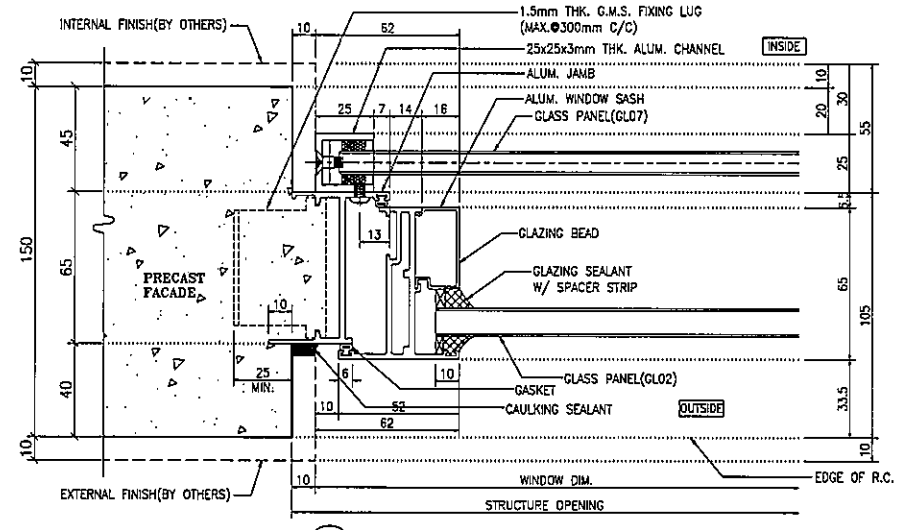


2 HORIZONTAL DETAIL
Openable Window
For Glass Barrier

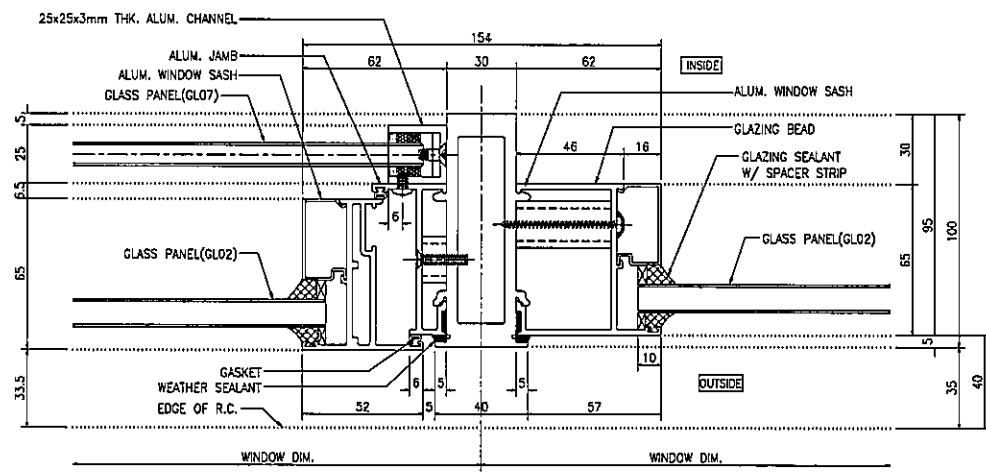

3 HORIZONTAL DETAIL
Mullion Of Openable Window
and Fixed Window
For Glass Barrier

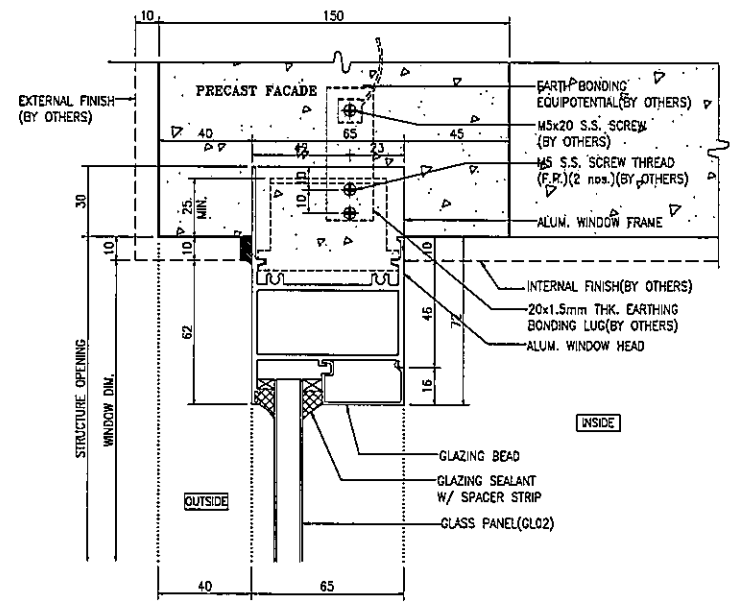


4 VERTICAL DETAIL
BONDING DETAILS OF PRECAST

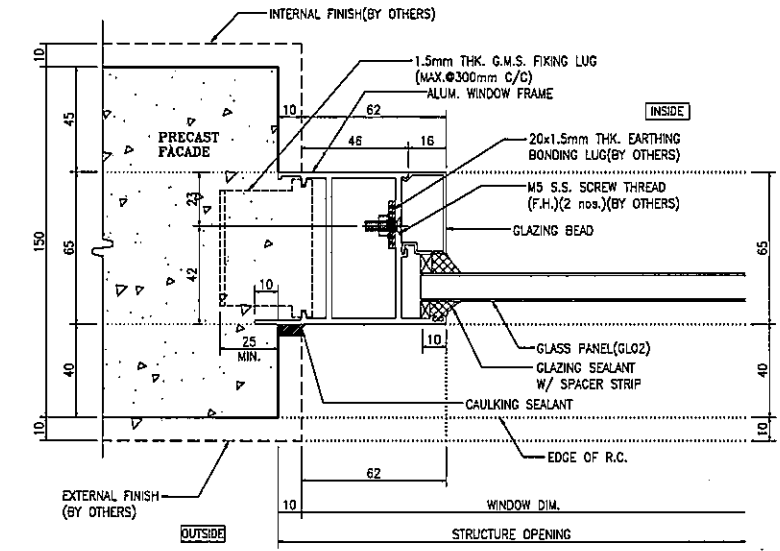


5 VERTICAL DETAIL
BONDING DETAILS OF PRECAST

B.D. REF :									
F.S.D. REF :									
Note :	1. All dimensions are in mm. 2. All elevations are viewed from outside. 3. All dimensions to be verified on site before fabrication.								
GENERAL NOTES									
Legend :									
1. F.F.L. --- Finished Floor Level									
2. S.F.L. --- Structural Floor Level									
3. (R) --- Reversed Detail									
(X1) --- DETAIL MARK NO.									
(X001) --- REFER SHEET NO.									
<table border="1" style="width: 100%;"> <tr> <th>NO.</th> <th>DATE</th> <th>REVISION</th> <th>BY</th> </tr> <tr> <td>A</td> <td>06.02.2020</td> <td>GENERAL REVISION</td> <td></td> </tr> </table>		NO.	DATE	REVISION	BY	A	06.02.2020	GENERAL REVISION	
NO.	DATE	REVISION	BY						
A	06.02.2020	GENERAL REVISION							
CLIENT :									
佳明集團控股有限公司 GRAND WING GROUP HOLDINGS LIMITED									
MAIN CONTRACTOR :									
GRAND TECH CONSTRUCTION CO. LTD.									
ARCHITECT :									
WONG TUNG & PARTNERS LIMITED ARCHITECTS & PLANNERS									
									
STRUCTURAL ENGINEER :									
 C M WONG & ASSOCIATES LTD									
 美特鋁質有限公司 MIDI ALUMINIUM FABRICATOR LTD.									
Units 6-8, Sunray Industrial Centre, 1/F 610 Cho Kwo Ling Road, Kowloon Tel: 23489211-4 Fax: (852) 27276566									
PROJECT :									
RESIDENTIAL DEVELOPMENT AT TSING YI TOWN LOT 190 SAI SHAN ROAD									
TITLE :									
TYPICAL DETAIL FOR PRECAST ALUM. WINDOW									
JOB NO. :	J-851								
DRAWN BY : C.H.P.	DATE : 30-11-2019								
CHKD BY :	SCALE A1: A3: 1:3								
DWG. NO. : J851-PW-602	REV. : A								

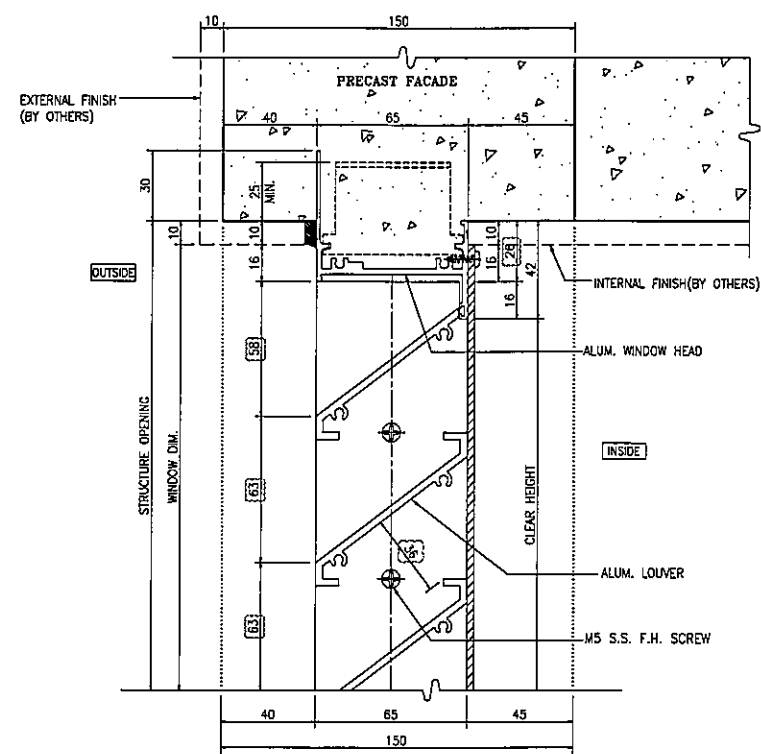


1 VERTICAL DETAIL
603 Fixed LOUVRE

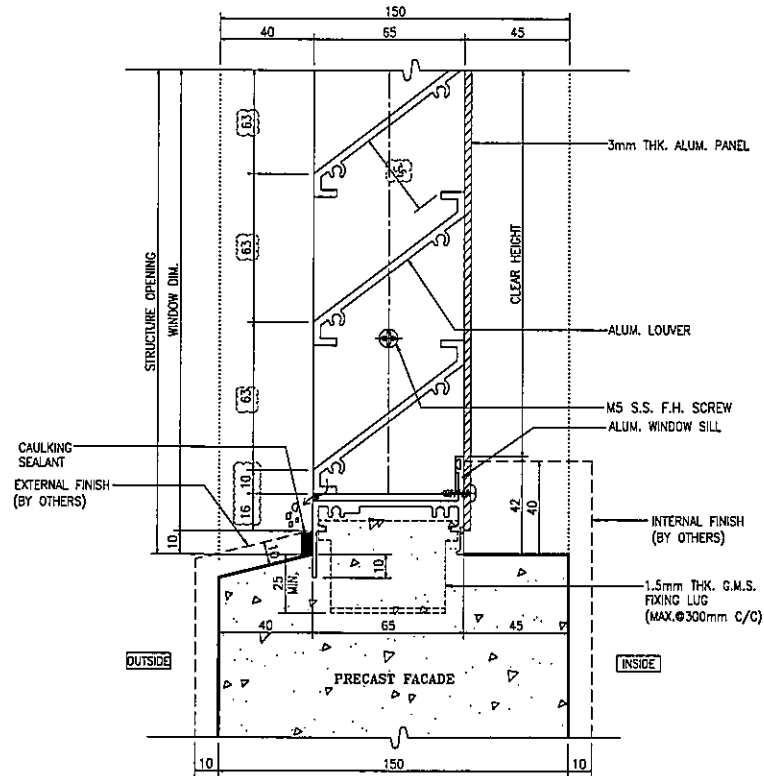


2 VERTICAL DETAIL
603 Fixed LOUVRE


LOUVRE TYPICAL DETAIL FOR FREE AREA

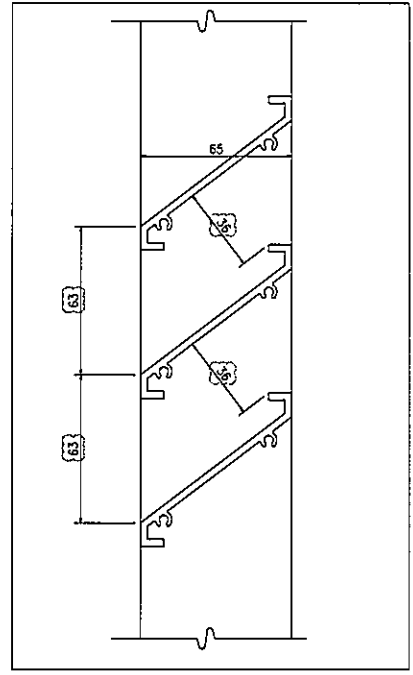

DIMENSION:
FOR FREE AREA $57\% \left(\frac{36}{63} \right) \times 100\% = 57\%$

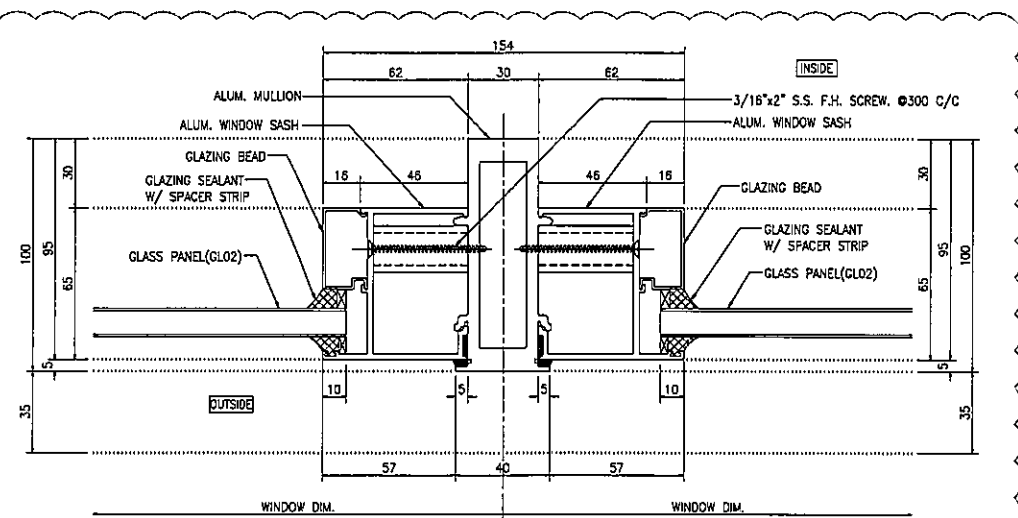

3 HORIZONTAL DETAIL
603 Mullion Of Fixed Window
And Openable Window

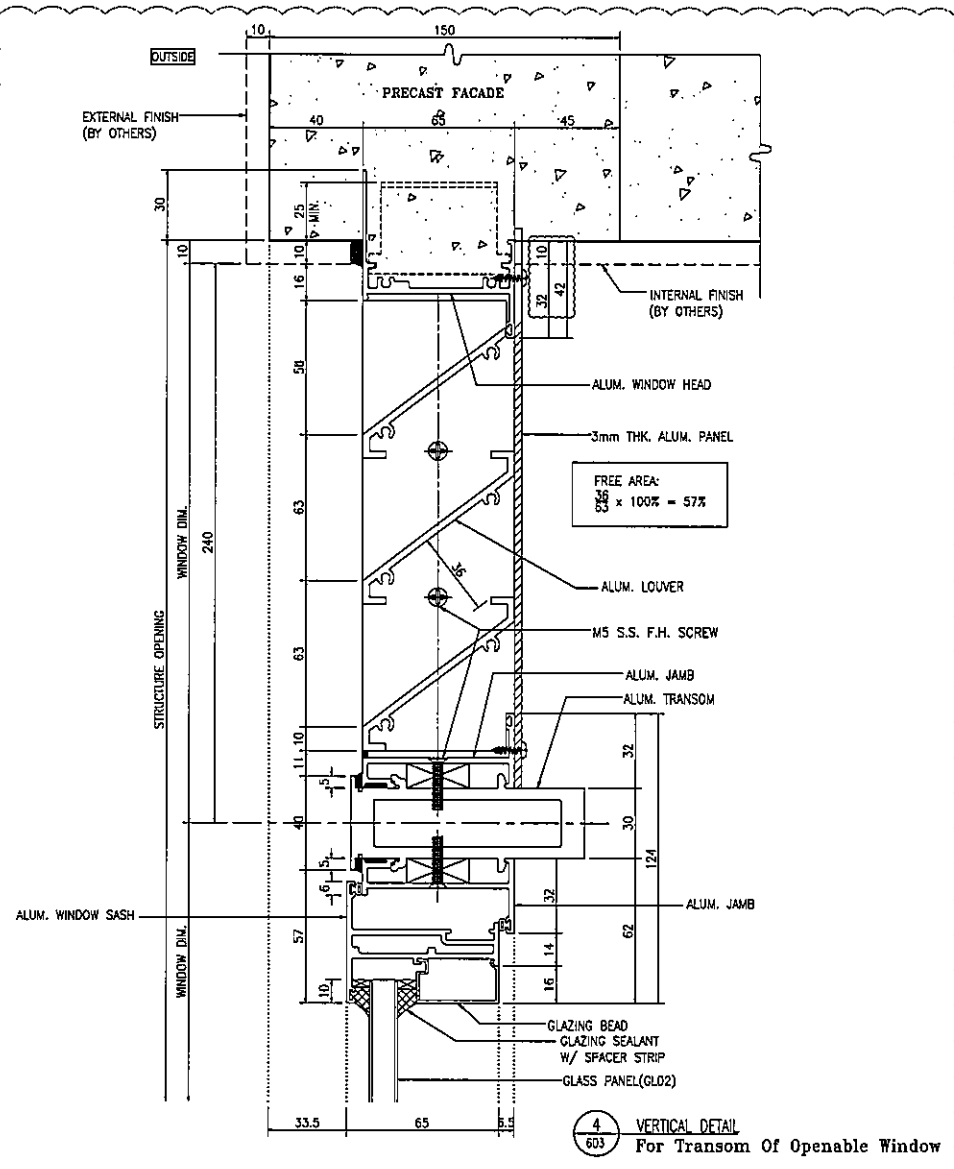

4 VERTICAL DETAIL
603 For Transom Of Openable Window

B.D. REF :			
F.S.D. REF :			
Note :			
1. All dimensions are in mm.			
2. All elevations are viewed from outside.			
3. All dimensions to be verified on site before fabrication.			
GENERAL NOTES			
Legend :			
1. F.F.L--- Finished Floor Level			
2. S.F.L--- Structural Floor Level			
3. (R) --- Reversed Detail			
(X1)		DETAIL MARK NO.	
(X001)		REFER SHEET NO.	
B	06.02.2020	GENERAL REVISION	
A	06.02.2020	GENERAL REVISION	
NO.	DATE	REVISED	BY
CLIENT :			
佳明集團控股有限公司 GRAND MING GROUP HOLDINGS LIMITED			
MAIN CONTRACTOR :			
GRAND TECH CONSTRUCTION CO. LTD.			
ARCHITECT :			
WONG TUNG & PARTNERS LIMITED ARCHITECTS & PLANNERS			
			
STRUCTURAL ENGINEER :			
 C M WONG & ASSOCIATES LTD			
ARCHITECT :			
 美特鋁質有限公司 MIDI ALUMINIUM FABRICATOR LTD.			
Units 6-8, Sunny Industrial Centre, 1/F 610 Cha Kwo Ling Road, Kowloon Tel: 23489211-4 Fax: (852) 27727666			
PROJECT :			
RESIDENTIAL DEVELOPMENT AT TSING YI TOWN LOT 190 SAI SHAN ROAD			
TITLE :			
TYPICAL DETAIL FOR PRECAST ALUM. LOUVRE			
JOB NO. : J-851			
DRAWN BY : C.H.P.		DATE : 30-11-2019	
CHKD BY :		SCALE A1: A3: 1:3	
DWC NO. : J851-PW-603		REV. : B	