



工程指示 / 要求簡箋(E.I.)

工程指示編號：EI / 1472 / 20

修改版次：H

工程編號：J851

工程名稱：青衣明翹匯住宅

工程項目：大貨試模窗

收件人：生統

發件人：Leung Hin Wai

日期：29/02/2020

要求提供 / 確認 事項：

- | | | |
|------------------------------------|-------------------------------------|-------------------------------|
| <input type="checkbox"/> 初步鋁料 B.M. | <input type="checkbox"/> 加工拆圖，然後生產 | <input type="checkbox"/> 尺寸表 |
| <input type="checkbox"/> 正式鋁料 B.M. | <input type="checkbox"/> 技術上資料 / 指示 | <input type="checkbox"/> 報價 |
| <input type="checkbox"/> 配件 B.M. | <input type="checkbox"/> 樣辦或貨品說明書 | <input type="checkbox"/> 分判合約 |
| <input type="checkbox"/> 其他：_____ | | |

內容：

現附上更新預制窗施工圖。

要按此新圖更新試模窗。

請在 28/2 前完成上列要求。

附： -

以上項目為：

- 原合約工程包 原合約工程加 / 減賬 新工程報價

原因： -

分發東莞各部門：

- () 生產技術總監 連附件 () 技術部 連附件 () 生產部 連附件 () 機械設計部 連附件
 () 採購部 連附件 () 生產統籌部 連附件
 () 質檢部 連附件 () 會計部 連附件 () 報關組 連附件 () 其他 _____ 連附件

分發香港各部門：


- () 行政部 連附件 () 會計部 連附件 () 統籌部 連附件 () 工程部地盤科文(柄) 連附件
 () 採購部 連附件 () QS 部 連附件 () 維修部 連附件 () 其他 _____ 連附件

傳遞編號：

HK 0219


發件人簽署：

項目經理簽署：

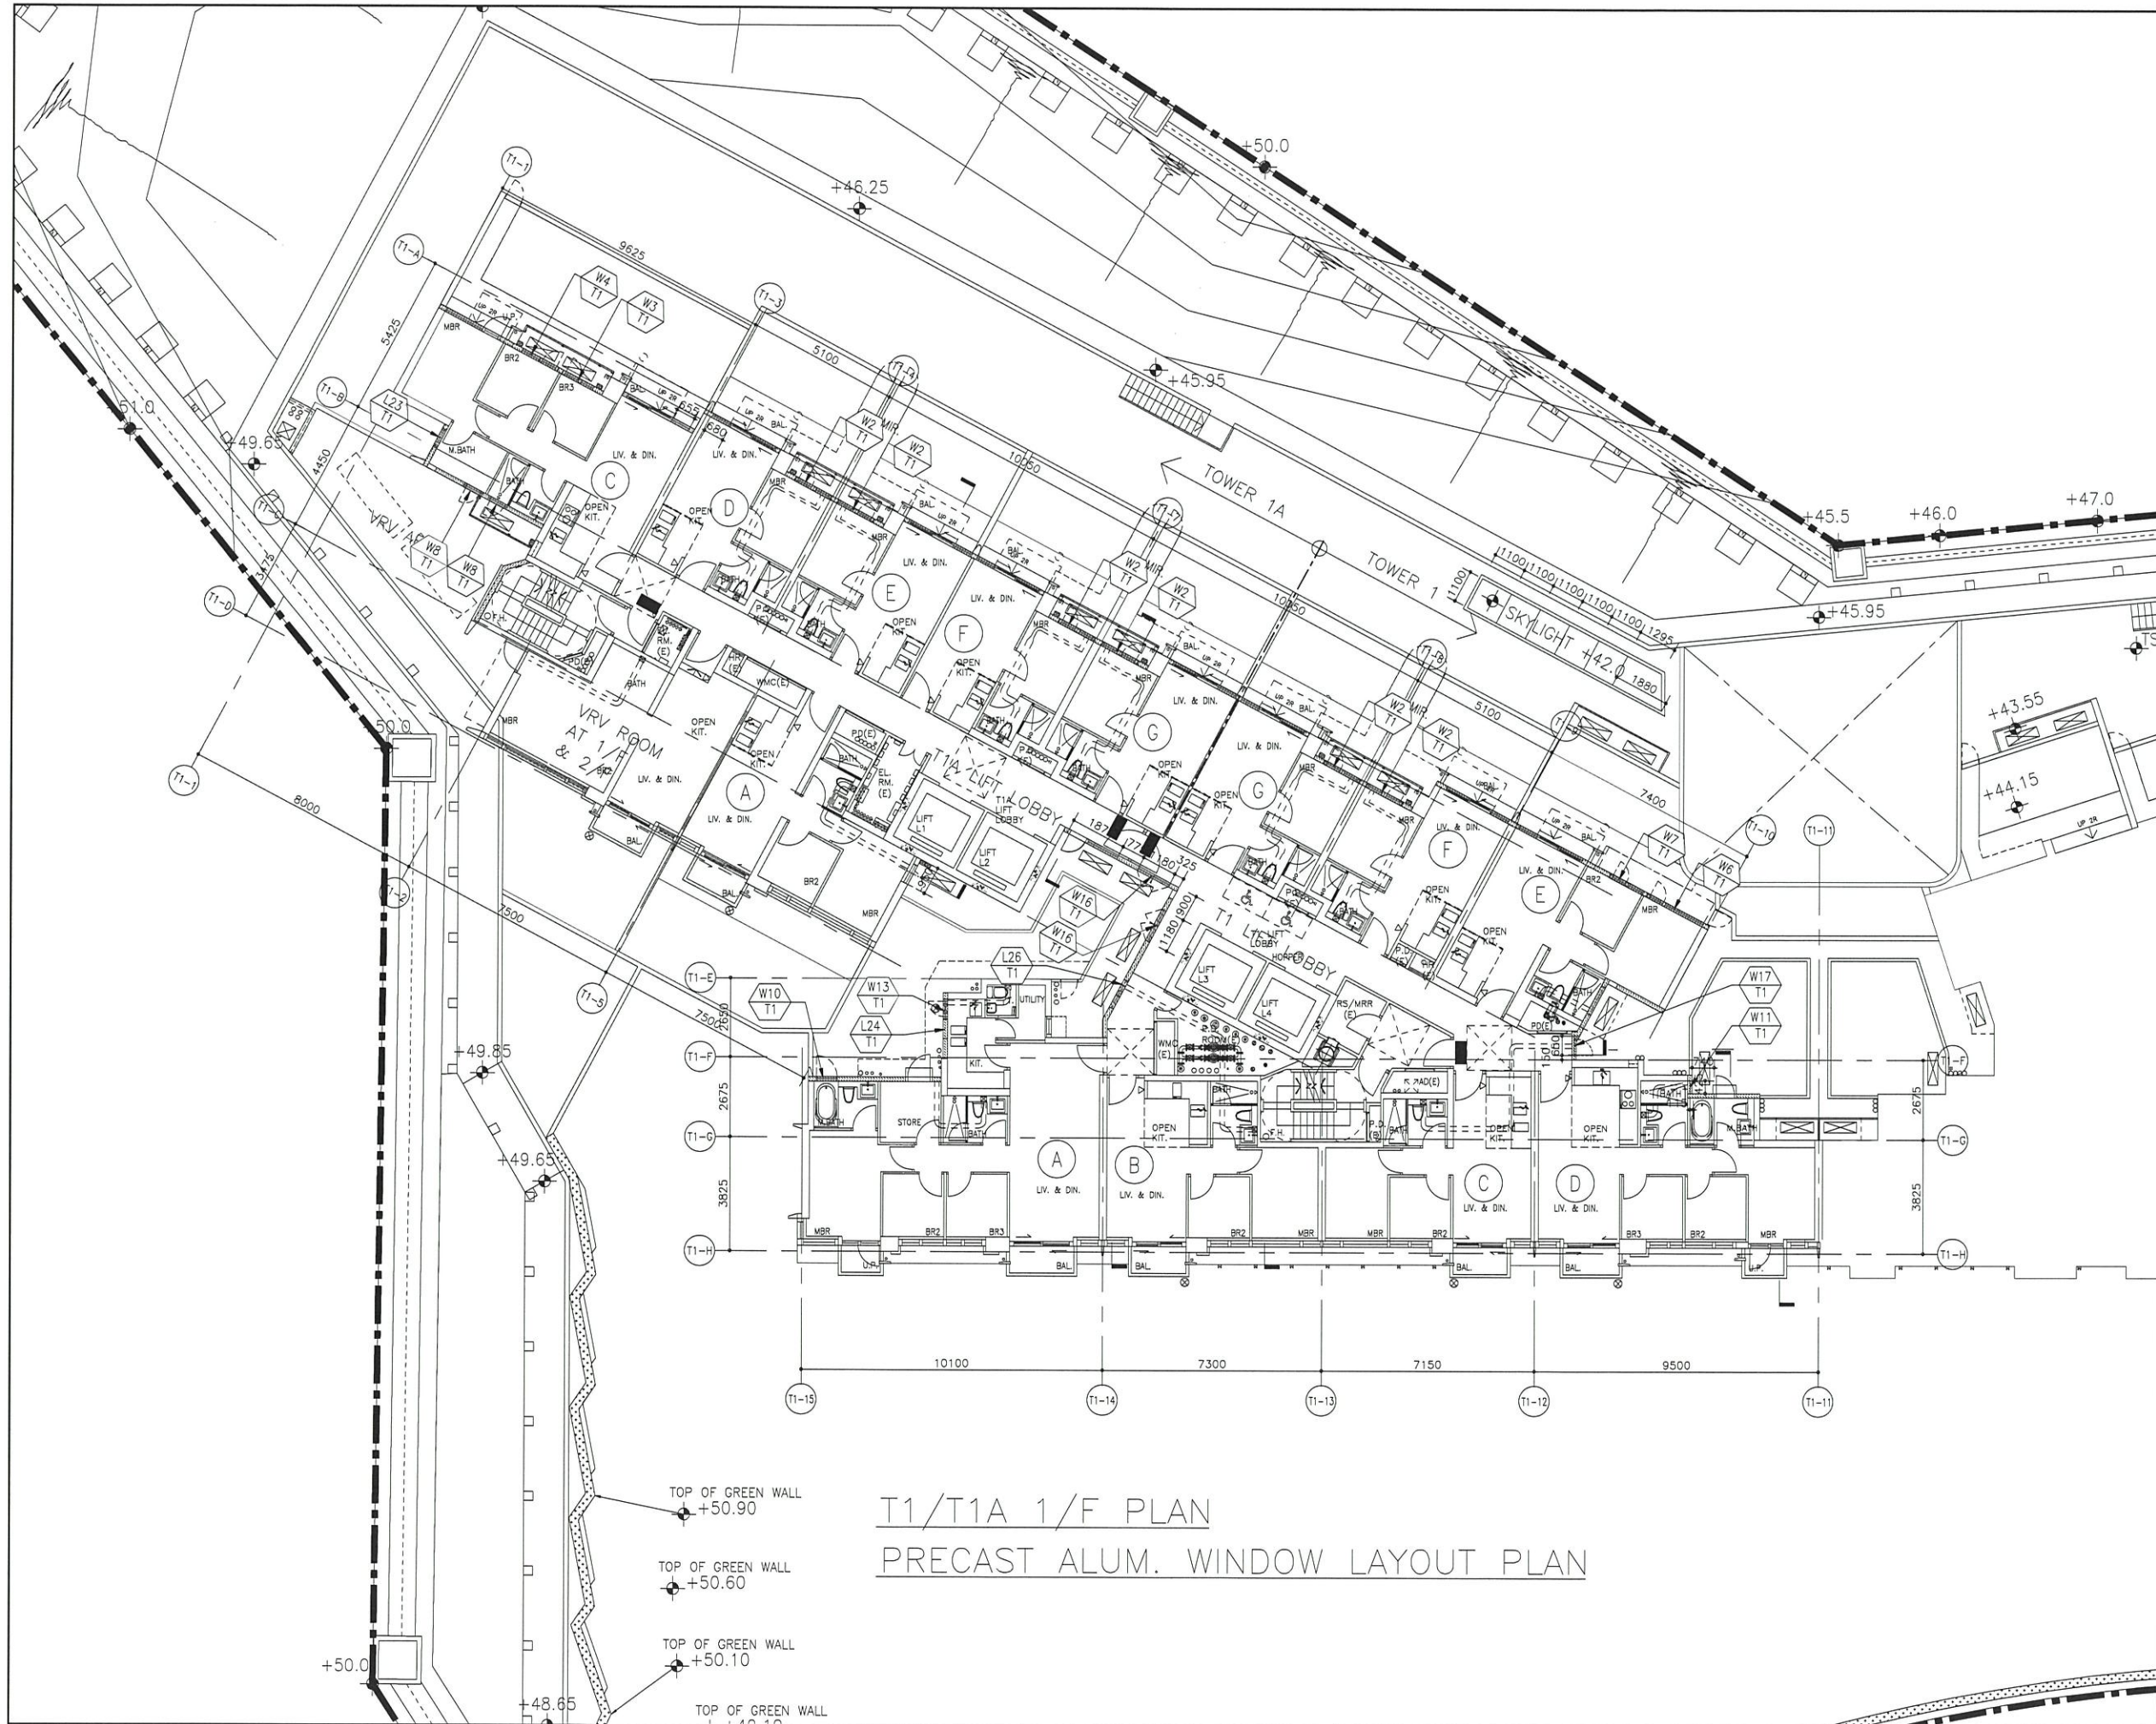

T1/T1A 1/F PLAN
 PRECAST ALUM. WINDOW LOCATION PLAN

B.D. REF :	
F.S.D. REF :	
Note : 1. All dimensions are in mm. 2. All elevations are viewed from outside. 3. All dimensions to be verified on site before fabrication.	
GENERAL NOTES	
Legend : 1. F.F.L.-- Finished Floor Level 2. S.F.L.-- Structural Floor Level 3. (R) -- Reversed Detail	
(X1)	DETAIL MARK NO.
(X001)	REFER SHEET NO.
NO.	DATE
REVISED	BY
CLIENT :	
佳明集團控股有限公司 GRAND MING GROUP HOLDINGS LIMITED	
MAIN CONTRACTOR :	
GRAND TECH CONSTRUCTION CO. LTD.	
ARCHITECT :	
WONG TUNG & PARTNERS LIMITED ARCHITECTS & PLANNERS 	
STRUCTURAL ENGINEER :	
 C M WONG & ASSOCIATES LTD	
 美特鋁質有限公司 MIDI ALUMINIUM FABRICATOR LTD. Units 6-8, Sunray Industrial Centre, 1/F 810 Cha Kwo Ling Road, Kowloon Tel: 23489211-4 Fax: (852) 2727666	
PROJECT :	
RESIDENTIAL DEVELOPMENT AT TSING YI TOWN LOT 190 SAI SHAN ROAD	
TITLE :	
TOWER 1/1A WINDOW LOCATION PLAN 1/F	
JOB NO. :	J-851
DRAWN BY : C.H.P.	DATE : 30-11-2019
CHKD BY :	SCALE A1: A3: 1:30
DWG. NO. : J851-PL-101	REV. : -

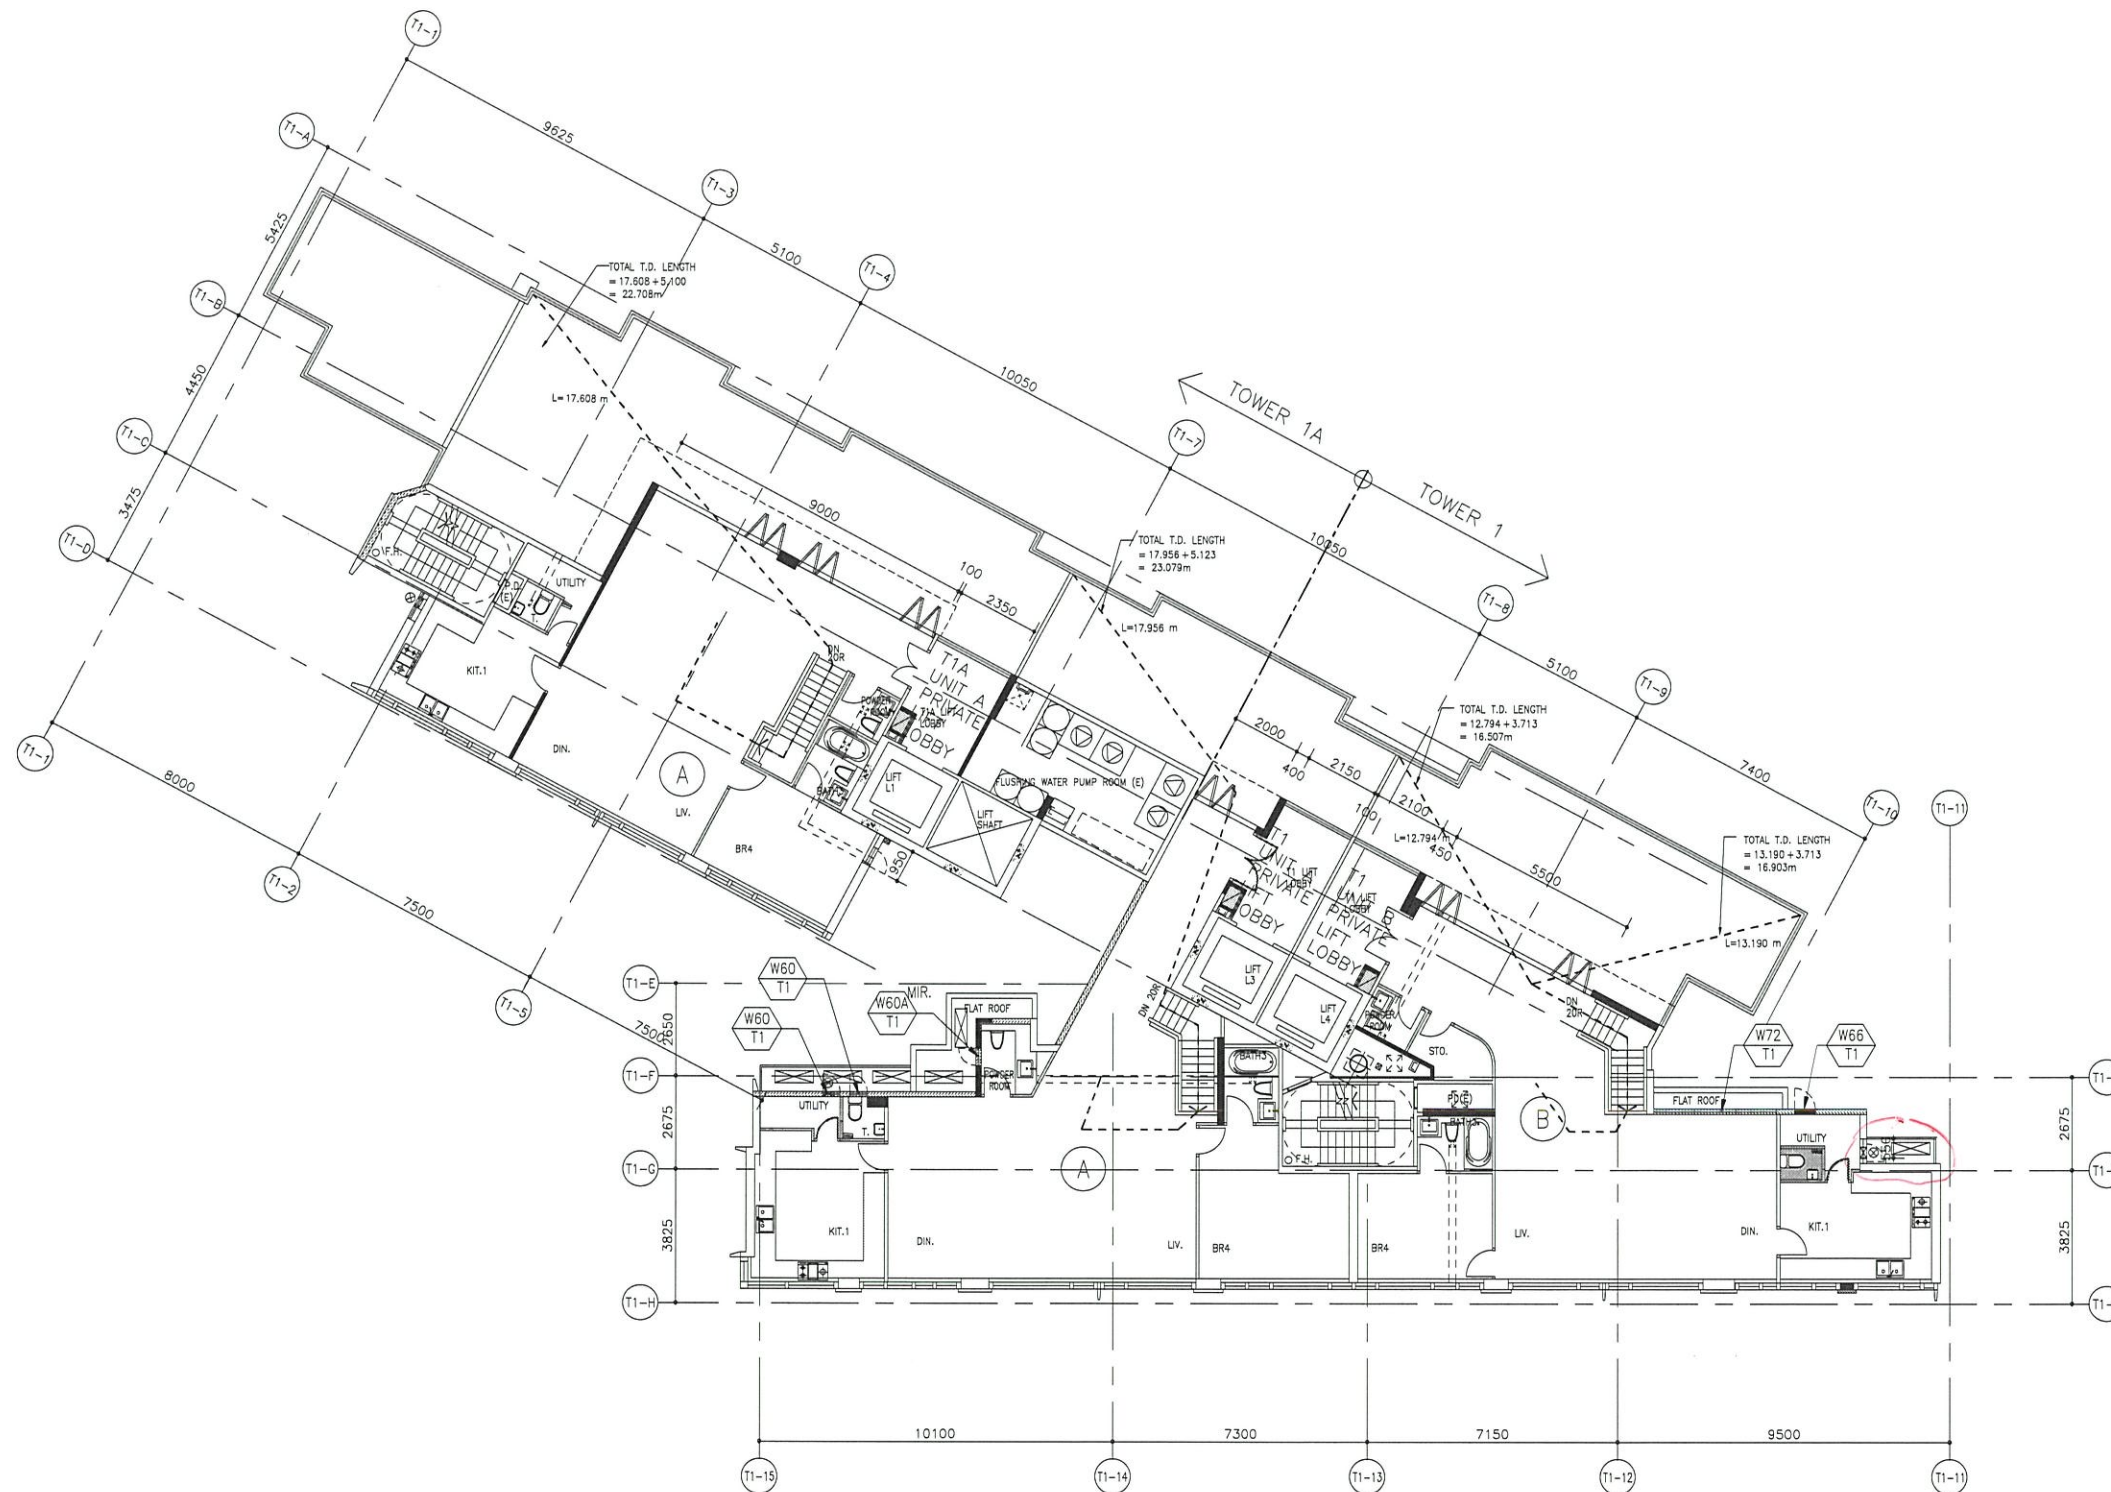

T1/T1A 35/F PLAN
 PRECAST ALUM. WINDOW LAYOUT PLAN

B.D. REF :
 F.S.D. REF :

Note :
 1. All dimensions are in mm.
 2. All elevations are viewed from outside.
 3. All dimensions to be verified on site before fabrication.

GENERAL NOTES

Legend :
 1. F.F.L.-- Finished Floor Level
 2. S.F.L.-- Structural Floor Level
 3. (R) -- Reversed Detail

X1 -- DETAIL MARK NO.
 X001 -- REFER SHEET NO.

NO.	DATE	GENERAL REVISION	REVISED	BY
A	XX.02.2020	GENERAL REVISION		

CLIENT :
 佳明集團控股有限公司
 GRAND MING GROUP HOLDINGS LIMITED

MAIN CONTRACTOR :
 GRAND TECH CONSTRUCTION CO. LTD.

ARCHITECT :
 WONG TUNG & PARTNERS LIMITED
 ARCHITECTS & PLANNERS

STRUCTURAL ENGINEER :


 C M WONG & ASSOCIATES LTD

美特鋁質有限公司
 MIDI ALUMINIUM FABRICATOR LTD.
 Units 6-8, Sunray Industrial Centre, 1/F
 610 Cha Kwo Ling Road, Kowloon
 Tel:23489211-4 Fax:(852)27727666

PROJECT :
 RESIDENTIAL DEVELOPMENT AT
 TSING YI TOWN LOT 190 SAI SHAN ROAD

TITLE :
 TOWER 1/1A WINDOW LOCATION PLAN
 35/F

JOB NO. : J-851
 DRAWN BY : C.H.P. DATE : 30-11-2019
 CHKD BY : SCALE A1: A3: 1:30
 DWG. NO. : J851-PL-105 REV. : A

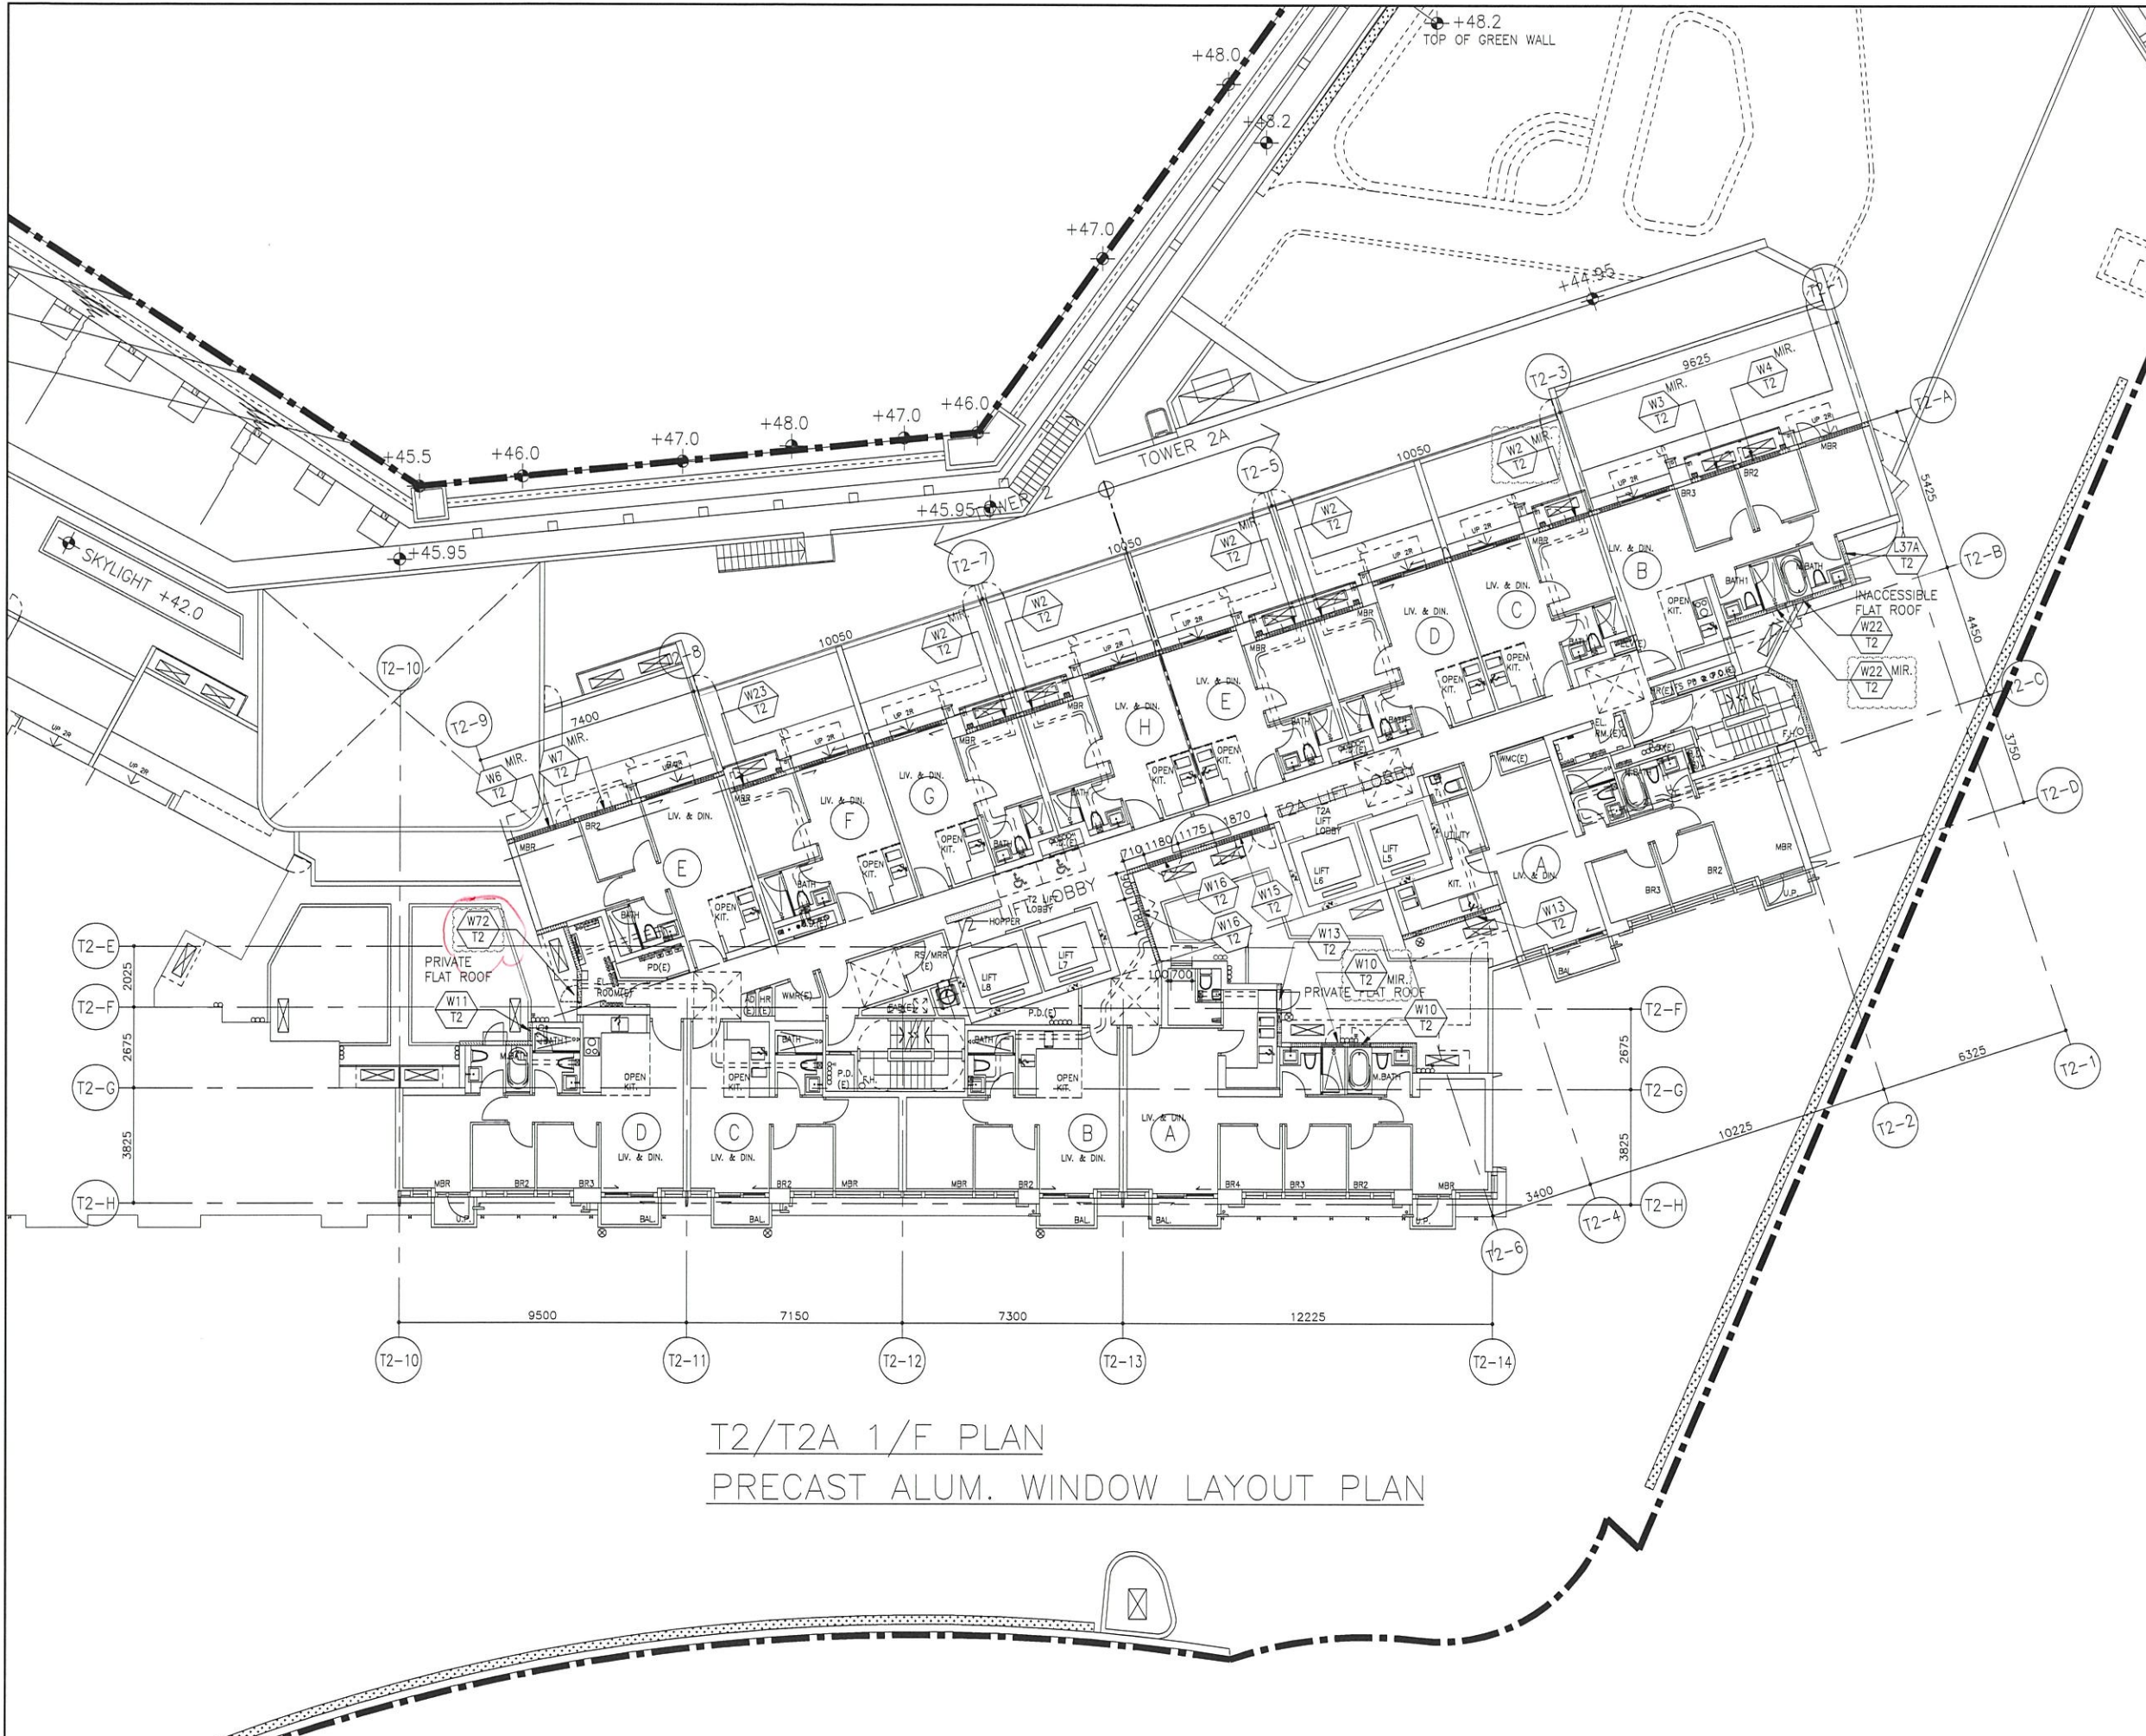

T2/T2A 1/F PLAN
 PRECAST ALUM. WINDOW LAYOUT PLAN

B.D. REF :
 F.S.D. REF :
 Note :
 1. All dimensions are in mm.
 2. All elevations are viewed from outside.
 3. All dimensions to be verified on site before fabrication.

GENERAL NOTES
 Legend :
 1. F.F.L.-- Finished Floor Level
 2. S.F.L.-- Structural Floor Level
 3. (R) -- Reversed Detail
 X1 -- DETAIL MARK NO.
 X001 -- REFER SHEET NO.

B	XX.02.2020	GENERAL REVISION	
A	06.02.2020	GENERAL REVISION	
NO.	DATE	REVISED	BY

CLIENT :
佳明集團控股有限公司
 GRAND MING GROUP HOLDINGS LIMITED

MAIN CONTRACTOR :
GRAND TECH CONSTRUCTION CO. LTD.

ARCHITECT :
WONG TUNG & PARTNERS LIMITED
 ARCHITECTS & PLANNERS

STRUCTURAL ENGINEER :


C M WONG & ASSOCIATES LTD

美特鋁質有限公司
 MIDI ALUMINIUM FABRICATOR LTD.
 Units 6-8, Sunray Industrial Centre, 1/F
 610 Cha Kwo Ling Road, Kowloon
 Tel: 23489211-4 Fax: (852) 2772666

PROJECT :
 RESIDENTIAL DEVELOPMENT AT
 TSING YI TOWN LOT 190 SAI SHAN ROAD

TITLE :
 TOWER 2/2A WINDOW LOCATION PLAN
 1/F

JOB NO. : J-851
 DRAWN BY : C.H.P. DATE : 30-11-2019
 CHKD BY : SCALE A1: A3: 1:30
 DWG. NO. : J851-PL-201 REV. : B

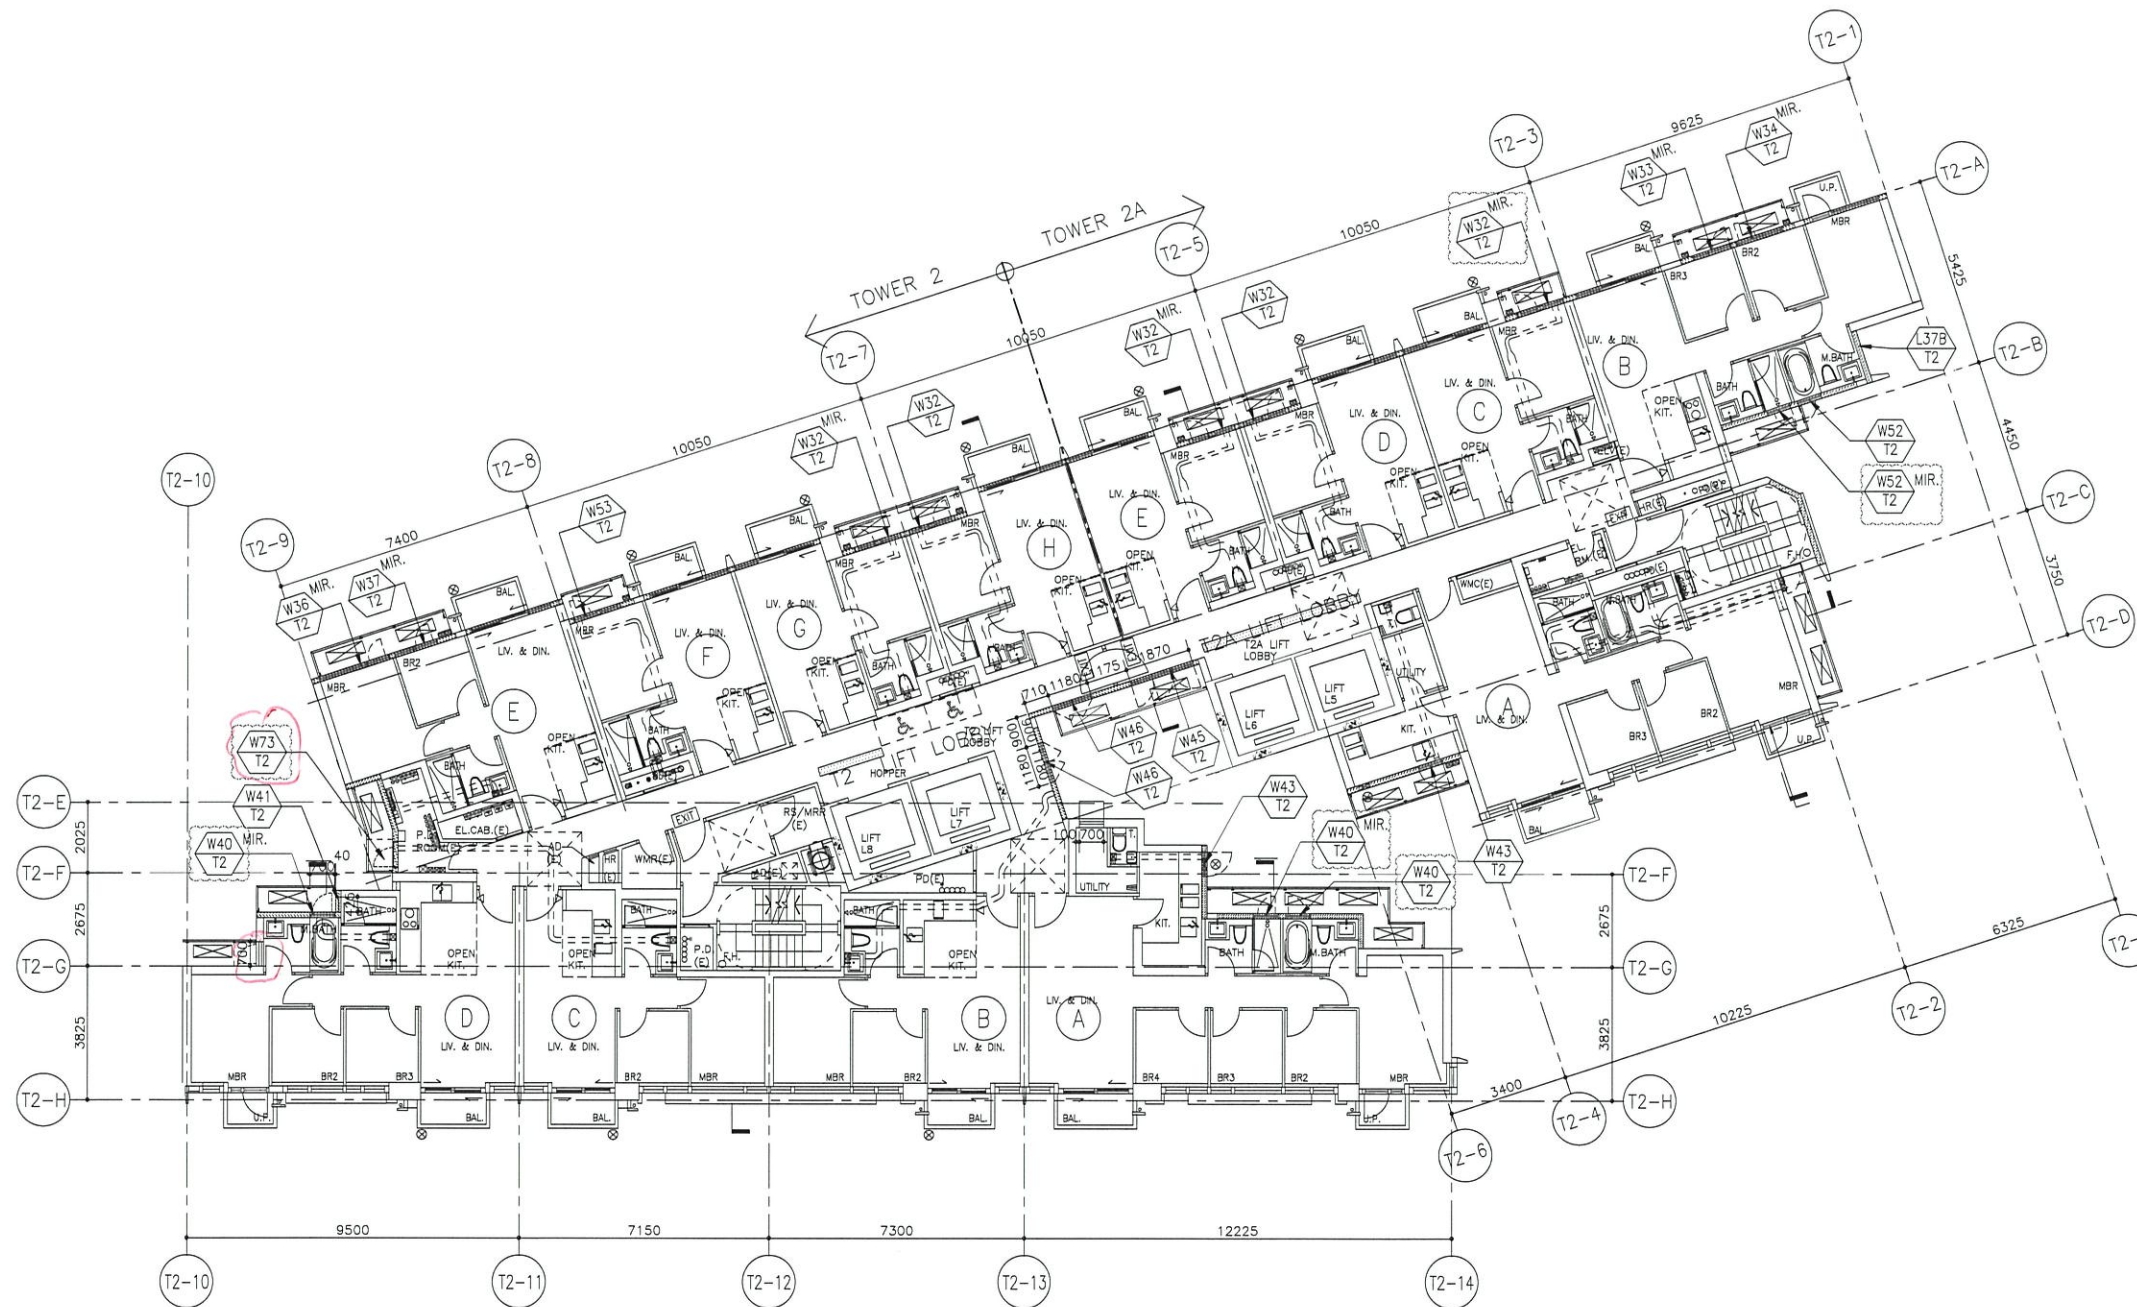

T2/T2A 32/F PLAN
 PRECAST ALUM. WINDOW LAYOUT PLAN

B.D. REF :

F.S.D. REF :

Note :
 1. All dimensions are in mm.
 2. All elevations are viewed from outside.
 3. All dimensions to be verified on site before fabrication.

GENERAL NOTES

Legend :
 1. F.F.L.-- Finished Floor Level
 2. S.F.L.-- Structural Floor Level
 3. (R) -- Reversed Detail

X1 -- DETAIL MARK NO.
 X001 -- REFER SHEET NO.

B	XX.02.2020	GENERAL REVISION	
A	06.02.2020	GENERAL REVISION	
NO.	DATE	REVISED	BY

CLIENT :
佳明集團控股有限公司
 GRAND MING GROUP HOLDINGS LIMITED

MAIN CONTRACTOR :
GRAND TECH CONSTRUCTION CO. LTD.

ARCHITECT :
WONG TUNG & PARTNERS LIMITED
 ARCHITECTS & PLANNERS



STRUCTURAL ENGINEER :
 **C M WONG & ASSOCIATES LTD**

 **美特鋁質有限公司**
 MIDI ALUMINIUM FABRICATOR LTD.
 Units 6-8, Sunray Industrial Centre, 1/F
 610 Cha Kwo Ling Road, Kowloon
 Tel:23489211-4 Fax:(852)27727666

PROJECT :
 RESIDENTIAL DEVELOPMENT AT
 TSING YI TOWN LOT 190 SAI SHAN ROAD


TITLE :
 TOWER 2/2A WINDOW LOCATION PLAN
 32/F

JOB NO. : J-851

DRAWN BY : C.H.P. DATE : 30-11-2019

CHKD BY : SCALE A1: A3: 1:30


DWG. NO. : J851-PL-203 REV. : B

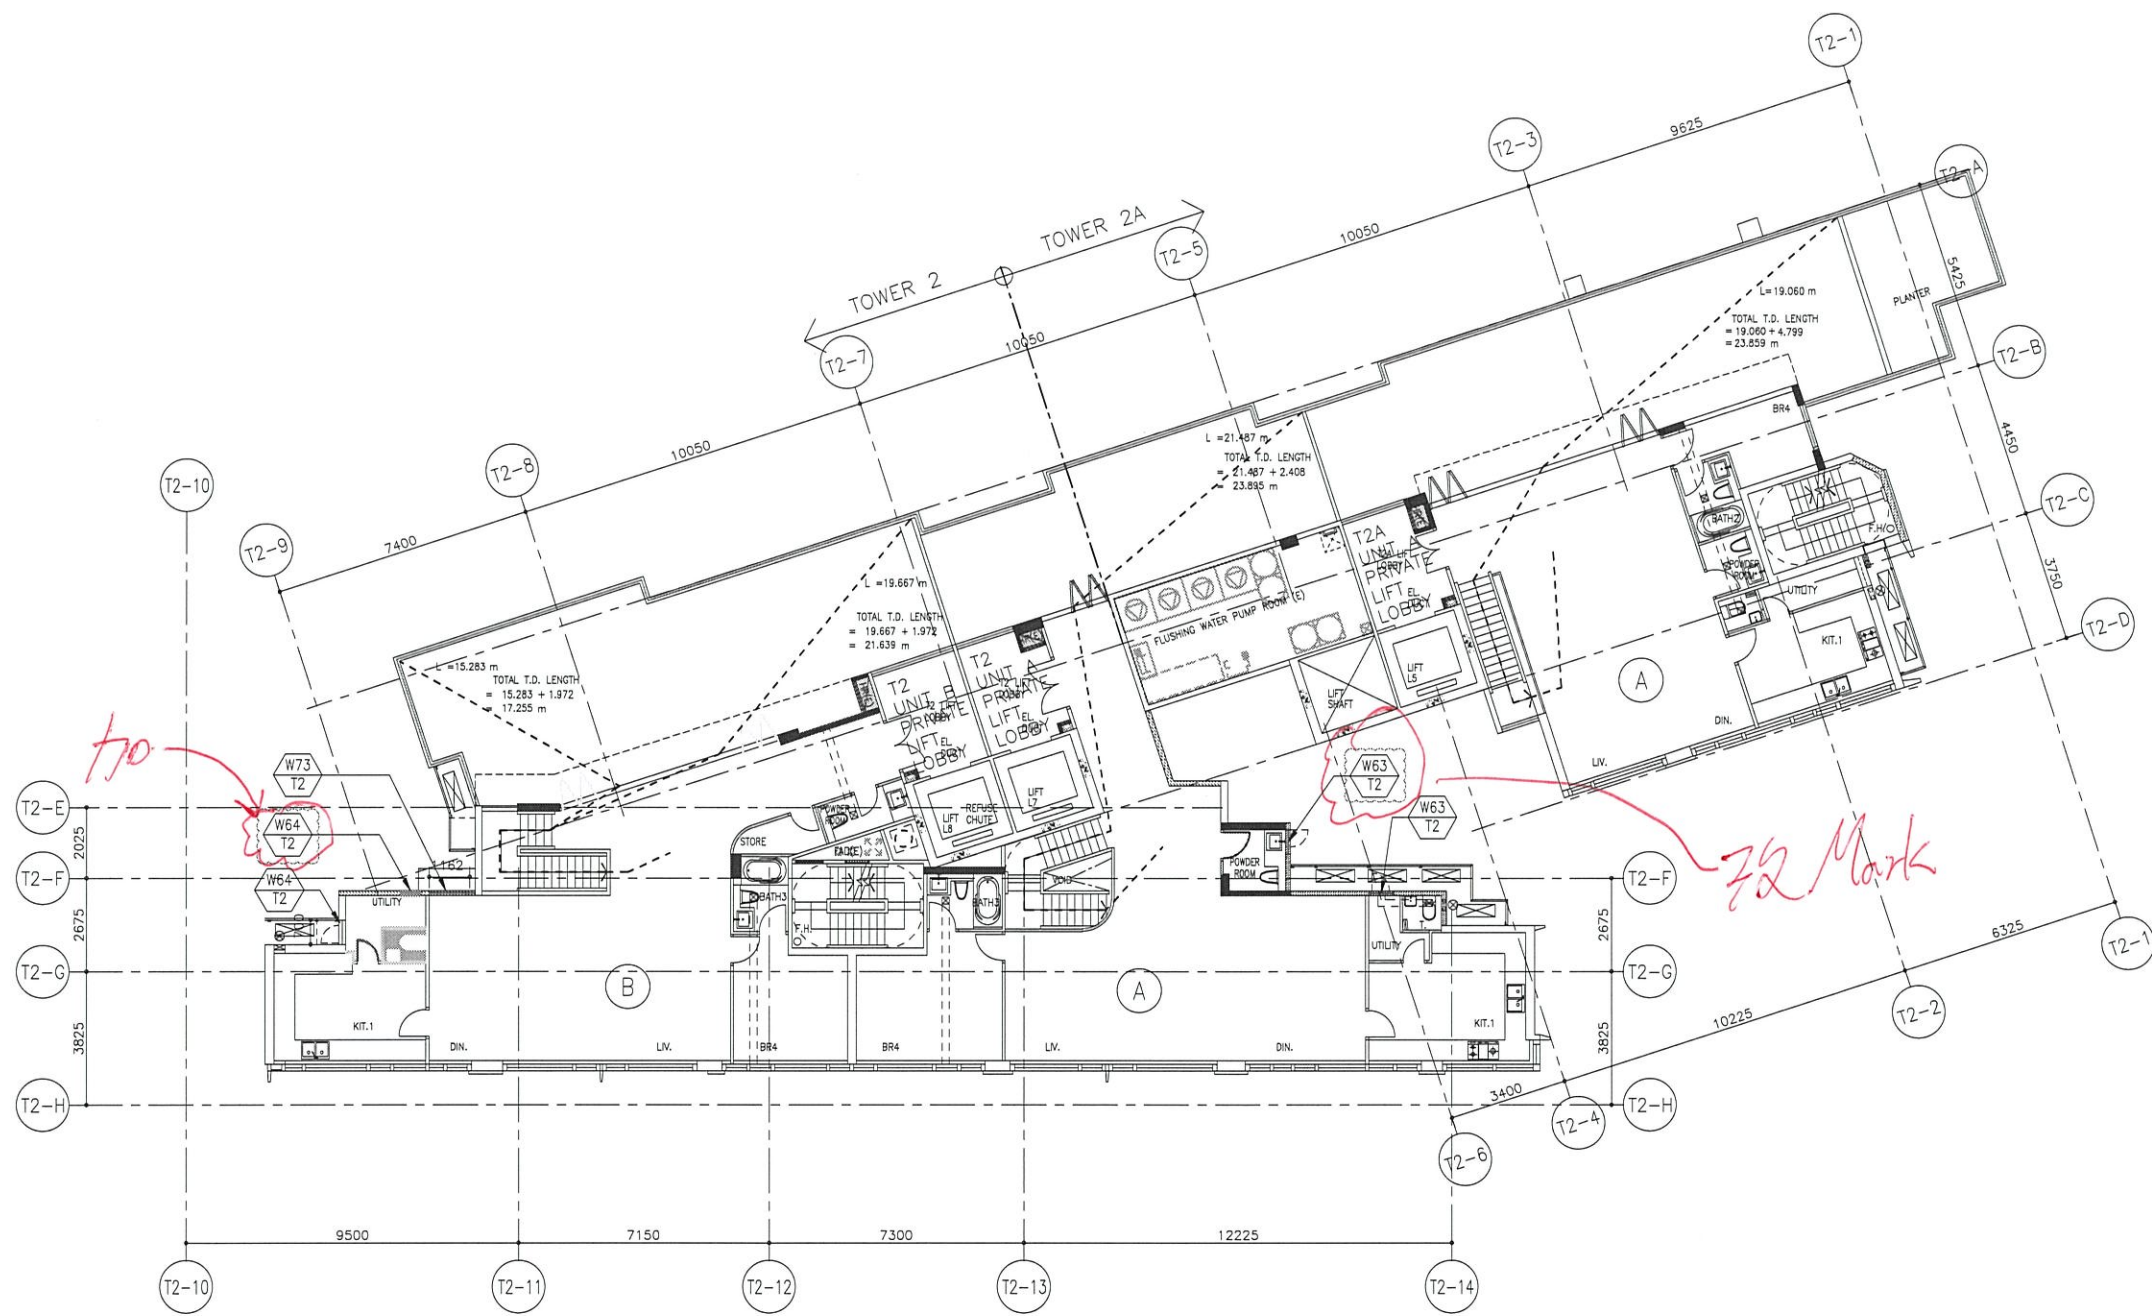


T2/T2A 35/F PLAN
 PRECAST ALUM. WINDOW LAYOUT PLAN

B.D. REF :											
F.S.D. REF :											
Note : 1. All dimensions are in mm. 2. All elevations are viewed from outside. 3. All dimensions to be verified on site before fabrication.											
GENERAL NOTES											
Legend : 1. F.F.L.-- Finished Floor Level 2. S.F.L.-- Structural Floor Level 3. (R) -- Reversed Detail											
(X1)	DETAIL MARK NO.										
(X001)	REFER SHEET NO.										
<table border="1" style="width: 100%; border-collapse: collapse;"> <thead> <tr> <th>NO.</th> <th>DATE</th> <th>GENERAL REVISION</th> <th>REVISED</th> <th>BY</th> </tr> </thead> <tbody> <tr> <td>A</td> <td>XX.02.2020</td> <td>GENERAL REVISION</td> <td></td> <td></td> </tr> </tbody> </table>		NO.	DATE	GENERAL REVISION	REVISED	BY	A	XX.02.2020	GENERAL REVISION		
NO.	DATE	GENERAL REVISION	REVISED	BY							
A	XX.02.2020	GENERAL REVISION									
CLIENT : 佳明集團控股有限公司 GRAND MING GROUP HOLDINGS LIMITED											
MAIN CONTRACTOR : GRAND TECH CONSTRUCTION CO. LTD.											
ARCHITECT : WONG TUNG & PARTNERS LIMITED ARCHITECTS & PLANNERS 											
STRUCTURAL ENGINEER : C M WONG & ASSOCIATES LTD											
美特鋁質有限公司 MIDI ALUMINIUM FABRICATOR LTD. Units 6-8, Sunray Industrial Centre, 1/F 610 Cha Kwo Ling Road, Kowloon Tel: 23489211-4 Fax: (852) 27727666											
PROJECT : RESIDENTIAL DEVELOPMENT AT TSING YI TOWN LOT 190 SAI SHAN ROAD											
TITLE : TOWER 2/2A WINDOW LOCATION PLAN 35/F											
JOB NO. : J-851											
DRAWN BY : C.H.P.	DATE : 30-11-2019										
CHKD BY :	SCALE A1: A3: 1:30										
DWG. NO. : J851-PL-205	REV. : A										


FREE AREA(%)	OPENABLE AREA	GLAZING AREA
57%	0.94	1.74

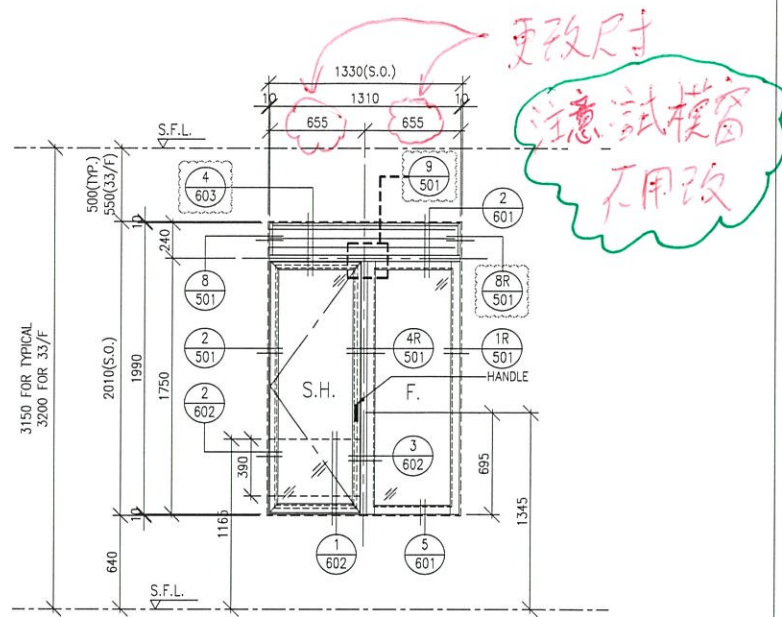

OPENABLE AREA	GLAZING AREA
1.05	1.43

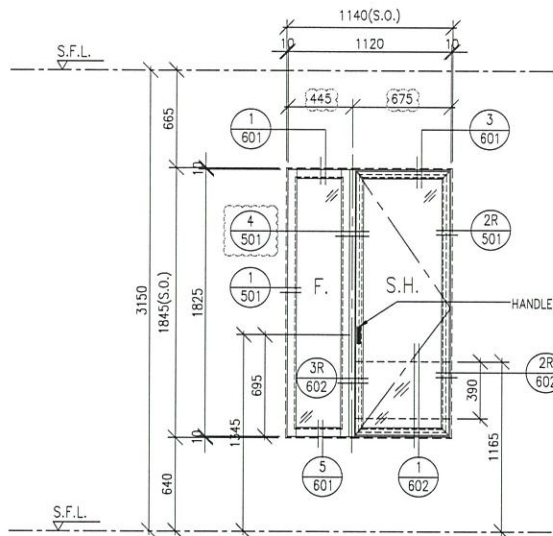

OPENABLE AREA	GLAZING AREA
1.05	1.81

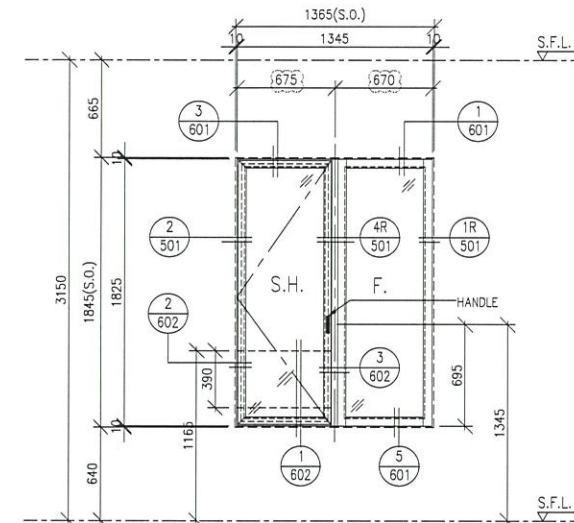

B.D. REF :
F.S.D. REF :
Note :
1. All dimensions are in mm.
2. All elevations are viewed from outside.
3. All dimensions to be verified on site before fabrication.

GENERAL NOTES
Legend :
1. F.F.L.-- Finished Floor Level
2. S.F.L.-- Structural Floor Level
3. (R) -- Reversed Detail
X1 -- DETAIL MARK NO.
X001 -- REFER SHEET NO.


WINDOW MARK **W2**
T1 84 nos.

LOCATION T1A FLAT E,G MBR. (1-31/F & 33/F ; 4,13,14,24/F OMITTED)
T1 FLAT F MBR. (1-31/F & 33/F ; 4,13,14,24/F OMITTED)

GLAZING GL02 FRAME AL11

REMARK 65mm ALUM. WINDOW SECTION

OPENABLE AREA	GLAZING AREA
1.05	3.07

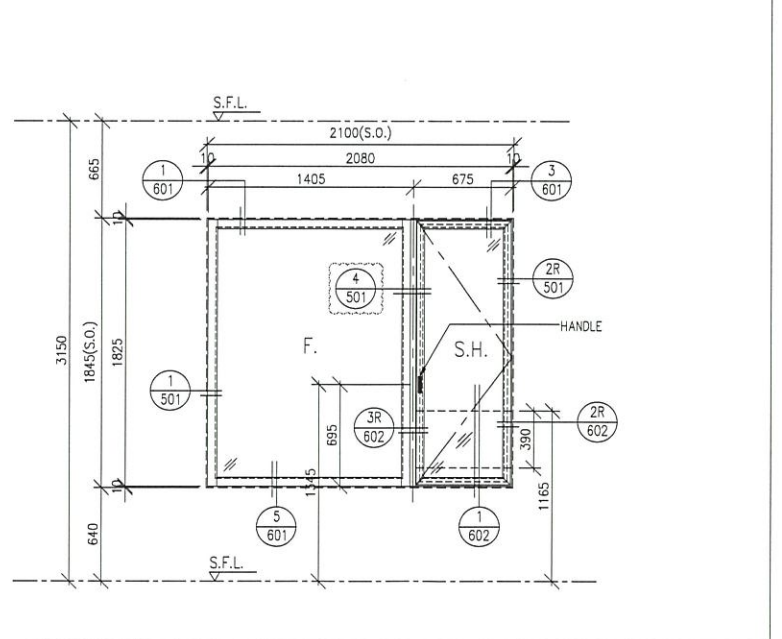

WINDOW MARK **W6**
T1 27 nos.

LOCATION T1 FLAT E MBR. (1-31/F; 4,13,14,24/F OMITTED)

GLAZING GL02 FRAME AL11

REMARK 65mm ALUM. WINDOW SECTION


WINDOW MARK **W3**
T1 27 nos.

LOCATION T1A FLAT C BR3. (1-31/F; 4,13,14,24/F OMITTED)

GLAZING GL02 FRAME AL11

REMARK 65mm ALUM. WINDOW SECTION

OPENABLE AREA	GLAZING AREA
1.05	1.60

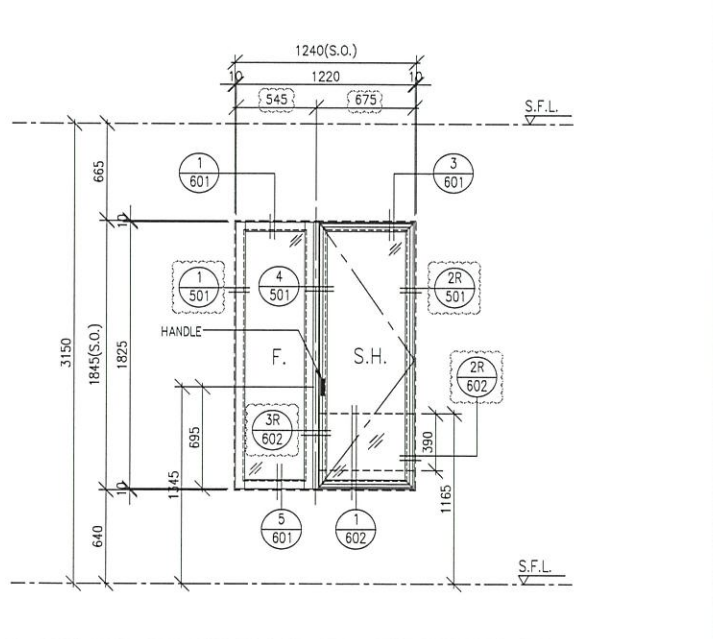

WINDOW MARK **W7**
T1 27 nos.

LOCATION T1 FLAT E BR2. (1-31/F; 4,13,14,24/F OMITTED)

GLAZING GL02 FRAME AL11

REMARK 65mm ALUM. WINDOW SECTION


WINDOW MARK **W4**
T1 27 nos.

LOCATION T1A FLAT C BR2. (1-31/F; 4,13,14,24/F OMITTED)

GLAZING GL02 FRAME AL11

REMARK 65mm ALUM. WINDOW SECTION

OPENABLE AREA	GLAZING AREA
0.52	0.43

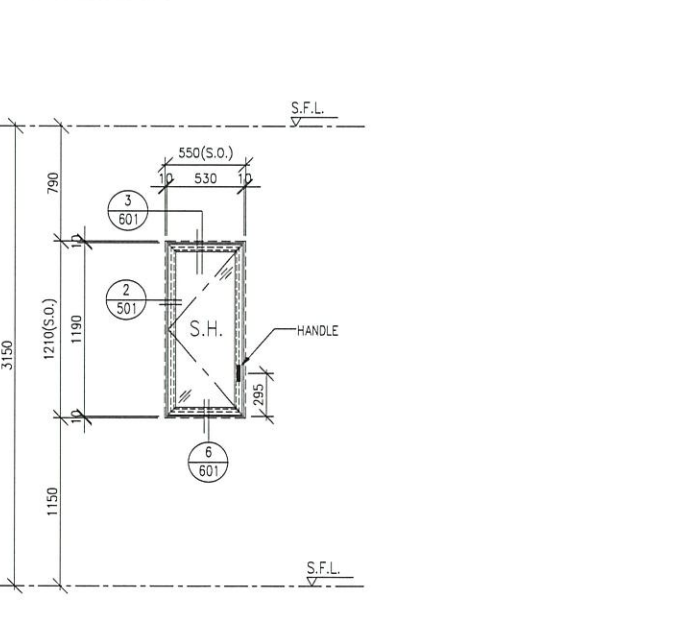

WINDOW MARK **W8**
T1 54 nos.

LOCATION T1A FLAT C M.BATH. (1-31/F; 4,13,14,24/F OMITTED)
T1A FLAT C BATH1. (1-31/F; 4,13,14,24/F OMITTED)

GLAZING GL06 FRAME AL11

REMARK 65mm ALUM. WINDOW SECTION

B	XX.02.2020	GENERAL REVISION	
A	06.02.2020	GENERAL REVISION	
NO.	DATE	REVISED	BY

CLIENT : 佳明集團控股有限公司
GRAND MING GROUP HOLDINGS LIMITED

MAIN CONTRACTOR : GRAND TECH CONSTRUCTION CO. LTD.

ARCHITECT : WONG TUNG & PARTNERS LIMITED
ARCHITECTS & PLANNERS
WT




STRUCTURAL ENGINEER : C M WONG & ASSOCIATES LTD

美特鋁質有限公司
MIDI ALUMINIUM FABRICATOR LTD.
Units 6-8, Sunray Industrial Centre, 1/F
610 Cha Kwo Ling Road, Kowloon
Tel:23489211-4 Fax:(852)2727666

PROJECT : RESIDENTIAL DEVELOPMENT AT
TSING YI TOWN LOT 190 SAI SHAN ROAD

TITLE : WINDOW SCHEDULE FOR PRECAST FACADE OF T1/T1A (1 OF 6)

JOB NO. : J-851
DRAWN BY : C.H.P. DATE : 30-11-2019
CHKD BY : SCALE A1: A3: 1:30
DWG. NO. : J851-SCH-101 REV. : B

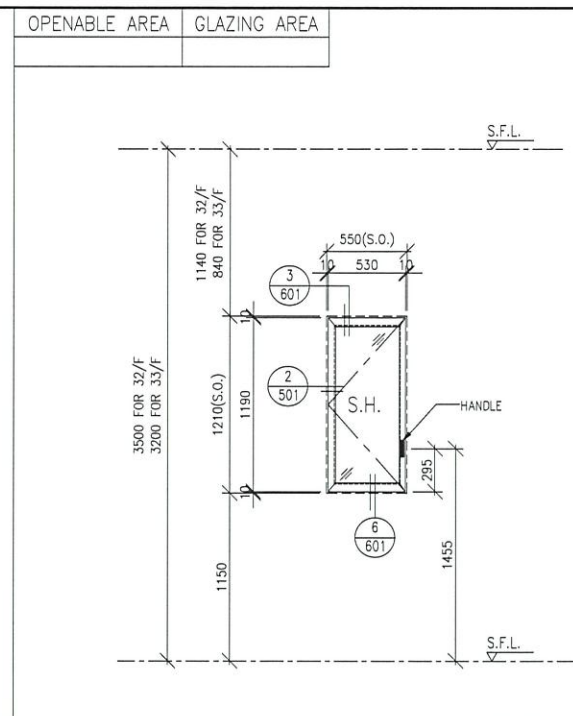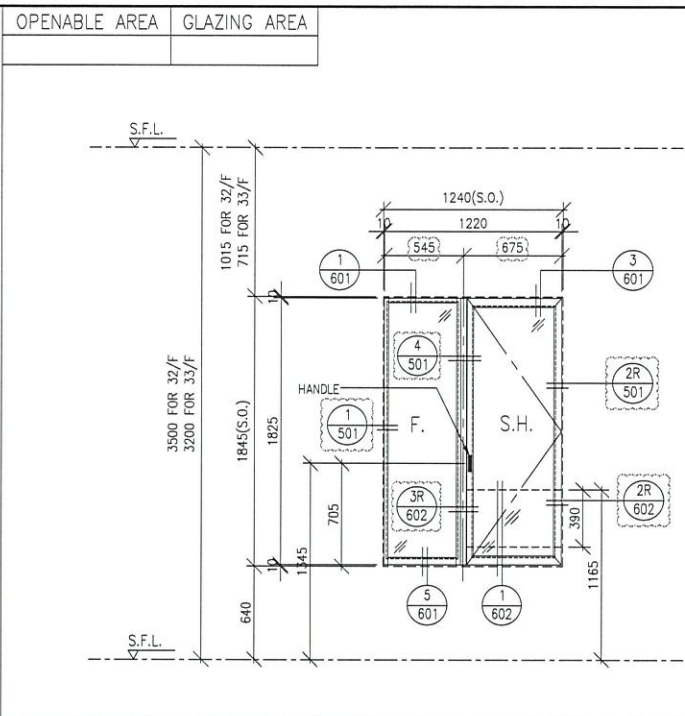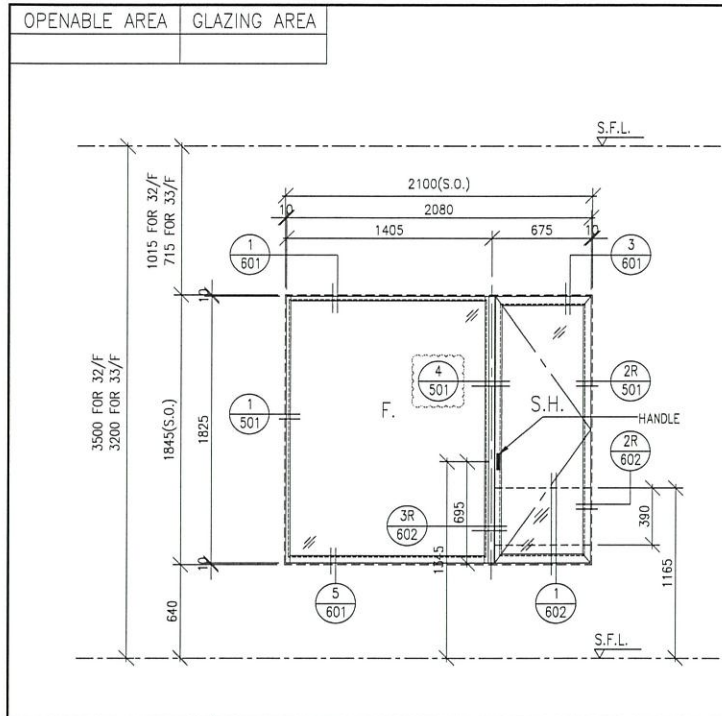

WINDOW MARK 2 nos.

LOCATION T1 FLAT E MBR. (32-33/F)

GLAZING GL02 FRAME AL11

REMARK 65mm ALUM. WINDOW SECTION

FREE AREA(%)	OPENABLE AREA	GLAZING AREA
57%		

WINDOW MARK 2 nos.

LOCATION T1 FLAT E BR2. (32-33/F)

GLAZING GL02 FRAME AL11

REMARK 65mm ALUM. WINDOW SECTION

FREE AREA(%)	OPENABLE AREA	GLAZING AREA
57%		




WINDOW MARK 4 nos.

LOCATION T1A FLAT C M.BATH. (32-33/F)
T1A FLAT C BATH1. (32-33/F)

GLAZING GL06 FRAME AL11

REMARK 65mm ALUM. WINDOW SECTION

FREE AREA(%)	OPENABLE AREA	GLAZING AREA
57%		

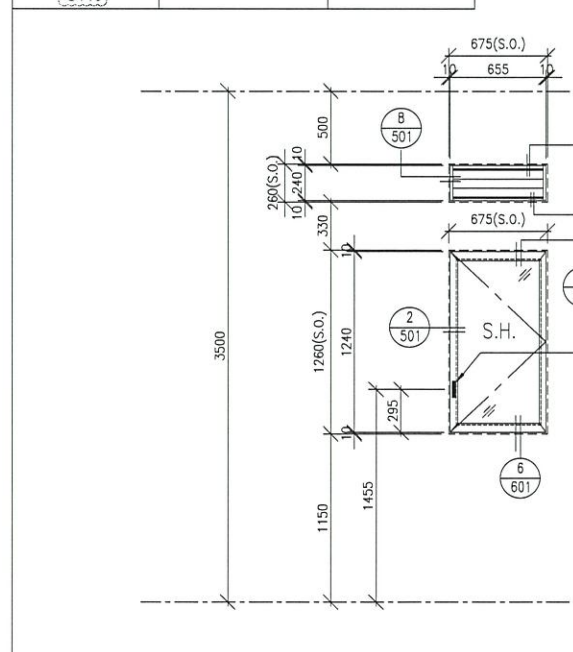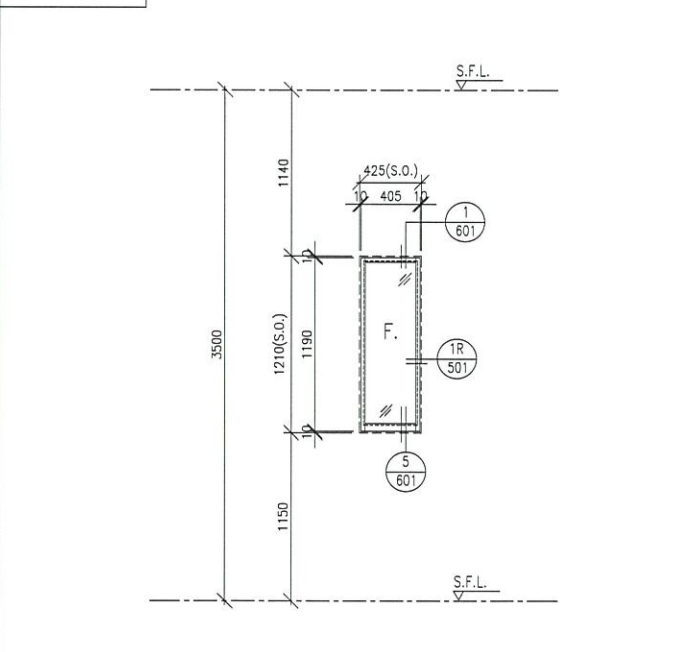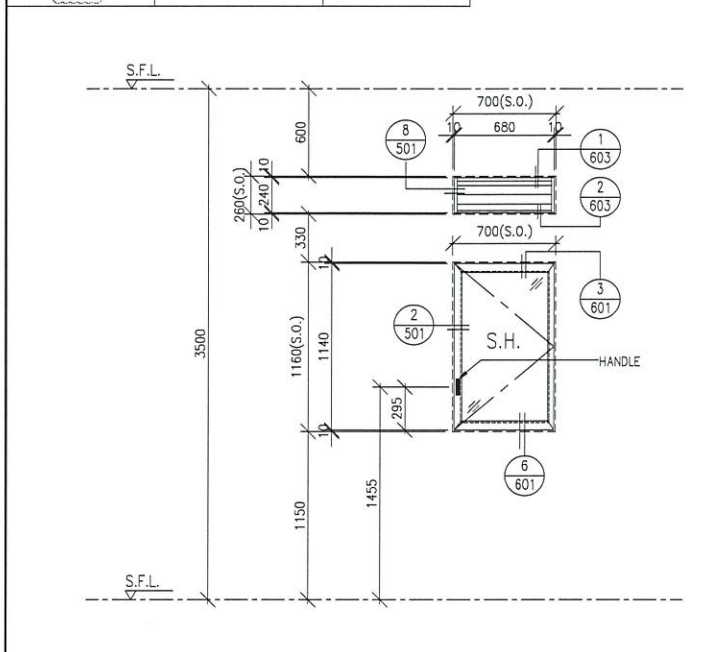

WINDOW MARK 1 no.

LOCATION T1 FLAT A M.BATH. (32/F)

GLAZING GL06 FRAME AL11

REMARK 65mm ALUM. WINDOW SECTION

WINDOW MARK 1 no.

LOCATION T1 FLAT D BATH1. (32/F)

GLAZING GL06 FRAME AL11

REMARK 65mm ALUM. WINDOW SECTION

WINDOW MARK 1 no.

LOCATION T1 FLAT A KIT. (32/F)

GLAZING GL02 FRAME AL11

REMARK 65mm ALUM. WINDOW SECTION

B.D. REF :
F.S.D. REF :
Note :
1. All dimensions are in mm.
2. All elevations are viewed from outside.
3. All dimensions to be verified on site before fabrication.

GENERAL NOTES

- Legend :
1. F.F.L.-- Finished Floor Level
2. S.F.L.-- Structural Floor Level
3. (R) -- Reversed Detail
 -- DETAIL MARK NO.
 -- REFER SHEET NO.

NO.	DATE	REVISION	BY
B	XX.02.2020	GENERAL REVISION	
A	06.02.2020	GENERAL REVISION	

CLIENT :
佳明集團控股有限公司
GRAND MING GROUP HOLDINGS LIMITED

MAIN CONTRACTOR :
GRAND TECH CONSTRUCTION CO. LTD.

ARCHITECT :
WONG TUNG & PARTNERS LIMITED
ARCHITECTS & PLANNERS

STRUCTURAL ENGINEER :
C M WONG & ASSOCIATES LTD

美特鋁質有限公司
MIDI ALUMINIUM FABRICATOR LTD.

Units 6-8, Sunray Industrial Centre, 1/F
610 Cha Kwo Ling Road, Kowloon
Tel: 23489211-4 Fax: (852) 27727666

PROJECT :
RESIDENTIAL DEVELOPMENT AT
TSING YI TOWN LOT 190 SAI SHAN ROAD




TITLE :
WINDOW SCHEDULE
FOR PRECAST FACADE
OF T1/T1A (4 OF 6)

JOB NO. : J-851

DRAWN BY : C.H.P. DATE : 30-11-2019

CHKD BY : SCALE A1: 1:30

DWG. NO. : J851-SCH-104 REV. : B

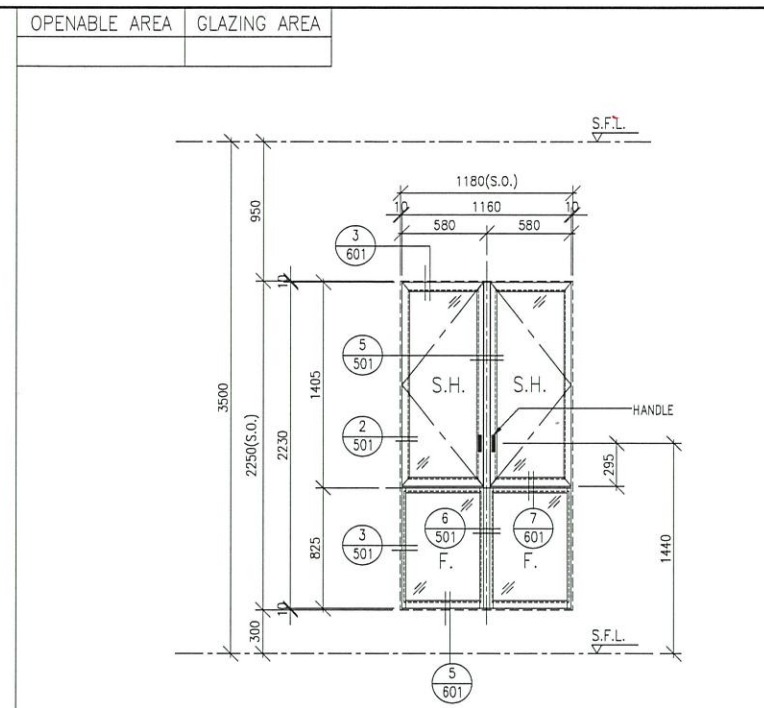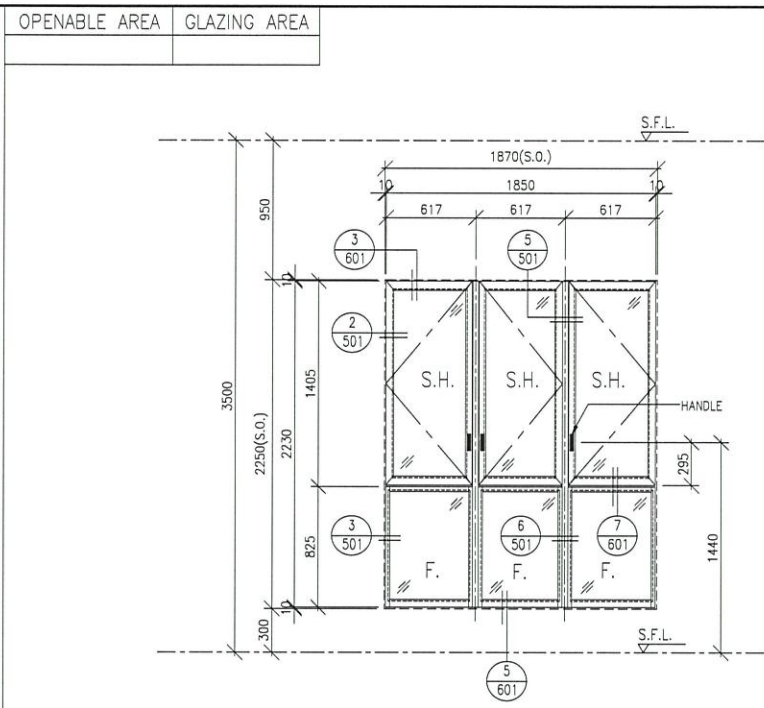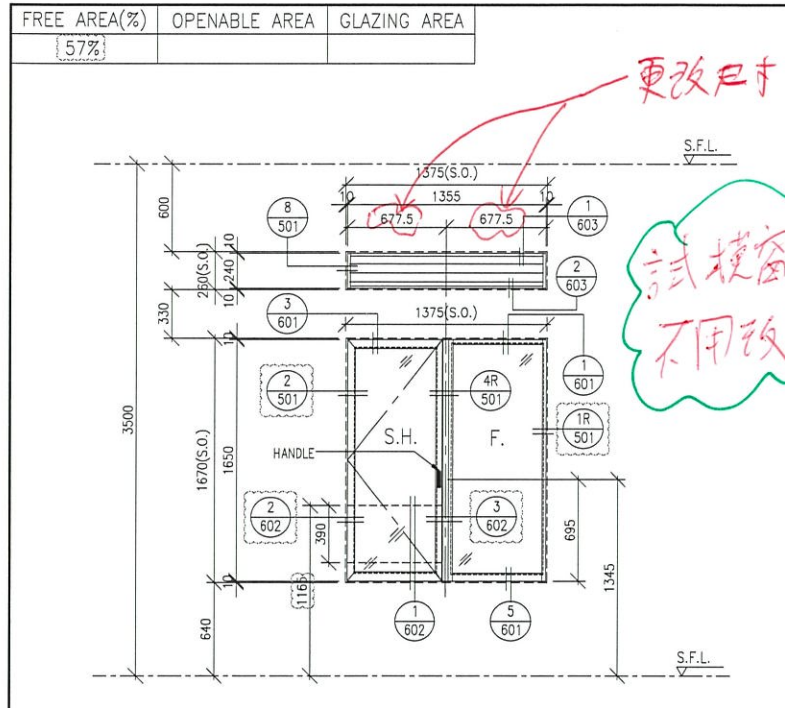

B.D. REF :
 F.S.D. REF :
 Note :
 1. All dimensions are in mm.
 2. All elevations are viewed from outside.
 3. All dimensions to be verified on site before fabrication.




GENERAL NOTES
 Legend :
 1. F.F.L.-- Finished Floor Level
 2. S.F.L.-- Structural Floor Level
 3. (R) -- Reversed Detail
 X1 -- DETAIL MARK NO.
 X001 -- REFER SHEET NO.

WINDOW MARK	W44 T1 1 nos.		
LOCATION	T1 FLAT A STORE (32/F)		
GLAZING	GL02	FRAME	AL11
REMARK	65mm ALUM. WINDOW SECTION		

WINDOW MARK	W45 T1 2 nos.		
LOCATION	T1A LOBBY CORRIDOR (32-33/F)		
GLAZING	GL08	FRAME	AL11
REMARK	65mm ALUM. WINDOW SECTION		

WINDOW MARK	W46 T1 4 nos.		
LOCATION	T1 LOBBY CORRIDOR (32-33/F)		
GLAZING	GL08	FRAME	AL11
REMARK	65mm ALUM. WINDOW SECTION		

B	XX.02.2020	GENERAL REVISION	
A	08.02.2020	GENERAL REVISION	
NO.	DATE	REVISED	BY

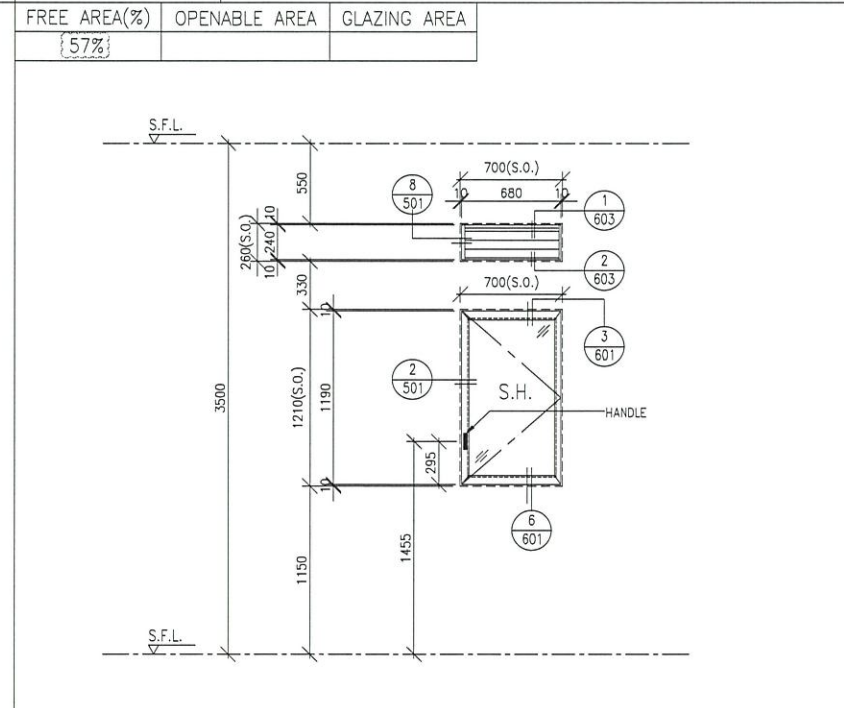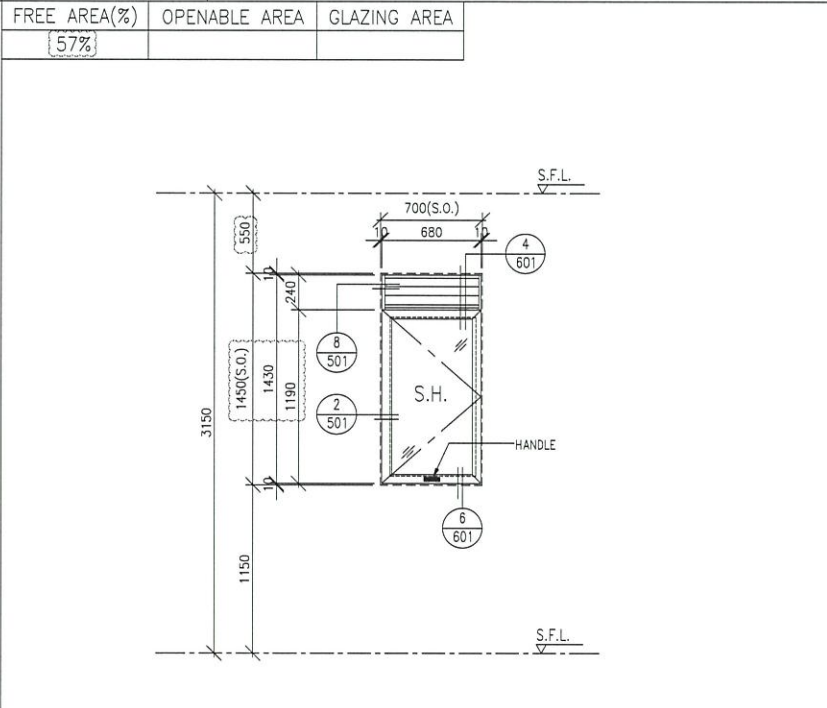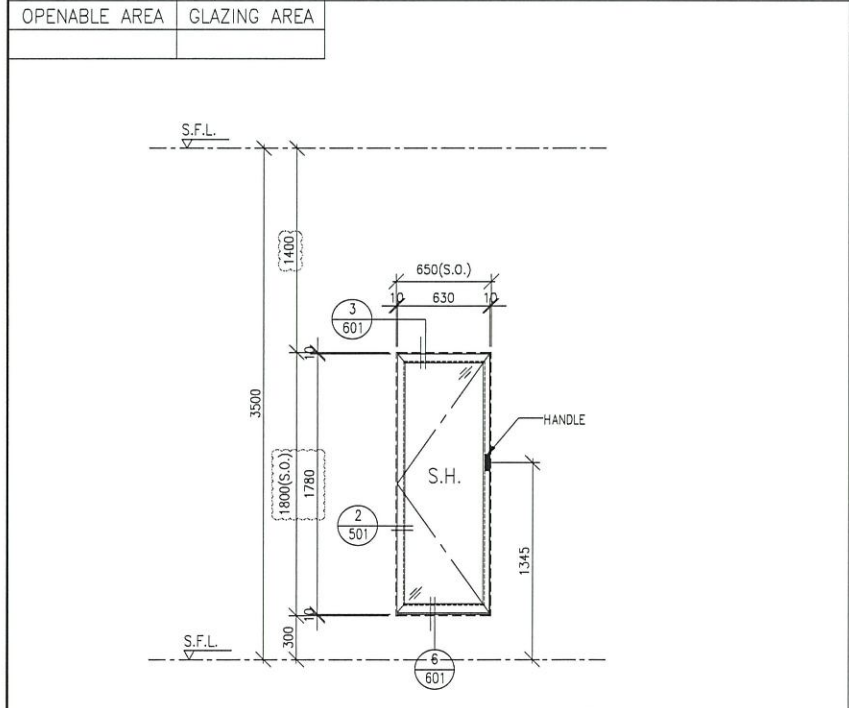

CLIENT :
佳明集團控股有限公司
 GRAND MING GROUP HOLDINGS LIMITED
 MAIN CONTRACTOR :
GRAND TECH CONSTRUCTION CO. LTD.
 ARCHITECT :
WONG TUNG & PARTNERS LIMITED
 ARCHITECTS & PLANNERS
 STRUCTURAL ENGINEER :
C M WONG & ASSOCIATES LTD
美特鋁質有限公司
 MIDI ALUMINIUM FABRICATOR LTD.
 Units 6-8, Sunray Industrial Centre, 1/F
 610 Cha Kwo Ling Road, Kowloon
 Tel:23489211-4 Fax:(852)27727666
 PROJECT :
 RESIDENTIAL DEVELOPMENT AT
 TSING YI TOWN LOT 190 SAI SHAN ROAD

WINDOW MARK	W47 T1 2 nos.		
LOCATION	T1 LOBBY CORRIDOR (32-33/F)		
GLAZING	GL06	FRAME	AL11
REMARK	65mm ALUM. WINDOW SECTION		

WINDOW MARK	W10A T1 26 nos.		
LOCATION	T1 FLAT D M.BATH. (2-31/F; 4,13,14,24/F OMITTED)		
GLAZING	GL06	FRAME	AL11
REMARK	65mm ALUM. WINDOW SECTION		

WINDOW MARK	W40A T1 1 no.		
LOCATION	T1 FLAT D M.BATH. (32/F)		
GLAZING	GL06	FRAME	AL11
REMARK	65mm ALUM. WINDOW SECTION		

TITLE :	WINDOW SCHEDULE FOR PRECAST FACADE OF T1/T1A (5 OF 6)		
JOB NO. :	J-851		
DRAWN BY : C.H.P.	DATE : 30-11-2019		
CHKD BY :	SCALE A1: A3: 1:30		
DWG. NO. : J851-SCH-105	REV. : B		

FREE AREA(%)	OPENABLE AREA	GLAZING AREA	WINDOW MARK	LOCATION	GLAZING	FRAME	AL11	REMARK
57%			W60 T1	T1 FLAT A UTILITY RM (35/F)	GL06		AL11	65mm ALUM. WINDOW SECTION
57%			W60A T1	T1 FLAT A POWDER ROOM (35/F)	GL06		AL11	65mm ALUM. WINDOW SECTION
57%			W61 T1	T1 FLAT B UTILITY RM (35/F)	GL06		AL11	65mm ALUM. WINDOW SECTION
57%			W66 T1	T1 FLAT B UTILITY RM (35/F)	GL06		AL11	65mm ALUM. WINDOW SECTION
57%			W72 T1	T1 FLAT B LIV. & DIN. (35/F)	GL02		AL11	65mm ALUM. WINDOW SECTION
57%			W38A T1	T1 FLAT A M.BATH1. (33/F)	GL06		AL11	65mm ALUM. WINDOW SECTION
57%			W64 T1	T1A FLAT B M.BATH1. (33/F)	GL06		AL11	65mm ALUM. WINDOW SECTION

B.D. REF :
F.S.D. REF :
Note :
1. All dimensions are in mm.
2. All elevations are viewed from outside.
3. All dimensions to be verified on site before fabrication.

GENERAL NOTES
Legend :
1. F.F.L.-- Finished Floor Level
2. S.F.L.-- Structural Floor Level
3. (R) -- Reversed Detail
X1 -- DETAIL MARK NO.
X001 -- REFER SHEET NO.


B	XX.02.2020	GENERAL REVISION
A	06.02.2020	GENERAL REVISION
NO.	DATE	REVISED


CLIENT :
佳明集團控股有限公司
GRAND MING GROUP HOLDINGS LIMITED
MAIN CONTRACTOR :
GRAND TECH CONSTRUCTION CO. LTD.
ARCHITECT :
WONG TUNG & PARTNERS LIMITED
ARCHITECTS & PLANNERS
WT
STRUCTURAL ENGINEER :
C M WONG & ASSOCIATES LTD
美特鋁質有限公司
MIDI ALUMINIUM FABRICATOR LTD.
Units 6-8, Sunray Industrial Centre, 1/F
510 Cho Kwo Ling Road, Kowloon
Tel:23489211-4 Fax:(852)27727666
PROJECT :
RESIDENTIAL DEVELOPMENT AT
TSING YI TOWN LOT 190 SAI SHAN ROAD

TITLE :
WINDOW SCHEDULE
FOR PRECAST FACADE
OF T1/T1A (6 OF 6)
JOB NO. : J-851
DRAWN BY : C.H.P. DATE : 30-11-2019
CHKD BY : SCALE A1: A3: 1:30
DWG. NO. : J851-SCH-106 REV. : B

<p>FREE AREA(%) 57%</p>	<p>FREE AREA(%) 57%</p>	<p>FREE AREA(%) 57%</p>	<p>B.D. REF : F.S.D. REF : Note : 1.All dimensions are in mm. 2.All elevations are viewed from outside. 3.All dimensions to be verified on site before fabrication.</p> <p>GENERAL NOTES</p> <p>Legend : 1. F.F.L.-- Finished Floor Level 2. S.F.L.-- Structural Floor Level 3. (R) -- Reversed Detail</p> <p>X1 -- DETAIL MARK NO. X001 -- REFER SHEET NO.</p>												
<p>WINDOW MARK 29 nos.</p>	<p>WINDOW MARK 28 nos.</p>	<p>WINDOW MARK 28 nos.</p>	<table border="1"> <tr> <td>B</td> <td>XX.02.2020</td> <td>GENERAL REVISION</td> <td></td> </tr> <tr> <td>A</td> <td>06.02.2020</td> <td>GENERAL REVISION</td> <td></td> </tr> <tr> <td>NO.</td> <td>DATE</td> <td>REVISED</td> <td>BY</td> </tr> </table>	B	XX.02.2020	GENERAL REVISION		A	06.02.2020	GENERAL REVISION		NO.	DATE	REVISED	BY
B	XX.02.2020	GENERAL REVISION													
A	06.02.2020	GENERAL REVISION													
NO.	DATE	REVISED	BY												
<p>LOCATION T1A FLAT C M.BATH. (1-33/F; 4,13,14,24/F OMITTED)</p>	<p>LOCATION T1 FLAT A KIT. (1-32/F; 4,13,14,24/F OMITTED)</p>	<p>LOCATION T1 LOBBY CORRIDOR (1-32/F; 4,13,14,24/F OMITTED)</p>	<p>CLIENT : 佳明集團控股有限公司 GRAND MING GROUP HOLDINGS LIMITED</p>												
<p>GLAZING FRAME AL11</p>	<p>GLAZING FRAME AL11</p>	<p>GLAZING FRAME AL11</p>	<p>MAIN CONTRACTOR : GRAND TECH CONSTRUCTION CO. LTD.</p>												
<p>REMARK 65mm ALUM. WINDOW SECTION</p>	<p>REMARK 65mm ALUM. WINDOW SECTION</p>	<p>REMARK 65mm ALUM. WINDOW SECTION</p>	<p>ARCHITECT : WONG TUNG & PARTNERS LIMITED ARCHITECTS & PLANNERS</p>												
<p>FREE AREA(%) 52.6%</p>	<p>FREE AREA(%) 52.6%</p> <p style="color: red; font-size: 2em; text-align: center;">刪除</p>	<p>FREE AREA(%) 52.6%</p>	<p>STRUCTURAL ENGINEER : C M WONG & ASSOCIATES LTD</p>												
<p>WINDOW MARK 29 nos.</p>	<p>WINDOW MARK</p>	<p>WINDOW MARK</p>	<p>美特鋁質有限公司 MIDI ALUMINIUM FABRICATOR LTD. Units 6-8, Sunray Industrial Centre, 1/F 610 Cha Kwo Ling Road, Kowloon Tel:23469211-4 Fax:(852)27727666</p>												
<p>LOCATION T1 FLAT E BATH. (1-33/F; 4,13,14,24/F OMITTED)</p>	<p>LOCATION</p>	<p>LOCATION</p>	<p>PROJECT : RESIDENTIAL DEVELOPMENT AT TSING YI TOWN LOT 190 SAI SHAN ROAD</p>												
<p>GLAZING FRAME AL11</p>	<p>GLAZING FRAME</p>	<p>GLAZING FRAME</p>	<p>TITLE : LOUVRE SCHEDULE FOR PRECAST FAÇADE OF T1/T1A</p>												
<p>REMARK 65mm ALUM. WINDOW SECTION</p>	<p>REMARK</p>	<p>REMARK</p>	<p>JOB NO. : J-851 DRAWN BY : C.H.P. DATE : 30-11-2019 CHKD BY : SCALE A1: A3: 1:30 DWG. NO. : J851-SCH-107 REV. : B</p>												

FREE AREA(%)	OPENABLE AREA	GLAZING AREA
57%		

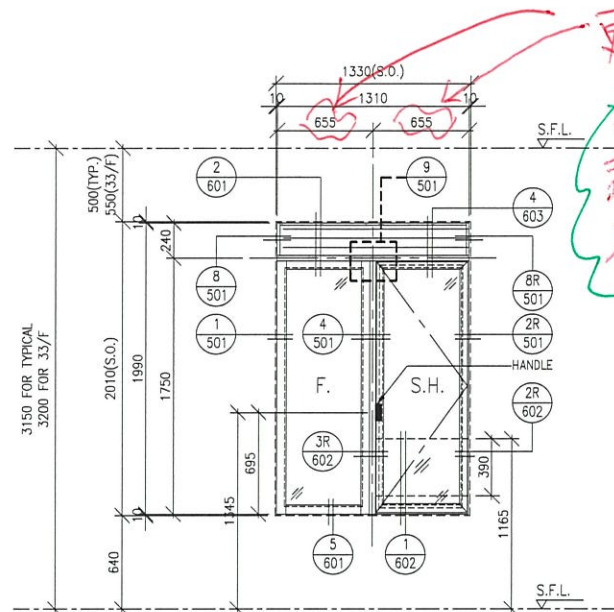


WINDOW MARK  MIR. 84 nos.


LOCATION T1A FLAT D,F MBR. (1-31/F & 33/F : 4,13,14,24/F OMITTED)
T1 FLAT G MBR. (1-31/F & 33/F : 4,13,14,24/F OMITTED)

GLAZING GL02 FRAME AL11

REMARK 65mm ALUM. WINDOW SECTION

FREE AREA(%)	OPENABLE AREA	GLAZING AREA
57%		

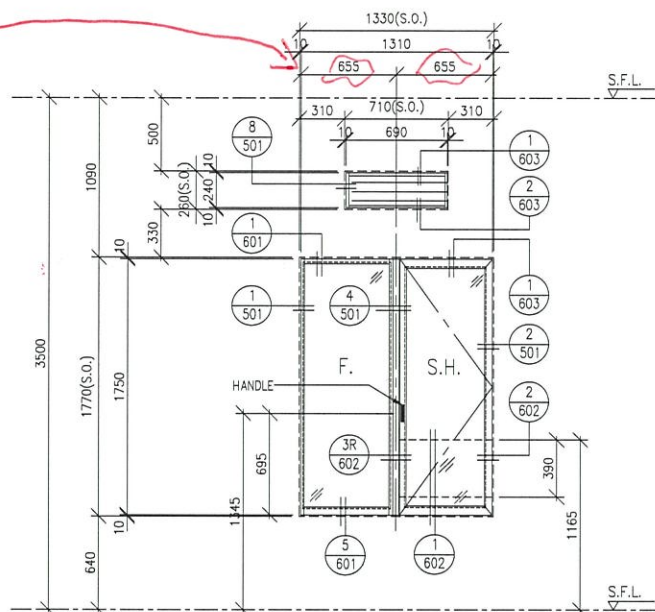

WINDOW MARK  MIR. 3 nos.

LOCATION T1A FLAT D,F MBR.(32/F)
T1 FLAT G MBR.(32/F)

GLAZING GL02 FRAME AL11

REMARK 65mm ALUM. WINDOW SECTION

B.D. REF :			
F.S.D. REF :			
Note :			
1.All dimensions are in mm.			
2.All elevations are viewed from outside.			
3.All dimensions to be verified on site before fabrication.			
GENERAL NOTES			
Legend :			
1. F.F.L.-- Finished Floor Level			
2. S.F.L.-- Structural Floor Level			
3. (R) -- Reversed Detail			
 -- DETAIL MARK NO.			
 -- REFER SHEET NO.			
NO.	DATE	REVISED	BY
CLIENT :			
佳明集團控股有限公司 GRAND MING GROUP HOLDINGS LIMITED			
MAIN CONTRACTOR :			
GRAND TECH CONSTRUCTION CO. LTD.			
ARCHITECT :			
WONG TUNG & PARTNERS LIMITED ARCHITECTS & PLANNERS			
			
STRUCTURAL ENGINEER :			
 C M WONG & ASSOCIATES LTD			
 美特鋁質有限公司 MIDI ALUMINIUM FABRICATOR LTD.			
Units 6-8, Sunray Industrial Centre, 1/F 610, Cha Kwo Ling Road, Kowloon Tel:23469211-4 Fax:(852)27727666			
PROJECT :			
RESIDENTIAL DEVELOPMENT AT TSING YI TOWN LOT 190 SAI SHAN ROAD			
TITLE :			
WINDOW SCHEDULE FOR PRECAST FACADE OF T1/T1A			
JOB NO. : J-851			
DRAWN BY : C.H.P.		DATE : 30-11-2019	
CHKD BY :		SCALE A1: A3: 1:30	
DWG. NO. : J851-SCH-108		REV. : -	

FREE AREA(%)	OPENABLE AREA	GLAZING AREA	OPENABLE AREA	GLAZING AREA	OPENABLE AREA	GLAZING AREA		
57%								
WINDOW MARK	W2 T2 54 nos.		WINDOW MARK	W3 T2 26 nos.		WINDOW MARK	W4 T2 26 nos.	
LOCATION	T2A FLAT D MBR. (1-31/F & 33/F; 4,13,14,24/F OMITTED) T2 FLAT H MBR. (1-31/F & 33/F; 4,13,14,24/F OMITTED)		LOCATION	T2A FLAT B BR3.(2-31/F; 4,13,14,24/F OMITTED)		LOCATION	T2A FLAT B BR2.(2-31/F; 4,13,14,24/F OMITTED)	
GLAZING	GL02	FRAME AL11	GLAZING	GL02	FRAME AL11	GLAZING	GL02	FRAME AL11
REMARK	65mm ALUM. WINDOW SECTION		REMARK	65mm ALUM. WINDOW SECTION		REMARK	65mm ALUM. WINDOW SECTION	
OPENABLE AREA	GLAZING AREA		OPENABLE AREA	GLAZING AREA		OPENABLE AREA	GLAZING AREA	
WINDOW MARK	W6 T2 26 nos.		WINDOW MARK	W7 T2 26 nos.		WINDOW MARK		
LOCATION	T2 FLAT E MBR.(2-31/F; 4,13,14,24/F OMITTED)		LOCATION	T2 FLAT E BR2(2-31/F; 4,13,14,24/F OMITTED)		LOCATION		
GLAZING	GL02	FRAME AL11	GLAZING	GL02	FRAME AL11	GLAZING		FRAME
REMARK	65mm ALUM. WINDOW SECTION		REMARK	65mm ALUM. WINDOW SECTION		REMARK		

B.D. REF :
F.S.D. REF :
Note :
1. All dimensions are in mm.
2. All elevations are viewed from outside.
3. All dimensions to be verified on site before fabrication.

GENERAL NOTES
Legend :
1. F.F.L.-- Finished Floor Level
2. S.F.L.-- Structural Floor Level
3. (R) -- Reversed Detail
X1 -- DETAIL MARK NO.
X001 -- REFER SHEET NO.

B	XX.02.2020	GENERAL REVISION	
A	06.02.2020	GENERAL REVISION	
NO.	DATE	REVISED	BY

CLIENT :
佳明集團控股有限公司
GRAND MING GROUP HOLDINGS LIMITED

MAIN CONTRACTOR :
GRAND TECH CONSTRUCTION CO. LTD.

ARCHITECT :
WONG TUNG & PARTNERS LIMITED
ARCHITECTS & PLANNERS

STRUCTURAL ENGINEER :
C M WONG & ASSOCIATES LTD

美特鋁質有限公司
MIDI ALUMINIUM FABRICATOR LTD.
Units 6-8, Sunray Industrial Centre, 1/F
610 Cha Kwo Ling Road, Kowloon
Tel:23489211-4 Fax:(852)2727666

PROJECT :
RESIDENTIAL DEVELOPMENT AT
TSING YI TOWN LOT 190 SAI SHAN ROAD

TITLE :
WINDOW SCHEDULE
FOR PRECAST FACADE
OF T2/T2A (1 OF 6)

JOB NO. : J-851
DRAWN BY : C.H.P. DATE : 30-11-2019
CHKD BY : SCALE A1: A3: 1:30
DWG. NO. : J851-SCH-201 REV. : B

FREE AREA(%)	GLAZING AREA	OPENABLE AREA	GLAZING AREA	FREE AREA(%)	GLAZING AREA	OPENABLE AREA		
57%				57%				
WINDOW MARK	W10 T2 27 nos.		WINDOW MARK	W11 T2 26 nos.		WINDOW MARK	W13 T2 52 nos.	
LOCATION	T2 FLAT A M.BATH.(1-31/F; 4,13,14,24/F OMITTED)		LOCATION	T2 FLAT D BATH1.(2-31/F; 4,13,14,24/F OMITTED)		LOCATION	T2 FLAT A KIT.(2-31/F; 4,13,14,24/F OMITTED) T2A FLAT A KIT.(2-31/F; 4,13,14,24/F OMITTED)	
GLAZING	GL06	FRAME AL11	GLAZING	GL06	FRAME AL11	GLAZING	GL02	FRAME AL11
REMARK	65mm ALUM. WINDOW SECTION		REMARK	65mm ALUM. WINDOW SECTION		REMARK	65mm ALUM. WINDOW SECTION	
			OPENABLE AREA	GLAZING AREA				
WINDOW MARK	W15 T2 27 nos.		WINDOW MARK	W16 T2 52 nos.				
LOCATION	T2A LOBBY CORRIDOR(1-31/F; 4,13,14,24/F OMITTED)		LOCATION	T2 LOBBY CORRIDOR(2-31/F; 4,13,14,24/F OMITTED)				
GLAZING		FRAME	GLAZING	GL08	FRAME AL11	GLAZING	GL08	FRAME AL11
REMARK	65mm ALUM. WINDOW SECTION		REMARK	65mm ALUM. WINDOW SECTION				

B.D. REF :
F.S.D. REF :
Note :
1.All dimensions are in mm.
2.All elevations are viewed from outside.
3.All dimensions to be verified on site before fabrication.

GENERAL NOTES
Legend :
1. F.F.L.-- Finished Floor Level
2. S.F.L.-- Structural Floor Level
3. (R) -- Reversed Detail
X1 -- DETAIL MARK NO.
X001 -- REFER SHEET NO.

B	XX.02.2020	GENERAL REVISION	
A	06.02.2020	GENERAL REVISION	
NO.	DATE	REVISED	BY

CLIENT :
佳明集團控股有限公司
GRAND MING GROUP HOLDINGS LIMITED

MAIN CONTRACTOR :
GRAND TECH CONSTRUCTION CO. LTD.

ARCHITECT :
WONG TUNG & PARTNERS LIMITED
ARCHITECTS & PLANNERS

STRUCTURAL ENGINEER :
 C M WONG & ASSOCIATES LTD



美特鋁質有限公司
MIDI ALUMINIUM FABRICATOR LTD.
Units 6-8, Sunray Industrial Centre, 1/F
610 Cha Kwo Ling Road, Kowloon
Tel:23469211-4 Fax:(852)27727666

PROJECT :
RESIDENTIAL DEVELOPMENT AT
TSING YI TOWN LOT 190 SAI SHAN ROAD

TITLE :
WINDOW SCHEDULE
FOR PRECAST FACADE
OF T2/T2A (2 OF 6)

JOB NO. : J-851
DRAWN BY : C.H.P. DATE : 30-11-2019
CHKD BY : SCALE A1: A3: 1:30
DWG. NO. : J851-SCH-202 REV. : B

FREE AREA(%)		OPENABLE AREA	GLAZING AREA	WINDOW MARK	LOCATION	GLAZING	FRAME	AL11	REMARK
57%				W22 T2	T2A FLAT B M.BATH.(2-31/F; 4,13,14,24/F OMITTED)	GL06	AL11		65mm ALUM. WINDOW SECTION
57%				W23 T2	T2 FLAT F MBR.(1-31/F & 33/F ; 4,13,14,24/F OMITTED)	GL02	AL11		65mm ALUM. WINDOW SECTION
57%				W32 T2	T2A FLAT D MBR.(32/F) T2 FLAT H MBR.(32/F)	GL02	AL11		65mm ALUM. WINDOW SECTION
57%				W33 T2	T2A FLAT B BR3. (32-33/F)	GL02	AL11		65mm ALUM. WINDOW SECTION
57%				W34 T2	T2A FLAT B BR2. (32-33/F)	GL02	AL11		65mm ALUM. WINDOW SECTION

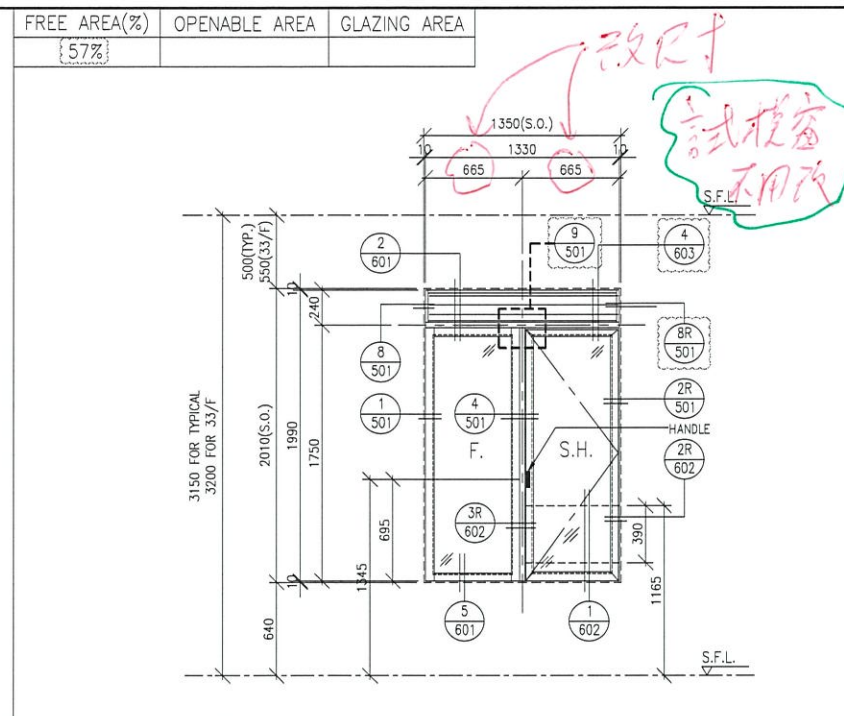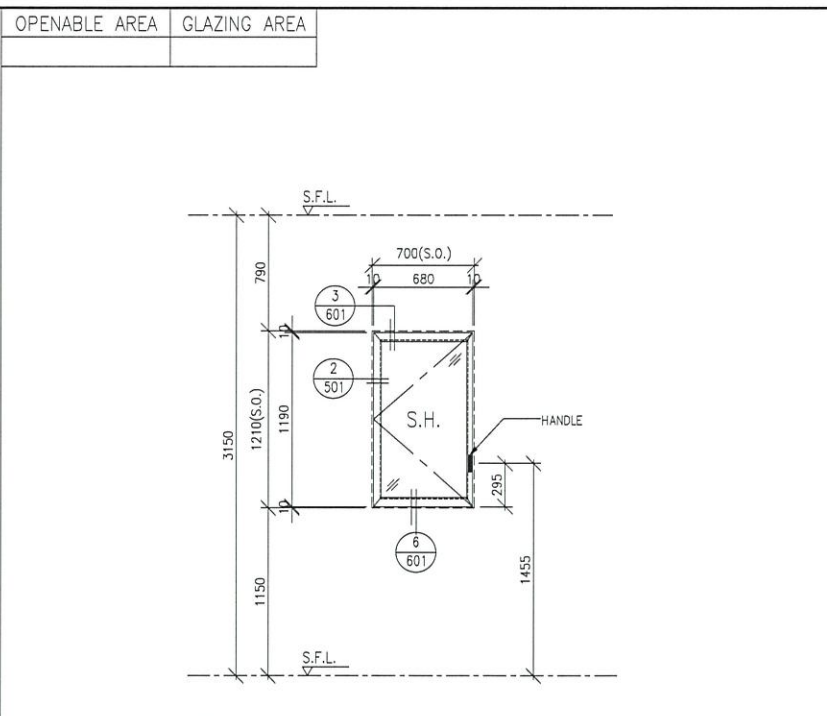

B.D. REF :
F.S.D. REF :
Note :
1.All dimensions are in mm.
2.All elevations are viewed from outside.
3.All dimensions to be verified on site before fabrication.

GENERAL NOTES




Legend :
1. F.F.L.-- Finished Floor Level
2. S.F.L.-- Structural Floor Level
3. (R) -- Reversed Detail

X1 -- DETAIL MARK NO.
X001 -- REFER SHEET NO.

WINDOW MARK	LOCATION	GLAZING	FRAME	AL11	REMARK
W22	T2A FLAT B M.BATH.(2-31/F; 4,13,14,24/F OMITTED)	GL06	AL11		65mm ALUM. WINDOW SECTION
W23	T2 FLAT F MBR.(1-31/F & 33/F ; 4,13,14,24/F OMITTED)	GL02	AL11		65mm ALUM. WINDOW SECTION

WINDOW MARK	LOCATION	GLAZING	FRAME	AL11	REMARK
W32	T2A FLAT D MBR.(32/F) T2 FLAT H MBR.(32/F)	GL02	AL11		65mm ALUM. WINDOW SECTION
W33	T2A FLAT B BR3. (32-33/F)	GL02	AL11		65mm ALUM. WINDOW SECTION
W34	T2A FLAT B BR2. (32-33/F)	GL02	AL11		65mm ALUM. WINDOW SECTION

WINDOW MARK	LOCATION	GLAZING	FRAME	AL11	REMARK
W32	T2A FLAT D MBR.(32/F) T2 FLAT H MBR.(32/F)	GL02	AL11		65mm ALUM. WINDOW SECTION
W33	T2A FLAT B BR3. (32-33/F)	GL02	AL11		65mm ALUM. WINDOW SECTION
W34	T2A FLAT B BR2. (32-33/F)	GL02	AL11		65mm ALUM. WINDOW SECTION

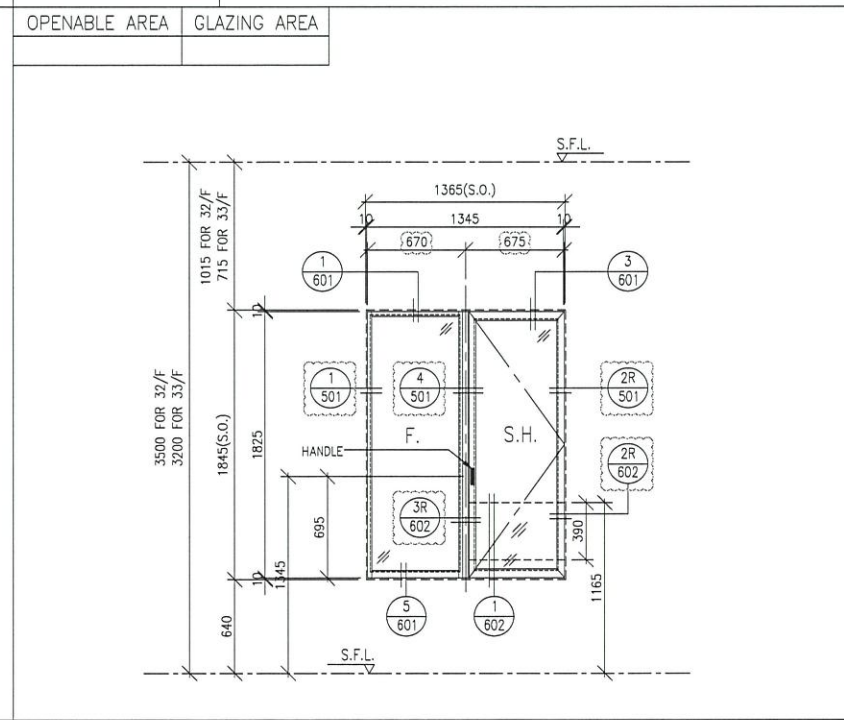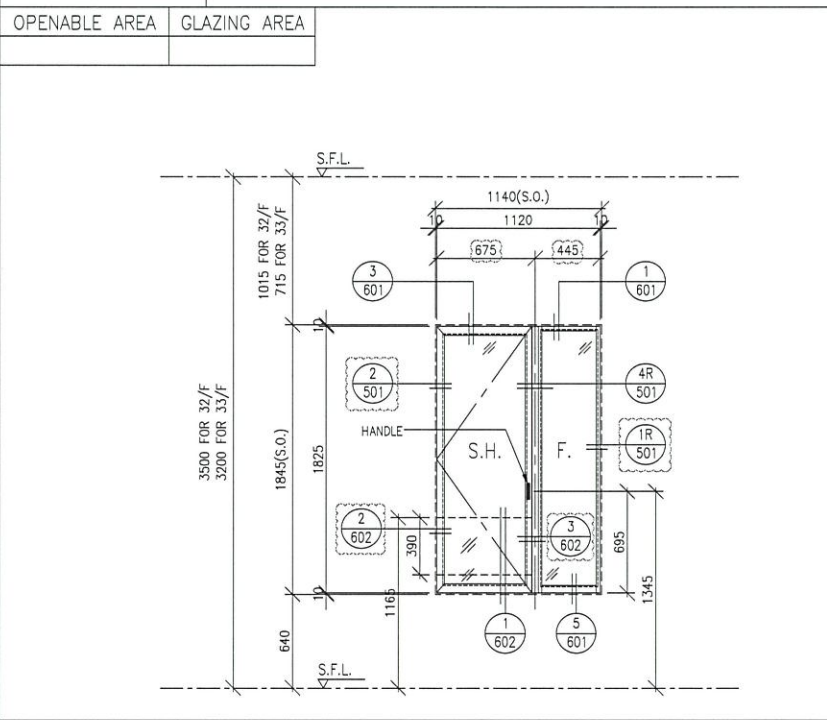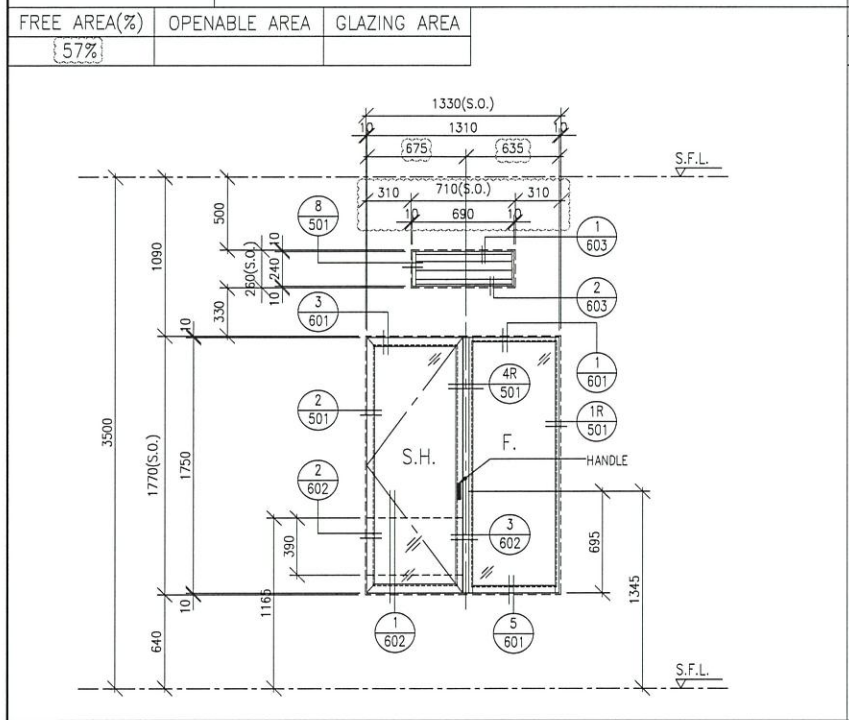

CLIENT :
佳明集團控股有限公司
GRAND MING GROUP HOLDINGS LIMITED

MAIN CONTRACTOR :
GRAND TECH CONSTRUCTION CO. LTD.

ARCHITECT :
WONG TUNG & PARTNERS LIMITED
ARCHITECTS & PLANNERS

STRUCTURAL ENGINEER :
C M WONG & ASSOCIATES LTD

美特鋁質有限公司
MIDI ALUMINIUM FABRICATOR LTD.
Units 6-8, Sunray Industrial Centre, 1/F
510 Cha Kwo Ling Road, Kowloon
Tel:23489211-4 Fax:(852)27727666

PROJECT :
RESIDENTIAL DEVELOPMENT AT
TSING YI TOWN LOT 190 SAI SHAN ROAD




TITLE :
WINDOW SCHEDULE
FOR PRECAST FACADE
OF T2/T2A (3 OF 6)


JOB NO. : J-851

DRAWN BY : C.H.P. DATE : 30-11-2019

CHKD BY : SCALE A1: 1:30

DWG. NO. : J851-SCH-203 REV. : B

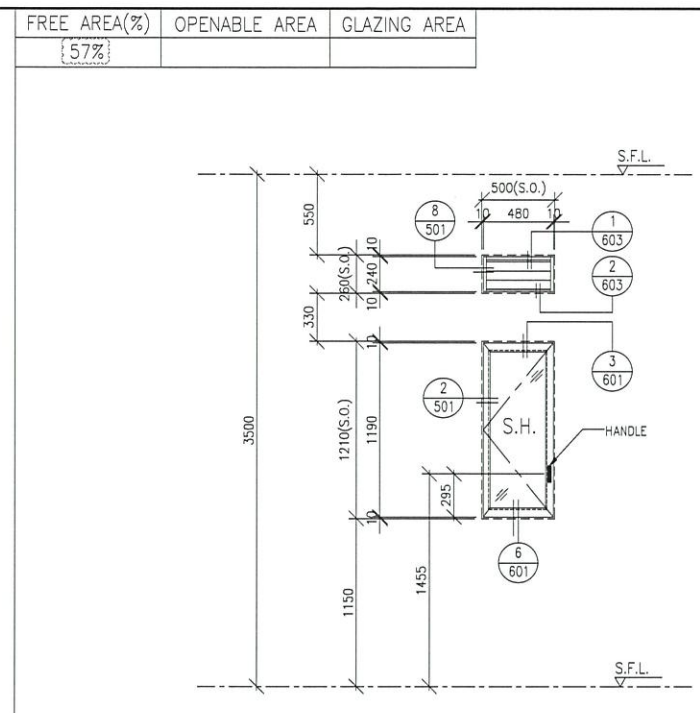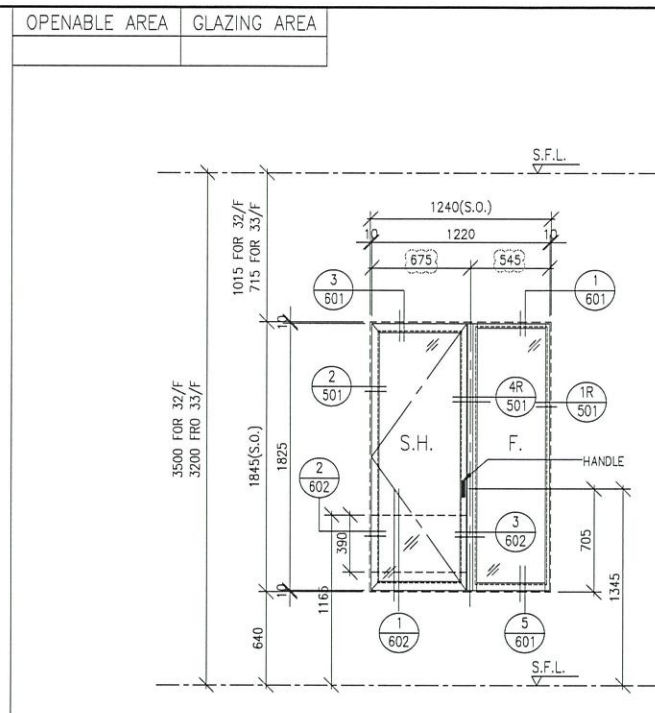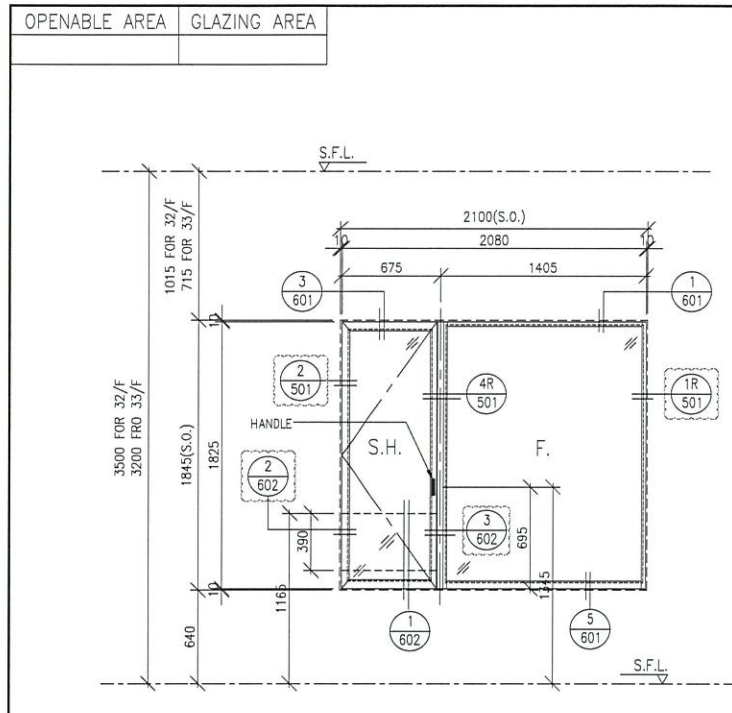

WINDOW MARK  2 nos.

LOCATION T2 FLAT E MBR. (32-33/F)

GLAZING GL02 FRAME AL11

REMARK 65mm ALUM. WINDOW SECTION

FREE AREA(%) 57% OPENABLE AREA GLAZING AREA


WINDOW MARK  2 nos.

LOCATION T2 FLAT E BR2. (32-33/F)

GLAZING GL02 FRAME AL11

REMARK 65mm ALUM. WINDOW SECTION

GLAZING AREA




WINDOW MARK  1 nos.


LOCATION T2 FLAT B M.BATH. (33/F)

GLAZING GL06 FRAME AL11

REMARK 65mm ALUM. WINDOW SECTION

FREE AREA(%) 57% OPENABLE AREA GLAZING AREA

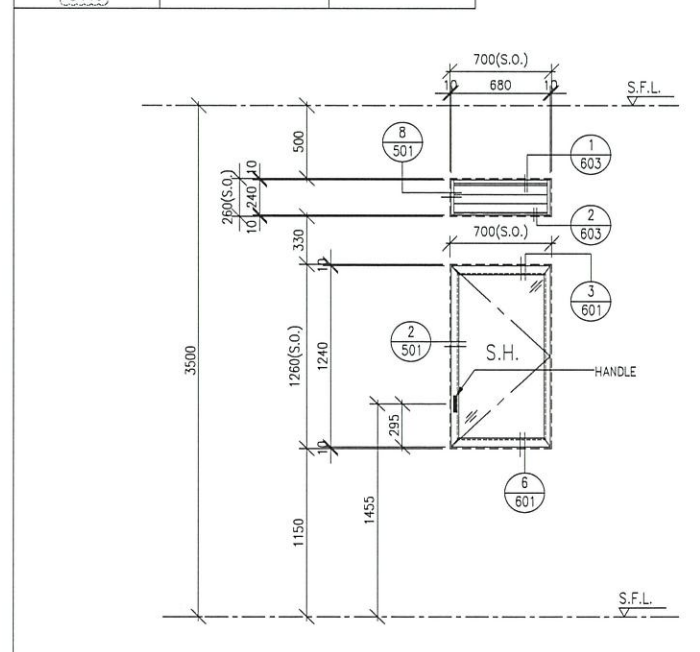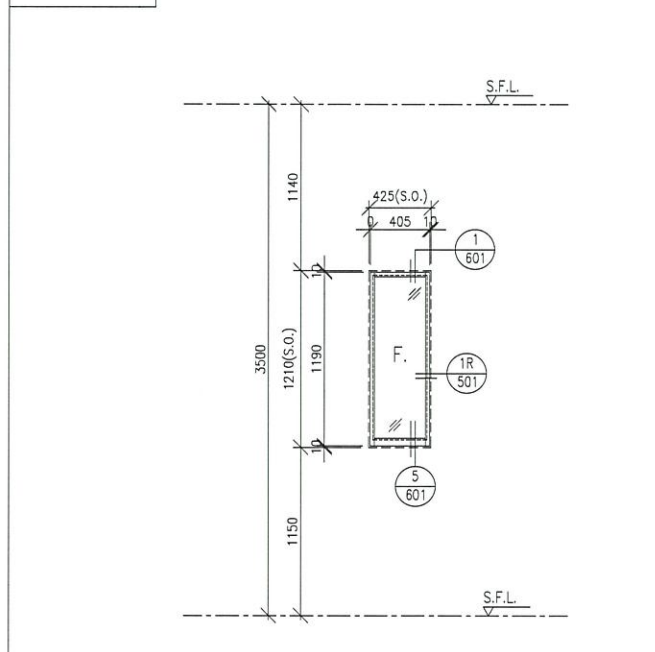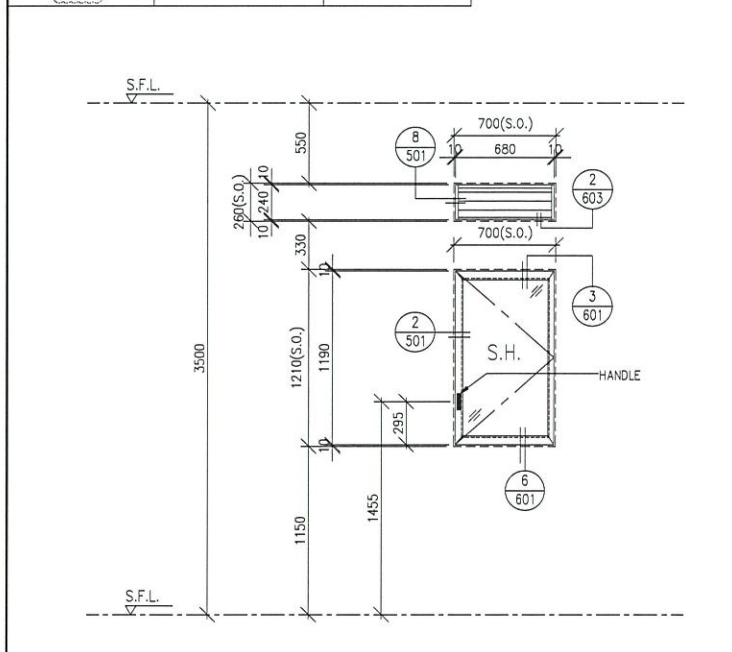


WINDOW MARK  1 no.

LOCATION T2 FLAT A M.BATH. (32/F)

GLAZING GL06 FRAME AL11

REMARK 65mm ALUM. WINDOW SECTION

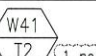WINDOW MARK  1 no.

LOCATION T2 FLAT D BATH1. (32/F)
T2 FLAT B M.BATH1. (33/F)

GLAZING GL06 FRAME AL11

REMARK 65mm ALUM. WINDOW SECTION

WINDOW MARK  2 nos.

LOCATION T2A FLAT A KIT. (32/F)
T2 FLAT A KIT. (32/F)
T2 FLAT A BATH1. (33/F)

GLAZING GL02 FRAME AL11

REMARK 65mm ALUM. WINDOW SECTION

B.D. REF :
F.S.D. REF :
Note :
1.All dimensions are in mm.
2.All elevations are viewed from outside.
3.All dimensions to be verified on site before fabrication.


GENERAL NOTES
Legend :
1. F.F.L.-- Finished Floor Level
2. S.F.L.-- Structural Floor Level
3. (R) -- Reversed Detail
X1 -- DETAIL MARK NO.
X001 -- REFER SHEET NO.

NO.	DATE	REVISION	BY
B	XX.02.2020	GENERAL REVISION	
A	06.02.2020	GENERAL REVISION	

CLIENT :
佳明集團控股有限公司
GRAND MING GROUP HOLDINGS LIMITED

MAIN CONTRACTOR :
GRAND TECH CONSTRUCTION CO. LTD.

ARCHITECT :
WONG TUNG & PARTNERS LIMITED
ARCHITECTS & PLANNERS


STRUCTURAL ENGINEER :
 C M WONG & ASSOCIATES LTD

 美特鋁質有限公司
MIDI ALUMINIUM FABRICATOR LTD.
Units 6-8, Sunray Industrial Centre, 1/F
610 Cha Kwo Ling Road, Kowloon
Tel:23489211-4 Fax:(852)27727666

PROJECT :
RESIDENTIAL DEVELOPMENT AT
TSING YI TOWN LOT 190 SAI SHAN ROAD

TITLE :
WINDOW SCHEDULE
FOR PRECAST FAÇADE
OF T2/T2A (4 OF 6)

JOB NO. : J-851
DRAWN BY : C.H.P. DATE : 30-11-2019
CHKD BY : SCALE A1: 1:30
DWG. NO. : J851-SCH-204 REV. : B

OPENABLE AREA		GLAZING AREA		OPENABLE AREA		GLAZING AREA			
								<p>B.D. REF :</p> <p>F.S.D. REF :</p> <p>Note :</p> <p>1. All dimensions are in mm.</p> <p>2. All elevations are viewed from outside.</p> <p>3. All dimensions to be verified on site before fabrication.</p> <p>GENERAL NOTES</p> <p>Legend :</p> <p>1. F.F.L.-- Finished Floor Level</p> <p>2. S.F.L.-- Structural Floor Level</p> <p>3. (R) -- Reversed Detail</p> <p>(X1) --- DETAIL MARK NO.</p> <p>(X001) --- REFER SHEET NO.</p>	
WINDOW MARK	W45 T2 2 nos.			WINDOW MARK	W46 T2 4 nos.				
LOCATION	T2A LOBBY CORRIDOR (32-33/F)			LOCATION	T2 LOBBY CORRIDOR (32-33/F)				
GLAZING	GL08	FRAME	AL11	GLAZING	GL08	FRAME	AL11		
REMARK	65mm ALUM. WINDOW SECTION			REMARK	65mm ALUM. WINDOW SECTION				
FREE AREA(%)	52%								
WINDOW MARK	W40A T2 2 nos.			WINDOW MARK					
LOCATION	T2 FLAT A BATH. (32/F) T2 FLAT A BATH1. (32/F)			LOCATION					
GLAZING	GL06	FRAME	AL11	GLAZING		FRAME			
REMARK	65mm ALUM. WINDOW SECTION			REMARK					

CLIENT :	
佳明集團控股有限公司 GRAND MING GROUP HOLDINGS LIMITED	
MAIN CONTRACTOR :	
GRAND TECH CONSTRUCTION CO. LTD.	
ARCHITECT :	
WONG TUNG & PARTNERS LIMITED ARCHITECTS & PLANNERS	
STRUCTURAL ENGINEER :	
C M WONG & ASSOCIATES LTD	
美特鋁質有限公司 MIDI ALUMINIUM FABRICATOR LTD.	
Units 6-8, Sunray Industrial Centre, 1/F 610 Cha Kwo Ling Road, Kowloon Tel:23489211-4 Fax:(852)2727666	
PROJECT :	
RESIDENTIAL DEVELOPMENT AT TSING YI TOWN LOT 190 SAI SHAN ROAD	
TITLE :	
WINDOW SCHEDULE FOR PRECAST FACADE OF T2/T2A (5 OF 6)	
JOB NO. :	J-851
DRAWN BY : C.H.P.	DATE : 30-11-2019
CHKD BY :	SCALE A1: A3: 1:30
DWG. NO. : J851-SCH-205	REV. : B

OPENABLE AREA		GLAZING AREA		FREE AREA(%)		GLAZING AREA		OPENABLE AREA			
				57%							
WINDOW MARK		W52 T2 2 nos.		WINDOW MARK		W53 T2 1 no.		WINDOW MARK		W63 T2 2 nos.	
LOCATION		T2A FLAT B M.BATH. (32-33/F)		LOCATION		T2 FLAT F MBR.(32/F)		LOCATION		T2 FLAT A UTILITY RM (35/F) T2 FLAT A POWDER RM (35/F)	
GLAZING		GL06		GLAZING		GL02		GLAZING		GL06	
FRAME		AL11		FRAME		AL11		FRAME		AL11	
REMARK		65mm ALUM. WINDOW SECTION		REMARK		65mm ALUM. WINDOW SECTION		REMARK		65mm ALUM. WINDOW SECTION	
FREE AREA(%)		OPENABLE AREA		FREE AREA(%)		GLAZING AREA		FREE AREA(%)		OPENABLE AREA	
57%				52%				57%			
GLAZING AREA				GLAZING AREA				GLAZING AREA			
WINDOW MARK		W64 T2 2 nos.		WINDOW MARK		W64A T2 1 no.		WINDOW MARK		W73 T2 1 no.	
LOCATION		T2 FLAT B UTILITY RM (35/F) T2 FLAT B UTILITY (35/F)		LOCATION		T2 FLAT A POWDER RM (35/F)		LOCATION		T2 FLAT B LIV. & DIN. (35/F)	
GLAZING		GL06		GLAZING		GL06		GLAZING		GL06	
FRAME		AL11		FRAME		AL11		FRAME		AL11	
REMARK		65mm ALUM. WINDOW SECTION		REMARK		65mm ALUM. WINDOW SECTION		REMARK		65mm ALUM. WINDOW SECTION	

B.D. REF :
F.S.D. REF :
Note :
1. All dimensions are in mm.
2. All elevations are viewed from outside.
3. All dimensions to be verified on site before fabrication.

GENERAL NOTES
Legend :
1. F.F.L.-- Finished Floor Level
2. S.F.L.-- Structural Floor Level
3. (R) -- Reversed Detail
X1 -- DETAIL MARK NO.
X001 -- REFER SHEET NO.

B	XX.02.2020	GENERAL REVISION	
A	06.02.2020	GENERAL REVISION	
NO.	DATE	REVISED	BY

CLIENT :
佳明集團控股有限公司
GRAND MING GROUP HOLDINGS LIMITED

MAIN CONTRACTOR :
GRAND TECH CONSTRUCTION CO. LTD.

ARCHITECT :
WONG TUNG & PARTNERS LIMITED
ARCHITECTS & PLANNERS







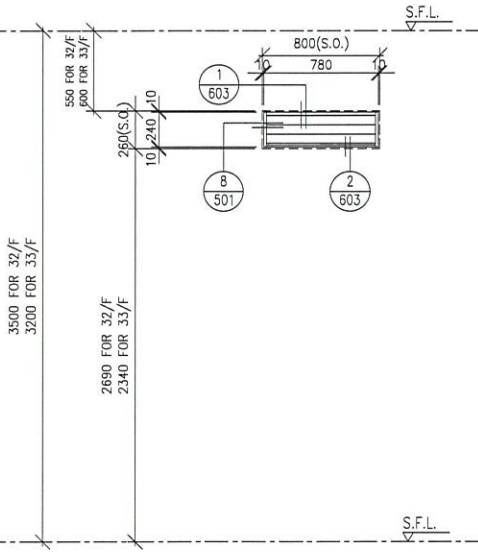




STRUCTURAL ENGINEER :
 C M WONG & ASSOCIATES LTD

美特鋁質有限公司
MIDI ALUMINIUM FABRICATOR LTD.
Units 6-8, Sunray Industrial Centre, 1/F
610 Cha Kwo Ling Road, Kowloon
Tel:23489211-4 Fax:(852)27727666

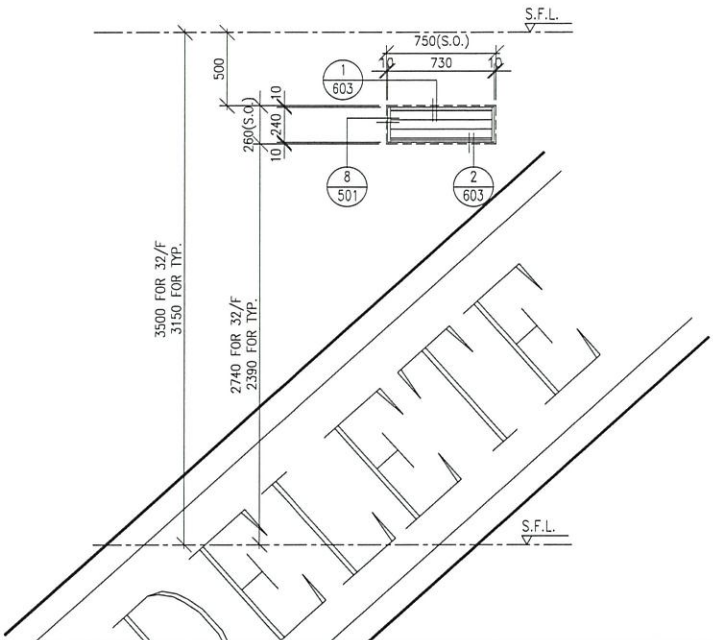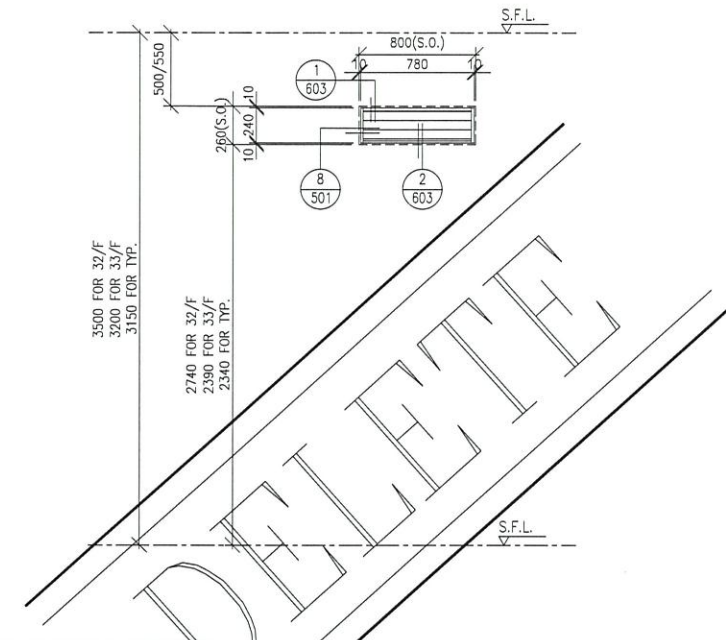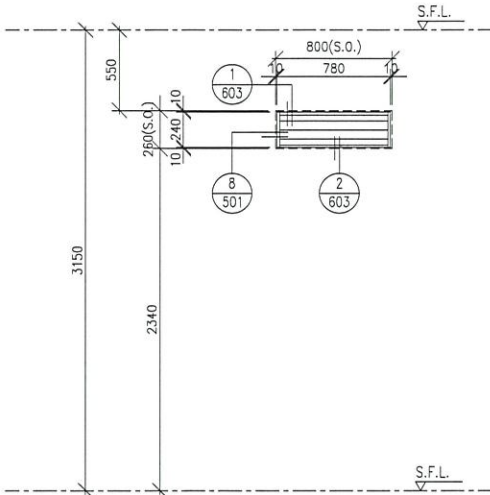PROJECT :
RESIDENTIAL DEVELOPMENT AT
TSING YI TOWN LOT 190 SAI SHAN ROAD

TITLE :
WINDOW SCHEDULE
FOR PRECAST FACADE
OF T2/T2A (6 OF 6)

JOB NO. : J-851
DRAWN BY : C.H.P. DATE : 30-11-2019
CHKD BY : SCALE A1: 1:30
A3: 1:30
DWG. NO. : J851-SCH-206 REV. : B

<p>FREE AREA(%) 57%</p> 	<p>FREE AREA(%) 57%</p> 	<p>FREE AREA(%) 57%</p> 	<p>B.D. REF : F.S.D. REF : Note : 1. All dimensions are in mm. 2. All elevations are viewed from outside. 3. All dimensions to be verified on site before fabrication.</p> <p>GENERAL NOTES</p> <p>Legend : 1. F.F.L.-- Finished Floor Level 2. S.F.L.-- Structural Floor Level 3. (R) -- Reversed Detail</p> <p>X1 -- DETAIL MARK NO. X001 -- REFER SHEET NO.</p>												
<p>WINDOW MARK  26 nos.</p>	<p>WINDOW MARK  29 nos.</p>	<p>WINDOW MARK  27 nos.</p>													
<p>LOCATION T2 FLAT A KIT. (1-32/F; 4,13,14,24/F OMITTED)</p>	<p>LOCATION T2 FLAT B BATH. (1-33/F; 4,13,14,24/F OMITTED)</p>	<p>LOCATION T2A FLAT B BATH. (1-31/F; 4,13,14,24/F OMITTED)</p>													
<p>GLAZING FRAME AL11</p>	<p>GLAZING FRAME AL11</p>	<p>GLAZING FRAME AL11</p>													
<p>REMARK 65mm ALUM. WINDOW SECTION</p>	<p>REMARK 65mm ALUM. WINDOW SECTION</p>	<p>REMARK 65mm ALUM. WINDOW SECTION</p>	<table border="1"> <tr> <td>B</td> <td>XX.02.2020</td> <td>GENERAL REVISION</td> <td></td> </tr> <tr> <td>A</td> <td>06.02.2020</td> <td>GENERAL REVISION</td> <td></td> </tr> <tr> <td>NO.</td> <td>DATE</td> <td>REVISED</td> <td>BY</td> </tr> </table>	B	XX.02.2020	GENERAL REVISION		A	06.02.2020	GENERAL REVISION		NO.	DATE	REVISED	BY
B	XX.02.2020	GENERAL REVISION													
A	06.02.2020	GENERAL REVISION													
NO.	DATE	REVISED	BY												
<p>FREE AREA(%) 57%</p> 			<p>CLIENT : 佳明集團控股有限公司 GRAND MING GROUP HOLDINGS LIMITED</p> <p>MAIN CONTRACTOR : GRAND TECH CONSTRUCTION CO. LTD.</p> <p>ARCHITECT : WONG TUNG & PARTNERS LIMITED ARCHITECTS & PLANNERS </p> <p>STRUCTURAL ENGINEER :  C M WONG & ASSOCIATES LTD</p> <p> 美特鋁質有限公司 MIDI ALUMINIUM FABRICATOR LTD. Units 6-8, Sunray Industrial Centre, 1/F 610 Cha Kwo Ling Road, Kowloon Tel:23489211-4 Fax:(852)27727666</p> <p>PROJECT : RESIDENTIAL DEVELOPMENT AT TSING YI TOWN LOT 190 SAI SHAN ROAD</p>												
<p>WINDOW MARK  2 nos.</p>		<p>WINDOW MARK</p>	<p>TITLE : LOUVRE SCHEDULE FOR PRECAST FACADE OF T2/T2A</p>												
<p>LOCATION T2A FLAT B BATH. (32/F & 33/F)</p>		<p>LOCATION</p>	<p>JOB NO. : J-851</p>												
<p>GLAZING FRAME AL11</p>		<p>GLAZING FRAME</p>	<p>DRAWN BY : C.H.P. DATE : 30-11-2019</p>												
<p>REMARK 65mm ALUM. WINDOW SECTION</p>		<p>REMARK</p>	<p>CHKD BY : SCALE A1: 1:30 A3: 1:30 DWG. NO. : J851-SCH-207 REV. : B</p>												

FREE AREA(%)	OPENABLE AREA	GLAZING AREA	FREE AREA(%)	OPENABLE AREA	GLAZING AREA	OPENABLE AREA	GLAZING AREA	
57%			57%					
WINDOW MARK	W2 T2 MIR. 81 nos.		WINDOW MARK	W10 T2 MIR. 54 nos.		WINDOW MARK	W22 T2 MIR. 26 nos.	
LOCATION	T2A FLAT A C&E MBR. (1-31/F & 33/F; 4,13,14,24/F OMITTED) T2 FLAT G MBR. (1-31/F & 33/F; 4,13,14,24/F OMITTED)		LOCATION	T2 FLAT A BATH1.(1-31/F; 4,13,14,24/F OMITTED) T2 FLAT D M.BATH.(2-31/F; 4,13,14,24/F OMITTED) T2A FLAT C MBR.(32/F)		LOCATION	T2A FLAT B BATH1.(2-31/F; 4,13,14,24/F OMITTED)	
GLAZING	GL02	FRAME AL11	GLAZING	GL06	FRAME AL11	GLAZING	GL06	FRAME AL11
REMARK	65mm ALUM. WINDOW SECTION		REMARK	65mm ALUM. WINDOW SECTION		REMARK	65mm ALUM. WINDOW SECTION	
FREE AREA(%)	OPENABLE AREA	GLAZING AREA	FREE AREA(%)	OPENABLE AREA	GLAZING AREA	OPENABLE AREA	GLAZING AREA	
57%			57%					
WINDOW MARK	W32 T2 MIR. 3 nos.		WINDOW MARK	W40 T2 MIR. 2 nos.		WINDOW MARK	W52 T2 MIR. 2 nos.	
LOCATION	T2A FLAT C,E MBR.(32/F) T2 FLAT G MBR.(32/F)		LOCATION	T2 FLAT D M.BATH. (32/F) T2 FLAT A BATH.1 (32/F)		LOCATION	T2A FLAT B BATH1. (32-33/F)	
GLAZING	GL02	FRAME AL11	GLAZING	GL06	FRAME AL11	GLAZING	GL06	FRAME AL11
REMARK	65mm ALUM. WINDOW SECTION		REMARK	65mm ALUM. WINDOW SECTION		REMARK	65mm ALUM. WINDOW SECTION	

B.D. REF :
F.S.D. REF :
Note :
1.All dimensions are in mm.
2.All elevations are viewed from outside.
3.All dimensions to be verified on site before fabrication.

GENERAL NOTES

Legend :
1. F.F.L.-- Finished Floor Level
2. S.F.L.-- Structural Floor Level
3. (R) -- Reversed Detail

X1 -- DETAIL MARK NO.
X001 -- REFER SHEET NO.

NO.	DATE	REVISED	BY

CLIENT :
佳明集團控股有限公司
GRAND MING GROUP HOLDINGS LIMITED

MAIN CONTRACTOR :
GRAND TECH CONSTRUCTION CO. LTD.

ARCHITECT :
WONG TUNG & PARTNERS LIMITED
ARCHITECTS & PLANNERS

STRUCTURAL ENGINEER :
C M WONG & ASSOCIATES LTD

美特鋁質有限公司
MIDI ALUMINIUM FABRICATOR LTD.
Units 6-8, Sunray Industrial Centre, 1/F
610 Cha Kwo Ling Road, Kowloon
Tel:23489211-4 Fax:(852)27727666

PROJECT :
RESIDENTIAL DEVELOPMENT AT
TSING YI TOWN LOT 190 SAI SHAN ROAD



TITLE :
WINDOW SCHEDULE FOR PRECAST FACADE OF T2/T2A

JOB NO. : J-851

DRAWN BY : C.H.P. DATE : 30-11-2019

CHKD BY : SCALE A1: A3: 1:30

DWG. NO. : J851-SCH-208 REV. : -

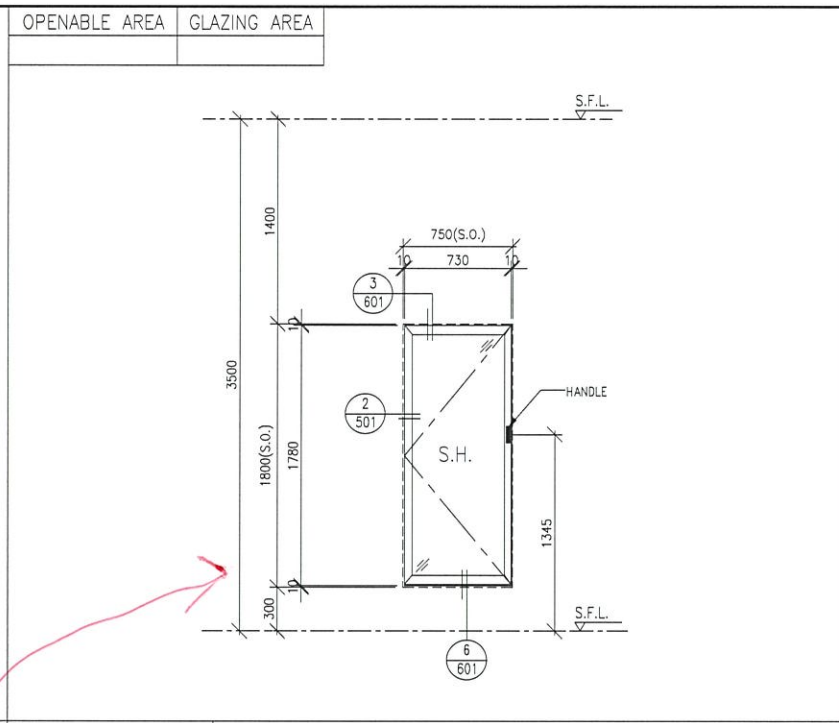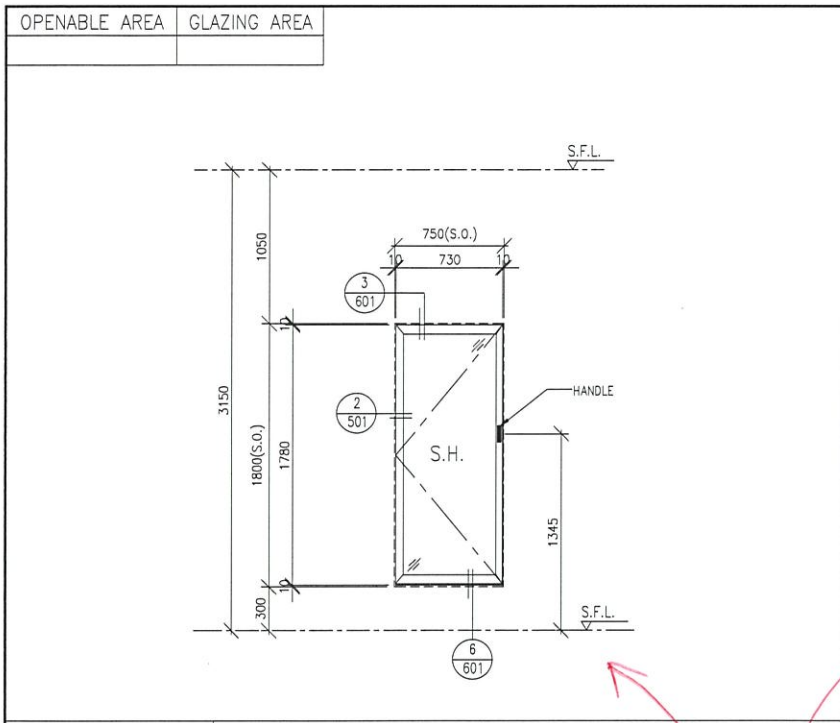

WINDOW MARK	27 nos.
LOCATION	T2 EL. ROOM(E). (1-31/F ; 4,13,14,24/F OMITTED)
GLAZING	GL08 FRAME AL11
REMARK	65mm ALUM. WINDOW SECTION

WINDOW MARK	2 nos.
LOCATION	T2 EL. ROOM(E). (32-33/F)
GLAZING	GL08 FRAME AL11
REMARK	65mm ALUM. WINDOW SECTION

新增

B.D. REF :
F.S.D. REF :
Note :
1. All dimensions are in mm.
2. All elevations are viewed from outside.
3. All dimensions to be verified on site before fabrication.

GENERAL NOTES
Legend :
1. F.F.L.-- Finished Floor Level
2. S.F.L.-- Structural Floor Level
3. (R) -- Reversed Detail
 -- DETAIL MARK NO.
 -- REFER SHEET NO.

NO.	DATE	REVISED	BY

CLIENT :
佳明集團控股有限公司
GRAND MING GROUP HOLDINGS LIMITED

MAIN CONTRACTOR :
GRAND TECH CONSTRUCTION CO. LTD.

ARCHITECT :
WONG TUNG & PARTNERS LIMITED
ARCHITECTS & PLANNERS

STRUCTURAL ENGINEER :
 C M WONG & ASSOCIATES LTD

美特鋁質有限公司
MIDI ALUMINIUM FABRICATOR LTD.
Units 6-8, Sunray Industrial Centre, 1/F
610 Cha Kwo Ling Road, Kowloon
Tel:23489211-4 Fax:(852)27727666

PROJECT :
**RESIDENTIAL DEVELOPMENT AT
TSING YI TOWN LOT 190 SAI SHAN ROAD**

TITLE :
**WINDOW SCHEDULE
FOR PRECAST FACADE
OF T2/T2A**

JOB NO. : J-851

DRAWN BY : C.H.P. DATE : 30-11-2019

CHKD BY : SCALE A1: 1:30

DWG. NO. : J851-SCH-209 REV. : -