

美 特 鋁 質 有 限 公 司
MIDI ALUMINIUM FABRICATOR LTD.

工程指示 / 要求簡箋(E.I.)

工程指示編號：EI / 1511 / 20

修改版次：F

工程編號：J851

工程名稱：青衣 明翹匯

工程項目：修改模圖(單元件幕牆)

收件人：羅小姐

發件人：Leung Hin Wai

日期：20/03/2020

要求提供 / 確認 事項：

- | | | |
|------------------------------------|-------------------------------------|-------------------------------|
| <input type="checkbox"/> 初步鋁料 B.M. | <input type="checkbox"/> 加工拆圖，然後生產 | <input type="checkbox"/> 尺寸表 |
| <input type="checkbox"/> 正式鋁料 B.M. | <input type="checkbox"/> 技術上資料 / 指示 | <input type="checkbox"/> 報價 |
| <input type="checkbox"/> 配件 B.M. | <input type="checkbox"/> 樣辦或貨品說明書 | <input type="checkbox"/> 分判合約 |
| <input type="checkbox"/> 其他：_____ | | |

內容：

請按附頁圖紙修改模圖。修改1頁。

請在_____前完成上列要求。

附：-

1+1頁

以上項目為：

- 原合約工程包 原合約工程加 / 減賬 新工程報價

原因：-

分發東莞各部門：

- () 生產技術總監 連附件 () 技術部 連附件 () 生產部 連附件 () 機械設計部 連附件
 () 採購部 連附件 () 生產統籌部 連附件
 () 質檢部 連附件 () 會計部 連附件 () 報關組 連附件 () 其他 _____ 連附件

分發香港各部門：

- () 行政部 連附件 () 會計部 連附件 () 統籌部 連附件 () 工程部地盤科文(柄) 連附件
 () 採購部 連附件 () QS 部 連附件 () 維修部 連附件 () 其他 _____ 連附件

傳遞編號：

HR0388

發件人簽署：

項目經理簽署：





MIDI ALUMINIUM FABRICATOR LTD.

DRAWING NO.
X85782(3)

REV.

TITLE
M18B

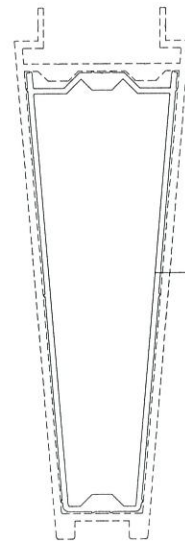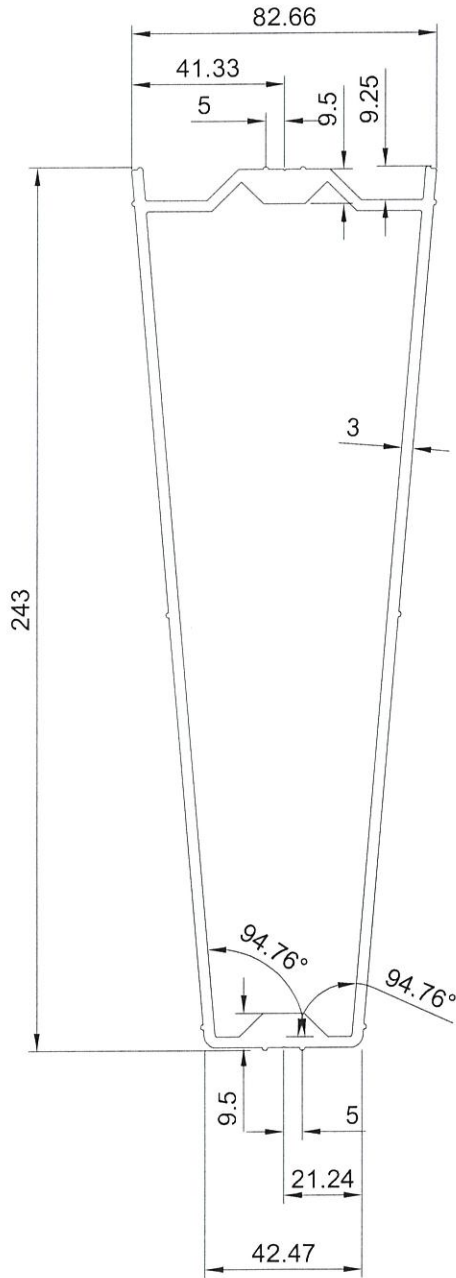

X85782(0)

美特鋁質有限公司

承認圖面

Handwritten signature

日期

20/3-2020

APPROVED :

6063-T6
Unspec.Radius: R0.5
Unspec.Thickness:4.0

SECTIONAL AREA	mm ²	ADDITIONAL TOLERANCE	DATE	REVISION			
				NO.	DATE	NAME	DESCRIPTION
2043.702		Thickness ± 0.1 mm	11/03/2020	A	16/3/20	WAI	
WEIGHT	KG/M	Flatness 0.1 /25mm width	SCALE	B	18/3/20	WAI	
5.538		Straightness 0.3 /300mm	1 : 1	C	20/3/20	WAI	
PERIMETER	mm	Twist 0.5° /300 mm max	DRAWN				
1223.885		Angularity ± 1.0 degree	CHECK				
V.F.	mm						