



美 特 鋁 質 有 限 公 司
MIDI ALUMINIUM FABRICATOR LTD.

工程指示 / 要求簡箋(E.I.)

工程指示編號：EI/1555 / 20

修改版次：H

工程編號：J851

工程名稱：青衣 明翹匯

工程項目：鋁料加工圖 (預制窗)

收件人：生統

發件人：Leung Hin Wai

日期：1/4-2020

要求提供 / 確認 事項：

- | | | |
|------------------------------------|-------------------------------------|-------------------------------|
| <input type="checkbox"/> 初步鋁料 B.M. | <input type="checkbox"/> 加工拆圖，然後生產 | <input type="checkbox"/> 尺寸表 |
| <input type="checkbox"/> 正式鋁料 B.M. | <input type="checkbox"/> 技術上資料 / 指示 | <input type="checkbox"/> 報價 |
| <input type="checkbox"/> 配件 B.M. | <input type="checkbox"/> 樣辦或貨品說明書 | <input type="checkbox"/> 分判合約 |
| <input type="checkbox"/> 其他：_____ | | |

內容：

請按附頁加工，送預制場。 T2-W63 減 1, T2-W63a 新增, T2-W53 百葉改尺寸

請在 15/4 前完成上列要求。

附： -

以上項目為：

原合約工程包

原合約工程加 / 減賬

新工程報價

原因：-

分發東莞各部門：

- | | | | |
|--|---|---|--|
| <input type="checkbox"/> 生產技術總監 <input type="checkbox"/> 連附件 | <input type="checkbox"/> 技術部 <input type="checkbox"/> 連附件 | <input type="checkbox"/> 生產部 <input type="checkbox"/> 連附件 | <input type="checkbox"/> 機械設計部 <input type="checkbox"/> 連附件 |
| <input type="checkbox"/> 採購部 <input type="checkbox"/> 連附件 | <input type="checkbox"/> 生產統籌部 <input type="checkbox"/> 連附件 | | |
| <input type="checkbox"/> 質檢部 <input type="checkbox"/> 連附件 | <input type="checkbox"/> 會計部 <input type="checkbox"/> 連附件 | <input type="checkbox"/> 報關組 <input type="checkbox"/> 連附件 | <input type="checkbox"/> 其他 _____ <input type="checkbox"/> 連附件 |

分發香港各部門：


- | | | | |
|---|--|---|--|
| <input type="checkbox"/> 行政部 <input type="checkbox"/> 連附件 | <input type="checkbox"/> 會計部 <input type="checkbox"/> 連附件 | <input type="checkbox"/> 統籌部 <input type="checkbox"/> 連附件 | <input type="checkbox"/> 工程部的地盤科文 <input type="checkbox"/> 連附件 |
| <input type="checkbox"/> 採購部 <input type="checkbox"/> 連附件 | <input type="checkbox"/> QS 部 <input type="checkbox"/> 連附件 | <input type="checkbox"/> 維修部 <input type="checkbox"/> 連附件 | <input type="checkbox"/> 其他 _____ <input type="checkbox"/> 連附件 |

傳遞編號：

HR 0487

發件人簽署：

項目經理簽署：

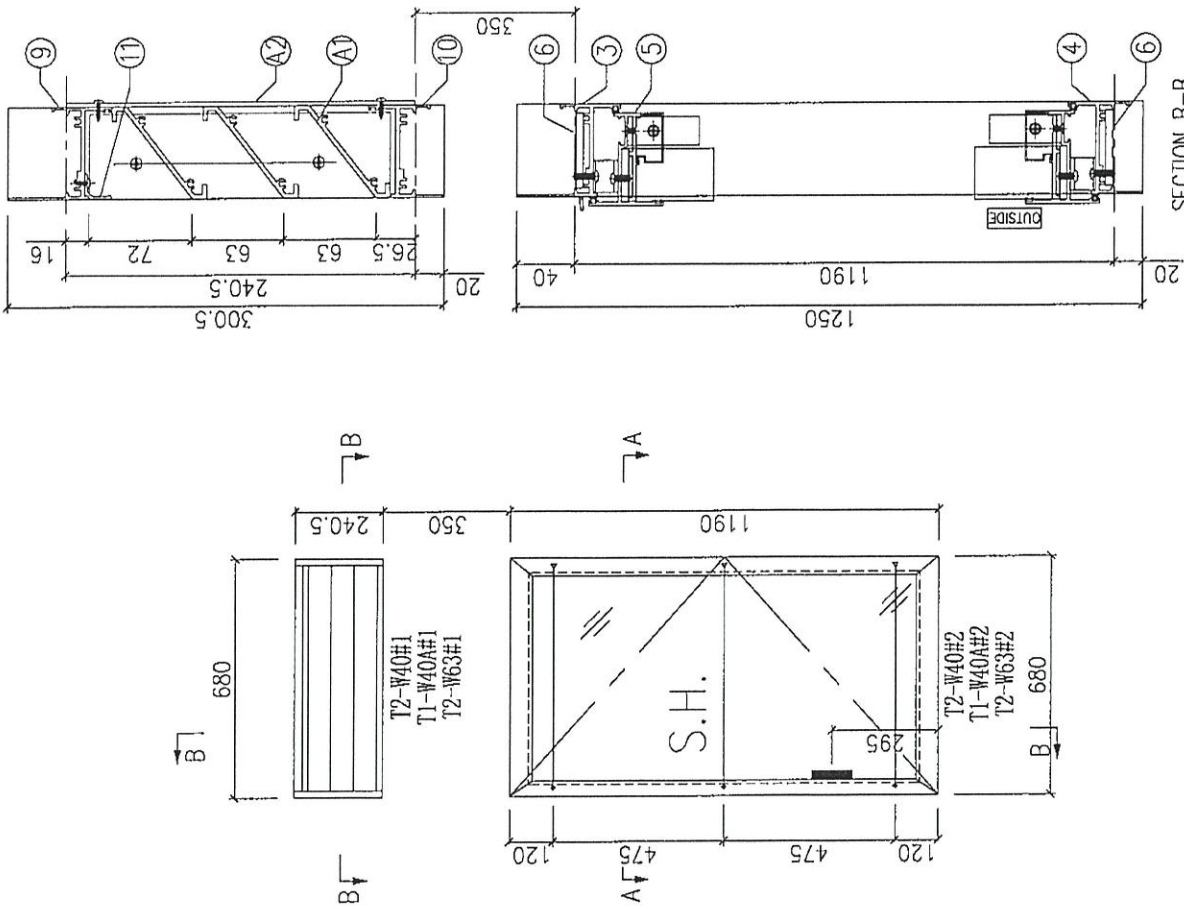

共3隻
現在 W40
W 40A 數量 1
W 63 數量 1

11	X84489-01D	百叶滴水线	640	1
10	X85687-06D	百叶底横	654	1
9	X85697-01D	百叶顶横	654	1
8	X85679-09R	生边企	300.5	1
7	X85679-09L	生边企	300.5	1
6	J851-LM06	不锈钢丝母巴	25	6
5	J851-SH10R	夏玉小短接660x1170	1	1
4	X85687-03RG	生底横	654	1
3	X85685-01RJ	生顶横	666	1
2	X85679-03LA	生边企	1250	1
1	X85679-02RB	生边企	1250	1

A3	J851-LM09	铝垫块 (40x10x3)	4	送佛
A2	LV-P01-04	百叶背板651x240	1	沙场
A1	LV-S02-04	百叶玉647x207.5	1	

Remarks:


Checked: KEN
Date: 25-02-2020
Project No: J851
Project Name: 青衣190
Material: PRE-CAST ALUM. WINDOW & LOUVRE
Drawn: W.E.X
Date: 25-02-2020
Shop Drawing No. -

Description: 门窗组装图
Tolerance: ±0.5
Projection:

Quantity: 1+1+2
Delivery to Rev:

Date	Amendments

Assembly No. T1-W40A/T2-W40/T2-W63
Rev. 7
MIDI Aluminium Fabricator Ltd.

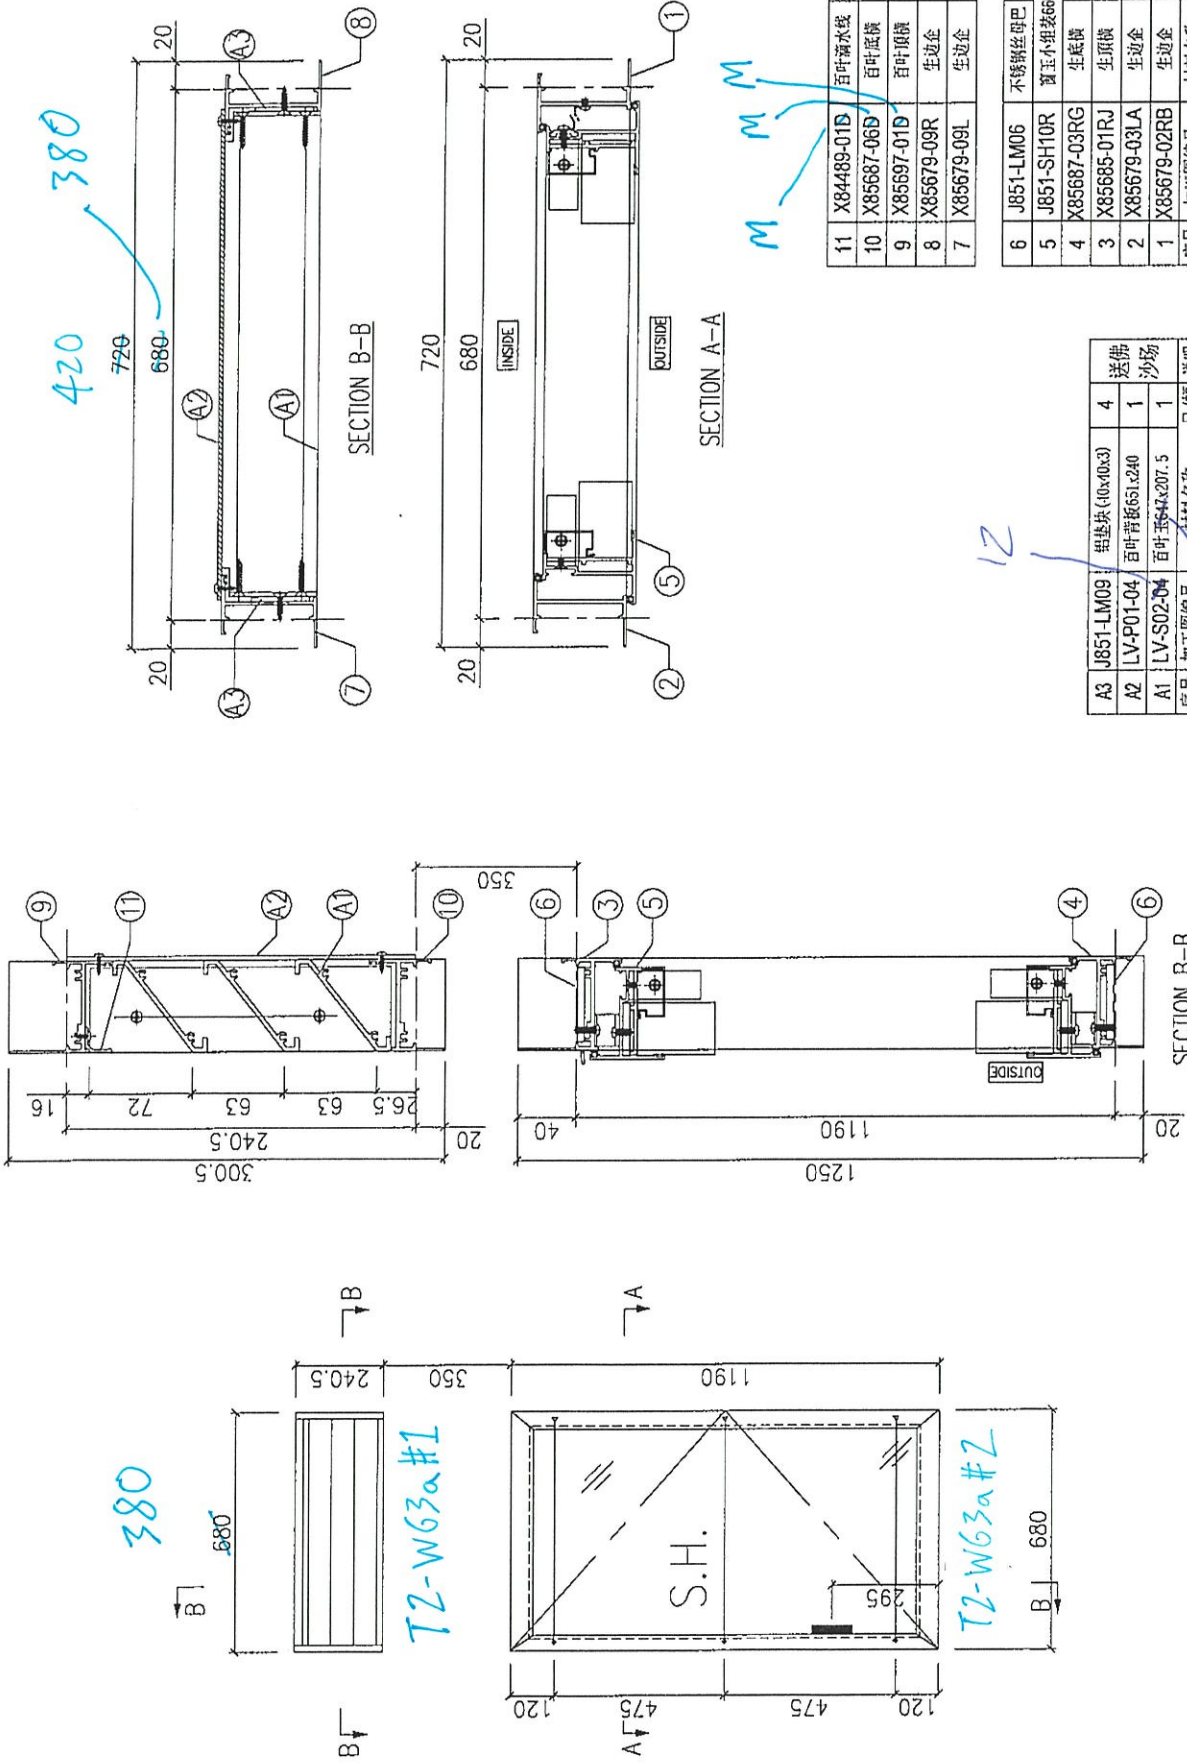

Checked: KEN		Description: 门窗组装图	
Date: 25-02-2020	Material:	QTY: 1	Delivery to Rev.
Drawn: W.E.X	Tolerance: ±0.5	Factory:	
Date: 25-02-2020	Finish:	Projection:	
Project No. J851	UCT534193SC-3	Site:	
Shop Drawing No. 肯衣190	PRE-CAST ALUM. WINDOW & LOUVRE	Assembly No. T2-W63a	Rev.
Remarks: T:\Jobs\851V-铝料、配件、玻璃、加工图\20200302\851预制窗组装修图.dwg			

11	X84489-01B	百叶滴水线	640	1
10	X85687-06D	百叶底横	654	1
9	X85697-01D	百叶顶横	654	1
8	X85679-09R	生边企	300.5	1
7	X85679-09L	生边企	300.5	1


6	J851-LM06	不锈钢丝网	25	6
5	J851-SH10R	黄玉小短胶	660x1170	1
4	X85687-03RG	生底横	654	1
3	X85685-01RJ	生顶横	666	1
2	X85679-03LA	生边企	1250	1
1	X85679-02RB	生边企	1250	1

A3	J851-LM09	铝垫块 (40x40x3)	4	送佛	
A2	LV-P01-04	百叶盖板	651x240	1	沙场
A1	LV-S02-04	百叶盖板	651x207.5	1	

690

730

FABRICATION DRAWING

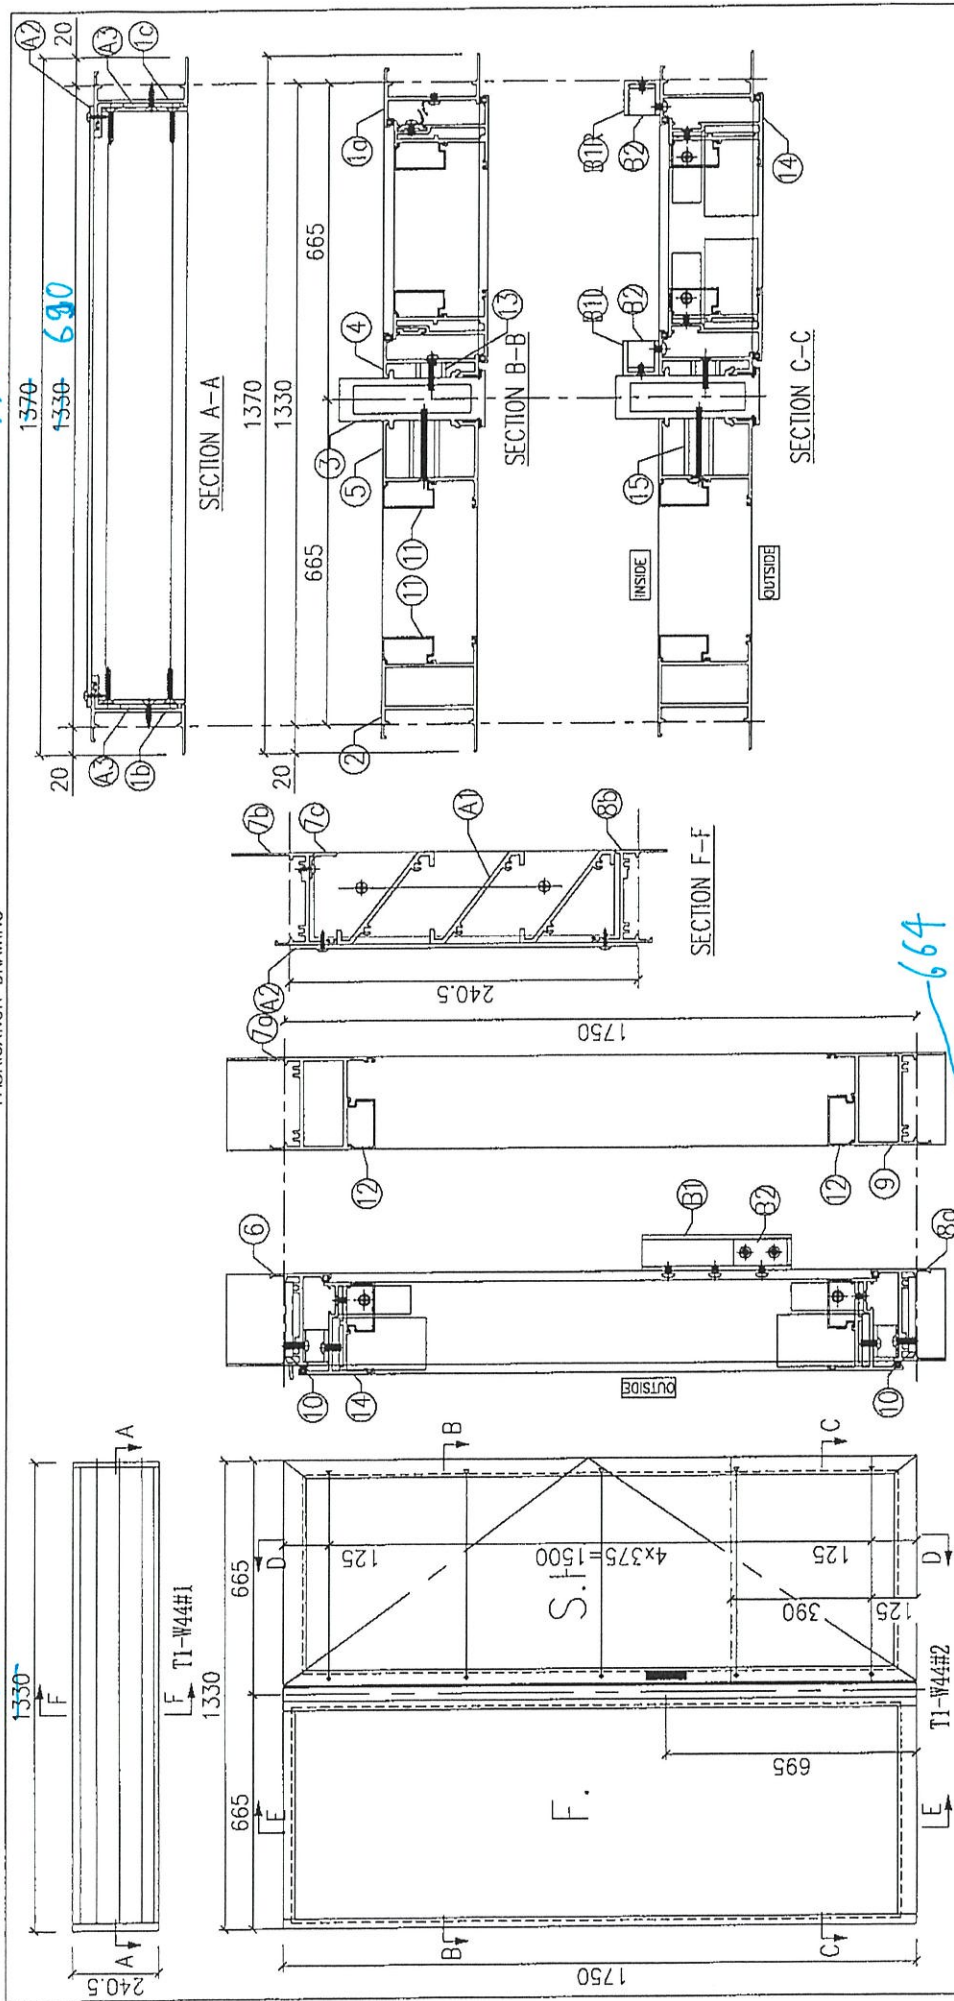

序号	加工图编号	材料名称	长度	支/幅	说明
5	X85682-02RB	框夹企	1810	1	
4	X85683-02LB	生夹企	1810	1	
3	X85684-02B	夹框通	1810	1	
2	X85677-02LC	框通企	1810	1	
1c	X85679-09R	生边企	300.5	1	
1b	X85679-09L	生边企	300.5	1	
1a	X85679-02RC	生边企	1810	1	
9	X85688-01C	垫玻璃	564	1	
8b	X85687-06C	生底横	1304	1	
8a	X85687-03RF	生底横	624	1	
7c	X84489-01C	百叶滴水线	1290	1	
7b	X85697-01C	百叶顶横	1304	1	
7a	X85686-01C	垫顶横	564	1	
6	X85686-01RH	生顶横	636	1	
15	J851-LM10	铝垫通	40.5	7	
14	J851-SH21R	富玉小组装(30x1730)	1730	1	
13	J851-LM12	铝垫通	10.5	7	
12	X856780	方玻璃线槽	525.5	2	
11	X856780	方玻璃线企	1657.5	2	
10	J851-LM06	不锈钢生边巴	25	6	
A3	J851-LM03	铝垫条(10x10x3)	4	4	送拆
A2	LV-P01-12	百叶背板(1301x240)	1	1	沙场
A1	LV-S02-03	百叶玉(1800x207.5)	1	1	沙场

664

650

657

门窗组裝图

664

664


664

664

664

664


FABRICATION DRAWING

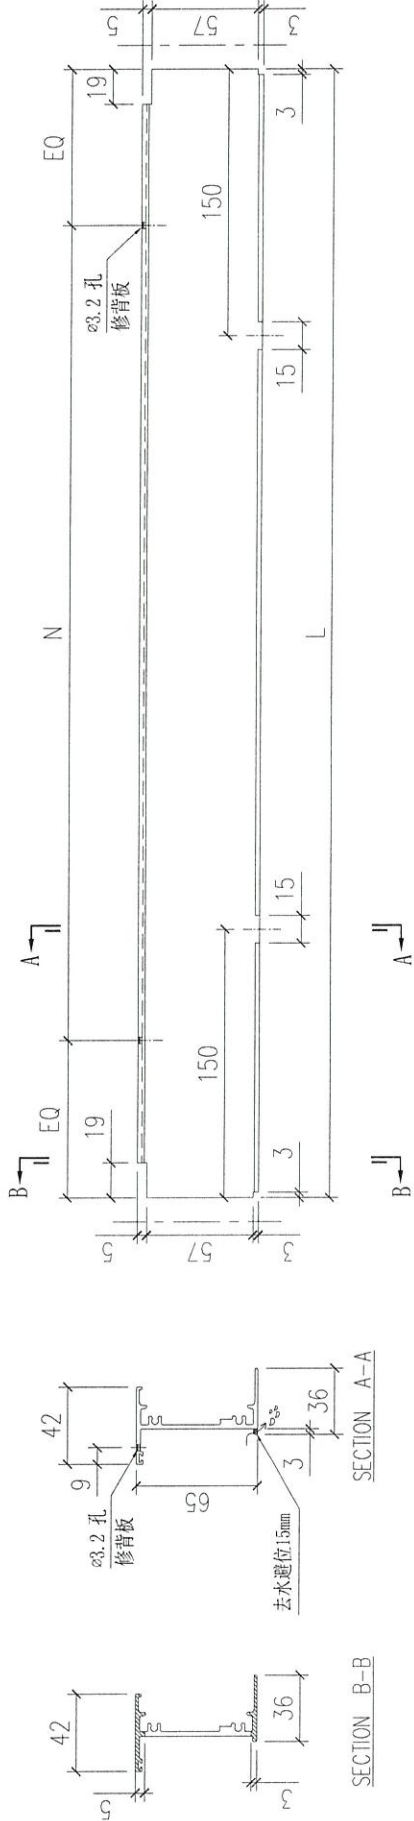

11	X85687-06N	664	2x306%
10	X85687-06M	354	1x500%
9	X85687-06J	1004	3x300c/c
8	X85687-06H	754	2x300c/c
7	X85687-06G	504	1x300c/c
6	X85687-06F	454	1x300c/c
5	X85687-06E	629	2x250c/c
4	X85687-06D	654	2x250c/c
3	X85687-06C	1304	4x300c/c
2	X85687-06B	1329	4x300c/c
1	X85687-06A	664	2x300c/c
序号	部件编号	L	N

Checked:	-	Description:	生底横, X856870
Date:	-	Material:	6061-T6
Drawn:	W.E.X	Finish:	UCT534193SC-3
Date:	15-02-2020	Project No:	J851
Rev:	-	Shop Drawing No.:	PRE-CAST ALUM. WINDOW & LOUVRE
Quantity:	-	Delivery to:	Factory
Tolerance:	±0.5	Site:	
Projection:		Assembly No.:	X85687-06
Amendments:		Rev.:	-


FABRICATION DRAWING

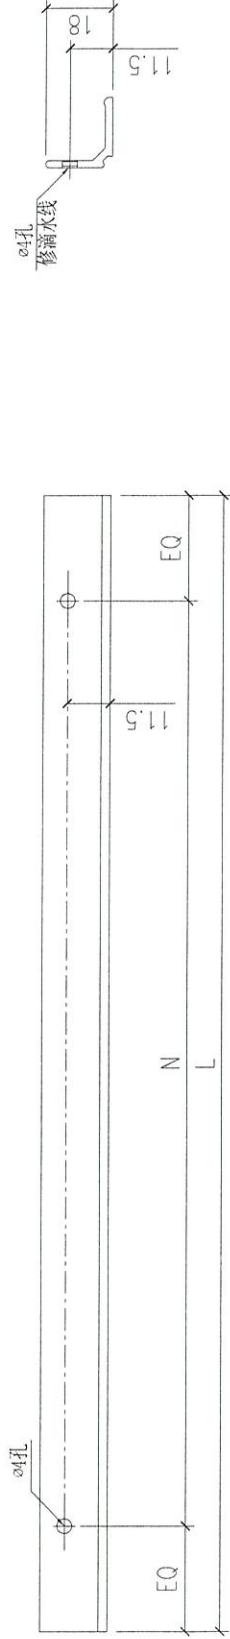

13	X84489-01N	650	2x300c/c
17	X84489-01M	340	1x300c/c
11	X84489-01L	650	2x300c/c
10	X84489-01K	-	-
9	X84489-01J	990	3x300c/c
8	X84489-01H	740	2x300c/c
7	X84489-01G	490	1x300c/c
6	X84489-01F	440	1x300c/c
5	X84489-01E	615	2x250c/c
4	X84489-01D	640	2x250c/c
3	X84489-01C	1290	4x300c/c
2	X84489-01B	1315	4x300c/c
1	X84489-01A	1270	4x300c/c
序号	部件编号	L	N

Checked: -		Description: 滴水线, X844890		QTY: -		Delivery to Rev: -		Date: -		Amendments: -	
Date: -		Material: 6061-T6		Tolerance: ±0.5		Factory					
Drawn: W.E.X		Finish: UCT534193SC-3		Projection:		Site: -		Assembly No: X84489-01		Rev: -	
Date: 15-02-2020		Project No. J851		Project Name: 青衣190		Shop Drawing No. PRE-CAST ALUM. WINDOW & LOUVRE					
Rev: -		Rev: -									

FABRICATION DRAWING

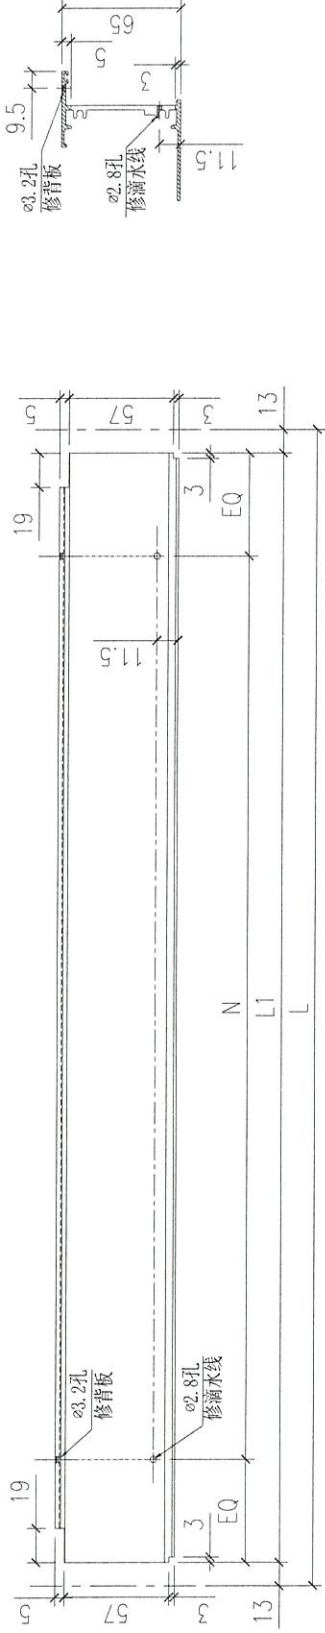

13	X85697-01N	690	664	2x300c/c
12	X85697-01M	380	354	1x300c/c
11	X85697-01L	690	664	2x300c/c
10	X85697-01K	-	-	-
9	X85697-01J	1030	1004	3x300c/c
8	X85697-01H	780	754	2x300c/c
7	X85697-01G	530	504	1x300c/c
6	X85697-01F	480	454	1x300c/c
5	X85697-01E	655	629	2x250c/c
4	X85697-01D	680	654	2x250c/c
3	X85697-01C	1330	1304	4x300c/c
2	X85697-01B	1355	1329	4x300c/c
1	X85697-01A	1310	1284	4x300c/c
序号	部件编号	L	L1	N

Checked: -		Description: 百叶顶横, X856970		Delivery to Rev. Date		Amendments	
Date: -		Material: 6061-T6		Factory			
Drawn: W.E.X		Tolerance: ±0.5		Site		Assembly No. X85697-01	
Date: 15-02-2020		Finish: UCT534193SC-3		Rev		Rev	
Project No. J851		Finish: UCT534193SC-3		Rev		Rev	
Rev. -		Finish: UCT534193SC-3		Rev		Rev	
Ship Drawing No. 青衣190		Finish: UCT534193SC-3		Rev		Rev	
PRE-CAST ALUM. WINDOW & LOUVRE		Finish: UCT534193SC-3		Rev		Rev	

MIDI Aluminium Fabricator Ltd.